

NOTES:


1. JUNCTION BOX EMBEDDED IN CEILING FOR FUTURE SMOKE DETECTOR.
2. JUNCTION BOX EMBEDDED IN CEILING FOR FUTURE CCTV CAMERA.
3. JUNCTION BOX FLUSH WITH FINISHED FLOOR FOR FUTURE PASSENGER INTERCOM.
4. REFER TO E-500 SERIES DRAWINGS FOR SYSTEM TERMINAL CABINET DETAIL.
5. SEE DRAWING SH-51-11-E-194 FOR COMMUNICATION ROOM EQUIPMENT LAYOUT.
6. CROSS ZONE IONIZATION SMOKE DETECTOR ON 2 CIRCUITS IN COMMUNICATION ROOM BY DIV.15
7. FUTURE RETAIL AREA TELEPHONE CONNECTION.
8. ELECTRICAL CONTRACTOR SHALL CO-ORDINATE EXPOSED MECHANICAL DUCT WORK PRIOR TO LOCATING ALL CCTV CAMERAS, DETECTORS ETC AND INSTALL AT U/S OF DUCT WORK. PROVIDE CHANNEL/ HANGERS ETC. FROM CEILING ABOVE AS REQUIRED. TYPICAL FOR ALL AREAS WITH NO CEILING. SEE ARCH. DETAIL.
9. ALL CONDUITS SHOWN ON THIS DRAWING SHALL BE EMBEDDED IN THE CEILING SLAB UNLESS OTHERWISE NOTED.
10. AGENT RELEASING CONTROL PANEL (BY DIV. 15).
11. REFER TO DRAWING E-080 FOR PA SPEAKER LAYOUT.
12. CONTROL MODULES FOR SIGNAGE MAY BE LOCATED ABOVE EMERGENCY POWER PANEL OR INSIDE THE SIGNAGE BOX.
13. REFER TO DRAWING 11-E-087 FOR SCADA SYSTEM LAYOUT.
14. FOR OTHER EMBEDDED CONDUITS AND PULL BOXES NOT SHOWN ON THIS DWG, REFER TO EMBEDDED CONDUIT DWG 11-E-123, 11-E-128.
15. 51-MM-78, 79 & 80 MOUNTED HIGH REFER TO DWG 11-E-909 & 911 FOR MORE DETAILS.
16. 51-CM-78, 79, 80, 81, 82, 83, & 84 MOUNTED HIGH REFER TO DWG 11-E-909 & 910 FOR MORE DETAILS.
17. PROVIDE 19mmC FROM THE COMMUNICATION ROOM DOWN TO THE FLOOR IN W/CONCOURSE. FLOOR CONDUITS TO CONNECT TOKEN PEDESTAL AT CLAM SHELL DOOR AND ALL TURNSTILES AND PASSIMETER. PROVIDE RECESSED JUNCTION BOX AT EACH PEDESTAL LOCATION.

REFERENCE DRAWING

Contract/Reference No. SH35-8-REF-38 Sheet No. 98

ADDENDUM 1

FOR CONTINUATION OF SERVICES BELOW SEE DWG. 11-E-180

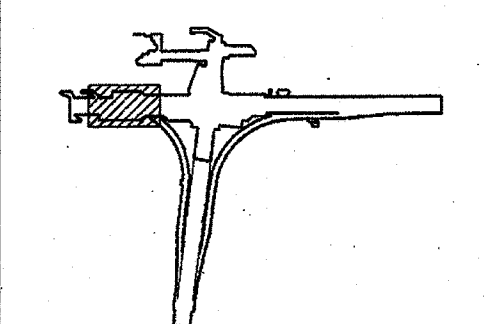

S/W/CONCOURSE

CONTRACT No. SH-51-J1
TORONTO TRANSIT COMMISSION
RAPID TRANSIT EXPANSION PROGRAM
DWG. No. SH-51-11-E-185 REV. No. 8 SHEET 1187

SHEPPARD SUBWAY
YONGE STATION AND RELATED STRUCTURES
SYSTEMS

DRAWN B. Gron 97/01/10
CHECKED C. Misketi 97/01/10
CORRECTED S. RANADIVE 06/01/27
SCALE @ FULL SCALE
1:100 0 1 2 3 4m

RECORD DRAWINGS:
FOR REFERENCE ONLY; NOT FOR CONSTRUCTION
THE REVISIONS TO THIS CONTRACT DOCUMENT, OR TO THIS RECORD DRAWING, AS THE CASE MAY BE, REFLECTING A SIGNIFICANT CHANGE IN THE WORK MADE DURING CONSTRUCTION ARE BASED ON DATA FURNISHED BY THE CONTRACTOR TO NORR LIMITED. NORR LIMITED ASSUMES NO RESPONSIBILITY FOR THE ACCURACY OF THE INFORMATION CONTAINED ON THIS DRAWING WHERE IT HAS BEEN PROVIDED BY THE CONTRACTOR. FURTHERMORE, THE ISSUE OF THIS DRAWING IS A REPRESENTATION BY NORR LIMITED THAT THE CONSTRUCTION, ENLARGEMENT OR ALTERATION OF THE BUILDING IS IN GENERAL, AS OPPOSED TO PRECISE, CONFORMITY WITH THE DESIGN PREPARED AND PROVIDED BY NORR LIMITED. IT IS NOT A REPRESENTATION THAT THE CONSTRUCTION, ENLARGEMENT OR ALTERATION OF THE BUILDING IS IN CONFORMITY WITH A DESIGN THAT HAS BEEN PREPARED OR PROVIDED BY OTHERS.

NORR
NORR Limited
Architects & Engineers

RELATED DRAWINGS
11-A-059 11-M-031
11-A-139 11-M-049
11-A-191 11-M-053
11-SC-046 11-E-123
11-SC-048 11-E-156
11-E-171
11-E-185

CONSTRUCTION
RECORD DRAWING
Issued for Information Only
NOT FOR CONSTRUCTION

| REVISIONS | REVISIONS |
|-----------------------------|----------------------------------|
| 1 c.o. CONDUITS & NOTES | 5 c.o. REISSUED FOR CONSTR |
| 98/06/12 PULL BOXES REMOVED | 00/03/17 MODIFICATIONS TO |
| 2 c.o. FA SYSTEM REVISED | 6 c.o. COLLECTOR'S BOOTH |
| TO CONFORM WITH | REVISIONS |
| 98/09/16 FA RISER TAG ADDED | 00/05/08 ADDITION TO F1311 |
| 3 c.o. CCTV LINE TYPE BOX | 7 c.o. |
| TAG NO. CHANGED | 00/08/04 |
| 99/02/12 MODIFICATIONS TO | 8 c.o. F1300, 338, 350, 360, 513 |
| WEST CONCOURSE | 03/11/28 RECORD DRAWING |
| 199/09/30 | |

*PLOTTER
*PEN SPEC
*PRE SPEC
*LEVELS
*USER

*REF06
*REF07
*REF08
*REF09
*REF10

*REF01
*REF02
*REF03
*REF04
*REF05

BLDG. REF. No. FILE 11E185

SHEET No. 1187

DRAWING No. SH-51-11-E-185