



Addendum #5

DATE: August 31, 2021

SUBJECT: Request for Tenders for "Library, and Information and Instructional Services (IITS) Interior

Renovation Project - Phase 1" UTSC2021-15

Included in this Addendum are: 2 pages for Addendum #5

2 pages for revised Appendix 1- Architectural Drawings

4 pages in total

1. Extension of Submission Deadline

The submission deadline has been extended to Wednesday, March 31, 2021, therefore,

DELETE: All references to the Submission Deadline of September 2, 2021 at

2:00:00 p.m., and

REPLACE WITH: Submission Deadline of Tuesday, September 7, 2021 at

2:00:00 p.m.

2. Appendix 1 – Architectural Drawings

1. **DELETE:** Drawing A3.4

REPLACE WITH: Drawing A3.4 distributed with this Addendum.

To revise the definition of Separate Price B-5 to include a specification of the moss panel.

2. DELETE: Drawing A3.9

REPLACE WITH: Drawing A3.9, distributed with this Addendum.

To revise the definition of Separate Price B-5 to include a specification of the moss panel.

3. Questions and Answers

Question 1:

There's not proper info on drawings for pricing of separate price B4 (New blinds in AC280) / drawings don't show location(s), elevation(s) for the blinds. Could you please clarify

Answer 1:


The location of the new blinds is AC280A, Library Lounge. The blinds are to cover the new screen described under SEPARATE PRICE B-3. Please reference the elevation found on Drawing 04/A3.2, and Appendix 2 – PC350 Design Tender Drawings.


Question 2: Regarding the Moss Panels, would you be able to provide more details such as the manufacturer, the preferred type etc.? It will be helpful to price accurately with specific requirement.

Answer 2:

Please refer to Items 2.1 and 2.2 above.

End of Addendum #5

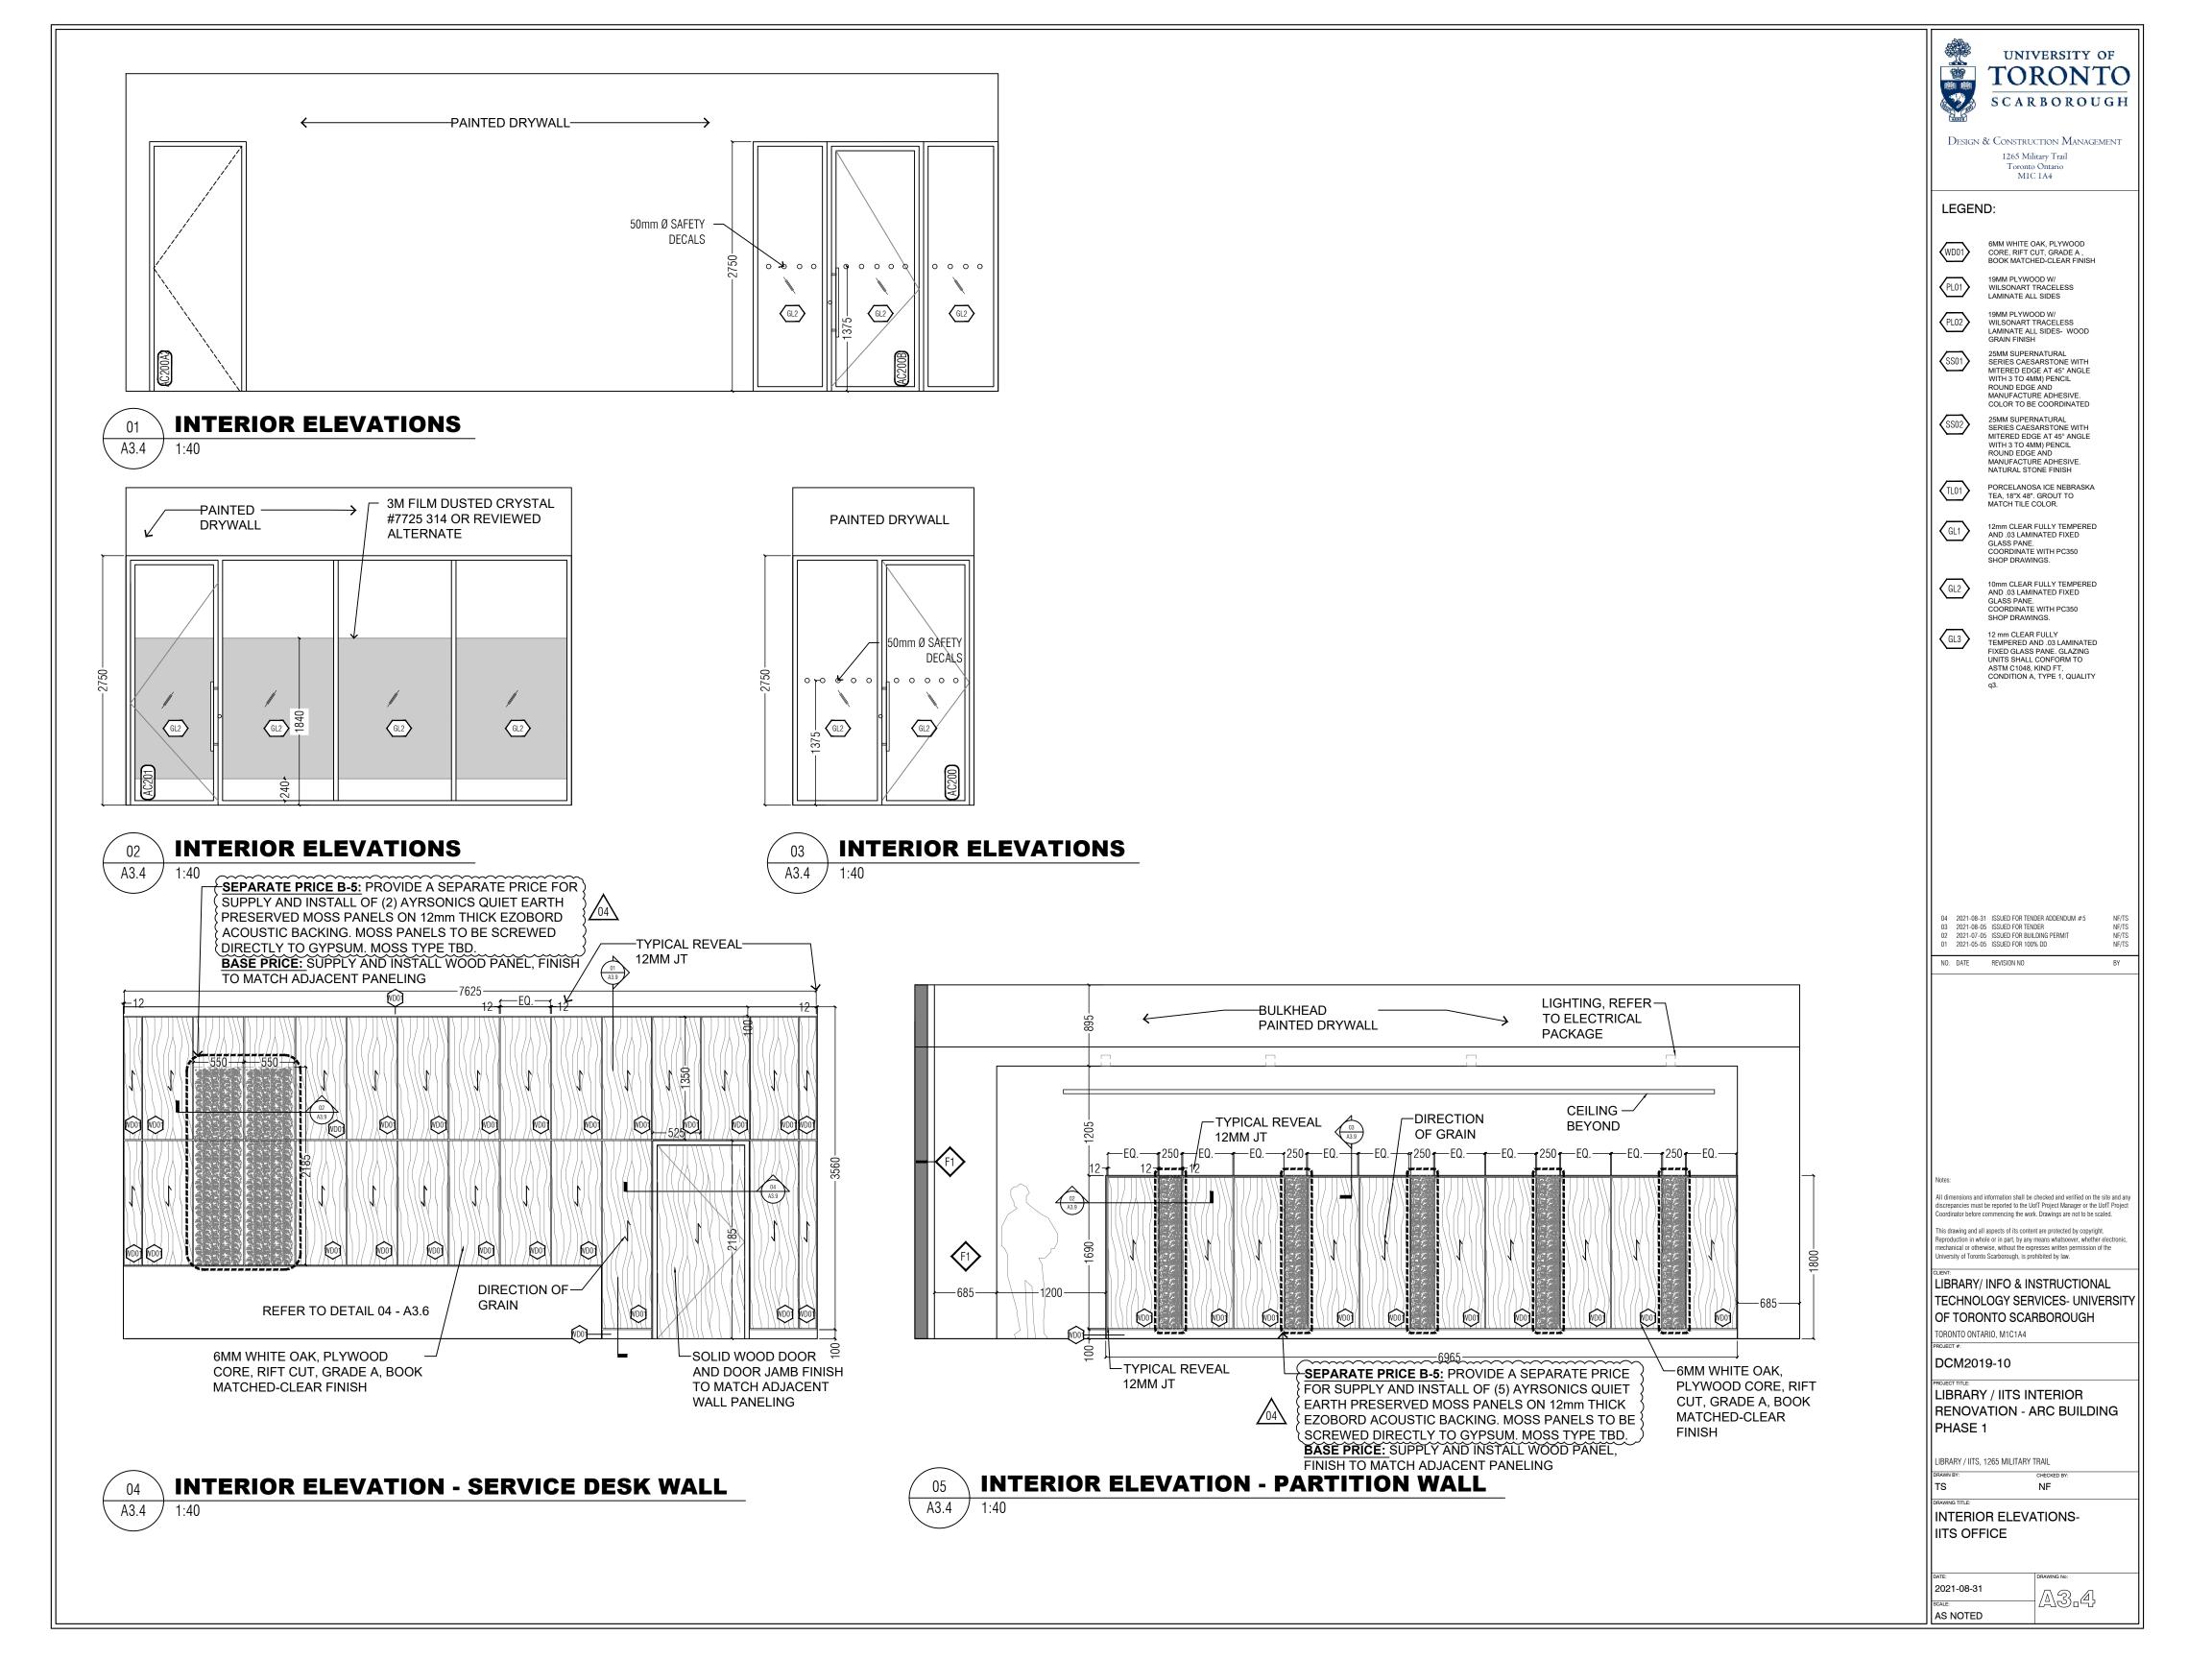

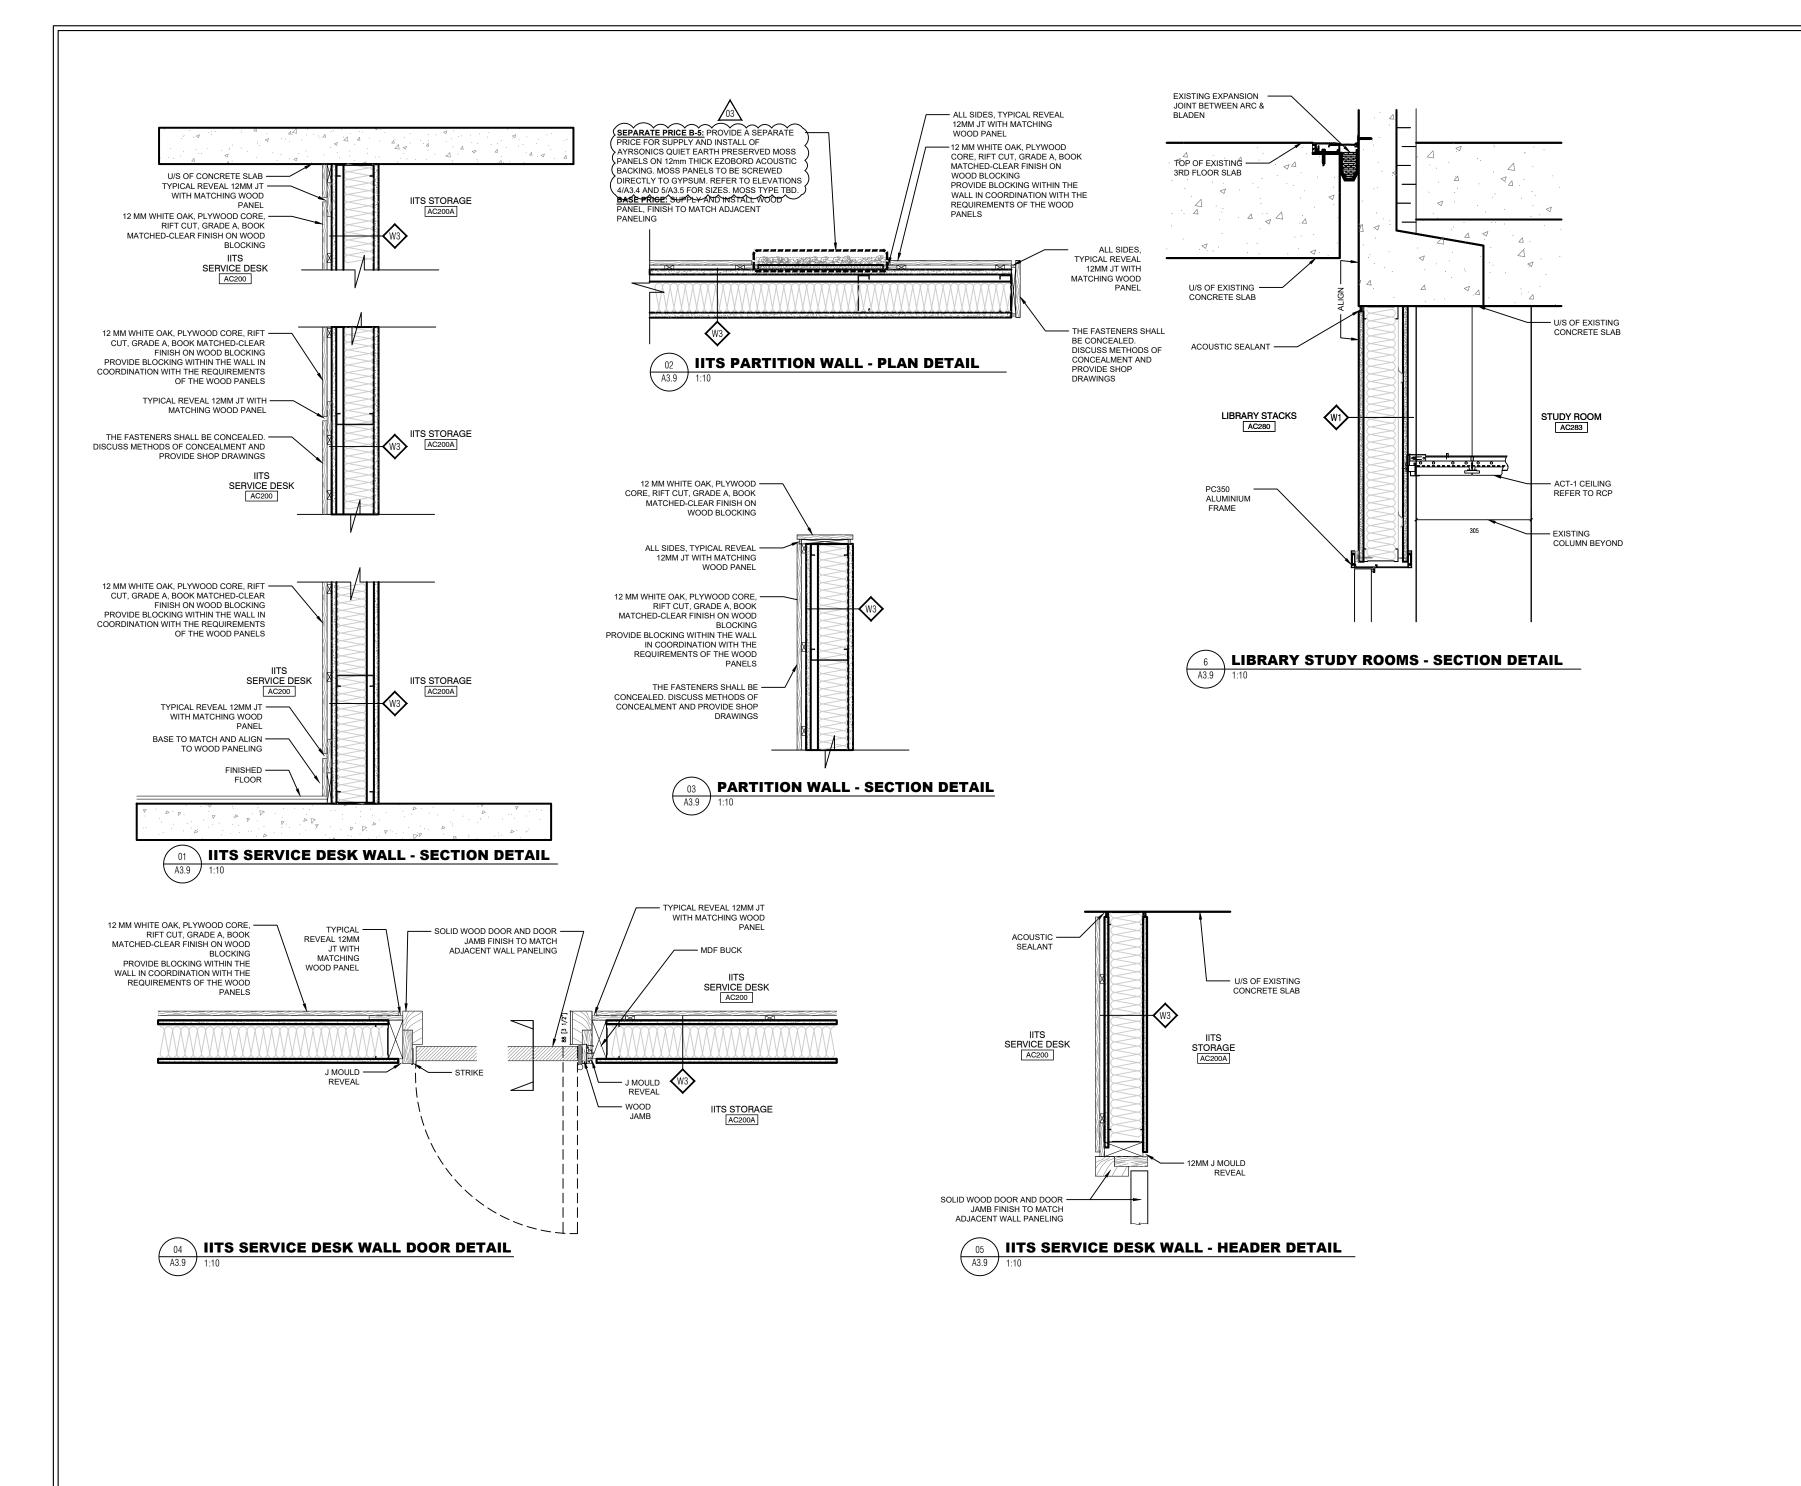

UNIVERSITY OF TORONTO
SCARBOROUGH

DESIGN & CONSTRUCTION MANAGEMENT
1265 Military Trail
Toronto Ontario
MIC 1A4

LEGEND:

6MM WHITE OAK, PLYWOOD CORE, RIFT CUT, GRADE A, BOOK MATCHED-CLEAR FINISH

> 19MM PLYWOOD W/ WILSONART TRACELESS LAMINATE ALL SIDES

PL02 19MM PLYWOOD W/
WILSONART TRACELESS
LAMINATE ALL SIDES- WOOD
GRAIN FINISH

25MM SUPERNATURAL
SERIES CAESARSTONE WITH
MITERED EDGE AT 45° ANGLE
WITH 3 TO 4MM) PENCIL
ROUND EDGE AND
MANUPACTURE ADHESIVE.
COLOR TO BE COORDINATED

25MM SUPERNATURAL
SERIES CAESARSTONE WITH
MITERED EDGE AT 45° ANGLE
WITH 3 TO 4MM) PENCIL
ROUND EDGE AND
MANUFACTURE ADHESIVE.
NATURAL STONE FINISH

PORCELANOSA ICE NEBRASKA
TEA, 18"X 48". GROUT TO
MATCH TILE COLOR.

GL1 12mm CLEAR FULLY TEMPERED AND. 03 LAMINATED FIXED GLASS PANE. COORDINATE WITH PC350

GL2 10mm CLEAR FULLY TEMPERED AND .03 LAMINATED FIXED GLASS PANE. COORDINATE WITH PC350

GL3

12 mm CLEAR FULLY
TEMPERED AND .03 LAMINATED
FIXED GLASS PANE. GLAZING
UNITS SHALL CONFORM TO
ASTM C1048, KIND FT,
CONDITION A, TYPE 1, QUALITY
03.

03 2021-08-31 ISSUED FOR TENDER ADDENDUM #5
02 2021-08-05 ISSUED FOR TENDER

2021-05-05 ISSUED FOR 100% DD

NO. DATE REVISION NO

Notes

All dimensions and information shall be checked and verified on the site and an discrepancies must be reported to the UofT Project Manager or the UofT Project Coordinator before commencing the work. Drawings are not to be scaled.

This drawing and all aspects of its content are protected by copyright.

Reproduction in whole or in part, by any means whatsoever, whether electronic, mechanical or otherwise, without the expresses written permission of the University of Toronto Scarborough, is prohibited by law.

LIBRARY/ INFO & INSTRUCTIONAL
TECHNOLOGY SERVICES- UNIVERSITY
OF TORONTO SCARBOROUGH

TORONTO ONTARIO, M1C1A4

DCM2019-10

LIBRARY / IITS INTERIOR RENOVATION - ARC BUILDING PHASE 1

LIBRARY / IITS, 1265 MILITARY TRAIL

TS

SECTION AND PLAN DETAILS

DATE: 2021-08-31

2021-08-31 SCALE: AS NOTED