

# WORKSHOP

## Addendum 03

<b>Project:</b>	2nd floor addition at 56 Edilcan Drive, Vaughan, for Accord Plastics	<b>Date:</b>	05 April 2024
<b>Project No.</b>	2231	<b>Pages incl. cover:</b>	17

---

The following changes, additions, deletions and clarifications are hereby made an integral part of the documents, including the drawings and specifications for the above project.


---

Item	Description
3.01	<p><b>Revision to RFP Schedule: Revise item 1 of Instructions to Bidders as follows:</b></p> <ul style="list-style-type: none"><li>• Bidder Question/Enquiries Due Date: 05 April 2024, 5pm</li><li>• Response to Questions Date: 08 April 2024, 5pm</li><li>• Submission Deadline (Technical + Financial): 16 April 2024, 2pm (via email)</li><li>• Supplementary Bid Form Submission 17 April 2024, 2pm (via email)</li></ul>
3.02	<p><b>Revision to Cash Allowance</b></p> <p>Further to Addendum 2, the Cash Allowance has been revised. Refer to updated Bid Form (attached).</p>
3.03	<p><b>Question:</b> Please confirm if the clerestory window noted on drawing A1.2 Level 1 - Proposed Plan is new or existing, if possible please provide any details/sections/elevation regarding the clerestory.</p> <p><b>Response:</b> There are no new clerestory windows on the ground floor. Note on drawing A1.2 refers to an existing window.</p>
3.04	<p><b>Question:</b></p> <ol style="list-style-type: none"><li>1. Can you please ask if any finishes would be required in Manufacturing area E112? If so, what is the extent?</li><li>2. For Second floor area 208, RFS just shows wall finish as "EXP". So is there no painting required to walls, but only painting to the exposed ceiling?</li><li>3. RFS shows n/a for wall finish in Mezzanine M105. Is this correct?</li></ol> <p><b>Response:</b></p> <ol style="list-style-type: none"><li>1. Face of new walls &amp; touch-up of new ceiling/wall penetrations to be painted.</li></ol>

# WORKSHOP

	<p>2. Exposed ceiling in manufacturing area is painted. All columns &amp; misc metals are to be painted. Perimeter exterior walls are not painted, exterior walls are composed of prefinished metal panels. Both sides of interior gypsum walls are to be painted, unless noted otherwise.</p> <p>3. Yes, this is a catwalk mezzanine that has no walls.</p>
3.05	<p><b>Question:</b> Is there a color spec for the plastic laminate and solid surface for the lunchroom ?</p> <p><b>Response:</b> Acceptable manufacturers for materials such as PLAM can be found in the Specifications, colour choices are to be chosen from manufacturer's colour range as indicated in Specification. Basis of design for the QTZ countertop as noted in the spec is to be:</p> <p>Basis-of-Design Material: Quartz by Ceasarstone, CambriaQuartz by Cambria, Quartz by Corian or approved equivalent.</p> <p>Colour to be chosen from Caesarstone's "Standard" Range of finishes.</p>
3.06	<p><b>Question:</b> Please see attached snapshot and advise on the following question.</p> <p>.1 Crystalline Waterproofing Additive: The concrete waterproofing and protection system shall be of the crystalline type that chemically controls and permanently fixes a non-soluble crystalline structure within the pores and capillary tracts of the concrete. This crystalline system causes the concrete to become sealed against the penetration of liquids from any direction and protects the concrete from deterioration due to harsh environmental conditions. The system is used for above or below-grade walls and slabs, including liquid retaining structures and where enhanced chemical resistance is required. The crystalline waterproofing additive shall have a Visual Detection System (VDS) to enable confirmation of the presence of the additive in hardened concrete.</p> <p>1.3 SYSTEM PERFORMANCE REQUIREMENTS</p> <p>.1 Testing Requirements: The crystalline waterproofing system shall have been tested in accordance with the following standards and conditions, and the testing results shall meet or exceed the performance requirements as specified herein.</p> <p>.2 Independent Laboratory: Testing shall have been performed by an accredited independent laboratory, meeting the requirements of ASTM E 329, CCRL, CCIL, ISO 17025 or other applicable international standard for certification of testing laboratories. The testing laboratory shall have obtained all control and treated concrete samples.</p> <p>.3 Crystalline Formation: The crystallizing capability of the waterproofing system shall be evidenced by independent scanning electron microscope (SEM) photographs showing crystalline formations within the concrete matrix.</p> <p>.4 Permeability: Independent testing shall be performed according to EN 12390-8. Treated samples shall be exposed to water with a pressure of 0.5 MPa for 72 hours. Treated samples must exhibit a reduction in permeability coefficient of at least 80% when compared to control concrete. Control samples must have a depth of penetration of at least 50 mm.</p> <p>.5 Sulfate Resistance: Independent testing shall be performed to determine "Sulfate Resistance of Concrete Specimens" treated with integral crystalline admixture. Treated and untreated samples shall be immersed in a concentrated sulfate solution for at least 4 months. On final weighing, the percentage mass loss of the treated samples shall be significantly lower than the control samples.</p> <p>.6 Compressive Strength: Concrete samples containing the crystalline waterproofing additive shall be tested against an untreated control sample of the same mix. At 28 days, the treated samples shall exhibit equal or increased compressive strength over the control sample.</p> <p>Do we assume you will retain an Independent Laboratory for testing samples? Is there pre pour sampling at the plant for this project?</p> <p><b>Response:</b> Third party testing is covered by cash allowance.</p>

# WORKSHOP
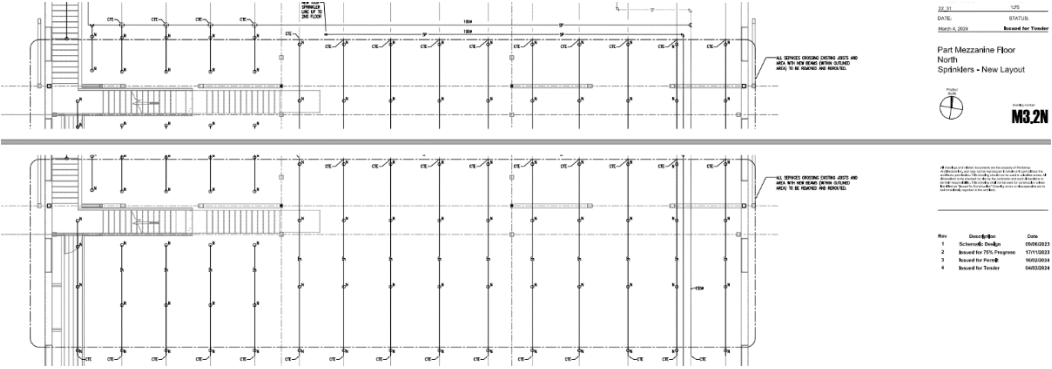
<p>3.07</p>	<p><b>Question:</b> Please see the screenshot below. Can you please confirm what is your approach when you would do this work on Mezzanine area, when you would do those structural changes and remove / add new branch lines for sprinklers? When you will do that work, you won't have sprinkler coverage for the rest of the floor and that is not right.</p>  <p><b>Answer:</b> This project is dependant on the chosen contractor's approach to phasing &amp; understanding of the complexity of working around an operational facility. It is up to you to generate an approach to this issue. Depending on Contractor's selected delivery methods, firewatch may be required while life safety systems are offline. As noted within the documents, firewatch is the Contractor's responsibility.</p>
<p>3.08</p>	<p><b>Question:</b> Demolition notes D3 and D4 on drawing A1.0 indicate to remove existing footings and columns. Structural Drawings indicate existing footings and columns to remain at noted locations.</p> <p><b>Answer:</b> Note D3 is to be revised to:</p> <ul style="list-style-type: none"> <li>• Prepare existing column to receive structural reinforcement and Intumescent paint finish, including the removal &amp; reinstatement of existing column mounted services. Refer also to mechanical &amp; electrical.</li> </ul> <p>Note D4 is to be revised to:</p> <ul style="list-style-type: none"> <li>• Cut and remove existing floor slab. Prepare to accept new concrete footing.</li> </ul>
<p>3.09</p>	<p><b>Question:</b> Is topographic survey of exterior grades available. It is required to determine required excavation work related to elevator / stair addition as well as exterior column footings. Also, clarify which detail, 4A/S403 or 4B/S403, applies at each exterior column location.</p> <p><b>Answer:</b> Topographic survey has been appended to this addendum.</p>
<p>3.10</p>	<p><b>Question:</b></p> <ol style="list-style-type: none"> <li>1. Addendum 2 mention a future cash allowance to cover unidentified mechanical and electrical that may need to be relocated as a result of fireproofing and joist reinforcement. Will the cash allowance also consider all conditions of unidentified services where work is taking place? For example, note S5 on A0.2.</li> </ol>

# WORKSHOP

	<p>2. Note D4 on A1.0 indicates we are to remove existing footings. Plan Detail 1 on S403 says FX1 footings are to remain. What is correct?</p> <p><b>Response:</b></p> <ol style="list-style-type: none"><li>1. All work outlined in the documents shall be included in the Base Bid. Work that is legitimately extra to the contract documents will be covered either by cash allowance or change order.</li><li>2. Refer to answer given in response 3.10</li></ol>
3.11	<p><b>Question:</b></p> <ol style="list-style-type: none"><li>1. Are we required to repaint entire of the existing ground floor exposed structural and floor deck?</li><li>2. From one of our trades : Please be advised Rockwool Mineral Fibre insulation is currently in access of 110 days from date of order. Our stock is insufficient to accommodate a project of this complexity. It may be prudent to advise consultant and see if an alternative product may be approved. Please advise.</li></ol> <p><b>Response:</b></p> <ol style="list-style-type: none"><li>1. Extent of painting for ground floor structure &amp; exposed floor structure has been noted in the drawings. Refer to drawing 1/A0.1 for fireproofing strategy as this indicates intumescent paint &amp; spray applied fireproofing. All new ground floor columns &amp; reinforced existing ground floor columns are to receive intumescent paint (as specified). See also: 1/A1.4, A4.0 (Note E1).</li><li>2. Quantity of mineral wool in the project is not substantial. Product alternates will be discussed with successful bidder upon contract award.</li></ol>

Encl. Updated Bid Form 00 41 00  
Topographic Survey drawing  
EAD-1 Electrical Addendum  
MAD-2 Mechanical Addendum

**End of Addendum 03**



**Allowances**

The following allowances are **included** within the base bid price identified above:

<b>Allowance</b>	<b>Value</b>
Testing & Inspections	\$30,000
Hardware Keying	\$5,000
Exterior Landscaping	\$400,000
Front Façade Improvements	\$125,000
Removal/reinstatement of services not otherwise identified within Contract Documents	\$40,000
<b>Total</b>	<b>\$600,000</b>

**Alternative Prices**

The amount to be added to, or deducted from, our base bid price (as entered in the Bid Form) is entered for each requested alternative. All alternative prices exclude Value Added Taxes. If there is no change to the base bid price for an alternative, we have so indicated. It is understood that:

- .1 the Owner may accept any of the alternatives and corresponding alternative prices in any order or combination, including all or none,
- .2 the lowest bidder will be determined solely from the base bid, without considering any alternative prices, alternatives and alternative prices are open for acceptance by the Owner for the same period of time as the base bid price,

<b>Description of Alternative</b>	<b>Effect on Base Bid</b>	
	<b>Add</b>	<b>Delete</b>
Alternative 1: 12-month elevator maintenance as outlined in Specification Section 14 20 00, Clause 1.2		

**Signatures:**

Signed and submitted for and on behalf of:

Company:

\_\_\_\_\_  
 (Name)



\_\_\_\_\_  
 (Street Address)

\_\_\_\_\_  
 (City, Province & Postal Code)

Signature: \_\_\_\_\_

Name and Title: \_\_\_\_\_

Dated at: \_\_\_\_\_ this \_\_\_\_\_ day of \_\_\_\_\_, 2024

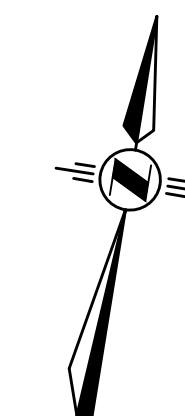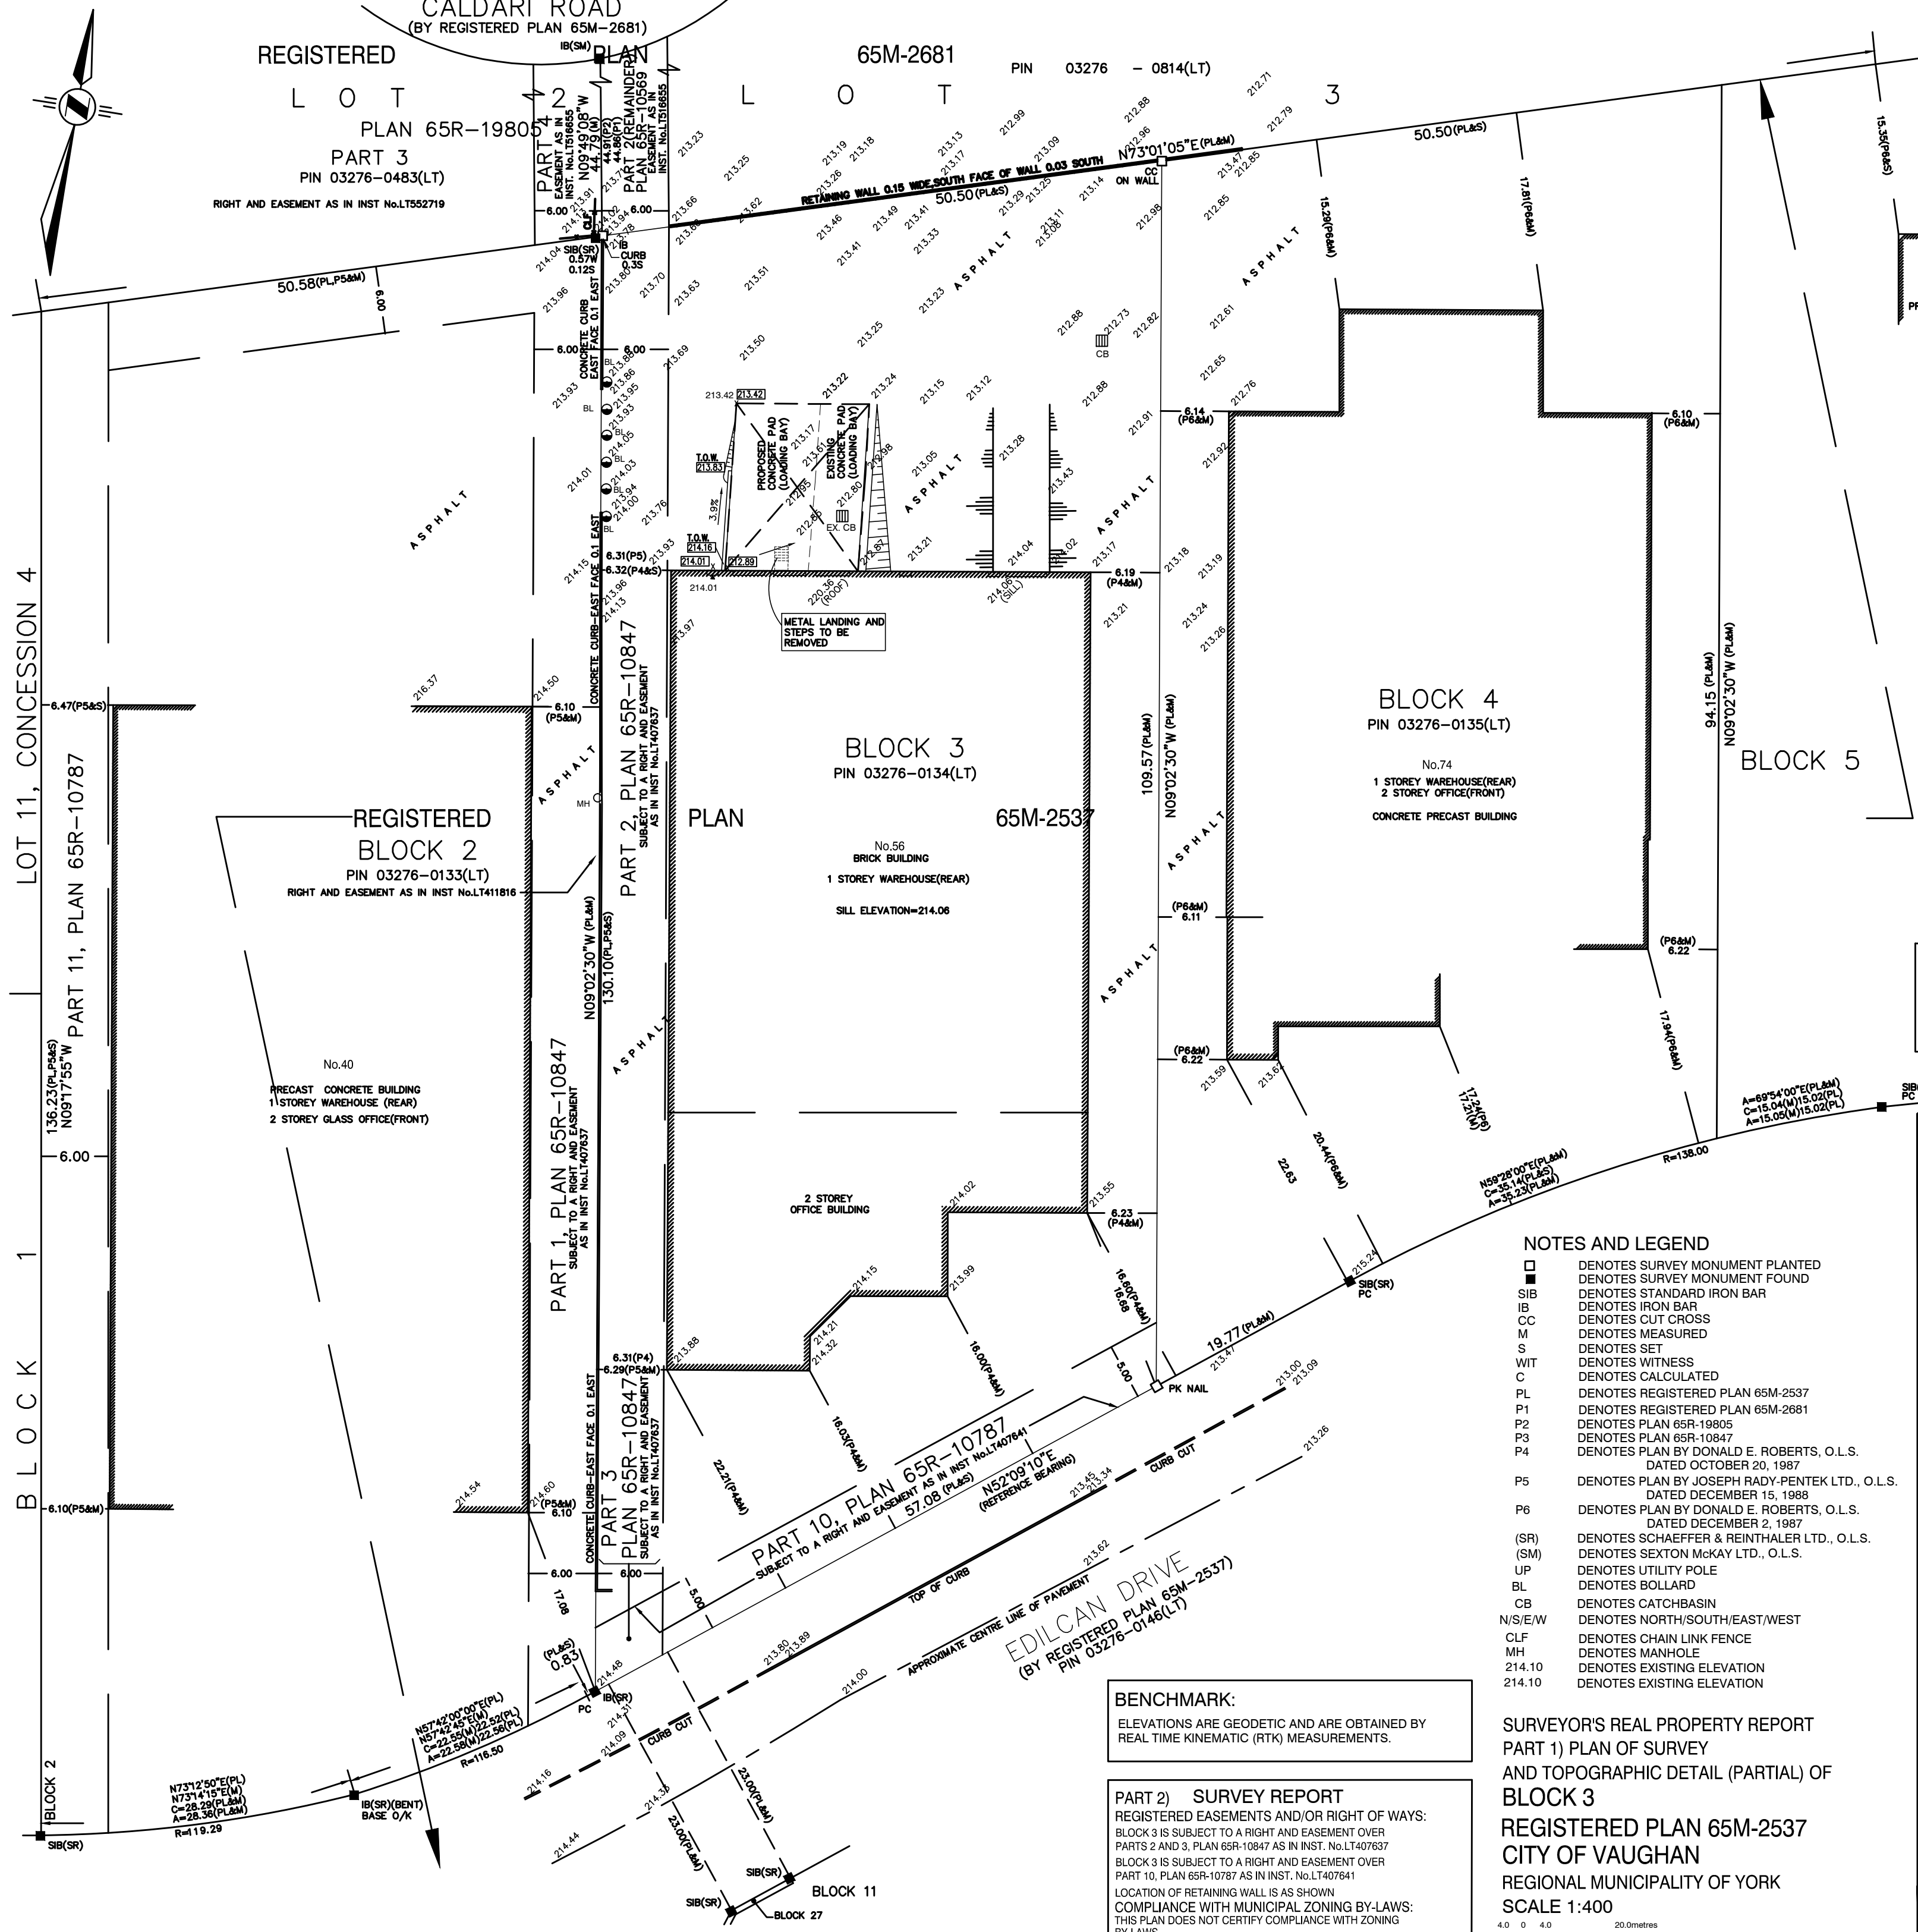

CALDARI ROAD  
(BY REGISTERED PLAN 65M-2681)  
REGISTERED PLAN 65M-2681  
PIN 03276 - 0814(LT)

LOT 4  
PART 4  
PLAN 65R-1980  
PART 3  
PIN 03276-0483(LT)  
RIGHT AND EASEMENT AS IN INST No.LT552719

LOT 11, CONCESSION 4

LOT 11, CONCESSION 1

REGISTERED BLOCK 2  
PIN 03276-0133(LT)  
RIGHT AND EASEMENT AS IN INST No.LT41816

BLOCK 3  
PIN 03276-0134(LT)  
No.56  
BRICK BUILDING  
1 STOREY WAREHOUSE(REAR)  
SILL ELEVATION=214.06

BLOCK 4  
PIN 03276-0135(LT)  
No.74  
1 STOREY WAREHOUSE(REAR)  
2 STOREY OFFICE(FRONT)  
CONCRETE PRECAST BUILDING

BLOCK 5

**BEARING NOTE:**  
BEARINGS ARE ASTROMOMIC AND ARE DERIVED FROM THE NORTHERLY LIMIT OF EDILCAN DRIVE AS SHOWN ON REGISTERED PLAN 65M-2537 HAVING A BEARING OF N52°09'10"E

**BENCHMARK:**  
ELEVATIONS ARE GEODETIC AND ARE OBTAINED BY REAL TIME KINEMATIC (RTK) MEASUREMENTS.

**PART 2) SURVEY REPORT**  
REGISTERED EASEMENTS AND/OR RIGHT OF WAYS:  
BLOCK 3 IS SUBJECT TO A RIGHT AND EASEMENT OVER PARTS 2 AND 3, PLAN 65R-10847 AS IN INST. No.LT407637  
BLOCK 3 IS SUBJECT TO A RIGHT AND EASEMENT OVER PART 10, PLAN 65R-10787 AS IN INST. No.LT407641  
LOCATION OF RETAINING WALL IS AS SHOWN  
COMPLIANCE WITH MUNICIPAL ZONING BY-LAWS:  
THIS PLAN DOES NOT CERTIFY COMPLIANCE WITH ZONING BY-LAWS.

**SURVEYOR'S REAL PROPERTY REPORT**  
PART 1) PLAN OF SURVEY  
AND TOPOGRAPHIC DETAIL (PARTIAL) OF  
BLOCK 3  
**REGISTERED PLAN 65M-2537**  
CITY OF VAUGHAN  
REGIONAL MUNICIPALITY OF YORK  
SCALE 1:400

**COMPLIANCE PACKAGE "J"**

The Architect is not responsible for the accuracy of survey, structural, mechanical, electrical, etc. engineering information shown on the drawing. Refer to the appropriate engineering drawings before proceeding with work.

Contractor shall check all dimensions on the work and report any discrepancy to the Architect before proceeding. Construction must conform to all applicable Codes and Requirement of Authorities having Jurisdiction.

All drawings, specifications and related documents are the copyright property of Peter Del Grosso O/A 249372 Ontario Inc. and must be returned upon request. Reproduction of drawings, specifications and related documents in part or whole is forbidden without the permission of Peter Del Grosso.

This drawing is not to be scaled.

This drawing is not to be used for construction unless signed by the Architect.

Issued for Construction: \_\_\_\_\_ PETER DEL GROSSO

Signature: \_\_\_\_\_

Date: \_\_\_\_\_

NO:	DATE:	REVISION:

DRAWING TITLE:  
**SITE PLAN**

PROJECT:  
**PROPOSED FOR**  
56 EDILCAN DRIVE  
VAUGHAN, ONTARIO

**PETER DEL GROSSO**  
ARCHITECTURAL TECHNOLOGIST

67 Elmbrook Crescent  
Etobicoke, Ontario M9C 5C7  
T: 416 621 3662  
e-mail: peterd@pdeldesign.ca  
www.pdeldesign.ca

NO:	DATE:	REVISION:
2.	NOV. 14/16	ISSUED FOR REVIEW


The undersigned has reviewed and takes responsibility for this design, and has the qualifications and meets the requirements set out in the Ontario Building Code to design the work shown on the attached documents

**QUALIFICATION INFORMATION**  
Required unless design is exempt under Division C, Subsection 3.2.5 of The Building Code

PETER DEL GROSSO 20567

**REGISTRATION INFORMATION**  
Required unless design is exempt under Division C, Subsection 3.2.4 of The Building Code

PETER DEL GROSSO 27288

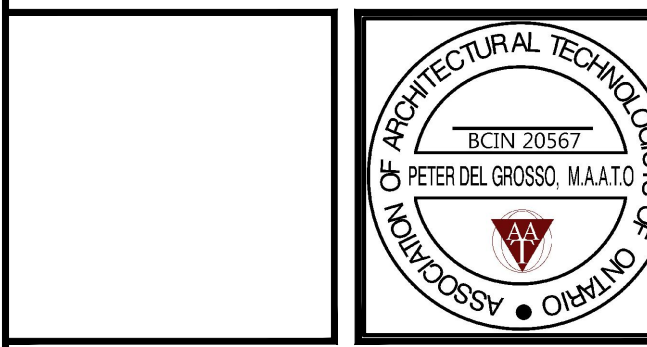

AREA:	DRAWING No.:
SCALE: 1:400	<b>SP-1</b>
DRAWN BY: PDG	PROJECT No.: 16-47
DATE: NOV. 14/16	

**LEGEND**

- STORM CONNECTION
- SANITARY CONNECTION
- WATER CONNECTION
- HYDRO CONNECTION
- ▭ DOUBLE CATCH BASIN
- ▭ CATCH BASIN
- STREET LIGHT
- HYDRANT
- ▭ TRANSFORMER
- ▭ CABLE TV PEDESTAL
- ▭ BELL PEDESTAL
- ▭ ENTRANCE DOOR LOCATION
- ▭ GARAGE DOOR LOCATION
- ▭ COMMUNITY MAILBOX
- ▭ ENGINEERED FILL LOT
- VALVE AND CHAMBER
- SANITARY MANHOLE
- STORM MANHOLE
- ▭ AIR-CONDITIONING UNIT
- ▭ PROPOSED GRADE
- ▭ EXISTING GRADE
- ▭ PROPOSED SWALE GRADE
- ▭ DOWNSPOUT LOCATION
- ▭ TELECOM. JUNCTION BOX
- ▭ PROPOSED BERM
- ▭ SWALE DIRECTION
- ▭ HYDRO METER
- ▭ GAS METER
- ▭ FINISHED FLOOR ELEVATION
- ▭ TOP OF FOUNDATION WALL
- ▭ FIN. BASEMENT FLOOR SLAB
- ▭ UNDERSIDE FOOTING ELEVATION
- BOREHOLE LOCATION
- ▭ SLOPE SECTION
- ▭ GARBAGE BIN
- ▭ RECYCLING BIN

**NOTES AND LEGEND**


- DENOTES SURVEY MONUMENT PLANTED
- DENOTES SURVEY MONUMENT FOUND
- SIB DENOTES STANDARD IRON BAR
- IB DENOTES IRON BAR
- CC DENOTES CUT CROSS
- M DENOTES MEASURED
- S DENOTES SET
- WIT DENOTES WITNESS
- C DENOTES CALCULATED
- PL DENOTES REGISTERED PLAN 65M-2537
- P1 DENOTES REGISTERED PLAN 65M-2681
- P2 DENOTES PLAN 65R-19805
- P3 DENOTES PLAN 65R-10847
- P4 DENOTES PLAN BY DONALD E. ROBERTS, O.L.S. DATED OCTOBER 20, 1987
- P5 DENOTES PLAN BY JOSEPH RADY-PENKTEK LTD., O.L.S. DATED DECEMBER 15, 1988
- P6 DENOTES PLAN BY DONALD E. ROBERTS, O.L.S. DATED DECEMBER 2, 1987
- (SR) DENOTES SCHAEFFER & REINTHALER LTD., O.L.S.
- (SM) DENOTES SEXTON McKay LTD., O.L.S.
- UP DENOTES UTILITY POLE
- BL DENOTES BOLLARD
- CB DENOTES CATCHBASIN
- N/S/E/W DENOTES NORTH/SOUTH/EAST/WEST
- CLF DENOTES CHAIN LINK FENCE
- MH DENOTES MANHOLE
- 214.10 DENOTES EXISTING ELEVATION
- 214.10 DENOTES EXISTING ELEVATION

SCALE 1:400  
4.0 0 4.0 20.0metres

Architect in Charge: Workshop Architecture Inc.	Electrical Addendum	EAD-1 (Addendum #3)
	Issue Date:	April 5, 2024
Project: <b>Accord Vaughan, 56 Edilcan Drive, Concord</b>	Project Number:	2023-1010

The following items are changes to the tender contract documents for this project. Contractor shall include the cost of these addendum items in the tender quotation. All material and workmanship are to be described in the contract documents unless otherwise stated. Contractor shall identify addendum numbers included in the tender quotation when submitting tender / bid form.


- 1.0 **Drawing E0.2 “Panels Schedule”** re-issued herewith.
  - 1.1 Refer to revisions bubbled in red on the revised drawing
- 2.0 **Drawing E0.3 “Single Line Diagram – Demolition”** re-issued herewith.
  - 1.1 The drawing is revised in its entirety
- 3.0 **Drawing E0.4 “Single Line Diagram – New”** re-issued herewith.
  - 1.2 The drawing is revised in its entirety
- 4.0 **Drawing E1.1S “Single Line Diagram – Demolition”** re-issued herewith.
  - 1.3 Demolition scope is revised – refer to the revised drawing
- 5.0 **Drawing E3.1S “Part Ground Floor south Power – New Layout”** not re-issued.
  - 1.4 Pumps tags were added to the drawing

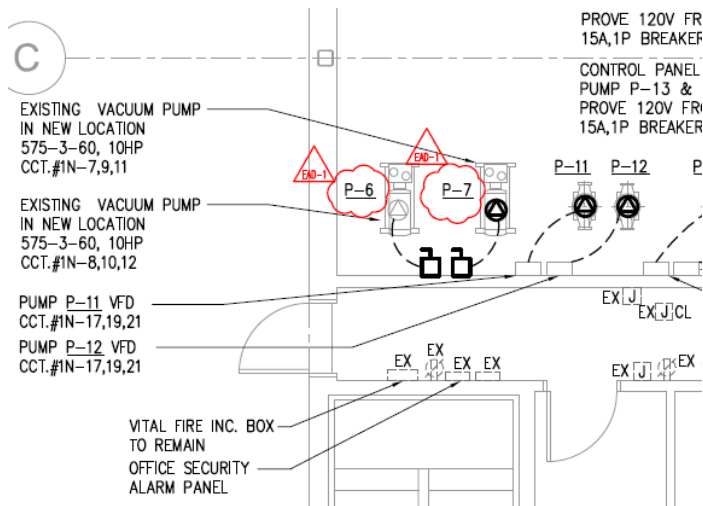




**6.0 Drawing E3.1N “Part Ground Floor North Power – New Layout” not re-issued.**

1.5 Add power to pump P-20 and mechanical controls

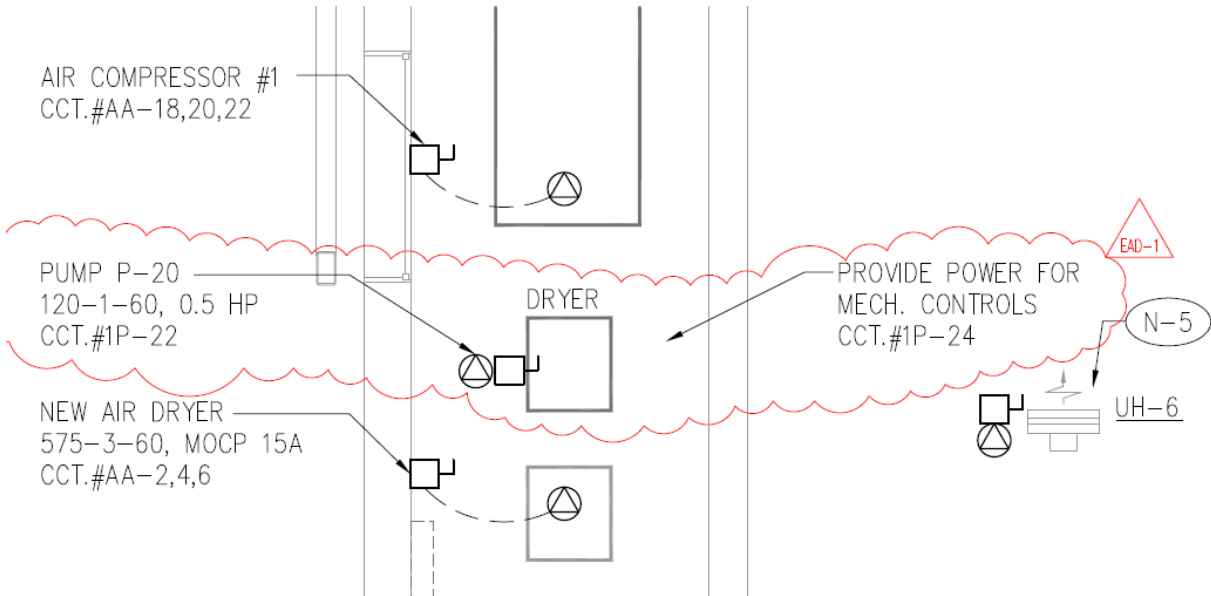

**7.0 Drawing E3.1S “Part Ground Floor south Power – New Layout” not re-issued.**

1.6 Panels and transformer tags were added to the drawing

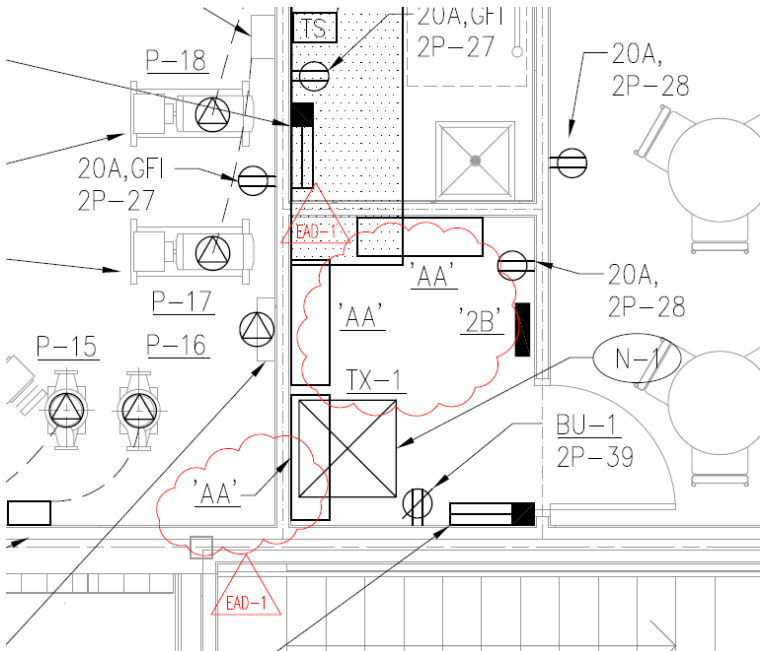

**8.0 Questions / Answers:**

8.1 **Q:** “I reviewed the project documents, and was not able to locate any data drops on the drawings provided in order to provide an accurate Communications quote.  
Will you please submit the following RFI:

*Please provide a Communications Site Plan/Drawing indicating data drops.  
Is there any specified Communications Systems Supplier, as there is a specified Security Systems Supplier, " Vingcard", outlined in Spec document"*

**A:** Communication scope is covered by cash allowance. Exact scope of work will be identified by Accord during construction.

8.2 **Q:** *"Provide clear photos, Manufacturer detail and KA rating for Existing 1600A SWBD in order to retrofit breakers."*

**A:** please refer to the attached photos





PANEL '1N'		TYPE: MAINS: 400 AMPS MOUNTING: RECESSED		BOLT-ON 400 AMPS RECESSED MOUNTED		LOCATION: GROUND FLOOR SOUTH	
LOAD	DESCRIPTION	BREAKER	CIRCUITS	BREAKER	DESCRIPTION	LOAD	
	EXISTING SPLITTER #2	60A	1	2	100A		
		3P	3	4			
		3P	5	6	3P		
10HP	EXISTING VACUUM PUMP P-6	30A	7	8	30A	10HP	
		3P	9	10			
		3P	11	12	3P		
	SPARE	20A	13	14	20A		
	SPARE	15A	15	16	15A		
2x7.5HP	CHILLED WATER RETURN PUMP P-11 & P-12	35A	17	18	35A	2x7.5HP	
		3P	19	20			
		3P	21	22	3P		
	SPACE		23	24			
	SPACE		25	26			
	SPACE		27	28			
	SPACE		29	30			
	SPACE		31	32			
	SPACE		33	34			
	SPACE		35	36			
	SPACE		37	38			
	SPACE		39	40			
	SPACE		41	42			

NOTE:  
TO BE C/W BUILT-IN MOLDED CASE MAIN SWITCH RATED AT 50KA INTERRUPTING CURRENT  
(1) BREAKER WITH ADJUSTABLE TRIP UNIT. SET TO 85A  
(2) BREAKER WITH ADJUSTABLE TRIP UNIT

PANEL 'AA' (TUB #1)		TYPE: MAINS: 800 AMPS SURFACE MOUNTED		BOLT-ON 800 AMPS SURFACE MOUNTED		LOCATION: 2ND FLOOR ELECTRICAL ROOM	
LOAD	DESCRIPTION	BREAKER	CIRCUITS	BREAKER	DESCRIPTION	LOAD	
60HP	ELEVATOR	175A	1	2	15A		
		3P	3	4			
		3P	5	6	3P		
		175A	7	8	20A		
		3P	9	10			
		3P	11	12	3P		
	TRANSFORMER TX-1						
	LIGHTS	20A	13	14	20A	LIGHTS	
	LIGHTS	20A	15	16	20A	LIGHTS	
	CHILLER CH-1	250A	17	18			
		3P	19	20			
		3P	21	22			
2x7.5HP	GLYCOL PUMP P-15 & P-16	35A	23	24	40A		
		3P	25	26			
			27	28	3P		
	SPACE		29	30	100A		
	SPACE		31	32			
	SPACE		33	34	3P		
	LIGHTS	20A	35	36	20A	LIGHTS	
	SPACE		37	38			
	SPACE		39	40			
	SPACE		41	42			
	SPACE		43	44			
	SPACE		45	46			
	SPACE		47	48			
	SPACE		49	50			
	SPACE		51	52			
	SPACE		53	54			
	SPACE		55	56			
	SPACE		57	58			
	SPACE		59	60			

NOTE:  
TO BE C/W BUILT-IN MOLDED CASE MAIN SWITCH RATED AT 50KA INTERRUPTING CURRENT  
(1) BREAKER WITH ADJUSTABLE TRIP UNIT. SET TO 175A  
(2) BREAKER WITH ADJUSTABLE TRIP UNIT.

PANEL 'AA' (TUB #2)		TYPE: MAINS: 800 AMPS SURFACE MOUNTED		BOLT-ON 800 AMPS SURFACE MOUNTED		LOCATION: 2ND FLOOR ELECTRICAL ROOM	
LOAD	DESCRIPTION	BREAKER	CIRCUITS	BREAKER	DESCRIPTION	LOAD	
	EXTRUDER LINE #1	100A	61	62	100A	EXTRUDER LINE #2	
		63	64				
		3P	65	66	3P		
		30A	67	68	30A		
		3P	69	70			
		3P	71	72	3P		
		30A	73	74	30A		
		3P	75	76			
		3P	77	78	3P		
		30A	79	80	30A		
		3P	81	82			
		3P	83	84	3P		
		30A	85	86	30A		
		3P	87	88			
		3P	89	90	3P		
		200A	91	92	200A		
		3P	93	94			
		3P	95	96	3P		
		30A	97	98	30A		
		3P	99	100			
		30A	101	102	3P		
		30A	103	104	30A		
		3P	105	106			
		3P	107	108	3P		
		30A	109	110	30A		
		3P	111	112			
		3P	113	114	3P		
		30A	115	116	30A		
		3P	117	118			
		3P	119	120	3P		

NOTE:  
BREAKER WILL BE PROVIDED BY ACCORD TEAM OUTSIDE OF THIS PROJECT. BREAKER SIZES ARE SHOWN FOR REFERENCE ONLY TO ALLOW FOR ADEQUATE SPACE IN THE PANEL.





PANEL '2P'		TYPE: MAINS: 225 AMPS RECESSED MOUNTED		BOLT-ON 225 AMPS RECESSED MOUNTED		LOCATION: 2ND FLOOR CORRIDOR	
LOAD	DESCRIPTION	BREAKER	CIRCUITS	BREAKER	DESCRIPTION	LOAD	
	UNIT HEATERS UH-2, UH-4, UH-5	15A	1	2	15A	UNIT HEATERS UH-1 & UH-3	
		3P	3	4	30A		
2.0KW	BASEBOARD HEATERS	15A	5	6	2P	BASEBOARD HEATERS	4.5KW
	SPACE		7	8	15A		
	LIGHTS	20A	9	10	2P	BASEBOARD HEATER	1.5KW
	MOTORIZED DAMPERS	15A	11	12	15A	MECHANICAL CONTROLS	
	LIGHTS	20A	13	14	20A	LIGHTS	
	WC EXHAUST FAN EF-1 & EF-2	15A	15	16	15A	DOOR OPERATOR	
720	BATTERY UNIT BU-2 & BU-3	15A	17	18	15A	BATTERY UNIT BU-4 & BU-5	720
		15A	19	20	15A	ELEC. ROOM EXHAUST FAN EF-8	1/4HP
1.4KW	HAND DRYER (UNIV. WASHROOM)	20A	21	22	20A	HAND DRYER (WASHROOM)	1.4KW
	FRIDGE, LUNCH ROOM	15A	23	24	20A	COUNTER RECEPTACLE, LUNCH ROOM	
	MICROWAVE, LUNCH ROOM	20A	25	26	20A	COUNTER RECEPTACLE, LUNCH ROOM	
	CONVENIENCE RECEPTACLE	20A	27	28	20A	CONVENIENCE RECEPTACLE	
1HP	GENERAL EXHAUST FAN EF-4	25A	29	30	25A	GENERAL EXHAUST FAN EF-6	1HP
1HP	GENERAL EXHAUST FAN EF-5	25A	31	32	25A	GENERAL EXHAUST FAN EF-7	1HP
1.5KW	DHW-1	20A	33	34	20A	OUTDOOR RECEPTACLE ON ROOF	
1.0KW	BASEBOARD HEATERS	15A	35	36	15A	ELEC. UNIT HEATER	1.5KW
		2P	37	38	2P		
720	BATTERY UNIT BU-1	15A	39	40	15A	EXIT SIGNS	
	CONTROL PANEL FOR P-17 & P-18	15A	41	42	15A	CONTROL PANEL FOR P-15 & P-16	
	INFRARED HEATER IRH-1 & IRH-2	15A	43	44	15A	INFRARED HEATER IRH-3	
			45	46			
			47	48			
			49	50			
			51	52			
			53	54			
			55	56			
			57	58			
			59	60			


NOTE:  
TO BE C/W BUILT-IN MOLDED CASE MAIN SWITCH RATED AT 50KA INTERRUPTING CURRENT

PANEL 'AA' (TUB #3)		TYPE: MAINS: 800 AMPS SURFACE MOUNTED		BOLT-ON 800 AMPS SURFACE MOUNTED		LOCATION: 2ND FLOOR ELECTRICAL ROOM	
LOAD	DESCRIPTION	BREAKER	CIRCUITS	BREAKER	DESCRIPTION	LOAD	
	EXTRUDER LINE #5	100A	121	122	100A	EXTRUDER LINE #6	
		3P	123	124			
		30A	125	126	3P		
		30A	127	128	30A		
		3P	129	130			
		30A	131	132	3P		
		30A	133	134	30A		
		3P	135	136			
		3P	137	138	3P		
		30A	139	140	30A		
		3P	141	142			
		3P	143	144	3P		
		30A	145	146	30A		
		3P	147	148			
		3P	149	150	3P		
		200A	151	152	200A		
		3P	153	154			
		3P	155	156	3P		
		30A	157	158	30A		
		3P	159	160			
		3P	161	162	3P		
		30A	163	164	30A		
		3P	165	166			
		3P	167	168	3P		
		30A	169	170	30A		
		3P	171	172			
		3P	173	174	3P		
		30A	175	176	30A		
		3P	177	178			
		3P	179	180	3P		

NOTE:  
BREAKER WILL BE PROVIDED BY ACCORD TEAM OUTSIDE OF THIS PROJECT. BREAKER SIZES ARE SHOWN FOR REFERENCE ONLY TO ALLOW FOR ADEQUATE SPACE IN THE PANEL.

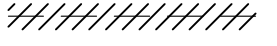PANEL '2B'		TYPE: MAINS: 600 AMPS SURFACE MOUNTED		BOLT-ON 600 AMPS SURFACE MOUNTED		LOCATION: 2ND FLOOR ELECTRICAL ROOM	
LOAD	DESCRIPTION	BREAKER	CIRCUITS	BREAKER	DESCRIPTION	LOAD	
	EXTRUDER LINE #1	15A	1	2	15A	EXTRUDER LINE #2	
		15A	3	4	15A	EXTRUDER LINE #2	
		20A	5	6	20A	EXTRUDER LINE #2	
		15A	7	8	15A	EXTRUDER LINE #2	
		20A	9	10	20A		
		3P	11	12			
		3P	13	14	3P		
		15A	15	16	15A	EXTRUDER LINE #4	
		15A	17	18	15A	EXTRUDER LINE #4	
		20A	19	20	20A	EXTRUDER LINE #4	
		15A	21	22	15A	EXTRUDER LINE #4	
		20A	23	24	20A		
		3P	25	26			
		3P	27	28	3P		
		15A	29	30	15A	EXTRUDER LINE #6	
		15A	31	32	15A	EXTRUDER LINE #6	
		20A	33	34	20A	EXTRUDER LINE #6	
		15A	35	36	15A	EXTRUDER LINE #6	
		20A	37	38	20A		
		3P	39	40			
		3P	41	42	3P		
		15A	43	44	15A	EXTRUDER LINE #8	
		15A	45	46	15A	EXTRUDER LINE #8	
		20A	47	48	20A	EXTRUDER LINE #8	
		15A	49	50	15A	EXTRUDER LINE #8	
		20A	51	52	20A		
		3P	53	54			
		3P	55	56	3P		
		57	58	60A			

LEGEND:	
	DENOTES: WIRING AND CONDUIT TO BE REMOVED
	DENOTES: EXISTING ELECTRICAL DEVICE TO BE REMOVED
	HIDDEN SHADED LINE DENOTES: EXISTING SERVICE
	SOLID LINE DENOTES: NEW SERVICE

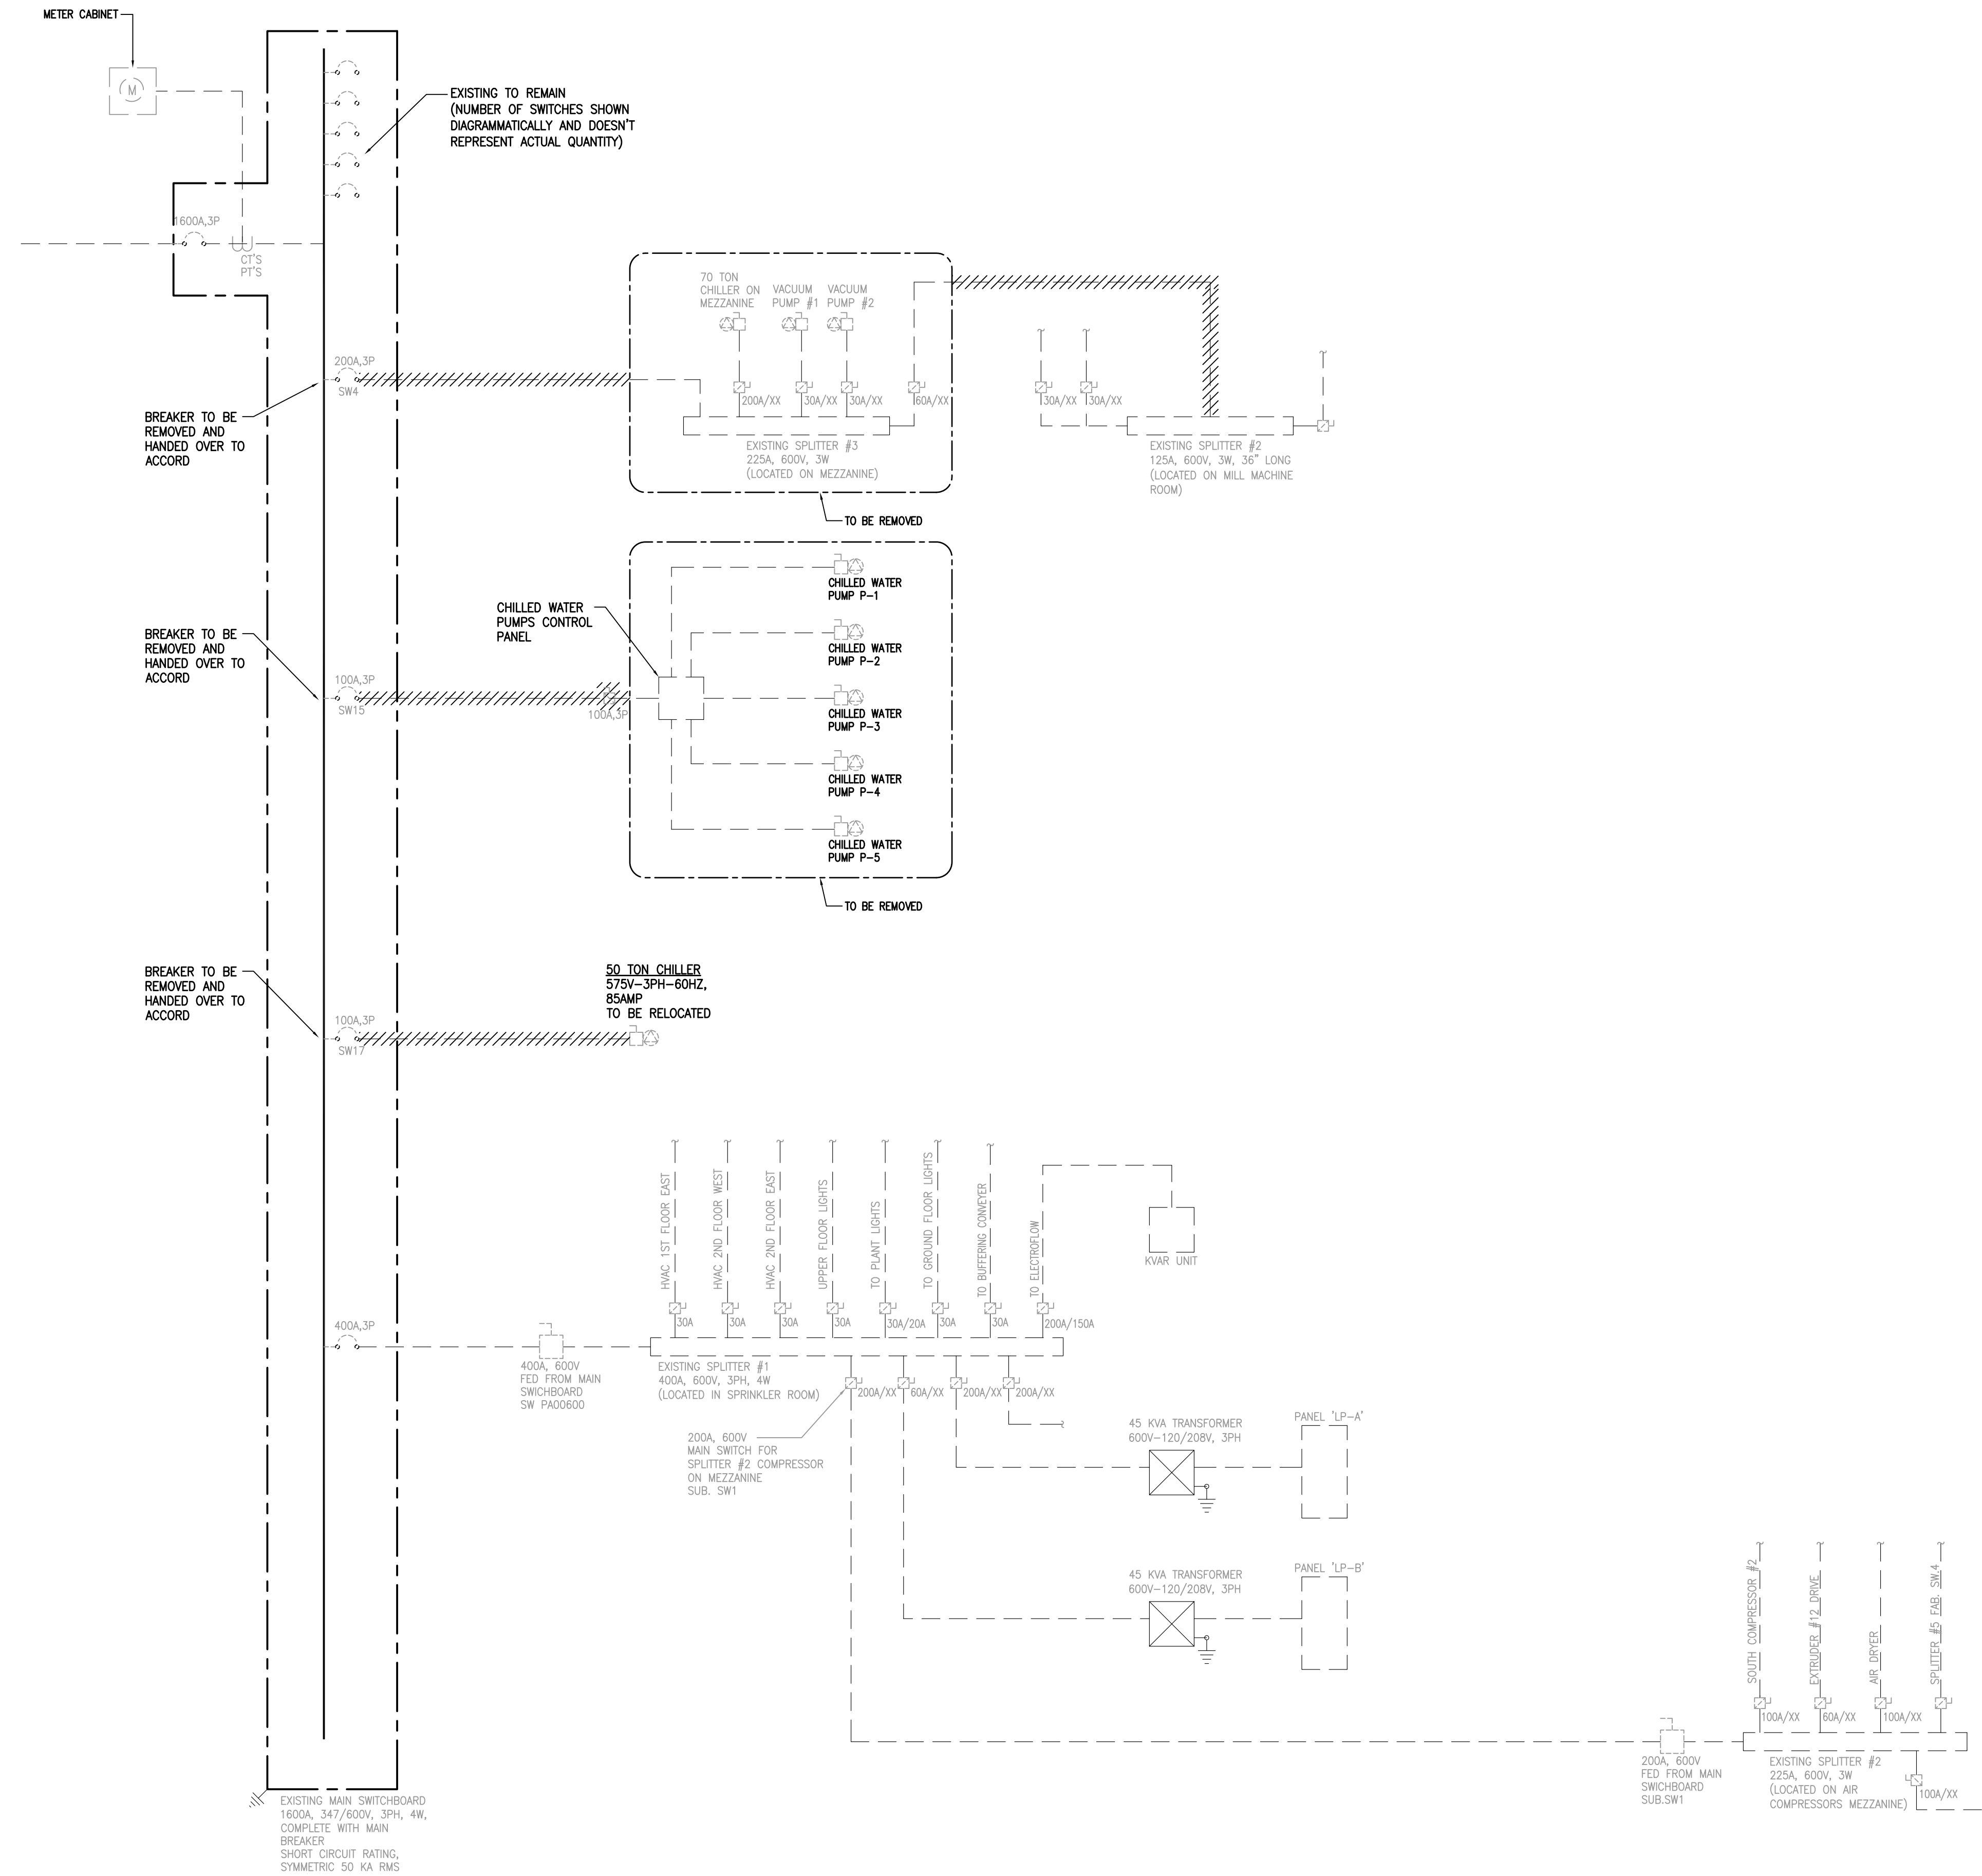

Rev	Description	Date
1	Schematic Design	09/06/2023
2	Issued for 75% Progress	17/11/2023
3	Issued for Permit	16/02/2024
4	Issued for Tender	04/03/2024
5	Issued for Addendum #3 (EAD-1)	05/04/2024

SHARMA & PARTNERS INC.  
**Mechanical and Electrical Engineers**  
 85 Carlaw Drive,  
 Unit 108  
 Toronto, Ontario  
 M5A 2P8  
 Tel: (416) 291-8822



SPH PROJECT # 2023-1010

# WORKSHOP architecture

WORKSHOP architecture Inc  
 6 Sousa Mendes St  
 Toronto Ontario M6P 0A8  
 T 416.901.8055 F 416.849.0383  
 www.workshoparchitecture.ca


Accord Vaughan

56 Edlican Drive, Concord, ON

PROJECT CODE:	SCALE:
22_31	N.T.S.
DATE:	STATUS:
April 5, 2024	<b>Addendum #3</b>


Single Line Diagram  
 Demolition

DRAWING IS RE-ISSUED FOR ADDENDUM #3 (EAD-1)

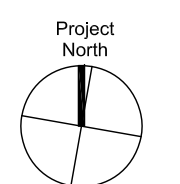

drawing number  
**E03**

Rev	Description	Date
1	Schematic Design	09/06/2023
2	Issued for 75% Progress	17/11/2023
3	Issued for Permit	16/02/2024
4	Issued for Tender	04/03/2024
5	Issued for Addendum #3 (EAD-1)	05/04/2024

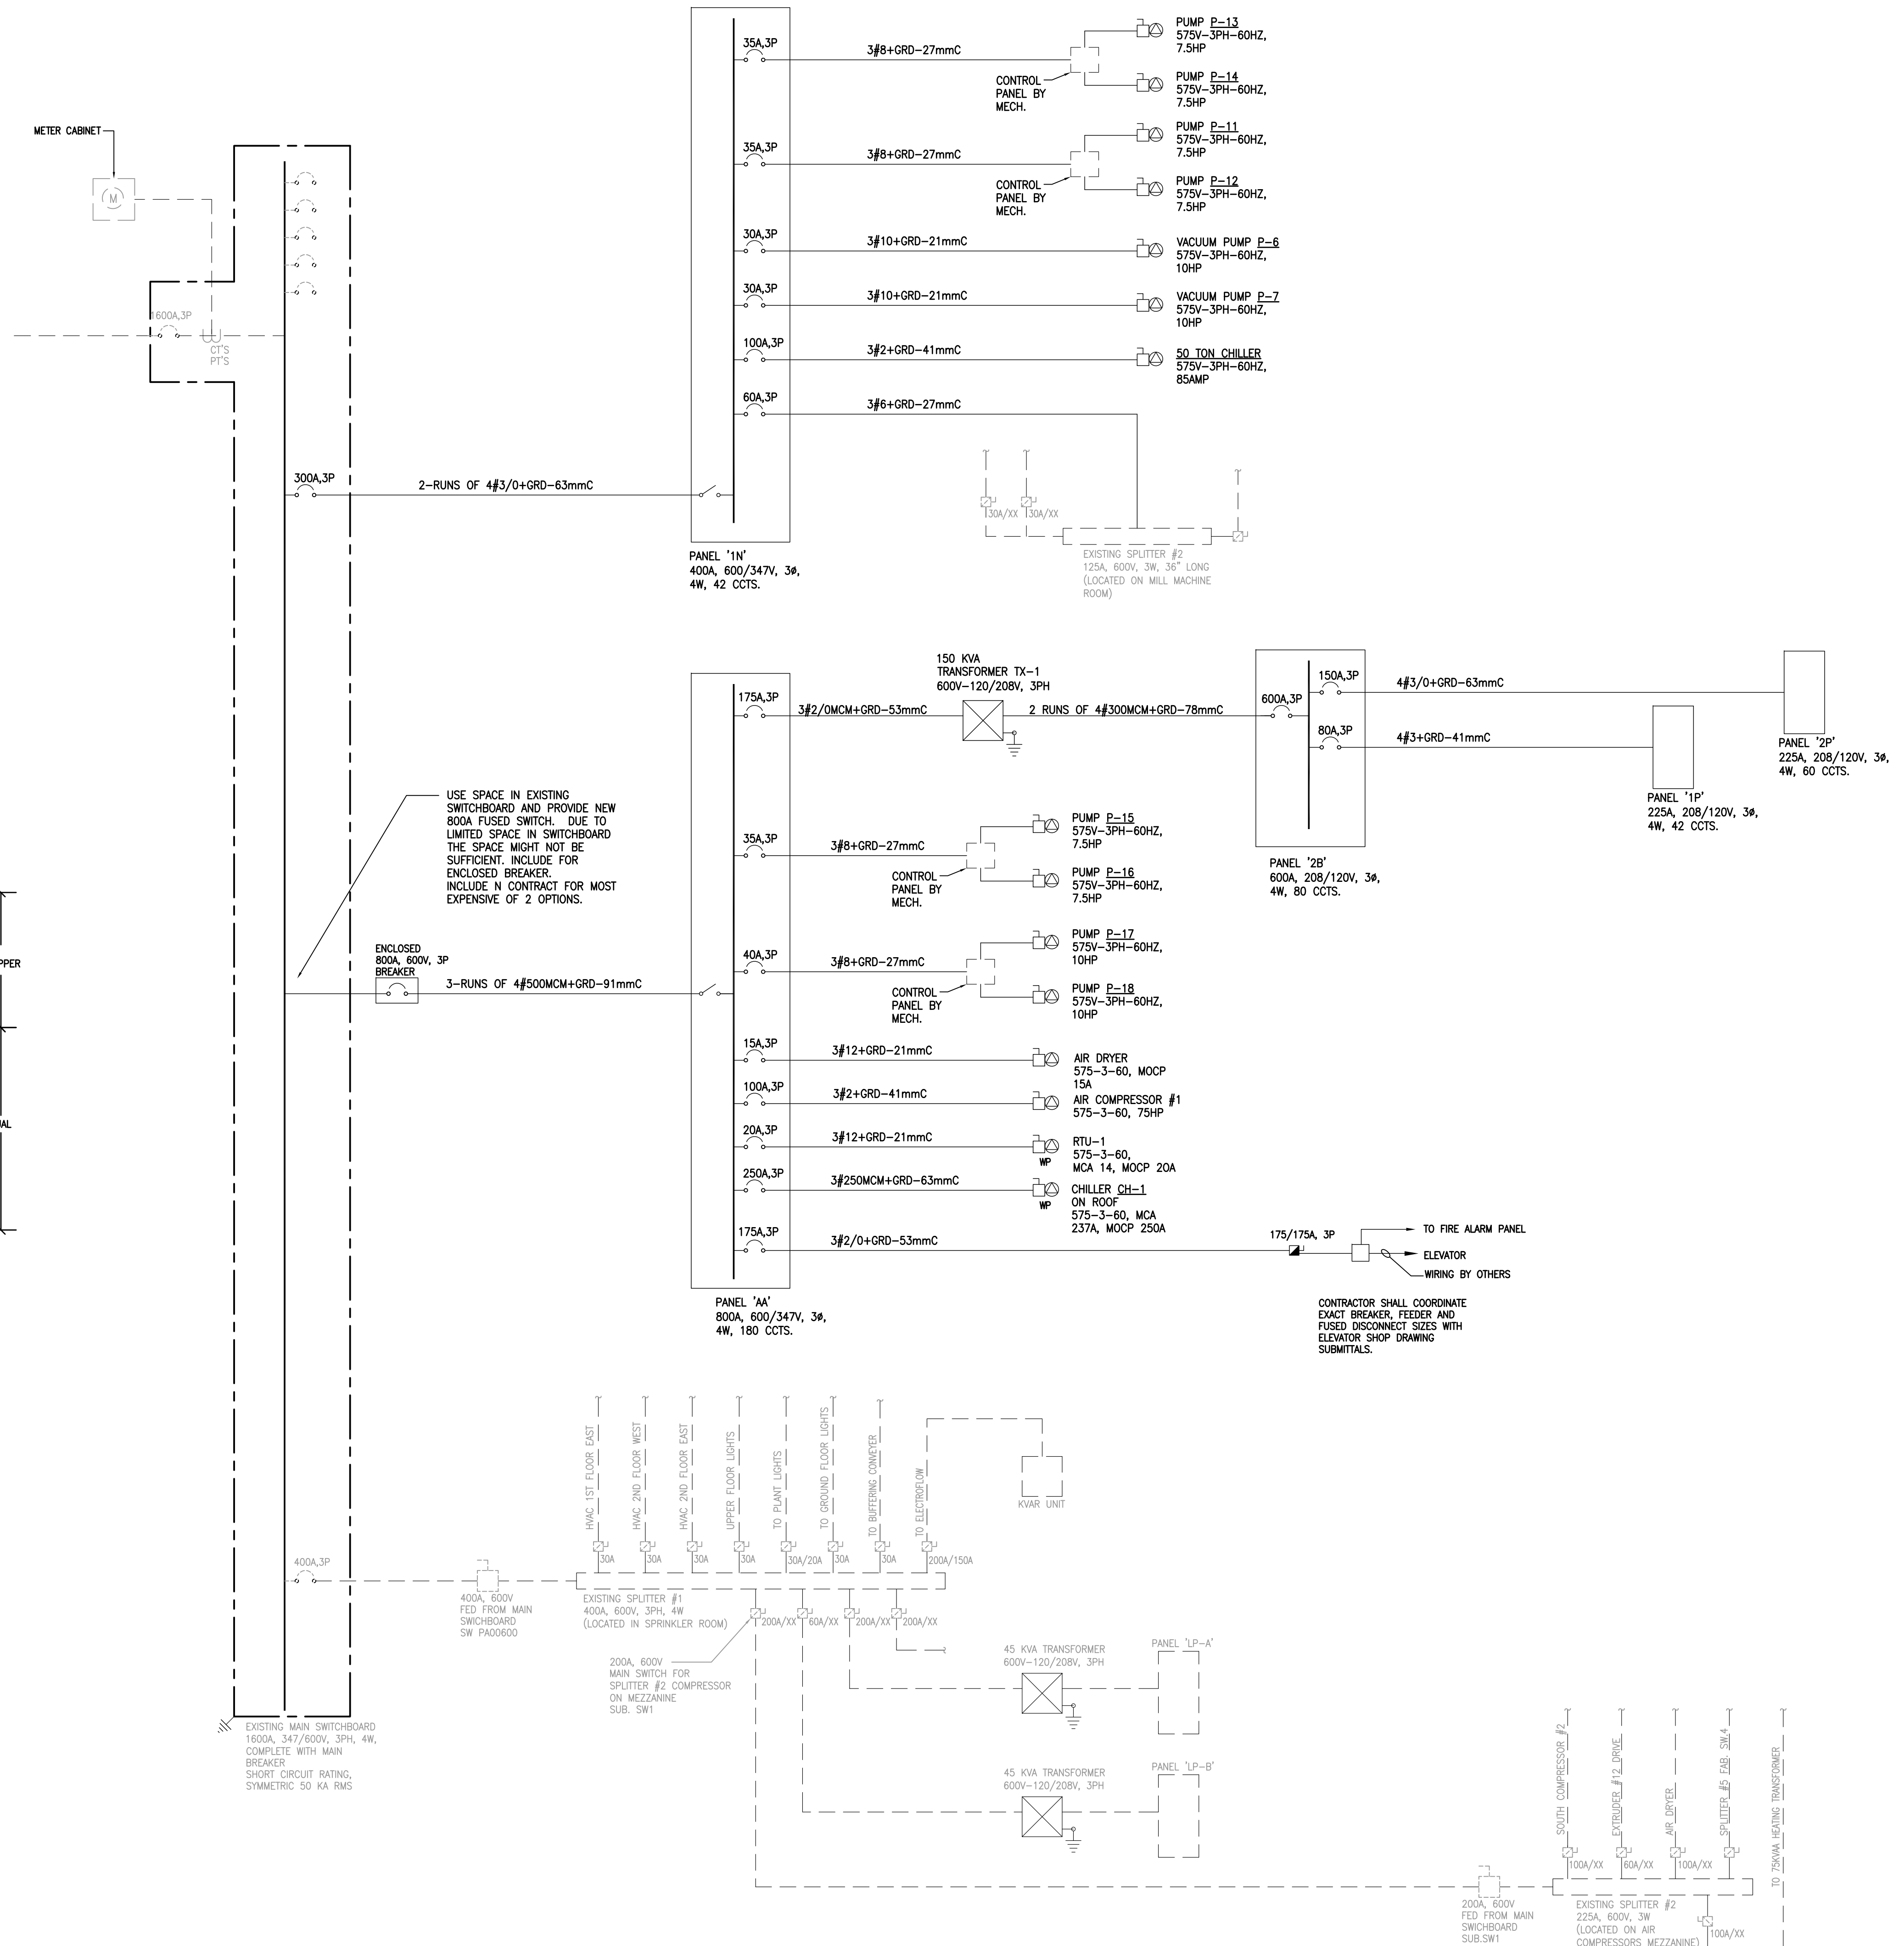

CABLE SIZES ON THIS DRAWING IS PROVIDED FOR COPPER. UNLESS SHOWN OTHERWISE, CABLES & CONDUIT TABLE BELOW TO BE USED

PRE-FIX NO. OF CONDUCTORS	CABLE & CONDUIT TABLE					
	MAX BREAKER SIZE	WIRE SIZE	AMP RATING @75°C	CONDUIT SIZE		
				4 CONDUCTORS	3 CONDUCTORS	2 CONDUCTORS
15	#12	25	21 (3/4")	21 (3/4")	21 (3/4")	COPPER
20	#12	25	21 (3/4")	21 (3/4")	21 (3/4")	
30	#10	35	27 (1")	21 (3/4")	21 (3/4")	
50	#8	50	27 (1")	27 (1")	21 (3/4")	
60	#8	65	35 (1 1/4")	35 (1 1/4")	27 (1")	
80	#4	85	41 (1 1/2")	35 (1 1/4")	35 (1 1/4")	
100	#1	100	41 (1 1/2")	35 (1 1/4")	35 (1 1/4")	
125	#2/0	130	53 (2")	53 (2")	-	
150	#3/0	150	53 (2")	53 (2")	-	
200	250MCM	200	78 (3")	63 (2 1/2")	-	
225	300MCM	230	78 (3")	63 (2 1/2")	-	
250	350MCM	255	78 (3")	78 (3")	-	
300	500MCM	310	103 (4")	91 (3 1/2")	-	
350	750MCM	380	103 (4")	103 (4")	-	
400	1000MCM	420	103 (4")	103 (4")	-	

NOTES:

- CABLE SHALL BE 90°C TYPE WITH 75°C AMPACITY TO SUIT BREAKER TERMINATION CHARACTERISTIC.
- FEEDER SHALL BE PROVIDED WITH BONDING CONDUCTOR AS PER CODE.
- PARALLEL RUNS, BONDING CONDUCTOR IS REQUIRED IN EACH CONDUIT RUN.
- RUN PARALLEL FEEDERS FOR RATING OVER 400A.
- CABLE SIZE FOR PARALLEL RUN TO BE #1/0.
- DO NOT USE THIS SCHEDULE FOR UNDERGROUND CABLE. SIZE UNDERGROUND CABLE AS PER OESC.
- USE THIS COLUMN FOR CIRCUIT WITH CURRENT CARRYING NEUTRAL/S. APPLY 0.8 CORRECTION FACTOR FROM TABLE 5C FOR 90°C AMPACITY.
- BOTH 75°C AND CORRECTED 90°C (IF APPLY) CABLE AMPACITY MUST BE GREATER THAN THE BREAKER SIZE. UP-SIZE CABLE AS REQUIRED TO SUIT VOLTAGE DROP.

SHARMA & PARTNERS INC.  
**Mechanical and Electrical Engineers**  
 85 Carlaw Drive,  
 Unit 108  
 Toronto, Ontario  
 M5A 2P8  
 Tel: (416) 291-8822

SPR PROJECT # 2023-1010

# WORKSHOP architecture

WORKSHOP architecture Inc  
 6 Sousa Mendes St  
 Toronto Ontario M5P 0A8  
 T 416.901.8055 F 416.849.0383  
 www.workshoparchitecture.ca

Accord Vaughan

56 Edlican Drive, Concord, ON

PROJECT CODE: 22\_31  
 SCALE: N.T.S.  
 DATE: April 5, 2024  
 STATUS: Addendum #3


Single Line Diagram  
 New

Project North

drawing number **E0.4**

DRAWING IS RE-ISSUED FOR ADDENDUM #3 (EAD-1)

Rev	Description	Date
1	Schematic Design	09/06/2023
2	Issued for 75% Progress	17/11/2023
3	Issued for Permit	16/02/2024
4	Issued for Tender	04/03/2024
5	Issued for Addendum #3 (EAD-1)	05/04/2024

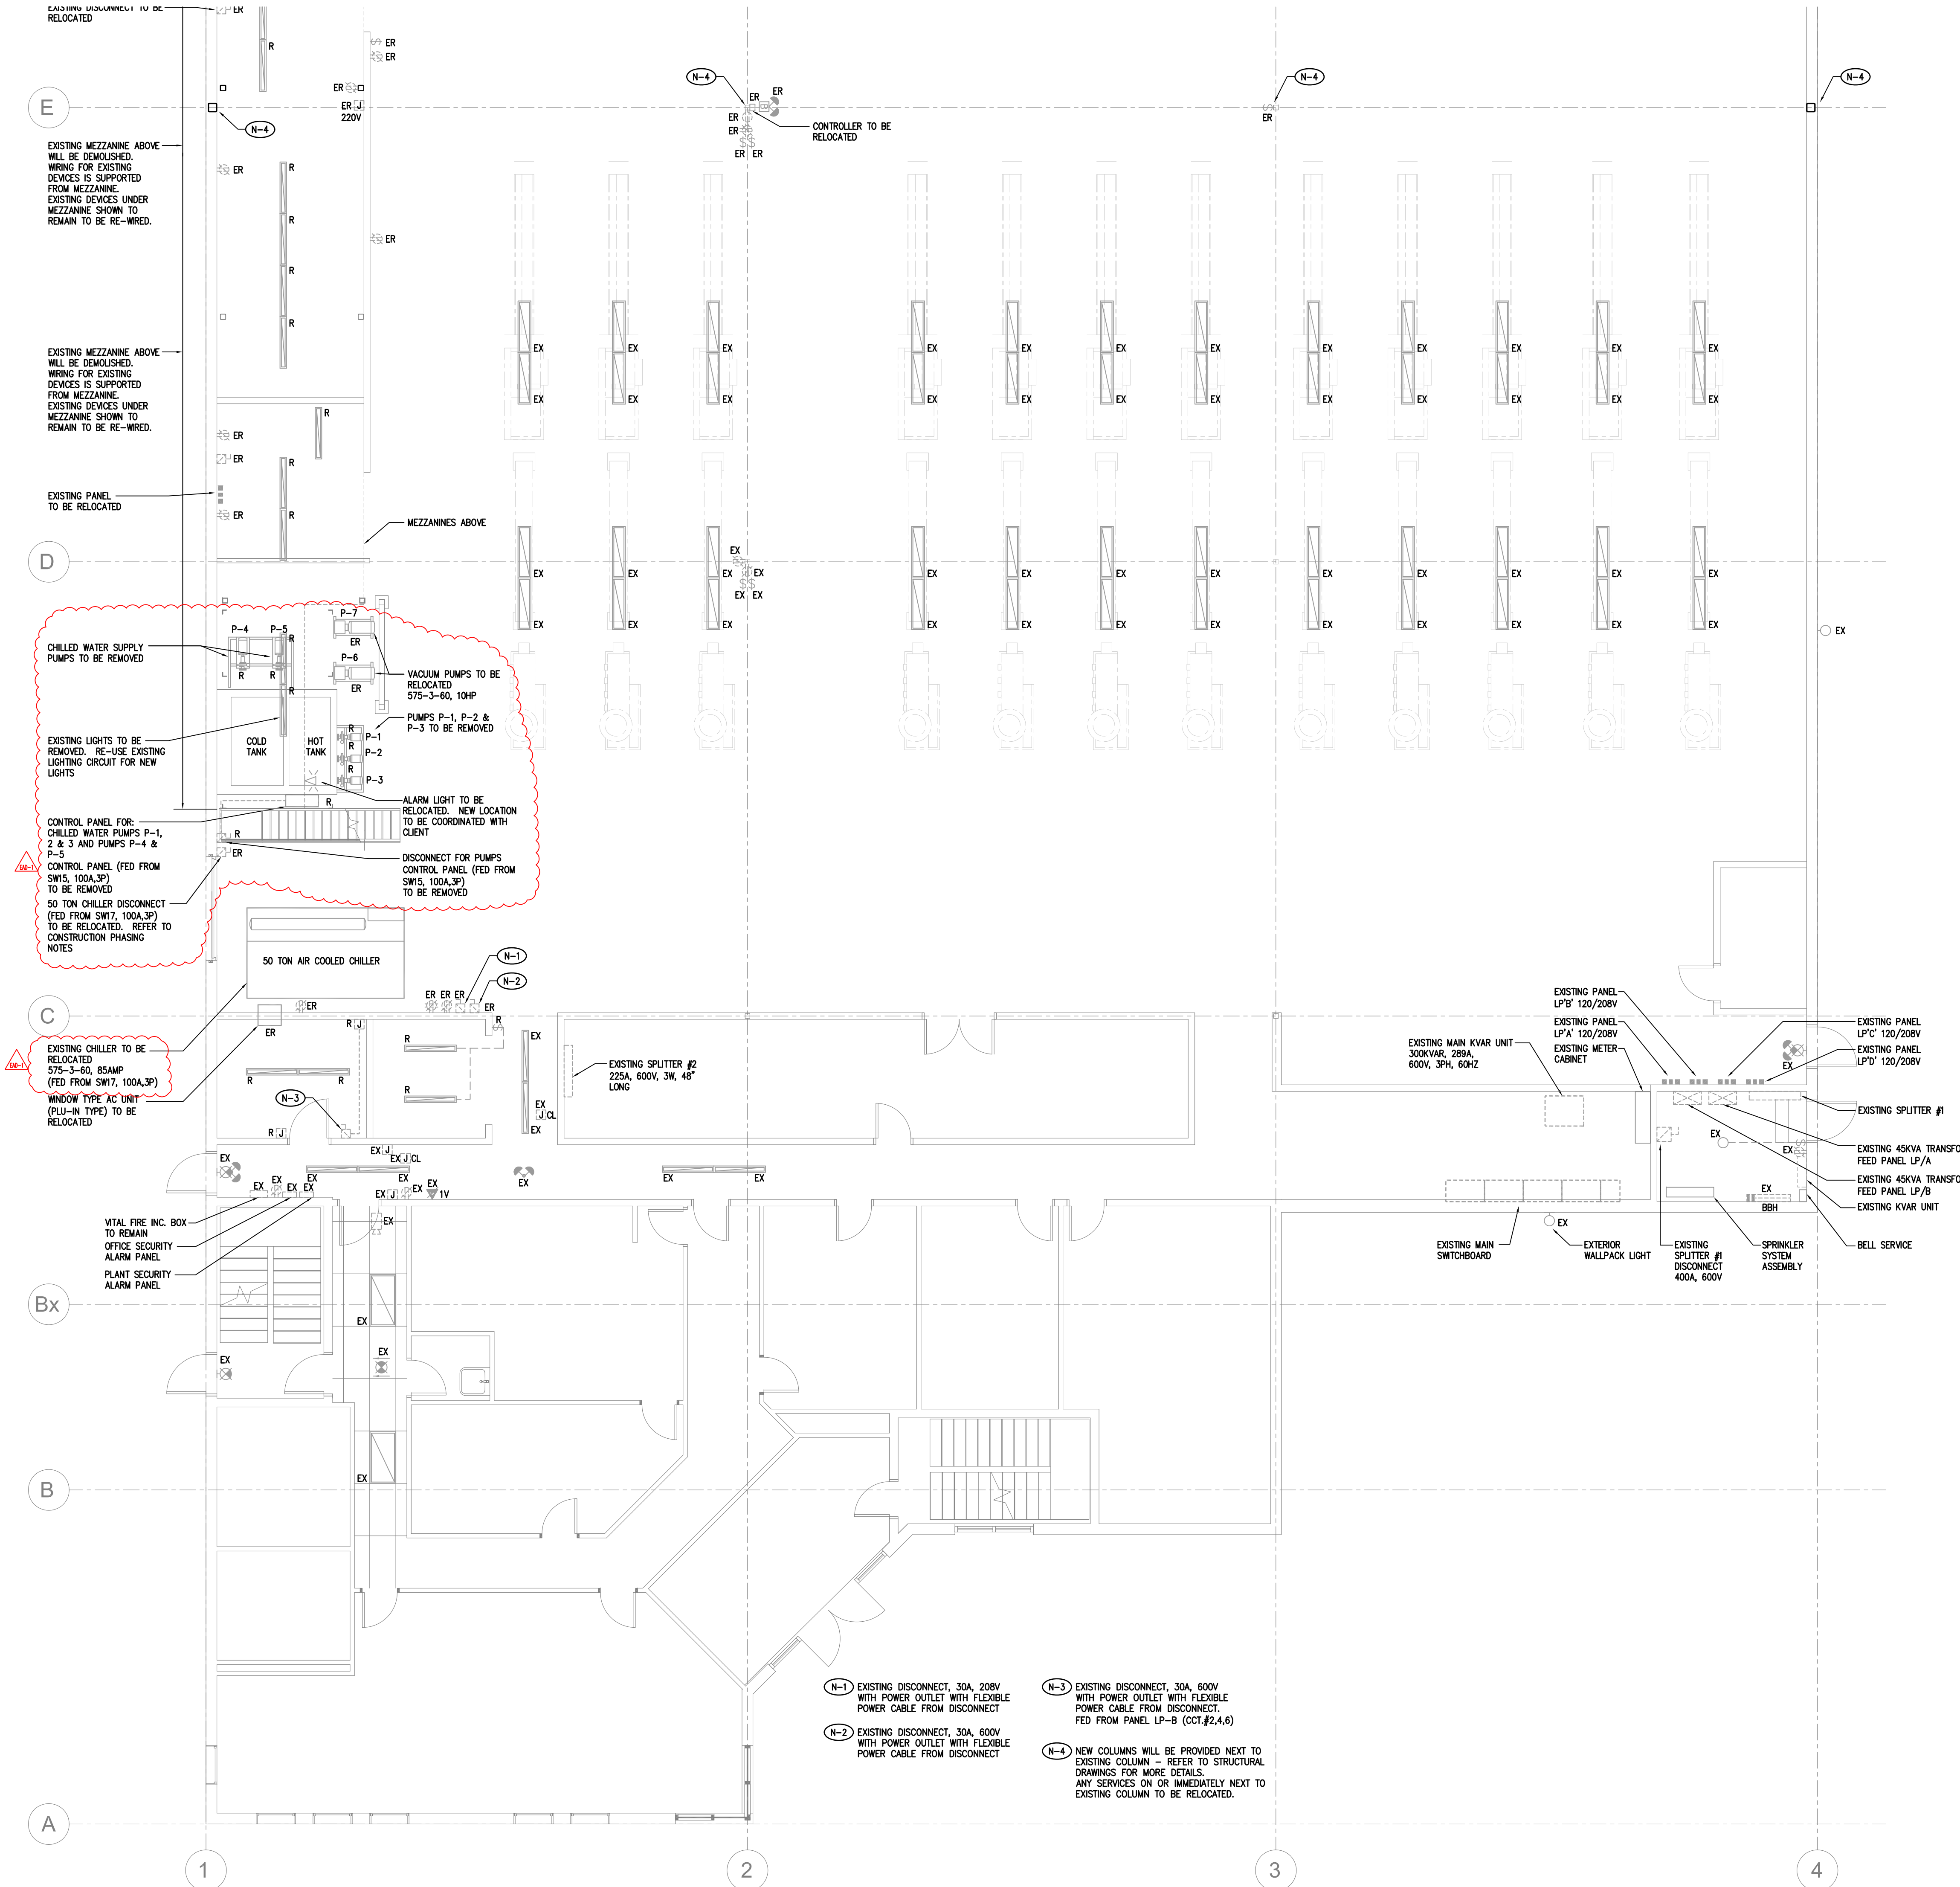

EXISTING MEZZANINE ABOVE WILL BE DEMOLISHED. WIRING FOR EXISTING DEVICES IS SUPPORTED FROM MEZZANINE. EXISTING DEVICES UNDER MEZZANINE SHOWN TO REMAIN TO BE RE-WRED.

EXISTING MEZZANINE ABOVE WILL BE DEMOLISHED. WIRING FOR EXISTING DEVICES IS SUPPORTED FROM MEZZANINE. EXISTING DEVICES UNDER MEZZANINE SHOWN TO REMAIN TO BE RE-WRED.

EXISTING PANEL TO BE RELOCATED

CHILLED WATER SUPPLY PUMPS TO BE REMOVED

EXISTING LIGHTS TO BE REMOVED. RE-USE EXISTING LIGHTING CIRCUIT FOR NEW LIGHTS

CONTROL PANEL FOR CHILLED WATER PUMPS P-1, 2 & 3 AND PUMPS P-4 & P-5 TO BE REMOVED

CONTROL PANEL (FED FROM SW15, 100A, 3P) TO BE REMOVED

50 TON CHILLER DISCONNECT (FED FROM SW17, 100A, 3P) TO BE RELOCATED. REFER TO CONSTRUCTION PHASING NOTES

VACUUM PUMPS TO BE RELOCATED 575-3-60, 10HP

PUMPS P-1, P-2 & P-3 TO BE REMOVED

ALARM LIGHT TO BE RELOCATED. NEW LOCATION TO BE COORDINATED WITH CLIENT

DISCONNECT FOR PUMPS CONTROL PANEL (FED FROM SW15, 100A, 3P) TO BE REMOVED

EXISTING CHILLER TO BE RELOCATED 575-3-60, 85AMP (FED FROM SW17, 100A, 3P)

WINDOW TYPE AC UNIT (PLI-IN TYPE) TO BE RELOCATED

VITAL FIRE INC. BOX TO REMAIN

OFFICE SECURITY ALARM PANEL

PLANT SECURITY ALARM PANEL

- (N-1) EXISTING DISCONNECT, 30A, 208V WITH POWER OUTLET WITH FLEXIBLE POWER CABLE FROM DISCONNECT
- (N-2) EXISTING DISCONNECT, 30A, 600V WITH POWER OUTLET WITH FLEXIBLE POWER CABLE FROM DISCONNECT
- (N-3) EXISTING DISCONNECT, 30A, 600V WITH POWER OUTLET WITH FLEXIBLE POWER CABLE FROM DISCONNECT, FED FROM PANEL LP-B (CCT #2,4,6)
- (N-4) NEW COLUMNS WILL BE PROVIDED NEXT TO EXISTING COLUMN - REFER TO STRUCTURAL DRAWINGS FOR MORE DETAILS. ANY SERVICES ON OR IMMEDIATELY NEXT TO EXISTING COLUMN TO BE RELOCATED.

SHARMA & PARTNERS INC.  
 Mechanical and Electrical Engineers  
 85 Colborne Drive,  
 Unit 108  
 Toronto, Ontario  
 M5S 2P8  
 Tel: (416) 291-8822



SRH PROJECT # 2023-1010

# WORKSHOP architecture

WORKSHOP architecture inc  
 6 Sousa Mendes St  
 Toronto Ontario M5P 0A8  
 T 416.901.8055 F 416.849.0383  
 www.workshoparchitecture.ca

Accord Vaughan  
 56 Edlican Drive, Concord, ON

PROJECT CODE:	SCALE:
22_31	1:75
DATE:	STATUS:
April 5, 2024	Addendum #3

## Part Ground Floor South Electrical Demolition

Architect in Charge:  
Workshop Architecture Inc.

Mechanical Addendum

MAD-2 (Addendum #3)

Issue Date:

April 5, 2024

Project: **Accord Vaughan, 56 Edilcan Drive, Concord**

Project Number:

2023-1010

---

The following items are changes to the tender contract documents for this project. Contractor shall include the cost of these addendum items in the tender quotation. All material and workmanship are to be described in the contract documents unless otherwise stated. Contractor shall identify addendum numbers included in the tender quotation when submitting tender / bid form.

---

**Question 1:**

*“On drawing M0.4 it’s shown filtration tank 600x600x600 and Blue Media Filter. Please let me know if this tank is precast and provide more details or spec about filter.”*

**Answer:**

Tank shall be 316 Stainless Steel , 18 gauge, 600x600x700 deep with folded top open edges, 2-50mm wide vertical filter track channels on opposite sides for Blue Media filter and back up extruded SS Steel frame holder for removable filters.

**Question 2:**

*“In spec all chilled water piping is black steel sch 40 but on drawing M0.4 piping which is going to owner supplied water tanks it’s written this piping is CPVC. Please clarify from which point black steel becomes CPVC.”*

**Answer:**

Chilled water piping between roof chiller and main heat exchanger glycol loop/ primary pumps, valves etc. shall be metallic ( Black Iron Sch.40).

All other chilled water piping in secondary loops to and from open tanks and hot side of heat exchanger will be CPVC Sch 80.

**1. Drawing M0.2 “Mechanical Equipment Schedules” not re-issued**

1.1 Pump schedule: pump P-20 is added. Pump to be Armstrong S55 or approved equal, circulator, 120V, 1ph, 60Hz, 0.5HP, 40 gpm, 20ft head, with speed controller at pump for balancing.


**2. Drawing M0.5 “Sprinkler and Compressed Air Diagrams” re-issued herewith.**

1.2 Diagram on detail 2 is revised.


1.3 All revisions shown on diagram are revised on floor plan. Floor plan is not issued in this addendum



**NOTES:**  
SPRINKLER SYSTEM IS MONITORED BY SECURITY COMPANY (EXECUTIVE ALARMS). NEW DEVICES AND ZONES TO BE MONITORED BY SECURITY COMPANY. THIS CONTRACTOR TO COORDINATE WITH EXECUTIVE ALARMS AS REQUIRED.

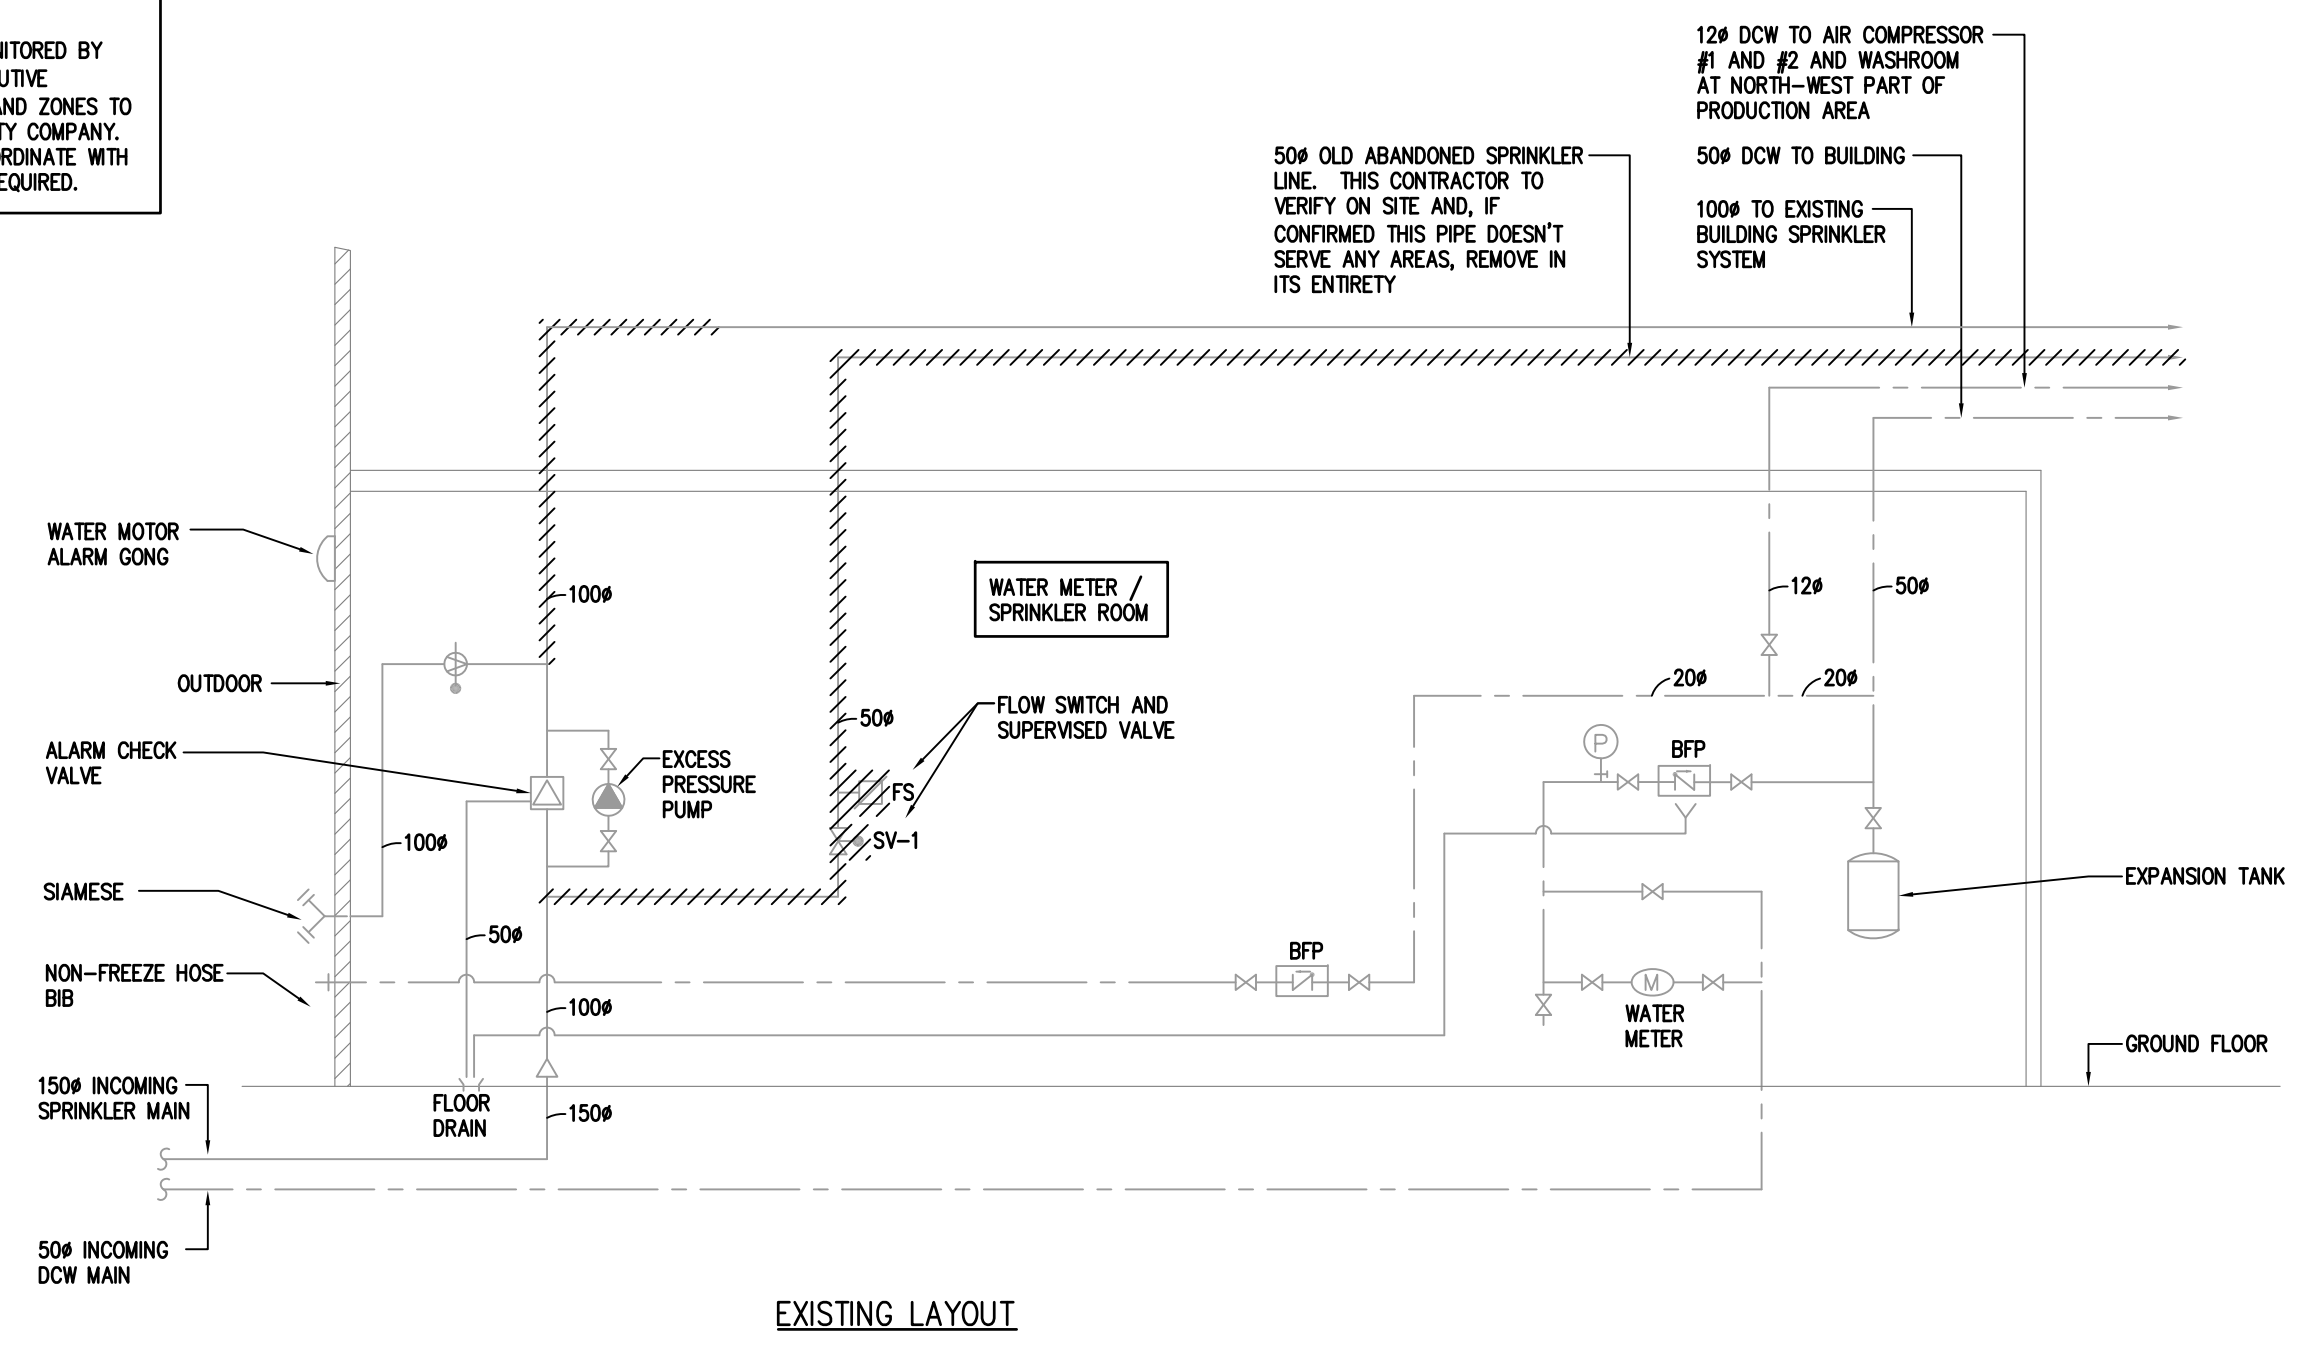

EXISTING LAYOUT

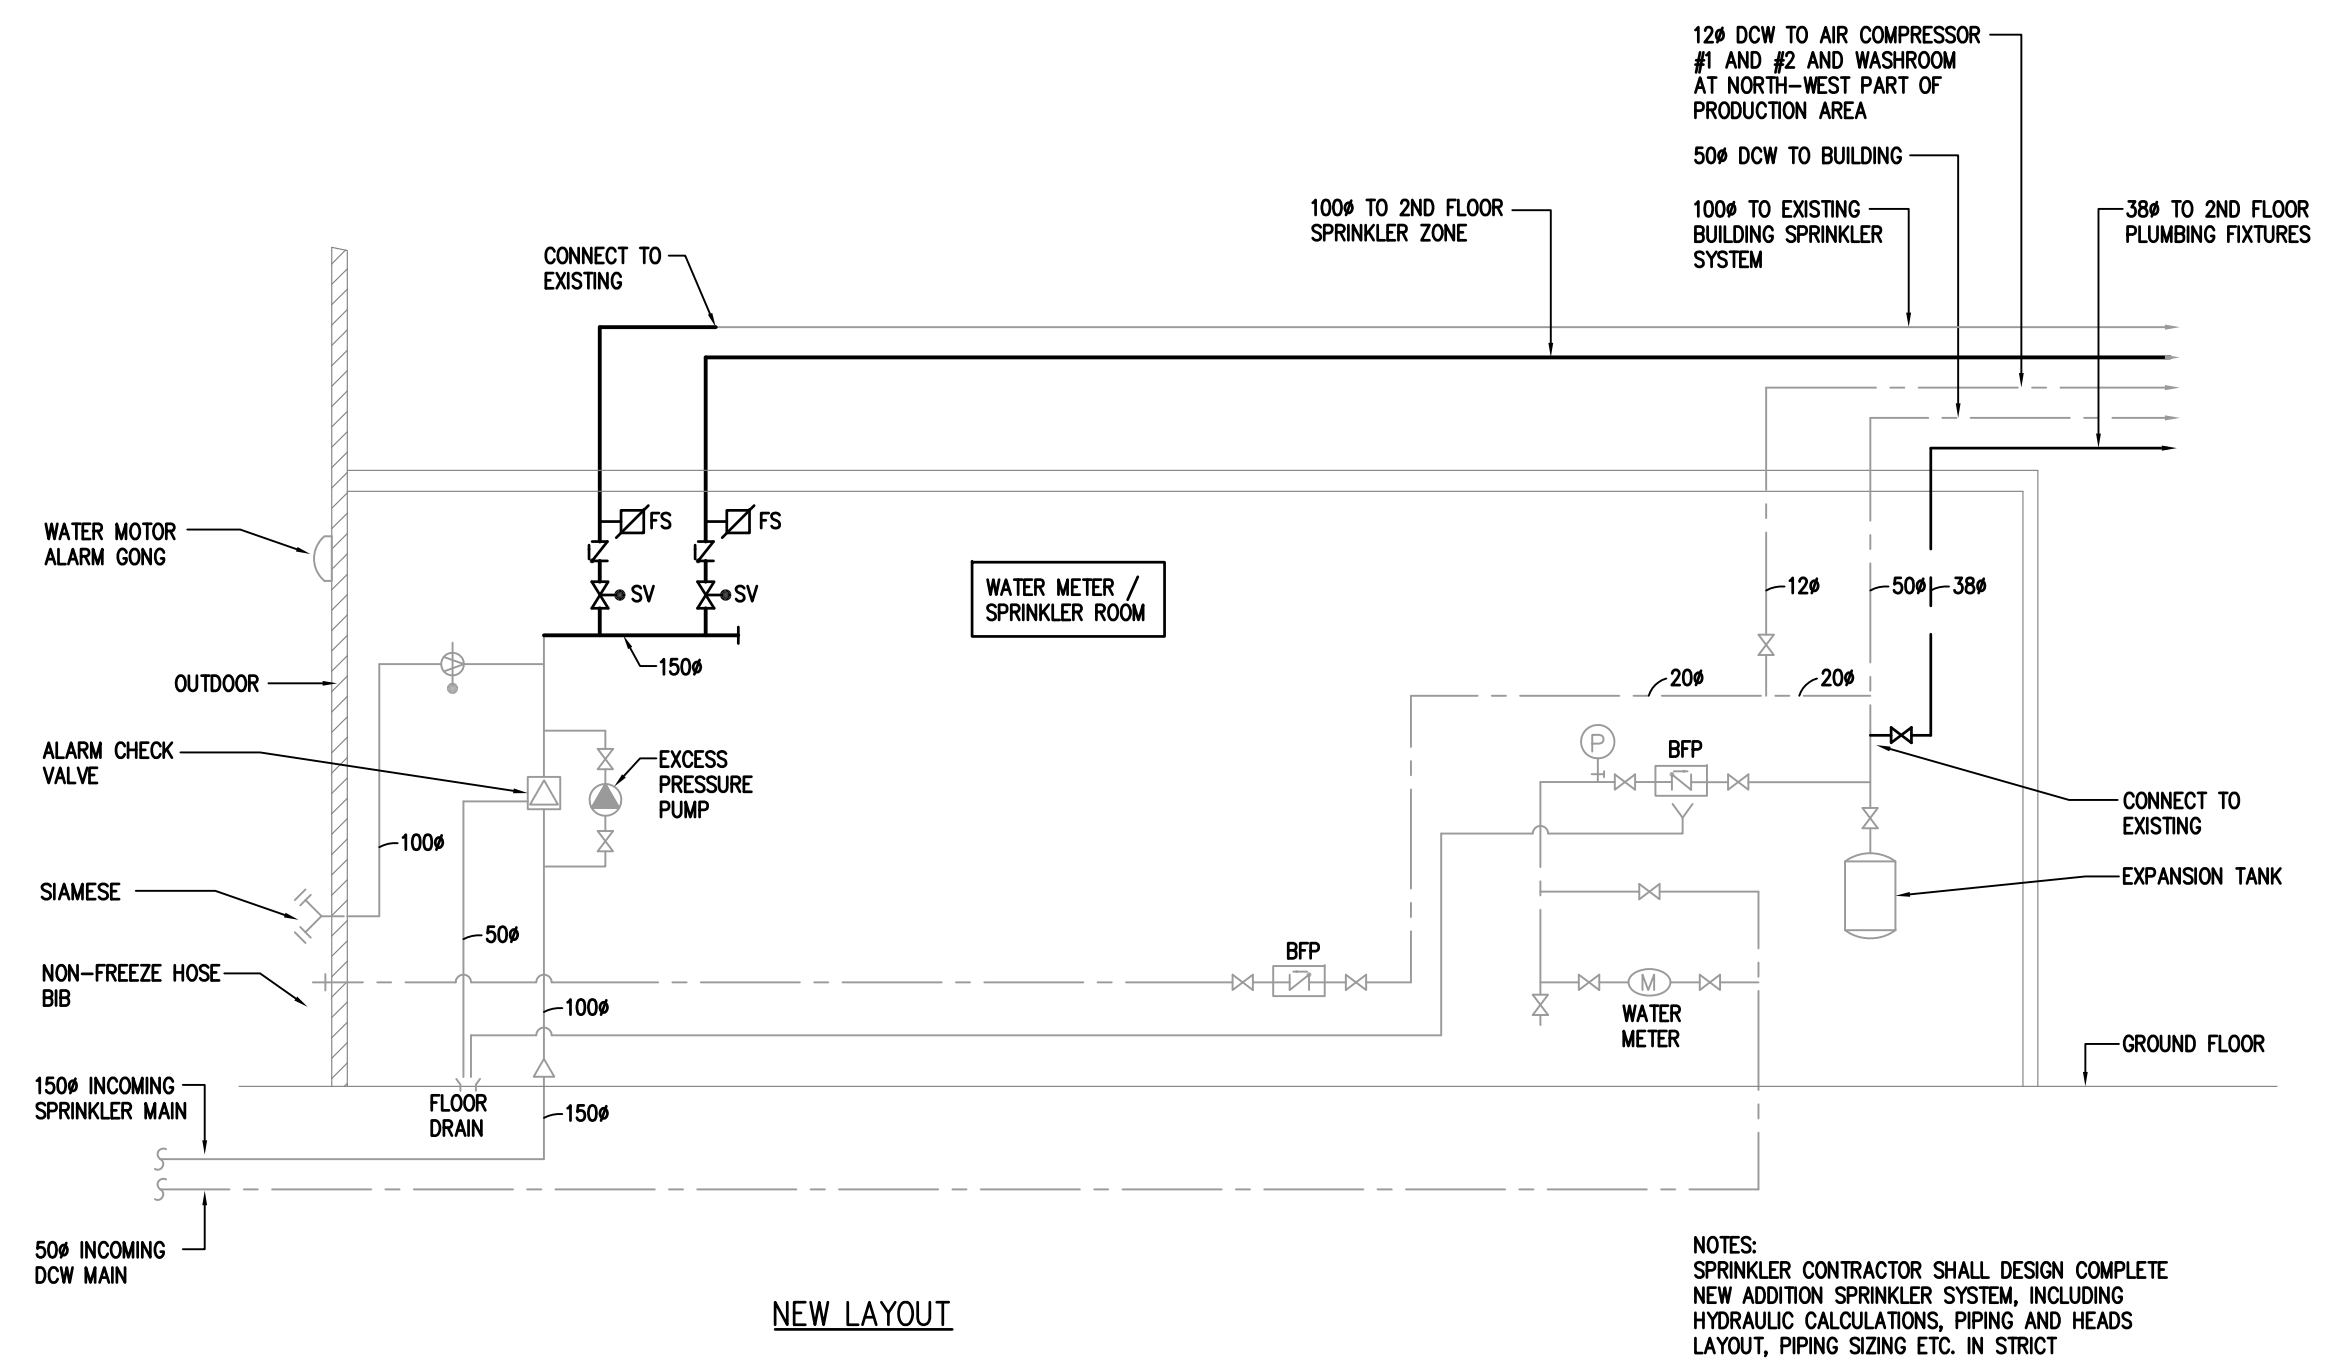


NEW LAYOUT


**NOTES:**  
SPRINKLER CONTRACTOR SHALL DESIGN COMPLETE NEW ADDITION SPRINKLER SYSTEM, INCLUDING HYDRAULIC CALCULATIONS, PIPING AND HEADS LAYOUT, PIPING SIZING ETC. IN STRICT ACCORDANCE WITH NFPA 13 REQUIREMENTS

Rev	Description	Date
1	Schematic Design	09/06/2023
2	Issued for 75% Progress	17/11/2024
3	Issued for Permit	16/02/2024
4	Issued for Tender	04/03/2024
5	Issued for Addendum #3 (MAD-2)	05/04/2024

**1 SPRINKLER ASSEMBLY**  
SCALE: N.T.S.

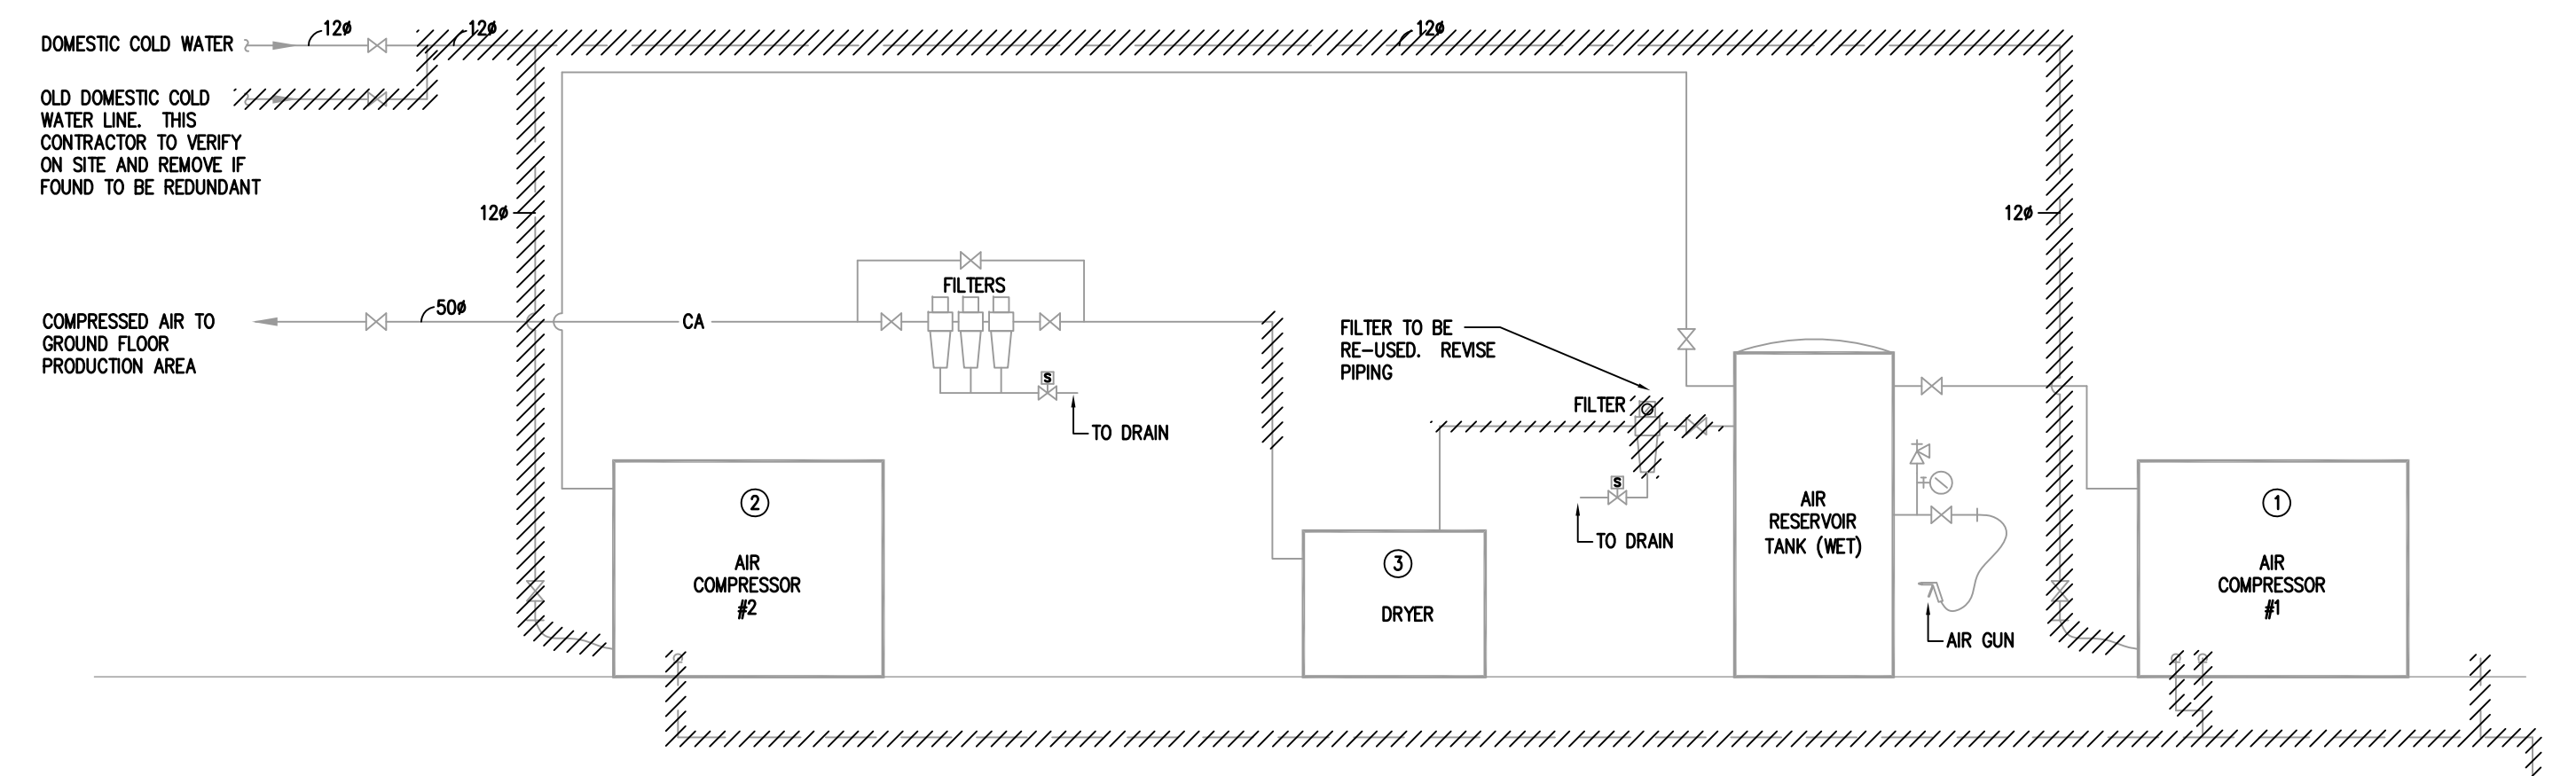

EXISTING LAYOUT

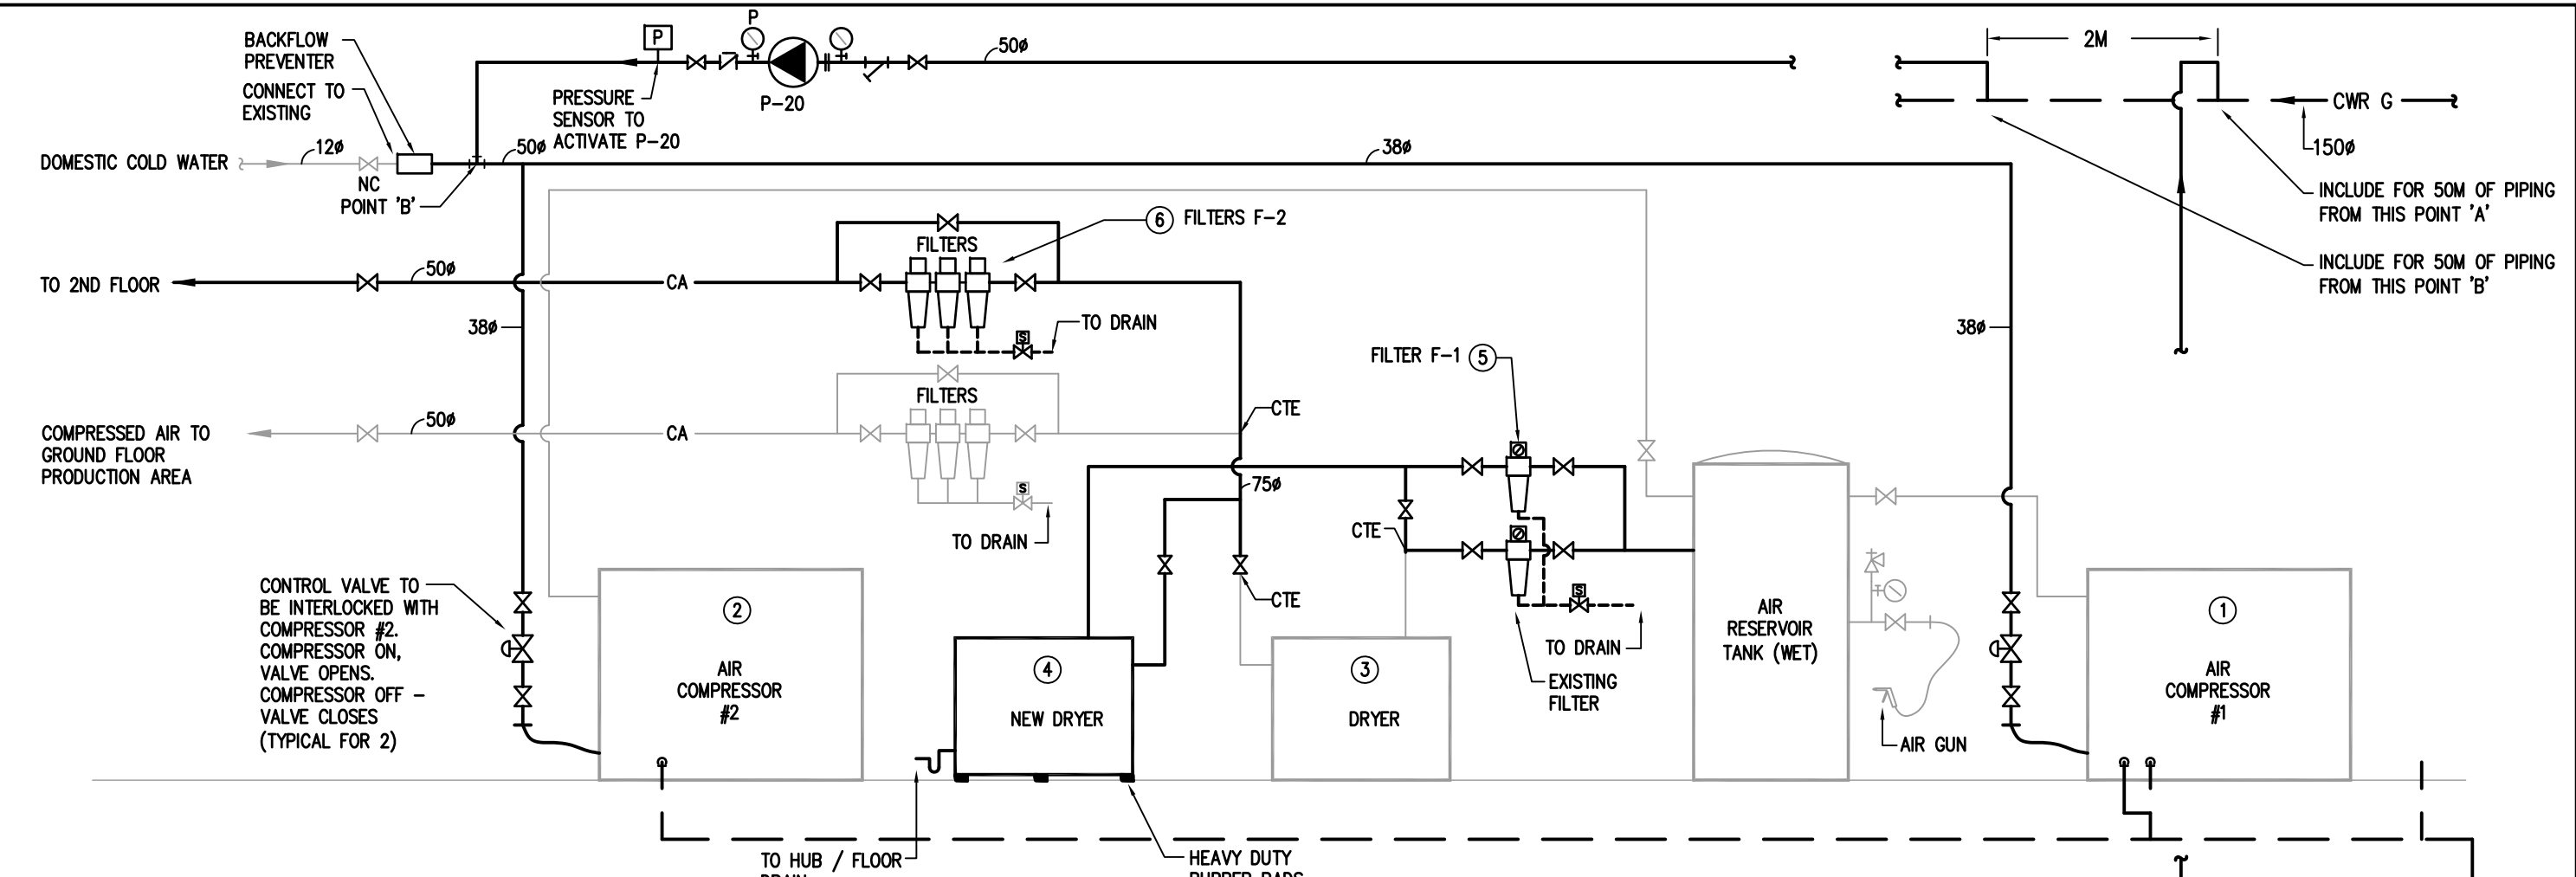

NEW LAYOUT

- ① AIR COMPRESSOR #1  
SURESCAN, 6000C, COMPMAIR CANADA  
MODEL 6075WH  
SERIAL # C10W3275NH00133  
MAX. PRESSURE 125 PSI  
75 HP, 575V-3PH-60HZ  
FLA 79.1 A
- ② AIR COMPRESSOR #2  
SURESCAN, 6000C, COMPMAIR CANADA  
MODEL 6075 AH  
SERIAL # C10A1094M884  
MAX. PRESSURE 125 PSI  
75 HP, 575V-3PH-60HZ  
FLA 81.8 A
- ③ AIR DRYER  
PURESTREAM BY FRULAIR  
MODEL ACT500-UQ
- ④ AIR COMPRESSOR #1  
SURESCAN, 6000C, COMPMAIR CANADA  
MODEL 6075WH  
SERIAL # C10W3275NH00133  
MAX. PRESSURE 125 PSI  
75 HP, 575V-3PH-60HZ  
FLA 79.1 A
- ⑤ AIR COMPRESSOR #2  
SURESCAN, 6000C, COMPMAIR CANADA  
MODEL 6075 AH  
SERIAL # C10A1094M884  
MAX. PRESSURE 125 PSI  
75 HP, 575V-3PH-60HZ  
FLA 81.8 A
- ⑥ AIR DRYER  
PURESTREAM BY FRULAIR  
MODEL ACT500-UQ
- ⑦ NEW AIR DRYER  
PURESTREAM REFRIGERATION ACT DRYER BY FRULAIR  
MODEL ACT 500U  
FLOW RATE: 500 SCFM  
39" DEWPOINT, R410A REFRIGERANT  
COMPLETE WITH AUTODRAIN, PRE & FINAL LIQUID AND OIL COALESCENT FILTER (500 CFM CAPACITY)  
OIL FILTERS: 2-1/2" NPT,  
316 STAINLESS STEEL BRAZED HEAT EXCHANGER  
HOT GAS BY-PASS VALVE  
UNIT WEIGHT: 406 LBS  
POWER: 575V-3PH-60HZ, MOCP 15A
- ⑧ NEW FILTER F-1:  
INGERSOLL RAND COMPRESSED AIR  
FILTERS OR EQUAL  
FLOW RATE: 500 SCFM  
PSIGS-10,  
580CFM FLOW,  
INGERSOLL GRADE G PARTICLE  
REMOVAL TO 1 MICRON INCLUDING  
COALESCED LIQUID, WAETER, OIL ETC.
- ⑨ NEW FILTERS F-2:  
INGERSOLL RAND COMPRESSED AIR  
FILTERS OR EQUAL  
SET OF 3 FILTERS GRADE A, G & H  
HIGH EFFICIENCY FILTERS WITH 0.01  
MICRON WATER, OIL, AEROSOLS ETC.  
REMOVAL:  
400 CFM FLOW

**2 COMPRESSED AIR PIPING DIAGRAM**  
SCALE: N.T.S.



**SHARMA & PARTNERS INC.**  
Mechanical and Electrical Engineers  
85 Collier Drive,  
Unit 108  
Toronto, Ontario  
M8A 2P8  
Tel: (416) 291-8822


SPH PROJECT #: 2023-1010  
**WORKSHOP**  
architecture  
WORKSHOP architecture inc  
6 Sousa Mendes St  
Toronto Ontario M5P 0A8  
T 416.901.8055 F 416.849.0383  
www.workshoparchitecture.ca

Accord Vaughan

56 Edlican Drive, Concord, ON

PROJECT CODE:	SCALE:
22_31	N.T.S.
DATE:	STATUS:
April 5, 2024	Addendum #3

Sprinkler and Compressed Air Diagrams

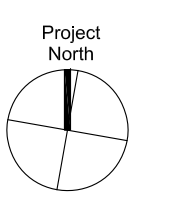

Project Number  
**M0.5**