

POWER SINGLE LINE DIAGRAM SYMBOLS	
	CKT BREAKER, ### INDICATES TRIP SETTING, "I" INDICATES NUMBER OF POLES
	DRAW-OUT CKT BREAKER, ### INDICATES TRIP SETTING, "I" INDICATES NUMBER OF POLES
	FUSED SWITCH, "###" INDICATES TRIP SETTING, "I" INDICATES NUMBER OF POLES
	ENCLOSED CIRCUIT BREAKER
	ENCLOSED NON-FUSED SWITCH
	ENCLOSED FUSED SWITCH
	KIRK KEY INTERLOCK
	AUTOMATIC TRANSFER
	SOLID STATE, ELECTRONIC ADJUSTABLE TRIP
	GROUND FAULT PROTECTION
	SURGE PROTECTIVE DEVICE
	DIGITAL MULTIMETER
	UTILITY METER
	AUTOMATIC/MANUAL TRANSFER SWITCH
	AUTOMATIC TRANSFER SWITCH, WITH BYPASS ISOLATION
	TRANSFORMER
	GENERATOR
	PANELBOARD
	PAD MOUNTED TRANSFORMER
	GROUND
	POTENTIAL TRANSFORMER
	CURRENT TRANSFORMER

POWER DISTRIBUTION AND SMALL POWER	
	20A DUPLEX RECEPTACLE, WALL MOUNTED SUBSCRIPT "USE" INDICATES TYPE A & C OUTLET
	20A DUPLEX RECEPTACLE, ABOVE BACK SPLASH OF CABINET, COUNTERTOP OR SINK
	20A DUPLEX RECEPTACLE, FLUSH MTD IN CEILING
	20A HALF SWITCHED DUPLEX RECEPTACLE, WALL MOUNTED
	SPECIAL PURPOSE RECEPTACLE, WALL MOUNTED, NEMA CONFIGURATION AS NOTED ON PLANS
	SHADING REPRESENTS RECEPTACLE ON LIFE SAFETY BRANCH
	SHADING REPRESENTS RECEPTACLE ON NON-LIFE SAFETY BRANCH
	DISCONNECT SWITCH, REFER TO EQUIPMENT CONNECTION SCHEDULE FOR DISCONNECT TYPE, UON
	COMBINATION MOTOR STARTER DISCONNECT
	MOTOR STARTER
	VARIABLE FREQUENCY DRIVE
	DIRECT CONNECTION, WALL MOUNTED, SUBSCRIPT "X" INDICATES UNIQUE IDENTIFIER, REFER TO EQUIPMENT CONNECTION SCHEDULE
	DIRECT CONNECTION, CEILING MOUNTED, SUBSCRIPT "X" INDICATES UNIQUE IDENTIFIER, REFER TO EQUIPMENT CONNECTION SCHEDULE
	MOTOR, SUBSCRIPT "X" DENOTES MOTOR DESIGNATION, REFER TO EQUIPMENT CONNECTION SCHEDULE
	GROUND BUS BAR
	FURNITURE OUTLET, WALL MOUNTED
	PANELBOARD
	TRANSFORMER
	FLOOR BOX, DUPLEX RECEPTACLE
	SPECIAL FLOORBOX, "I" INDICATES UNIQUE FLOOR BOX TYPE
	RECEPTACLE TYPE NUMBER INDICATES BRANCH CIRCUIT NUMBER
	FLOOR BOX, DUPLEX RECEPTACLE
	FLOOR BOX, COMBINATION POWER/COMMUNICATIONS OUTLET
	SPECIAL FLOORBOX, "I" INDICATES UNIQUE FLOOR BOX TYPE
	TYPE NUMBER INDICATES BRANCH CIRCUIT NUMBER
	FLOOR BOX, CONFIGURATION AS INDICATED, FLUSH MOUNTED, UNLESS OTHERWISE NOTED. NOTE: FOR ABOVE DEVICES, SUBSCRIPT "X" INDICATES: P - PEDESTAL MOUNTED FL - FLUSH MOUNTED PT - POKE THROUGH S - SURFACE MOUNTED
	JUNCTION BOX, FLUSH MTD IN FLOOR

LIGHTING, LIGHTING SWITCHING & CONTROLS	
	UPPER CASE LETTERS INDICATE LIGHTING FIXTURE TYPE
	NUMBER INDICATES CIRCUIT NUMBER, LOWER CASE LETTER INDICATES SWITCHED
	LIGHTING FIXTURE ON NORMAL BRANCH POWER - CEILING MOUNTED
	LIGHTING FIXTURE ON NORMAL BRANCH POWER - WALL MOUNTED
	STRIP LIGHTING FIXTURE ON NORMAL BRANCH POWER
	PENDANT LINEAR FIXTURE ON NORMAL BRANCH POWER
	DOWNLIGHT LIGHTING FIXTURE ON NORMAL BRANCH POWER - RECESSED MOUNTED
	PENDANT LIGHTING FIXTURE ON NORMAL BRANCH POWER
	WALL WASH LIGHTING FIXTURE ON NORMAL BRANCH POWER - ARROW INDICATES DIRECTION OF BEAM
	WALL SCONCE LIGHTING FIXTURE ON NORMAL BRANCH POWER - WALL MOUNTED
	BOLLARD LIGHT FIXTURE ON NORMAL BRANCH POWER
	SITE LIGHTING SINGLE HEAD ON NORMAL BRANCH POWER - POLE MOUNTED
	SITE LIGHTING DUAL HEAD ON NORMAL BRANCH POWER - POLE MOUNTED
	EXIT SIGN - SINGLE FACE - CEILING MOUNTED
	EXIT SIGN - SINGLE FACE - WALL MOUNTED
	LOW LEVEL EXIT SIGN - SINGLE FACE - WALL OR DOOR MOUNTED
	DUAL HEAD EMERGENCY LIGHT WITH INTEGRAL BATTERY PACK - WALL MOUNTED
	SPST SWITCH, WALL MOUNTED, "ab" INDICATES INDIVIDUAL, GANGED SWITCHES AND ASSOCIATED SWITCH LEGS CONTROLLED, SUBSCRIPT "X" INDICATES: 2 - DOUBLE POLE 3 - THREE WAY 4 - FOUR WAY D - WALL BOX DIMMER
	OCCUPANCY SENSOR, CEILING MOUNTED
	OCCUPANCY SENSOR, WALL MOUNTED
	VACANCY SENSOR, CEILING MOUNTED
	VACANCY SENSOR, WALL MOUNTED
	DIMMING CONTROL PANEL, SUBSCRIPT "X" INDICATES TYPE
	DIMMING CONTROL STATION, SUBSCRIPT "X" INDICATES TYPE OR UNIQUE IDENTIFIER
	LIGHTING CONTROL PANEL
	SHUNT TRIP PUSH BUTTON
	TIME CLOCK, SUBSCRIPT "X" INDICATES UNIQUE IDENTIFIER
	DAYLIGHT SENSOR, CEILING MOUNTED
	PHOTOCCELL

FIRE ALARM SYSTEM	
	FIRE ALARM STROBE, WALL MOUNTED
	FIRE ALARM HORN, WALL MOUNTED
	FIRE ALARM HORN/STROBE, WALL MOUNTED
	FIRE ALARM SPEAKER, WALL MOUNTED
	FIRE ALARM SPEAKER/STROBE, WALL MOUNTED
	FIRE ALARM BELL, WALL MOUNTED
	HEAT DETECTOR, WALL MOUNTED
	SMOKE DETECTOR, WALL MOUNTED
	SMOKE DETECTOR, DUCT MOUNTED
	CARBON MONOXIDE DETECTOR
	FIREFIGHTERS TELEPHONE OUTLET
	REMOTE INDICATOR LIGHT
	FIRE ALARM CONTROL PANEL
	FIRE ALARM REMOTE ANNUNCIATOR PANEL
	DATA GATHERING PANEL
	FIRE ALARM TERMINAL CABINET
	FIRE ALARM TRANSPONDER PANEL
	FIRE ALARM STROBE, CEILING MOUNTED
	FIRE ALARM HORN, CEILING MOUNTED
	FIRE ALARM HORN/STROBE, CEILING MOUNTED
	FIRE ALARM SPEAKER, CEILING MOUNTED
	FIRE ALARM SPEAKER/STROBE, CEILING MOUNTED
	FIRE ALARM PULL STATION
	HEAT DETECTOR, CEILING MOUNTED
	SMOKE DETECTOR, CEILING MOUNTED
	FIRE/SMOKE DAMPER
	SMOKE DAMPER
	SMOKE ALARM
	COMBINATION SMOKE ALARM AND CARBON MONOXIDE DETECTOR
	TAMPER SWITCH
	REMOTE TEST STATION
	FLOW SWITCH
	SUPERVISORY VALVE
	ELECTRO-MAGNETIC DOOR HOLDER

TAGS AND CALL OUT SYMBOLS	
	SECTION CALLOUT
	SECTION DESIGNATION SHEET NUMBER
	DETAIL CALLOUT
	DETAIL DESIGNATION SHEET NUMBER
	REVISION CALLOUT
	KEYNOTE CALLOUT

SECURITY SYSTEM	
<div> <div> <div>DEVICE TAG</div> <div>AAA</div> <div>MOUNTING TAG</div> <div>SECONDARY ATTRIBUTE</div> </div> </div>	
ALL SECURITY SYSTEM DEVICES ARE WALL MOUNTED UNLESS OTHERWISE INDICATED BY MOUNTING TAG	
	ACCESS CONTROL PANEL
	ALARM DEVICE
	CARD READER (HDB9 MULTICLASS SE8 RP40)
	DOOR CONTACT
	ELECTRIFIED LOCKSET
	ELECTRIC STRIKE
	INTERCOM (MODEL: COMMEND I05 TD) DUR: OUTDOOR DURESS STATION (MODEL: CODE BLUE C8 2x4 OR EQUIVALENT) MASTER STATION (MODEL: MODEL: COMMEND I08 TD)
	KEYPAD
	MAGNETIC LOCK
	PANIC BUTTON
	COLUMN SWITCH W/HANDS FREE PUSH BUTTON
	LOW FREQUENCY EXCITER
	INFRARED READER
	REMOTE DISPLAY UNIT
	LOCAL AREA RECEIVER
	DIRECTIONAL PASSIVE TAG DETECTOR
	INFRARED CURTAIN
	RF READER
	RF READER MASTER
	RF LONG RANGE READER
	RF ETHERNET READER
	AUTO DOOR OPERATOR
	CARD READER (HDB9 MULTICLASS SE8 RP40) OR BARCODE CODE CARD READER (AXIS A8207)
	DOOR CONTROLLER
	DOOR CONTROLLER
	ELECTRIFIED PANIC HARDWARE
	GLASS BREAK DETECTOR
	INTRUSION DETECTION DEVICE
	KEY SWITCH
	MOTION SENSOR
	PANEL / CONTROLLER
	POWER TRANSFER
	REQUEST TO EXIT DEVICE
	ALARM SENSOR
	SECURITY SYSTEM POWER SUPPLY
	SERVER
	SECURITY WORKSTATION
	CCTV CAMERA, WALL-MOUNTED
	CCTV CAMERA, CEILING-MOUNTED CA1: AXIS P207-LV DOME CA2: AXIS P207-LV DOME CA3: AXIS P407-PLIVE CA4: AXIS P3737-PLI
	"PRESS FOR EMERGENCY ASSISTANCE" SWITCH
	"ASSISTANCE REQUESTED" LED ANNUNCIATOR WITH SOUNDER
	OCCUPANCY LAMP
NOTE: 1. PROVIDE A 1/2" CONDUIT ROUTED BETWEEN THE BACK BOX AND THE NEAREST CABLE PATHWAY, UNO. 2. PANIC BUTTON SHALL BE SURFACE-MOUNTED TO UNDERSIDE OF COUNTER/DESK. MOUNT THE BACK BOX DIRECTLY BELOW THE COUNTER/DESK AND PROVIDE SURFACE-MOUNTED RACEWAY FROM THE BACK BOX TO THE PANIC BUTTON LOCATION.	

DEMOLITION	
	EXISTING TO BE REMOVED
	EXISTING TO BE RELOCATED
	EXISTING TO REMAIN
	EXISTING - NEW LOCATION
	DEMOLITION CONDUIT
	DEMOLITION EQUIPMENT
	EXISTING TO REMAIN CONDUIT
	EXISTING TO REMAIN EQUIPMENT
	RELOCATED / NEW CONDUIT
	RELOCATED / NEW EQUIPMENT

NURSE CALL SYSTEM	
	NURSE CALL CORRIDOR ZONE LIGHT
	NURSE CALL ROOM DOME LIGHT
	NURSE CALL CONSOLE
	NURSE CALL ANNUNCIATOR
	NURSE CALL ASSET TRACKING
	NURSE CALL CODE BLUE STATION
	NURSE CALL CODE BLUE STATION WITH STAFF ASSIST BUTION
	NURSE CALL EMERGENCY PULL STATION
	NURSE CALL EMERGENCY PULL SHOWER STATION
	NURSE CALL GATEWAY
	NURSE CALL MASTER STATION
	NURSE CALL DUTY STATION
	NURSE CALL PATIENT STATION
	NURSE CALL STAFF ASSIST STATION
	NURSE CALL STAFF STATION


ABBREVIATIONS	
A	ANALOG
AFCI	ARC FAULT CIRCUIT INTERRUPTOR
AFF	ABOVE FINISHED FLOOR
ATS	AUTOMATIC TRANSFER SWITCH
CK	CLOCK HANGER
CL	CEILING MOUNTED
EMT	ELECTRICAL METALLIC TUBING
EP	EXPLOSION PROOF
F	FURNITURE OR MILLWORK MOUNTED
FL	FLOOR MOUNTED
GFCI	GROUND FAULT CIRCUIT INTERRUPTER
GFI	GROUND FAULT INTERRUPTER
MCC	MOTOR CONTROL CENTER
MD	MOTORIZED DAMPER
MH	MOUNTING HEIGHT
NC	NORMALLY CLOSED
NO	NORMALLY OPEN
OC	OVER THE COUNTER
PTZ	PAN, TILT, ZOOM
ST	SHUNT TRIP
TP	TAMPER PROOF
WP	WEATHER PROOF

CIRCUITING	
	BLOG-E1MDPHA.10
	CIRCUIT NUMBER PANEL DESIGNATION
	CONDUIT SIZE GROUND CONDUCTOR QUANTITY AND SIZE
	CIRCUIT CONDUCTOR QUANTITY AND SIZE

TELECOMMUNICATIONS SYSTEM	
	WALL MOUNT IP PHONE VOICE DATA OUTLET
	WALL MOUNT DATA OUTLET
	WALL MOUNT DATA/IP PHONE VOICE DATA OUTLET
	CEILING MOUNT IP PHONE VOICE DATA OUTLET
	CEILING MOUNT DATA OUTLET
	CEILING MOUNT DATA/IP PHONE VOICE DATA OUTLET
	FLOOR MOUNT IP PHONE VOICE DATA OUTLET
	FLOOR MOUNT DATA OUTLET
	FLOOR MOUNT DATA/IP PHONE VOICE DATA OUTLET
	WIRELESS ACCESS POINT WITH CEILING MOUNT DATA (WAPS SUPPLIED BY UHN AND INSTALLED BY THIS CONTRACTOR)
	JUNCTION BOX FOR AV SYSTEM
DEVICE LEGEND X - NUMBER OF DATA JACKS Y - NUMBER OF VOICE JACKS XY - NUMBER OF DATA/VOICE JACKS NO SUBSCRIPT = (1) DATA/VOICE MOUNTING: OUTLET MOUNTING HEIGHTS TO BE COORDINATED WITH INTERIOR DESIGNER DURING 00 PHASE	

PUBLIC ADDRESS SYSTEM	
<div> <div> <div>DEVICE TAG</div> <div>AAA</div> <div>MOUNTING TAG</div> </div> </div>	
ALL PUBLIC ADDRESS SYSTEM DEVICES ARE WALL MOUNTED UNLESS OTHERWISE INDICATED BY MOUNTING TAG	
	PAGING SPEAKERS OR HORN
	PAGING STATION

CLOCK SYSTEM	
	CLOCK
	ELAPS CLOCK
	TRANSMITTER/RECEIVER ANTENNA
NOTES 1. PROVIDE A 4-11/16" SQUARE BY 2-1/8" DEEP BACK BOX WITH A SINGLE GANG REDUCTION RING AT EACH LOCATION, UNO. 2. PROVIDE A 1" CONDUIT ROUTED BETWEEN THE BACK BOX AND THE NEAREST CABLE PATHWAY, UNO.	

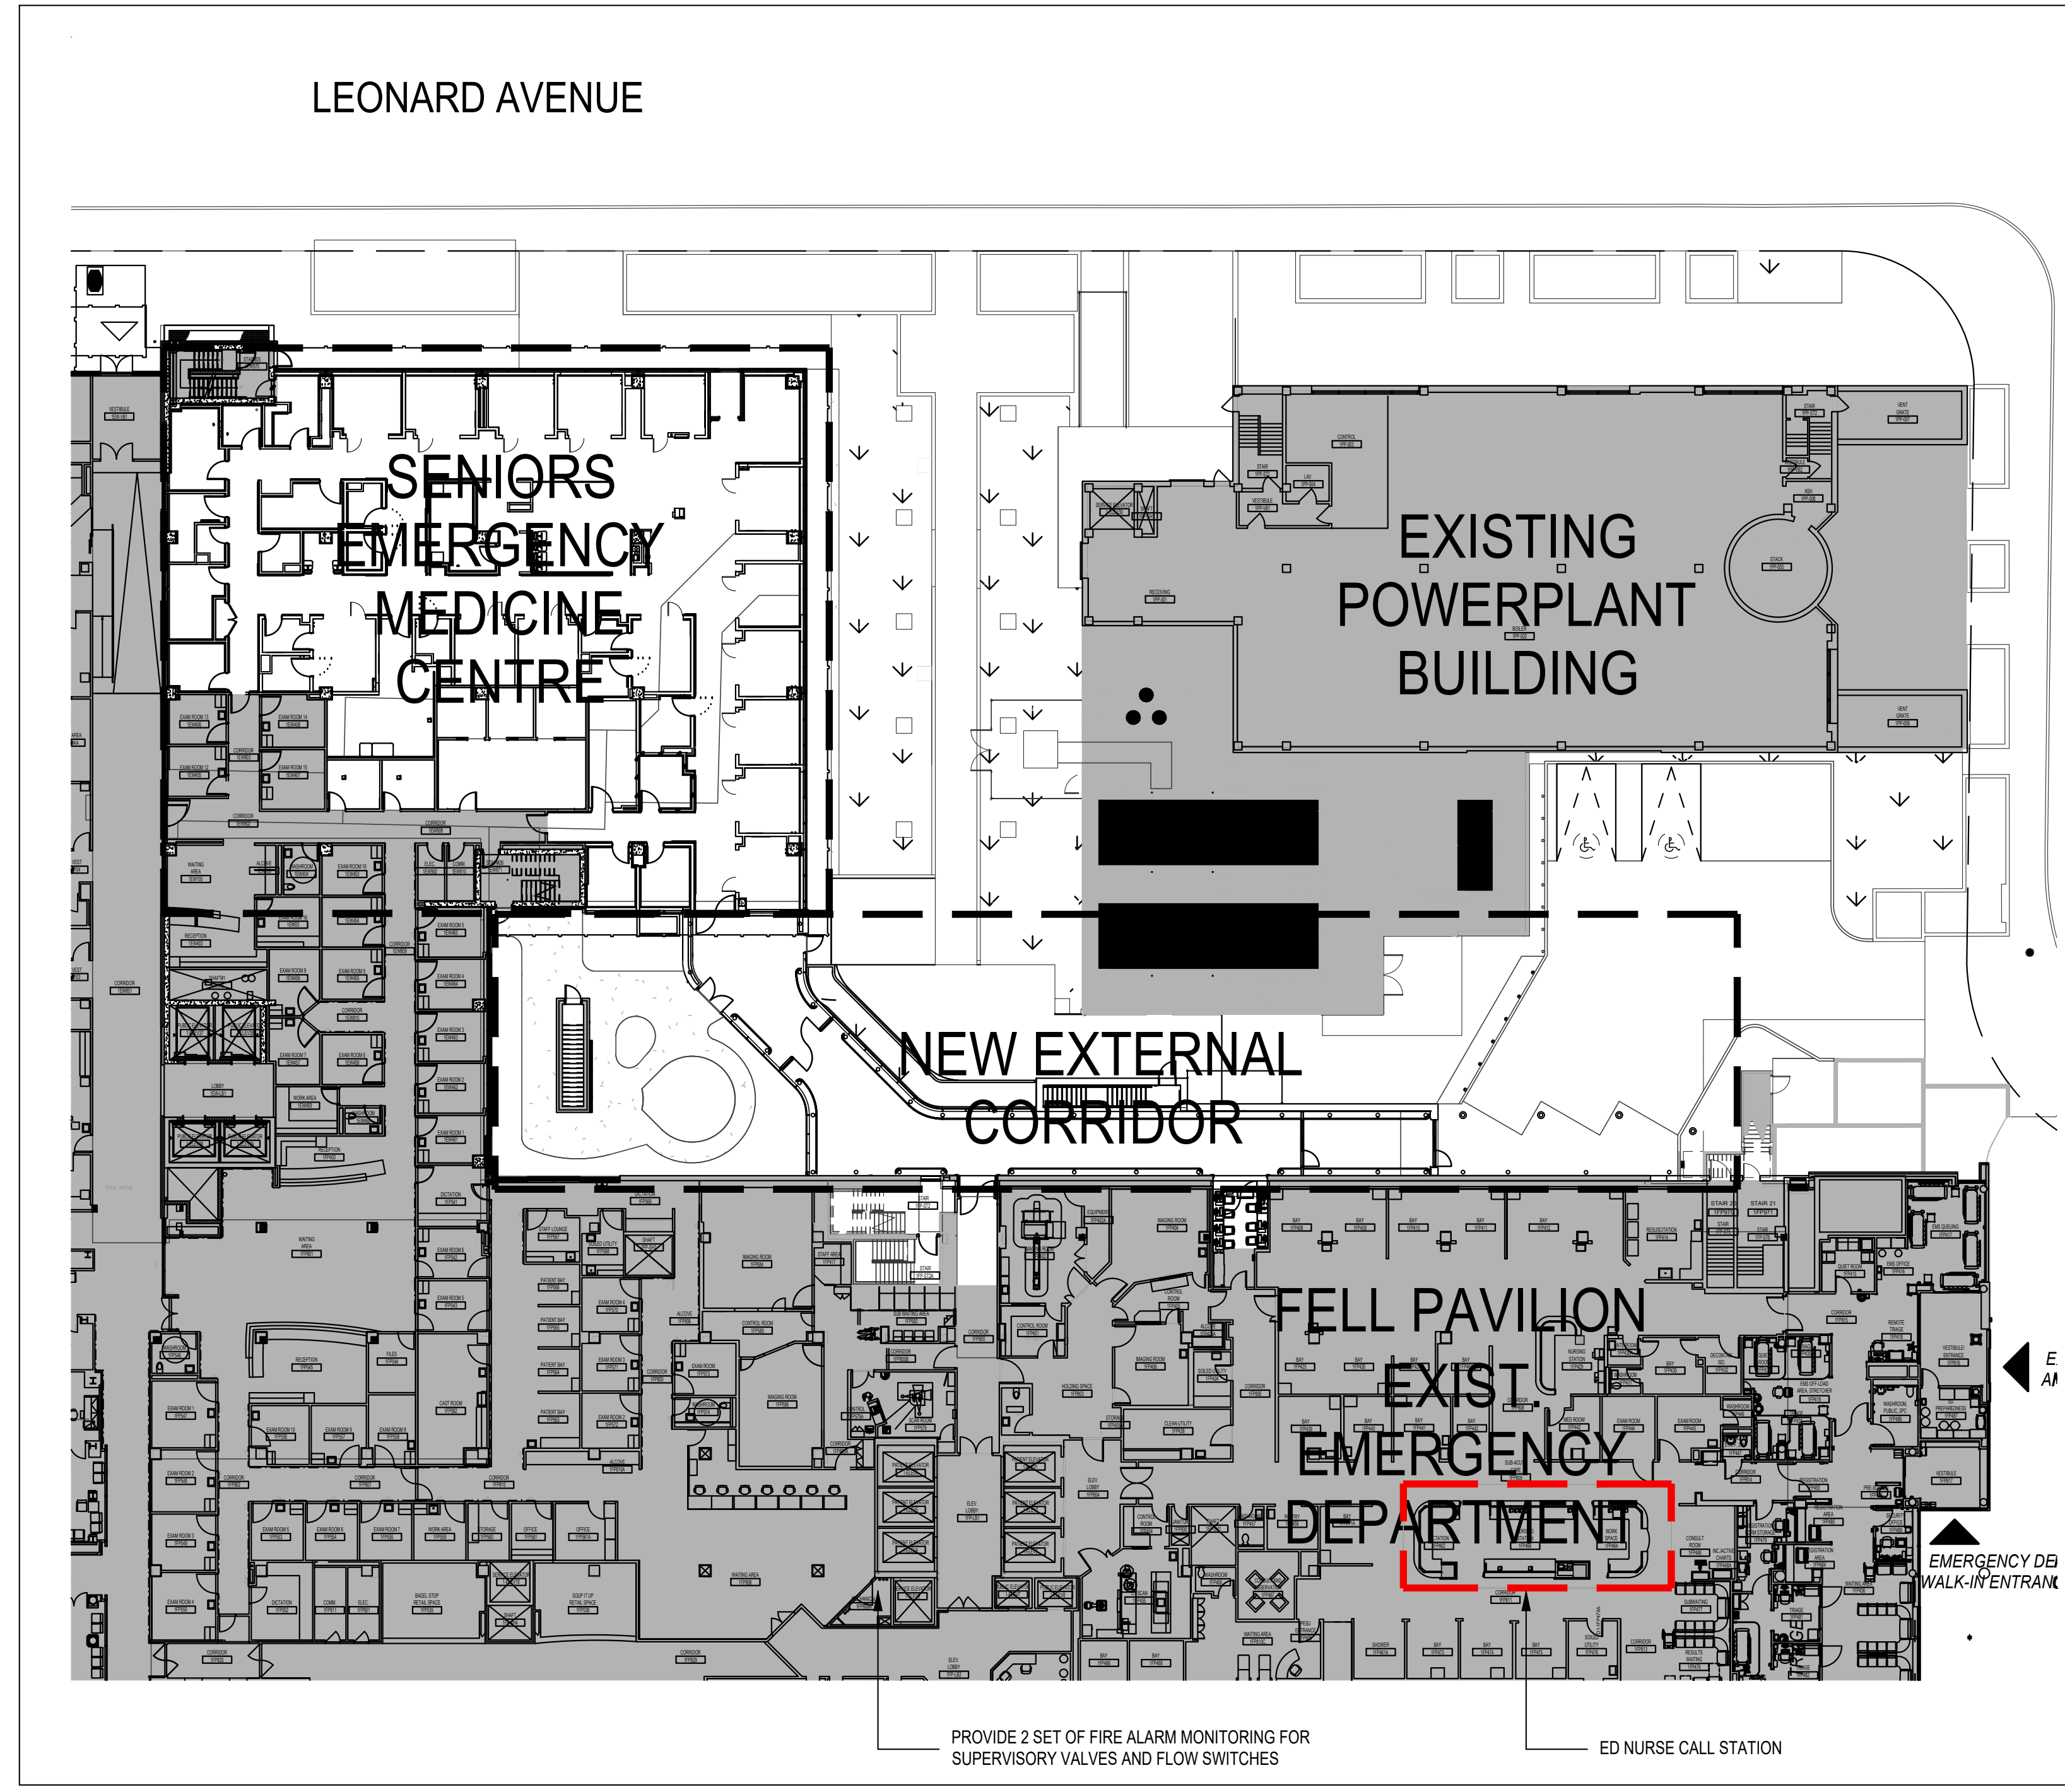

OVERALL PLAN
E-001 / SCALE: 1:250

DRAWING LIST		
	DRAWING NAME	SCALE
E-001	LEGEND, ABBREVIATION AND DRAWING LIST	N.T.S
E-002	GENERAL NOTE AND LUMINAIRES SCHEDULES	N.T.S
E-003	SEPARATE PRICE PLAN	N.T.S
E-101	LEVEL 1 FLOOR PLAN - DEMO - LIGHTING	AS SHOWN
E-102	LEVEL 1 FLOOR PLAN - DEMO - ELECTRICAL	AS SHOWN
E-103	LEVEL 1 FLOOR PLAN - DEMO - POWER SYSTEMS	AS SHOWN
E-201	LEVEL 1 FLOOR PLAN - NEW WORK - LIGHTING	AS SHOWN
E-202	LEVEL 1 FLOOR PLAN - NEW WORK - ELECTRICAL AND POWER SYSTEMS	AS SHOWN
E-203	LEVEL 1 FLOOR PLAN - NEW WORK - EXAM ROOMS	AS SHOWN
E-204	BASEMENT - ELECTRICAL LAYOUT	AS SHOWN
E-205	PENTHOUSE & ROOF FLOOR PLAN - ELECTRICAL LAYOUT	AS SHOWN
E-301	BELOW GRADE FLOOR - ELECTRICAL LAYOUT	AS SHOWN
E-302	GROUND FLOOR PLAN - LIGHTING LAYOUT	AS SHOWN
E-303	GROUND FLOOR PLAN - POWER & SYSTEMS LAYOUT	AS SHOWN
E-401	ELECTRICAL DETAILS AND PANEL SCHEDULES	N.T.S
E-402	MECHANICAL EQUIPMENT SCHEDULES	N.T.S
E-501	ELECTRICAL RISER DIAGRAM	N.T.S
C-E101	GROUND FLOOR OVERALL PLAN - ELECTRICAL LAYOUT	AS SHOWN
C-E201	LEVEL 3 FLOOR PLAN - ELECTRICAL LAYOUT	AS SHOWN
C-E202	LEVEL 1 ROOF - ELECTRICAL LAYOUT & ENLARGED PLAN	AS SHOWN
C-E301	ELECTRICAL RISER DIAGRAM AND LUMINAIRE SCHEDULE	AS SHOWN

University Health Network
Toronto Western Hospital
399 Bathurst Street
Toronto, ON M5T 2S8
www.uhn.ca

ARCHITECT:

CUMULUS ARCHITECTS INC.

160 Pears Ave., Suite 300
Toronto, ON M5R 3P6
416-539-0783
www.cumulusarch.com

CONSULTANT:

1-800-695-3217 / 1-800-695-0187
220 Commerce Valley Drive West, Suite 110
Markham, ON L3T 0A8
Canada
www.exp.com

• BUILDINGS • EARTH & ENVIRONMENT • ENERGY •
• INDUSTRIAL • INFRASTRUCTURE • SUSTAINABILITY •

PROJECT STATUS:

REVISIONS

NO	DESCRIPTION	DATE
1	Issued for Design Development Progress	2024.04.05
2	Issued for 100 DD	2024.05.10
3	Issued for 50% CD / Permit	2024.08.02
4	Issued for 90% CD	2024.08.08
5	Issued for 100% CD	2024.09.27
6	Issued for Tender	2024.10.11
7	Issued for Tender Addendum	2024.10.25
8	Issued for Tender Addendum No.5	2024.11.19

PROJECT:

UHN TWH - Seniors Emergency Medicine Centre
399 Bathurst Street, Toronto ON M5T 2S8
UHN PROJECT NO.: SAP #110022016

TITLE:

OVERALL PLAN, LEGEND, ABBREVIATION AND DRAWING LIST

PROJECT NO:

MRK-23004289

CHECKED:

M.S.

DRAWING NO:

E-001

GENERAL NOTES	
1. ALL DRAWINGS ARE DIAGRAMMATIC ONLY. THE ARRANGEMENTS OF EQUIPMENT SHOWN ARE APPROXIMATIONS ONLY AND MAY BE ALTERED BY THE ENGINEERS TO MEET THE REQUIREMENTS OF THE PROJECT. THESE DRAWINGS SHALL BE READ IN CONJUNCTION WITH THE ARCHITECTURAL, EQUIPMENT CONSULTANTS' MECHANICAL AND STRUCTURAL DRAWINGS FOR INSTALLATION OF ALL EQUIPMENT AND DEVICES.	25.2. IN FIRE RATED CONSTRUCTION, PACK & SEAL VOID BETWEEN OPENING & CONDUIT FOR LENGTH OF OPENING WITH ASBESTOS-FREE ELASTOMERIC ULC LISTED & LABELLED MATERIALS. INSTALL FIRESTOP & SMOKE SEAL MATERIALS IN ACCORDANCE TO ULC CERTIFICATION & MANUFACTURER'S REQUIREMENTS TO PROVIDE FIRESTOP RATINGS OF OPENINGS IN ACCORDANCE WITH GOVERNING BUILDING CODE REQUIREMENTS.
2. CONTRACTOR TO INCLUDE FOR PAYMENT OF REQUIRED PERMITS, FEES, LICENSES, CERTIFICATES OF INSPECTION ETC IF REQUIRED.	25.3. DO NOT CUT OR DRILL EXISTING WORK WITHOUT PRIOR OWNER'S APPROVAL. IN CONSULTATION WITH OWNER & PROVIDE PROFESSIONAL STRUCTURAL ENGINEER REPORT & SIGNOFF REQUIRED FOR LOCATIONS OF ALL CORING IN SLAB. DETERMINE PRESENCE OF EXISTING SERVICES & REINFORCING RODS CONCEALED BEHIND SURFACE TO BE CUT. ENSURE THAT AREAS OF BOTH SIDES OF THE SURFACE BEING CUT ARE PROTECTED FROM DEBRIS. NOTE: ELECTRICAL CONTRACTOR WILL BE HELD RESPONSIBLE FOR DAMAGE DONE TO EXISTING BUILDING & SERVICES CAUSED BY CUTTING OR DRILLING. CAREFULLY HAND CHESEL TO EXPOSE RE-BAR AND BURIED SERVICES AND CHESEL OUT REQUIRED OPENINGS. NO GRAY PERMITTED FOR SLAB SCANNING.
3. ALL OPENINGS, IF APPLICABLE, SHALL BE SEALED WITH APPROVED FIRE STOP MATERIAL TO MEET THE FRP OF THE ASSEMBLY. MAKE NOTE TO REFER TO ARCH DWGS. ANY FIREPROOFING MATERIAL REMOVED WILL BE REPLACED WITH A SUITABLE AND APPROVED FIREPROOFING MATERIAL AND SHALL BE INSTALLED AS PER MANUFACTURER'S RECOMMENDATIONS TO APPLICABLE BUILDING AND FIRE CODES.	26. DISCONNECT, REMOVAL & RELOCATION WORK 26.1. WHERE INDICATED ON DRAWINGS, & DETERMINED BY SITE VISIT, DISCONNECT & REMOVE ITEMS OF EXISTING OBSOLETE ELECTRICAL WORK & RELOCATE DEVICES, WHERE FIXTURES, SWITCHES, RECEPTACLES & OTHER DEVICES &/OR EQUIPMENT IS REMOVED, DISCONNECT AT POINT OF ELECTRICAL SUPPLY, REMOVE OBSOLETE WIRING, & MAKE SYSTEM SAFE. REVISE PANELBOARD DIRECTORIES ACCORDINGLY, IF AFFECTED BY WORK.
4. CONTRACTOR SHALL BE RESPONSIBLE FOR ALL FINISHING OF DAMAGED BUILDING AREAS AND FINISHES AFFECTED BY THE WORK AS OUTLINED UNDER SCOPE OF WORK OF THIS PROJECT. ASSUME FULL RESPONSIBILITY FOR ALL WORKS DONE. SHOULD ANY EXISTING SYSTEM OR PROPERTY BE DAMAGED BY THE CONTRACTOR, MAKE FULL REPAIR/REPLACEMENTS WITHOUT EXTRA COST, AND TO THE SATISFACTION OF CONSULTANT AND THE OWNER.	26.2. UNLESS OTHERWISE NOTED, OBSOLETE MATERIALS WHICH ARE DISCONNECTED & ARE NOT TO BE RELOCATED OR REUSED SHALL BE REMOVED FROM SITE & DISPOSED. OBTAIN FROM OWNER, LIST OF EXISTING ITEMS TO BE CAREFULLY REMOVED & TURNED OVER TO OWNER. SAID ITEMS WILL REMAIN PROPERTY OF OWNER.
5. CONTRACTOR IS RESPONSIBLE FOR STORAGE AND PROTECTION OF ALL EXISTING ITEMS WHICH WILL BE RELOCATED/REUSED IN THIS PROJECT.	26.3. PROVIDE JUNCTION BOXES, OUTLET BOXES, WIRING, PLATES, ETC., AS NECESSARY FOR COMPLETE RELOCATION OF DEVICES.
6. THE CONTRACTOR IS RESPONSIBLE FOR THE INSTALLATION AND DISTRIBUTION OF TEMPORARY POWER AND LIGHTING WITHIN THE PREMISES DURING THE CONSTRUCTION PERIOD. EXPOSED ELECTRICAL CORDS OUTSIDE THE PREMISES SHALL NOT BE PERMITTED.	26.4. WHERE EXISTING SERVICES PASS THROUGH OR ARE IN AN AREA TO SERVE ITEMS WHICH ARE TO REMAIN, MAINTAIN SERVICES INCLUDE FOR ROUTING EXISTING SERVICES CONCEALED BEHIND FINISHES & WHICH BECOME EXPOSED DURING RENOVATION WORK, SO AS TO BE CONCEALED BEHIND FINISHES.
7. CONTRACTOR SHALL BE RESPONSIBLE FOR COORDINATION OF ALL THE WORK WITH ALL OTHER TRADES, EXISTING SITE CONDITIONS, CONSULTANTS, AND THE OWNER TO AVOID INTERFERENCE WITH OTHER SERVICES. ALL WORK SHALL BE SCHEDULED AND CARRIED OUT BY THE CONTRACTOR IN A MANNER TO ENSURE CONTINUED AND NON-INTERRUPTED OPERATION OF EXISTING FACILITY.	26.5. IN AREAS WHICH ARE NOT BEING ARCHITECTURALLY RENOVATED & WHICH ELECTRICAL CONTRACTOR MUST RUN SERVICES THROUGH, BE RESPONSIBLE FOR REMOVAL & REINSTALLATION OF ARCHITECTURAL CEILING TILES, MECHANICAL EQUIPMENT, SPRINKLERS, ETC., AS REQUIRED FOR INSTALLATION OF YOUR WORK. IF THE REQUIRED ELECTRICAL WORK IS REQUIRED TO ACCOMMODATE WORK OF OTHER TRADES, AND REMOVAL OF EXISTING CEILING TILES IS NOT THE RESPONSIBILITY OF OTHERS, BE RESPONSIBLE FOR ALL WORK TO GAIN ACCESS TO THOSE DEVICES THAT NEED TO BE WORKED ON, PRIOR TO REMOVAL OF CEILING TILES OR OTHER DEVICES, INSPECT FOR DAMAGES/WORKING ORDER AND REPORT ANY DEFICIENCIES TO OWNER PRIOR TO START OF WORK. PATCH & MAKE GOOD (INCLUDING PAINTING) SURFACES TO MATCH EXISTING.
8. CONTRACTOR SHALL IDENTIFY AND LABEL CLEARLY ALL CIRCUITS, WIRING, SERVICES, JUNCTION BOXES, PULLBOXES, DEVICES, OUTLETS AND EQUIPMENT INSTALLED AND CONNECTED UNDER THE SCOPE OF WORK OF THIS PROJECT. IDENTIFICATION SHALL BE AS PER OWNER'S REQUIREMENTS AND ALL MARKINGS SHALL BE LAMACOD TYPE. COORDINATE ALL LABELING WITH THE OWNER AND CONSULTANT.	26.6. COMPLY WITH THE OWNER'S LATEST WASTE MANAGEMENT GUIDELINES WITH SPECIFIC REFERENCE TO WASTE SEGREGATION AND REMOVALS.
9. NEW AND EXISTING ELECTRICAL WIRING AND CABLES EXPOSED WITHIN THE CEILING SPACES SHALL CONFORM TO THE PLENUM REQUIREMENTS OF ONTARIO BUILDING CODE SENTENCE 3.6.4.3. (1).	27. HAZARDOUS MATERIALS 27.1. IF AT ANY TIME DURING COURSE OF WORK ASBESTOS MATERIALS ARE ENCOUNTERED OR SUSPECTED, CEASE WORK IN AREA IN QUESTION & IMMEDIATELY REPORT, IN ACCORDANCE WITH ONTARIO REGULATION 654/95 (SECTION 7), TO CONSULTANT AND OWNER PROJECT MANAGER. DO NOT RESUME WORK IN AFFECTED AREA WITHOUT APPROVAL FROM CONSULTANT AND OWNER PROJECT MANAGER.
10. DURING CONSTRUCTION ENSURE ALL LUMINAIRES IN AND/OR OUT OF SCOPE OF WORK ARE FREE OF DUST AND DEBRIS. CONTRACTOR TO CLEAN LUMINAIRES AFFECTED BY CONSTRUCTION DUST AND/OR DEBRIS.	28. EXISTING FIRE ALARM SYSTEM WORK 28.1. WHERE NOTED ON DRAWINGS, DISCONNECT & REMOVE REQUIRED DEVICES. NEW WORK TO BE AN EXTENSION OF EXISTING SYSTEM. PERFORM WORK IN ACCORDANCE WITH LATEST EDITION OF CAN/ULC-5524. SEQUENCE OF OPERATION OF NEW WORK TO FUNCTION AS EXISTING SYSTEM. UNLESS OTHERWISE NOTED, CONNECT ADDITIONAL DEVICES TO EXISTING ZONES SERVING AREA & PROVIDE WIRING OF MINIMUM NO. 16 AWG IN CONDUIT & AS PER OESC REQUIREMENTS. ALARM INITIATING CIRCUITS SHALL BE RUN IN SEPARATE CONDUITS FROM ALARM SIGNALLING CIRCUITS.
11. EXISTING PANEL SCHEDULE SHALL BE UPDATED UPON PROJECT COMPLETION. BREAKERS THAT ARE NOT IN USE SHALL BE SWITCHED TO THE OFF POSITION AND MARKED AS SPARE UPON PROJECT COMPLETION. WHERE EXISTING CIRCUITS ON PANELS ARE NOT AFFECTED, THOSE CIRCUITS WILL BE INCLUDED IN THE NEW PANEL DIRECTORIES WHERE PANELS HAVE BEEN AFFECTED BY THIS PROJECT. CONTRACTOR IS RESPONSIBLE FOR UPDATING ANY AND ALL PANEL DIRECTORIES ALTERED BY THE SCOPE OF WORK AND PROVIDING PRINTED COPIES IN EACH, IN ADDITION TO PROVIDING UPDATED AND NEW PANEL DIRECTORIES IN AS-BUILT DRAWINGS, SEE NOTE 15.	28.2. DURING WORK TO THE EXISTING FIRE ALARM SYSTEM THE TIME & DURATION OF INTERRUPTION SHALL BE APPROVED BY THE OWNER & ONLY 1 ZONE SHALL BE INTERRUPTED AT ANY 1 TIME IN ALL AREAS WHERE THE RENOVATION WORK REQUIRES SHUTDOWN OF ANY PART OF THE FIRE ALARM PROTECTION SYSTEM. PROVIDE MANUAL FIRE ALARM PROTECTION (FIRE WARDEN) BY MEANS OF SUPERVISING THE AREA AS APPROVED BY GOVERNING AUTHORITIES. AT NO TIME SHALL THE FIRE ALARM SYSTEM OR ANY 1 ZONE BE LEFT INOPERATIVE AFTER HOURS WITHOUT APPROPRIATE FIRE WATCH. PROVIDE ALL REQUIRED BYPASS WIRING & TEMPORARY WIRING AS MAY BE REQUIRED TO MAINTAIN ALL PARTS OF THE FIRE ALARM SYSTEM OPERATIVE DURING CONSTRUCTION & ALTERATIONS.
12. REWORK ALL EXISTING POWER SUCH THAT SURROUNDING AREAS REMAIN OPERATIONAL AND ARE NOT AFFECTED AS A RESULT OF BUILDING DEMOLITION.	28.3. PROVIDE FIRE ALARM PULL STATION AT LOCATIONS OF ELECTROMAGNETICALLY LOCKED DOORS. PULL STATIONS SHALL BE C/W AUXILIARY CONTACTS FOR CONNECTIONS TO SECURITY SYSTEM TO RELEASE MAGLOCKS UPON FIRE ALARM SYSTEM & PULL STATION ACTIVATION. PROVIDE WIRING & CONDUIT & REQUIRED INTERCONNECTIONS TO SECURITY SYSTEM. CO-ORDINATE WORK WITH SECURITY SYSTEM CONTRACTOR. PROVIDE OBC COMPLIANT MESSAGE SNOGAGE WITH "PULLSTATION FOR EMERGENCY EXIT", ADJACENT PULL STATION.
13. THE CONTRACTOR SHALL BE RESPONSIBLE FOR VISITING THE SITE AND EXAMINING ALL CONDITION AFFECTING THE ELECTRICAL INSTALLATION. NO CONSIDERATION WILL BE GIVEN TO CLAIMS FOR EXTRA COSTS ARISING FROM FAILURE TO VISIT SITE.	28.4. WHEN FIRE ALARM SYSTEM WORK IS COMPLETE & READY FOR ACCEPTANCE, PROVIDE & ARRANGE FOR INDEPENDENT TESTING COMPANY VPOND AS APPROVED BY THE OWNER - EXISTING FIRE ALARM MAINTENANCE CONTRACTOR TO INSPECT, TEST & CERTIFY EQUIPMENT, INCLUDING INITIATING DEVICES, SIGNALING DEVICES, CONTROL DEVICES & WIRING. CONDUCT WORK IN ACCORDANCE WITH LATEST EDITIONS OF CAN/ULC-5536 & 5537. TESTS TO BE CONDUCTED IN PRESENCE OF OWNER &/OR CONSULTANT. CERTIFY SYSTEM AND PROVIDE 3 COPIES OF SIGNED VERIFICATION REPORT.
14. THE WORD "PROVIDE" SHALL MEAN SUPPLY, INSTALL, CONNECT AND TEST.	28.5. THE TESTING COMPANIES MUST EMPLOY TECHNICIANS CERTIFIED BY CANADIAN FIRE ALARM ASSOCIATION &/OR ONTARIO FIRE MARSHALL, AS APPLICABLE.
15. SUBMIT "AS-BUILT" DRAWINGS. THESE DRAWINGS SHALL RECORD ALL CHANGES TO DESIGN.	28.6. CONTRACTOR TO COORDINATE WITH EXISTING FIRE ALARM PROVIDER FOR WORK REQUIRED WITHIN SCOPE OF WORK.
16. LUMINAIRES SHALL BEAR THE APPROPRIATE ULC LABEL FOR LOCATION, MOUNTING POSITION AND OPERATING CONDITIONS IN WHICH IT IS INSTALLED.	28.7. REFER TO ARCHITECTURAL DRAWINGS ADD4 FOR THE SEPARATE PRICE PLAN.
17. LUMINAIRES SHALL BE INSTALLED COMPLETE WITH ALL ACCESSORIES, GLASSWARE, CANOPIES, SOCKETS, REFLECTORS, OPTICS, WIRING DEVICES AND SUPPLIED WITH NEW LAMPS OF THE TYPE AND WATTAGE INDICATED ON DRAWINGS OR IN SPECIFICATIONS.	29. ALL RECEPTACLES TO BE 5-20R HOSPITAL GRADE IN THIS PROJECT UNLESS SPECIFIED.
18. WALL MOUNTED LUMINAIRES AND JUNCTIONS BOXES SHALL BE RIGIDLY SUPPORTED TO STRUCTURE TO PROVIDE ADEQUATE SUPPORT DURING NORMAL OPERATION.	
19. CONTRACTOR SHALL PROVIDE ADDITIONAL JUNCTION BOXES AS REQUIRED WHERE CONDUCTORS EXCEED FACTORY PROVIDED JUNCTION BOX LIMITATIONS.	
20. FIRE RATED DRYSPRM BOARD ENCLOSURES SHALL BE CONSTRUCTED AROUND ALL RECESSED LUMINAIRES THAT PENETRATE FIRE RATED AREAS AS DENIED BY ARCHITECTURAL.	
21. ANY ABANDONED CONDUITS AND FEEDERS SHALL NOT BE REUSED AND TO BE REMOVED WITHIN WITHIN THE AREA ARE OF RENOVATION.	
22. CONTRACTOR SHALL MAINTAIN A VOLTAGE DROP OF 3% FOR ALL BRANCH CIRCUITS.	
23. EXAMINATION OF SITE & DOCUMENTS 23.1. PRIOR TO SUBMITTING BID, CAREFULLY EXAMINE CONDITIONS AT SITE WHICH WILL OR MAY AFFECT WORK, DRAWINGS, & SPECIFICATIONS, & BECOME FAMILIAR WITH BUILDING CONSTRUCTION, FINISHES & OTHER WORK ASSOCIATED WITH WORK, IN ORDER THAT BID INCLUDES FOR EVERYTHING NECESSARY FOR COMPLETION OF WORK.	
24. INTERRUPTIONS TO & SHUT-DOWNS OF EXISTING SERVICES & SYSTEMS 24.1. INCLUDE FOR COSTS OF PREMIUM TIME TO PERFORM WORK DURING NIGHTS, WEEKENDS OR OTHER TIME OUTSIDE OF NORMAL WORKING HOURS, AS NECESSARY TO MAINTAIN SERVICES IN OPERATION OR WITH MINIMUM INTERRUPTIONS & TO COMPLY WITH OWNER'S REQUIREMENTS. NOTE: WORK ASSOCIATED WITH SHUT-DOWNS & INTERRUPTIONS WILL BE CARRIED OUT AS CONTINUOUS OPERATIONS TO MINIMIZE SHUT-DOWN TIME & TO RENOVATE SYSTEMS AS SOON AS POSSIBLE & PRIOR TO SHUT-DOWN, ENSURE MATERIALS & LABOUR REQUIRED TO COMPLETE WORK FOR WHICH SHUT-DOWN IS REQUIRED ARE AVAILABLE AT SITE. ANY REQUIRED SERVICE INTERRUPTIONS MUST BE COORDINATED WITH THE OWNER TWO WEEKS IN ADVANCE OF THE EXPECTED INTERRUPTION.	
25. CUTTING, PATCHING & CORE DRILLING 25.1. DO CUTTING, PATCHING & CORE DRILLING OF EXISTING BUILDING REQUIRED FOR INSTALLATION OF WORK. PERFORM CUTTING IN NEAT & TRUE FASHION, WITH PROPER TOOLS & EQUIPMENT TO OWNER'S APPROVAL. PATCHING WILL EXACTLY MATCH EXISTING FINISHES & BE PERFORMED BY TRADESMEN	

LIGHT LEVEL REQUIREMENT	
ROOM TYPE	TARGET LIGHT LEVEL
CORRIDOR	500LUX (GENERAL LEVEL)
EXAM ROOM	500LUX (GENERAL LEVEL) EXAM MODE : 1000LUX (PATIENT BED LEVEL)
OFFICE	500LUX (TASK LEVEL)
STORAGE AREA	200LUX (GENERAL LEVEL)
WASHROOM	200LUX (GENERAL LEVEL)
STAIR	150LUX (GENERAL LEVEL)

NOTES:
1. CONTRACTOR SHALL SUBMIT THE PHOTOMETRIC FOR APPROVAL.


1. LIGHT LEVEL REQUIREMENT
0002 SCALE: N.T.S.

LUMINAIRE SCHEDULE													
TYPE	BASE MANUFACTURER (AS SPECIFIED)	CATALOGUE NUMBER	CEILING MOUNTED		WALL MOUNTED			WATTAGE	COLOUR TEMP.	VOLTAGE		REMARKS	
			SURFACE	RECESSED	SUSPENDED	SURFACE	RECESSED			BRACKET	120V		347V
A1	PEERLESS ELECTRIC	SDL-3-1ACF-14G		•					3500K		•	COMPLETE WITH ALL NECESSARY MOUNTING ACCESSORIES.	
A2	METALUMEN	S6-1LTUN-4-MB-SA-L3-1-T-1-90		•				6.1W/FT	3500K		•	COMPLETE WITH ALL NECESSARY MOUNTING ACCESSORIES.	
A3	LIFESHIELD	DBX-C-14-G-0-S-PCH/OCOD-DA-1-9-35-L040-ED-U		•					33W	3500K	•	COMPLETE WITH ALL NECESSARY MOUNTING ACCESSORIES.	
A4	LIFESHIELD	SAME AS A3 WITH 1"x4" SIZE		•					33W	3500K		COMPLETE WITH ALL NECESSARY MOUNTING ACCESSORIES.	
B1	ACOLYTE	CHDACPSWSC-RB-90-AC12065						•	311 lm/W	3500K	•	FIXTURE LENGTH AS SHOWN ON LAYOUT COMPLETE WITH ALL NECESSARY MOUNTING ACCESSORIES.	
B2	COLUMBIA LIGHTING	MPS-4-9-35-ML-F-W-E-U	•						31.6W	3500K	•	COMPLETE WITH ALL NECESSARY MOUNTING ACCESSORIES.	
C1	AMICO LIGHTS CORPS	L-LUN-120-AMB-01					•			AMBER	•	COMPLETE WITH ALL NECESSARY MOUNTING ACCESSORIES.	
D1	AMICO LIGHTS CORPS	L-SDM-TW-120-A1E1-LED35 (AMBIENT & EXAM)		•					40W (AMBIENT) 30W (EXAM)	TUNABLE WHITE	•	COMPLETE WITH ALL NECESSARY MOUNTING ACCESSORIES.	
D2	AMICO LIGHTS CORPS	L-SDM-TW-120-A1E1-LED35 (AMBIENT ONLY)		•					40W (AMBIENT)	TUNABLE WHITE	•	COMPLETE WITH ALL NECESSARY MOUNTING ACCESSORIES.	
D3	PEELESS-ELECTRIC	LFR-4RD-M-15L35K8XW-DM1_LFR-4RD-T-S TUNABLE		•					20.5W	TUNABLE WHITE	•	COMPLETE WITH ALL NECESSARY MOUNTING ACCESSORIES.	
D3A	PEELESS-ELECTRIC	SAME AS D3 BUT 2" SIZE		•						TUNABLE WHITE	•	COMPLETE WITH ALL NECESSARY MOUNTING ACCESSORIES.	
D4	AMICO LIGHTS CORPS	L-SKY-4-120-TW-1/2 (AMBIENT, EXAM, READING)		•					20.5W	TUNABLE WHITE	•	COMPLETE WITH ALL NECESSARY MOUNTING ACCESSORIES.	
L1	PEERLESS-ELECTRIC	SL-14G-40-TW-12R-CT-W-MV		•						TUNABLE WHITE	•	COMPLETE WITH ALL NECESSARY MOUNTING ACCESSORIES.	
L2	ACCLAIM LIGHTING	F2M-226-XXAN				•			6W/m	TUNABLE WHITE	•	COMPLETE WITH ALL NECESSARY MOUNTING ACCESSORIES.	
L3	AMICO LIGHTS CORPS	L-SDM-120-A1E1-L30-B-G-LVD		•					30W	TUNABLE WHITE	•	COMPLETE WITH ALL NECESSARY MOUNTING ACCESSORIES.	
L4	METALUMEN	RM4-DOD-112XIN-2MB-AM-LX1500 -T1-1C-T-4-90		•					70W	TUNABLE WHITE	•	3000LUMEN OUTPUT COMPLETE WITH ALL NECESSARY MOUNTING ACCESSORIES.	
L5	LITECONTROL	4L-NG-D-08-SOF-C1-2765T-D125-D01-1C-UNV		•					10.2W/FT	TUNABLE WHITE	•	COMPLETE WITH ALL NECESSARY MOUNTING ACCESSORIES.	
L6	LITECONTROL	SAME AS L5 BUT 4' LENGTH		•					10.2W/FT	TUNABLE WHITE	•	COMPLETE WITH ALL NECESSARY MOUNTING ACCESSORIES. PROVIDE ALL NECESSARY ACCESSORIES, JOINING, HOUSING TO JOIN WITH L7.	
L7	LITECONTROL	SAME AS L5 BUT 3' LENGTH		•					10.2W/FT	TUNABLE WHITE	•	COMPLETE WITH ALL NECESSARY MOUNTING ACCESSORIES. PROVIDE ALL NECESSARY ACCESSORIES, JOINING, HOUSING TO JOIN WITH L6.	
E1	ALPHABET	NU4-RD-20LM-40K-90-20D-CL-BK -BK-120V-DIM10		•					17W	TUNABLE WHITE	•	COMPLETE WITH ALL NECESSARY MOUNTING ACCESSORIES.	
E2	ALPHABET	NU3-RD-10LM-40K-90-20D-DL-BK -BK-120V-DIM10		•					9W	4000K	•	COMPLETE WITH ALL NECESSARY MOUNTING ACCESSORIES.	
F1	KIM LIGHTING	RN-D-8-10-4K9-S-DL-UNV-BLS		•						4000K	•	FIXTURE LENGTH AS SHOWN ON LAYOUT. COMPLETE WITH ALL NECESSARY MOUNTING ACCESSORIES. PROVIDE ALL NECESSARY ACCESSORIES, JOINING, HOUSING TO JOIN WITH F1.	
F2	LITECONTROL	WS2-DW-D-08-SOF-C1-2765T-D030 -D01-1C-UNV	•						2.6W/FT	TUNABLE WHITE	•	FIXTURE LENGTH AS SHOWN ON LAYOUT COMPLETE WITH ALL NECESSARY MOUNTING ACCESSORIES.	
W1	CURRENT	VPW1-24L-10-3K7-3-UNV-BLT						•	10W	4000K		COMPLETE WITH ALL NECESSARY MOUNTING ACCESSORIES.	
X1	EMERG-LITE	EA-3-A-ATN	•			•			2.5W		•	PICTOGRAM EXIT SIGN C/W EXTRUDED ALUMINUM HOUSING AND FACE PLATES AND WHITE LED LIGHT SOURCE. CEILING OR WALL MOUNTED WITH SINGLE OR DOUBLE FACE, WITH OR WITHOUT ARROWS AS SHOWN ON DRAWINGS. COMPLETE WITH ALL NECESSARY MOUNTING ACCESSORIES.	
Z1	LANDSCAPE FIXTURE		•									ELECTRICAL TO SUPPLY AND INSTALL LIGHTING FIXTURE AS SPECIFIED BY LANDSCAPE DESIGNER. PLEASE REFER TO LANDSCAPE DRAWING FOR THE DETAILS.	
BU1	LUMACELL	RGS1082LD1				•			2.5W		•	REMOTE HEAD WITH BUILT-IN 30 MINUTES BATTERY UNIT BUT, 120V AC INPUT, 6V OUTPUT, 108W WATTAGE	
NOTES:													
1. ALL FINISHES, FLANGE AND PLASTER COLOURS TO BE CONFIRMED WITH ARCHITECT/DESIGNER PRIOR TO ORDERING LUMINAIRES.													
2. ALL LUMINAIRES SHALL BE CSA APPROVED.													
3. CONTRACTOR TO PROVIDE MOUNTING ACCESSORIES AND HARDWARE TO SUIT CEILING AND WALL FINISHES.													
4. PROVIDE APPROVED EQUAL FOR ENGINEER'S REVIEW DURING SHOP DRAWINGS REVIEW.													
5. PROVIDE SUITABLE STEP DOWN TRANSFORMER FOR ANY LOW VOLTAGE HOUSING TRANSFORMER.													
6. TUNABLE WHITE COLOR TEMPERATURE RANGE FROM 2700K TO 6500K. 2 DRIVERS TO CONTROL POWER AND COLOR TEMPERATURE.													
7. TUNABLE WHITE FIXTURE CCT SHALL BE CONTROLLED AUTOMATICALLY BY DEFAULT AUTOMATIC CCT CURVE. FIXTURE CCT SHALL BEGIN RAMPING FROM 2700 K STARTING 60 MINUTES BEFORE SUNRISE, COMPLETING THE RAMP UP TO 4000 K 120 MINUTES AFTER SUNRISE. FIXTURE CCT SHALL BEGIN RAMPING DOWN FROM 4000 K 120 MINUTES BEFORE SUNSET, COMPLETING THE RAMP DOWN TO 2700 K 60 MINUTES AFTER SUNSET. THE RAMP UP AND RAMP DOWN SHALL EACH CONSIST OF THE OPTIMAL NUMBER OF DISCRETE STEPS NEEDED TO ACHIEVE THE DEFAULT AUTOMATIC CCT CURVE. EACH FADE DURATION SHALL LAST 15 MINUTES. EXACT SETTING SHALL BE VERIFIED WITH USER BEFORE PROGRAMMING ON SITE.													

CLIENT:



ARCHITECT:

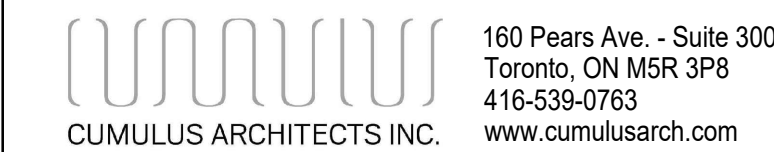

CONSULTANT:



• BUILDINGS • EARTH & ENVIRONMENT • ENERGY •

• INDUSTRIAL • INFRASTRUCTURE • SUSTAINABILITY •

PROJECT STATUS:

REVISIONS

NO	DESCRIPTION	DATE
1	Issued for Design Development Progress	2024.04.05
2	Issued for 100 DD	2024.05.10
3	Issued for 50% CD / Permit	2024.08.02
4	Issued for 90% CD	2024.09.08
5	Issued for 100% CD	2024.09.27
6	Issued for Tender	2024.10.11
7	Issued for Tender Addendum	2024.10.25
8	Issued for Tender Addendum No.2	2024.11.01
9	Issued for Tender Addendum No.5	2024.11.19

PROJECT:

UHN TWH - Seniors Emergency Medicine Centre
399 Bathurst Street, Toronto ON M5T 2S8
UHN PROJECT NO.: SAP #110022016

TITLE:

GENERAL NOTES AND LUMINAIRES SCHEDULES

PROJECT NO:

MRK-23004289

CHECKED:


M.S.

DRAWING NO:


E-002

GENERAL NOTES:
1. THIS DRAWING IS FOR REFERENCE ONLY. PLEASE REFER TO ARCHITECTURAL DRAWING A004 FOR EXACT SEPARATE PRICE PLAN.


LEGEND - SEPERATE PRICE	
	PATIENT TRANSFER
	FELL REMEDIATION WATERPROOFING
	SAI TOUCHDOWN DAY AREA
	BELOW GRADE CRAWL SPACE
	COURTYARD LANDSCAPING - IRRIGATION & SNOW MELT
	SENIORS EMERGENCY MEDICINE CENTRE & CORRIDOR'S CHILLER

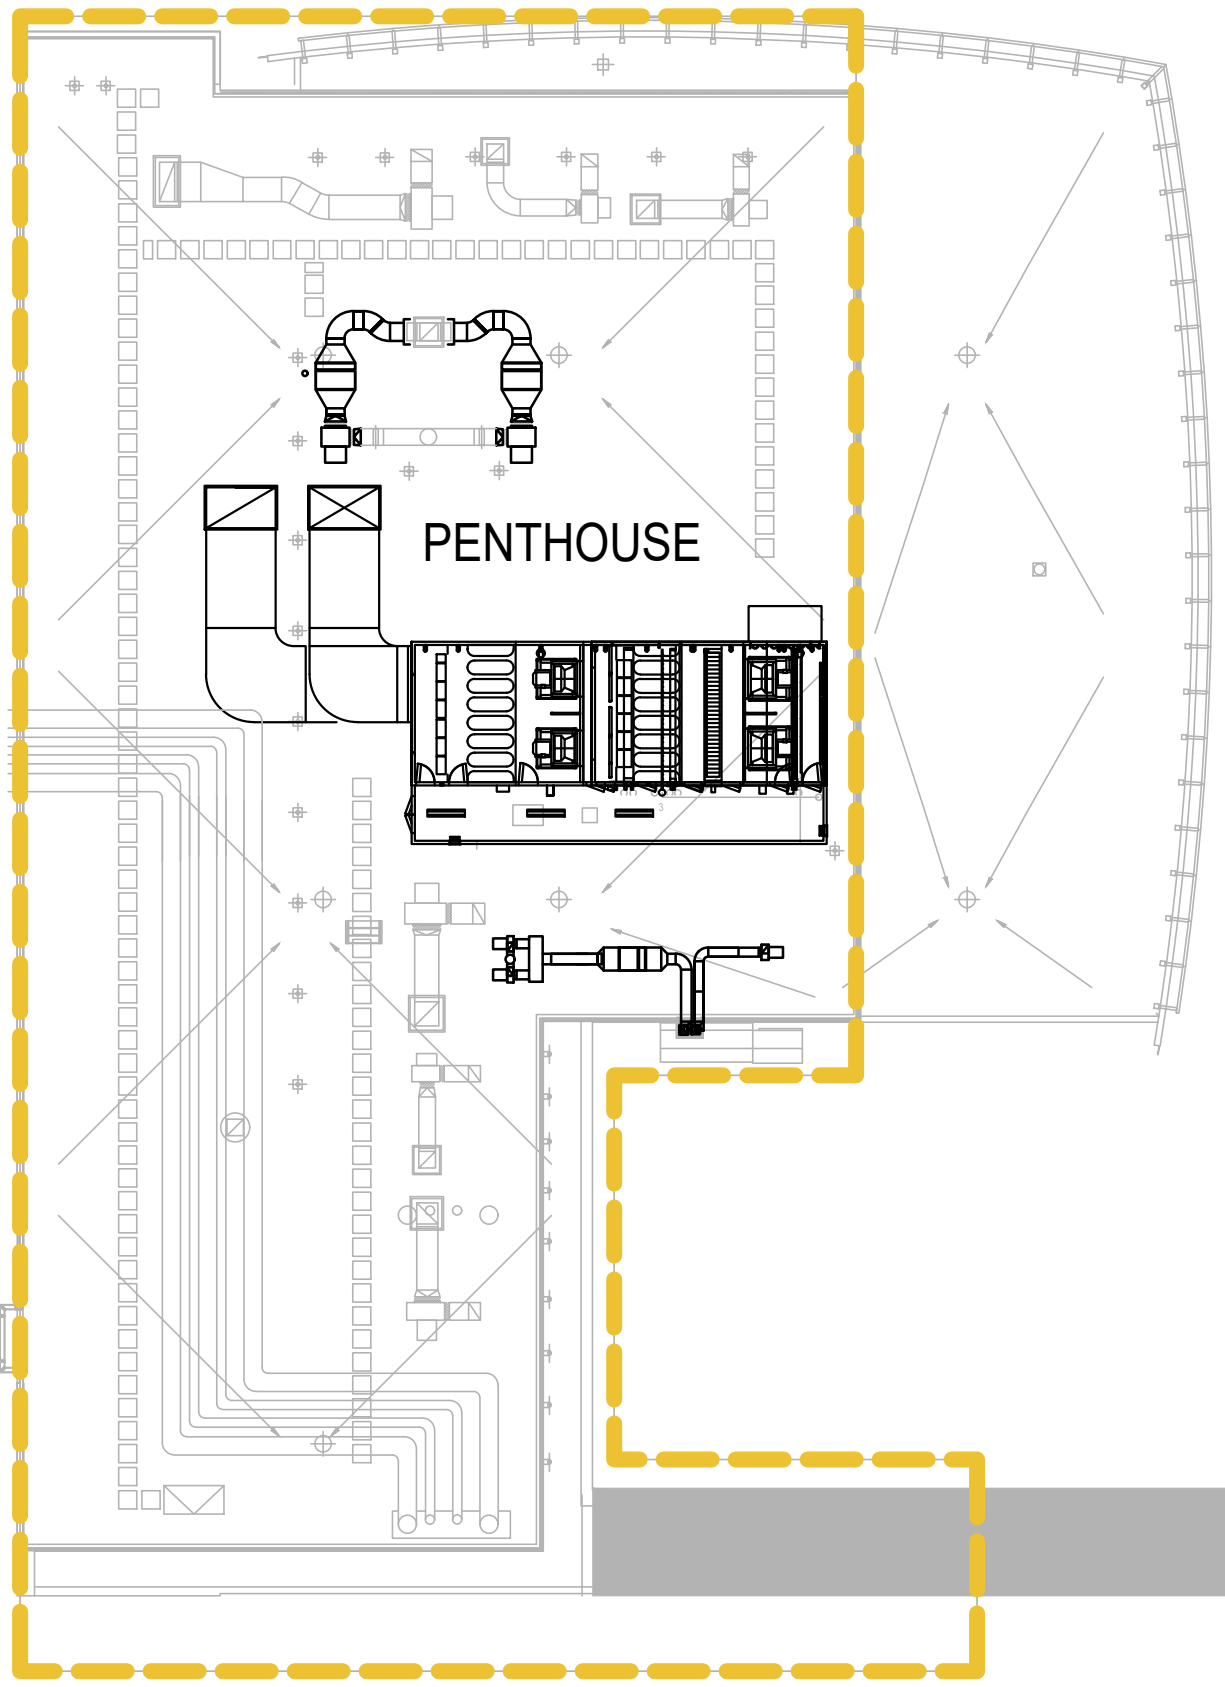


④ Separate Price - Level 10
1 : 250

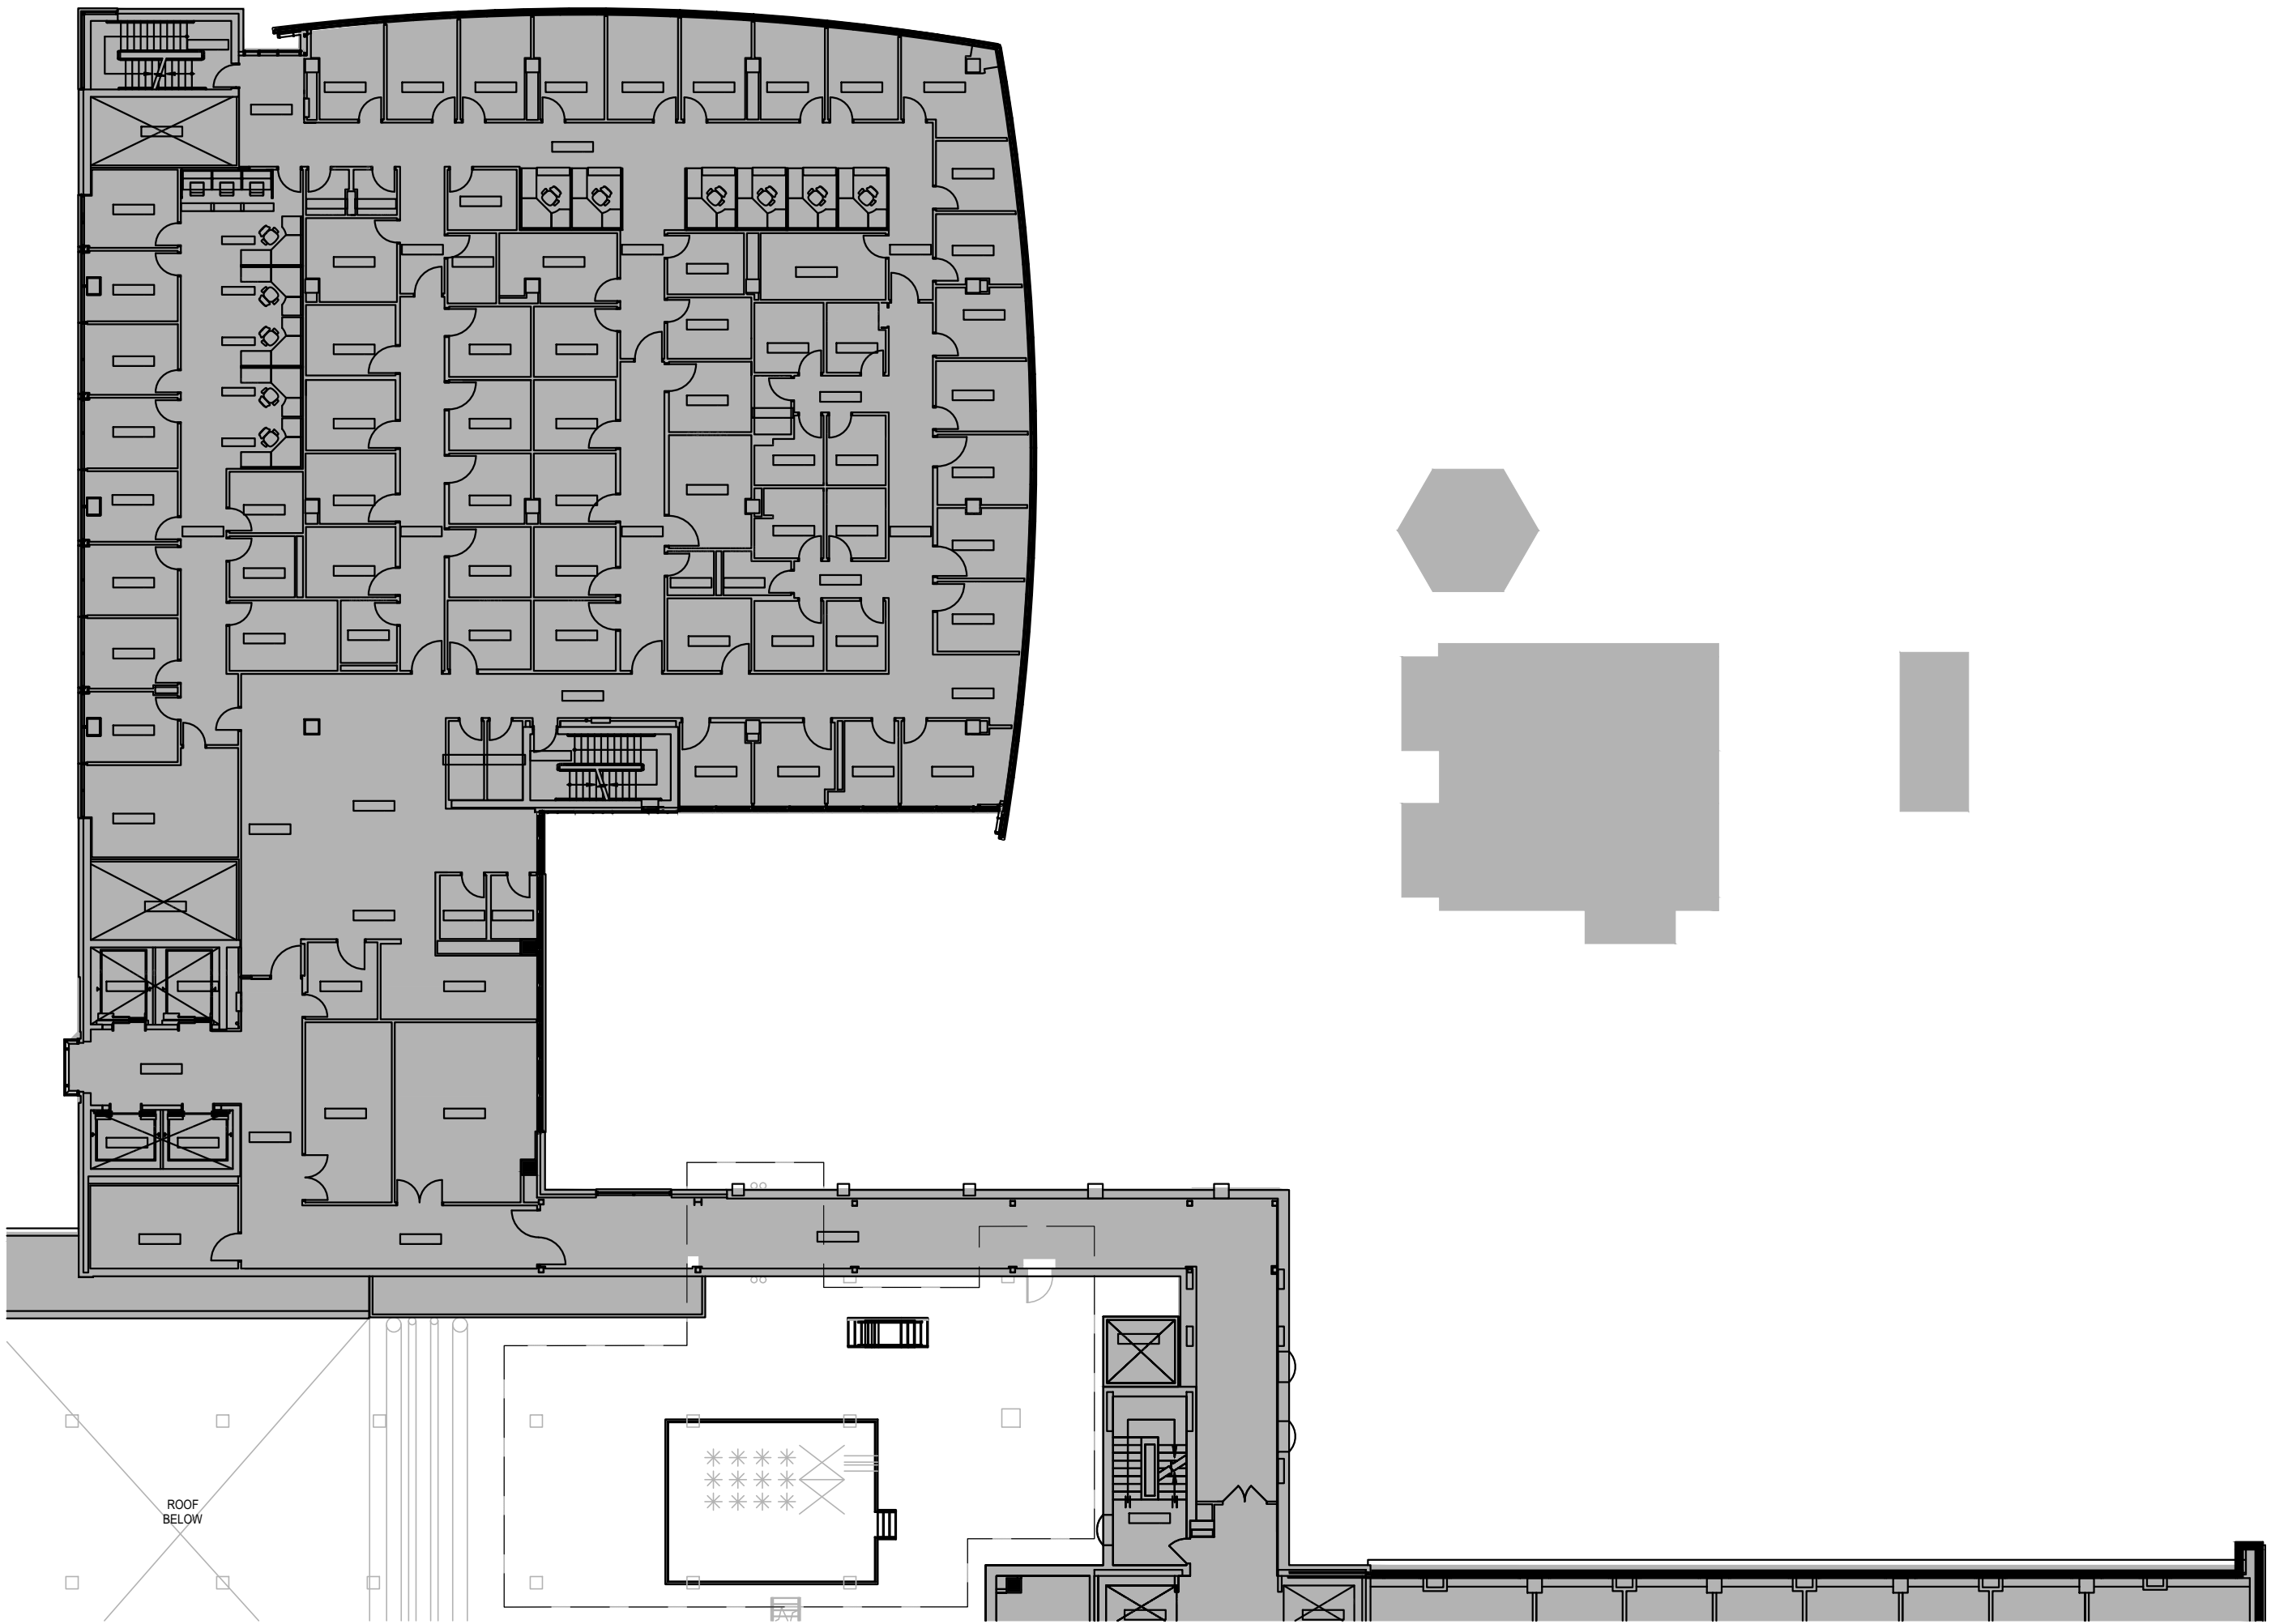

③ Separate Price - Level 8
1 : 250

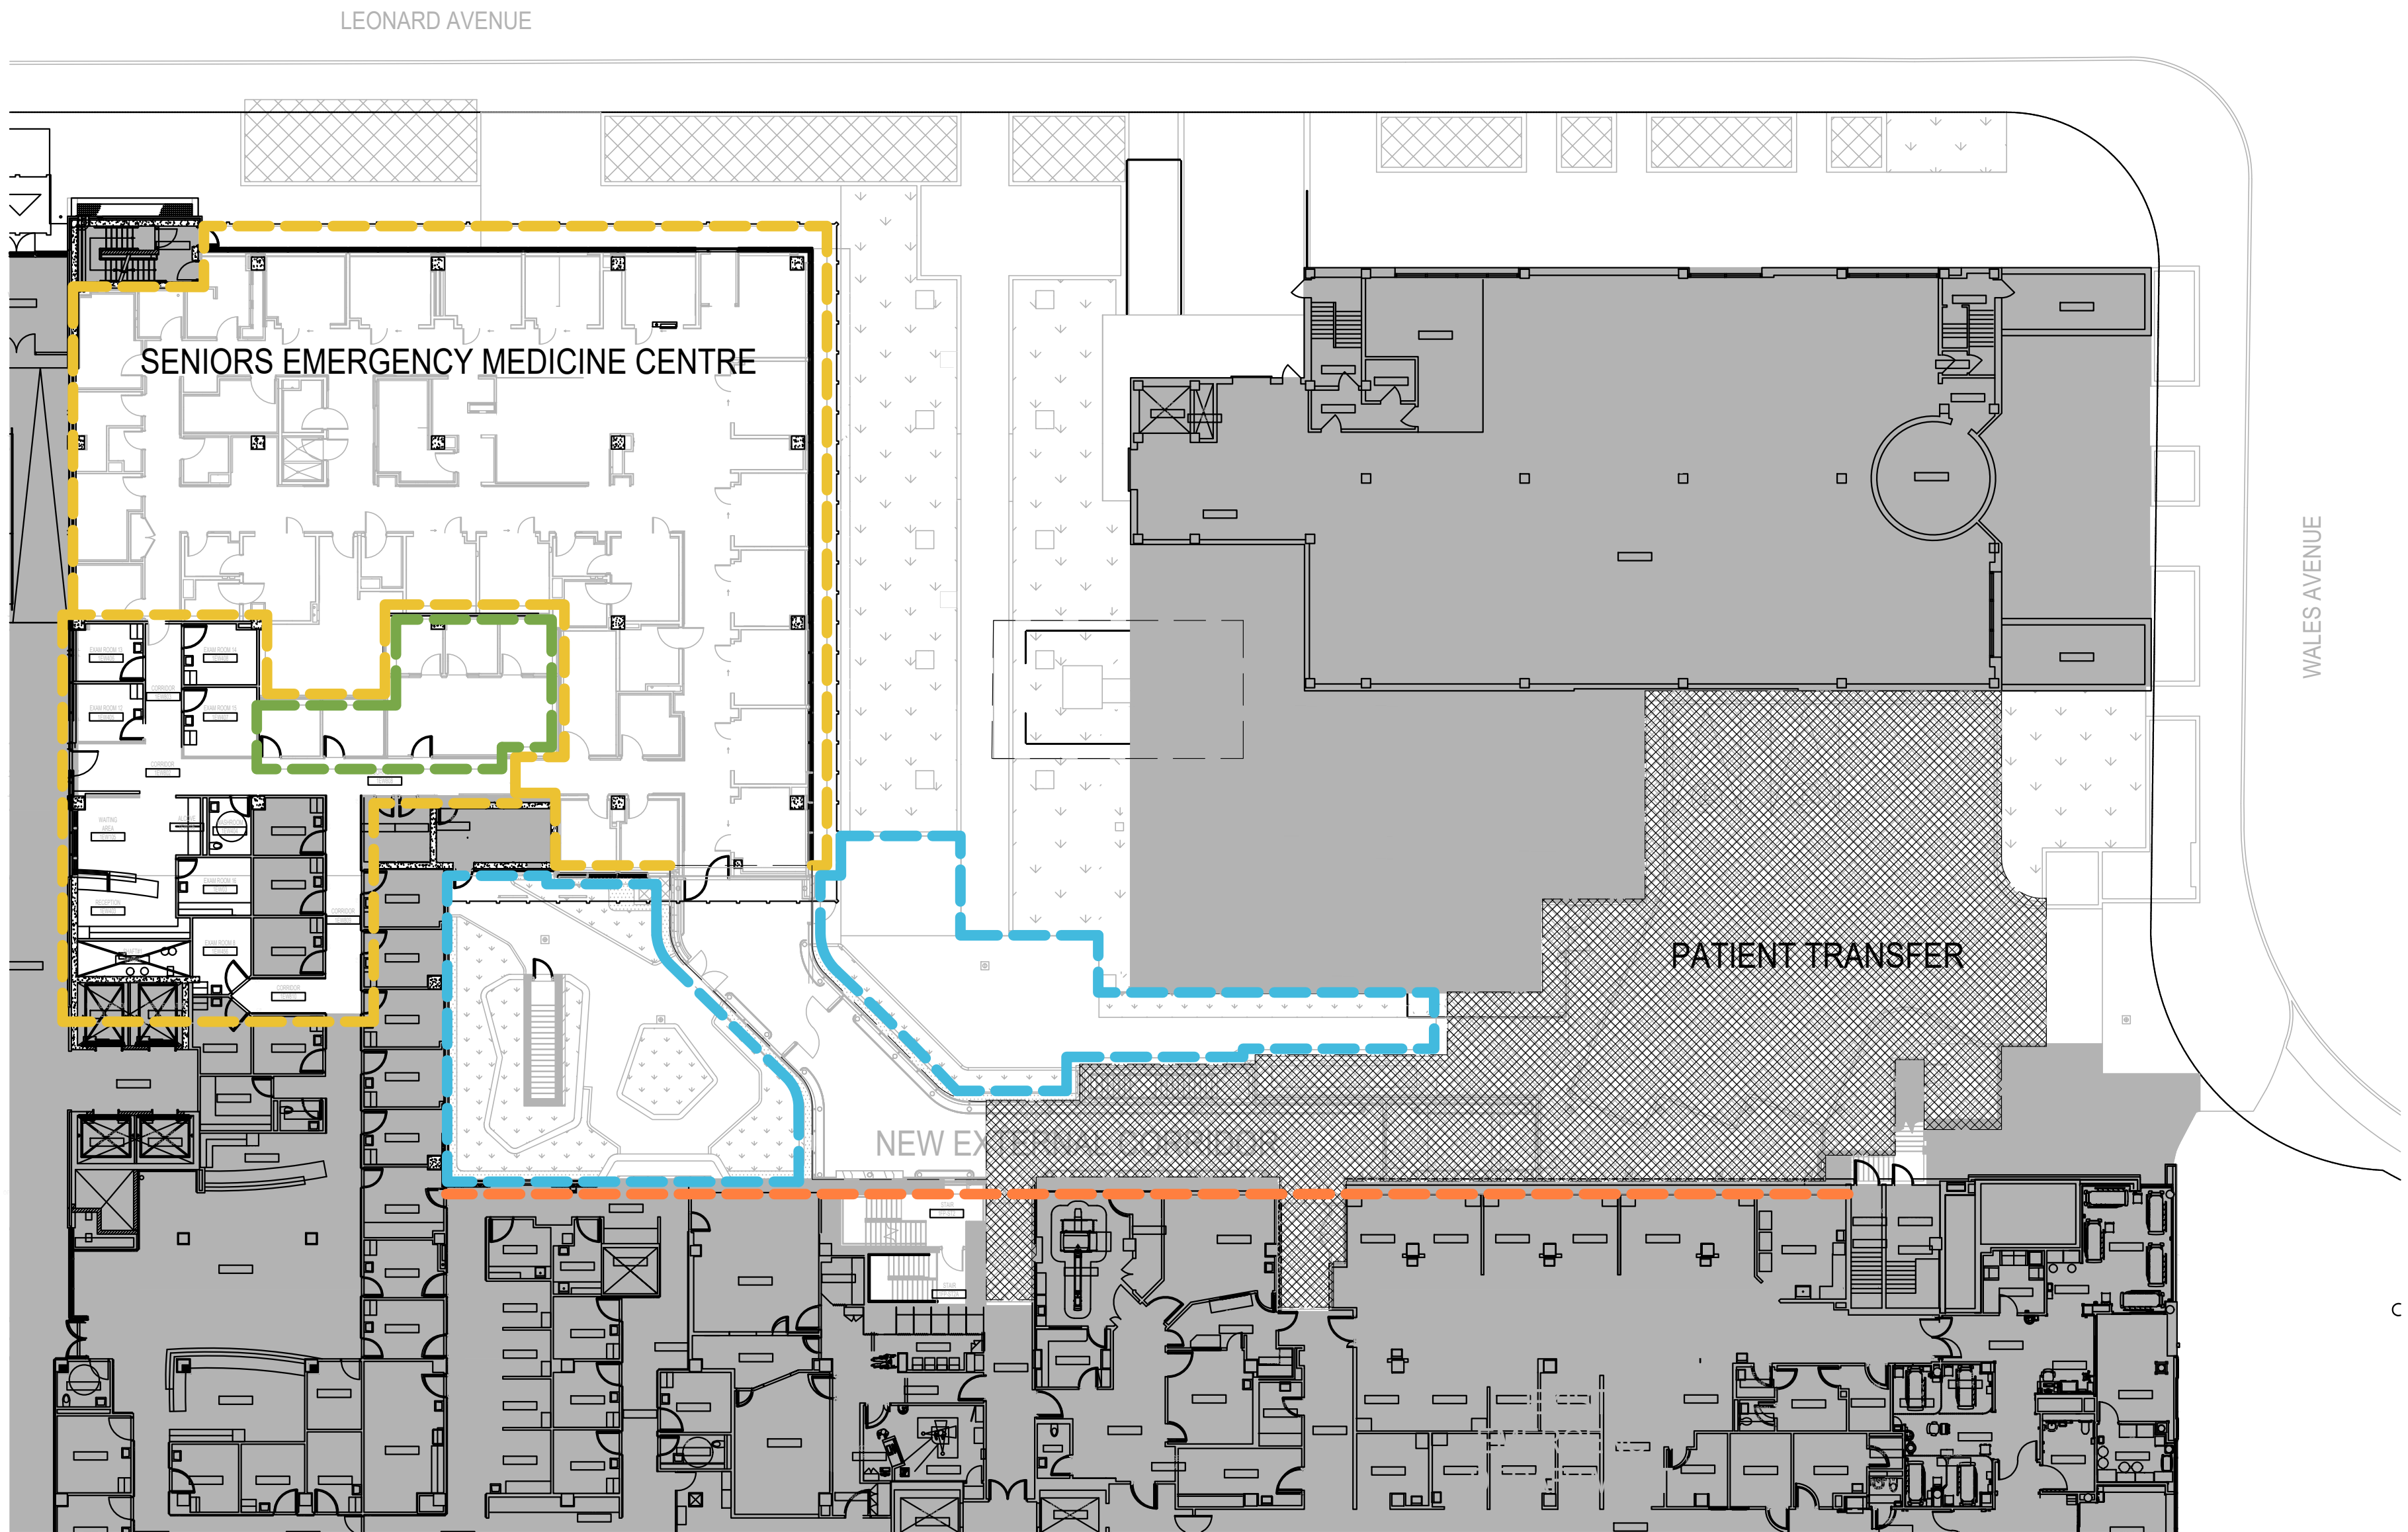

② Separate Price - Level 1
1 : 250

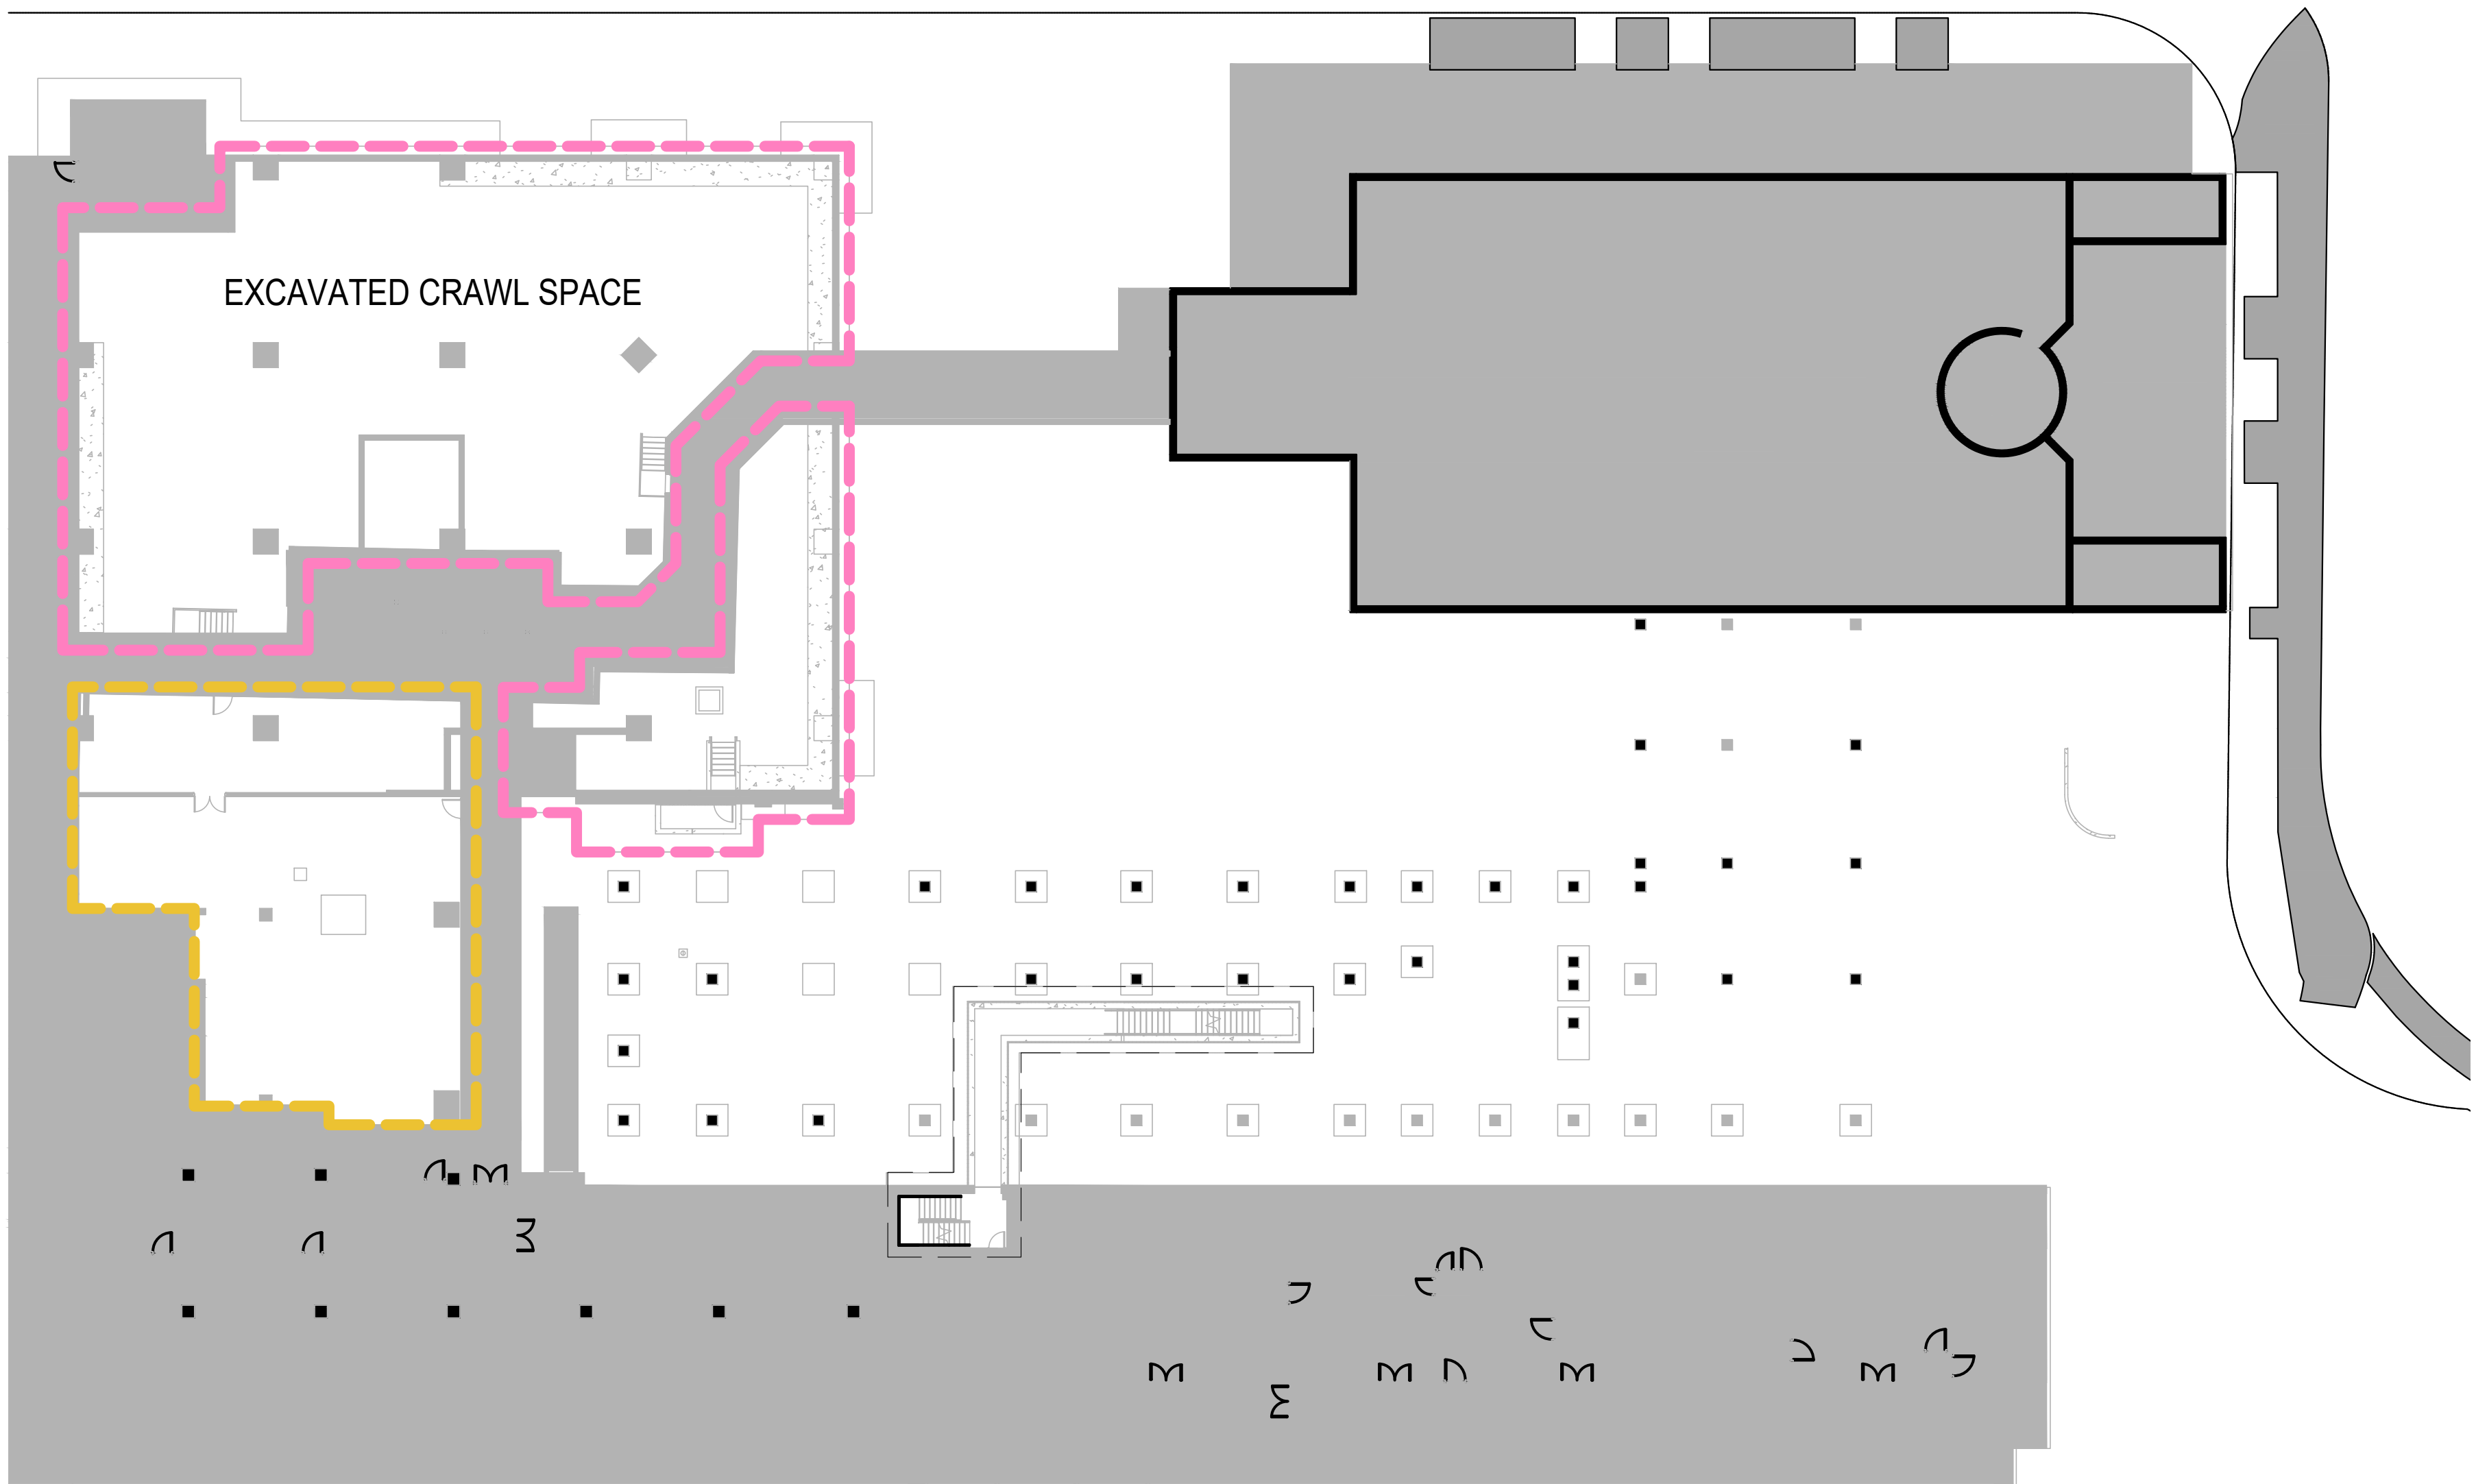

① Separate Price - Basement Plan
1 : 250

NOTE: SEPRATE SCOPE IDENTIFICATION DRAWINGS PREPARED BY ARCH.

CLIENT:




ARCHITECT:



CONSULTANT:



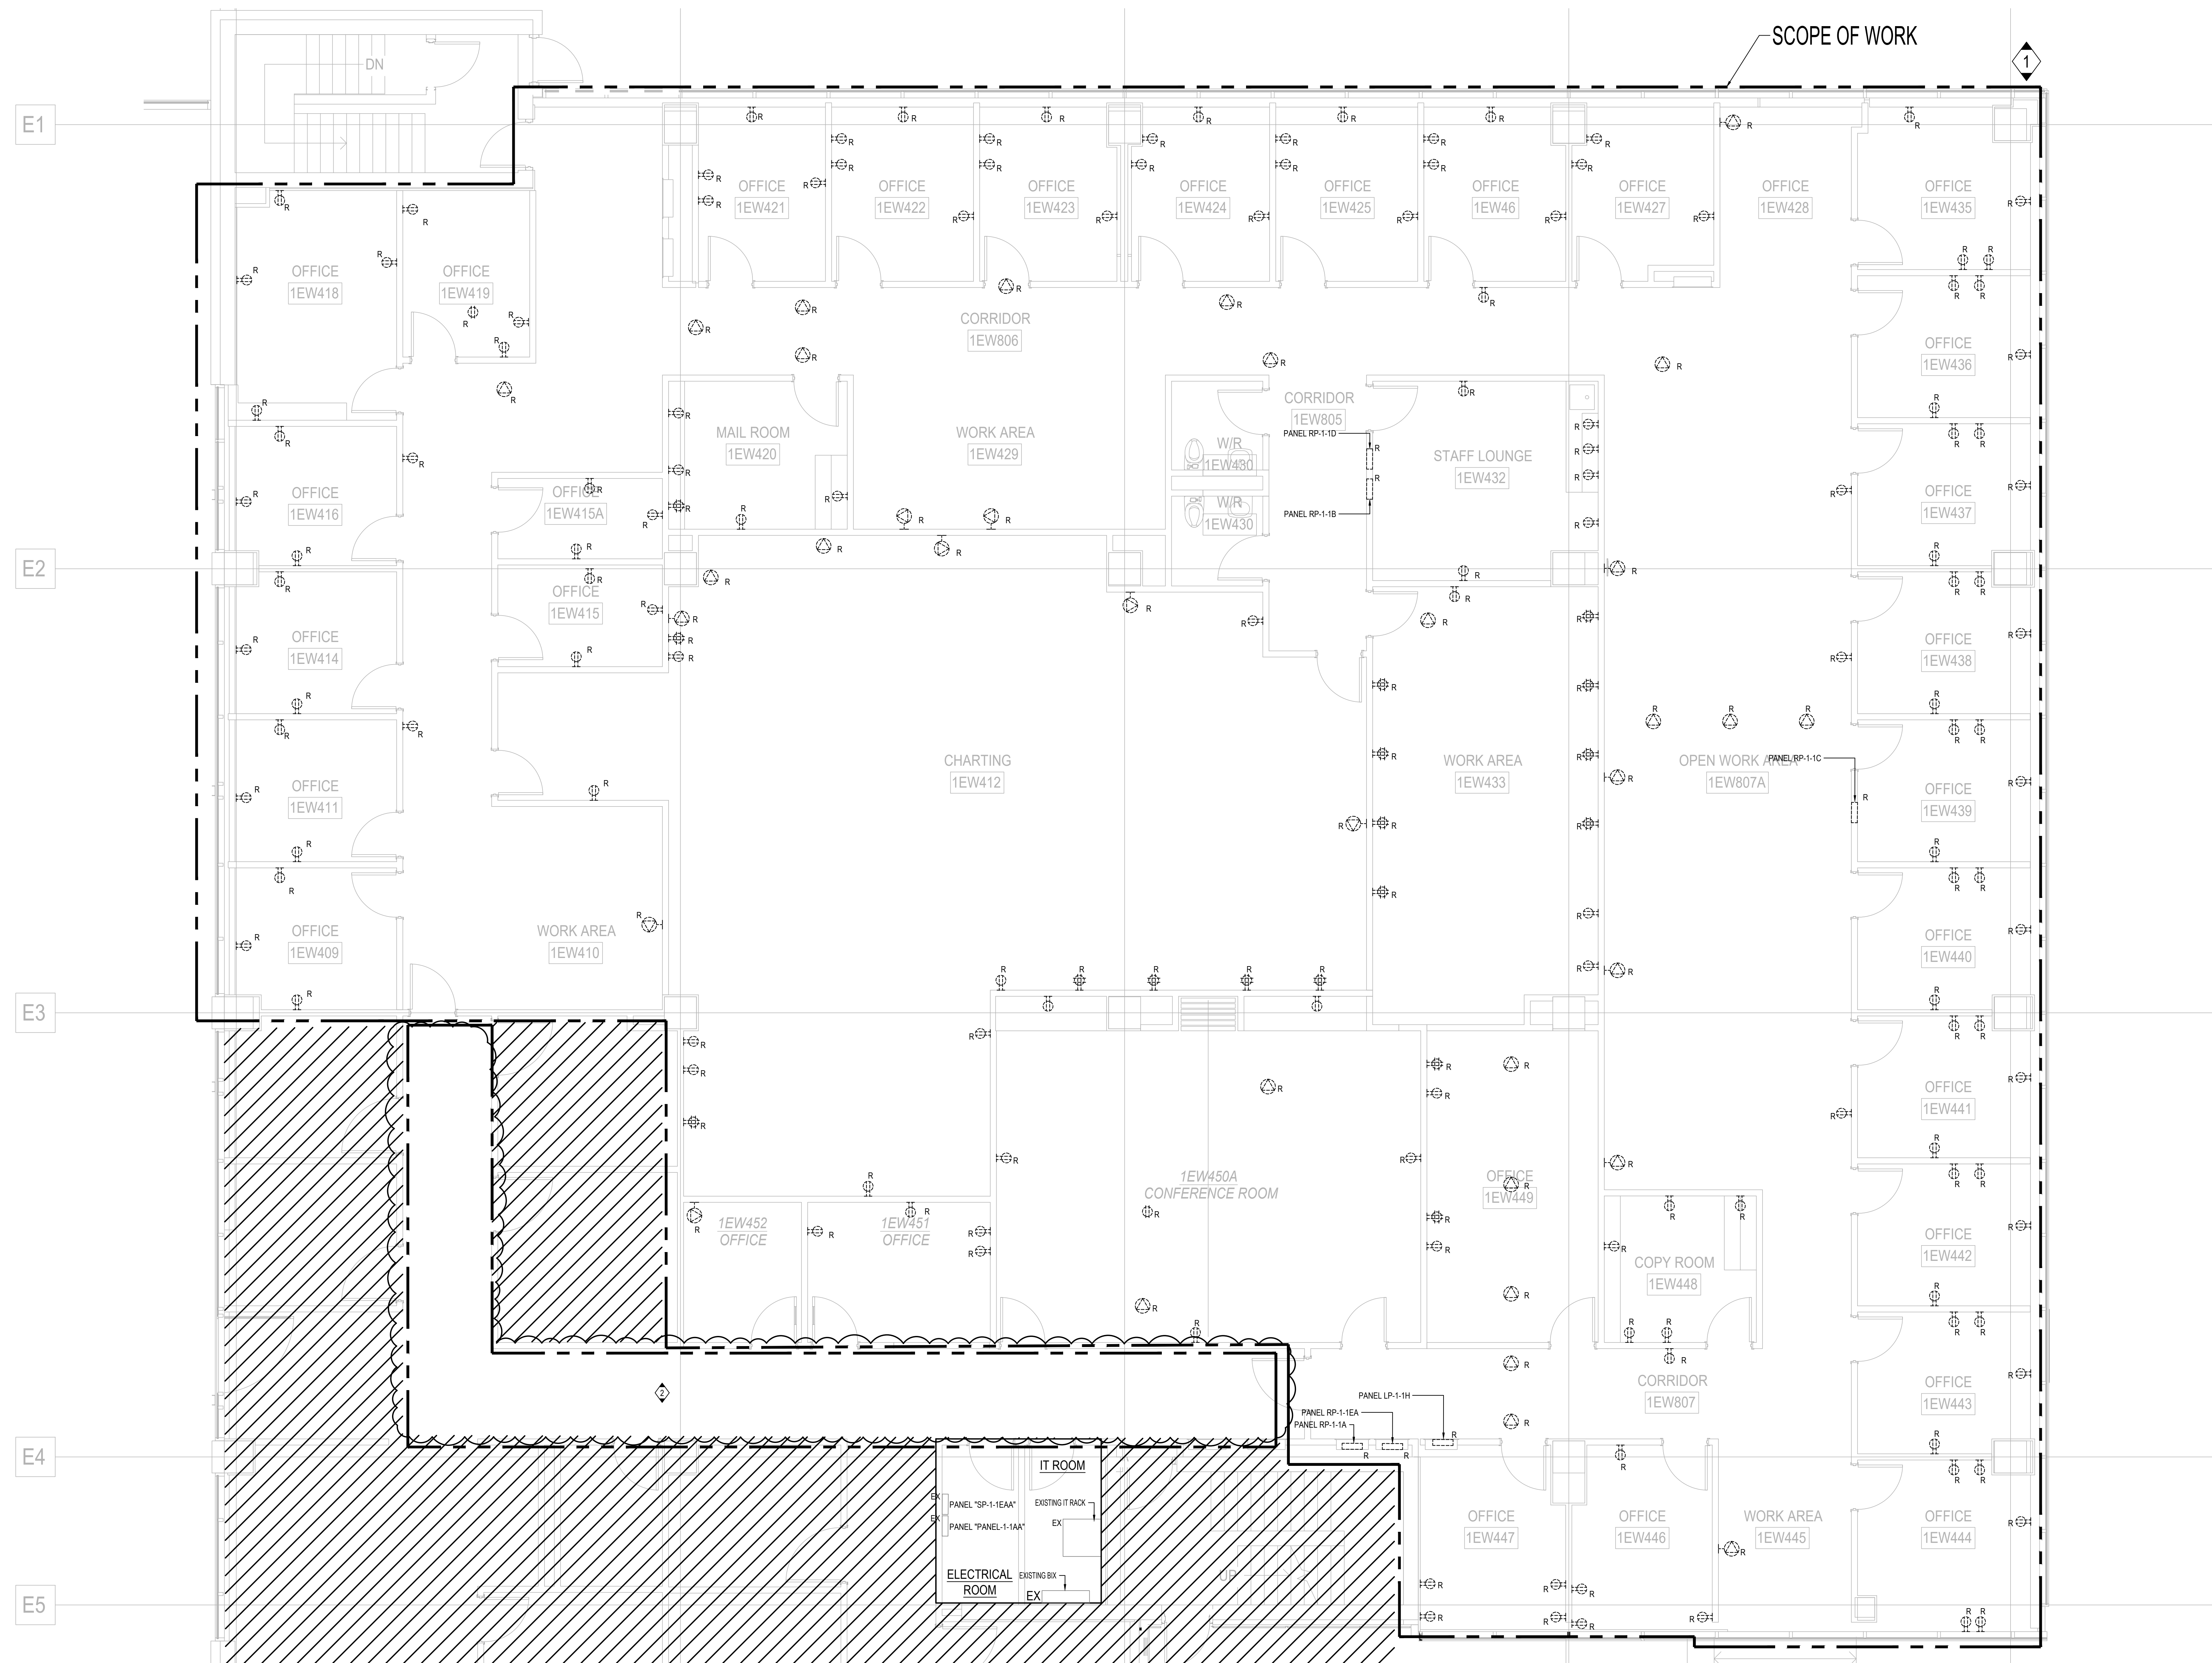

GENERAL NOTES:

1. ALL SERVICES SHOWN ARE DIAGRAMMATIC ONLY. THE ARRANGEMENTS OF EQUIPMENT SHOWN ARE APPROXIMATE AND EXACT LOCATION AND QUANTITY SHALL BE DETERMINED BY THE CONSULTANT.
2. THIS DRAWING IS TO BE READ IN CONJUNCTION WITH ARCHITECTURAL AND MECHANICAL SPECIFICATIONS. ALL AREAS OF CONFLICT SHALL BE BROUGHT TO THE ATTENTION OF THE CONSULTANT PRIOR TO COMMENCING WORK.
3. ALL EQUIPMENT AND DEVICES ON THIS DRAWING ARE EXISTING TO BE REMOVED AND REPLACED BY EQUIPMENT TO BE PROVIDED BY THE CONTRACTOR. THE CONTRACTOR SHALL REMOVE AND WIRING BACK TO THE SOURCE PANEL. ELECTRICAL CONTRACTOR TO NOTE THAT THE LAYOUTS AND DEVICES SHOWN ARE NOT TO SCALE. THE CONTRACTOR SHALL VERIFY THE LOCATION AND THAT NOT ALL DEVICES ARE SHOWN. ELECTRICAL CONTRACTOR TO SITE VERIFY THE QUANTITY OF DEVICES TO BE DEMOLISHED AND PERSONS DEMOLITION WORK ACCORDINGLY.
4. FOLLOWING DEMOLITION AND REMOVAL OF EXISTING CELINGS, THE CONTRACTOR SHALL REMOVE ALL EXISTING REDUNDANT AND UN-USED LINE AND DISCONNECT ALL WIRING. THE CONTRACTOR SHALL BE REQUIRED TO REMAIN IN OPERATION SHALL BE PROPERLY FASTENED/SUSPENDED FROM THE EXISTING CEILING. THE CONTRACTOR SHALL PROVIDE COVER SHEET PROVIDED WITH SUITABLE COVER PLATES.
5. ELECTRICAL CONTRACTOR TO ENSURE ALL ELECTRICAL, LIFE SAFETY SERVICES AND SERVICES FOR EXISTING EQUIPMENT THAT ARE REQUIRED TO REMAIN IN SERVICE SHALL REMAIN OPERATIONAL DURING ENTIRE CONSTRUCTION.
6. WHEN EQUIPMENT OR DEVICES ARE REMOVED, CUT BACK AND REMOVE CONDUIT AND REMOVED EQUIPMENT. THE CONTRACTOR SHALL REMOVE ALL EXISTING EQUIPMENT TO REMAIN. THE CONTRACTOR SHALL REPLACE/RE-ROUTED BRANCH

8. THE CONTRACTOR SHALL ENSURE CONTINUITY OF OPERATION OF REMAINING EQUIPMENT.
9. THE WORKING SHALL BE AWARES THAT NOT ALL EXISTING EQUIPMENT AND DEVICES REQUIRED TO BE REMOVED ARE NECESSARILY INDICATED ON THIS PLAN. THE CONTRACTOR SHALL STILL BE RESPONSIBLE FOR REMOVING ALL EXISTING EQUIPMENT AND DEVICES NOT INDICATED ON THIS PLAN. THE CONTRACTOR SHALL BE RESPONSIBLE TO FACILITATE THE REMOVAL OF ALL DEVICES AND EQUIPMENT AS REQUIRED TO FACILITATE THE COMPLETE DEMOLITION.
10. ELECTRICAL CONTRACTOR TO ENGAGE THE BASE BUILDING FIRE ALARM CONTRACTOR TO COORDINATE WITH THE BASE BUILDING FIRE ALARM CONTRACTOR FOR THE FIRE ALARM WORK WITHIN THE SCOPE OF THIS PROJECT.
11. SITE VISY REQUIRED CUFFLOORS/CLIMBERS, REMOVE ALL CONDUITS AND CABLE BACK TO SOURCE. PROVIDE PROPER SEAL AND GRIND SMOOTH FOR THE CLOSURES.
12. FIRE ALARM
 - 11.1 DURING WORK TO THE EXISTING FIRE ALARM SYSTEM THE TEAM 11.2 DURING OF INTERUPTION SHALL BE APPROVED BY THE OWNER & THE CITY. 11.3 1. ZONE 1 SHALL BE INTENTED TO BE MAINTAINED THROUGHOUT THE WORK WHERE THE RENOVATION WORK REQUIRED SHOWS OUTSIDE OF ANY PART OF THE EXISTING PROTECTING AREA. THE CONTRACTOR SHALL BE RESPONSIBLE FOR PROTECTION (FIRE WARDEN) BY MEANS OF SUPERVISING THE AREA AS WELL AS THE PROTECTING AREA. THE CONTRACTOR SHALL BE RESPONSIBLE FOR THE FIRE ALARM SYSTEM ANY 1. ZONE BE LEFT NEPTROVING/OVERNIGHT.
 - 11.4 THE CONTRACTOR SHALL BE REQUIRED BY TEMPORARY WORKING AS MAY BE REQUIRED TO MAINTAIN ALL PARTS OF THE FIRE ALARM SYSTEM OPERATIVE DURING CONSTRUCTION & 1. ALTERATIONS.
 - 11.5 MAINTAIN EXISTING FIRE ALARM SYSTEM, PULL STATIONS, EXIT SIGNS AND SMOKE DETECTORS. THE CONTRACTOR SHALL BE RESPONSIBLE FOR THE DEVICES WHERE DISRUPTION TO LIFE SAFETY SYSTEM ARE REQUIRED. PROVIDE CONTINUOUS MONITORING DURING SHUT DOWN PERIOD AND REPAIR THE SYSTEM TO THE EXISTING STATE.

- [illegible]

13. ENSURE CREDIT INTEGRITY FOR ALL BRANCH CIRCUITS SERVING AREAS OUTSIDE OF SCOPE OF WORK. TRANSFER CIRCUITS TO EXISTING TO BE REMAINED PANELS AS REQUIRED TO KEEP OUT OF SCOPE SERVICES OF OPERATION.
14. TELECOMMUNICATIONS: ACCESS CONTROL, PAGING AND SECURITY:
 - a. EXISTING DATA OUTLETS, JACKS, FACEPLATES, INDICATORS, CABLES, CORDING, CABLES AND ASSOCIATED SUPPORT WITHIN AREA OF WORK TO BE REMOVED BACK TO THE SOURCE IN COMPLETION OF WORK AND DISCARDED
 - b. WIRELESS ACCESS POINT DEVICES WITHIN SCOPE OF WORK TO BE DISCONNECTED SAFELY AND RETURNED TO OWNER. CONTRACTOR TO CONFIRM EXACT LOCATION AND QUANTITY OF WIRELESS ACCESS POINTS TO BE RETURNED TO THE SOURCE
 - c. ELECTRICAL CONTRACTOR TO VERIFY ALL THE DEVICE LOCATION AND QUANTITY OF ACCESS POINTS TO BE RETURNED TO THE SOURCE
 - d. HATCHED AREA INDICATES EXISTING SERVICES WITHIN THIS SPACE TO BE REMOVED TO THE SOURCE OPERATIONAL FOR THE ENTIRE DURATION OF CONSTRUCTION
 - e. EXISTING PAGING SYSTEMS, CABLES AND CONDUITS WITHIN AREA OF WORK TO BE REMOVED TO THE SOURCE
 - f. EXISTING PAGING SYSTEMS, CABLES AND CONDUITS WITHIN AREA NECESSARY TRIPPING TO ENSURE NOT AFFECTING EXISTING OPERATION OF EXISTING FLOORS
15. NURSE CALL:
 - a. EXISTING NURSE CALL DEVICES AND ASSOCIATED WIRING, CONDUITS ETC. WITHIN AREA OF DEMOLITION TO BE DISCONNECTED AND REMOVED BACK TO THE SOURCE
16. MASTER CLOCK:
 - a. EXISTING MASTER CLOCK DEVICES AND ASSOCIATED WIRING, CONDUITS ETC. WITHIN AREA OF DEMOLITION TO BE DISCONNECTED AND REMOVED BACK TO THE SOURCE.

- SCOPE OF WORK AREA. DEVICES THESE AREAS ARE EXISTING TO BE REMOVED UNLESS NOTED OTHERWISE.
2. AREA CONNECTING THE EXISTING ELECTRICAL AND IT ROOMS POSSIBLE REQUIRED FOR REMOVING WIRING AND CONDUIT.
- REINSTATE CEILING AFTER DEMOLITION NEW WORK

KEY NOTES:


- SCOPE OF WORK AREA. DEVICES THESE AREAS ARE EXISTING TO BE REMOVED UNLESS NOTED OTHERWISE.
2. AREA CONNECTING THE EXISTING ELECTRICAL AND IT ROOMS POSSIBLE REQUIRED FOR REMOVING WIRING AND CONDUIT.
- REINSTATE CEILING AFTER DEMOLITION NEW WORK

CLIENT



**University Health Network
Toronto Western Hospital
399 Bathurst Street
Toronto ON M5T 2S8
www.uhn.ca**

ARCHITECT

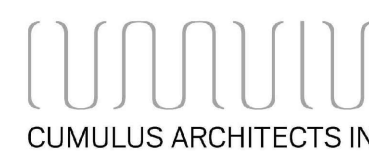

160 Pears Ave. - Suite 300
Toronto, ON M5R 3P8
416-539-0763
www.cumulusarch.com

CONSULTANT:



t: 905.696.3217 | f: 905.696.016
220 Commerce Valley Drive West
Markham, ON L3T 0A8

WWW.QXD.COM

• BUILDINGS • EARTH & ENVIRONMENT • ENERGY •
• INDUSTRIAL • INFRASTRUCTURE • SUSTAINABILITY •

PROJECT STATUS:	
-----------------	--

REVISIONS

NO	DESCRIPTION	DATE
1	Issued for Design Development Progress	2024.04.01
2	Issued for 100 DD	2024.05.01
3	Issued for 50% CD / Permit	2024.08.01
4	Issued for 90% CD	2024.09.01
5	Issued for 100% CD	2024.09.01
6	Issued for Tender	2024.10.01
7	Issued for Tender Addendum No.4	2024.11.01
8	Issued for Tender Addendum No.5	2024.11.01

PROJECT:
UHN TWH - Seniors Emergency Medicine Centre
399 Bathurst Street, Toronto ON M5T 2S8
UHN PROJECT NO.: SAP #110022016

TITLE:

LEVEL 1 FLO


[illegible]

MDK 22004200

CHECKED:

M.S.

E-102

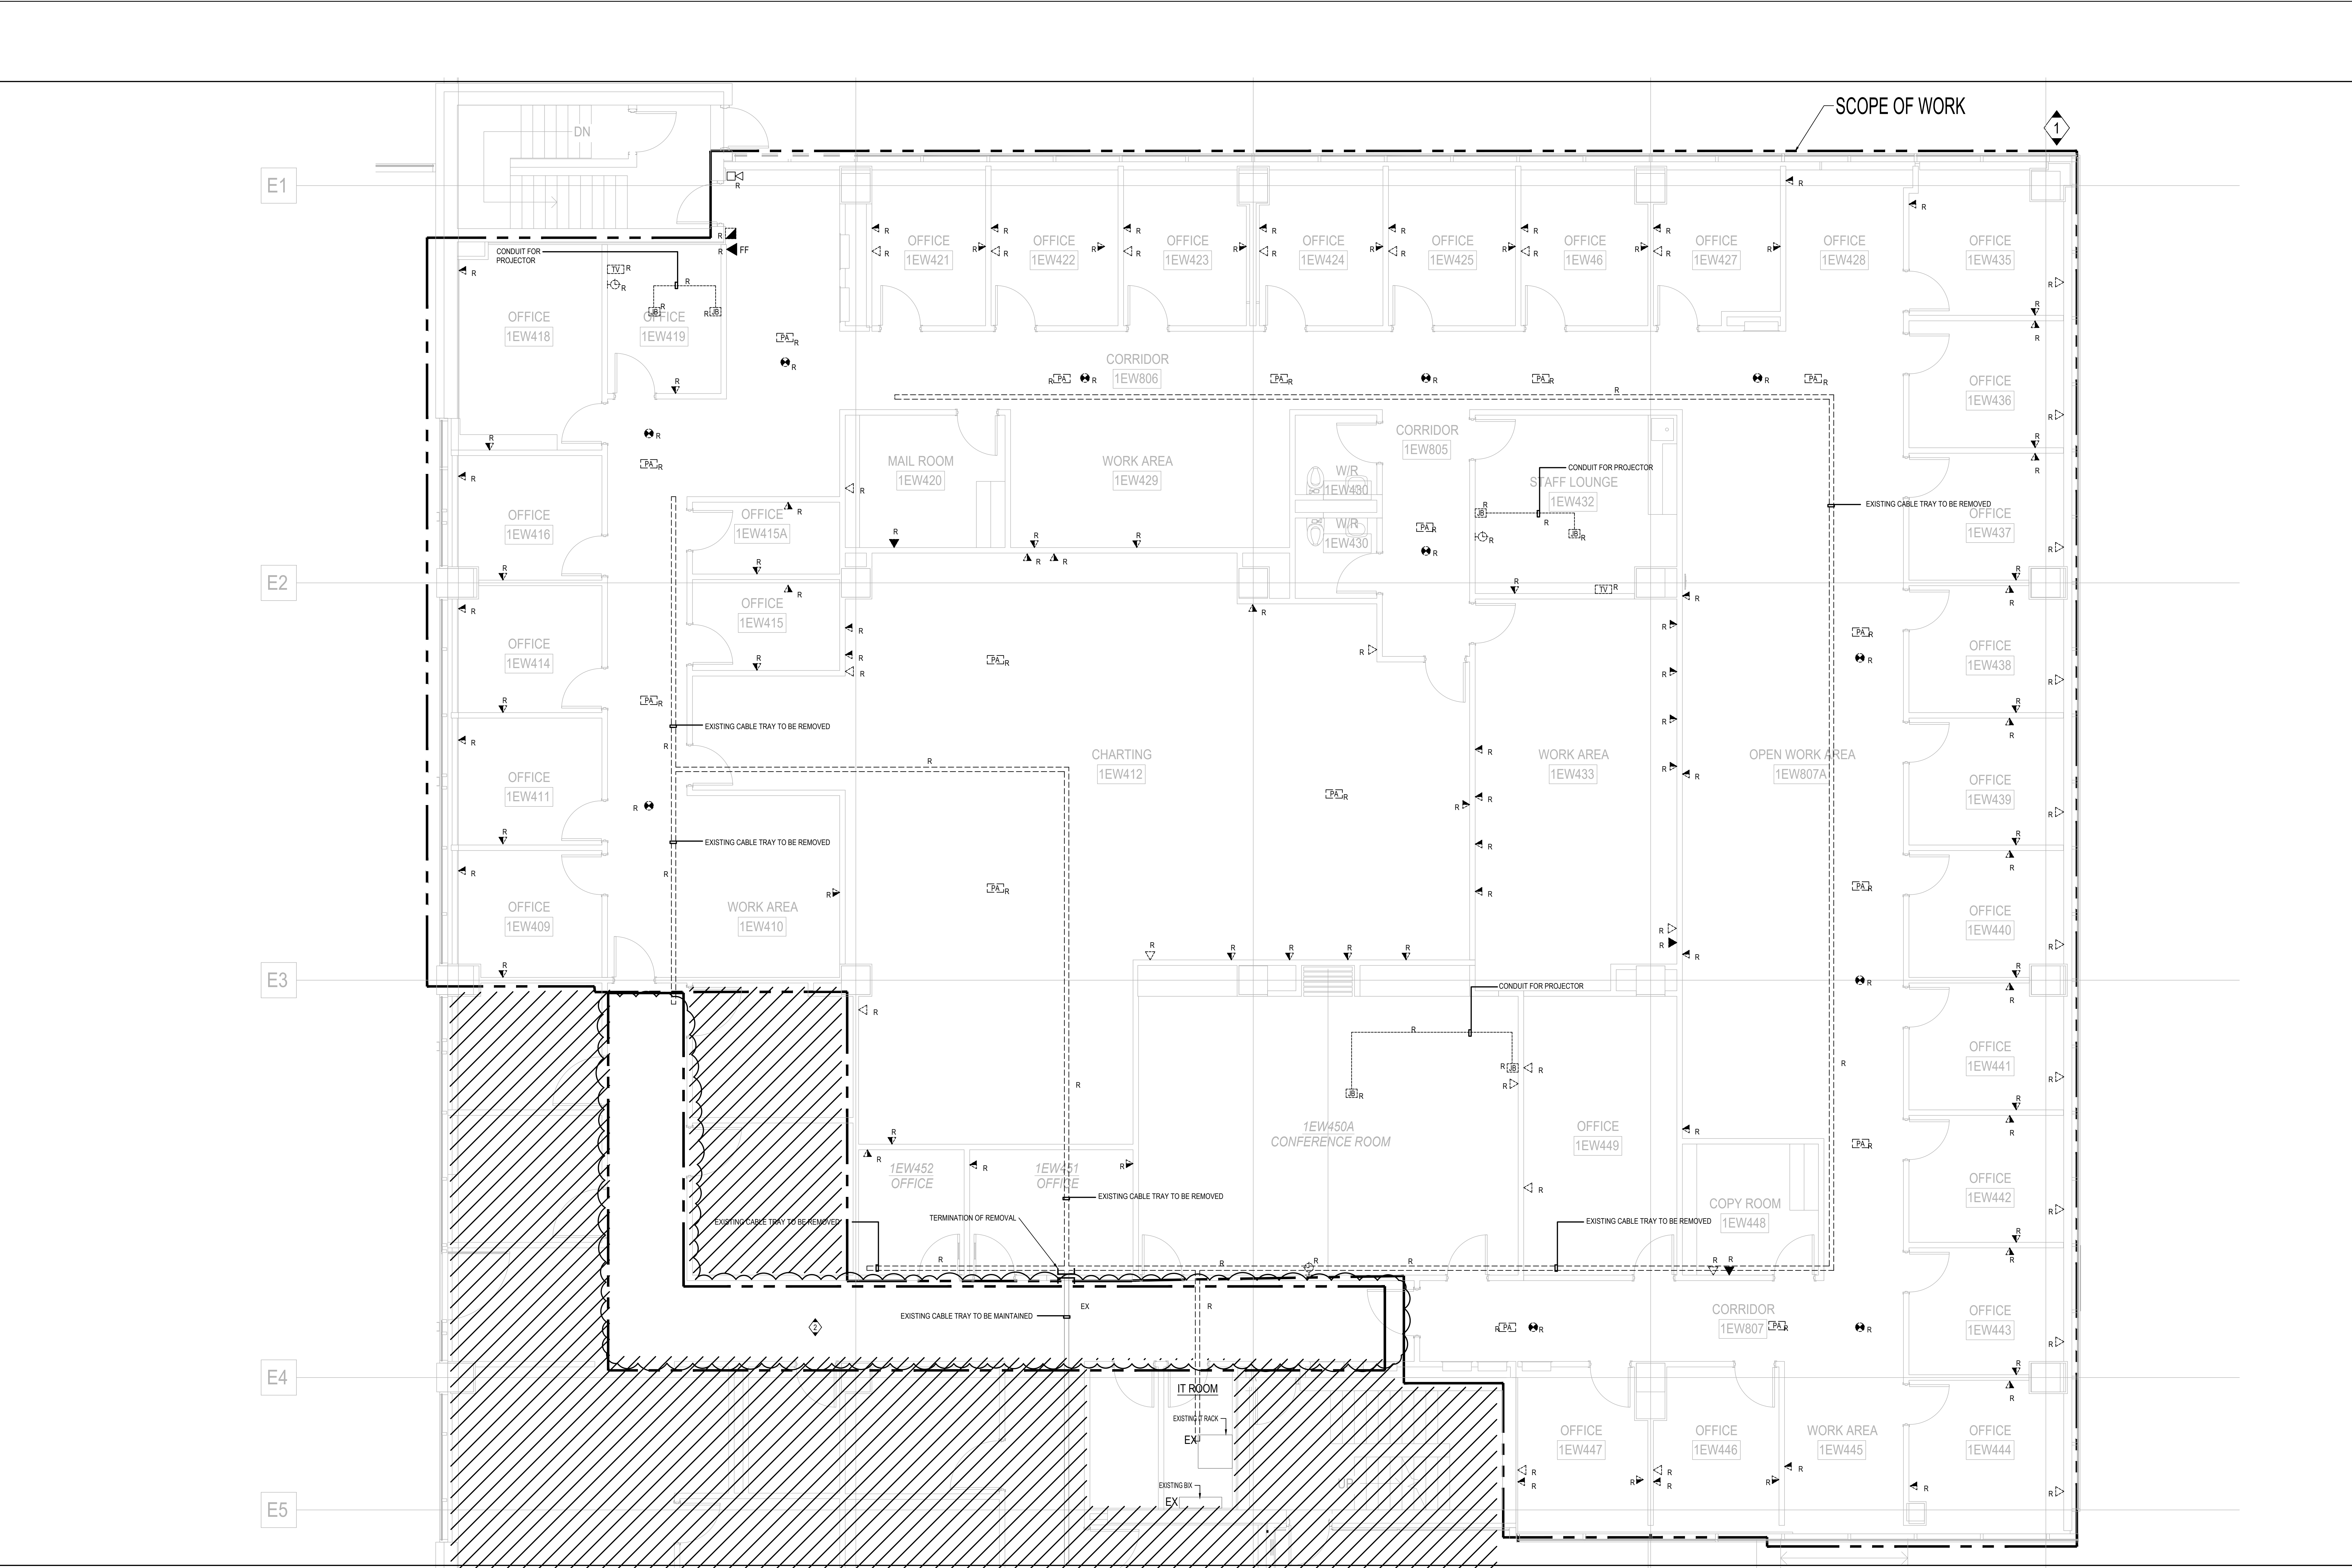

GENERAL NOTES:

- ALL SERVICES SHOWN ARE DIAGRAMMATIC ONLY. THE ARRANGEMENTS OF EQUIPMENT SHOWN ARE APPROXIMATE AND EXACT LOCATION AND QUANTITY SHALL BE VERIFIED ON SITE.
- THIS DRAWING IS TO BE READ IN CONJUNCTION WITH ARCHITECTURAL AND MECHANICAL DRAWINGS. ALL AREAS OF CONFLICT SHALL BE BROUGHT TO THE ATTENTION OF THE CONSULTANT PRIOR TO COMMENCING WORK.
- ALL EQUIPMENT AND DEVICES ON THIS DRAWING ARE EXISTING TO BE DISCONNECTED AND REMOVED OR RELOCATED UNLESS NOTED OTHERWISE. CUT BACK AND REMOVE CONDUIT AND WIRING BACK TO THE SOURCE PANEL. ELECTRICAL CONTRACTOR TO NOTE THAT THE LAYOUTS AND DEVICES SHOWN ARE FROM AS-BUILT DRAWINGS AVAILABLE AT THE TIME OF DRAFTING AND NOT ALL DEVICES ARE SHOWN. ELECTRICAL CONTRACTOR TO SITE VERIFY EXACT QUANTITY OF DEVICES TO BE DEMOLISHED AND PERFORM DEMOLITION WORK ACCORDINGLY.
- FOLLOWING DEMOLITION AND REMOVAL OF EXISTING CEILING, THE CONTRACTOR SHALL REMOVE ALL EXISTING REDUNDANT AND UNUSED LINE VOLTAGE AND LOW VOLTAGE WIRING. EXISTING WIRING THAT IS REQUIRED TO REMAIN IN OPERATION SHALL BE PROPERLY FASTENED/SUSPENDED FROM THE CEILING. ANY EXISTING JUNCTION BOXES WITHOUT COVERS SHALL BE PROVIDED WITH SUITABLE COVER PLATES.
- ELECTRICAL CONTRACTOR TO ENSURE ALL ELECTRICAL LIFE SAFETY SERVICES AND SERVICES FOR EXISTING EQUIPMENT THAT ARE REQUIRED TO REMAIN IN SERVICE SHALL REMAIN OPERATIONAL DURING ENTIRE CONSTRUCTION.
- WHERE EQUIPMENT OR DEVICES ARE REMOVED, CUT BACK AND REMOVE CONDUIT AND WIRING BACK TO SOURCE PANEL.
- WHERE REMOVED EQUIPMENT AFFECTS THE OPERATION OF EXISTING EQUIPMENT TO REMAIN, THE CONTRACTOR SHALL RE-ACCEPT/TEST BRANCH

WIRING AS REQUIRED TO ENSURE CONTINUITY OF OPERATION OF REMAINING EQUIPMENT.

- THE CONTRACTOR SHALL BE AWARE THAT NOT ALL EXISTING EQUIPMENT AND DEVICES REQUIRED TO BE REMOVED ARE NECESSARILY INDICATED ON THIS PLAN. THE CONTRACTOR SHALL STILL BE RESPONSIBLE FOR REMOVING ALL SUCH EQUIPMENT INCLUDING BUT NOT LIMITED TO WIRING AND CONDUITS AS REQUIRED TO FACILITATE THE COMPLETE DEMOLITION.
- ELECTRICAL CONTRACTOR TO ENGAGE THE BASE BUILDING FIRE ALARM CONTRACTOR FOR ANY FIRE ALARM WORK WITHIN THE SCOPE OF THIS PROJECT.
- SITE VERIFY EXISTING OUTFLOOR/SUB CONDUITS. REMOVE ALL CONDUITS AND CABLE BACK TO SOURCE. PROVIDE PROPER SEAL AND GRAND SMOOTH FOR THE OPENING.
- FIRE ALARM
DURING WORK TO THE EXISTING FIRE ALARM SYSTEM THE TIME & DURATION OF INTERRUPTION SHALL BE APPROVED BY THE OWNER & ONLY 1 ZONE SHALL BE INTERRUPTED AT ANY TIME. IN ALL AREAS WHERE THE RENOVATION WORK REQUIRES SHUTDOWN OF ANY PART OF THE FIRE ALARM PROTECTION SYSTEM, PROVIDE MANUAL FIRE ALARM PROTECTION (FIRE WARDEN) BY MEANS OF SUPERVISING THE AREA AS APPROVED BY GOVERNING AUTHORITIES. AT NO TIME SHALL THE FIRE ALARM SYSTEM OR ANY 1 ZONE BE LEFT INOPERATIVE OVERNIGHT. PROVIDE ALL REQUIRED BYPASS WIRING & TEMPORARY WIRING AS MAY BE REQUIRED TO MAINTAIN ALL PARTS OF THE FIRE ALARM SYSTEM OPERATIVE DURING CONSTRUCTION & ALTERATIONS.
- ALL EXISTING FIRE ALARM ZONES TO BE MAINTAINED.
- MAINTAIN EXISTING FIRE ALARM SYSTEM PULL STATIONS, EDT SIGNS AND EMERGENCY LIGHTS IN FULL OPERATION BEFORE INSTALLATION OF NEW DEVICES. WHERE DISRUPTION TO LIFE SAFETY SYSTEM ARE REQUIRED, PROVIDE CONTINUOUS MONITORING DURING SHUT DOWN PERIOD AND ENSURE THAT ALL SYSTEMS ARE REACTIVATED PRIOR TO LEAVING THE

SITE AT THE END OF EACH WORKING DAY.

- WHEN FIRE ALARM SYSTEM WORK IS COMPLETE & READY FOR ACCEPTANCE, PROVIDE & ARRANGE FOR INDEPENDENT TESTING COMPANY (P/NO) AS APPROVED BY THE OWNER. EXISTING FIRE ALARM MAINTENANCE CONTRACTOR TO INSPECT, TEST & CERTIFY EQUIPMENT INCLUDING INITIATING DEVICES, SIGNALING DEVICES, CONTROL DEVICES & WIRING. CONDUCT WORK IN ACCORDANCE WITH LATEST EDITIONS OF CANULC 5508-A & 5507. TESTS TO BE CONDUCTED IN PRESENCE OF OWNER & OR CONSULTANT. CERTIFY SYSTEM AND PROVIDE 3 COPIES OF SIGNED VERIFICATION REPORT.
- THE TESTING COMPANIES MUST EMPLOY TECHNICIANS CERTIFIED BY CANADIAN FIRE ALARM ASSOCIATION & OR ONTARIO FIRE MARSHALL, AS APPLICABLE.
- LIGHTING
EXISTING LUMINAIRES, WIRING & CONDUITS WITHIN AREA OF DEMOLITION TO BE REMOVED BACK TO THE SOURCE AND DISCARDED. REFER TO ARCHITECTURAL DRAWINGS FOR EXISTING LAYOUT. EXACT QUANTITY TO BE CONFIRMED ON SITE BY ELECTRICAL CONTRACTOR.
- EXISTING LIGHTING SWITCHES, WIRING AND CONDUITS WITHIN AREA OF DEMOLITION TO BE REMOVED BACK TO THE SOURCE AND DISCARDED.
- EXISTING EXIT SIGNAGE, WIRING AND CONDUITS WITHIN AREA OF DEMOLITION TO BE REMOVED BACK TO THE SOURCE AND DISCARDED.
- ELECTRICAL CONTRACTOR TO VERIFY ALL THE DEVICE LOCATION AND QUANTITY ON SITE AND PERFORM DEMOLITION WORK ACCORDINGLY. HATCHED AREA INDICATES EXISTING SERVICES WITHIN THIS SPACE TO REMAIN AS EXISTING AND TO BE OPERATIONAL FOR THE ENTIRE DURATION OF CONSTRUCTION.
- POWER
EXISTING POWER OUTLETS, FACEPLATES, BACKBOXES, WIRING AND CONDUITS (IF ANY) WITHIN AREA OF DEMOLITION TO BE REMOVED BACK TO THE SOURCE AND DISCARDED.
- ELECTRICAL CONTRACTOR TO VERIFY ALL THE DEVICE LOCATION AND QUANTITY ON SITE AND PERFORM DEMOLITION WORK ACCORDINGLY.

- ENSURE CIRCUIT INTEGRITY FOR ALL BRANCH CIRCUITS SERVING AREAS OUTSIDE OF SCOPE OF WORK. TRANSFER CIRCUITS TO EXISTING TO BE REMAINED PANELS AS REQUIRED TO KEEP OUT OF SCOPE SERVICES OPERATIONAL.
- COMMUNICATIONS, ACCESS CONTROL, PAGING AND SECURITY:
EXISTING DATA OUTLETS, JACKS, FACEPLATES, BACKBOXES, HORIZONTAL CABLING, CONDUITS AND ASSOCIATED SUPPORTING WITHIN AREA OF DEMOLITION TO BE REMOVED BACK TO THE SOURCE IN COMM. ROOM (13M402) AND DISCARDED.
- WIRELESS ACCESS POINT DEVICES WITHIN SCOPE OF WORK TO BE DISCONNECTED SAFELY AND RETURNED TO OWNER. CONTRACTOR TO CONFIRM EXACT LOCATION AND QUANTITY OF WIRELESS ACCESS POINTS TO BE DEMOLISHED ON SITE.
- ELECTRICAL CONTRACTOR TO VERIFY ALL THE DEVICE LOCATION AND QUANTITY ON SITE AND PERFORM DEMOLITION WORK ACCORDINGLY. HATCHED AREA INDICATES EXISTING SERVICES WITHIN THIS SPACE TO REMAIN AS EXISTING AND TO BE OPERATIONAL FOR THE ENTIRE DURATION OF CONSTRUCTION.
- EXISTING PAGING SPEAKERS, CABLING AND CONDUITS WITHIN AREA OF DEMOLITION TO BE REMOVED BACK TO THE SOURCE. PROVIDE ALL NECESSARY TESTING TO ENSURE NOT AFFECTING EXISTING OPERATION OF OTHER FLOORS.
- NURSE CALL:
EXISTING NURSE CALL DEVICES AND ASSOCIATED WIRING, CONDUITS ETC. WITHIN AREA OF DEMOLITION TO BE DISCONNECTED AND REMOVED BACK TO THE SOURCE.
- MASTER CLOCK:
EXISTING MASTER CLOCK DEVICES AND ASSOCIATED WIRING, CONDUITS ETC. WITHIN AREA OF DEMOLITION TO BE DISCONNECTED AND REMOVED BACK TO THE SOURCE.


KEY NOTES:

- SCOPE OF WORK AREA - THESE AREAS ARE EXISTING TO BE REMOVED UNLESS NOTED OTHERWISE.
- AREA CONNECTING THE EXISTING ELECTRICAL AND IT ROOMS POSSIBLE REQUIRED FOR REMOVING WIRING AND CONDUIT. REINSTATE CEILING AFTER DEMOLITION NEW WORK.

CLIENT:



ARCHITECT:

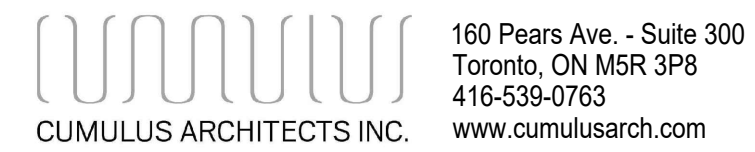

CONSULTANT:



PROJECT STATUS:

REVISIONS

NO.	DESCRIPTION	DATE
1	Issued for Design Development Progress	2024.04.05
2	Issued for 100 CD	2024.05.10
3	Issued for 50% CD / Permit	2024.05.02
4	Issued for 90% CD	2024.09.06
5	Issued for 100% CD	2024.09.27
6	Issued for Tender	2024.10.11
7	Issued for Tender Addendum	2024.10.25
8	Issued for Tender Addendum No.4	2024.11.12
9	Issued for Tender Addendum No.5	2024.11.19

PROJECT:
UHN TWH - Seniors Emergency Medicine Centre
399 Bathurst Street, Toronto ON M5T 2S8
UHN PROJECT NO.: SAP #110022016

TITLE:
LEVEL 1 FLOOR PLAN - DEMO - POWER SYSTEM

PROJECT NO.:
MRK-23004289

CHECKED:
M.S.

DRAWING NO.:
E-103

KEY NOTES:

- EXAM ROOMS: EACH LIGHTING ZONE FOR EXAM ROOM, TUNABLE WHITE WITH LIGHT SWITCH OVERRIDE (AT DOORWAY AND HEAD WALL), CORRIDORS AND EXAM ROOM ARE UNDER THE COLOR TEMPERATURE AND DIMMING LEVEL, UNLESS OVERRIDE BY SWITCHES IN ROOM.
- PATIENT CORRIDORS: TUNABLE WHITE DIMMER AND WARMER IN PM, BRIGHTER IN AM. PROGRAMMED TO TUNE LIGHT THROUGHOUT THE DAY AND DIM AUTOMATICALLY AT NIGHT (TO APPROX 50% BRIGHTNESS). STAFF HAVE CONTROL AT CARE STATION TO TURN ON FULL BRIGHTNESS AT ANY TIME.
- ALCOVES: FOLLOW CORRIDOR BRIGHTNESS AND COLOR TEMPERATURE UNTIL AT NIGHT. TURN OFF AT NIGHT AND BE ABLE TO BRING THE FIXTURES TO 75% BRIGHTNESS WHEN OCCUPANCY SENSOR IS ACTIVATED.
- CARE TEAM STATION 100% BRIGHTNESS WITH DIMMABLE CONTROLS
- SWITCH ON + VACANCY SENSOR, 100% BRIGHTNESS IE. STAFF WILL NEED TO TURN ON LIGHT TO ENTER, WILL TURN OFF AUTOMATICALLY WHEN EMPTY
- STAFF CORRIDORS: FOLLOW CORRIDOR SETTING AND SENSOR BE ABLE TO BRING THE ZONE FIXTURES TO 75% OUTPUT FOR 5 MINUTES AND BACK TO CORRIDOR SETTING.
- OCCUPANCY SENSOR (AUTO ON WHEN DOOR IS OPENED, 30-MINUTE TIMER AUTO-OFF)
- STAFF WC + SHOWER: OCCUPANCY SENSOR (AUTO ON, 30-MINUTE TIMER AUTO-OFF)
- NIGHT LIGHT, TIMER CONTROL, SUNSET TO SUNRISE
- REINSTATE THE CEILING IF ACCESS TO ABOVE CEILING IS REQUIRED DURING DEMO.

REMARKS:
BEFORE PROGRAMMING THE LIGHTING SCENES ON-SITE, CONTRACTOR SHALL VERIFY WITH ENGINEER AND USER FOR FINAL SETTING AND SUIT WITHOUT COST IMPLICATION.

REFER TO DRAWING E302 SECTION 1 FOR CONTINUOUS

PROJECT STATUS:

REVISIONS

NO	DESCRIPTION	DATE
1	Issued for Design Development Progress	2024.04.05
2	Issued for 100 DD	2024.05.10
3	Issued for 50% CD / Permit	2024.08.02
4	Issued for 90% CD	2024.09.06
5	Issued for 100% CD	2024.09.27
6	Issued for Tender	2024.10.11
7	Issued for Tender Addendum	2024.10.25
8	Issued for Tender Addendum No.2	2024.11.01
9	Issued for Tender Addendum No.5	2024.11.19

PROJECT:

UHN TWH - Seniors Emergency Medicine Centre
399 Bathurst Street, Toronto ON M5T 2S8
UHN PROJECT NO.: SAP #110022016

TITLE:

LEVEL 1 FLOOR PLAN - NEW WORK -
LIGHTING LAYOUT

PROJECT NO:

MRK-23004289

CHECKED:


M.S.

DRAWING NO:

E-201

1. LEVEL 1 FLOOR PLAN - NEW WORK - HVAC PIPING



1:50

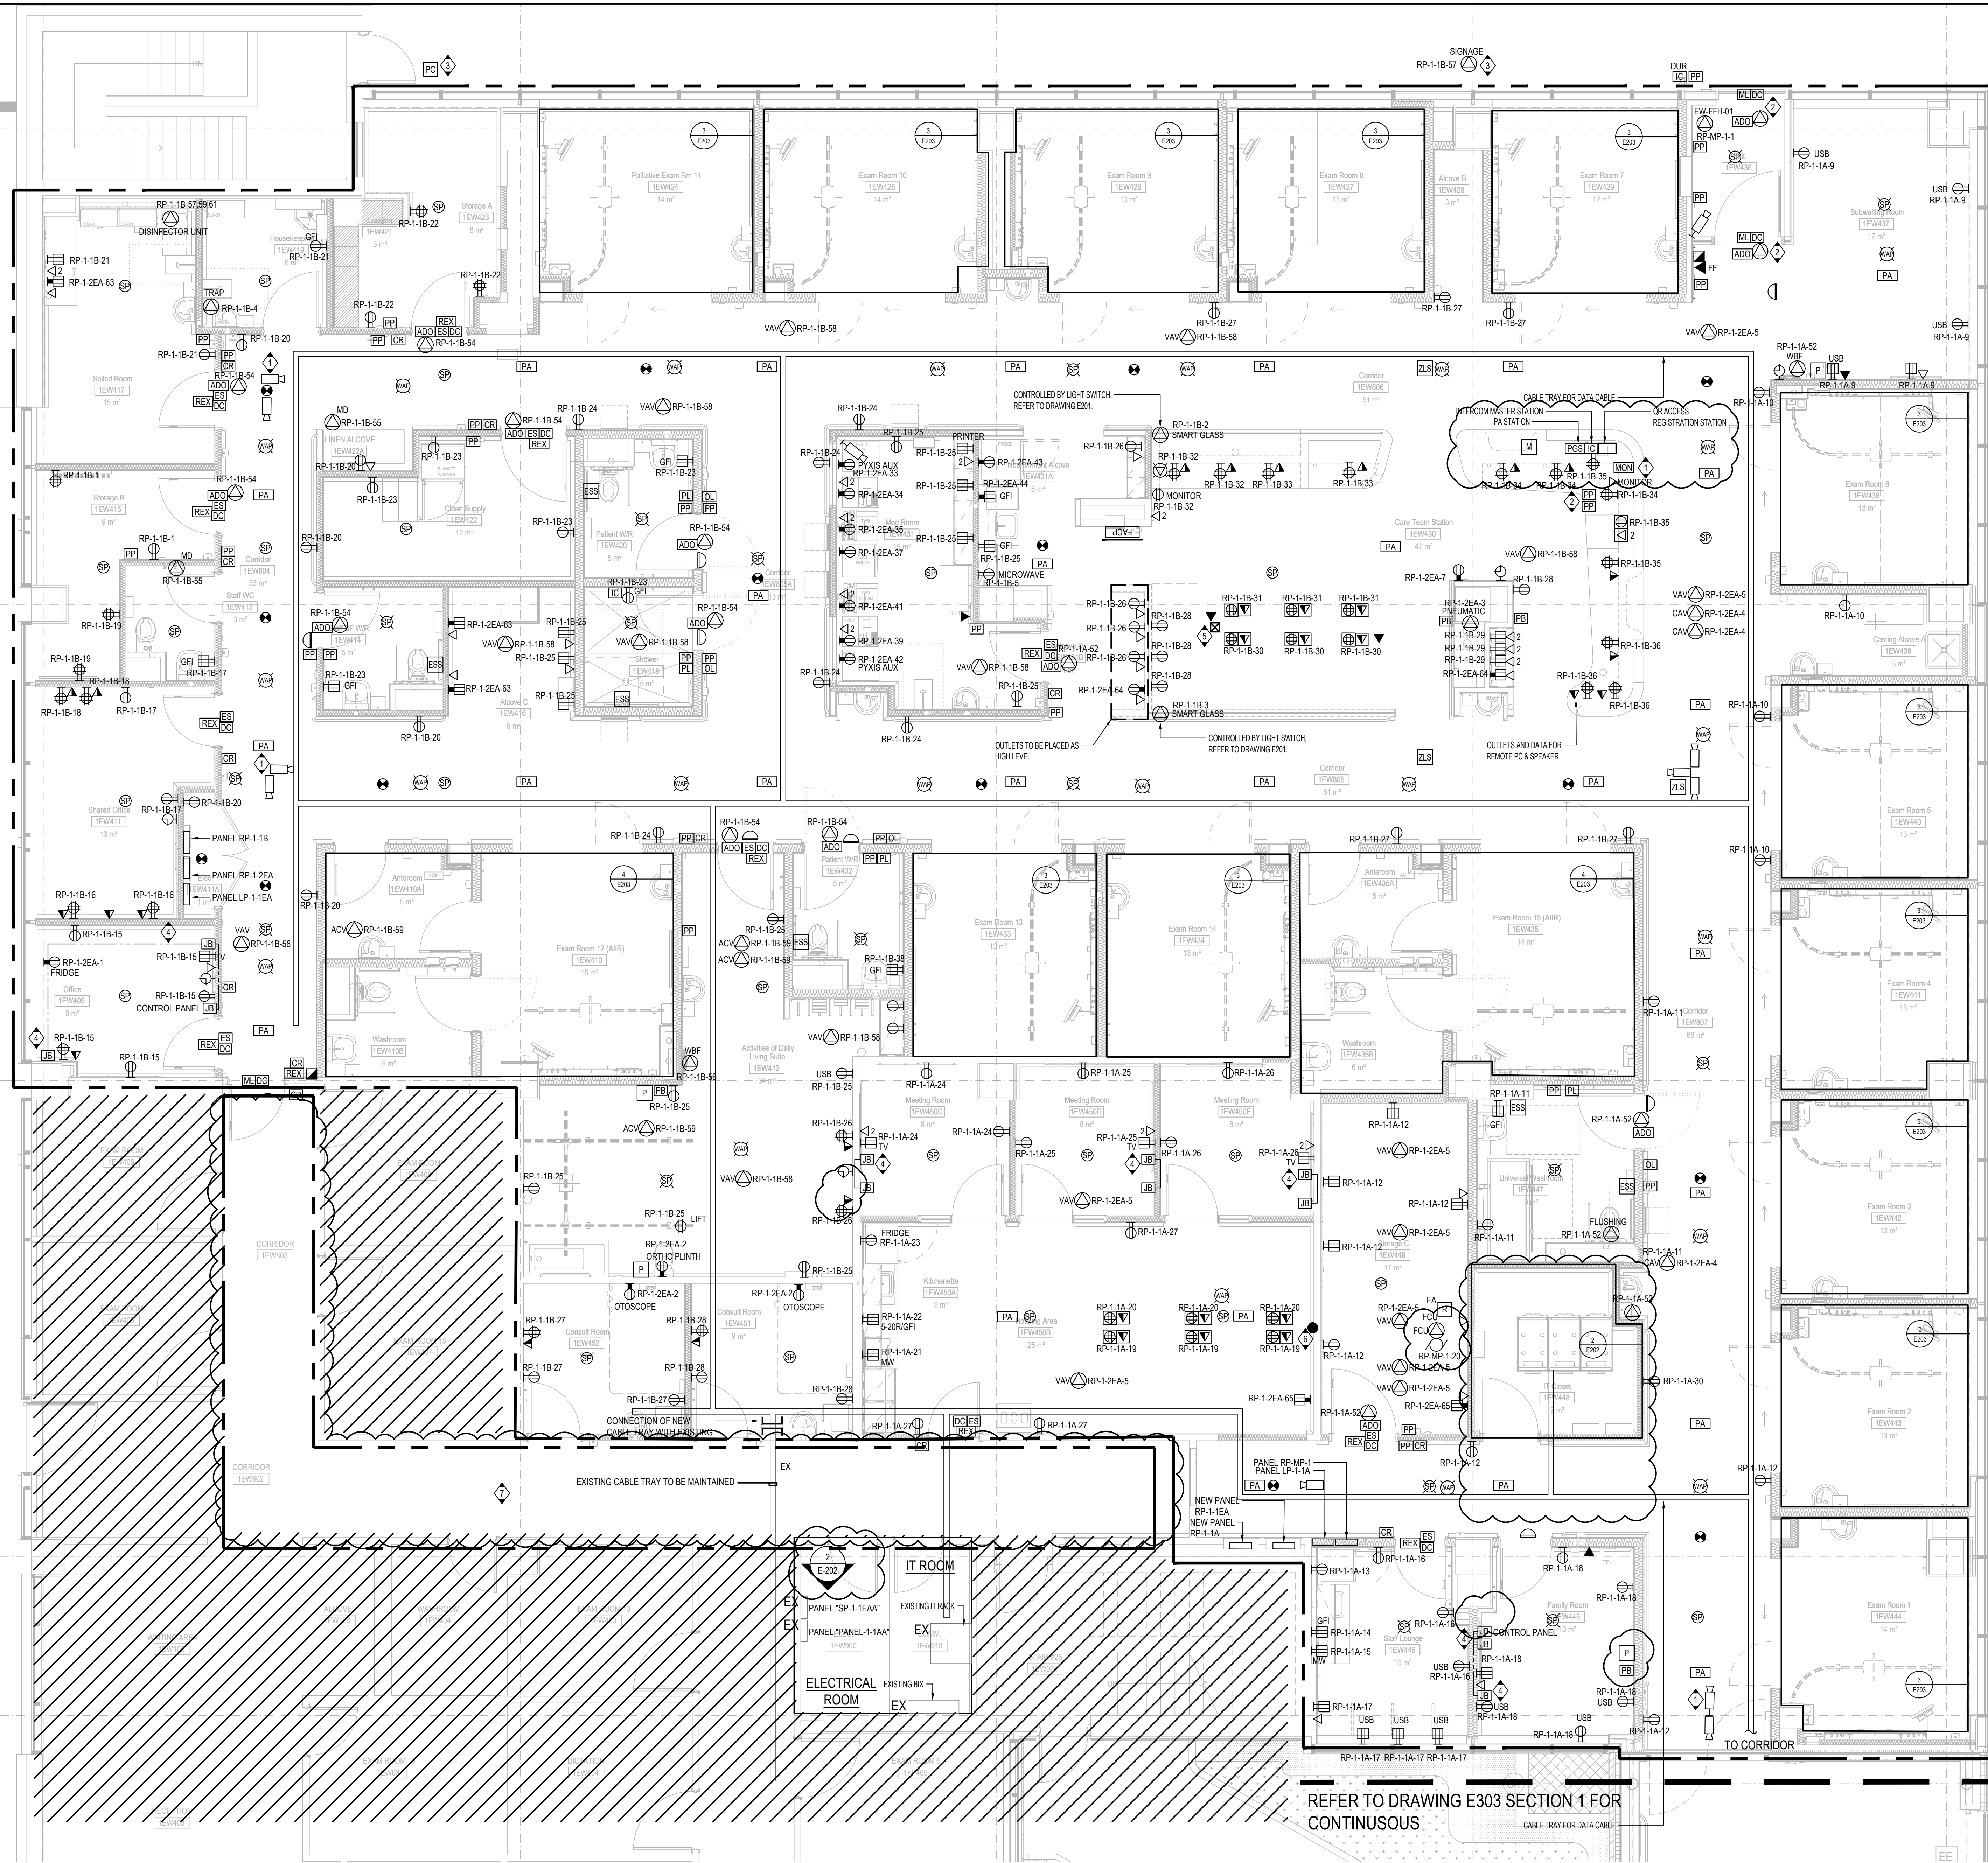

REFER TO DRAWING E303 SECTION 1 FOR CONTINUOUS

- GENERAL NOTES:
- FOR EXISTING ALL THE DATA CABLE, PROVIDE NEW 'J' HOOKS TO SUPPORT.
 - ALL NEW AND EXISTING ELECTRICAL PANELS TO BE REMAINED ARE TO BE PAINTED IN GREY AND RED. FOR NORMAL/ EMERGENCY POWER. REFER TO UHN STANDARDS FOR PAINT CODE CODE. PREP SURFACE FOR NEW FINISH ON EXISTING PANEL AND NEW PANELS TO BE FACTORY APPLIED.
 - PROVIDE NEW LAMACIDS FOR NEW AND EXISTING ELECTRICAL PANELS. REFER TO UHN'S STANDARDS.
 - REFER TO ARCHITECTURE DRAWINGS FOR THE TYPICAL RECEPTACLES AND DATA POINTS HEIGHT.
 - CAMERA PLACEMENT AND VIEW ANGLE TO BE CONFIRMED AND SET WITH UHN SECURITY TEAM
 - MOUNTING HEIGHT OF ELECTRICAL DEVICES/ROUGH-INS FOR AV EQUIPMENT:-
 - MONITOR VARIES. PLEASE REFER TO ARCH DRAWING FOR DETAILS AND COORDINATE WITH UHN ON-SITE.
 - CONTROL PANEL - SAME AS LIGHTING SWITCH.
 - COMPUTER STATION - REFER TO ARCHITECTURAL LAYOUT
 - REFER TO ARCHITECTURAL DRAWINGS FOR THE EXACT MOUNTING HEIGHT OF DATA OUTLETS AND RECEPTACLES

- KEY NOTES:
- THE CCTV IMAGE FOR THREE CAMERAS TO BE SHOWN ON THE MONITOR.
 - UNDER DESK RELEASE BUTTONS WITH LABELING AT NURSE STATION FOR TWO ENTRANCE DOORS. (SDC MODEL D15-2 OR EQUIVALENT)
 - PROVIDE PHOTOCELL CONTROL FOR THE CIRCUIT. LOCATION AS SHOWN.
 - CONTRACTOR SHALL PROVIDE ELECTRICAL INFRASTRUCTURE INCLUDING CONNECTIONS, CONDUITS, BACKBOXES ETC. COORDINATE WITH UHN AND AV CONTRACTOR ON-SITE FOR THE EXACT ROUGH-INS AND POWER REQUIREMENTS. REFER TO ARCH DRAWING FOR DETAILS. ALL CONDUITS FOR AV EQUIPMENT TO BE 3/4" UNLESS SPECIFIED.
 - PROVIDE POWER POLE FOR POWER AND DATA FROM CEILING AND WORK STATION. COORDINATE WITH FURNITURE SUPPLIER FOR CONNECTION DETAILS.
 - PROVIDE ELECTRICAL WHIP FOR SYSTEM FURNITURE. CONTRACTOR TO COORDINATE WITH NEW WHIP LOCATION COLUMN FRONT TO FACE. SITE VERIFY WITH UHN.
 - REINSTATE THE CEILING IF ACCESS TO ABOVE CEILING IS REQUIRED DURING DEMO.

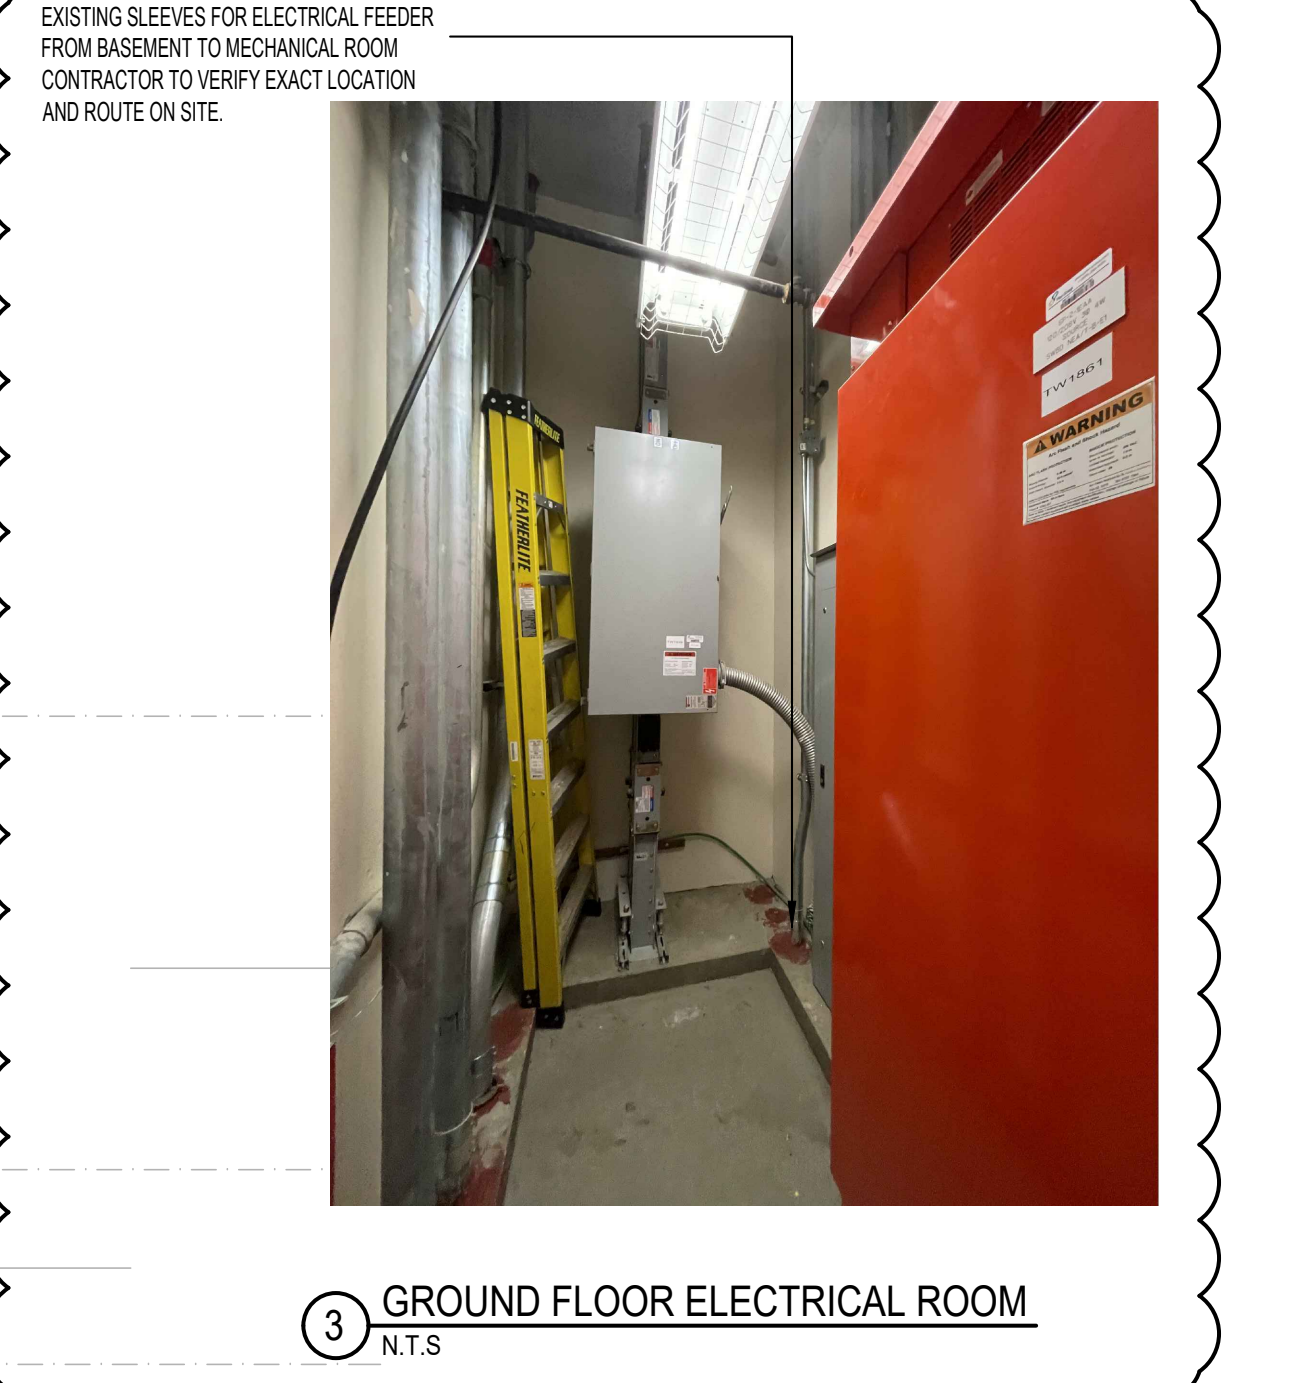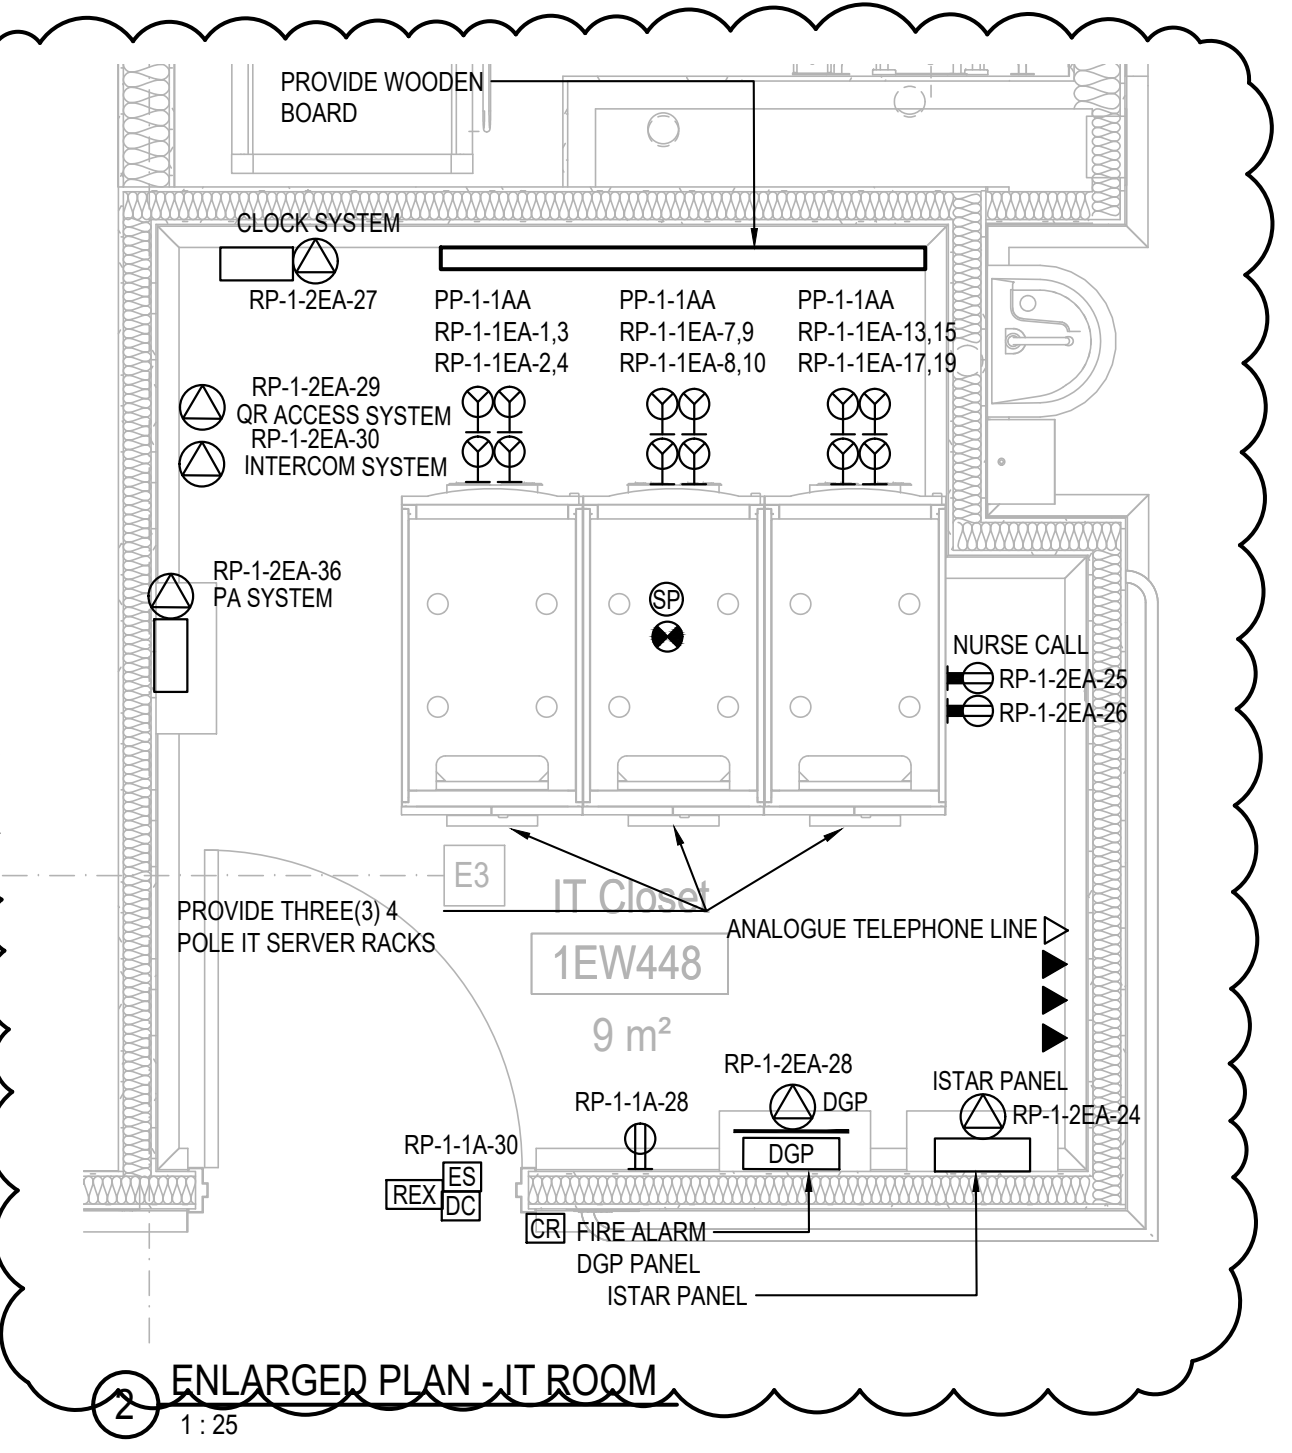

3. GROUND FLOOR ELECTRICAL ROOM

CLIENT:



ARCHITECT:



CONSULTANT:



- BUILDINGS • EARTH & ENVIRONMENT • ENERGY •
- INDUSTRIAL • INFRASTRUCTURE • SUSTAINABILITY •

PROJECT STATUS:

REVISIONS

NO	DESCRIPTION	DATE
1	Issued for Design Development Progress	2024.04.05
2	Issued for 100 CD	2024.05.10
3	Issued for 50% CD / Permit	2024.08.02
4	Issued for 90% CD	2024.09.06
5	Issued for 100% CD	2024.09.27
6	Issued for Tender	2024.10.11
7	Issued for Tender Addendum	2024.10.25
8	Issued for Tender Addendum No.4	2024.11.12
9	Issued for Tender Addendum No.5	2024.11.19

PROJECT:

UHN TWH - Seniors Emergency Medicine Centre
399 Bathurst Street, Toronto ON M5T 2S8
UHN PROJECT NO.: SAP #110022016

TITLE:

LEVEL 1 FLOOR PLAN - NEW WORK -
ELECTRICAL AND POWER SYSTEMS

PROJECT NO:



MRK-23004289

CHECKED:

M.S.





DRAWING NO:


E-202

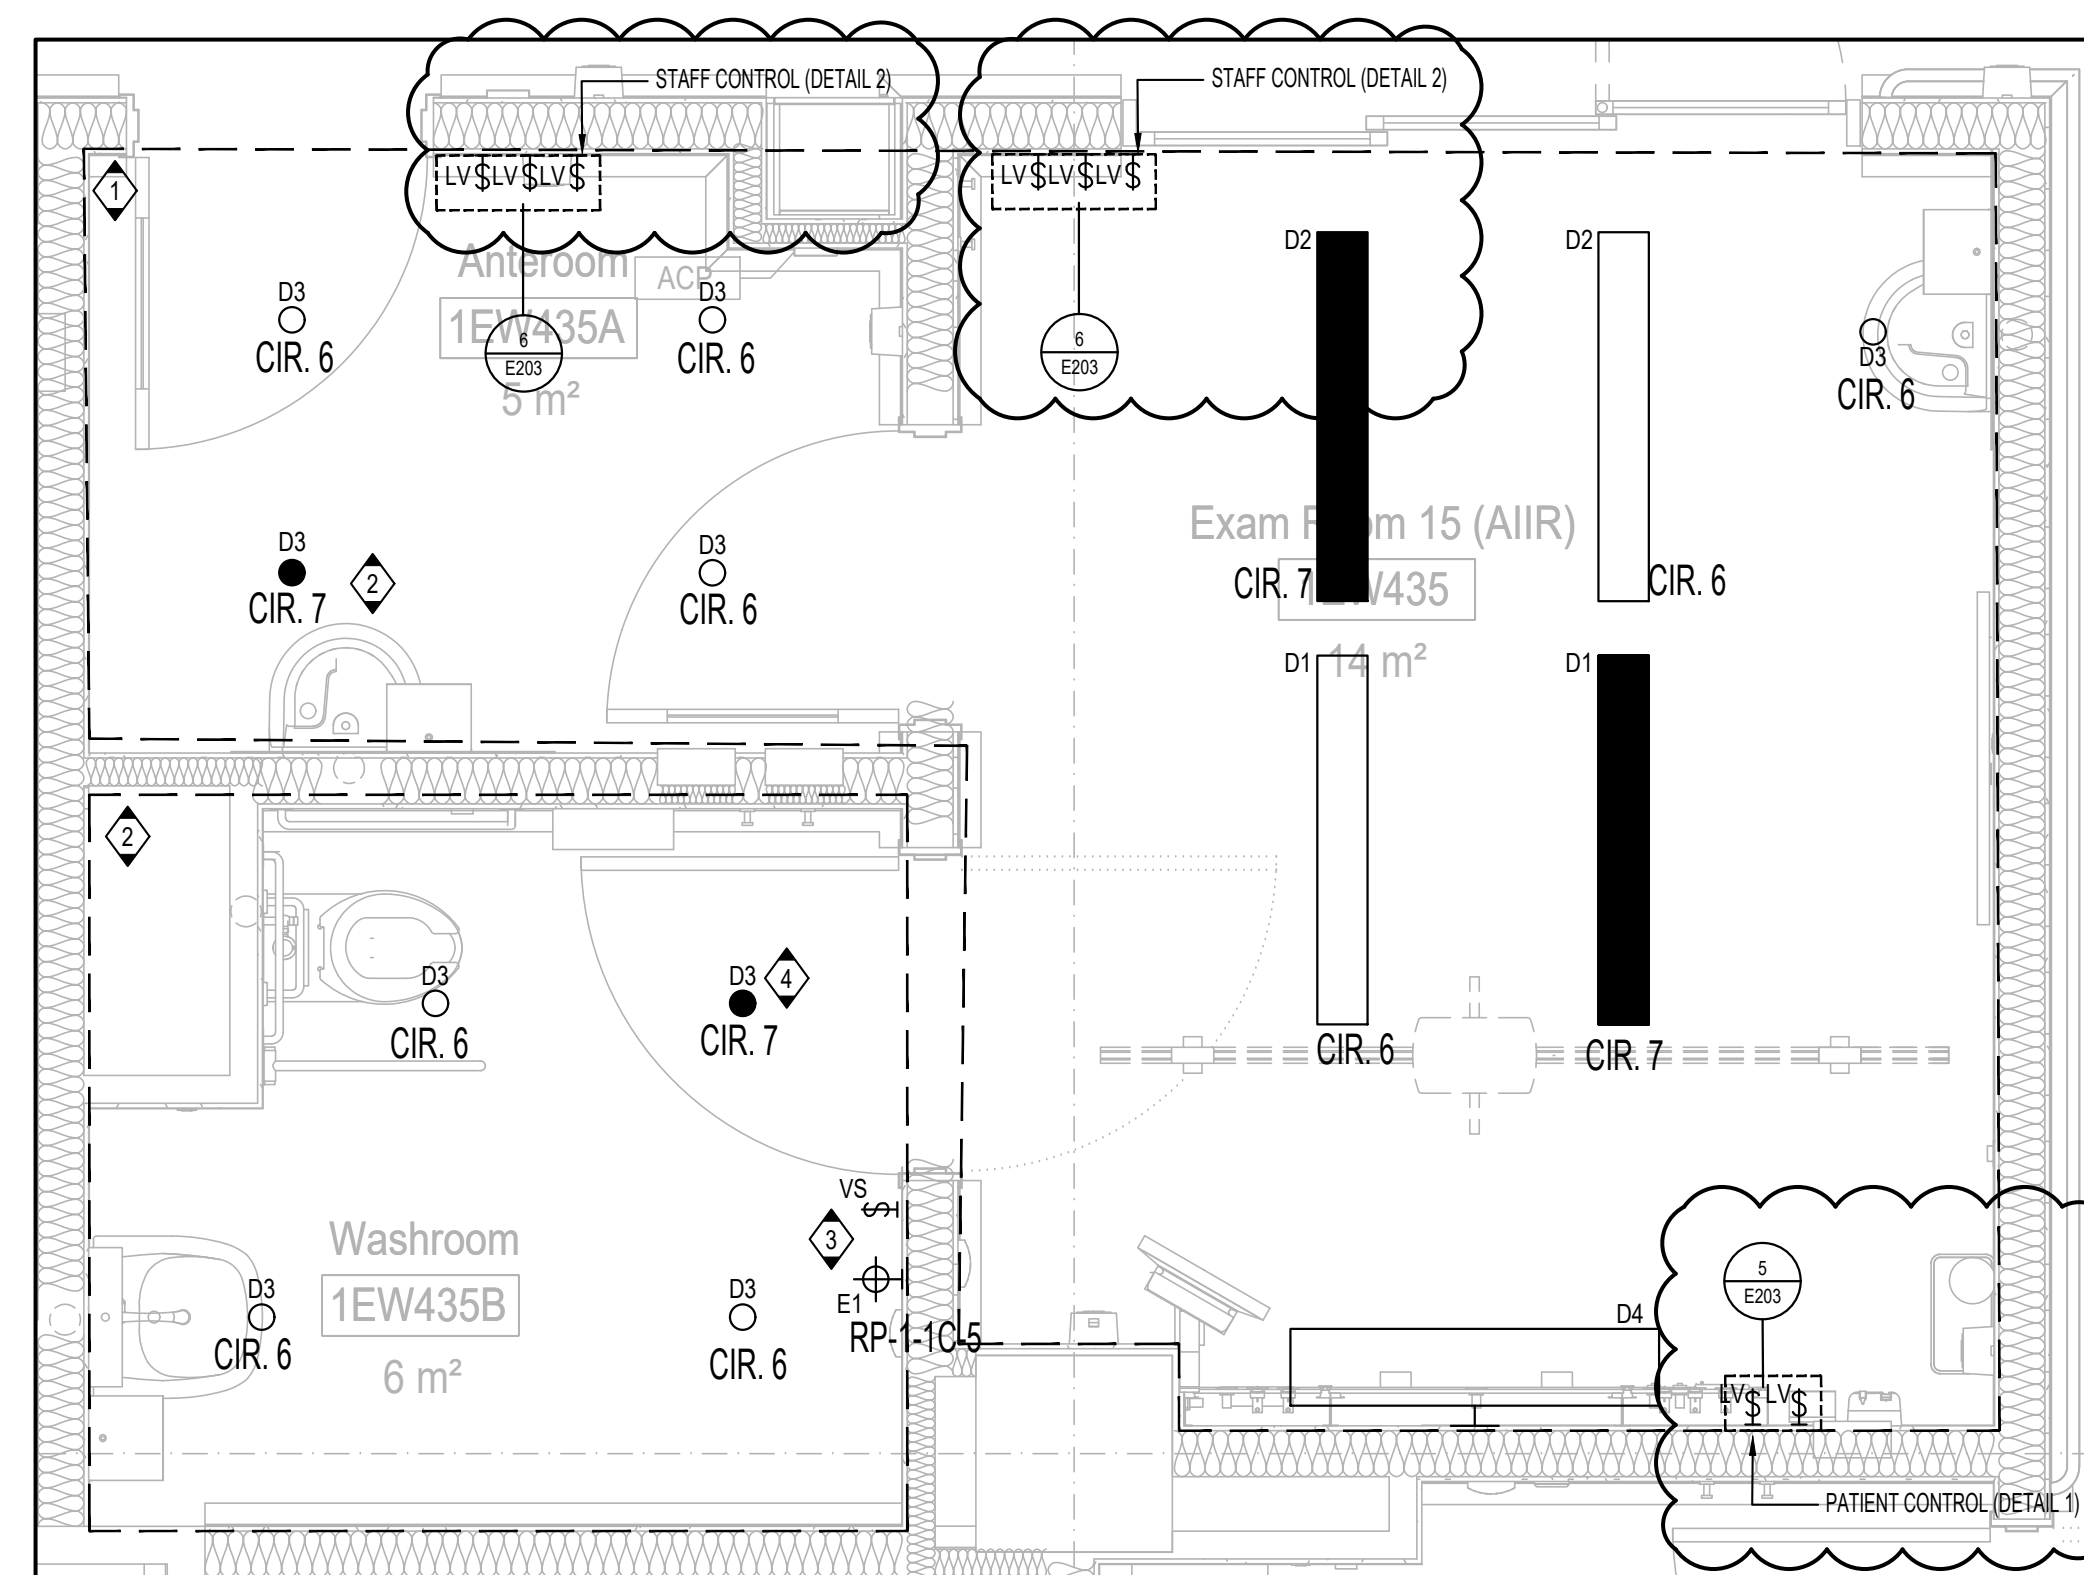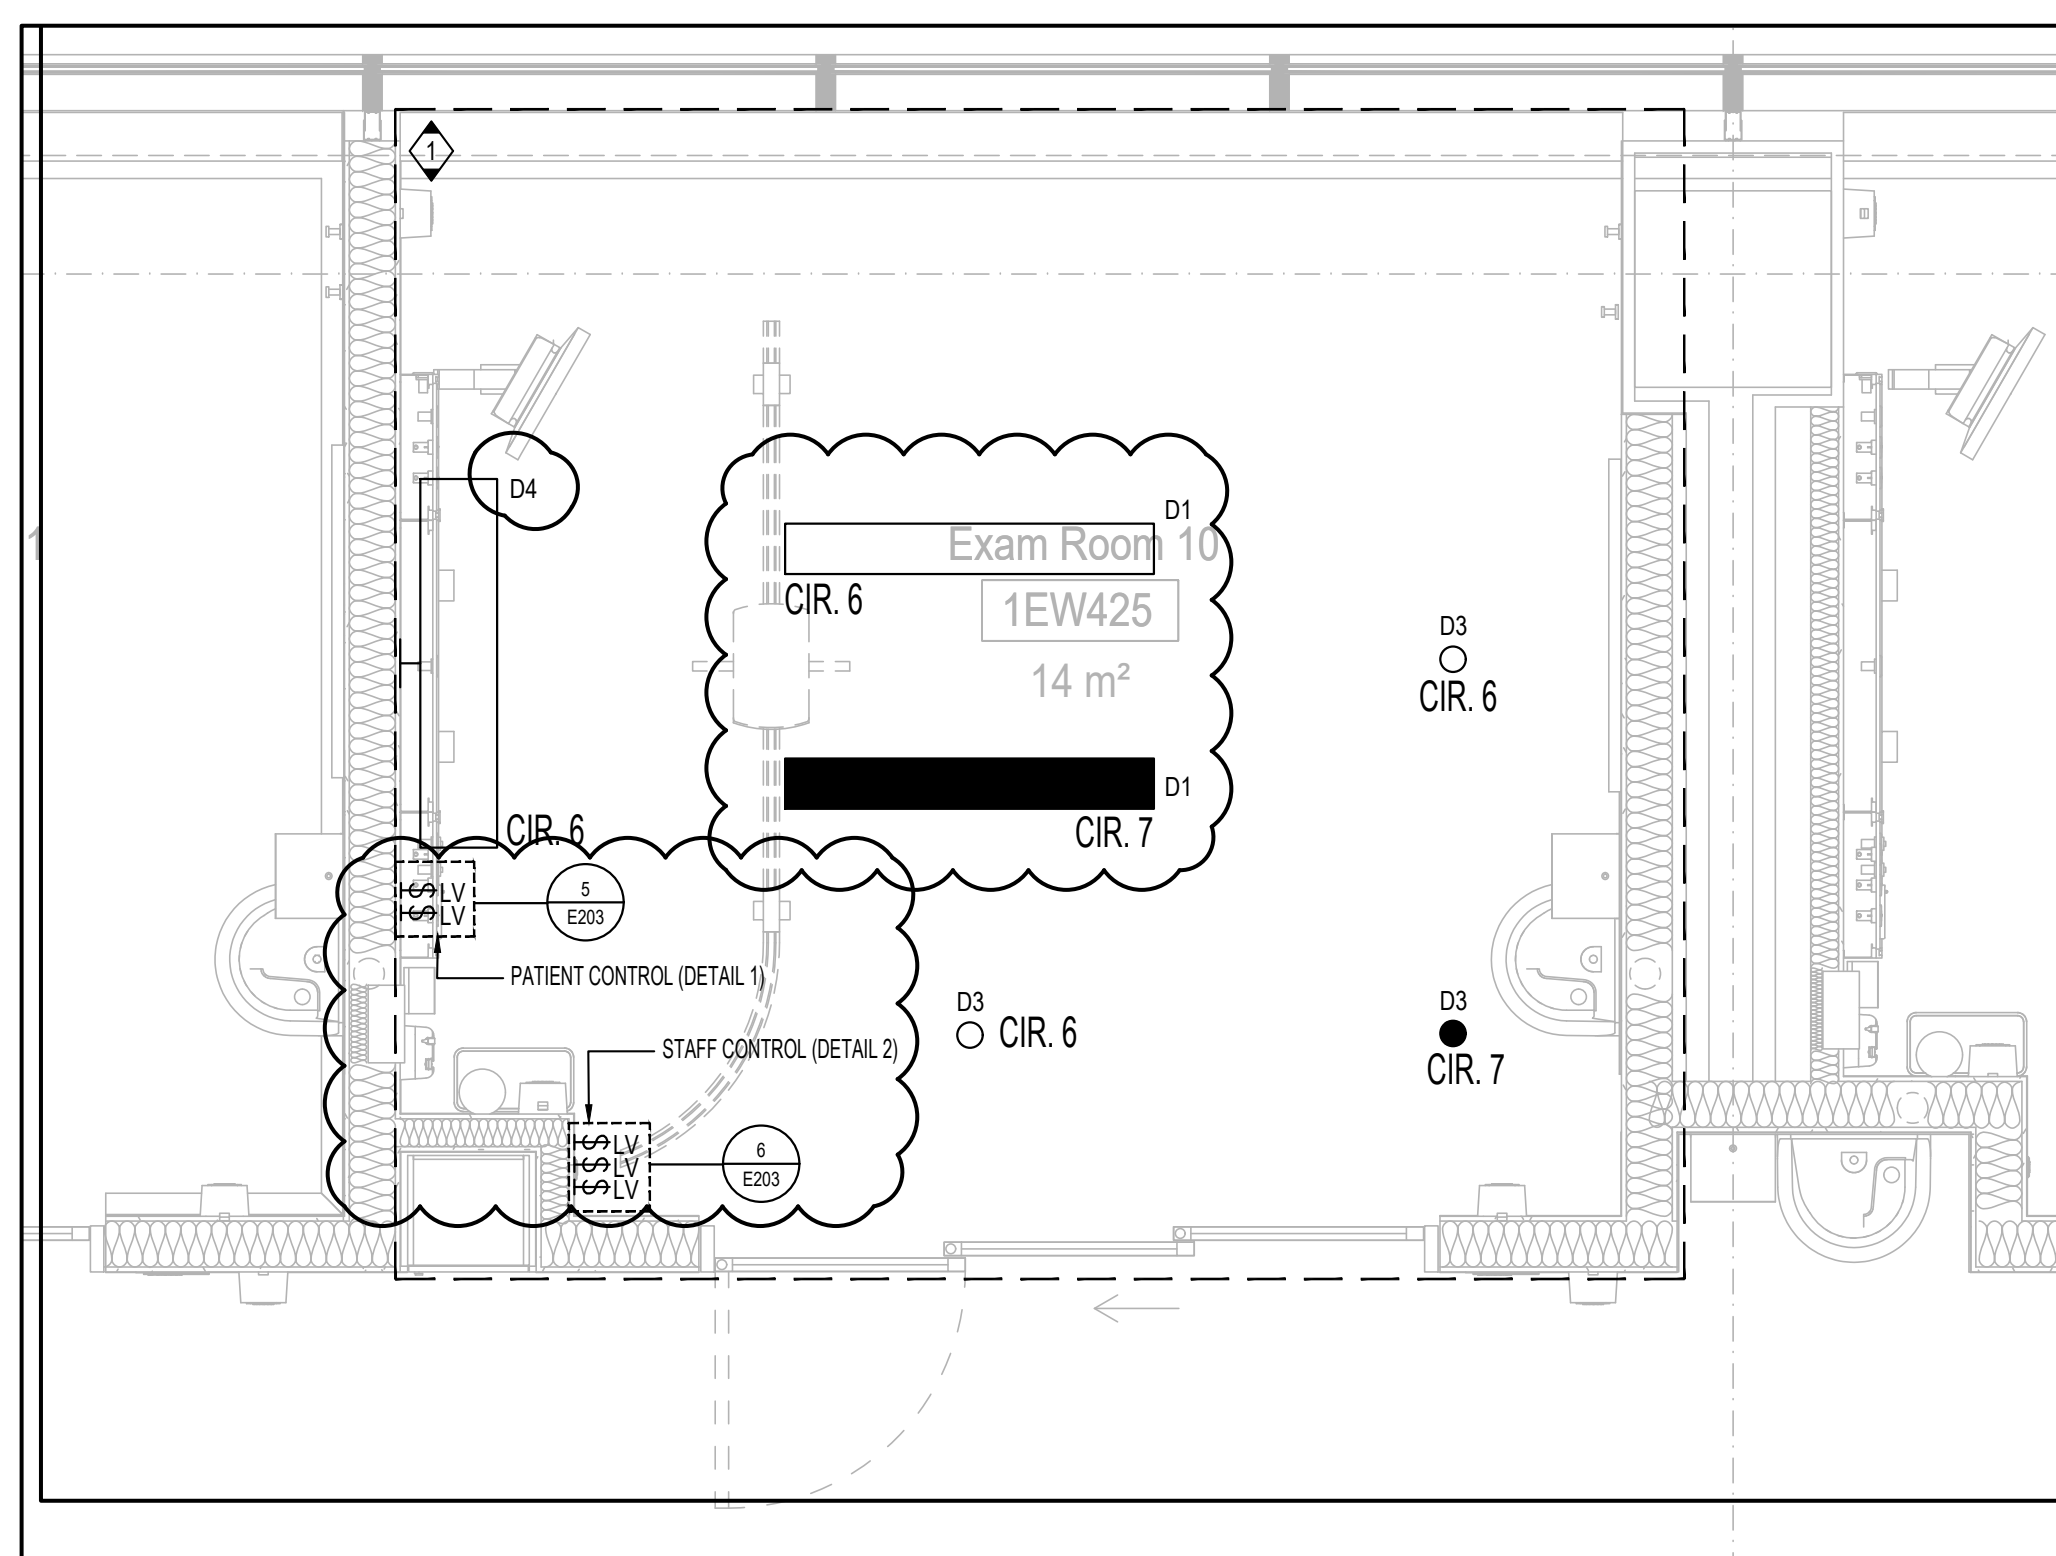


KEY NOTES:	
◇	LIGHTING CONTROL : TUNABLE WHITE WITH LIGHT SWITCH OVERRIDE (AT DOORWAY AND HEAD WALL)
◇	LIGHTING CONTROL : OCCUPANCY SENSOR (AUTO ON, 30-MINUTE TIMER AUTO-OFF)
◇	LIGHTING CONTROL : NIGHT LIGHT: TIMER CONTROL, SUNSET TO SUNRISE
◇	PROVIDE UL-924 RELAY FOR EMERGENCY LIGHTING.

	Q1	Q2	Q3	Q4	Q5	Q6	Q7	Q8
EXAM ROOM 1	RP-1-B-39	RP-1-B-42	RP-1-E-26A	RP-1-B-50		LP-1-A-13	LP-1-E-9	RP-1-E-2A
EXAM ROOM 2	RP-1-B-40	RP-1-B-46	RP-1-E-26A	RP-1-B-50		LP-1-A-23	LP-1-E-9	RP-1-E-2A
EXAM ROOM 3	RP-1-B-42	RP-1-B-47	RP-1-E-26A	RP-1-B-50		LP-1-A-13	LP-1-E-9	RP-1-E-2A
EXAM ROOM 4	RP-1-B-43	RP-1-E-84	RP-1-B-50	RP-1-B-50		LP-1-A-24	LP-1-E-10	RP-1-E-2A
EXAM ROOM 5	RP-1-B-44	RP-1-B-48	RP-1-E-26A	RP-1-B-50		LP-1-A-24	LP-1-E-10	RP-1-E-2A
EXAM ROOM 6	RP-1-B-45	RP-1-B-48	RP-1-E-26A	RP-1-B-50		LP-1-A-14	LP-1-E-10	RP-1-E-2A
EXAM ROOM 7	RP-1-A-63	RP-1-A-60	RP-1-E-26A	RP-1-A-49		LP-1-A-15	LP-1-E-11	RP-1-E-2A
EXAM ROOM 8	RP-1-A-42	RP-1-A-60	RP-1-E-26A	RP-1-A-49		LP-1-A-15	LP-1-E-11	RP-1-E-2A
EXAM ROOM 9	RP-1-A-43	RP-1-A-61	RP-1-E-26A	RP-1-A-49		LP-1-A-15	LP-1-E-11	RP-1-E-2A
EXAM ROOM 10	RP-1-A-44	RP-1-E-26A	RP-1-E-26A	RP-1-A-49		LP-1-A-16	LP-1-E-12	RP-1-E-2A
EXAM ROOM 11	RP-1-A-45	RP-1-A-62	RP-1-E-26A	RP-1-A-49		LP-1-A-20	LP-1-E-12	RP-1-E-2A
EXAM ROOM 12 (AIR ROOM)	RP-1-A-46	RP-1-A-62	RP-1-E-26A	RP-1-A-51		LP-1-A-17	LP-1-E-12	RP-1-E-2A
EXAM ROOM 13	RP-1-A-47	RP-1-A-63	RP-1-E-26A	RP-1-A-54		LP-1-A-27	LP-1-E-13	RP-1-E-2A
EXAM ROOM 14	RP-1-A-48	RP-1-A-63	RP-1-E-26A	RP-1-A-54		LP-1-A-27	LP-1-E-13	RP-1-E-2A
EXAM ROOM 15 (AIR ROOM)	RP-1-A-58	RP-1-A-64	RP-1-E-26A	RP-1-A-54	RP-1-A-52	LP-1-A-27	LP-1-E-13	RP-1-E-2A

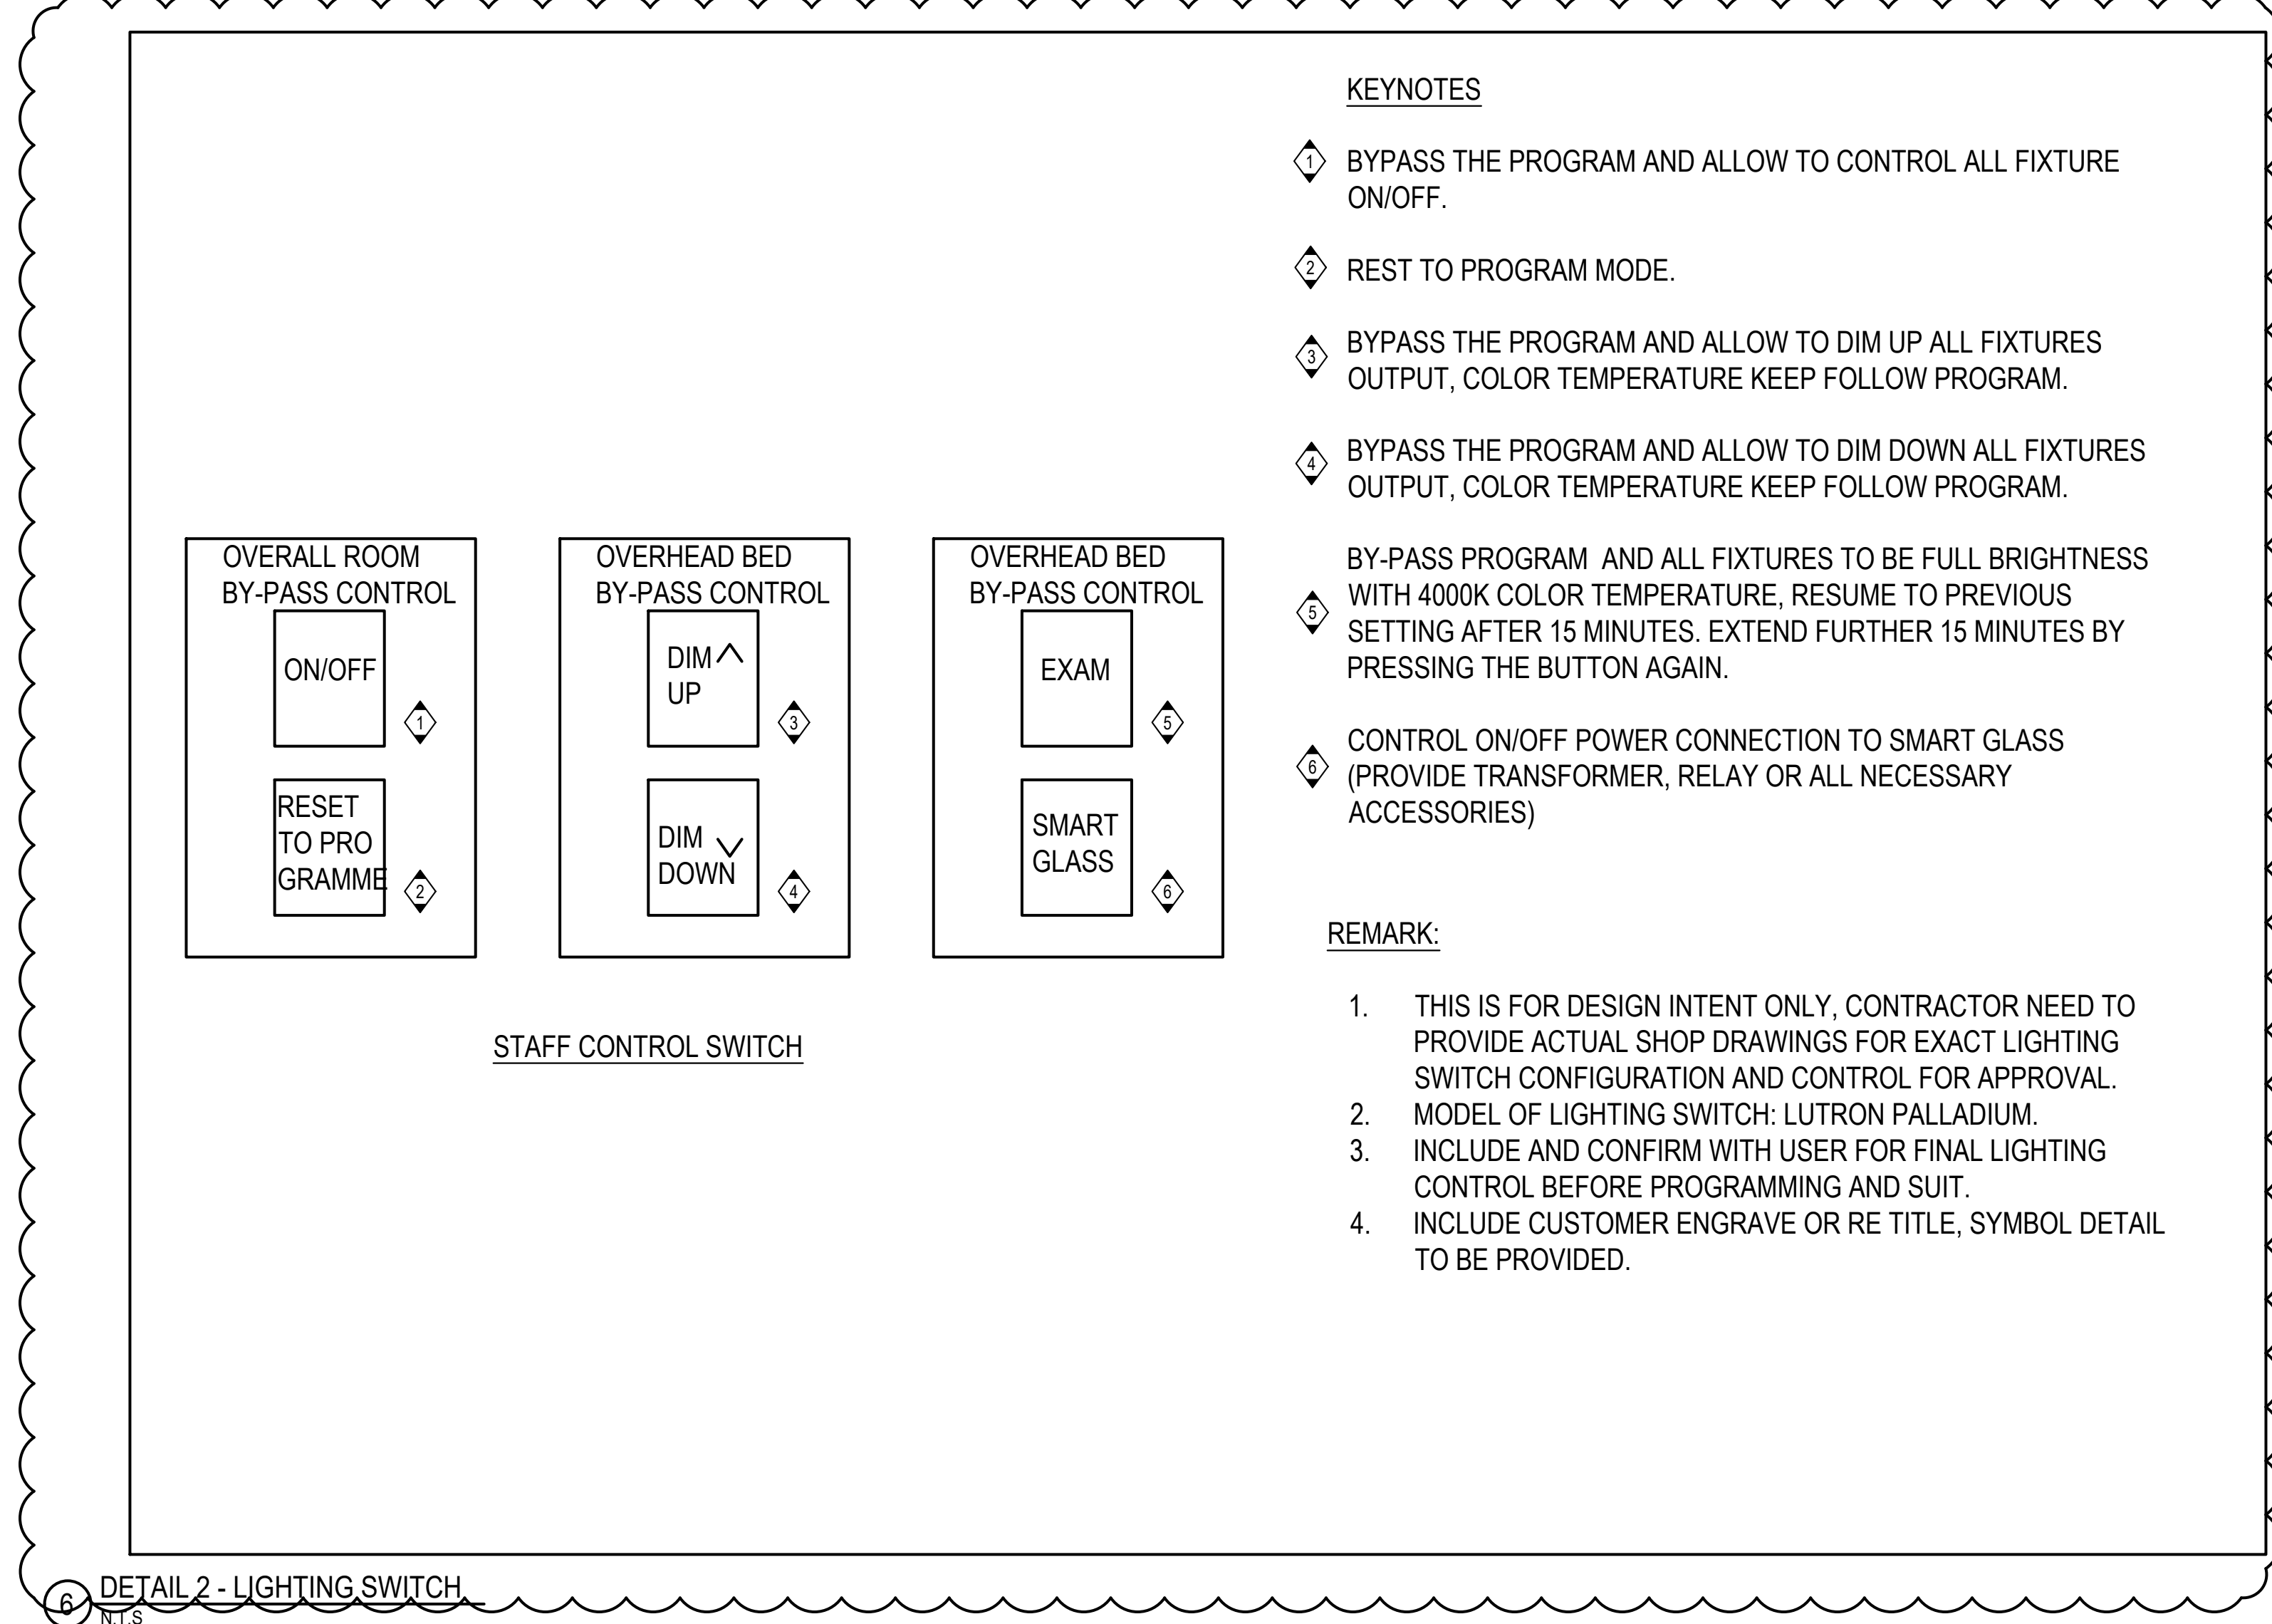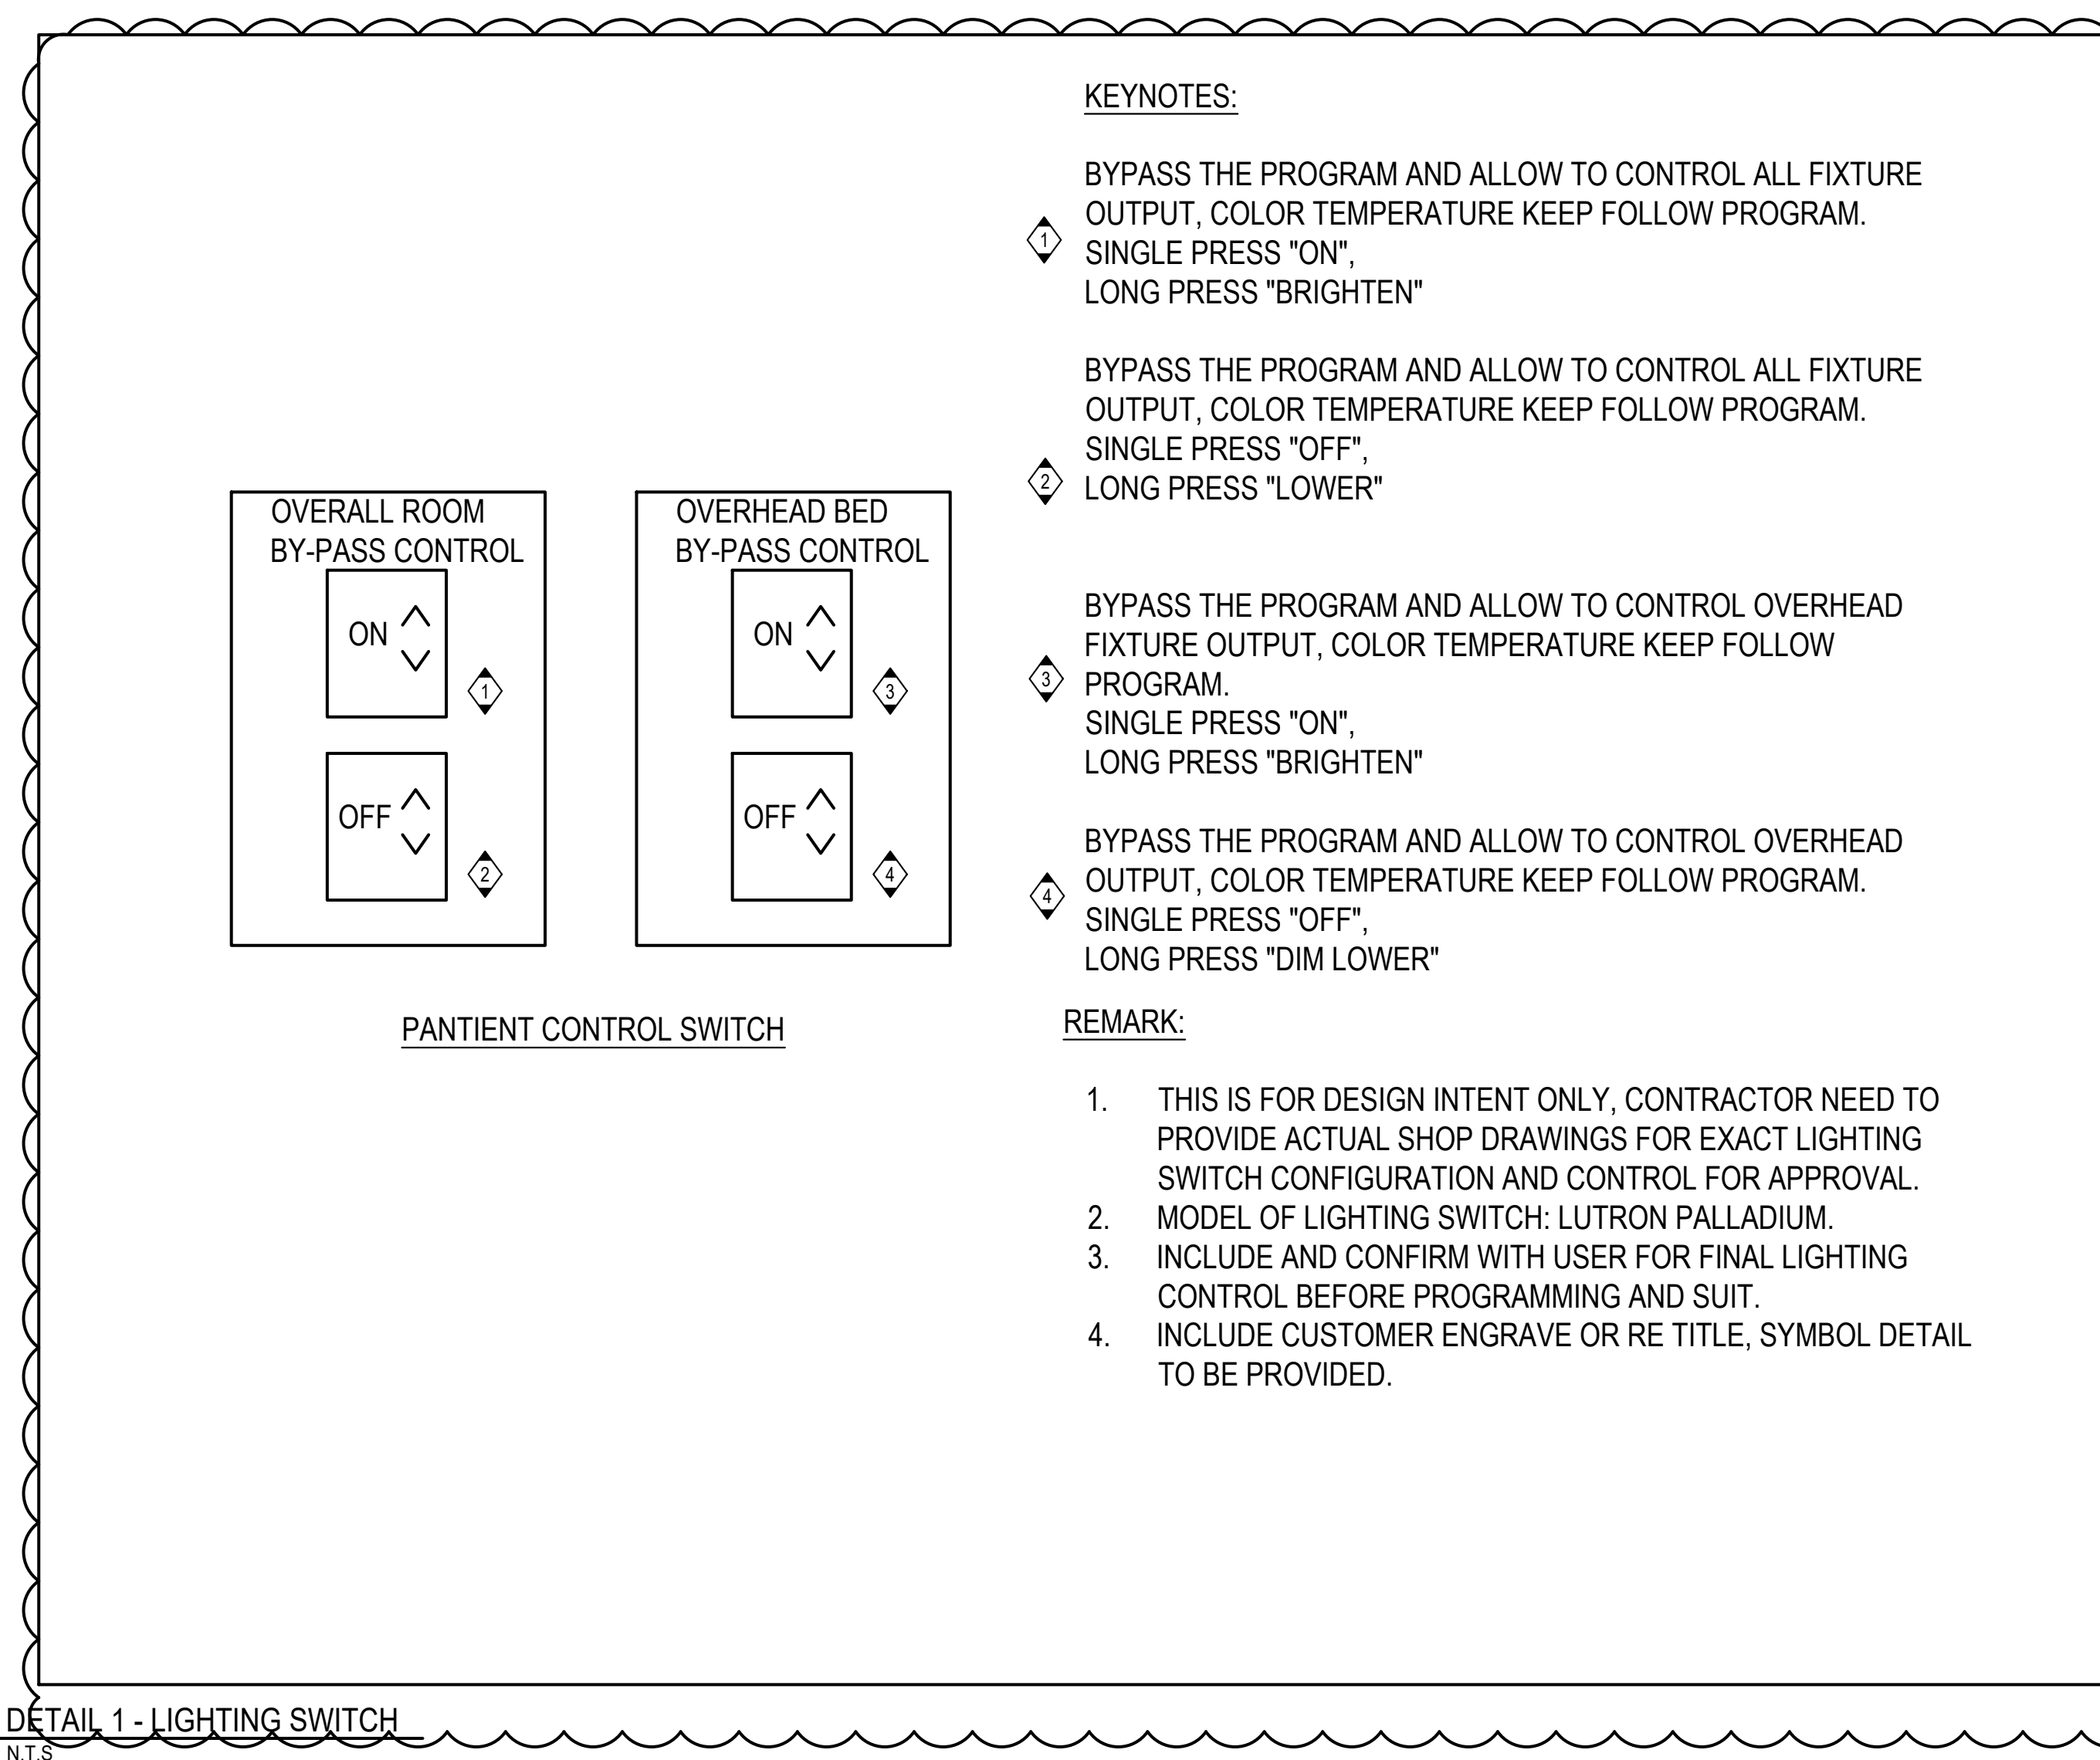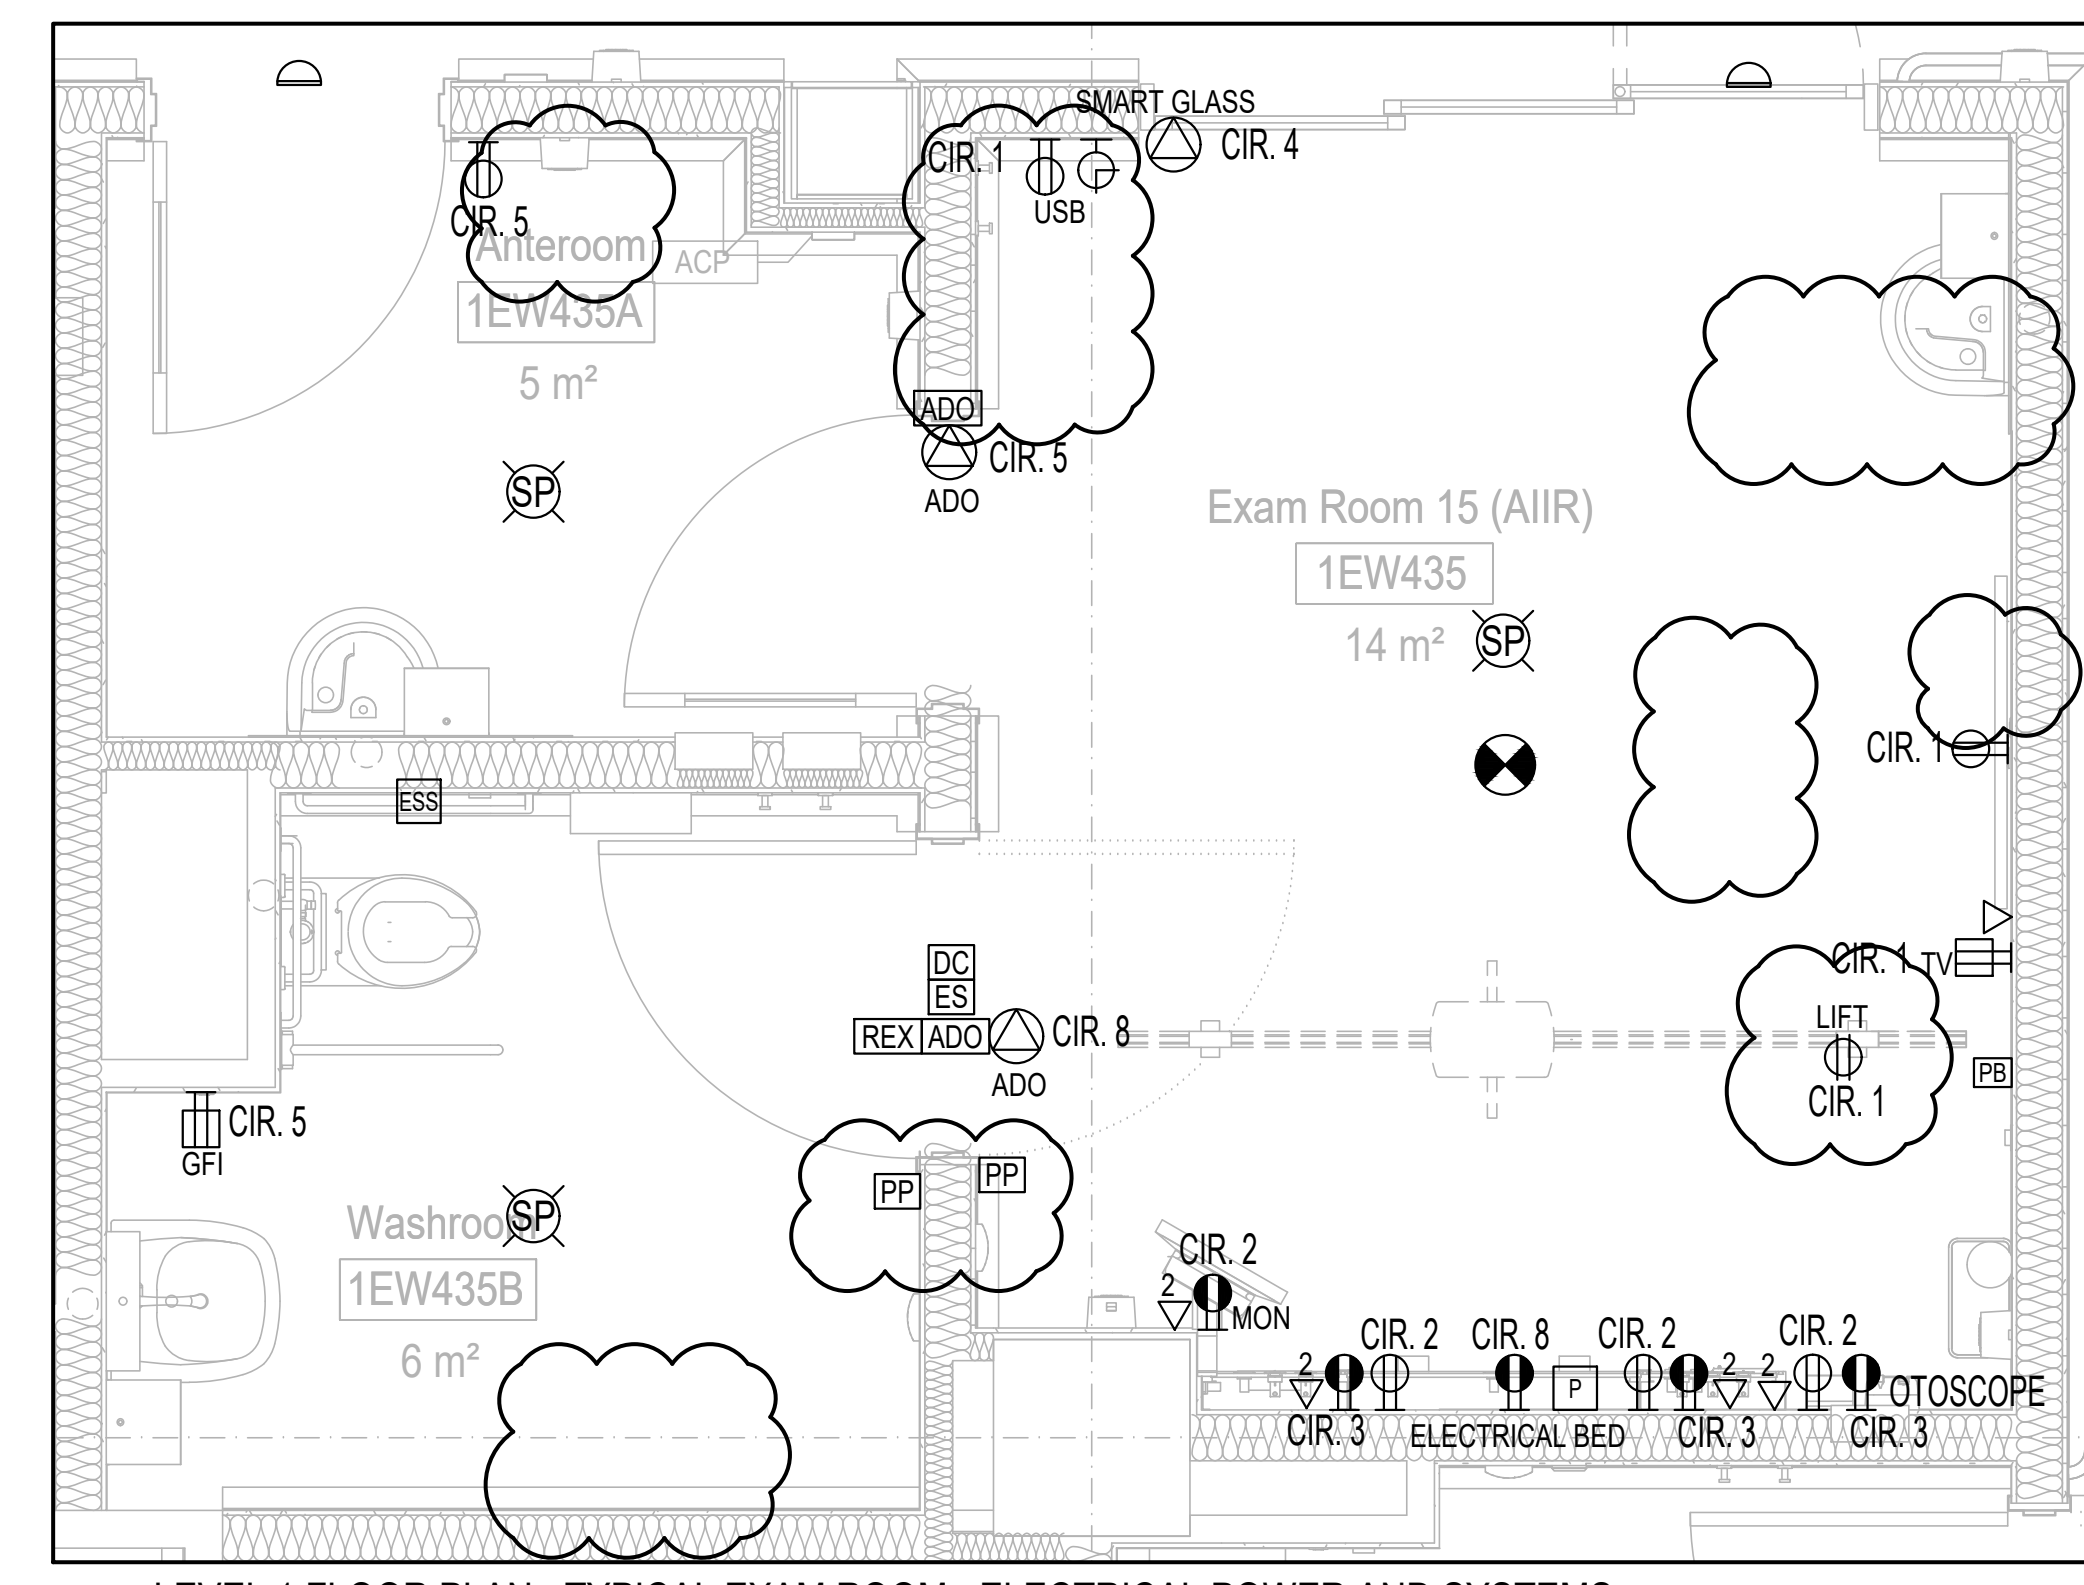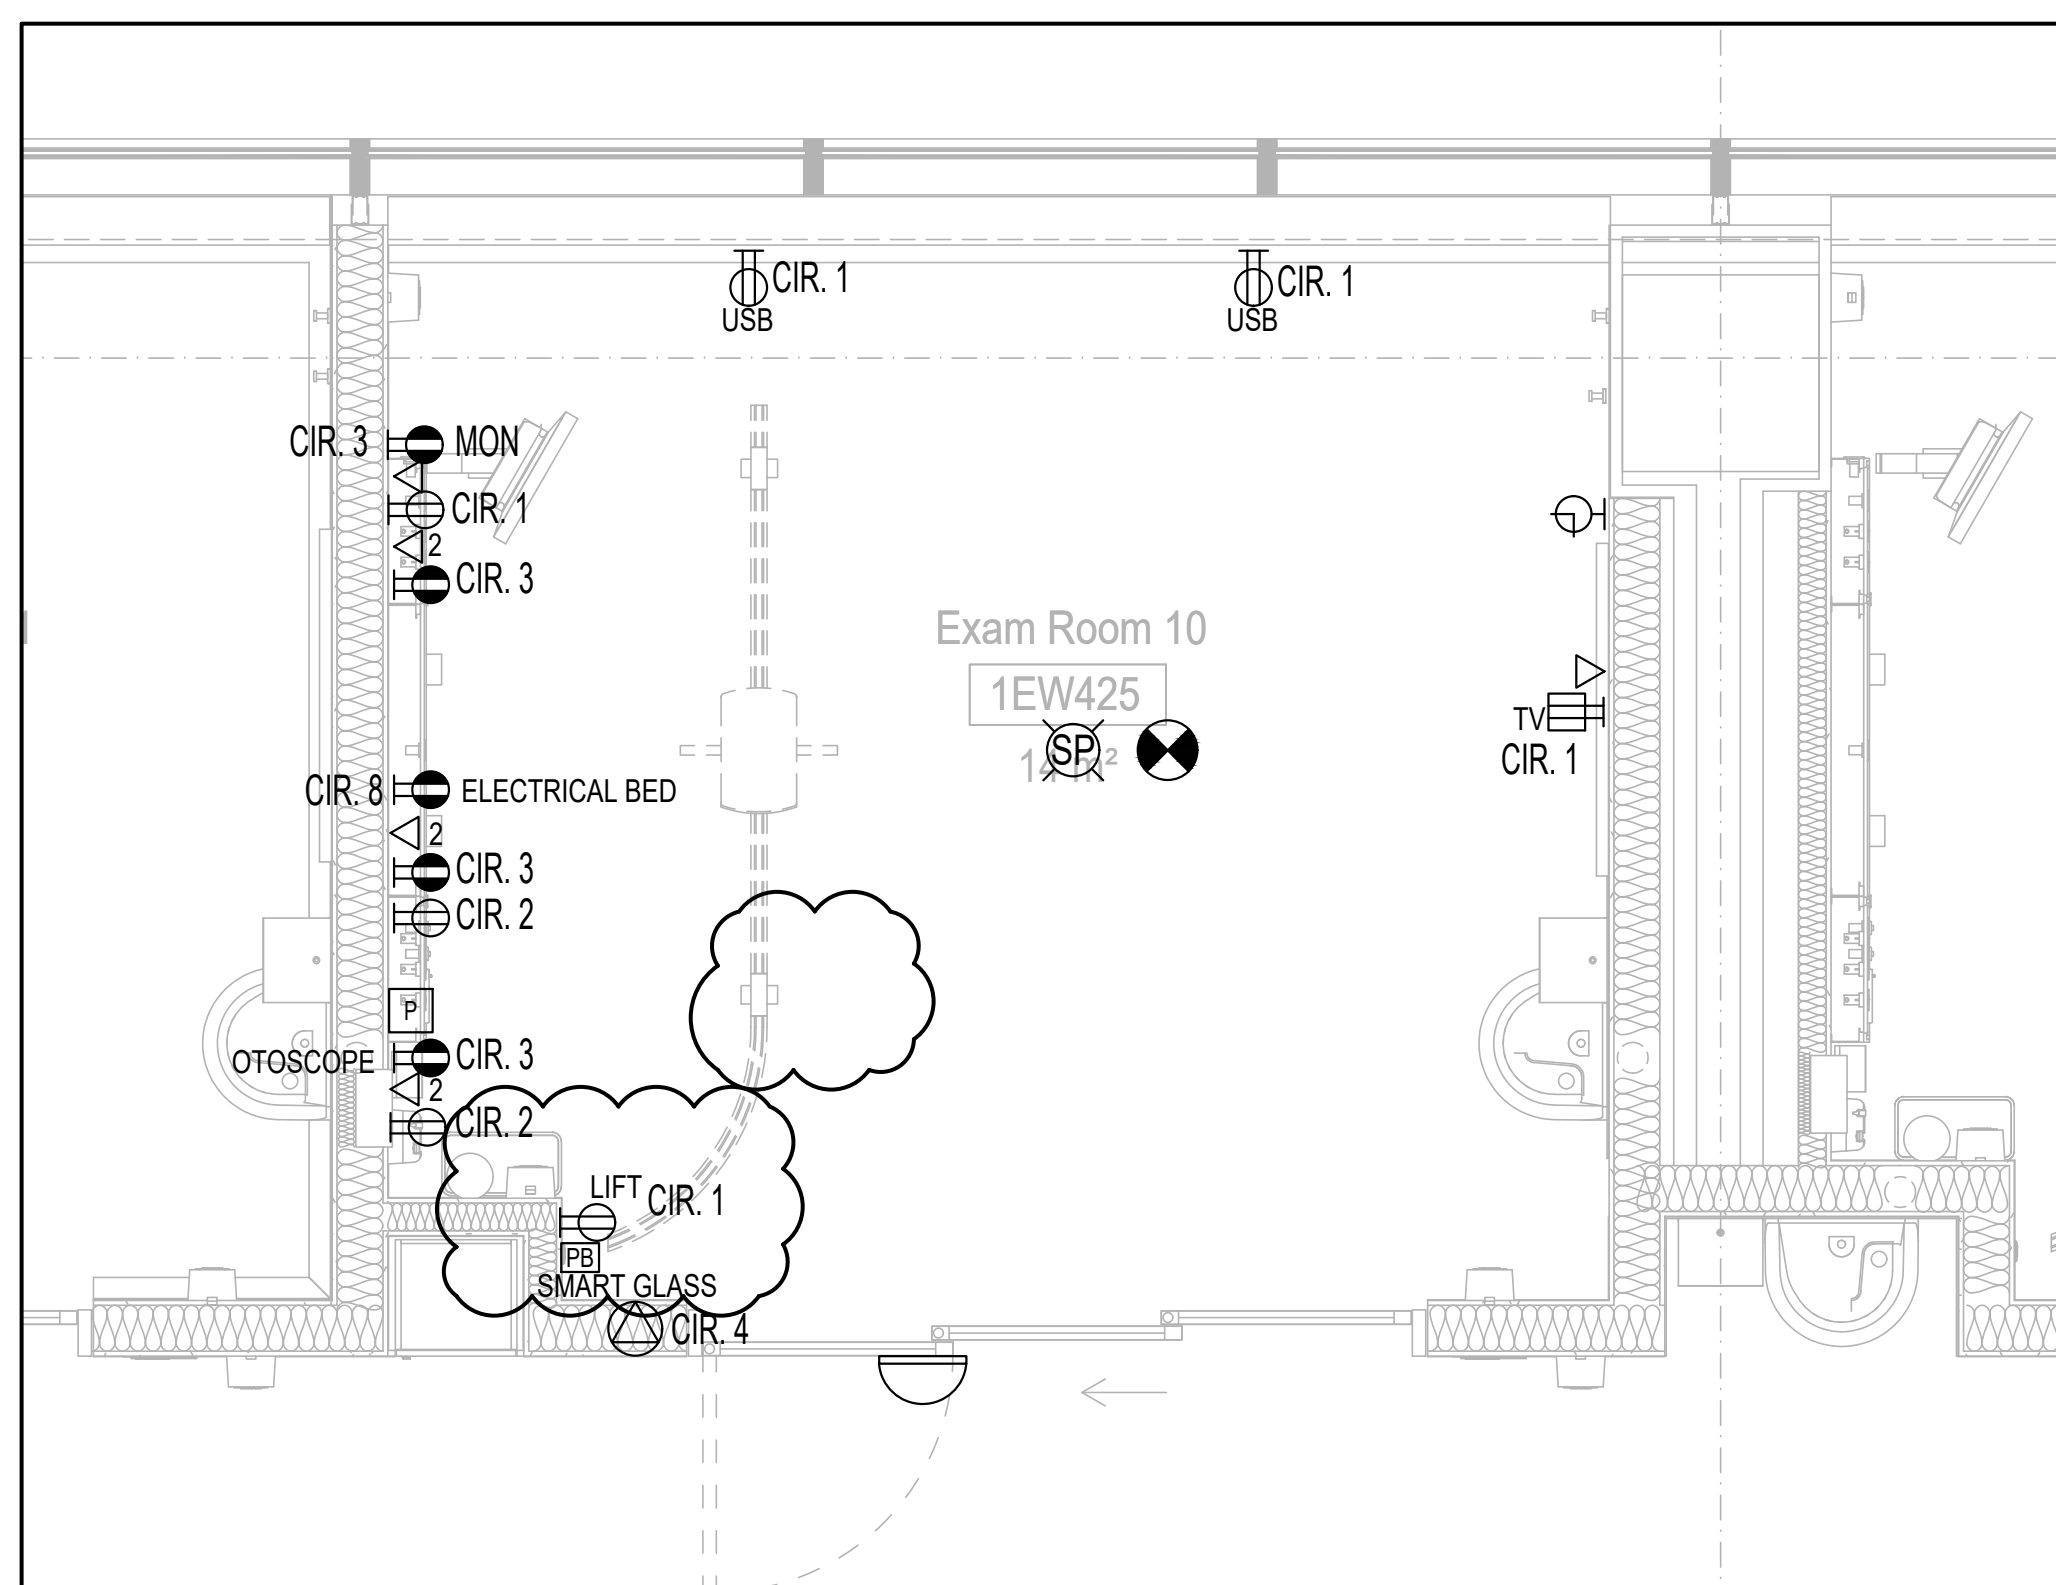


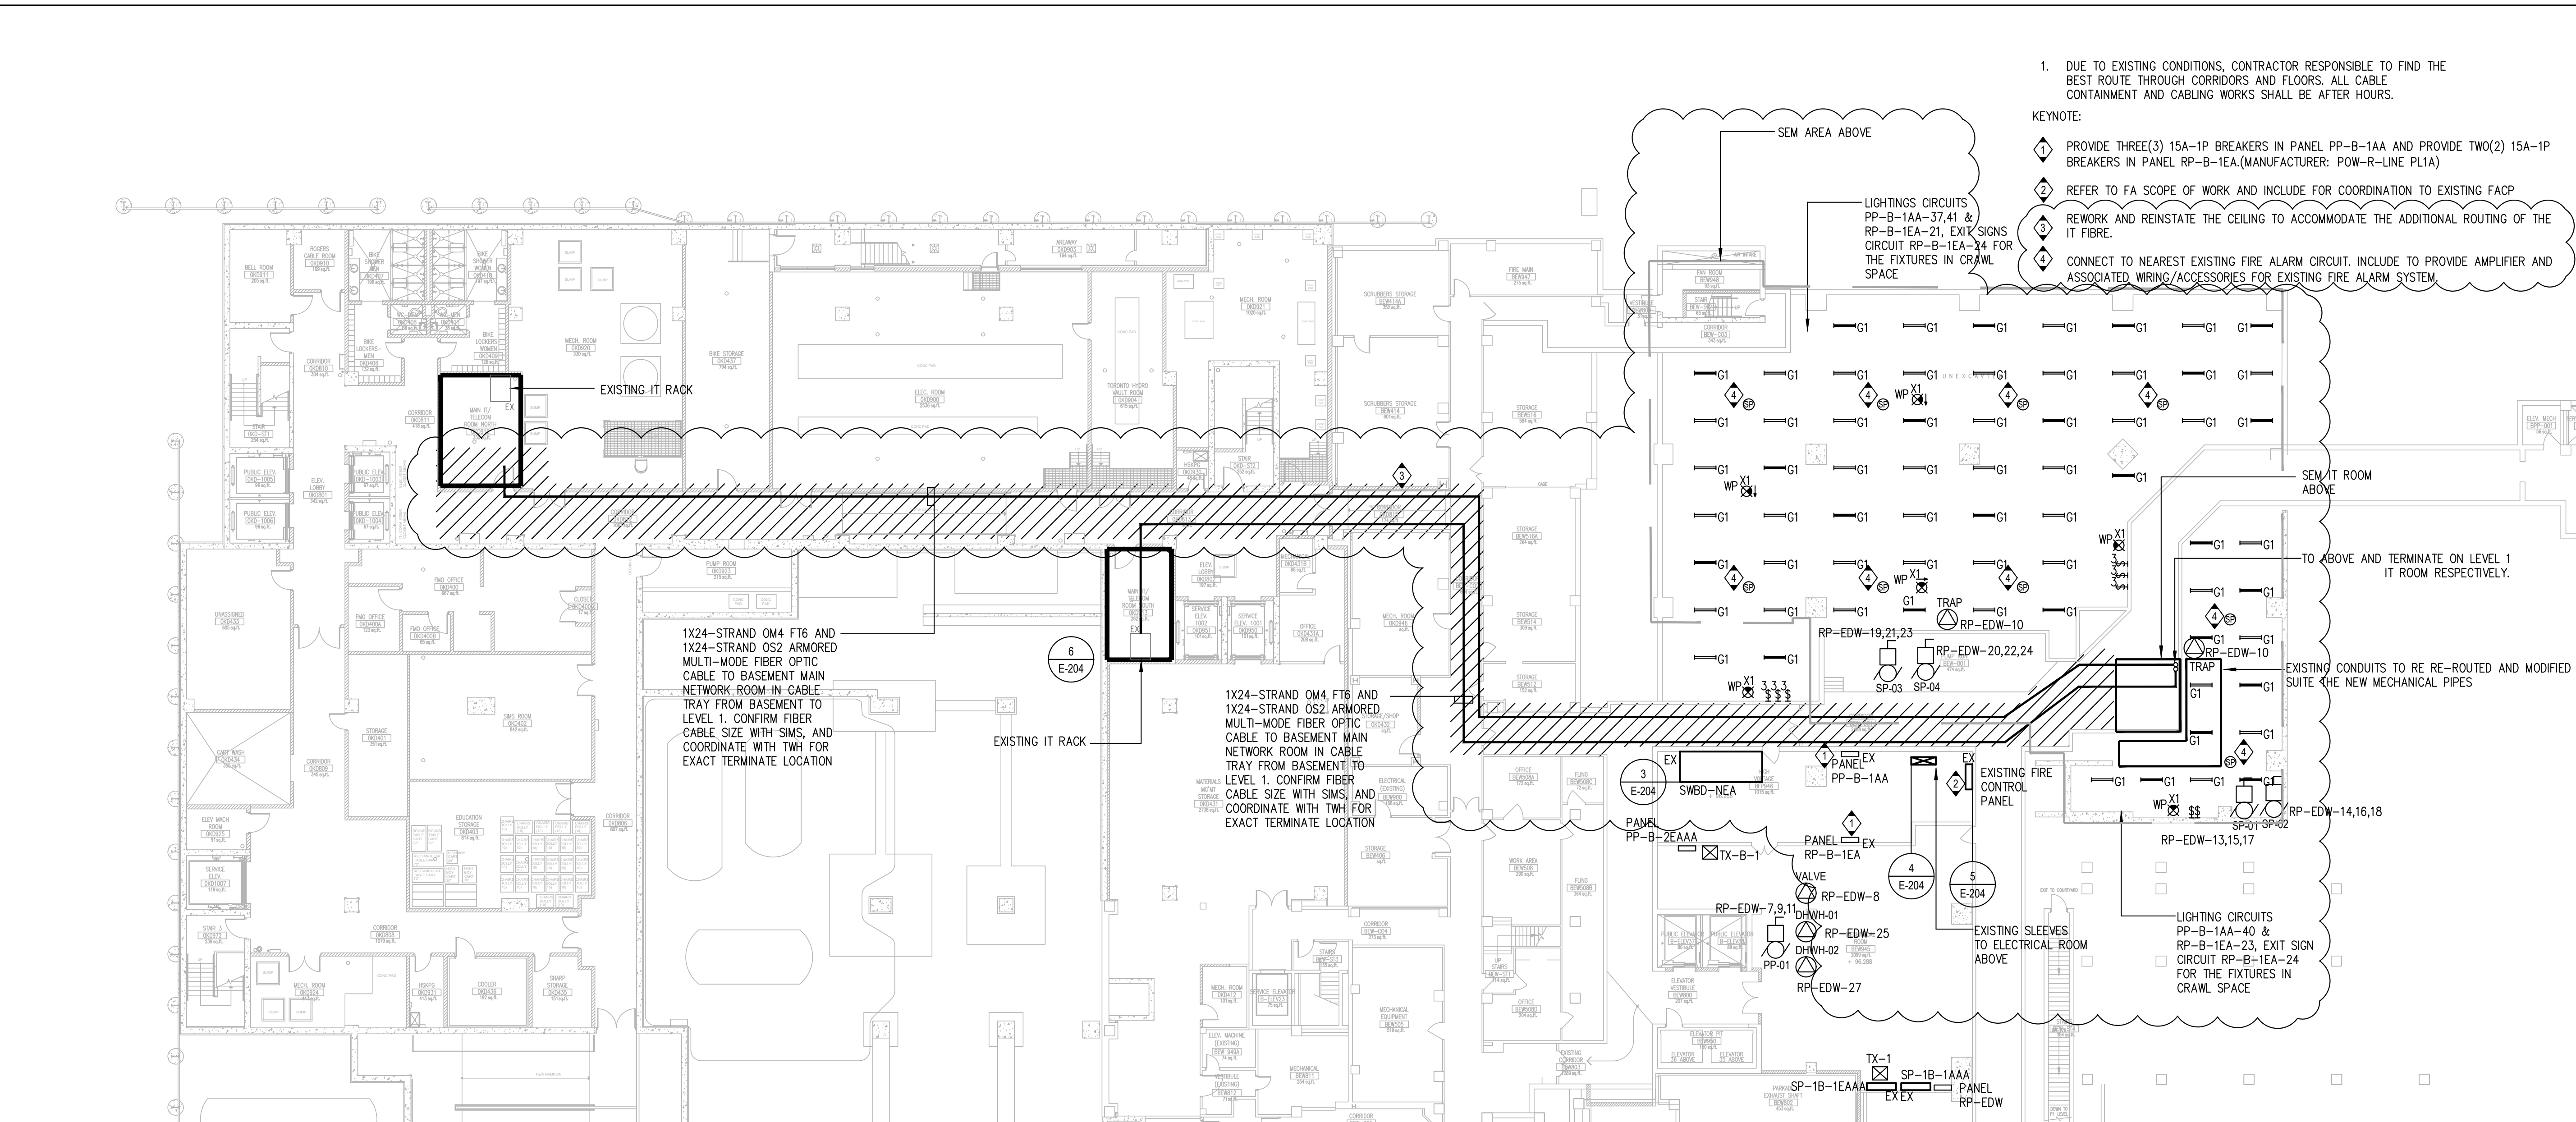

1 BASEMENT PART FLOOR PLAN
1:200

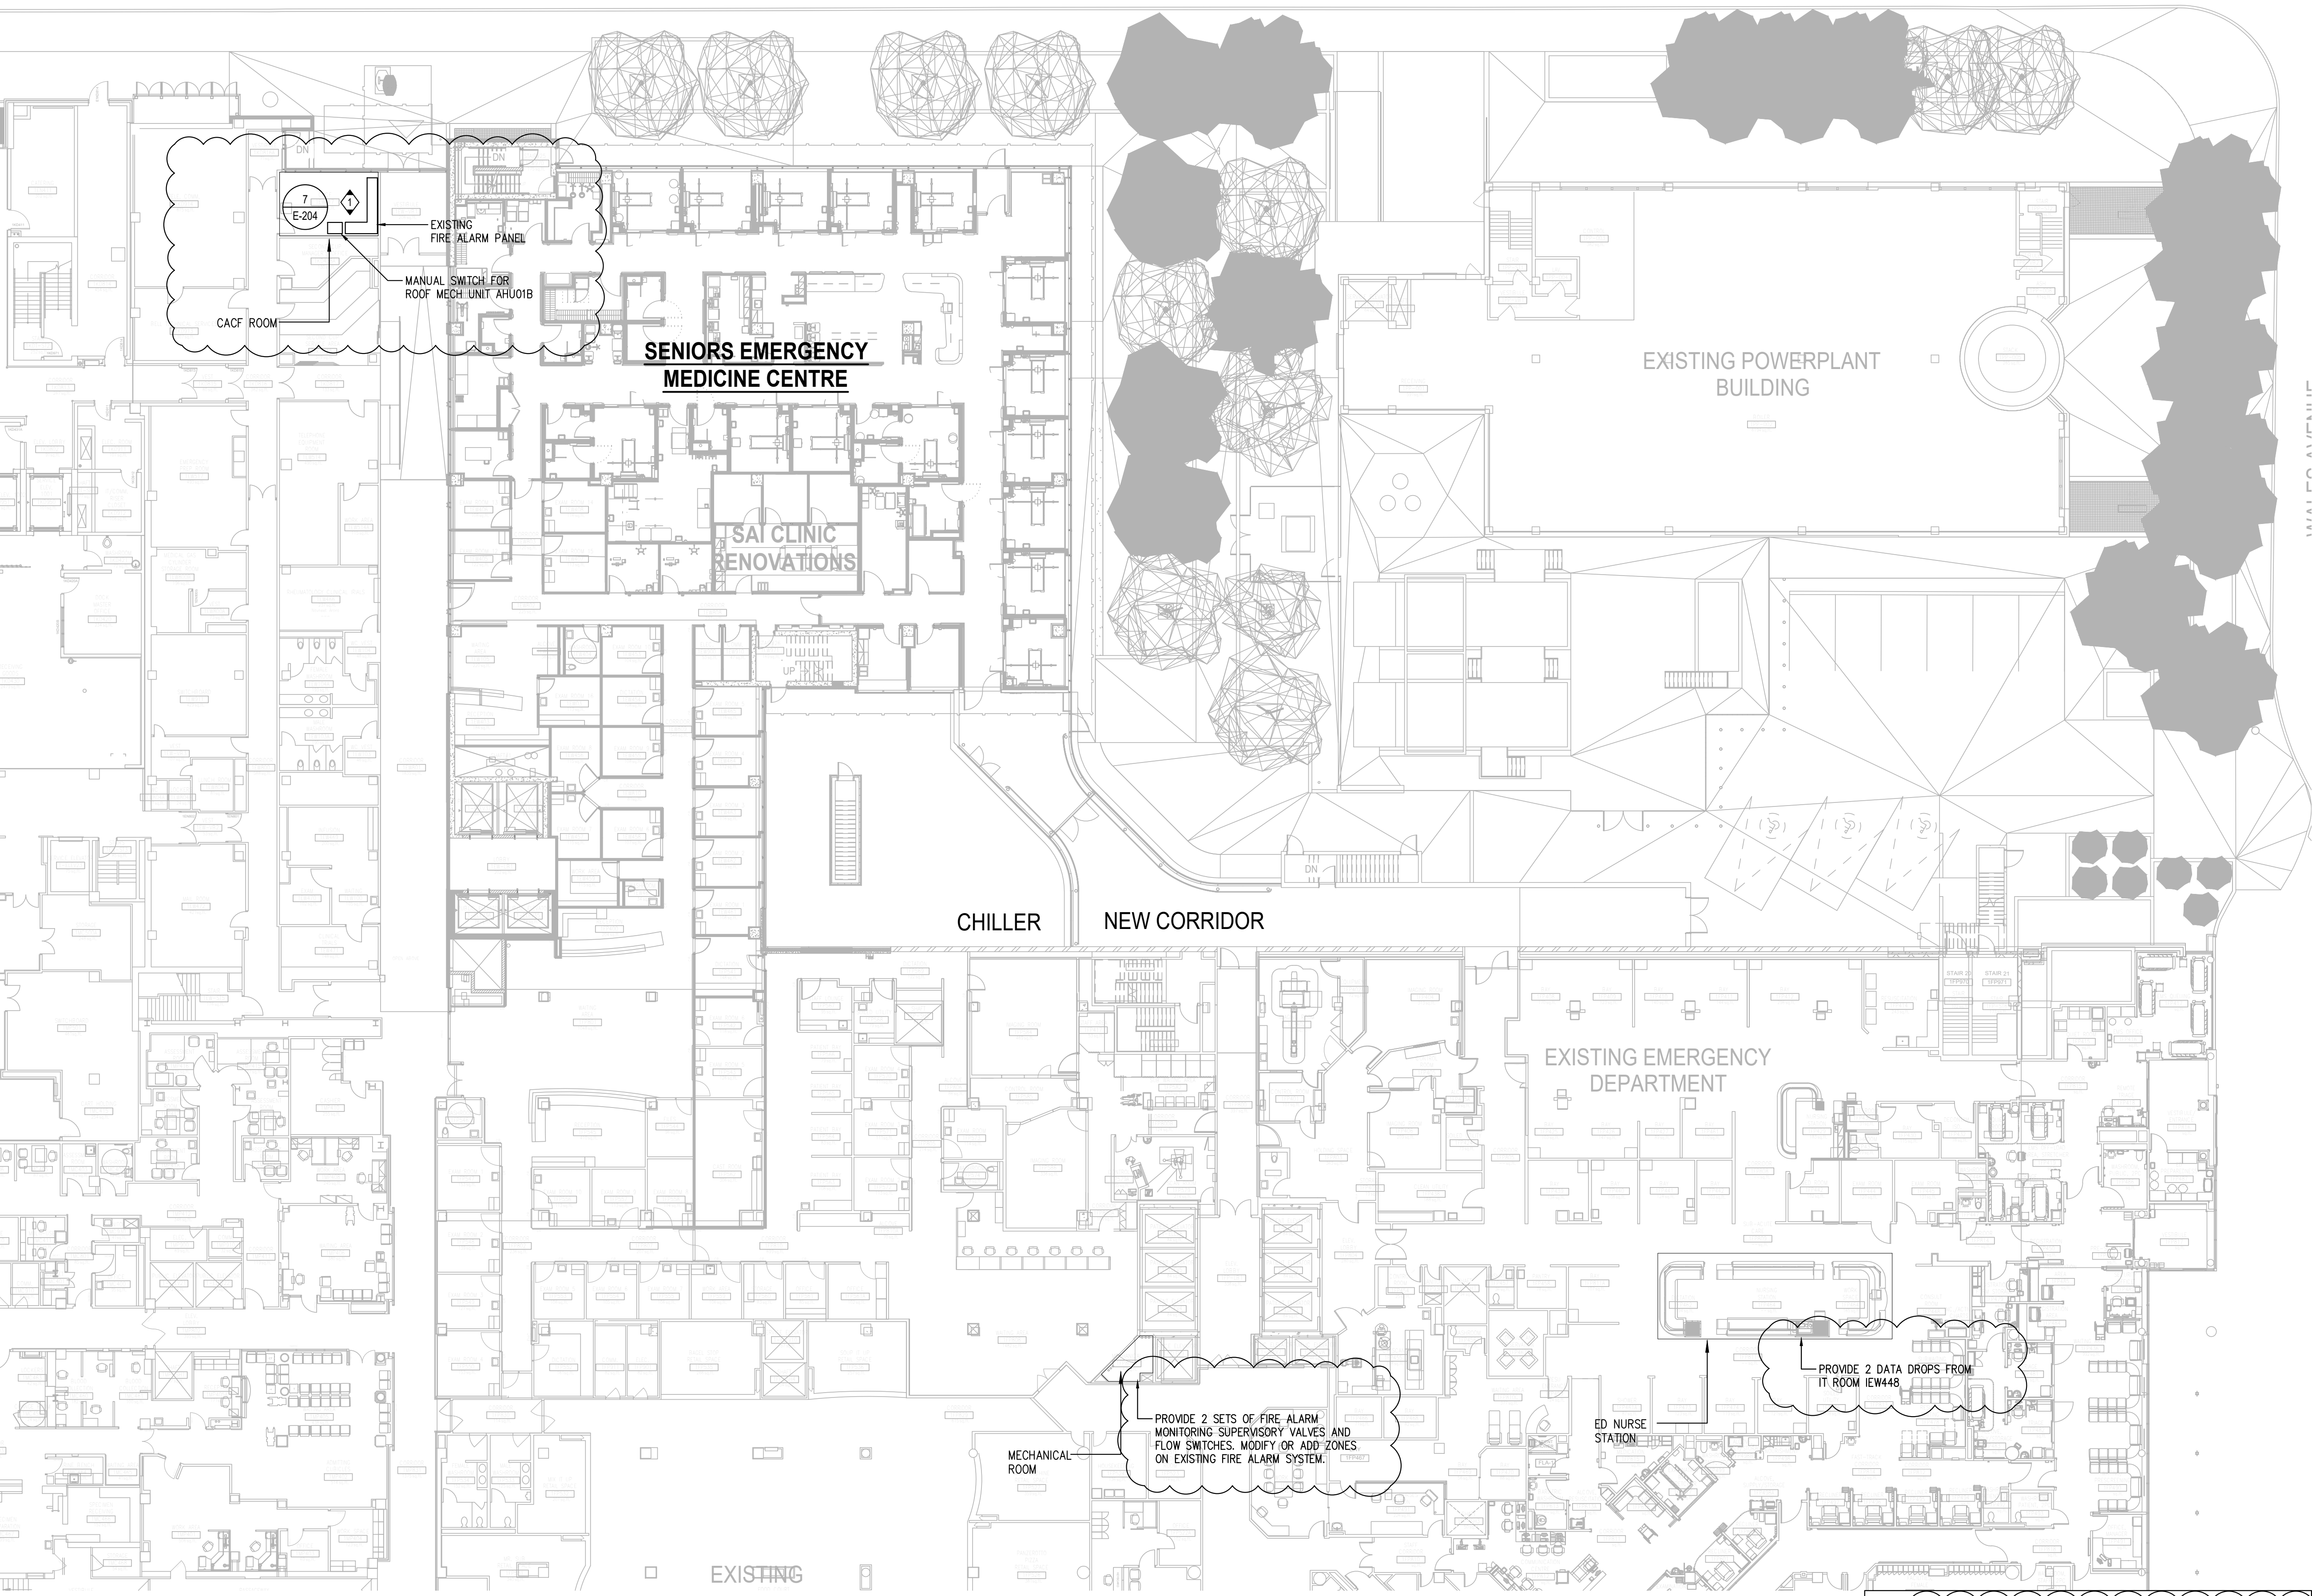

2 GROUND PART FLOOR PLAN
1:200

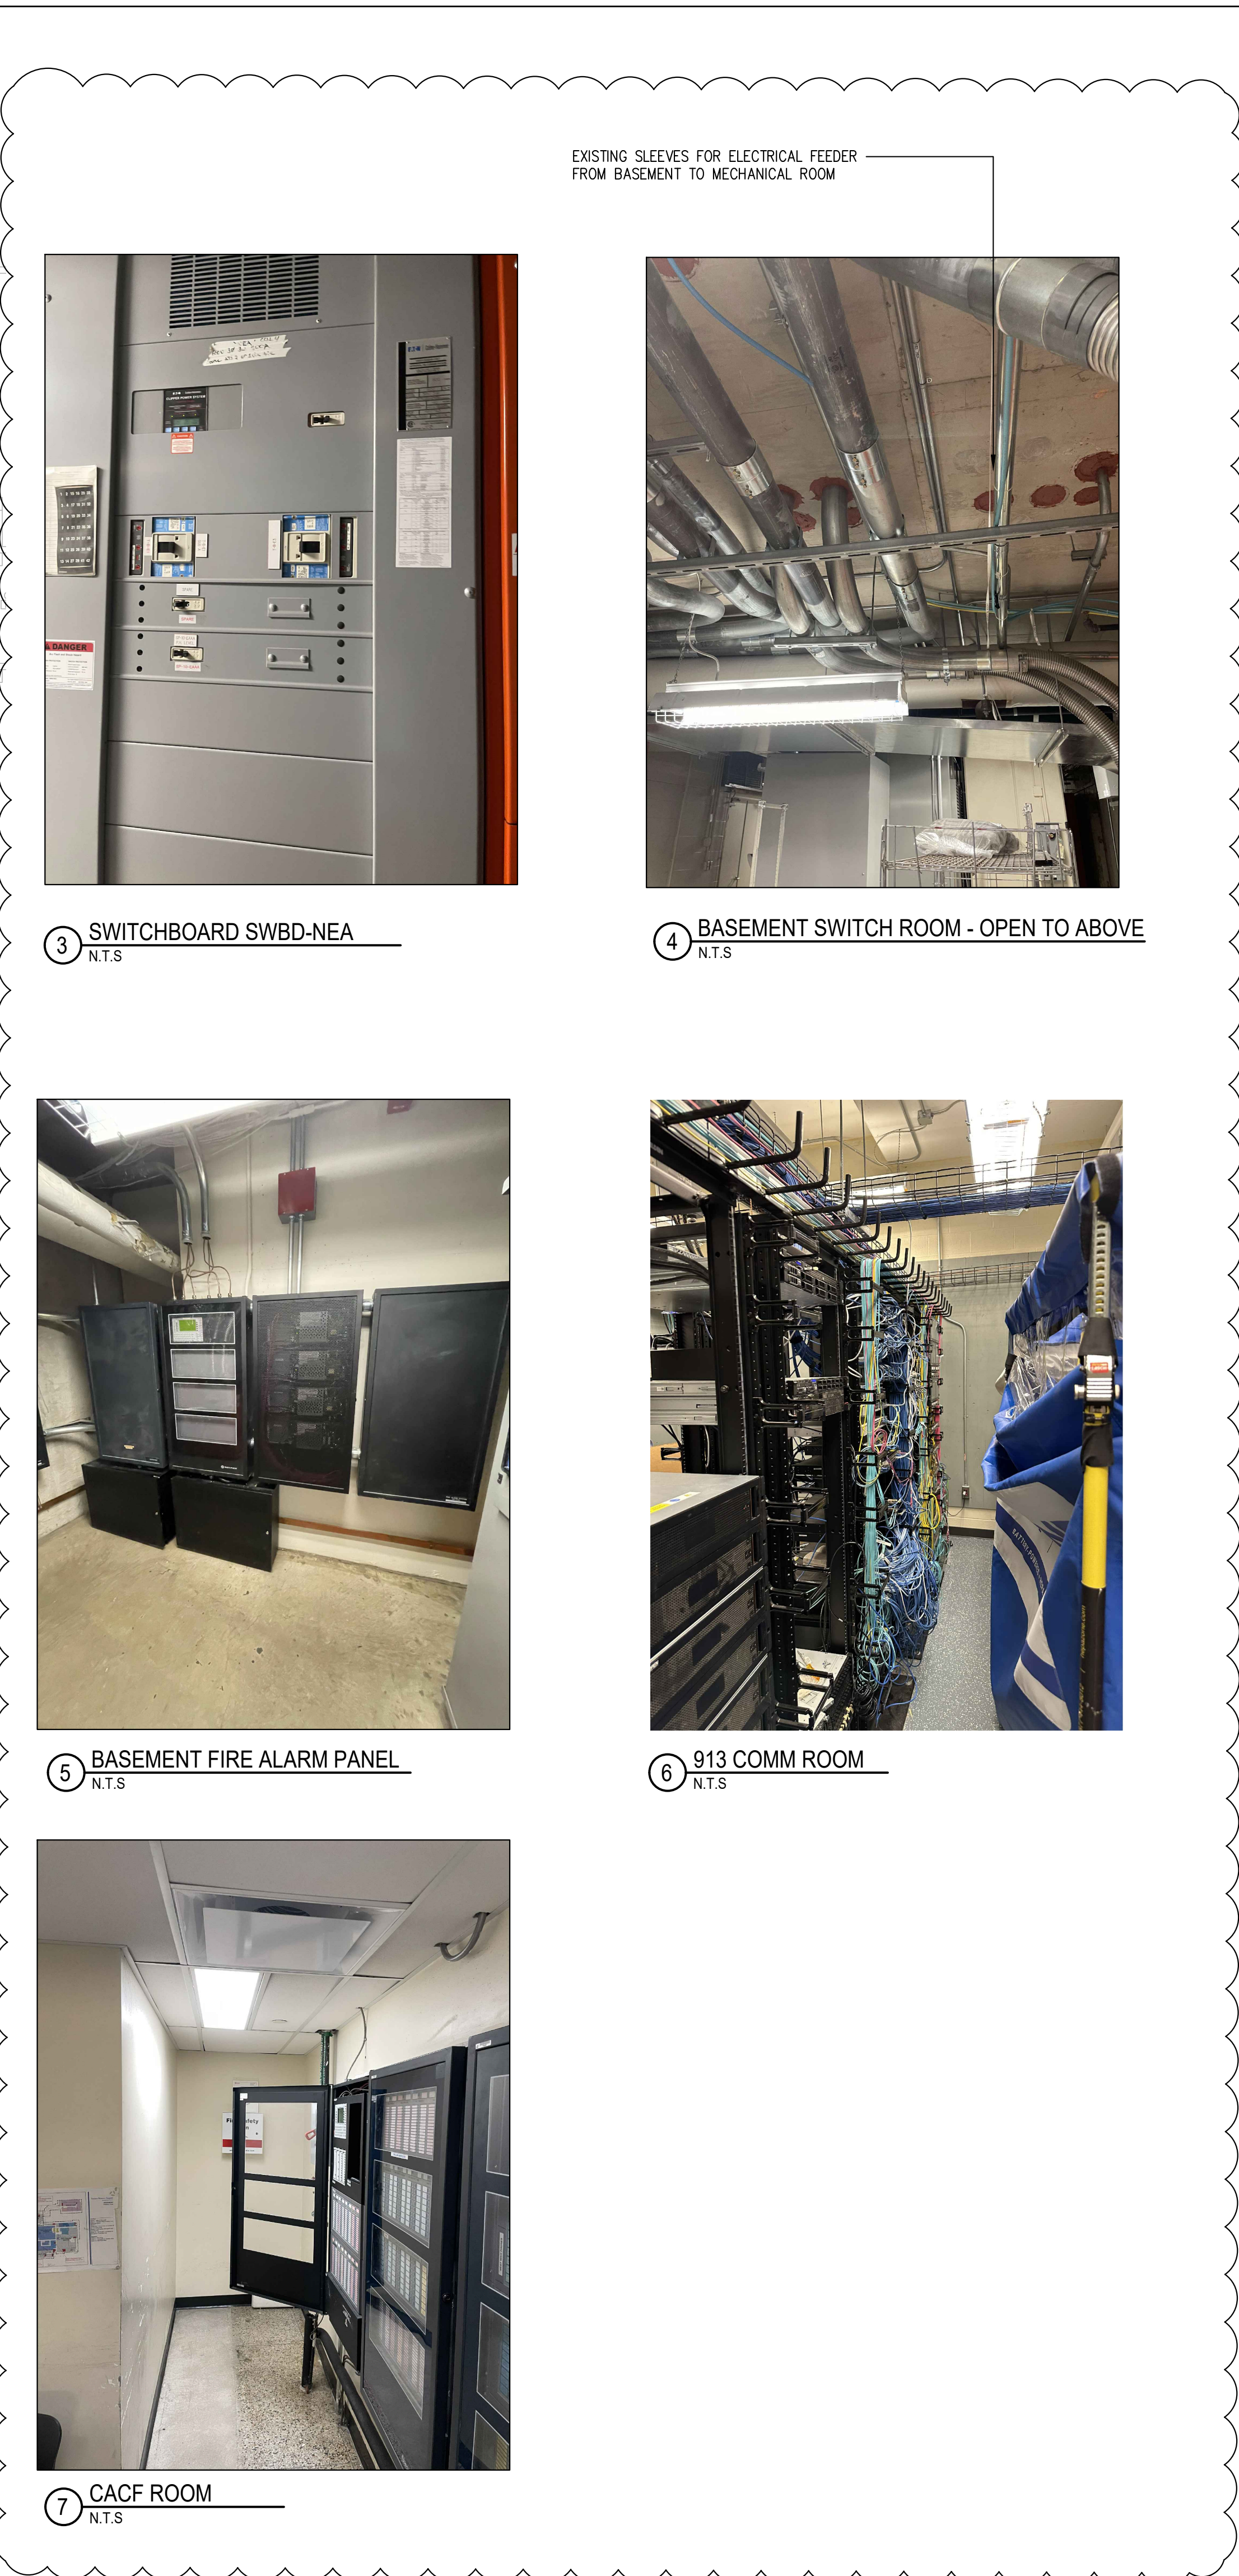


3 SWITCHBOARD SWBD-NEA
N.T.S.

4 BASEMENT SWITCH ROOM - OPEN TO ABOVE
N.T.S.


5 BASEMENT FIRE ALARM PANEL
N.T.S.

6 913 COMM ROOM
N.T.S.


7 CACF ROOM
N.T.S.



University Health Network
Toronto Western Hospital
399 Bathurst Street
Toronto ON M5T 2S8
www.uhn.ca

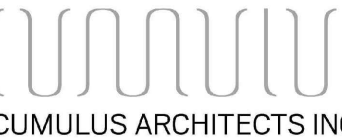

160 Pears Ave - Suite 300
Toronto, ON M5R 3P8
416-538-0763
www.cumulusarch.com



exp.
• BUILDINGS • EARTH & ENVIRONMENT • ENERGY •
• INDUSTRIAL • INFRASTRUCTURE • SUSTAINABILITY •

PROJECT STATUS:

REVISIONS

NO	DESCRIPTION	DATE
1	Issued for Design Development Progress	2024.04.05
2	Issued for 100 CD	2024.05.10
3	Issued for 50% CD / Permit	2024.08.02
4	Issued for 90% CD	2024.09.06
5	Issued for 100% CD	2024.09.27
6	Issued for Tender	2024.10.11
7	Issued for Tender Addendum	2024.10.25
8	Issued for Tender Addendum No.4	2024.11.12
9	Issued for Tender Addendum No.5	2024.11.19




PROJECT:
UHN TWH - Seniors Emergency Medicine Centre
399 Bathurst Street, Toronto ON M5T 2S8
UHN PROJECT NO.: SAP #110022016

TITLE:
BASEMENT FLOOR PLAN

PROJECT NO:
MRK-23004289

DRAWING NO:
E-204

CHECKED:
M.S.

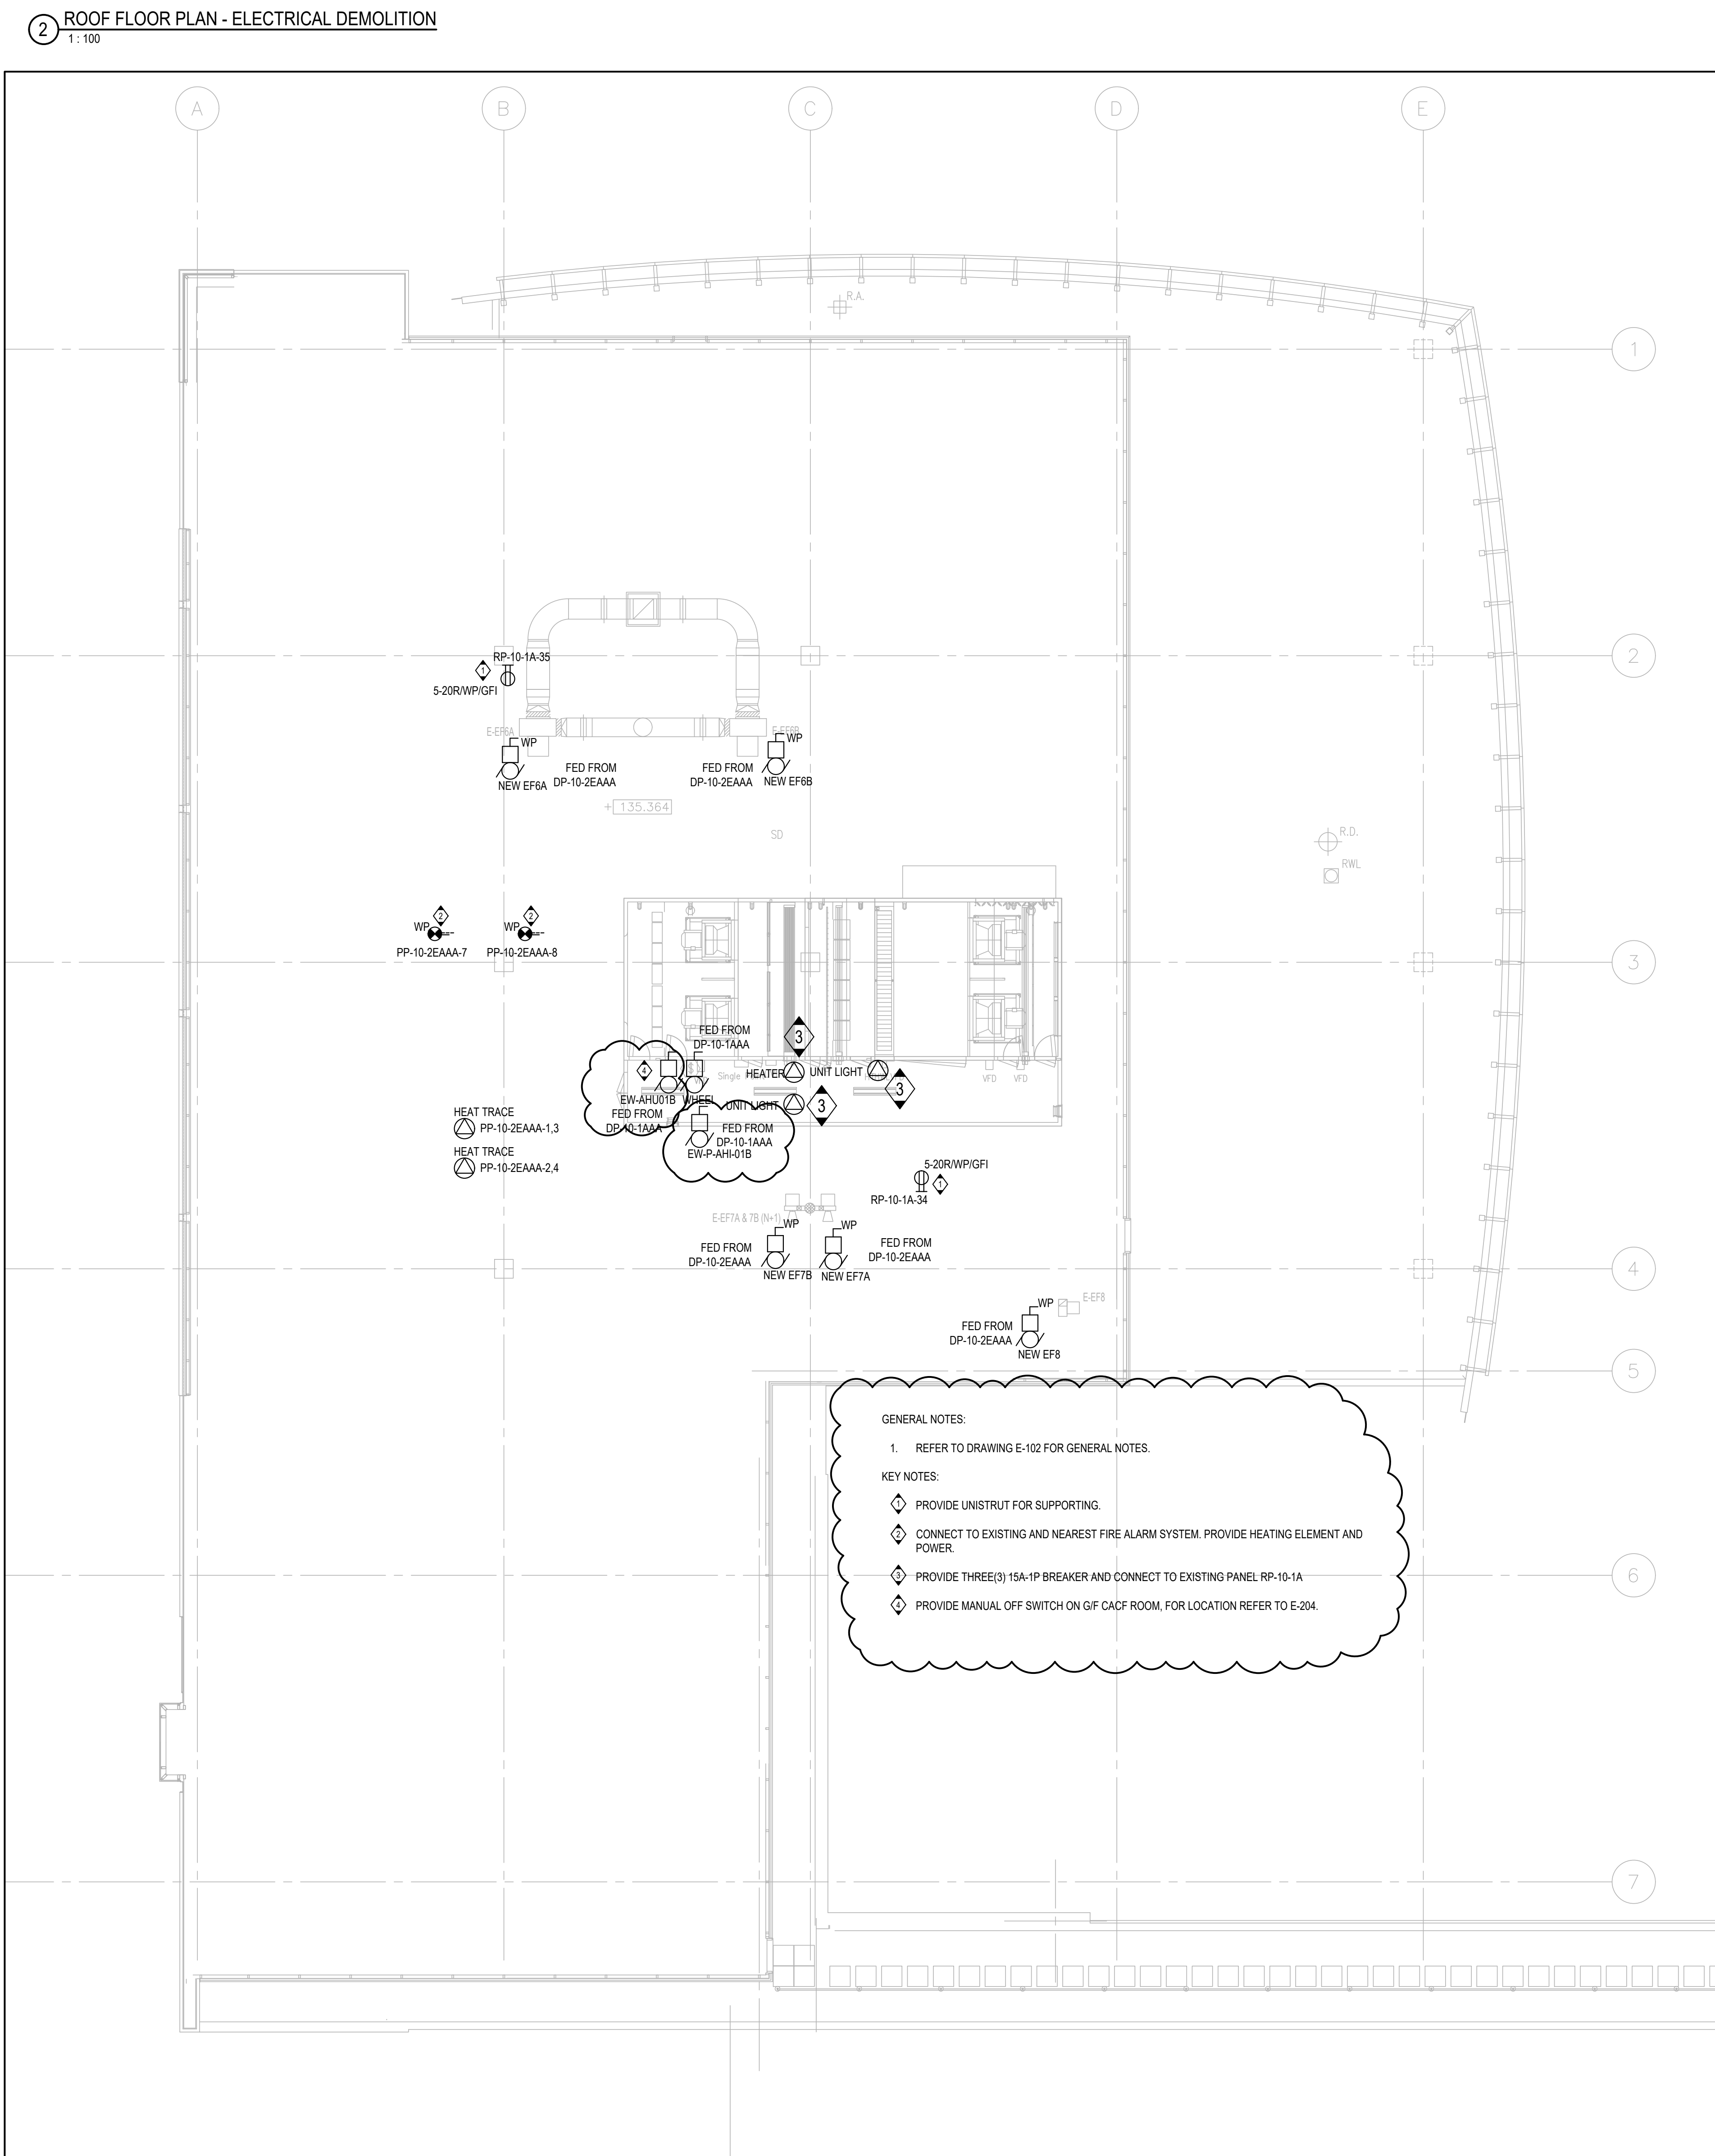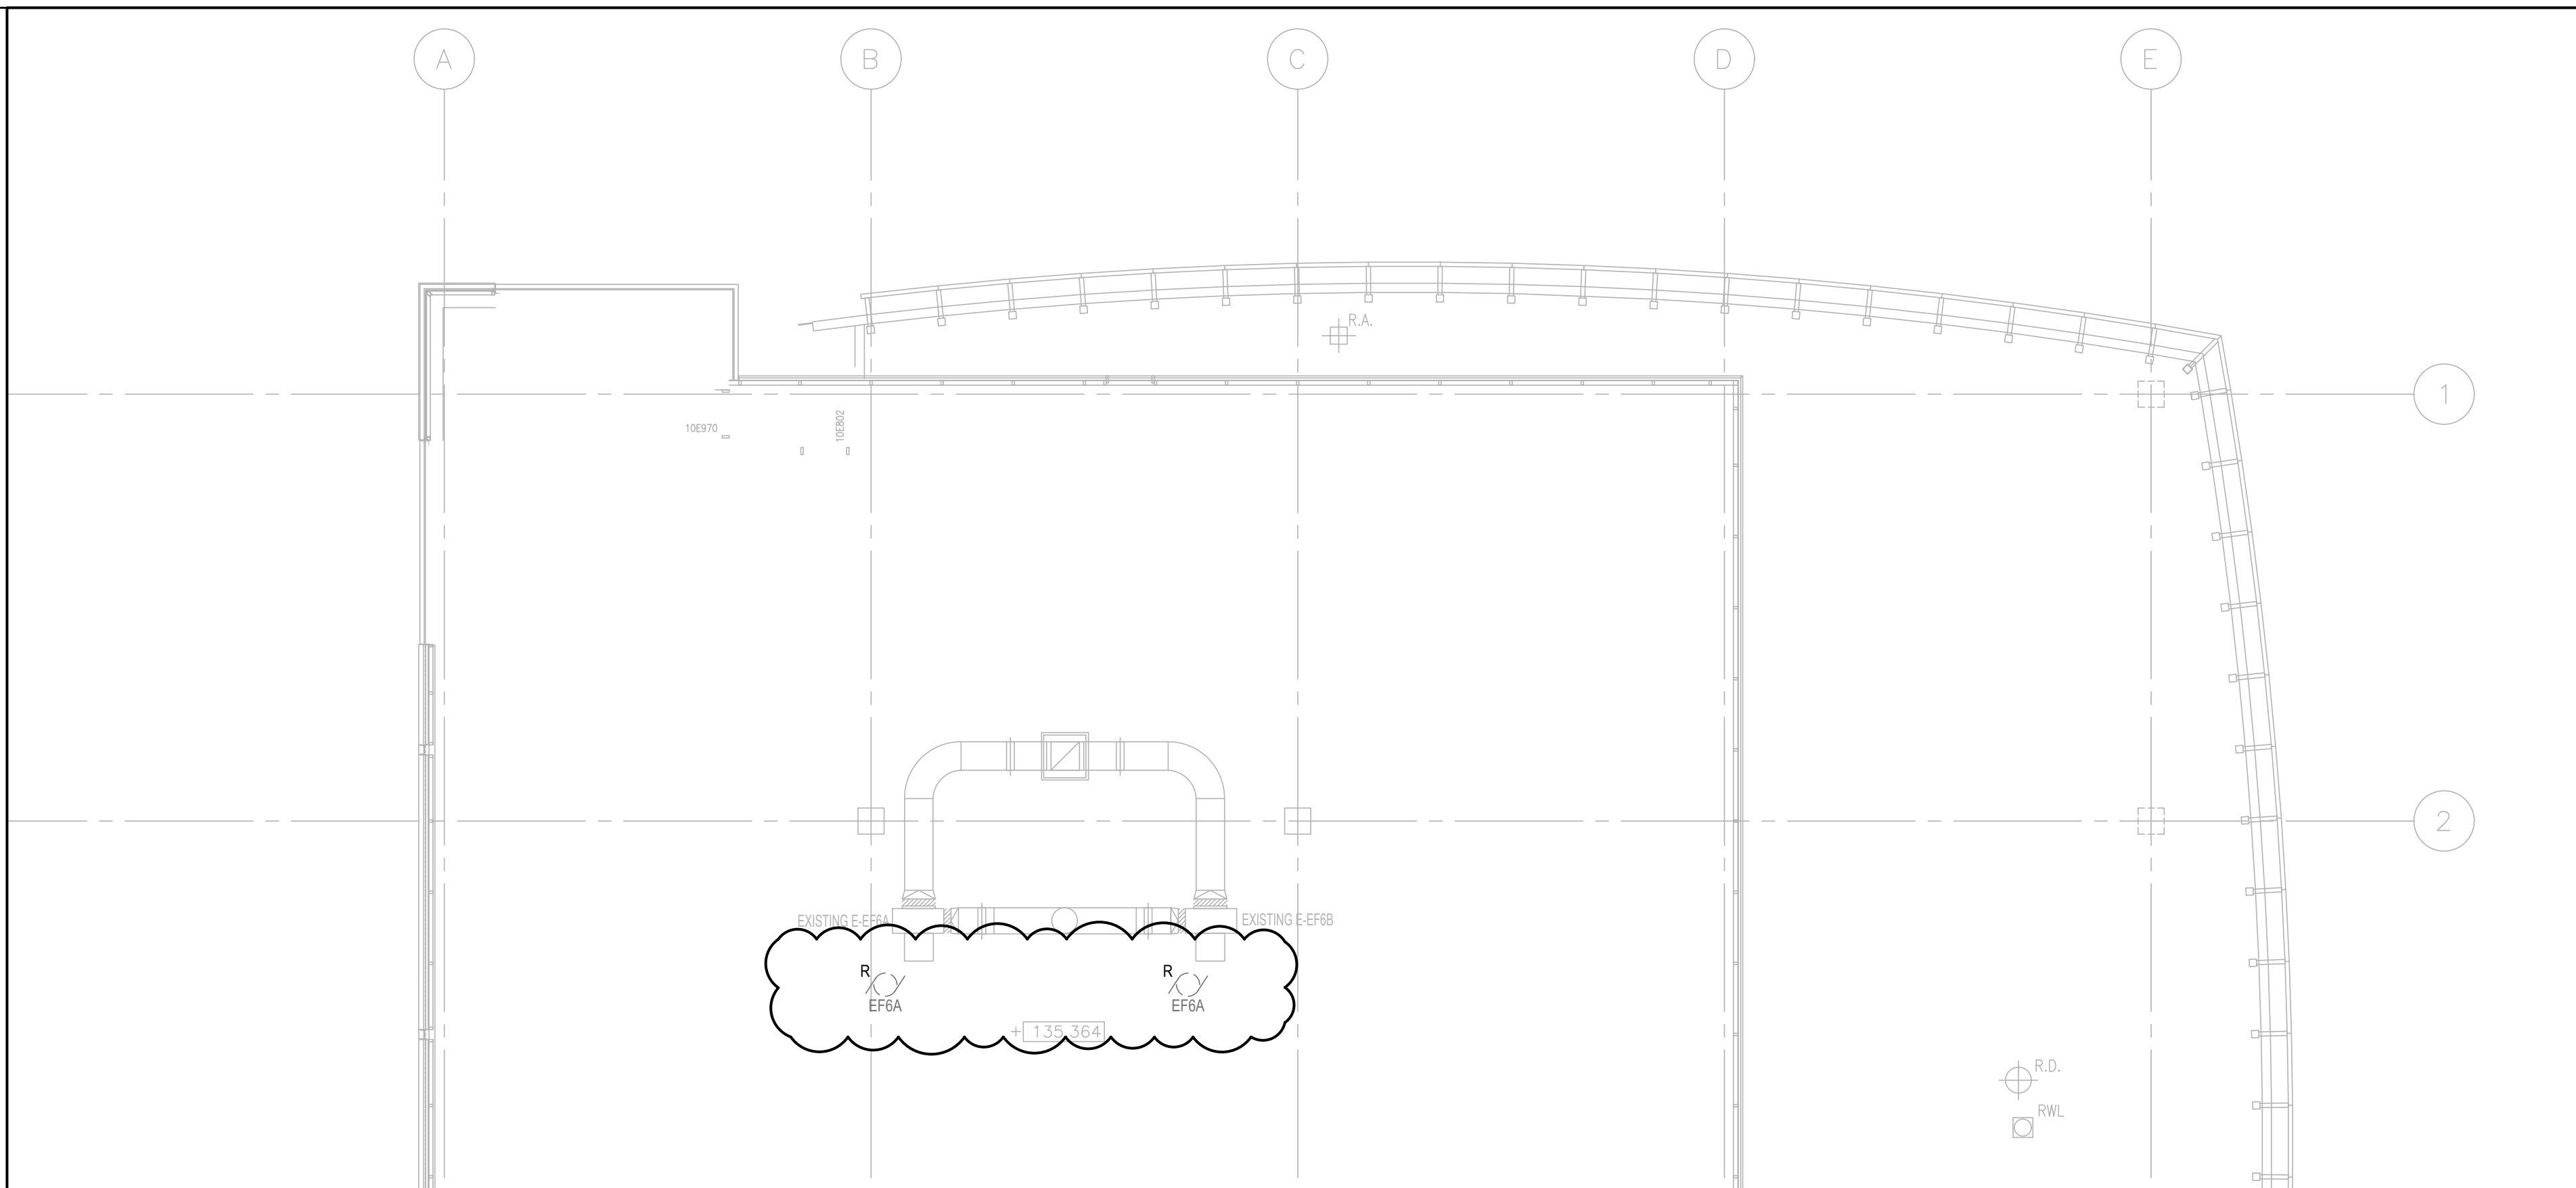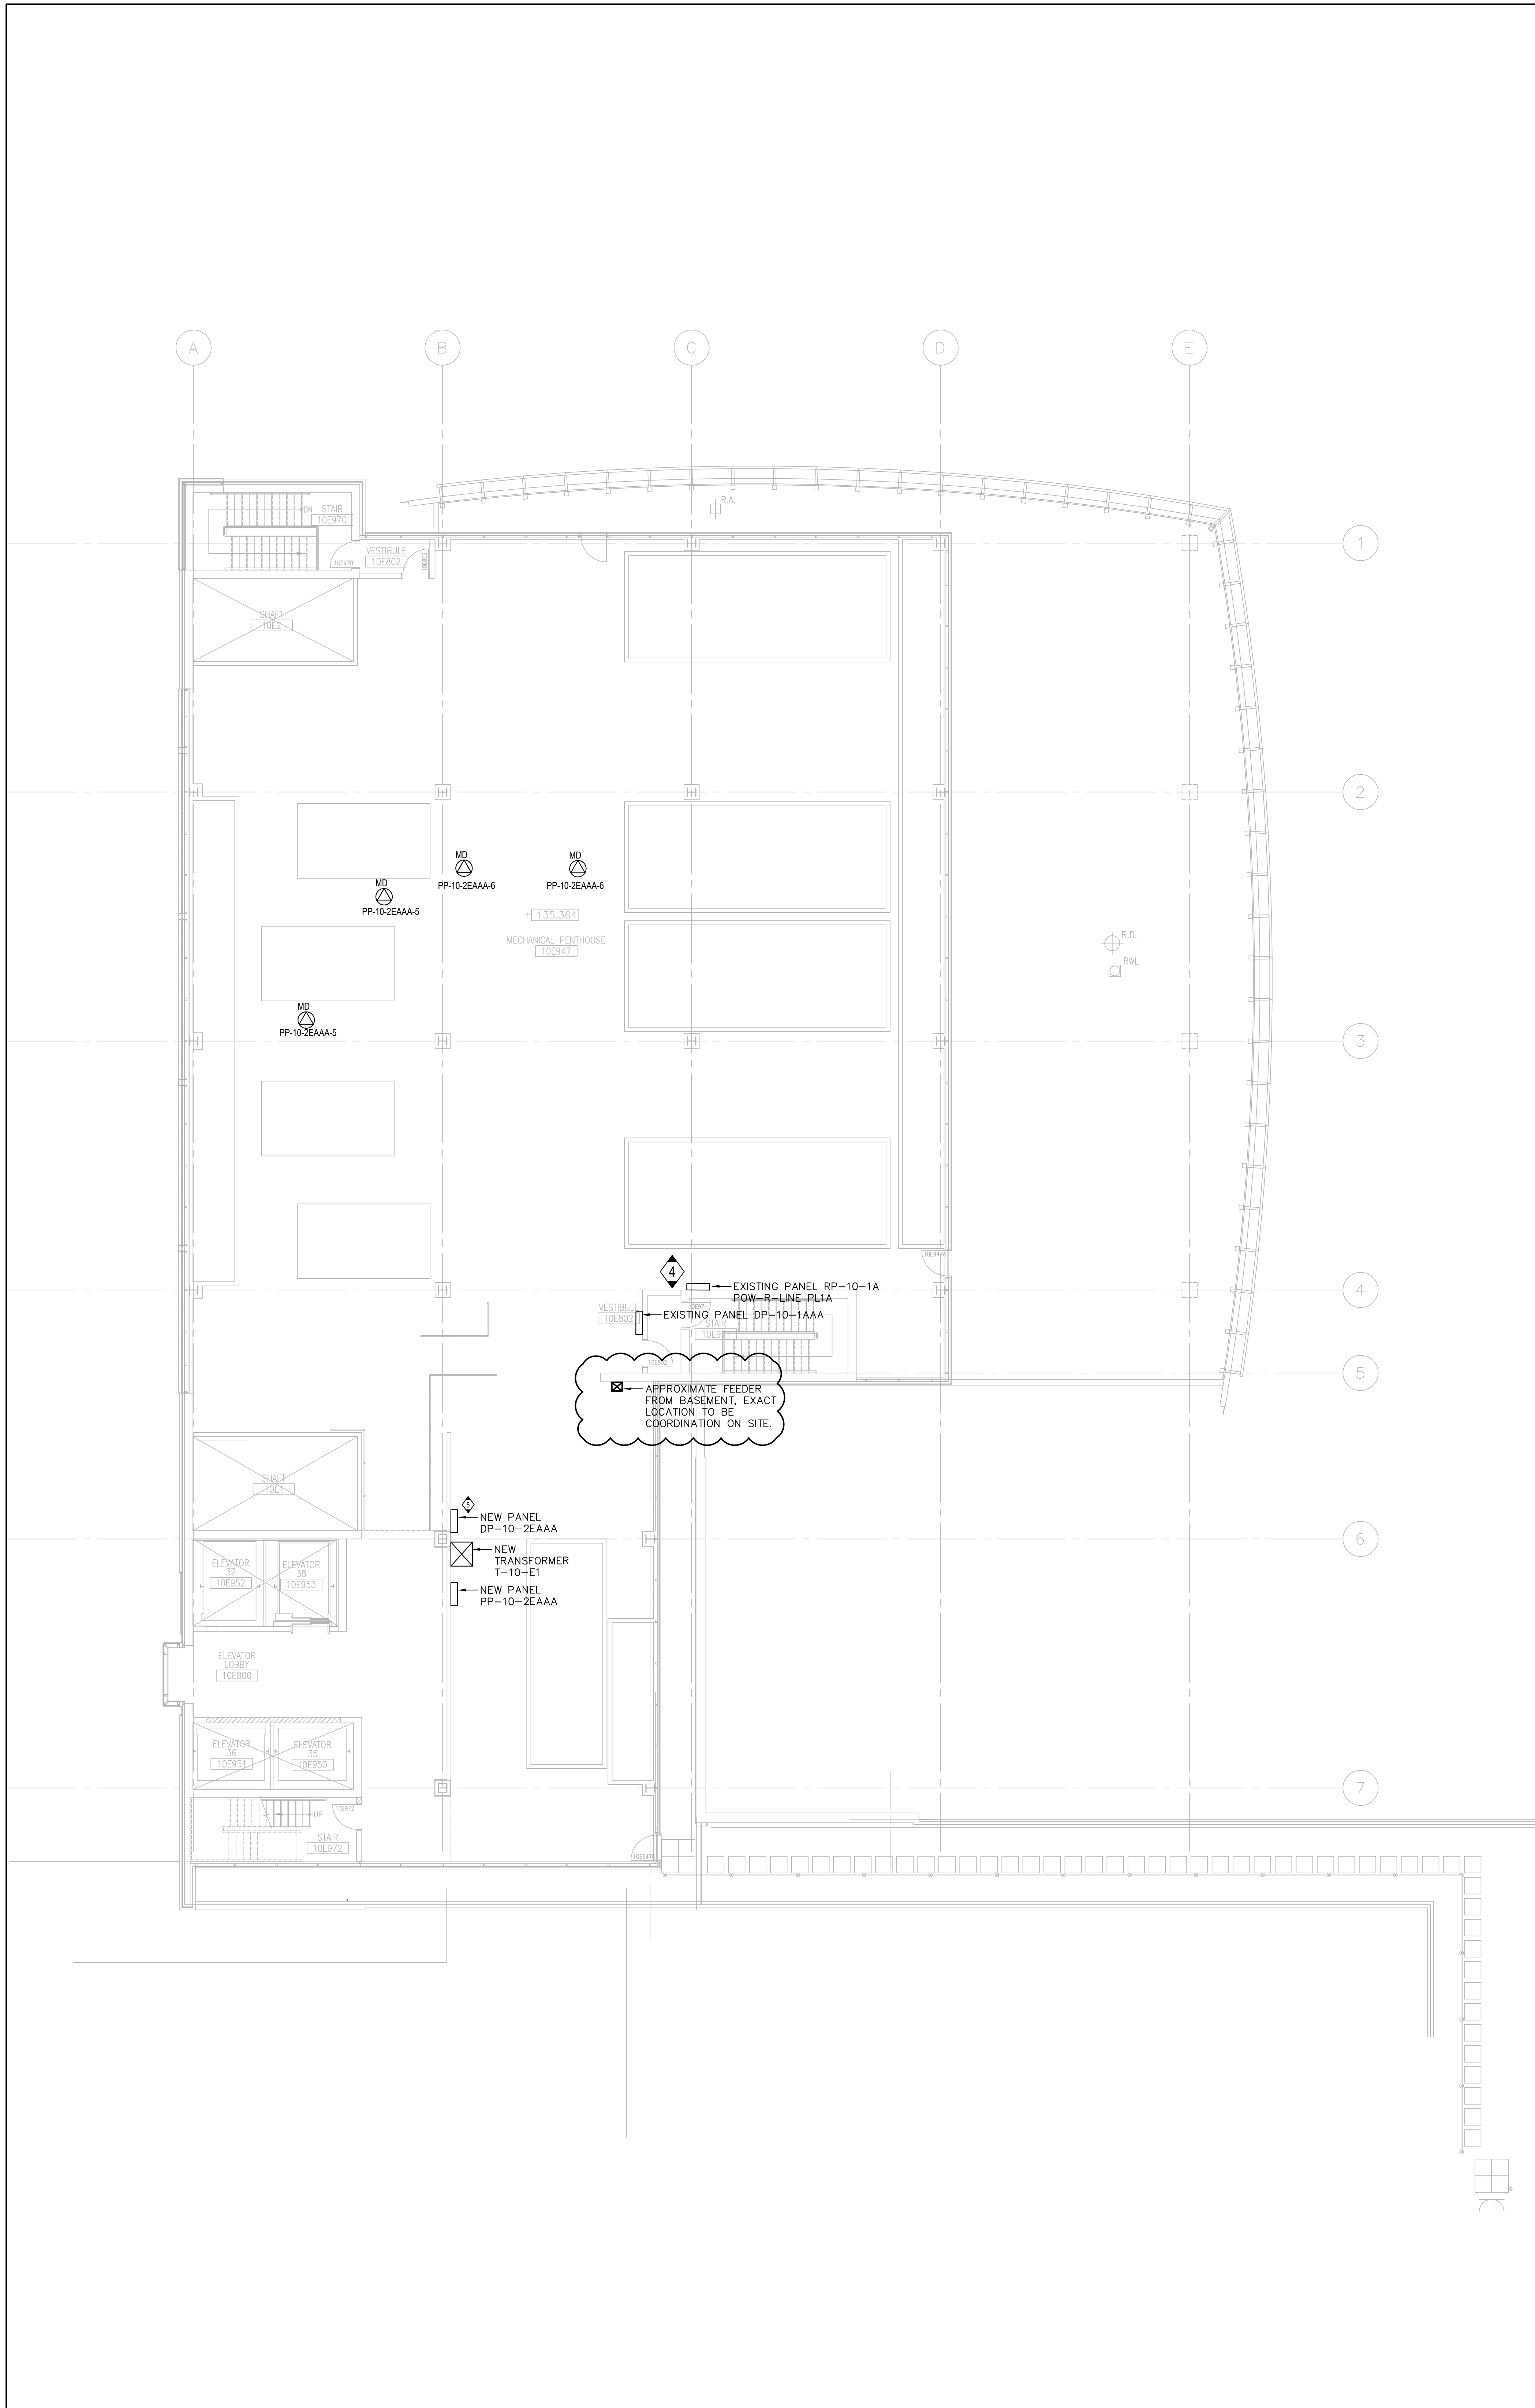

CLIENT:

UHN University Health Network
Toronto Western Hospital
399 Bathurst Street
Toronto ON M5T 2S8
www.uhn.ca

ARCHITECT:

CUMULUS ARCHITECTS INC. 160 Pears Ave. - Suite 300
Toronto, ON M5R 3P8
416-598-0763
www.cumulusarch.com

CONSULTANT:

exp.
1-800-695-3217 (T: 905-695-0167)
220 Commerce Valley Drive West, Suite 110
Markham, ON L3T 0A8
Canada
www.exp.com

• BUILDINGS • EARTH & ENVIRONMENT • ENERGY •
• INDUSTRIAL • INFRASTRUCTURE • SUSTAINABILITY •

PROJECT STATUS:

REVISIONS

NO.	DESCRIPTION	DATE
1	Issued for Design Development Progress	2024.04.05
2	Issued for 100% CD	2024.05.10
3	Issued for 50% CD / Permit	2024.08.02
4	Issued for 90% CD	2024.09.06
5	Issued for 100% CD	2024.09.27
6	Issued for Tender	2024.10.11
7	Issued for Tender Addendum No.2	2024.11.01
8	Issued for Tender Addendum No.4	2024.11.12
9	Issued for Tender Addendum No.5	2024.11.19

PROJECT:

UHN TWH - Seniors Emergency Medicine Centre
399 Bathurst Street, Toronto ON M5T 2S8
UHN PROJECT NO.: SAP #110022016

TITLE:

PENTHOUSE & ROOF FLOOR PLAN -
ELECTRICAL LAYOUT

PROJECT NO:
MRK-23004289

DRAWING NO:
E-205

CHECKED:
M.S.

MECHANICAL EQUIPMENT SCHEDULE(BY OTHERS)

[illegible]

FORCE FLOW HEATER SCHEDULE																			
EQUIPMENT TAG	LOCATION	DESCRIPTION	MANUFACTURER	MODEL	AIRFLOW (L/S)	HEATING CAPACITY (KW)	EWT (°C)	FLUID		PRESSURE DROP (KPa)	ELECTRICAL		EMERGENCY POWER (V/N)	REMOTE THERMOSTAT (V/N)	DIMENSIONS			WEIGHT (KG)	REMARKS
								LWT (°C)	FLOW (L/S)		MOTOR (KW)	POWER (V/Ph/Hz)			LENGTH (MM)	WIDTH (MM)	HEIGHT (MM)		
EW-FPH01	EXIT 1EW36 (SEM CENTRE)	CEILING MOUNTED	SIGMA	SFF-A-02	104	4	66	54	0.1	0.07	0.075	120/160	Y	N	660	241	660	34.0	
FP-FPH01	EXIT DOOR AT FP ROOF & STAIR	CEILING MOUNTED	SIGMA	SFF-A-02	104	4	66	54	0.1	0.71	0.075	120/160	Y	N	660	241	660	34.0	
FP-UH0101	LOWER LEVEL	CEILING MOUNTED	SIGMA	015H	132	4	66	54	0.18	2.09	0.037	120/160	Y	N	483	368	343	13.2	
NOTES: 1 C/W LOCALISED PACKAGED CONTROLS.																			

ENERGY RECOVERY VENTILATOR SCHEDULE (ERV)															
SYSTEM REFERENCE TAG	DESCRIPTION	LOCATION	MANUFACTURER	MODEL	AIR FLOW (CFM)	AIR FLOW (L/S)	HEATING COIL (ELEC)		ELECTRICAL (UNIT AND ELEC. HEATER)			EMERGENCY POWER (Y/N)	FIRE SHUT DOWN (Y/N)	UNIT WEIGHT (KG)	REMARKS
							TOTAL (KVA)	FLA (A)	MCA (A)	MROPD (A)	POWER (V/KHz/PH)				
FP-AH12ERV-1	ENERGY RECOVERY	CEILING MOUNTED	OXYGEN 8	A16IN	500	236	2.00	14.9	18.3	20	208/60/1	Y	Y	200.0	
FP-AH12ERV-1	ENERGY RECOVERY	CEILING MOUNTED	OXYGEN 8	A16IN	500	236	2.00	14.9	18.3	20	208/60/1	Y	N	200.0	
NOTES:															
1. ERV DESIGNED WITH FAN AND ELEC. HEATER FOR PRE HEAT															
2. PROVIDE ECM MOTOR															
3. ALL UNITS TO HAVE BOTTOM ACCESS FOR SERVICE.															
4. MERV 13/8 FILTERS															
5. MAIN POWER WILL FEED THE ELEC. HEATER AND ELECTRICAL CONTRACTOR TO PROVIDE WIRING FROM HEATER TO THE UNIT.															
6. MAINTAIN CLEARANCE AS REQUIRED, UNIT TO BE INSTALLED SUCH A WAY THAT IT CAN BE DROPPED FOR MAINTENANCE WITHOUT PIPING REWORK.															

ELECTRIC HEAT TRACING SCHEDULE								
REFERENCE TAG	MANUFACTURER	MODEL	DESCRIPTION	LENGTH (M)	REQUIRED	ELECTRIC...	REMARKS	
					OUTPUT (W/M)	V/PH/NZ		EMERGENCY POWER (Y/N)
ETC-01	RAYCHEM	5XL2E-CR	SERVING CORRIDOR CANOPY	32.6	10	208/160	Y	CONTROLLER C910-485 RAYCHEM
NOTES:	1. PROVIDE CABLE SEGMENTS AS REQUIRED TO COMPLETELY TRACE PIPING RUN AS INDICATED ON DRAWINGS.							
	2. PROVIDE RAYCHEM (OR EQUIVALENT) POWERED AND UN-POWERED CONNECTIONS AND SUPPORTS AS REQUIRED TO PROVIDE COMPLETE SYSTEM.							
	3. PICK-UP DRY CONTACTS AT EACH CONTROLLER TO ALARM BAS ON ANY TROUBLE SIGNAL.							
	4. COMMUNICATIONS CABLE IS REQUIRED TO BE EXTENDED FROM PIPE MOUNTED RTD BACK TO CONTROLLER. ALLOW FOR SUFFICIENT CONTROLS CABLING AND CONDUIT.							
	5. CONTROLS CABLE TO BE IN CONDUIT.							
	6. HEAT TRACING AND PIPE SYSTEMS ARE DESIGNED FOR -23°C (-10°F) AMBIENT TEMPERATURE.							
	7. THIS SCHEDULE IS TO BE READ IN CONJUNCTION WITH SPECIFICATION 20 05 25 REGARDING STANDARDS FOR PIPE INSULATION.							

AIR CURTAIN SCHEDULE (ELECTRIC)																
SYSTEM REFERENCE TAG	LOCATION	DESCRIPTION	MANUFACTURER	MODEL	AIRFLOW (L/S)	HEATING CAPACITY (KW)	ELECTRICAL		EMERGENCY POWER (Y/N)	REMOTE THERMOSTAT (Y/N)	UNIT				WEIGHT (KG)	REMARKS
							MOTOR (KW)	POWER (V/Ph/Hz)			NZ WIDTH (MM)	WIDTH (MM)	HEIGHT (MM)	DEPTH (MM)		
FP-ACH11	CORRIDOR EAST DOOR	CEILING MOUNTED		CHA-2-T2 (E)	1659	20	2 x 0.75	575/360	Y	N	1800	1900	426	515	182	
NOTES:	1. UNIT IS CW LOCAL CONTROL PANEL/DISCONNECT WITH BACnet CARD TO BE CONNECTED TO BAS CONTROLS 2. MECHANICAL CONTRACTOR TO INCLUDE FOR STEP DOWN TRANSFORMER IF REQUIRED AND ELEC. TO PROVIDE POWER. 3. INTERLOCK UNIT WITH CONCEALED DOOR SWITCH AND UNIT TO BE BOTTOM SUPPLY AND BOTTOM RETURN. 4. UNIT COLOR TO BE COORDINATED ON SITE AND WITH ARCH. BEFORE ORDERING 5. FOR EQUALS OR ALTERNATES - THE MIN LENGTH WILL BE TO COVER THE DOOR OPENING AND IF THE UNIT IS LONGER ITS TO BE ACCEPTED BY THE CONSULTANTS. 6. MOUNTING AS PER MANUFACTURER RECOMMENDATION															

FAN SCHEDULE															REMARKS
SYSTEM REFERENCE TAG	DESCRIPTION	LOCATION	MANUFACTURER	MODEL	AIR FLOW (CFM)	AIR FLOW (L/S)	FAN E.S.P. (Pa)	MIN OUTLET VELOCITY (M/S)	ELECTRICAL		FAN EFFICIENCY %	EMERGENCY POWER (Y/N)	FIRE SHUT DOWN (Y/N)	UNIT WEIGHT (KG)	
									POWER (V/Hz/PH)	FLA (A)					
EW-EF-14	WASHROOM EXH.	ROOF	PENNBARRY	D10	700	330	374	8	575/603	0.9	1.18	Y	N	13.6	
EW-EF-13A & 13B	ISOLATION EXH.	ROOF	PENNBARRY	D08	850	401	747	8	575/603	2.4	99.00	Y	N	16.8	
EW-EF-6A & 6B	EXISTING TB EXHAUST SYSTEM	ROOF	PENNBARRY	VCR-SWSI-AF 222	7842	3,701	1643	8	575/603	17.0	1.26	Y	N	90.7	EXISTING FANS TO BE REPLACED WITH NEW FANS TO ADD HEPA FILTERS IN THE...
NOTES: 1. ALL ROOF MOUNTED FANS CW 450 MM HIGH ROOF CURB. 2. DIRECT DRIVE WITH EC MOTOR. 3. PROVIDE WEATHER PROOF DISCONNECTS FOR ALL OUTDOOR FANS. 4. PROVIDE LOCAL DISCONNECTS FOR CELING/ROOF MOUNTED FANS. 5. PROVIDE VFDS FOR ALL FANS IN THE PENTHOUSE AND LOCAL DISCONNECT. COORDINATE EXACT LOCATION ON SITE 6. EXHAUST STACK SHOULD BE MINIMUM 3M ABOVE ANY NEARBY AIR INTAKE (EW-AHU-01b) 7. FAN/STACK SUPPORTS SHALL BE PROVIDED															

FAN COIL UNIT SCHEDULE (2P CHILLED WATER)																					
SYSTEM REFERENCE TAG	DESCRIPTION	LOCATION	MANUFACTURER	MODEL	AIR FLOW (CFM)	AIR FLOW (L/S)	UNIT E.S.P. (Pa)	COOLING COIL						ELECTRICAL				EMERGENCY POWER (Y/N)	FIRE SHUT DOWN (Y/N)	UNIT WEIGHT (KG)	REMARKS
								TOTAL (KW)	SENSIBLE (KW)	EWI (°C)	LWT (°C)	FLOW (L/S)	PD (KPA)	FLA (A)	MCA (A)	MROPD (A)	POWER (V/Hz/PH)				
EW-FCU-01	IT ROOM COOLING UNIT	IT ROOM	IEC	HYL16	1478	698	50	13.84	13.36	5.6	12.2	0.49	9.27	11.4	12.825	20	115/60/1	N	Y	102.05	
<div>NOTES:</div> <div>1. FAN COIL UNIT TO BE COMPLETE WITH 2" (50MM) MERV 13 FILTER SECTION.</div> <div>2. PROVIDE ECM MOTOR</div> <div>3. FAN COIL UNIT TO HAVE BOTTOM ACCESS FOR SERVICE.</div> <div>4. FCU IS COMPLETE WITH DRAIN PAN AND DRAIN PUMP</div>																					




AIR COOLED CONDENSING UNIT SCHEDULE												REMARKS
SYSTEM REFERENCE TAG	AC INDOOR UNIT REFERENCE	LOCATION	MANUFACTURER	MODEL	NOMINAL	ELECTRICAL			EMERGENCY POWER (Y/N)	FIRE ALARM SHUT DOWN (Y/N)	WEIGHT (KG)	
					COOLING CAPACITY (KW)	MOP AMPS	MCA AMPS	VOLTAGE V/PH/Hz				
FP-AH12-CU	FP-AH12	OUTDOOR	REFPLUS	OEZ-050-1H1-SD	15.94	40	26.38	208/60/3	Y	N	172	
FP-AH13-CU	FP-AH13	OUTDOOR	REFPLUS	OEZ-050-1H1-SD	15.94	40	26.38	208/60/3	Y	N	172	
FP-AH14-CU	FP-AH14	OUTDOOR	REFPLUS	OEZ-050-1H1-SD	15.94	40	26.38	208/60/3	Y	N	172	
NOTES:												
1. REFRIGERANT SHALL BE R410A OR ANY LATEST REF. AVAILABLE AS LONG AS THE UNIT CAPACITY AND SIZING IS MET.												
2. CONTRACTOR TO COORDINATE ON SITE FOR THE REFRIGERANT PIPING SIZE AND INSTALLATION BASED ON MANUFACTURER RECOMMENDATION.												
3. MECHANICAL CONTRACTOR TO COORDINATE WALL, CEILING AND ROOF PENETRATIONS AND ELECTRICAL REQUIREMENTS ON SITE.												
4. REFER TO ASSOCIATED INDOOR UNIT SCHEDULE FOR COMPLETE SYSTEM INFORMATION.												
5. UNITS COMPLETE WITH LOW-AMBIENT KIT. FINAL LOCATION AND ENCLOSURE TO BE COORDINATED WITH ARCH. DRAWINGS												


CEILING MOUNTED VENTILATION UNIT SCHEDULE																													
SYSTEM REFERENCE TAG	DESCRIPTION	LOCATION	MANUFACTURER	MODEL	AIR FLOW		UNIT E.S.P. (Pa)	COOLING COIL (DX)						HEATING COIL (30% P GLY)						SILENCER		ELECTRICAL			EMERGENCY POWER (Y/N)	FIRE SHUT DOWN (Y/N)	UNIT WEIGHT (KG)	REMARKS	
					(CFM)	(L/S)		TOTAL (KW)	SENSIBLE (KW)	EAT DB (°C)	EAT WB (°C)	LAT DB (°C)	LAT WB (°C)	TOTAL (KW)	EAT DB (°C)	LAT DB (°C)	EWT (°C)	LWT (°C)	FLOW (L/S)	PD (KPA)	INLET (Y/N)	DISCHARGE (Y/N)	MCA (A)	MROPD (A)					POWER (V/Hz/PH)
FP-ACH12	CORRIDOR VENT.	CORRIDOR CEILING MOUNTED	DAIKIN	BCHD0161	1500	708	124	15.6	13	26.7	18.3	12.0	11.7	5.4	21.10	27.3	50.7	37.8	0.095	0.81	N	N	19.8	25	115/50/1	Y	N	216	
FP-ACH13	CORRIDOR VENT.	CORRIDOR CEILING MOUNTED	DAIKIN	BCHD0161	1500	708	124	15.6	13	26.7	18.3	12.0	11.7	5.4	21.10	27.3	50.7	37.8	0.095	0.81	N	N	19.8	25	115/50/1	Y	N	216	
FP-ACH14	CORRIDOR VENT.	CORRIDOR CEILING MOUNTED	DAIKIN	BCHD0161	1500	708	124	15.6	13	26.7	18.3	12.0	11.7	5.4	21.10	27.3	50.7	37.8	0.095	0.81	N	N	19.8	25	115/50/1	Y	N	216	
NOTES: 1. UNITS TO BE COMPLETE WITH 2" (50MM) MERV 13 FILTER SECTION. 2. PROVIDE ECM MOTOR 3. ALL UNITS TO HAVE BOTTOM ACCESS FOR SERVICE AND INSTALLED IN SUCH A WAY THAT THE UNIT CAN BE DROPPED DOWN FOR MAINTENANCE WITHOUT THE PIPING REWORK. 4. REFER TO FLOOR PLANS FOR LOCATIONS AND PROVIDE REQUIRED CLEARANCE AS PER THE MANUFACTURER RECOMMENDATION 5. REFER TO CONDENSING UNIT SCHEDULE FOR OUTDOOR UNITS. 6. FCUS ARE COMPLETE WITH DRAIN PAN AND LEAK DETECTION																													

PUMP SCHEDULE (HYDRONIC SYSTEM)															REMARKS
SYSTEM REFERENCE TAG	DESCRIPTION SYSTEM	LOCATION	MANUFACTURER	MODEL	FLUID TYPE	FLOW RATE (L/S)	PUMP HEAD (KPA)	MOTOR SIZE MOTOR POWER (KW)	DUTY POINT POWER (KW)	ELECTRICAL (V/PH/Hz)	VFD (Y/N)	OPERATION (DUTY/STANDBY)	PRESSURE RATING (KPA)	EMERGENCY POWER (Y/N)	
EW-P-AHU-018	COOLING PUMP	AHU VESTIBULE	BELL & GOSSETT	E-80 SERIES 4X4X78	30% P.G.	15	82	2.2	2.0	575/360	Y	DUTY	1207	Y	
NOTES: 1. BAS INTERFACE FOR SETPOINT MONITORING, ALARM, ETC. 2. PUMP COMPLETE WITH VFD. MECHANICAL CONTRACTOR TO SUPPLY AND ELECTRICAL CONTRACTOR TO INSTALL THE VFD. 3. PROVIDE SUCTION GUIDE & FLO-TREX VALVE 4. PROVIDE 25-50MM RUBBER/NOPRENE PADS, THE PUMP IS TO BE INSTALLED INTEGRAL TO THE UNIT VESTIBULE AND COODINATED BY AHU UNIT SUPPLIER, CONTRACTOR TO PROVIDE PROPER CLEARANCE FOR MAINTENANCE.															


PLUMBING & DRAINAGE PUMPS													
REFERENCE TAG	SERVICE	LOCATION	TYPE	FLOW RATE US	HEAD PRESSURE KPA	RPM	MANUFACTURER-MODEL	MOTOR SIZE KW (HP)	ELECTRICAL POWER SUPPLY (V/PH/Hz)	STARTER TYPE	WEIGHT (KG)	EMERGENCY POWER(Y/N)	COMMENTS
PP-01	DHW RECIRCULATION	LEVEL 0	RECIRCULATION	1.30	110	3450	TACO - VR1SH	0.9	208/160	-	14	NO	
SP-1	SANITARY	FOUNDATION	SUBMERSIBLE	4.7	105	3450	ZOELLER - 6294	1.11 kW	208/3/60		44	YES	DUTY C/W GUIDE RAIL Z-RAIL 39-0129 STEP DOWN TRANSFORMER (600V/208V) TO BE SUPPLIED BY MANUFACTURER.
SP-2	SANITARY	FOUNDATION	SUBMERSIBLE	4.7	105	3450	ZOELLER - 6294	1.11 kW	208/3/60	-	44	YES	STAND-BY C/W GUIDE RAIL Z-RAIL 39-0129 STEP DOWN TRANSFORMER (600V/208V) TO BE SUPPLIED BY MANUFACTURER.
SP-3	SANITARY	FOUNDATION	SUBMERSIBLE	4.7	120	3450	ZOELLER - J6294	1.11 kW	208/3/60	-	44	YES	DUTY C/W GUIDE RAIL Z-RAIL 39-0129 STEP DOWN TRANSFORMER (600V/208V) TO BE SUPPLIED BY MANUFACTURER.
SP-4	SANITARY	FOUNDATION	SUBMERSIBLE	4.7	120	3450	ZOELLER - J6294	1.11 kW	208/3/60	-	44	YES	STAND-BY C/W GUIDE RAIL Z-RAIL 39-0129 STEP DOWN TRANSFORMER (600V/208V) TO BE SUPPLIED BY MANUFACTURER.
NOTES													

TAG	SERVICE	PIPE DIAMETER	PIPE LENGTH		ELECTRICAL V/Ph/Hz	EMERGENCY POWER	COMMENTS
		(mm)	(FT)	(m)			
ETC-01	CHILLED WATER	150	64.0	19.5	208/1/60	(Y/N) Y	
NOTES:	1. PROVIDE CABLE SEGMENTS AS REQUIRED TO COMPLETELY TRACE PIPING RUN AS INDICATED ON DRAWINGS.						
	2. PROVIDE RAYCLOC (OR EQUIVALENT) POWERED AND UN-POWERED CONNECTIONS AND SUPPORTS AS REQUIRED TO PROVIDE COMPLETE SYSTEM.						
NOTES:	3. PICK-UP DRY CONTACTS AT EACH CONTROLLER TO ALARM BAS ON ANY TROUBLE SIGNAL.						
	4. COMMUNICATIONS CABLE IS REQUIRED TO BE EXTENDED FROM PIPE MOUNTED RTD BACK TO CONTROLLER. ALLOW FOR SUFFICIENT CONTROLS CABLING AND CONDUIT.						
	5. CONTROLS CABLE TO BE IN CONDUIT						
	6. HEAT TRACING AND PIPE SYSTEMS ARE DESIGNED FOR -10°F AMBIENT TEMPERATURE.						
	7. THIS SCHEDULE IS TO BE READ IN CONJUNCTION WITH SPECIFICATION 20 07 00 REGARDING STANDARDS FOR PIPE INSULATION.						

<div>CLIENT:</div> <div><div>UHN</div><div><div>University Health Network</div><div>Toronto Western Hospital</div><div>399 Bathurst Street</div><div>Toronto ON M5T 2S8</div><div>www.uhn.ca</div></div></div>		
<div>ARCHITECT:</div> <div><div>CUMULUS ARCHITECTS INC.</div><div><div>160 Pears Ave. - Suite 300</div><div>Toronto, ON M5R 3P8</div><div>416-539-0763</div><div>www.cumulusarch.com</div></div></div>		
<div>CONSULTANT:</div> <div><div><div>1 905.695.3217 1 905.695.0167</div><div>220 Commercial Valley Drive West, Suite 110</div><div>Markham, ON L3T 0A3</div><div>Canada</div></div><div>exp.</div><div><div>www.exp.com</div><div>• BUILDINGS • EARTH & ENVIRONMENT • ENERGY •</div><div>INDUSTRIAL • INFRASTRUCTURE • SUSTAINABILITY •</div></div></div>		
<div>PROJECT:</div> <div>UHN TWH - Seniors Emergency Medicine Centre 399 Bathurst Street, Toronto ON M5T 2S8 UHN PROJECT NO.: SAP #110022016</div>		
<div>TITLE:</div> <div>MECHANICAL EQUIPMENT SCHEDULES</div>		
<div>PROJECT NO:</div> <div>MRK-23004289</div> <div>CHECKED:</div> <div>M.S.</div>	<div>DRAWING NO:</div> <div>E-402</div>	

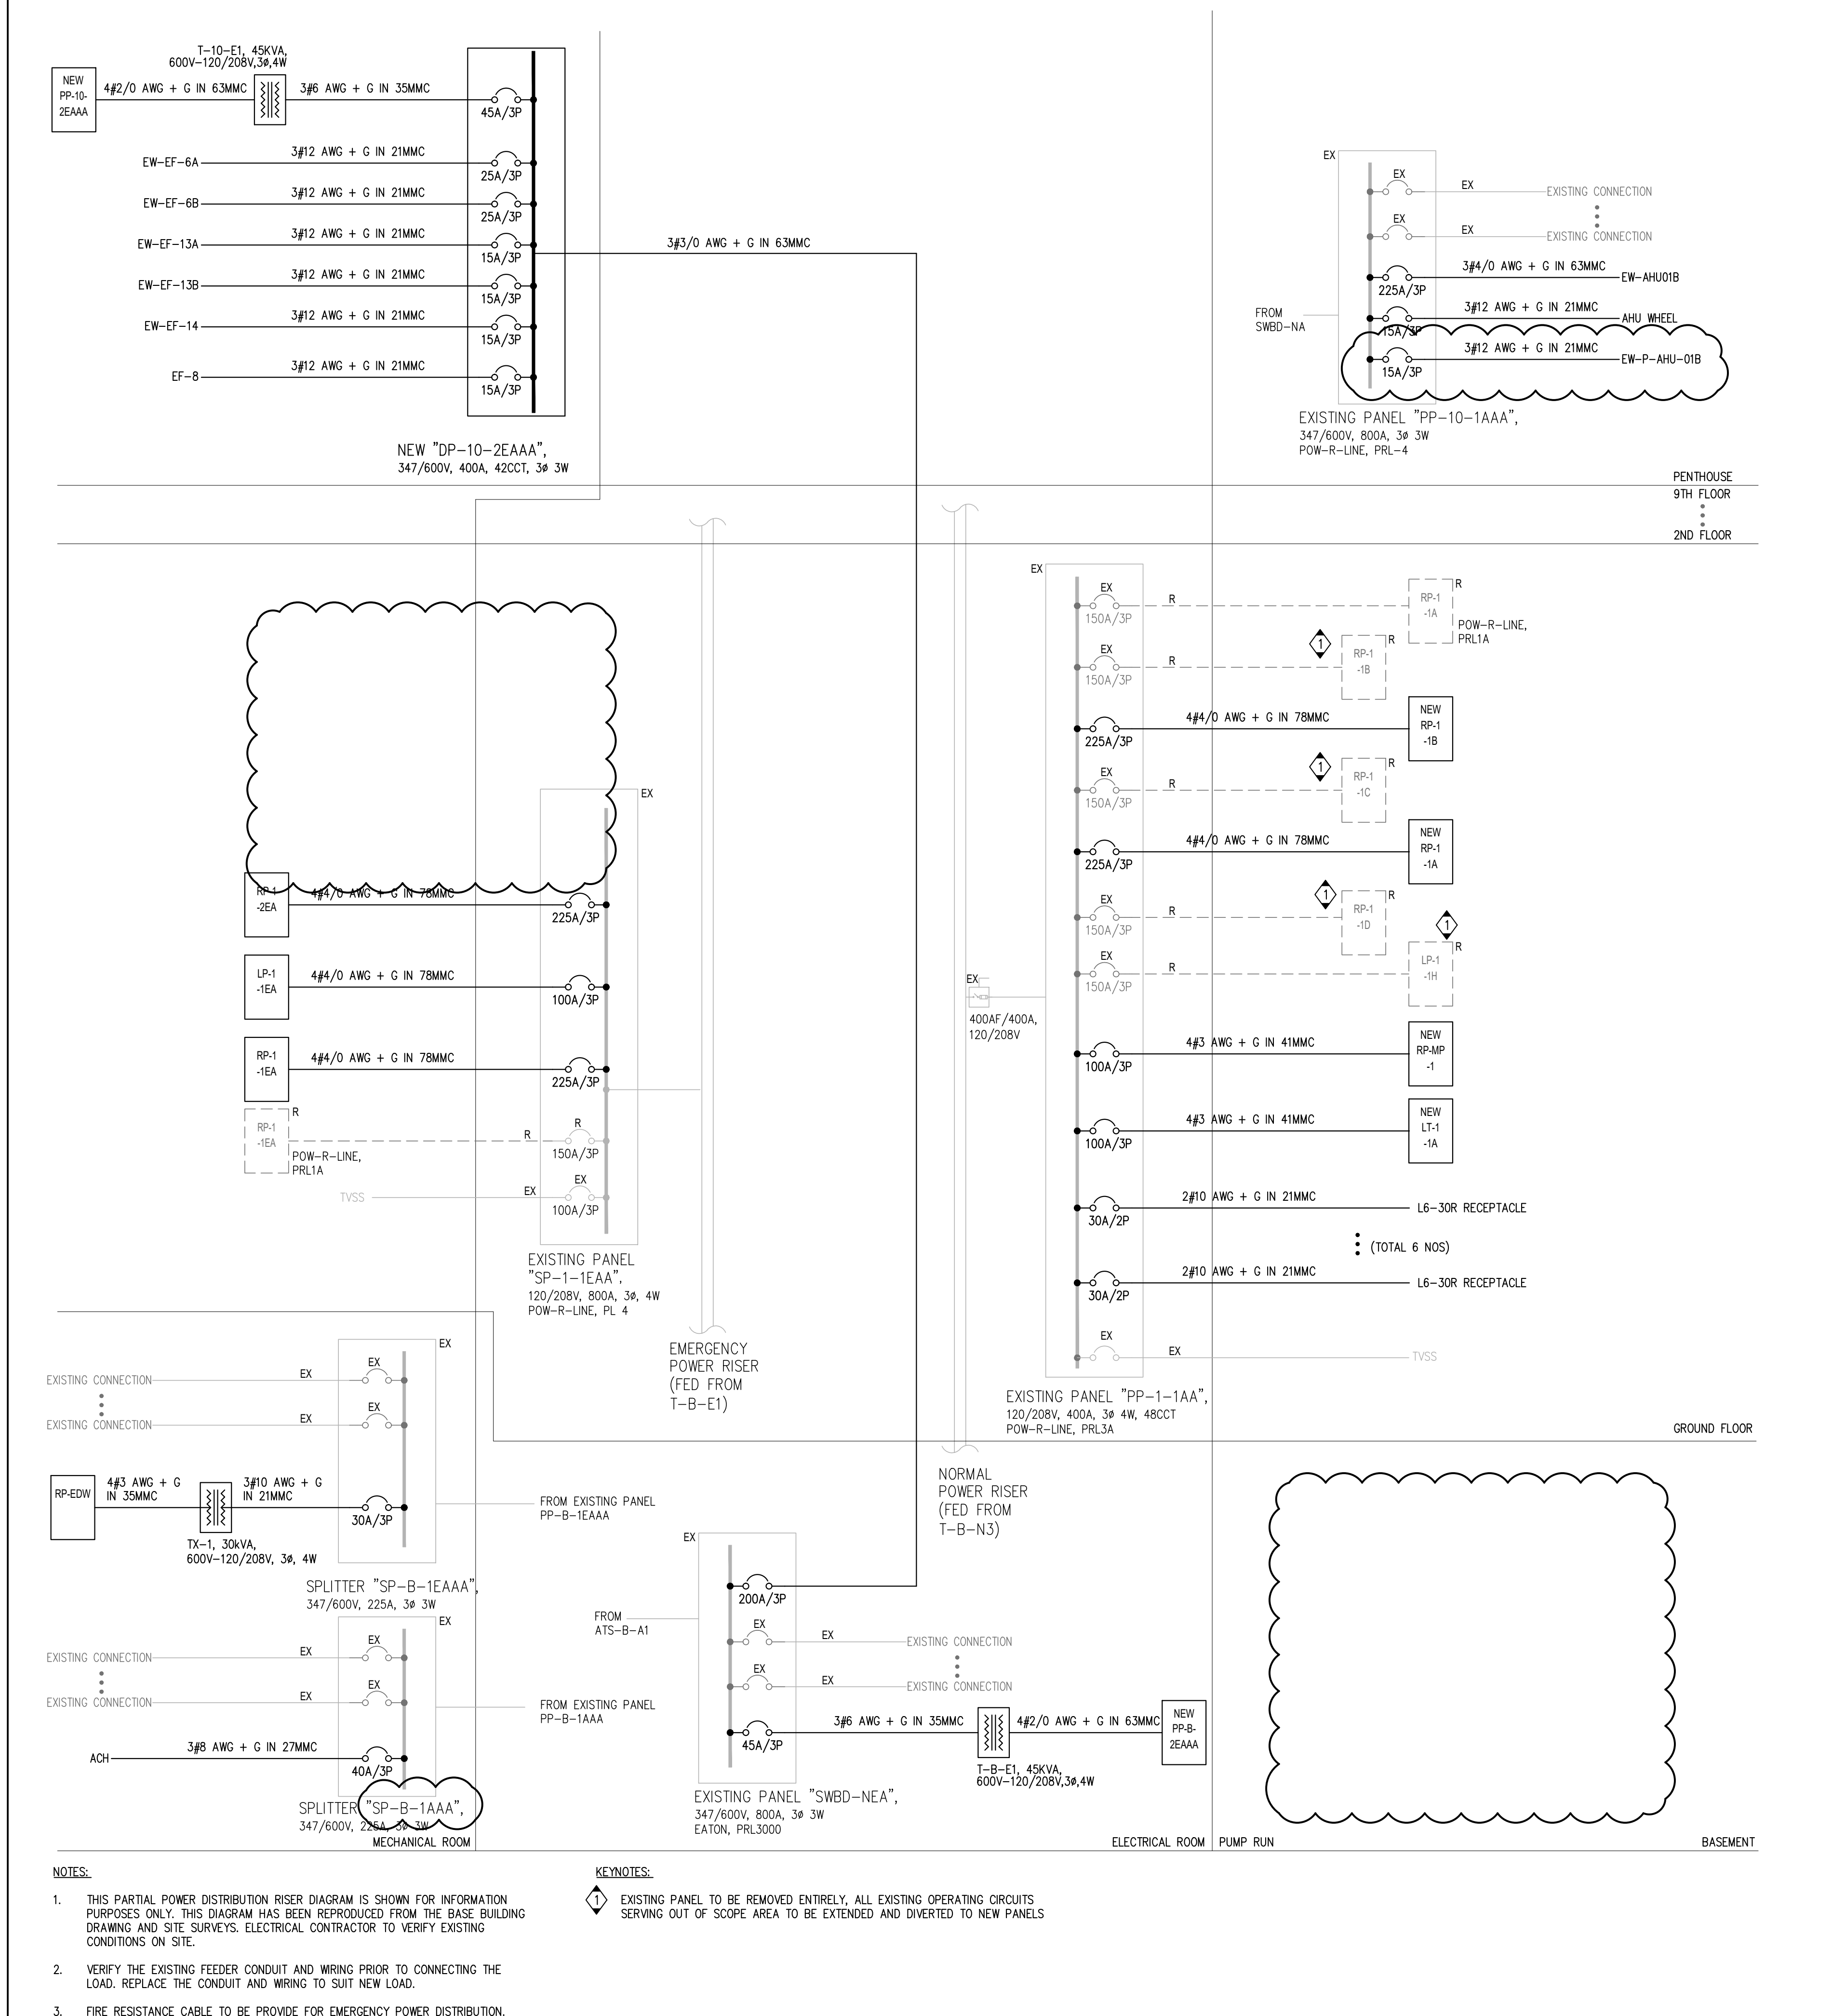

1 SENIOR EMERGENCY CENTER - PARTIAL POWER DISTRIBUTION RISER DIAGRAM
SCALE: N.T.S.

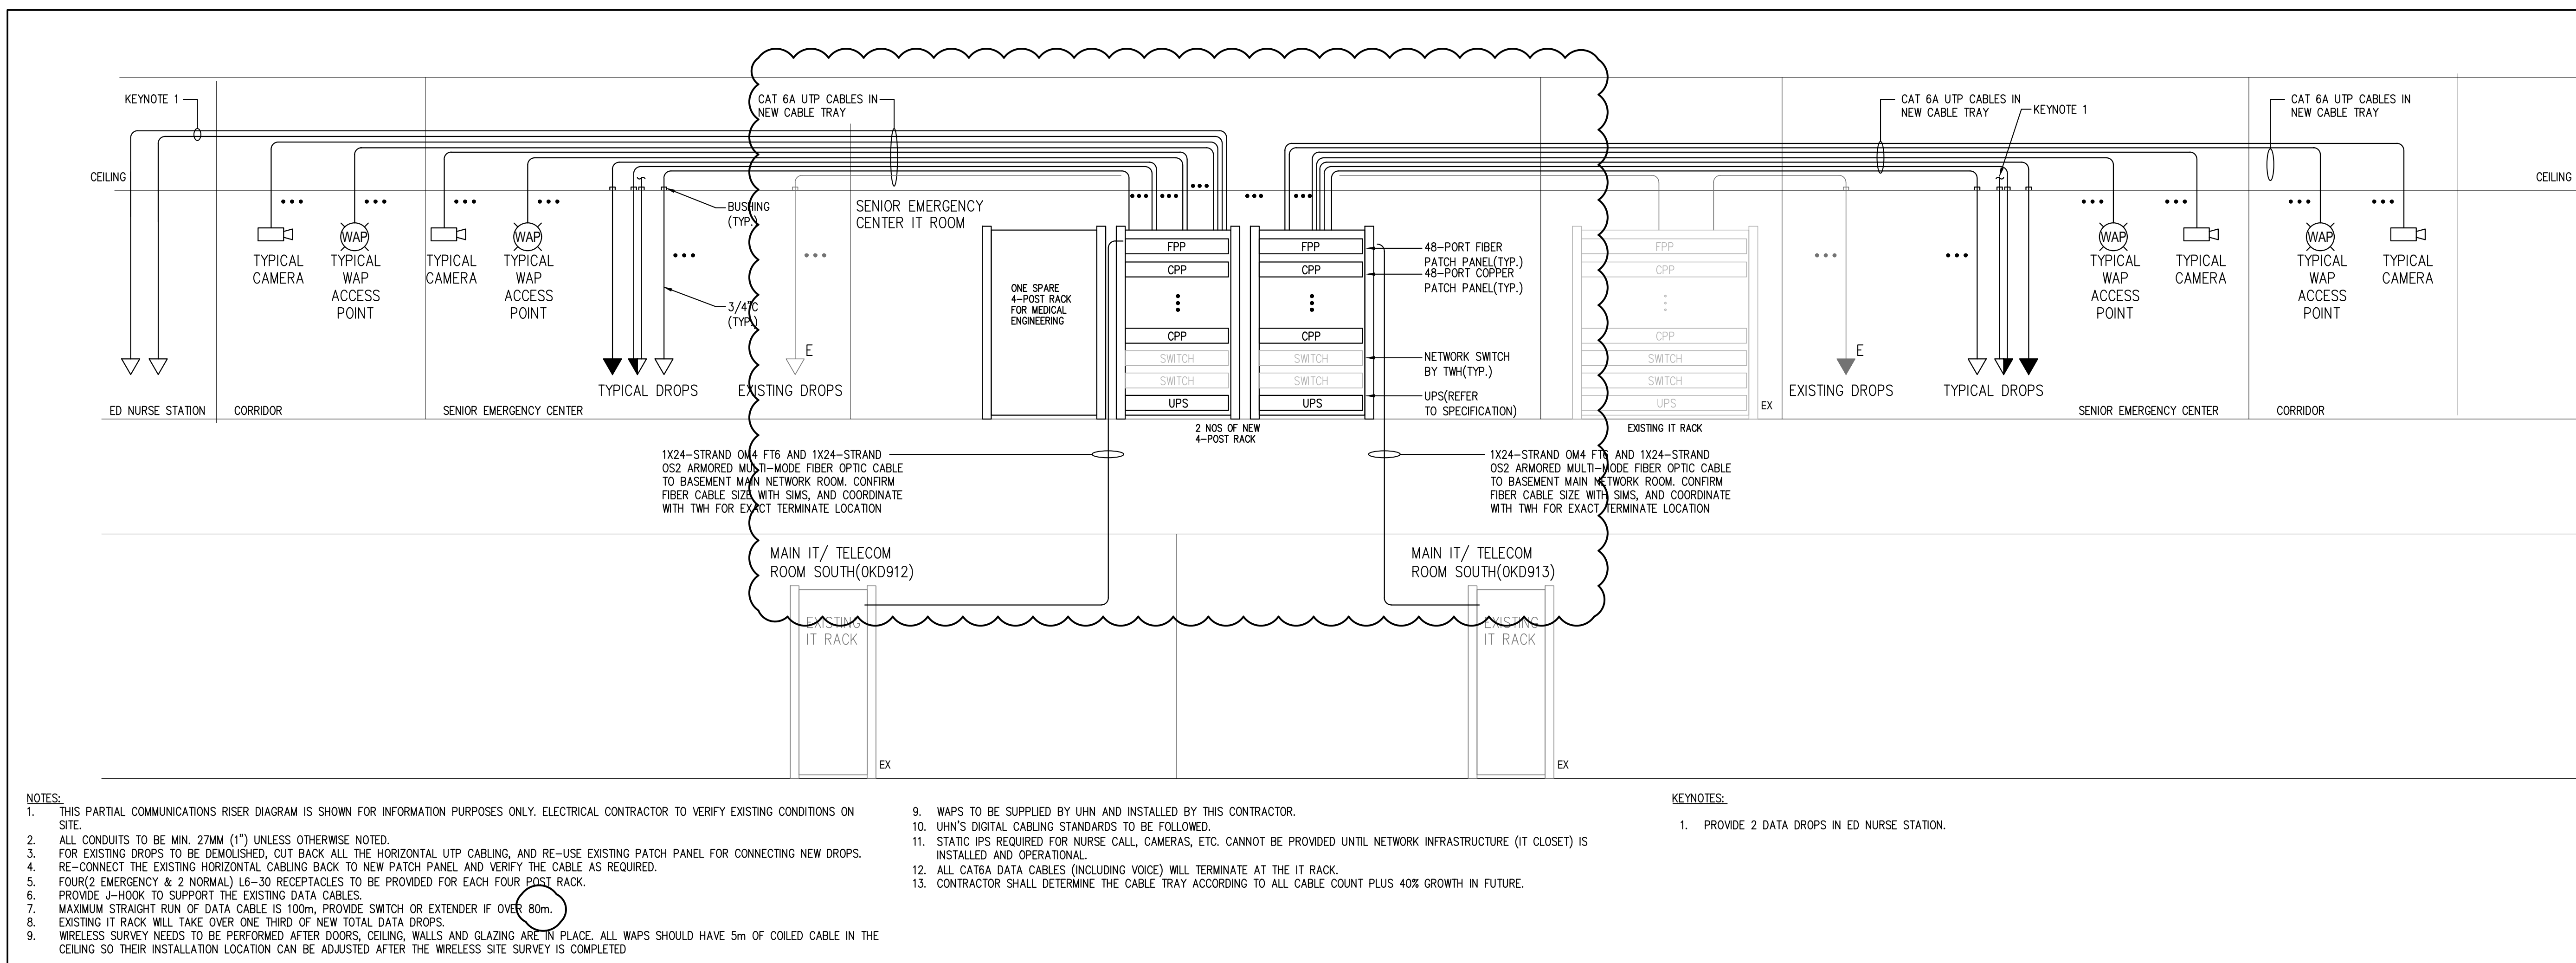

3 SENIOR EMERGENCY CENTER - PARTIAL COMMUNICATIONS RISER DIAGRAM
SCALE: N.T.S.


FIRE ALARM CONTROL NOTES:

- DOORS EQUIPPED WITH ELECTROMAGNETIC HOLD-OPEN DEVICES CONNECTED TO FIRE ALARM SYSTEM WILL BE AUTOMATICALLY RELEASED UPON ALERT SIGNAL (FIRST STAGE).
- DEDICATED FIRE ALARM DETECTORS TO BE PROVIDED ON BOTH SIDE OF THE DOOR IF THE DOORS ARE FIRE COMPARTMENT DOORS OR SMOKE CONTROL DOORS.
- DOORS EQUIPPED WITH MAGLOCKS SHALL BE RELEASED:
- UPON ACTIVATION OF ALARM SIGNAL (SECOND STAGE) FOR THE AREAS CLASSIFIED AS "CARE OCCUPANCY" IN CONFORMANCE WITH ONTARIO BUILDING CODE.
- UPON ACTIVATION OF ALERT SIGNAL (FIRST STAGE) FOR ALL OTHER AREAS EXCEPT FOR AREAS DESIGNATED AS "CONTAINED USE AREA OR AN IMPEDED EGRESS ZONE".
- FOR MAGLOCKS INSTALLED IN "CONTAINED USE AREAS OR AN IMPEDED EGRESS ZONES", THE MAGLOCKS SHALL BE RELEASED EITHER LOCALLY OR REMOTELY IN CONFORMANCE WITH ONTARIO BUILDING CODE 3.3.1.1.2.
- MANUAL PULL STATION TO BE PROVIDED ON SECURE SIDE OF THE DOOR TO RELEASE MAGLOCK.
- PROVIDE FIRE RATED CABLES AS REQUIRED BY LOCAL CODE AND AUTHORITY HAVING JURISDICTION.
- SPRINKLER SYSTEM FLOW SWITCHES, PRESSURE SWITCHES AND SUPERVISED VALVES SHALL BE INTERFACED WITH FIRE ALARM SYSTEM.
- ALL SMOKE CONTROL DAMPERS SHALL BE INTERFACED WITH FIRE ALARM SYSTEM.
- PROVIDE NEW FIRE ALARM ZONES FOR SENIOR EMERGENCY AREA AND LINK CORRIDOR.


NOTES:

- PROVIDE FIRE ALARM SIGNAL TO PA SYSTEM FOR OVERRIDE.



2 DETAIL OF TYPICAL FIRE ALARM CIRCUIT
SCALE: N.T.S.

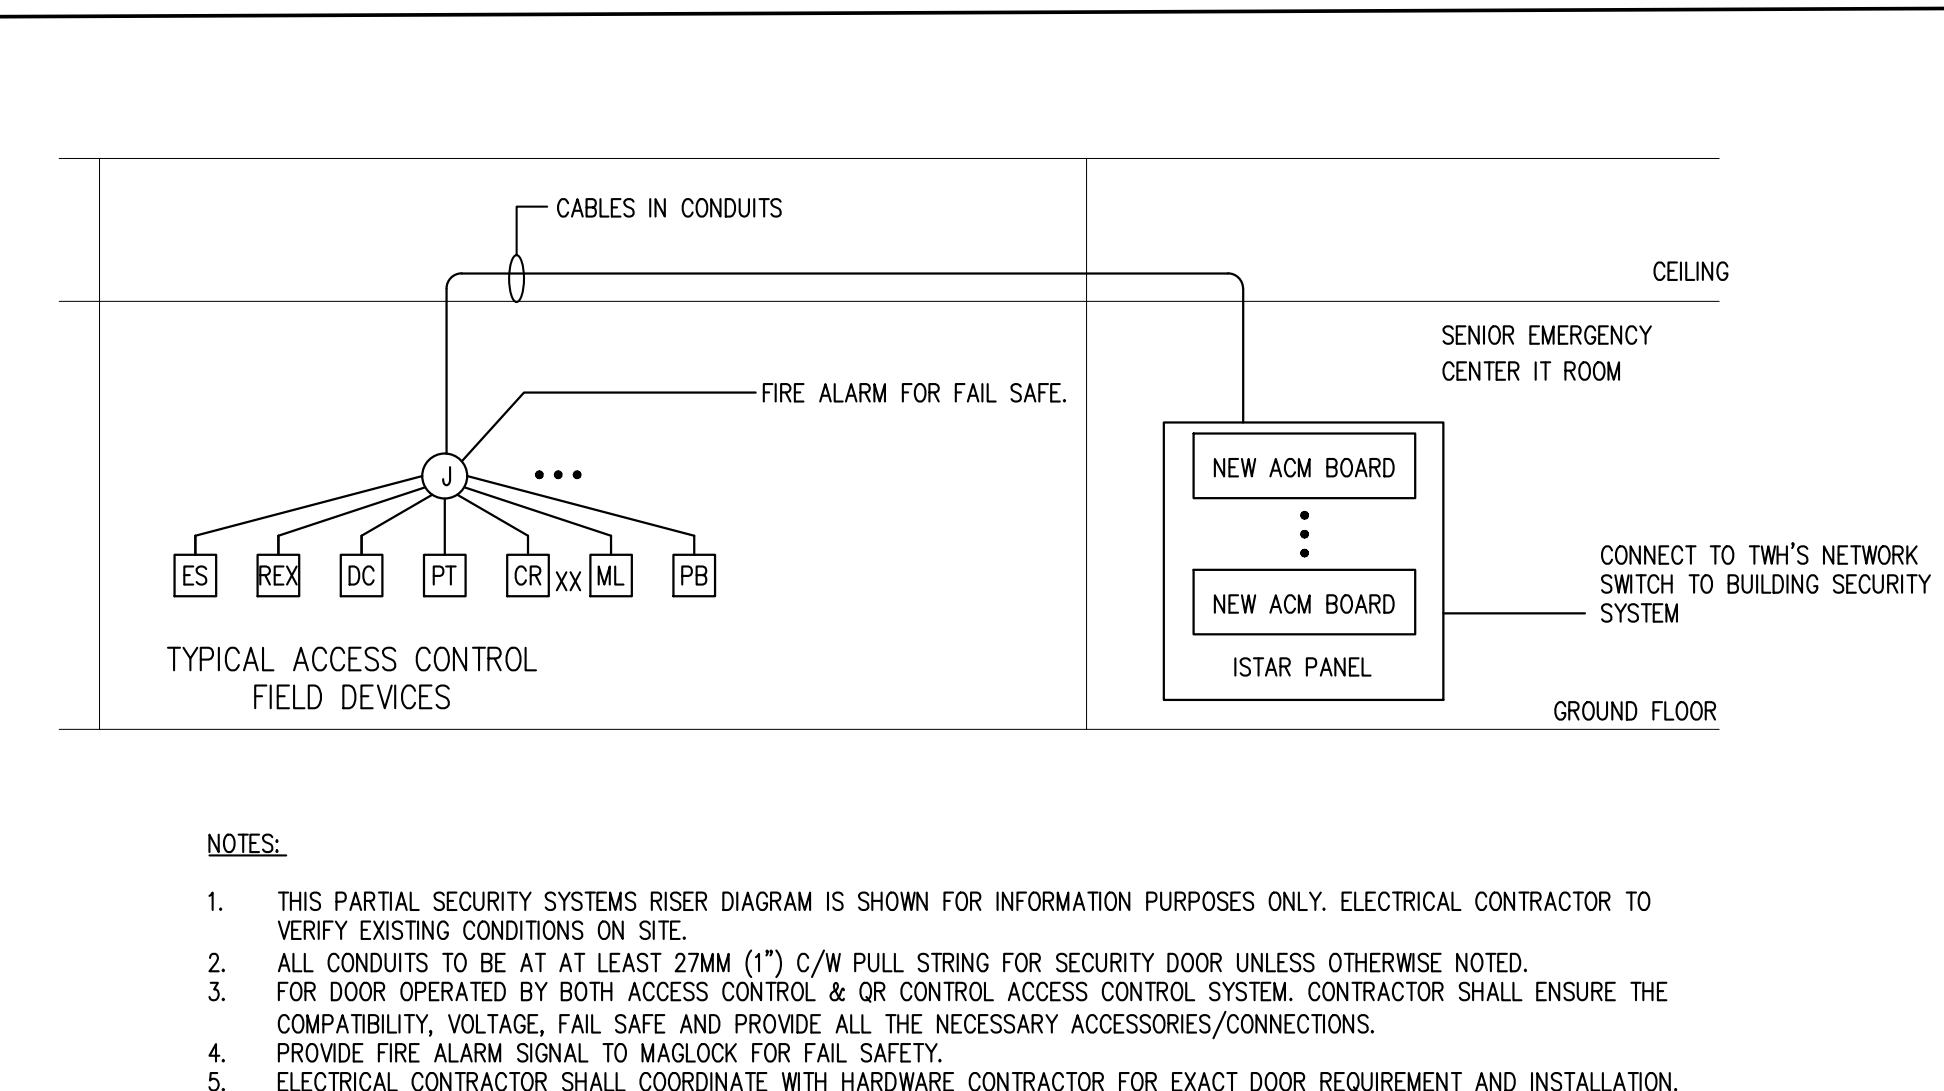


4 SENIOR EMERGENCY CENTER - PARTIAL SECURITY/ACCESS CONTROL RISER DIAGRAM
SCALE: N.T.S.

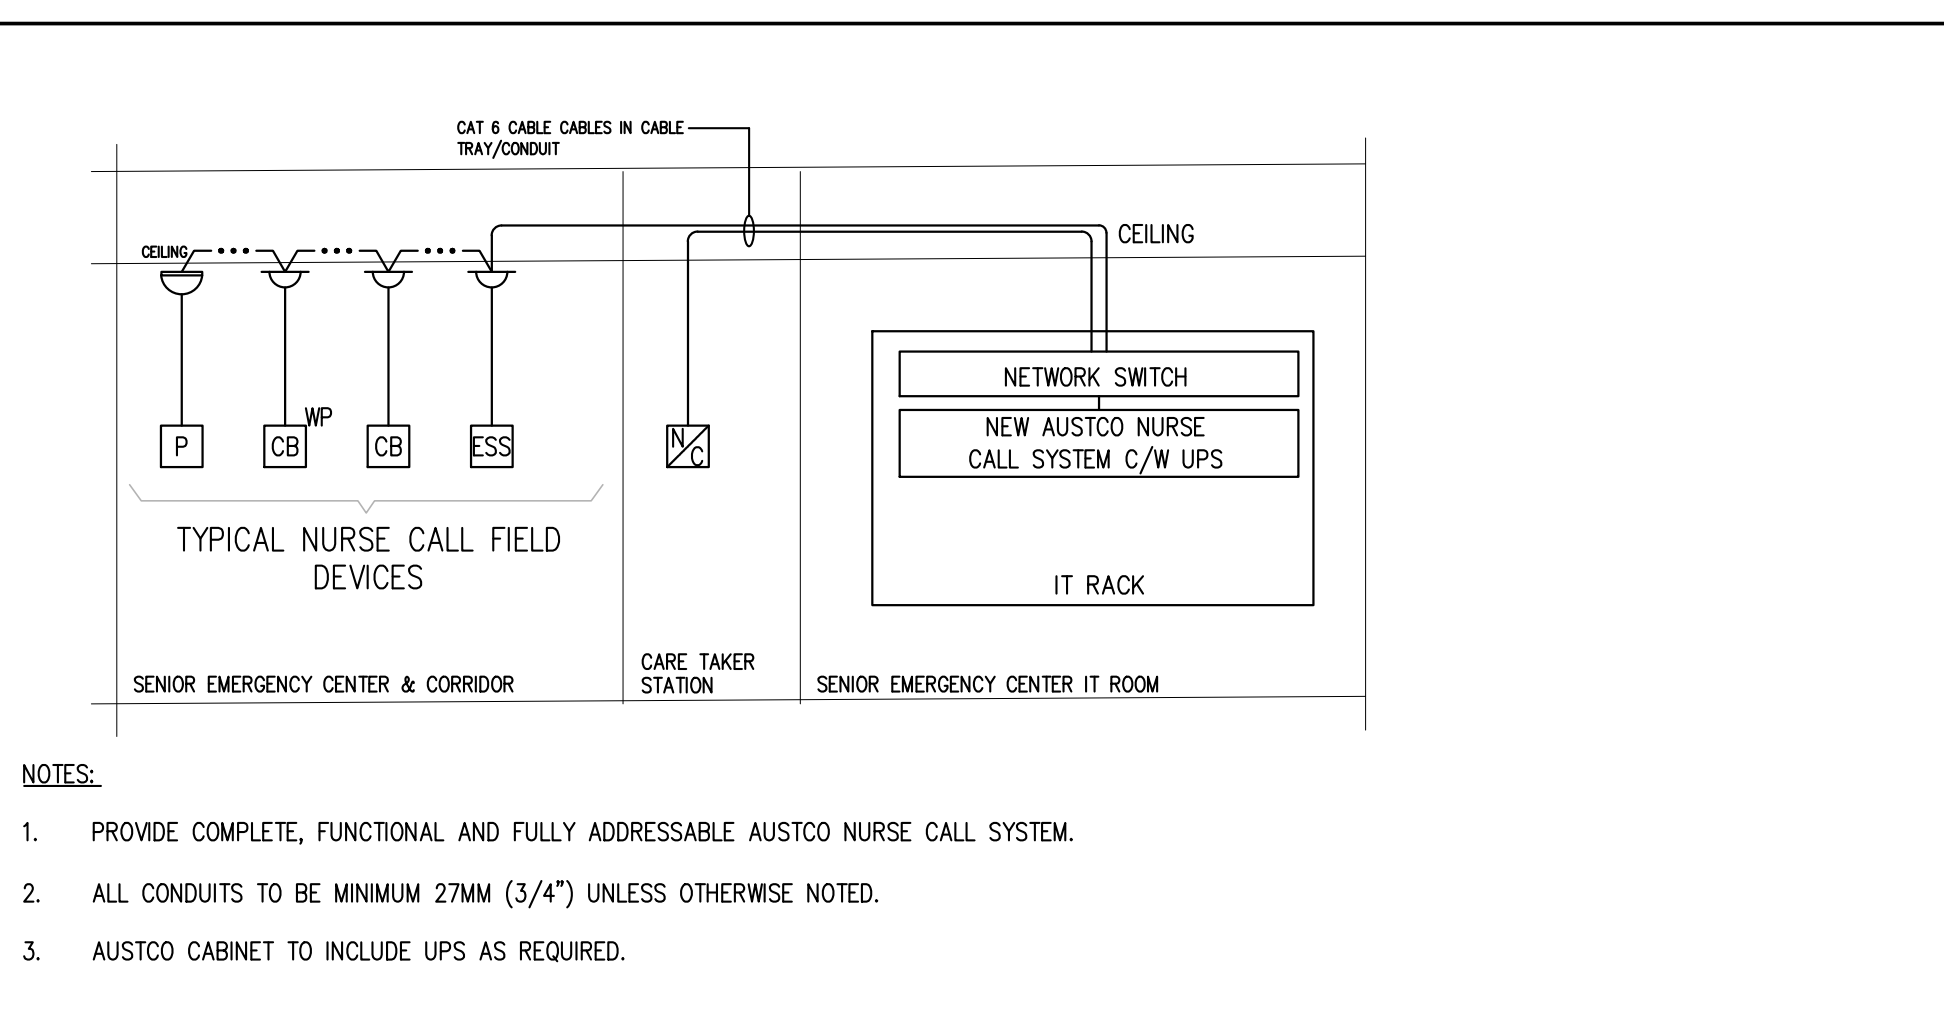


5 NURSE CALL RISER DIAGRAM
SCALE: N.T.S.

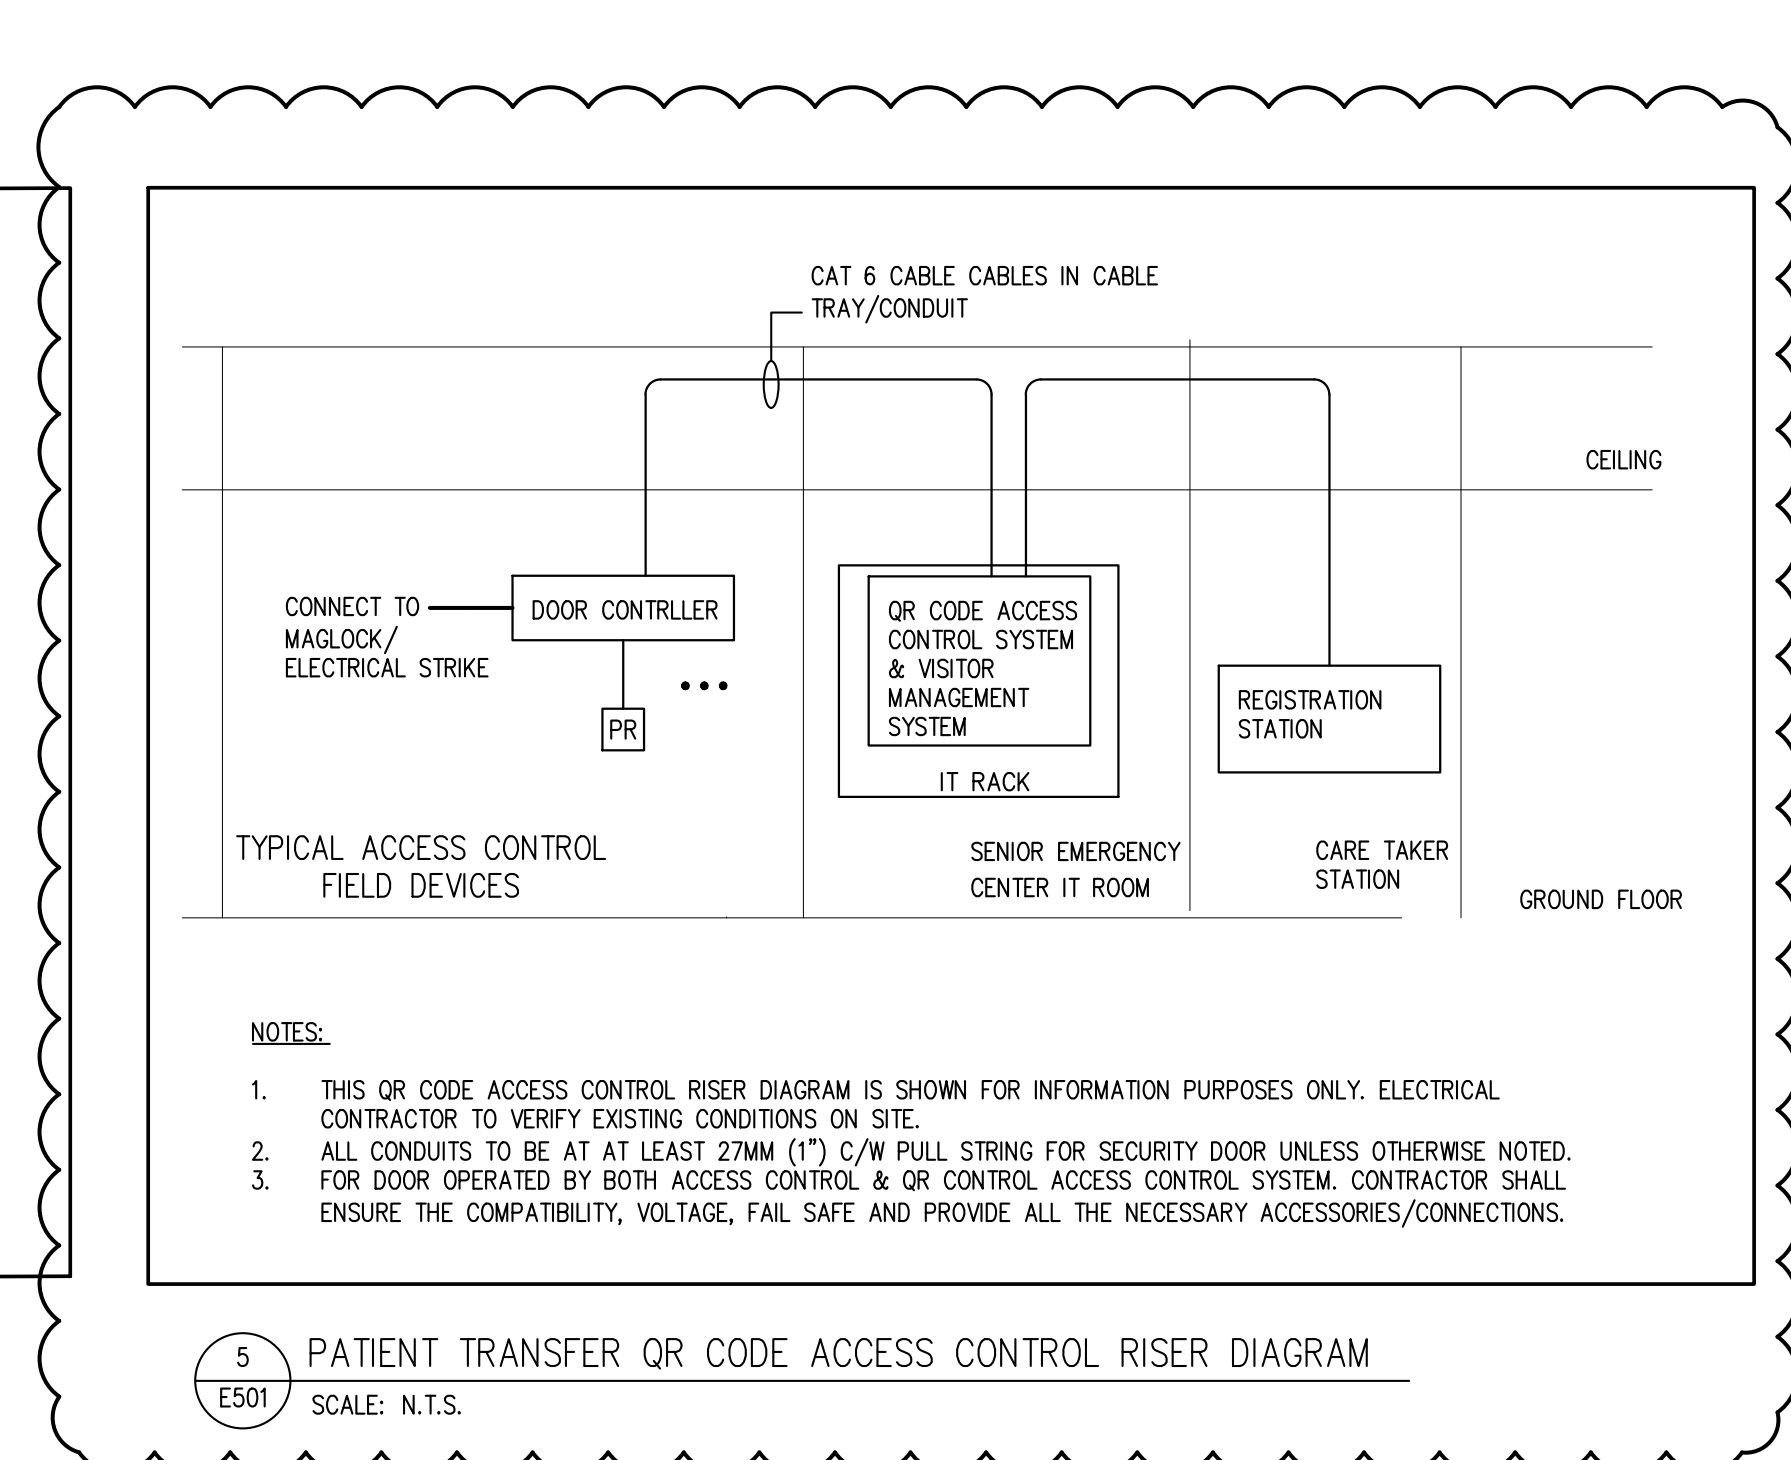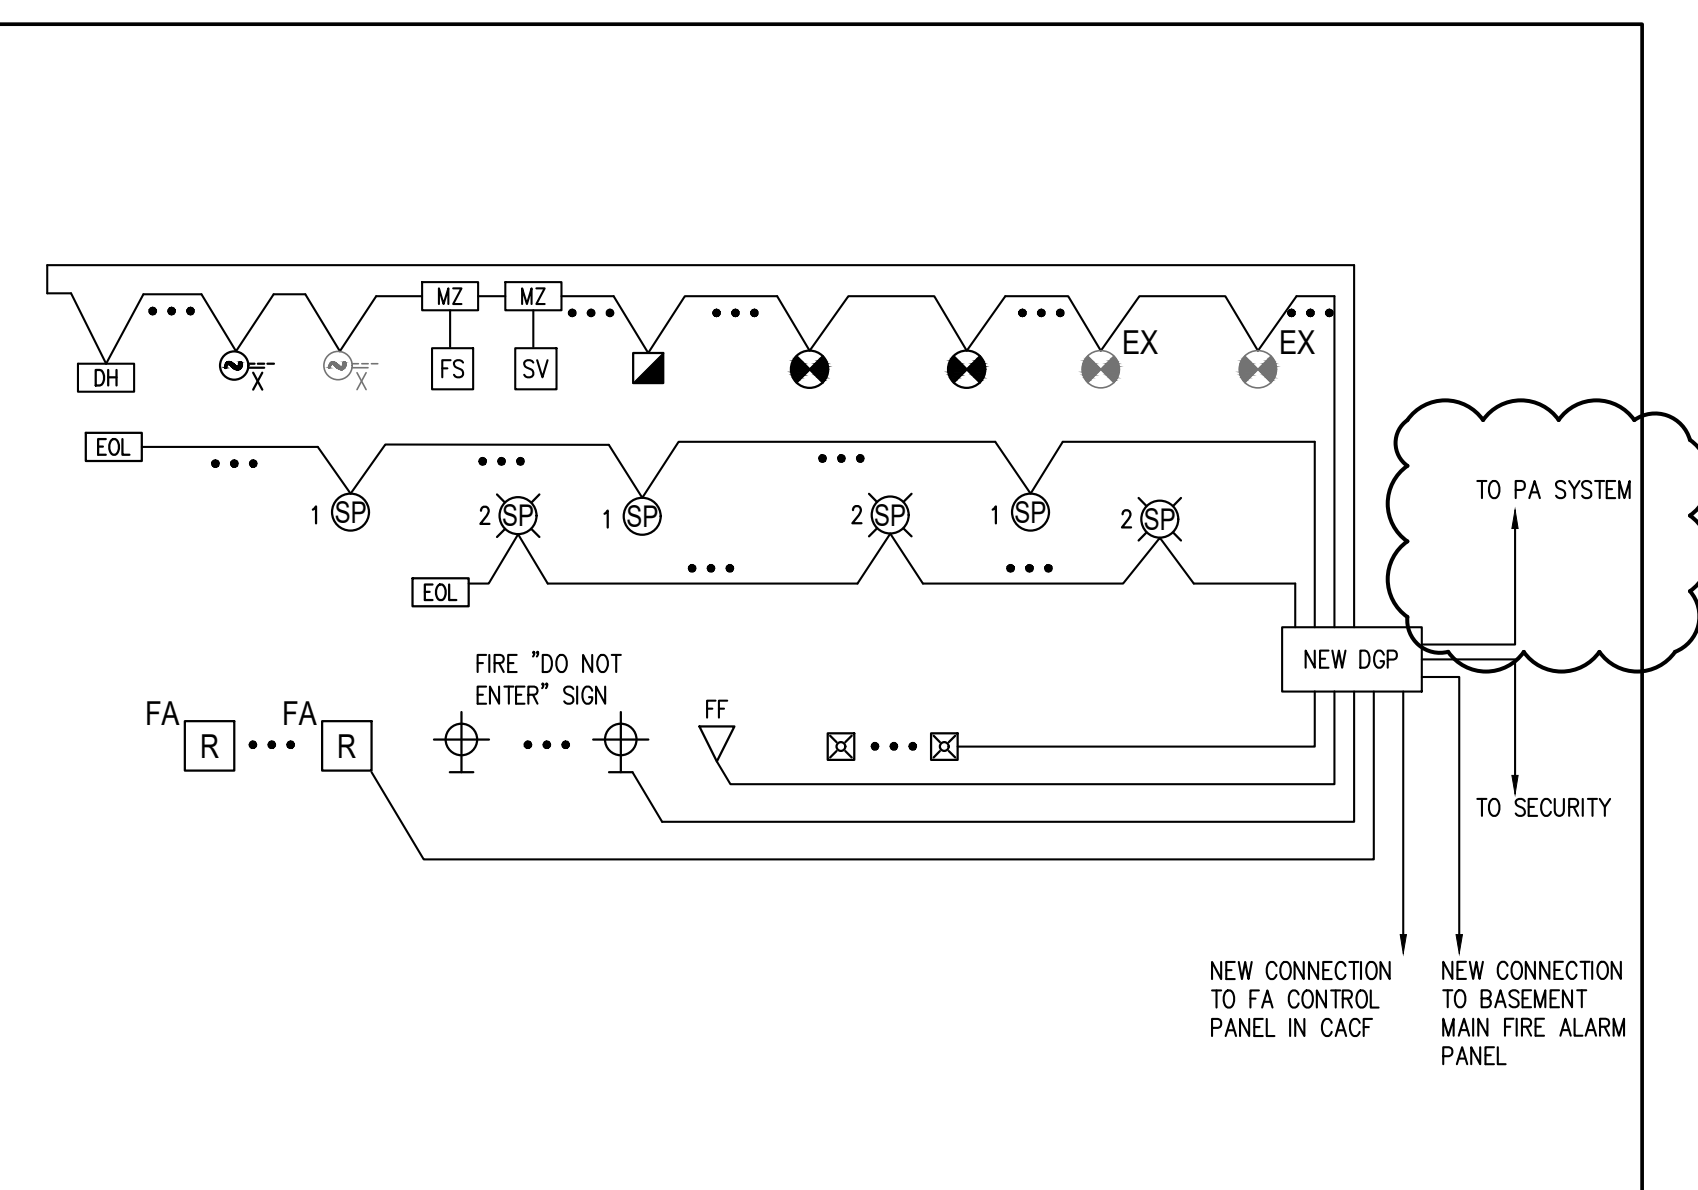


6 PATIENT TRANSFER QR CODE ACCESS CONTROL RISER DIAGRAM
SCALE: N.T.S.

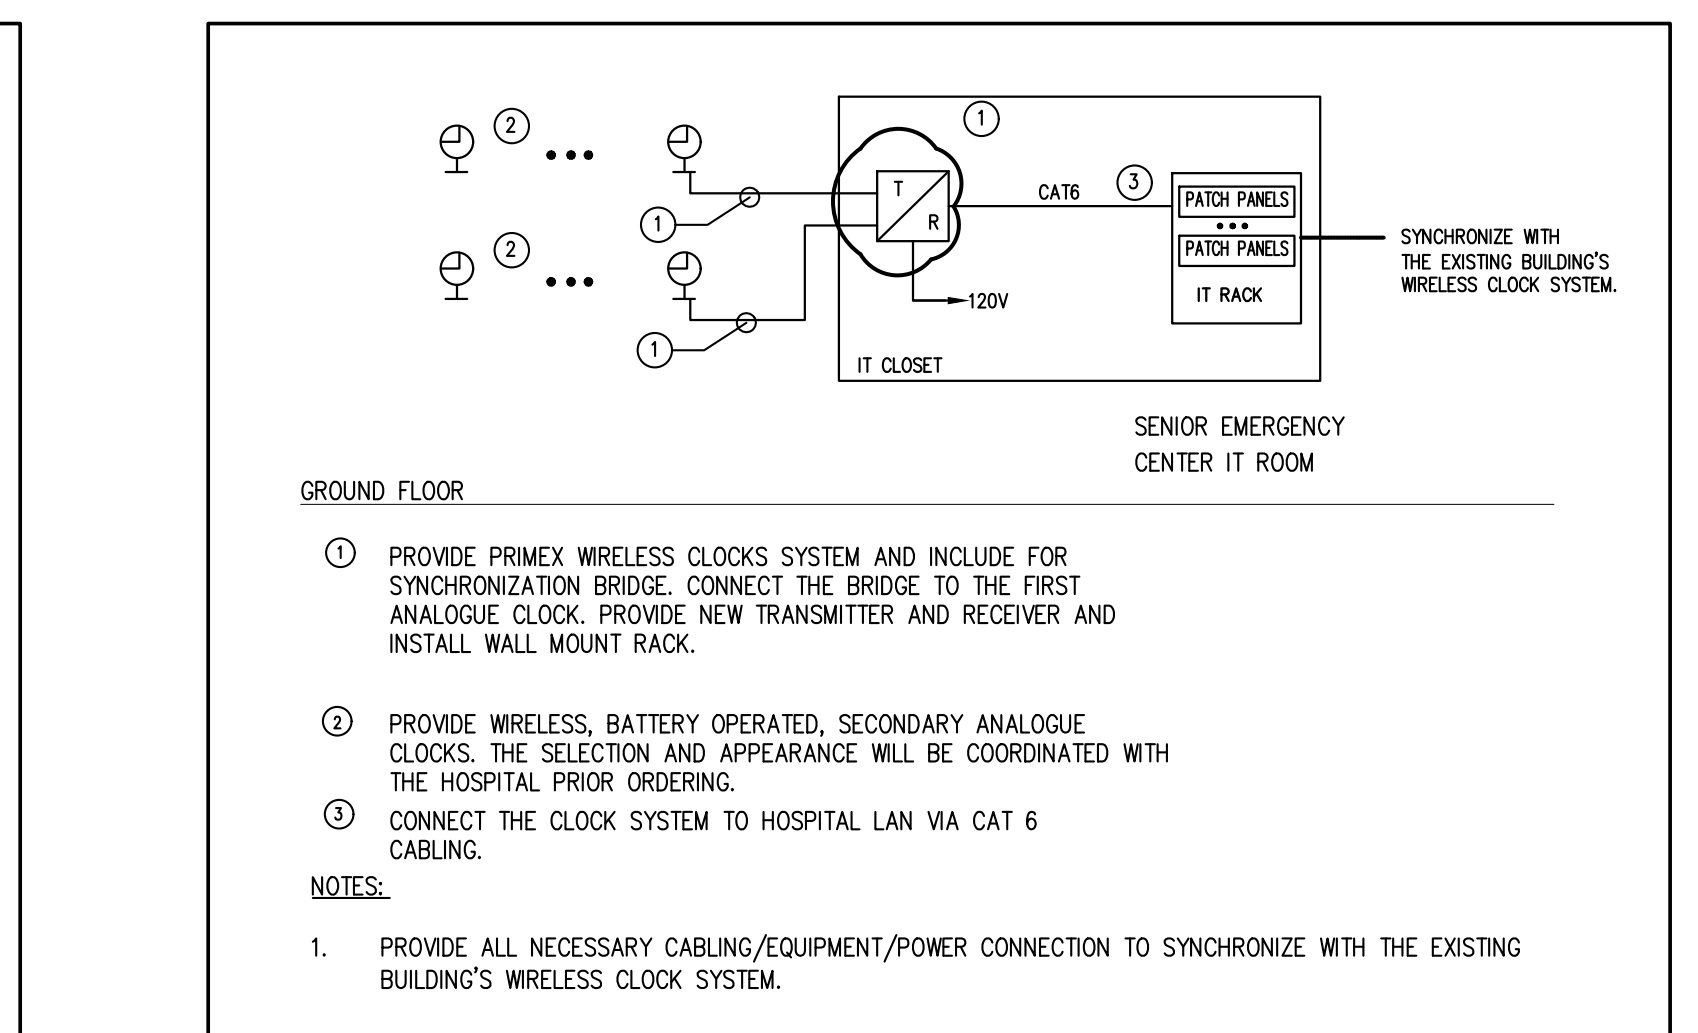

6 MASTER CLOCK SYSTEM RISER DIAGRAM
SCALE: N.T.S.

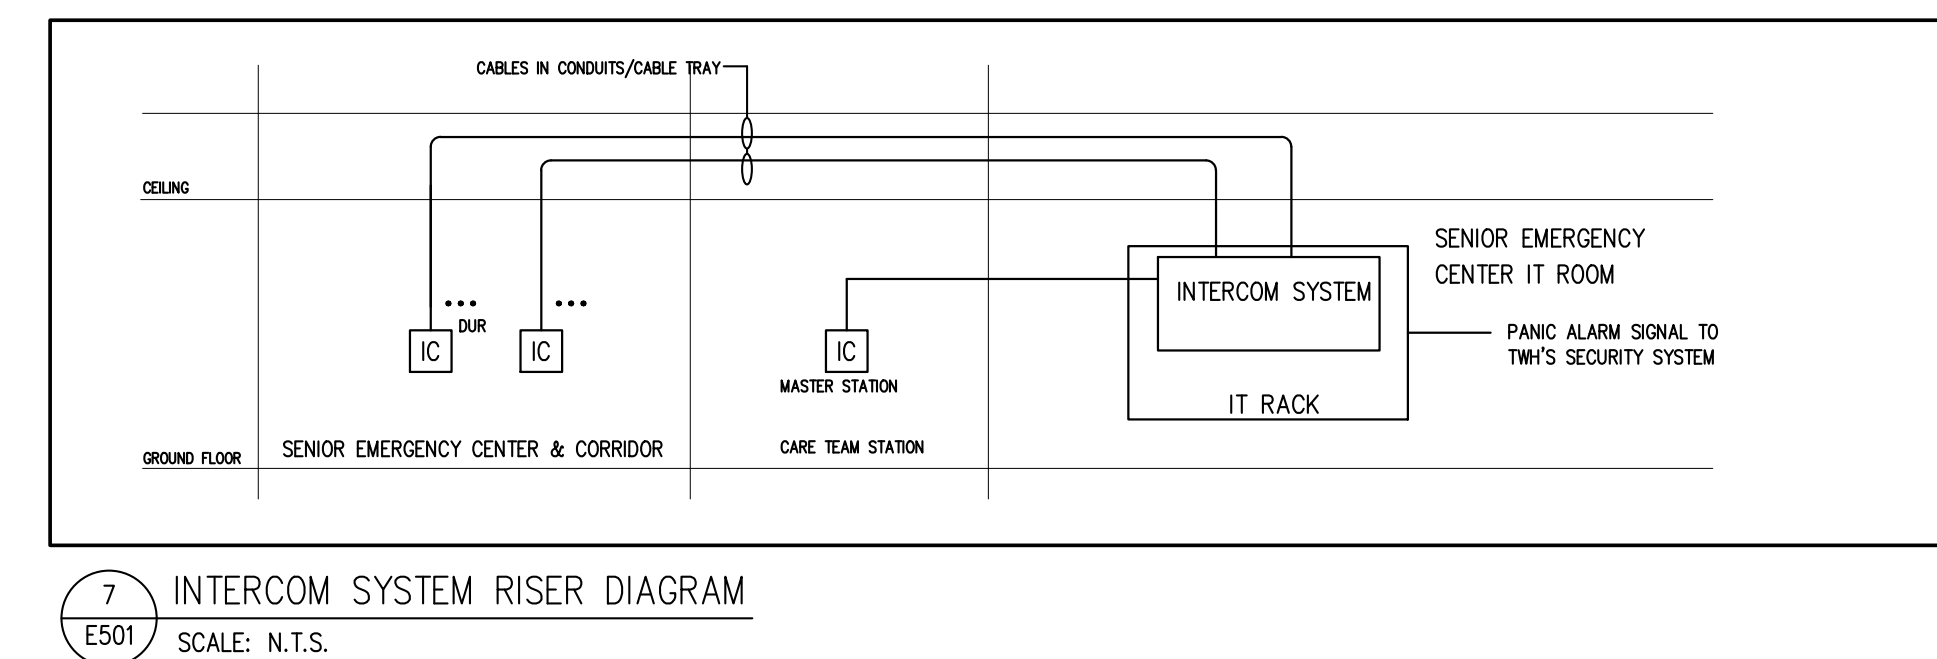

7 INTERCOM SYSTEM RISER DIAGRAM
SCALE: N.T.S.

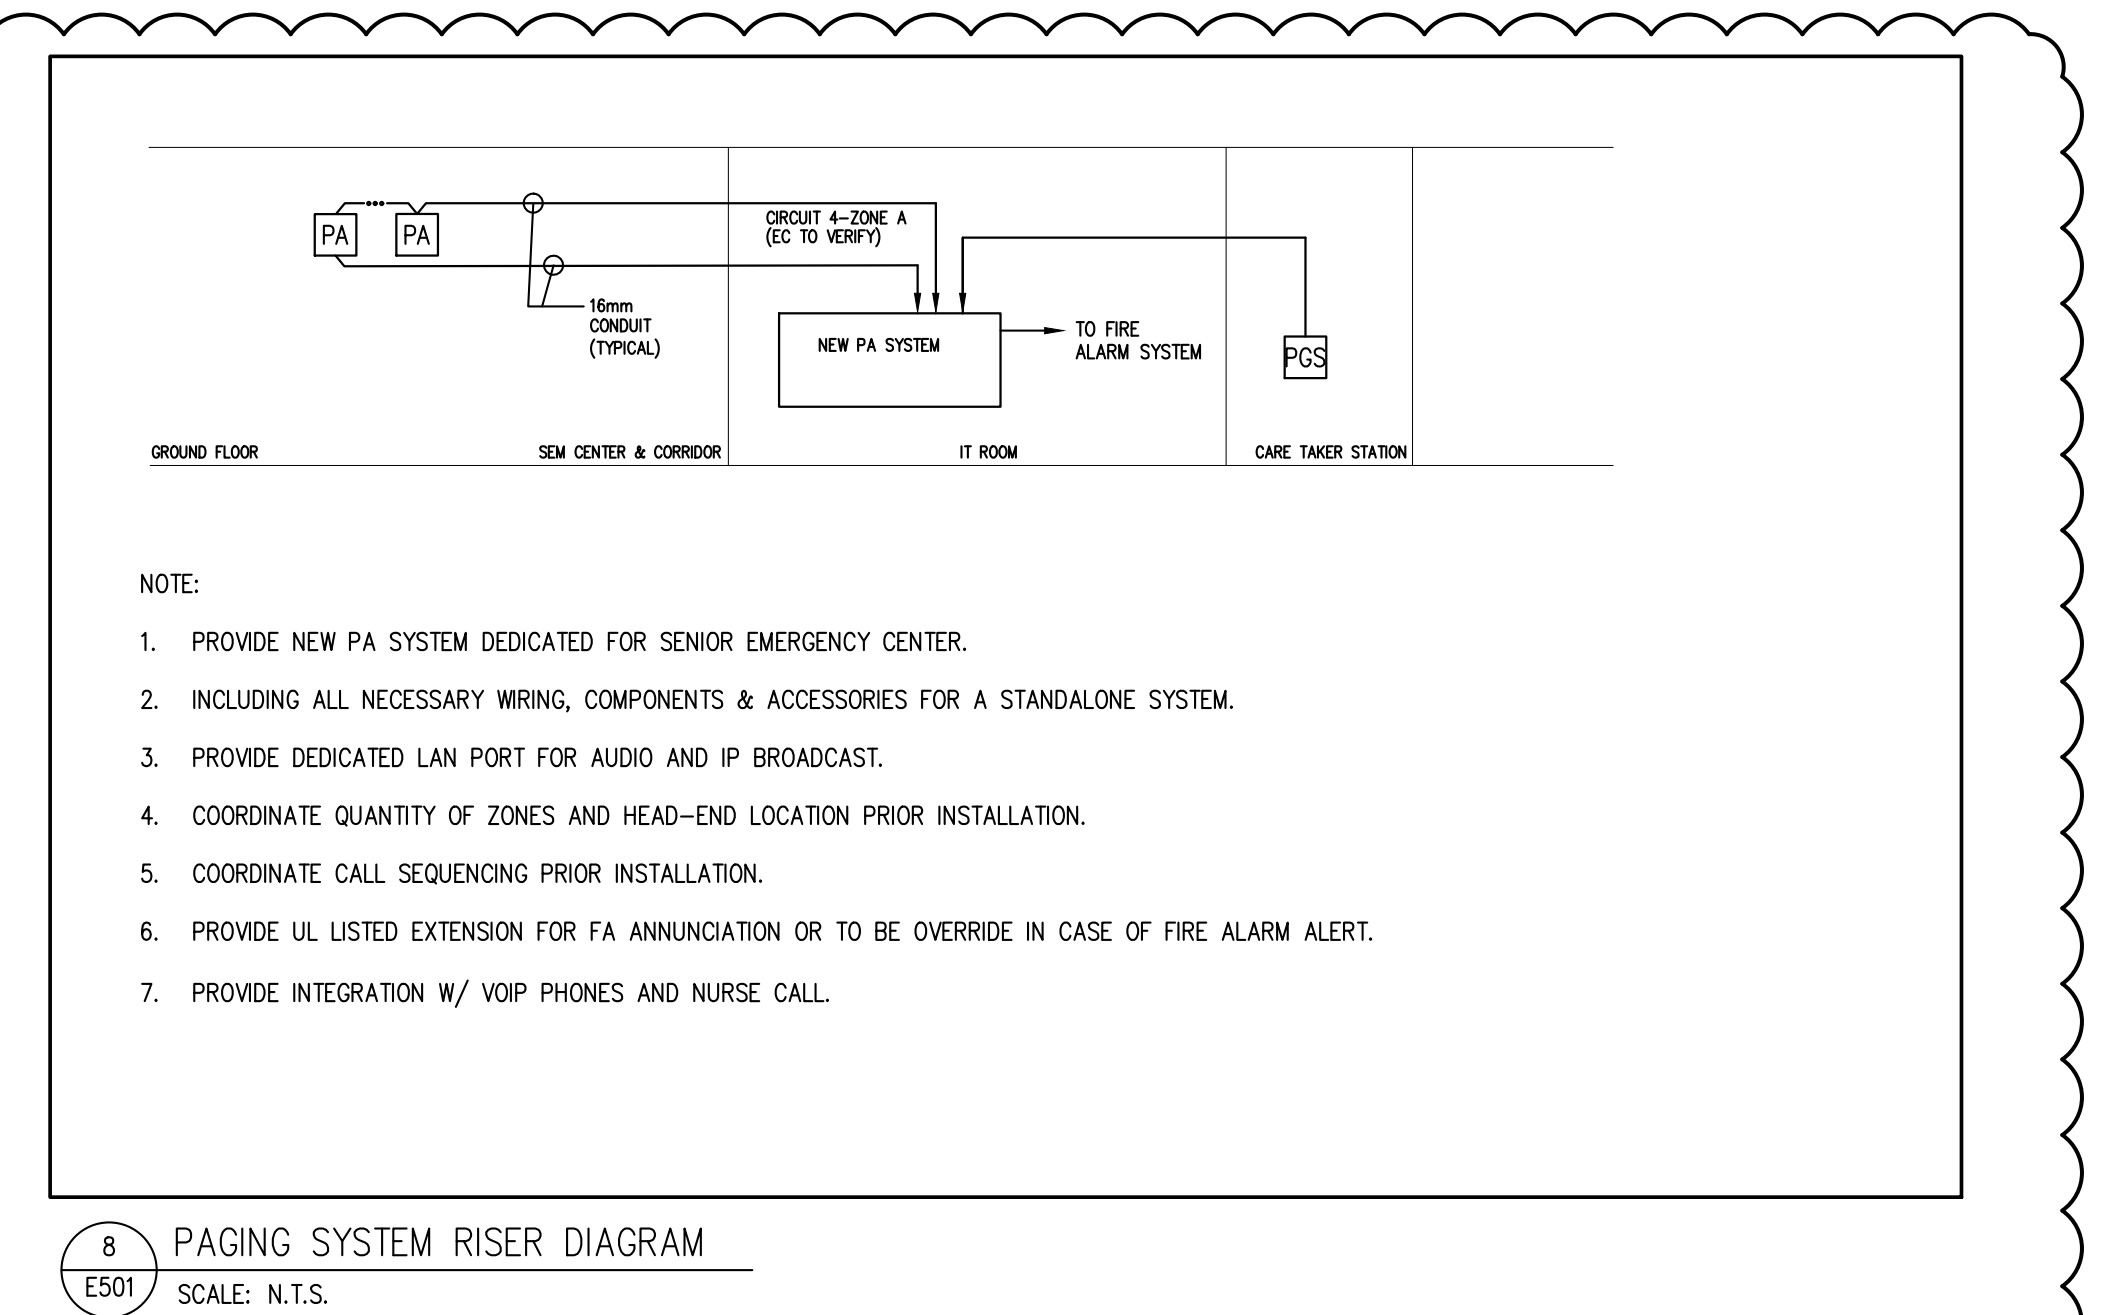

8 PAGING SYSTEM RISER DIAGRAM
SCALE: N.T.S.

ARCHITECT:

CUMULUS ARCHITECTS INC.
160 Pears Ave., Suite 300
Toronto, ON M5R 3P8
416-539-0763
www.cumulusarch.com

CONSULTANT:

exp.
1-800-695-3217 / 1-800-695-0167
220 Commerce Valley Drive West, Suite 110
Markham, ON L3T 0A8
Canada
www.exp.com
• BUILDINGS • EARTH & ENVIRONMENT • ENERGY •
• INDUSTRIAL • INFRASTRUCTURE • SUSTAINABILITY •

PROJECT STATUS:

REVISIONS

NO	DESCRIPTION	DATE
1	Issued for Design Development Progress	2024.04.05
2	Issued for 100 DD	2024.05.10
3	Issued for 50% CD / Permit	2024.08.02
4	Issued for 90% CD	2024.09.08
5	Issued for 100% CD	2024.09.27
6	Issued for Tender	2024.10.11
7	Issued for Tender Addendum	2024.10.25
8	Issued for Tender Addendum No.2	2024.11.01
9	Issued for Tender Addendum No.4	2024.11.12
10	Issued for Tender Addendum No.5	2024.11.19

PROJECT:

UHN TWH - Seniors Emergency Medicine Centre
399 Bathurst Street, Toronto ON M5T 2S8
UHN PROJECT NO.: SAP #110022016

TITLE:

ELECTRICAL RISER DIAGRAM

PROJECT NO:


MRK-23004289

CHECKED:


M.S.

DRAWING NO:

E-501

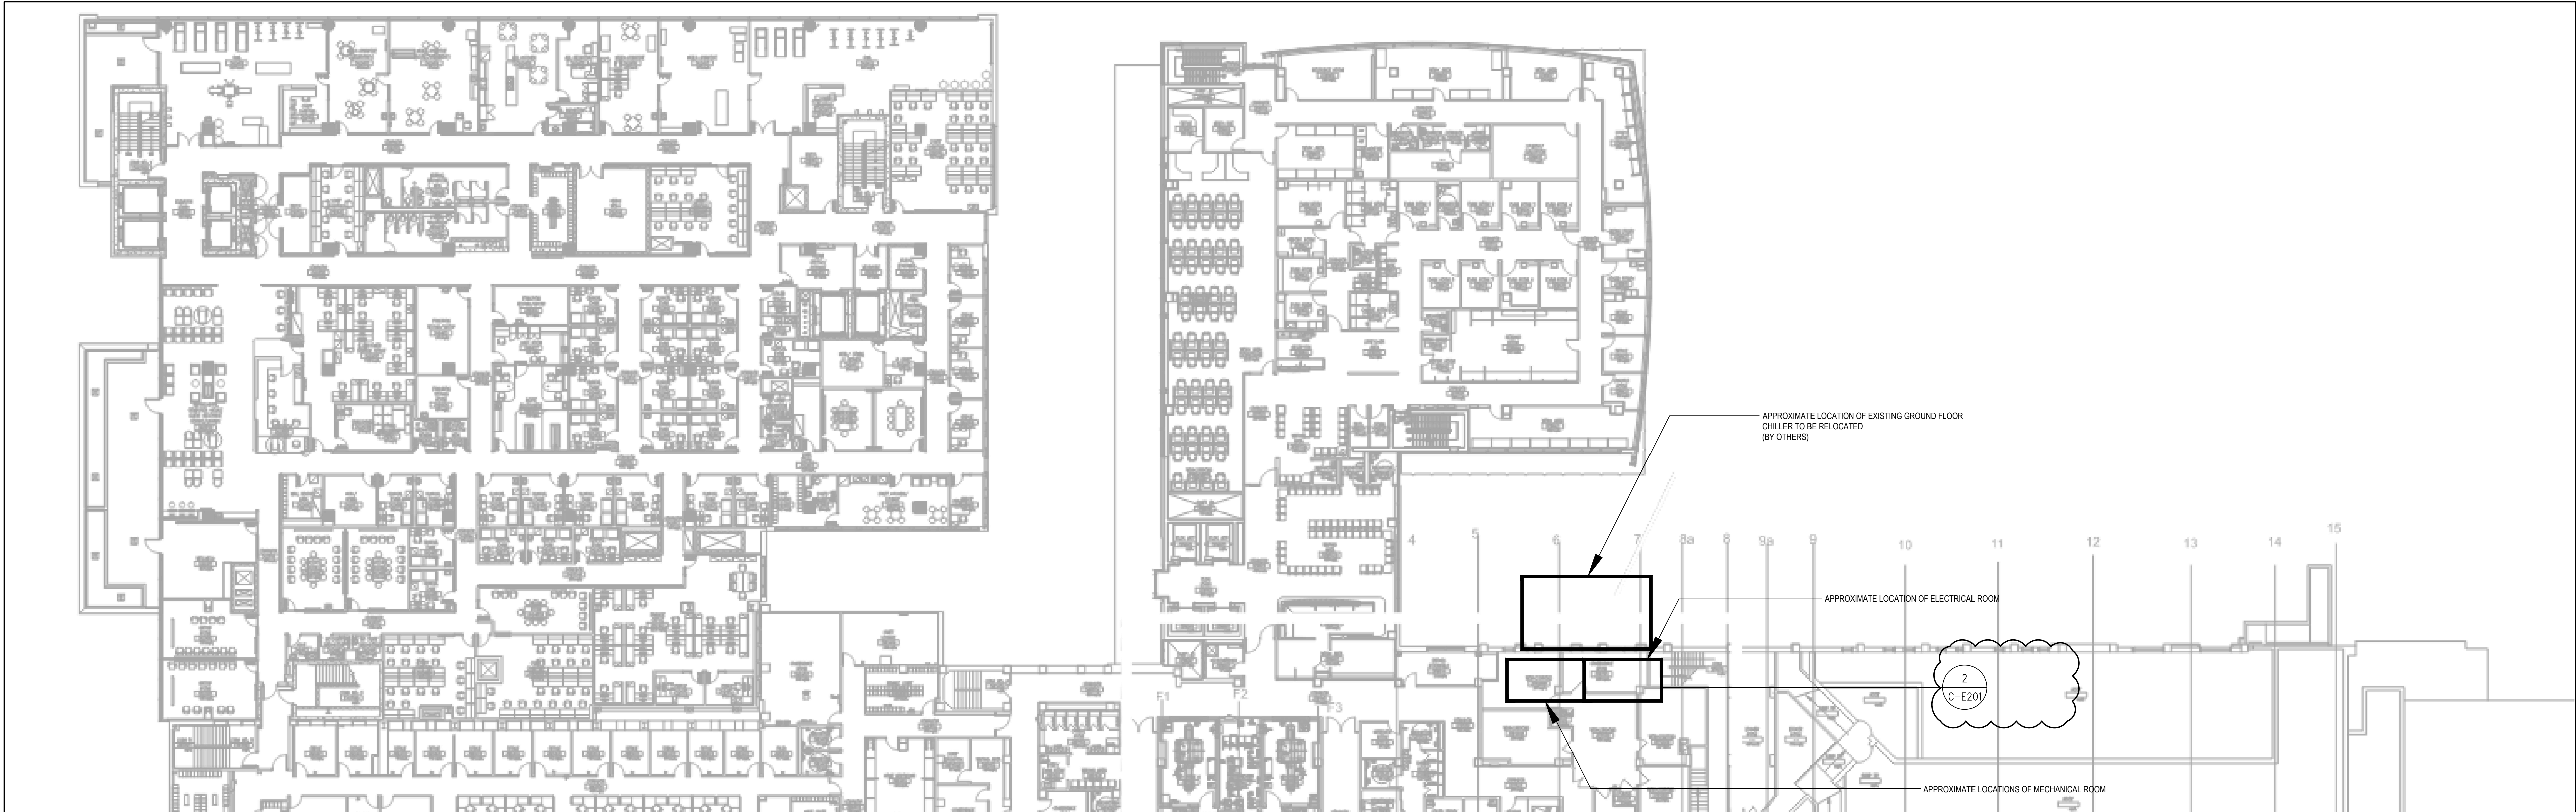

1 3RD FLOOR - POWER & SYSTEM
N.T.S

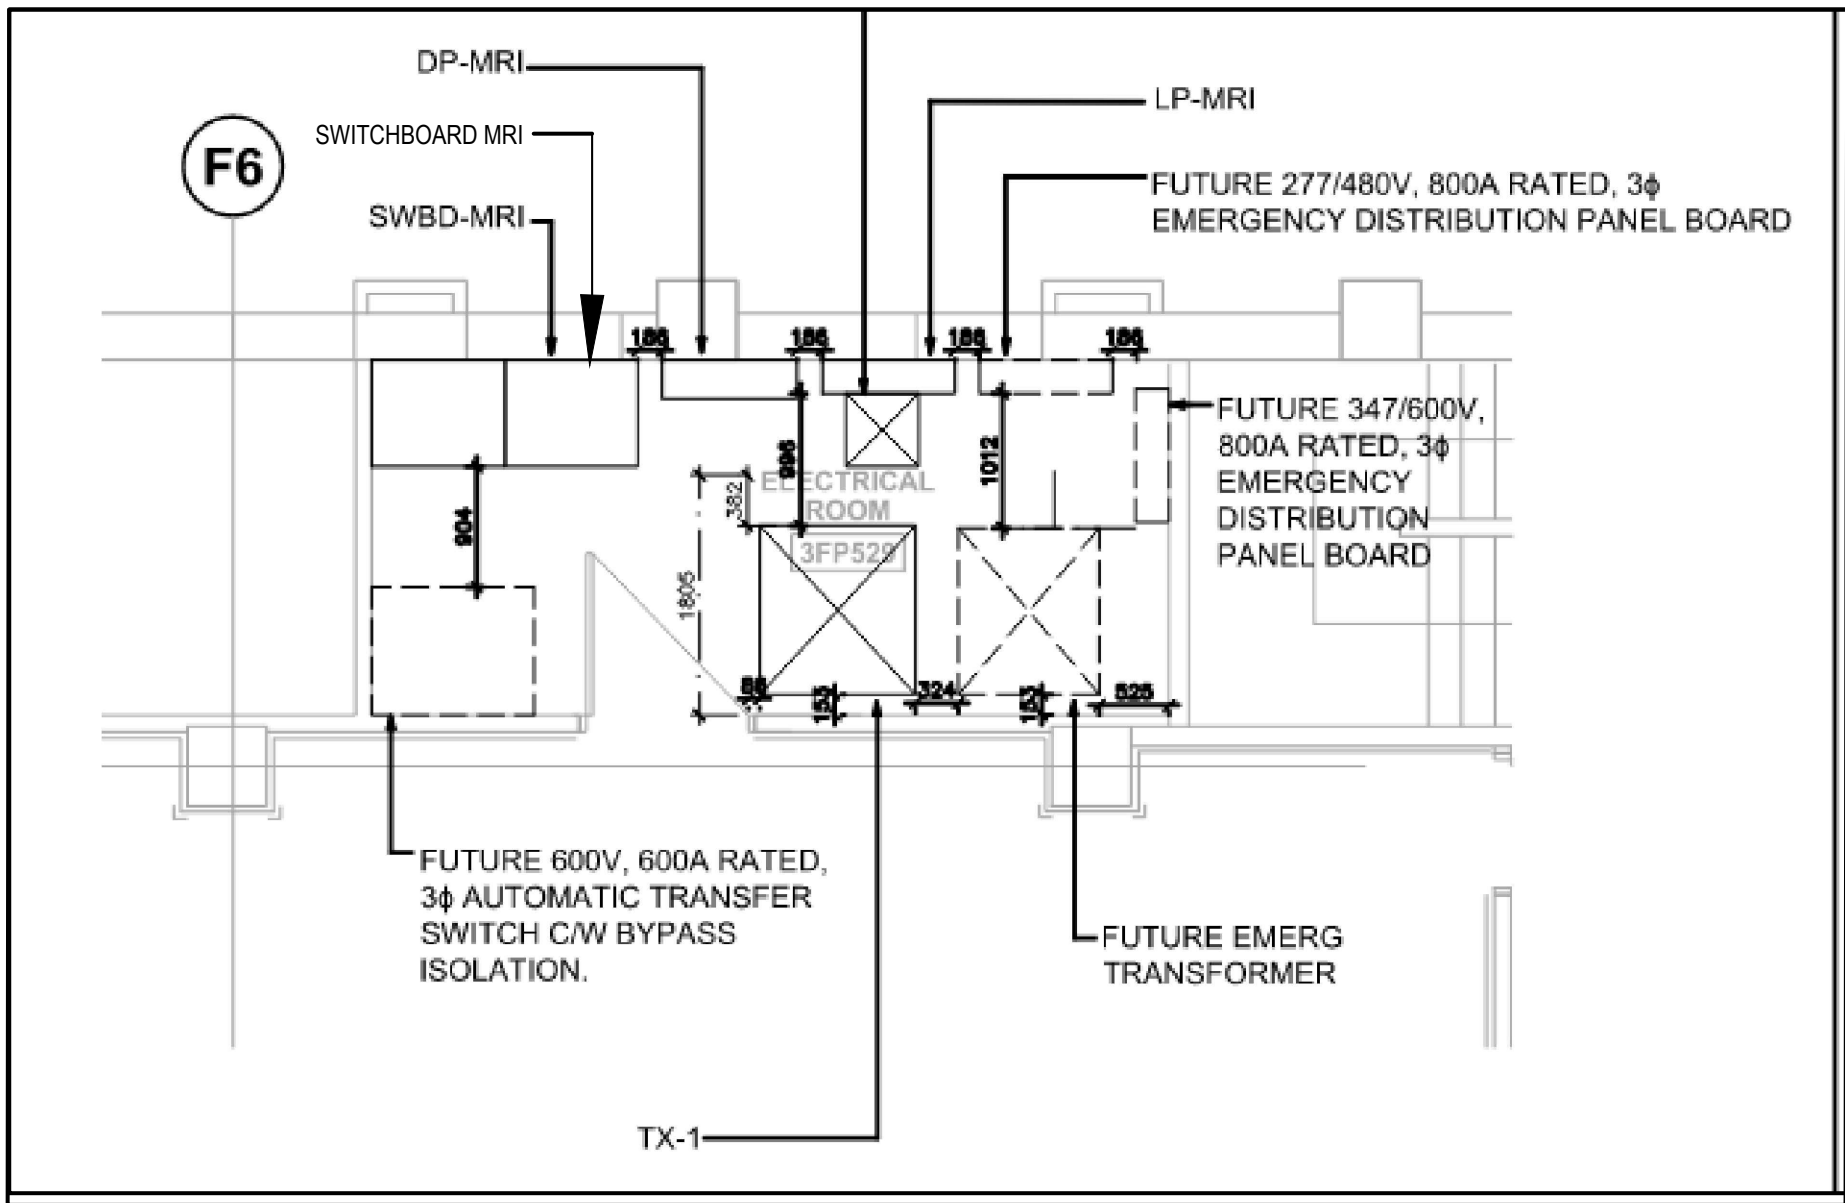

2 ENLARGED PLAN - ELECTRICAL ROOM
N.T.S

CLIENT:

UHN University Health Network
Toronto Western Hospital
399 Bathurst Street
Toronto ON M5T 2S8
www.uhn.ca

ARCHITECT:

CUMULUS ARCHITECTS INC.
160 Pears Ave. - Suite 300
Toronto, ON M5R 3P6
416-538-0763
www.cumulusarch.com

CONSULTANT:

exp.
t: 905.695.3217 f: 905.695.0167
220 Commerce Valley Drive West, Suite 110
Markham, ON L3T 0A8
Canada
www.exp.com
• BUILDINGS • EARTH & ENVIRONMENT • ENERGY •
• INDUSTRIAL • INFRASTRUCTURE • SUSTAINABILITY •

PROJECT STATUS:

REVISIONS

NO.	DESCRIPTION	DATE
1	Issued for Permit	2024.04.05
2	Issued for Permit Comment	2024.07.29
3	Issued for 90% CD / Permit	2024.09.06
4	Issued for 100% CD	2024.09.27
5	Issued for Tender	2024.10.11
6	Issued for Tender Addendum No.5	2024.11.19

PROJECT:
UHN TWH - Seniors Emergency Medicine Centre
399 Bathurst Street, Toronto ON M5T 2S8
UHN PROJECT NO.: SAP #110022016

TITLE:
LEVEL 3 FLOOR PLAN - ELECTRICAL
LAYOUT

PROJECT NO:


MRK-23004289

CHECKED:


M.S.

DRAWING NO:

C-E201

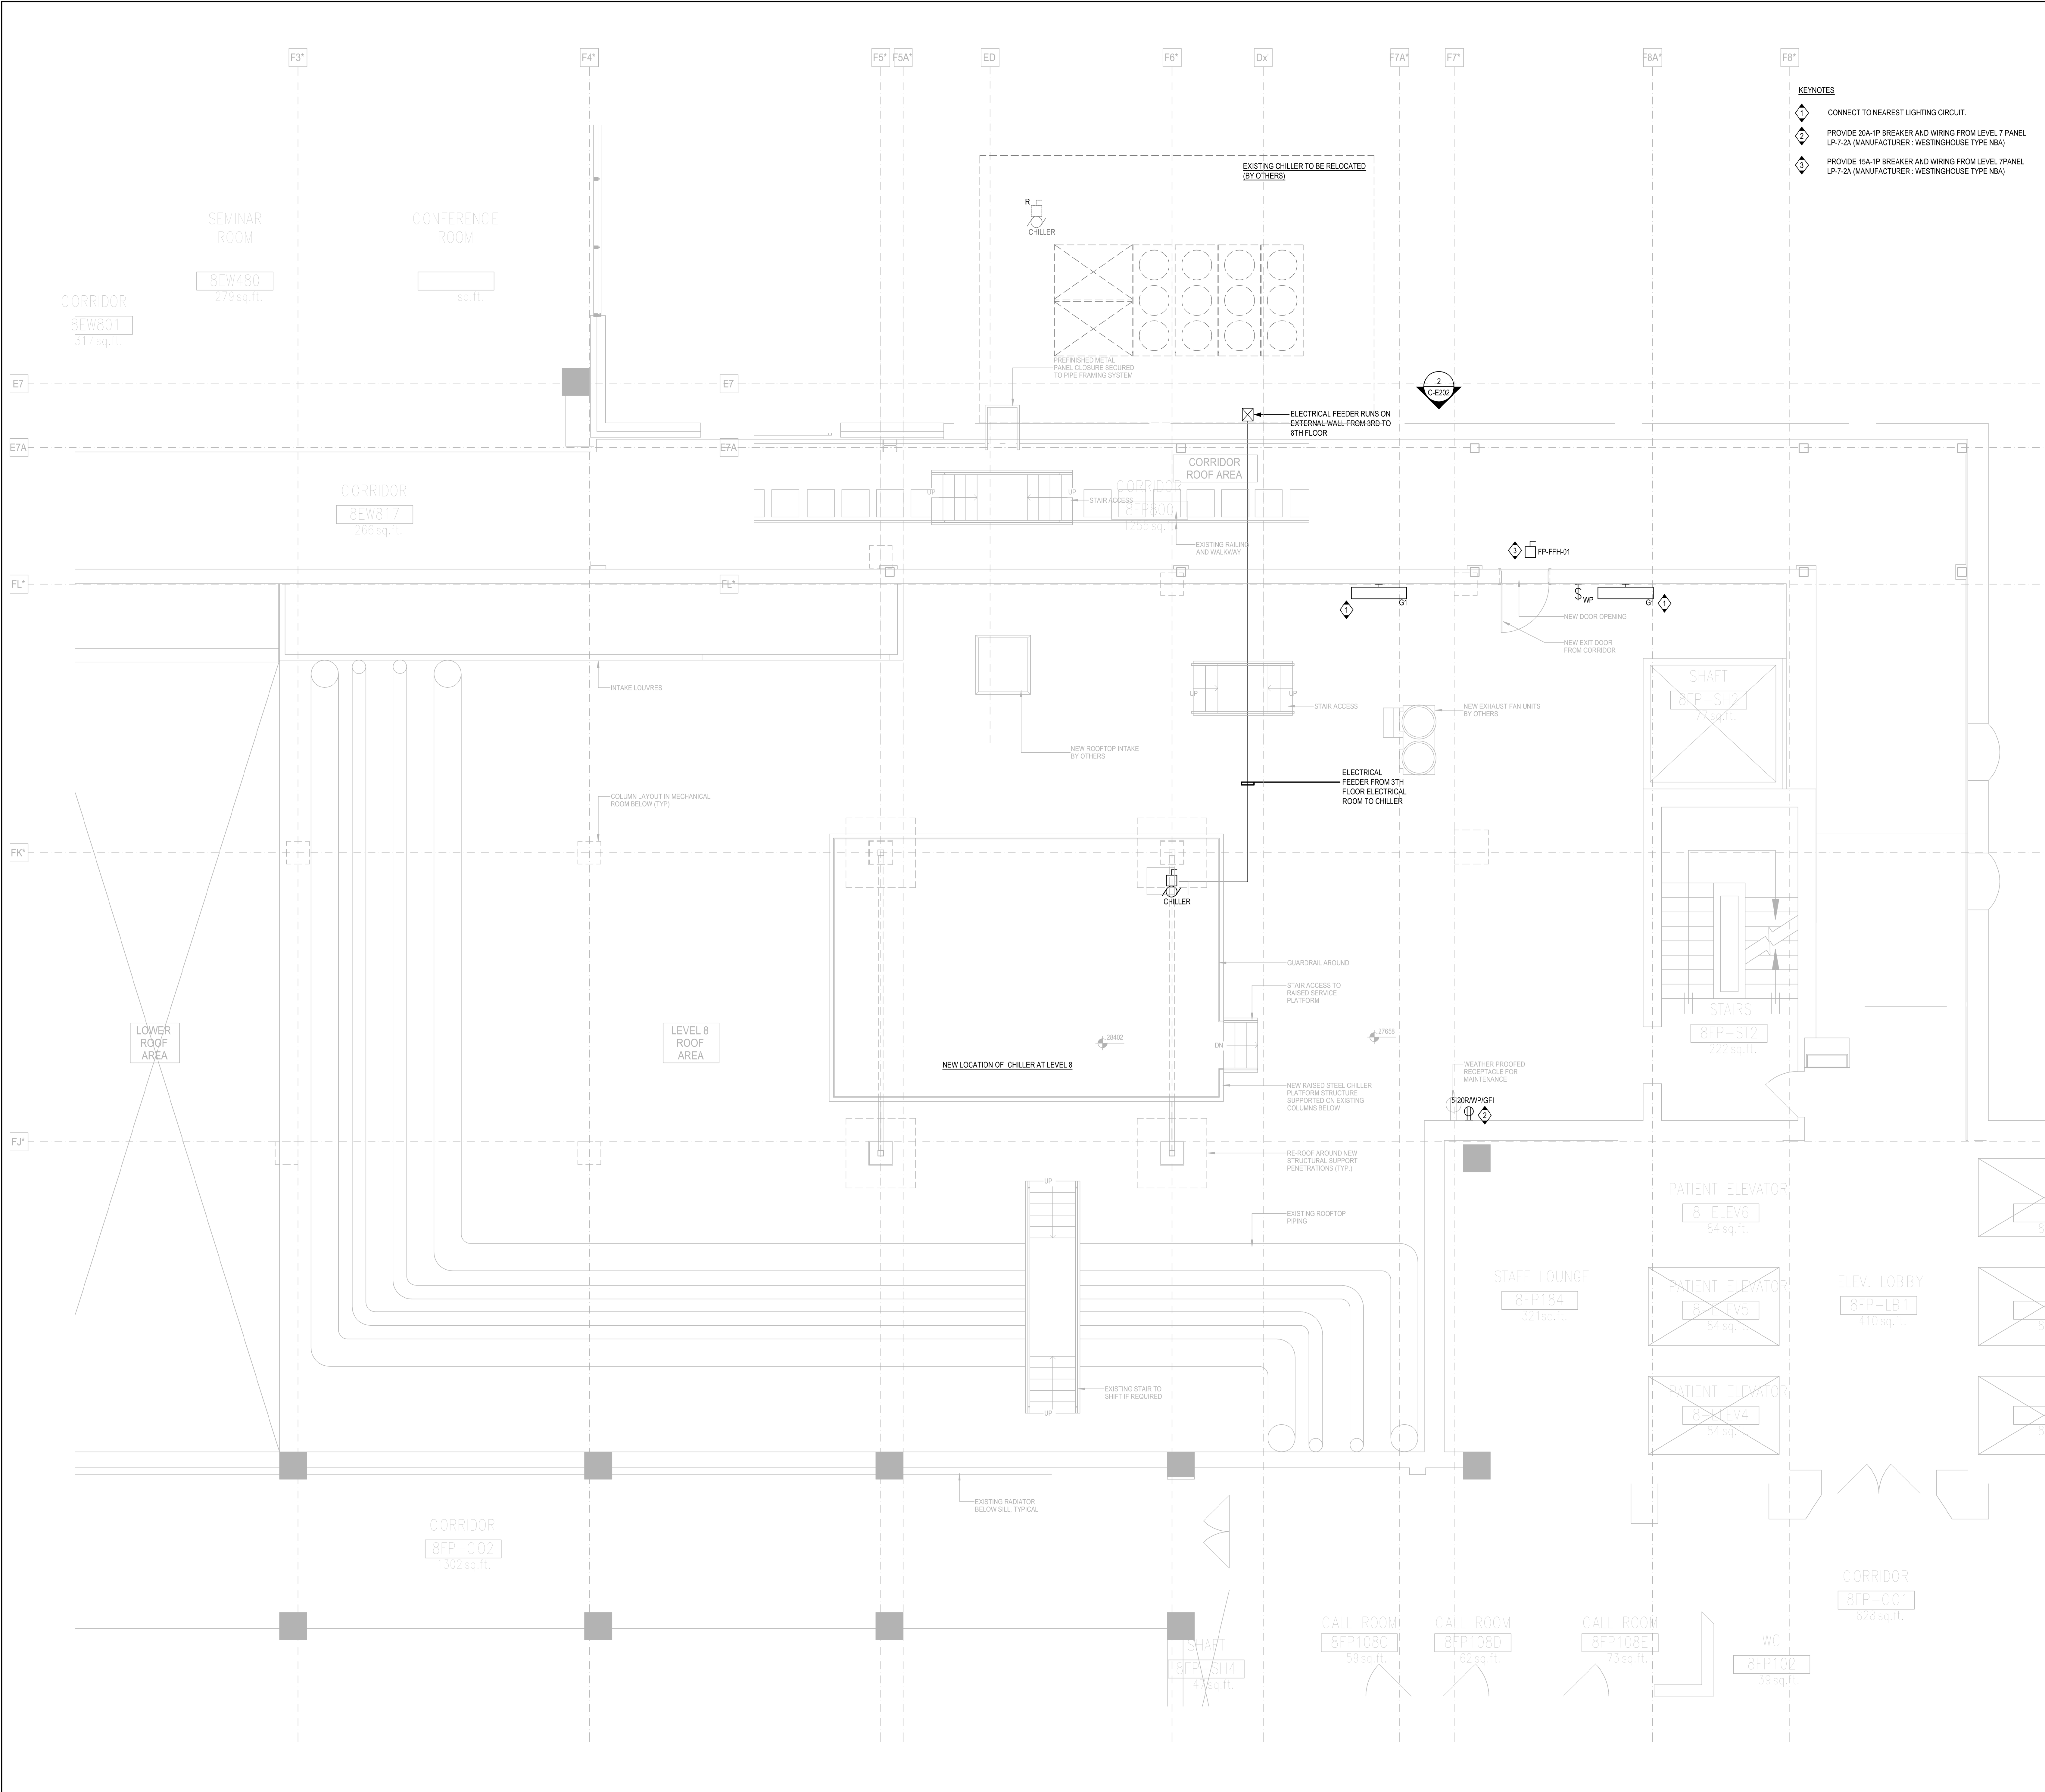

1 LEVEL 8 ROOF PLAN - ELECTRICAL LAYOUT
1:50

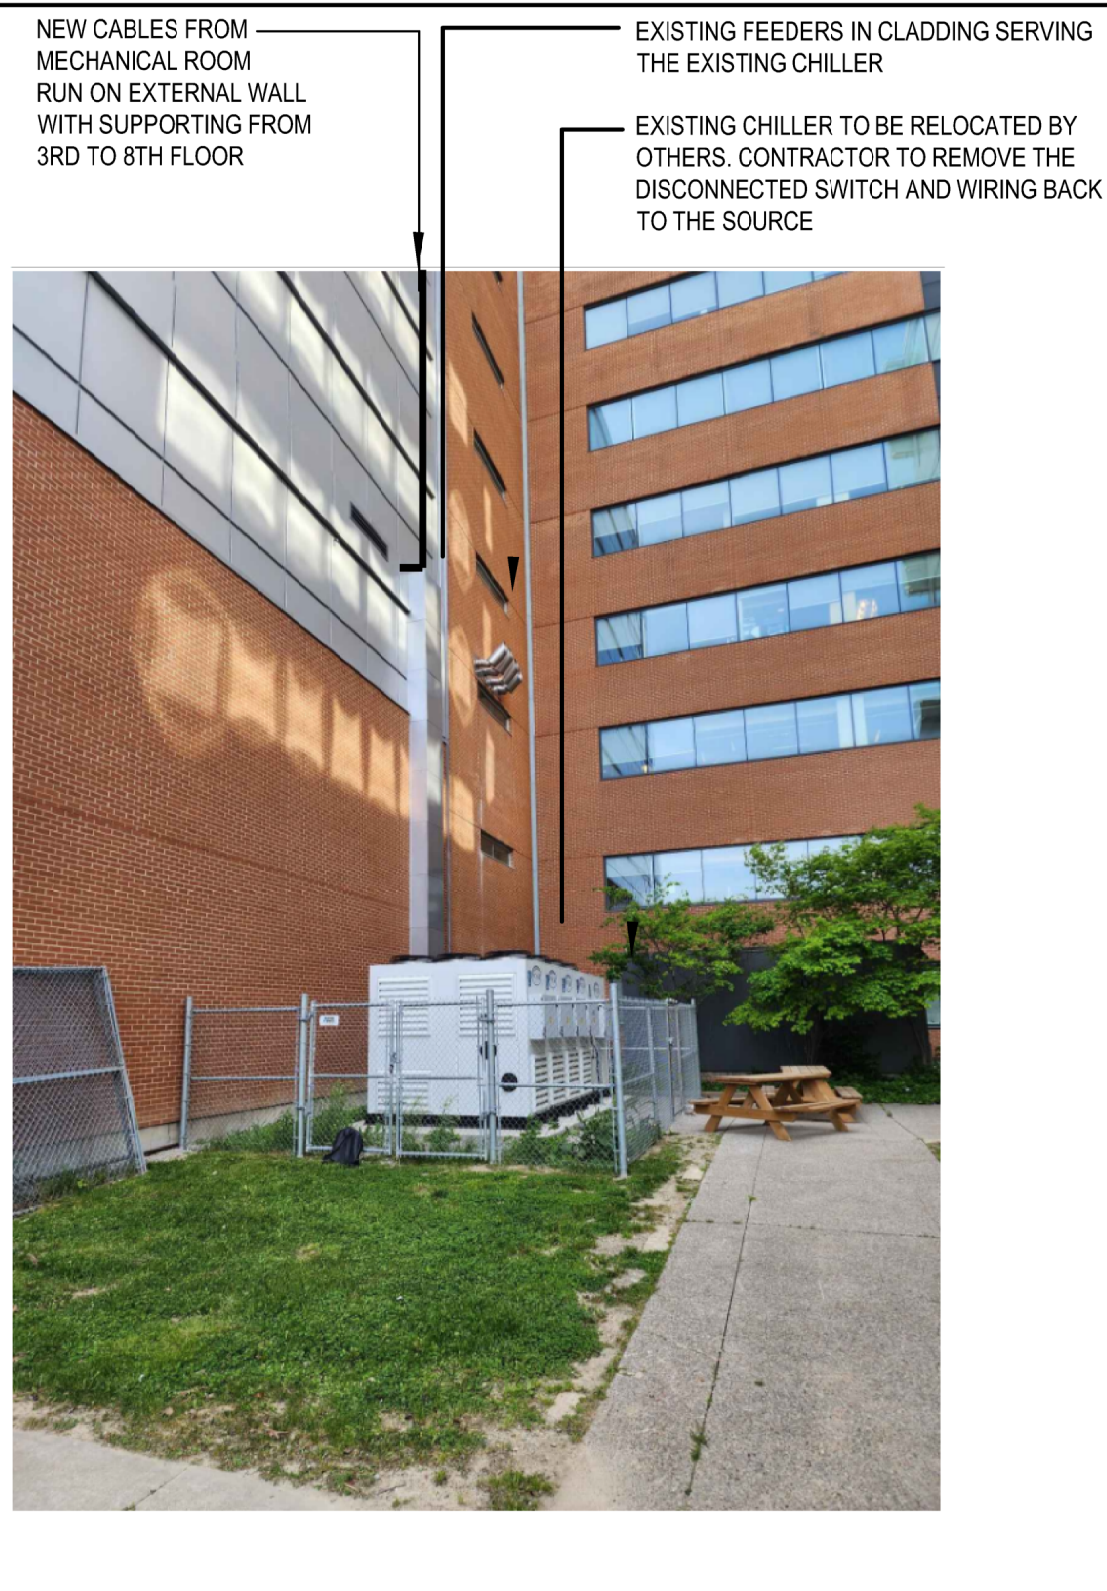

2 SITE PHOTO
NTS

CLIENT:

UHN University Health Network
Toronto Western Hospital
399 Bathurst Street
Toronto ON M5T 2S8
www.uhn.ca

ARCHITECT:

CUMULUS ARCHITECTS INC. 160 Pears Ave., Suite 300
Toronto, ON M5R 3P8
416-535-0763
www.cumulusarch.com

CONSULTANT:

exp.
1: 905.695.3217 | F: 905.695.0167
220 Commerce Valley Drive West, Suite 110
Markham, ON L3T 0A8
Canada
www.exp.com
• BUILDINGS • EARTH & ENVIRONMENT • ENERGY •
• INDUSTRIAL • INFRASTRUCTURE • SUSTAINABILITY •

PROJECT STATUS:

REVISIONS

NO	DESCRIPTION	DATE
1	Issued for Permit	2024.04.05
2	Issued for Permit Comment	2024.07.29
3	Issued for 90% CD / Permit	2024.09.06
4	Issued for 100% CD	2024.09.27
5	Issued for Tender	2024.10.11
6	Issued for Tender Addendum	2024.10.25

PROJECT:
UHN TWIH - Seniors Emergency Medicine Centre
399 Bathurst Street, Toronto ON M5T 2S8
UHN PROJECT NO.: SAP #110022016


TITLE:
LEVEL 8 ROOF - ELECTRICAL LAYOUT &
ENLARGED PLAN

PROJECT NO:
MRK-23004289


CHECKED:
M.S.

DRAWING NO:

C-E202

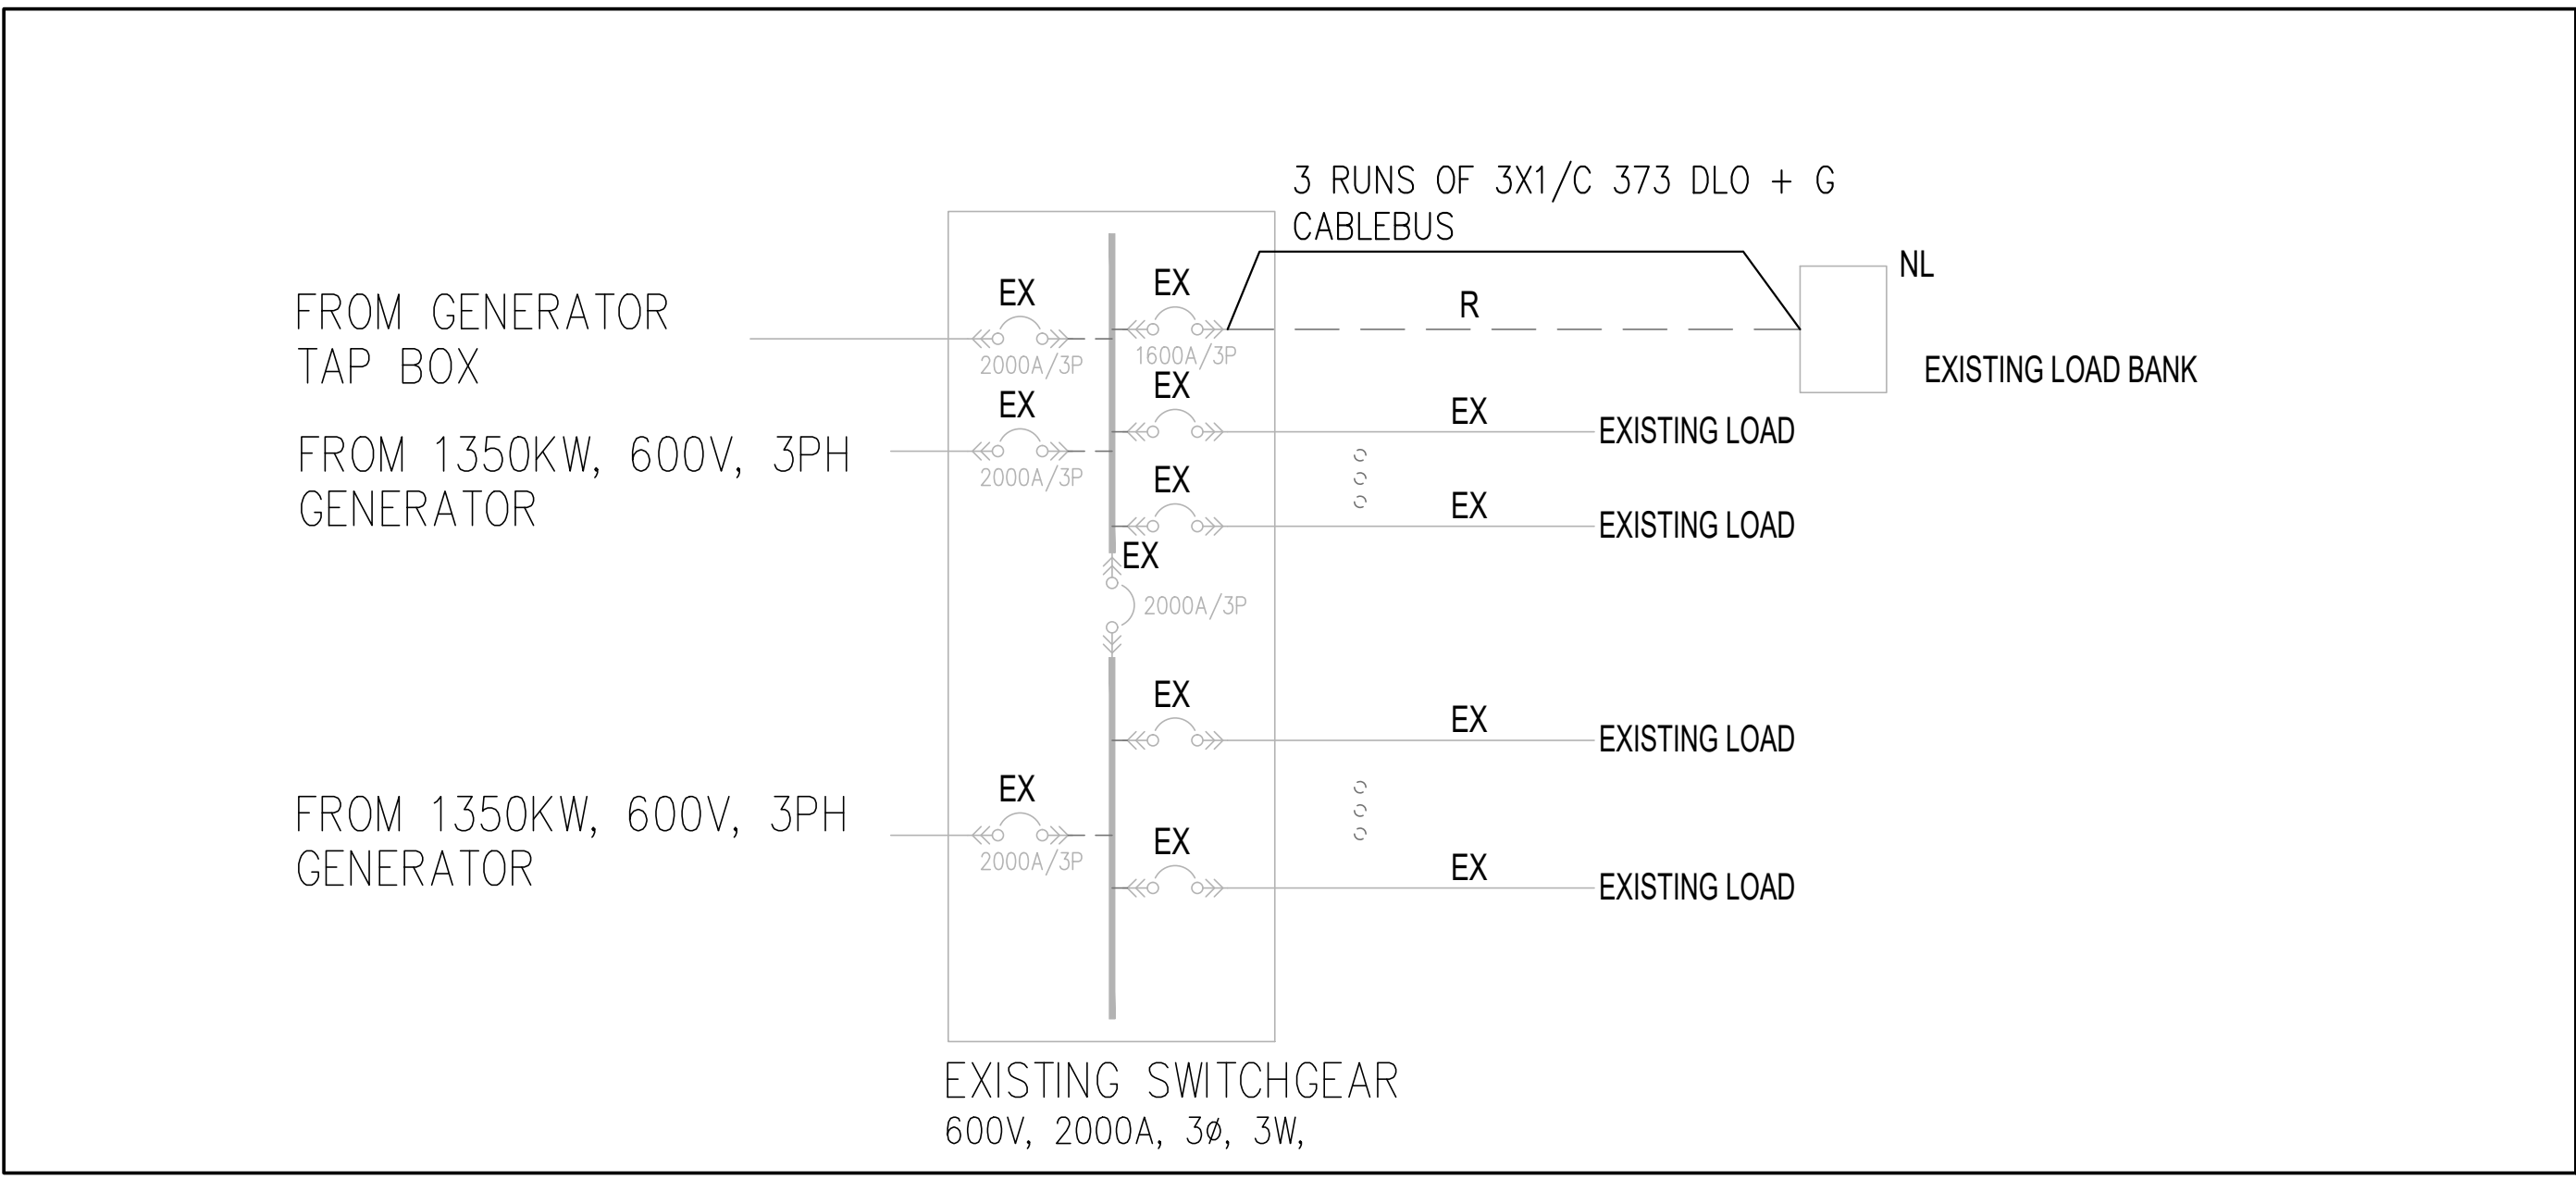

1 PARTIAL POWER DISTRIBUTION RISER DIAGRAM – G/F LOAD BANK RELOCATION
C-E409 SCALE: N.T.S.

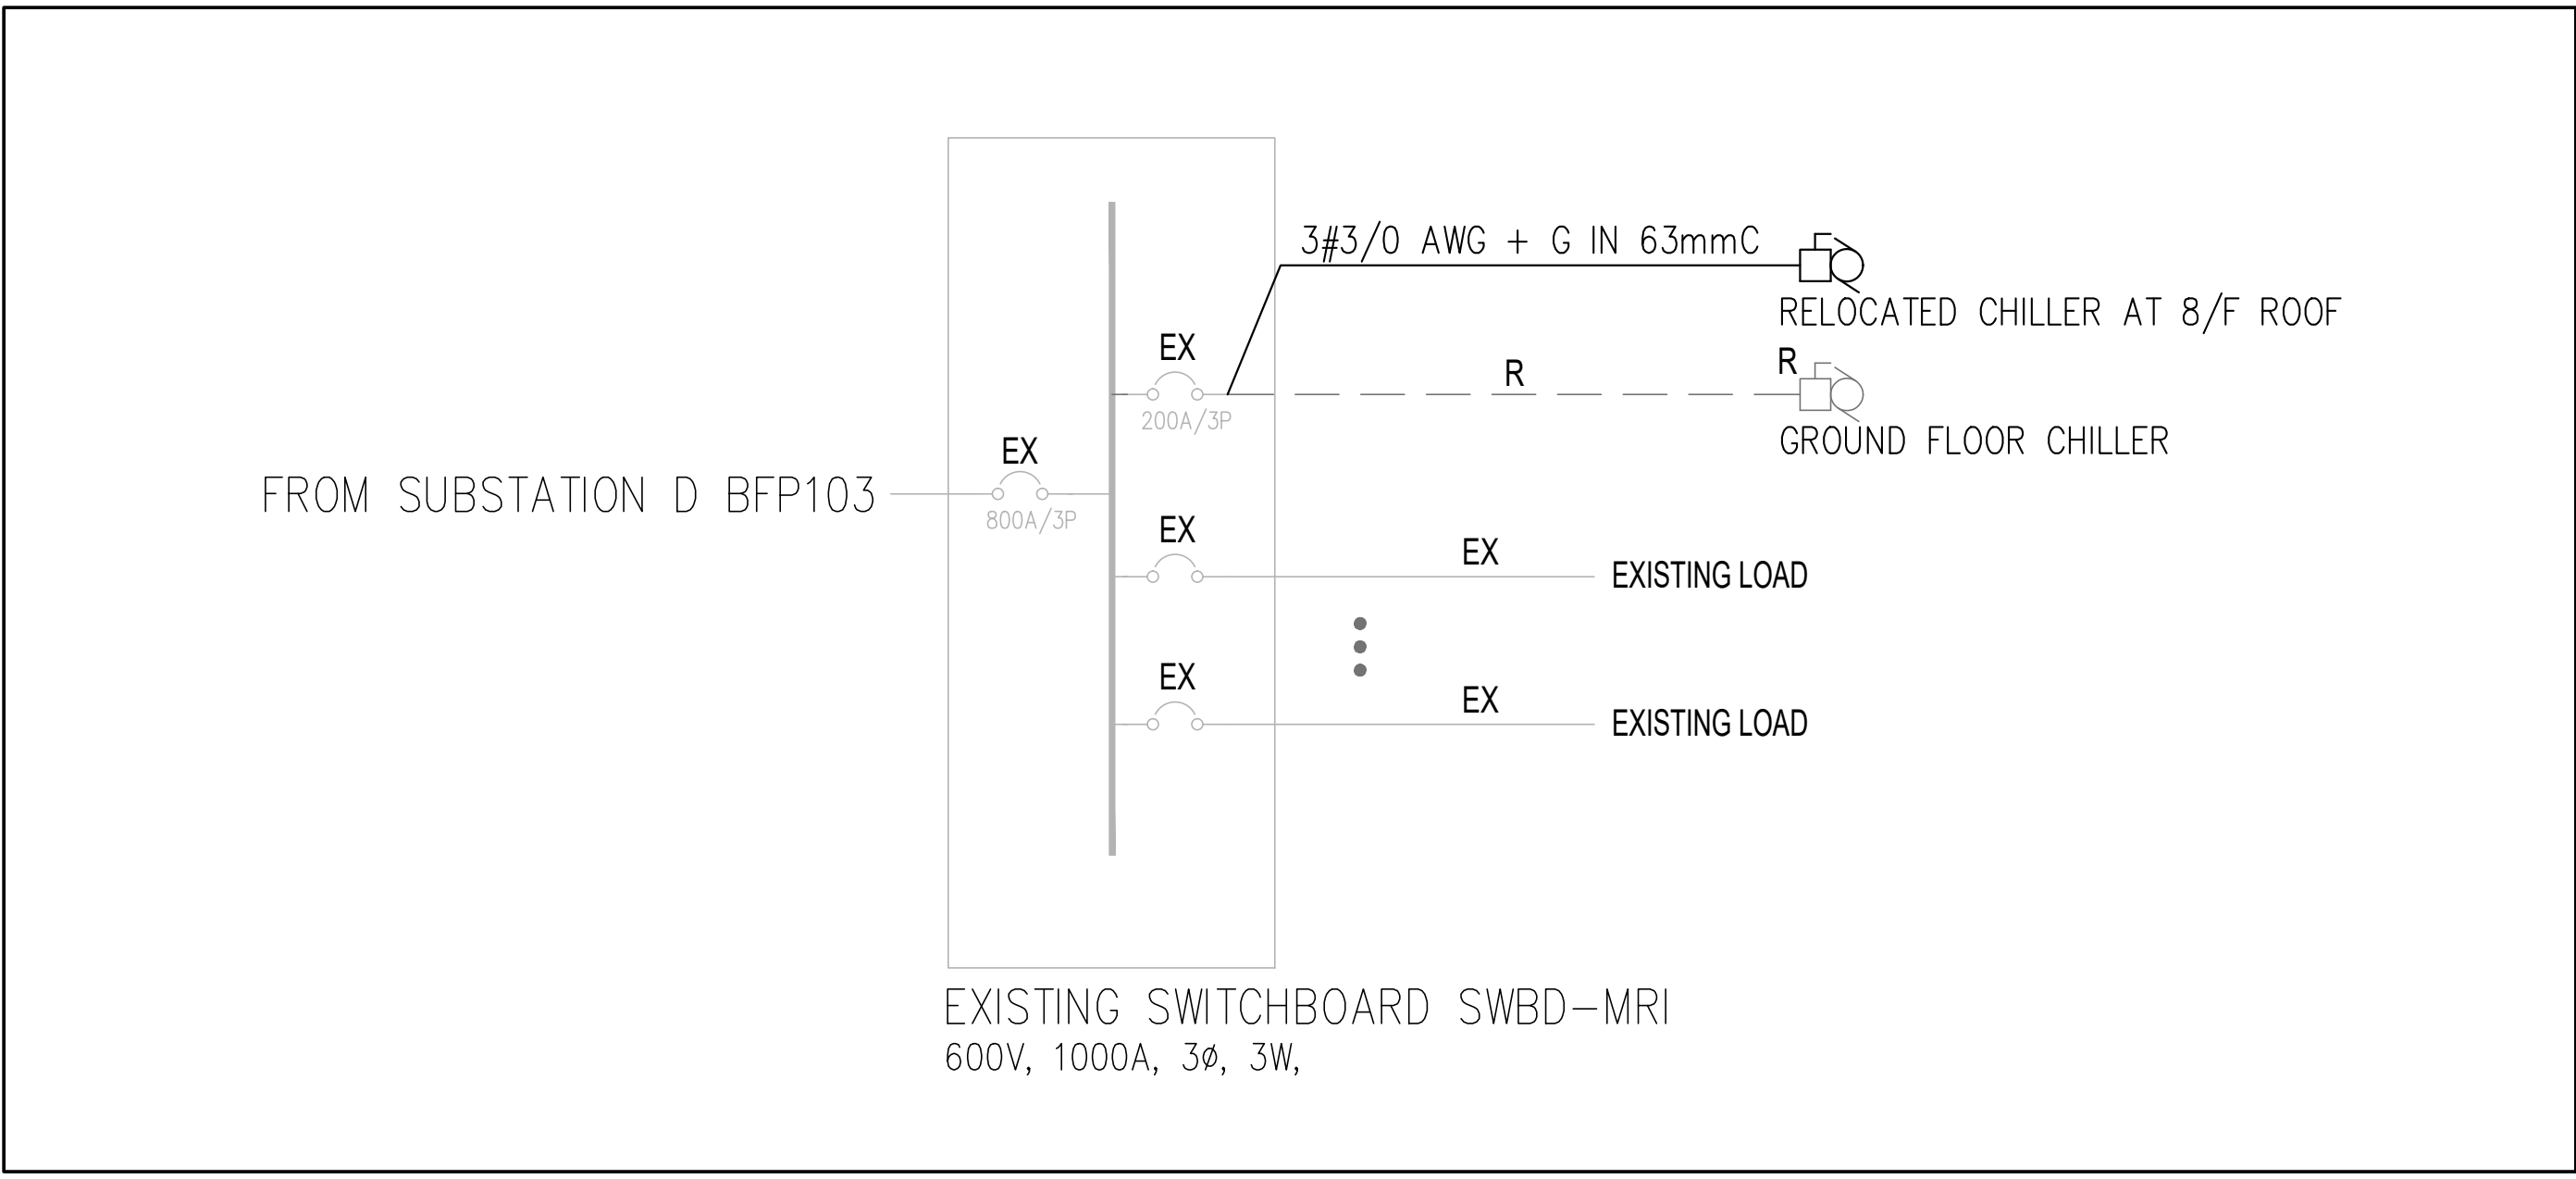

2 PARTIAL POWER DISTRIBUTION RISER DIAGRAM – CHILLER RELOCATION
C-E409 SCALE: N.T.S.

LUMINAIRE SCHEDULE											
TYPE	BASE MANUFACTURER (AS SPECIFIED)	CATALOGUE NUMBER	CEILING MOUNTED		WALL MOUNTED		WATTAGE	COLOUR TEMP.	VOLTAGE		REMARKS
			SURFACE	RECESSED	SURFACE	RECESSED			120V	347V	
G1	COLUMBIA LIGHTING	LXEM-4-3500-ML-RFA-E-U LXEM-4-4000-ML-RFA-E-U	•		•		42W	3500K OR 4000K	•		3500K FOR BASEMENT CRAWL SPACE, 4000K FOR OUTDOOR. COMPLETE WITH ALL NECESSARY MOUNTING ACCESSORIES.
NOTES: 1. ALL FINISHES, FLANGE AND PLASTER COLOURS TO BE CONFIRMED WITH ARCHITECT/DESIGNER PRIOR TO ORDERING LUMINAIRES. 2. ALL LUMINAIRES SHALL BE CSA APPROVED. 3. CONTRACTOR TO PROVIDE MOUNTING ACCESSORIES AND HARDWARE TO SUIT CEILING AND WALL FINISHES. 4. PROVIDE APPROVED EQUAL FOR ENGINEER'S REVIEW DURING SHOP DRAWINGS REVIEW. 5. PROVIDE SUITABLE STEP DOWN TRANSFORMER FOR ANY LOW VOLTAGE LIGHTING AS REQUIRED.											

CLIENT:



University Health Network
Toronto Western Hospital
399 Bathurst Street
Toronto, ON M5T 2S8
www.uhn.ca

ARCHITECT:



160 Pears Ave. - Suite 300
Toronto, ON M5R 3P6
416-538-0763
www.cumulusarch.com

CONSULTANT:



1-800-660-3217 / 1-800-660-0187
220 Commerce Valley Drive West, Suite 110
Markham, ON L3T 0A8
Canada
www.exp.com

• BUILDINGS • EARTH & ENVIRONMENT • ENERGY •

• INDUSTRIAL • INFRASTRUCTURE • SUSTAINABILITY •

PROJECT STATUS:

REVISIONS

NO.	DESCRIPTION	DATE
1	Issued for Permit	2024.04.05
2	Issued for 90% CD	2024.09.06
3	Issued for 100% CD	2024.09.27
4	Issued for Tender	2024.10.11
5	Issued for Tender Addendum No.5	2024.11.19

PROJECT:

UHN TWH - Seniors Emergency Medicine Centre
399 Bathurst Street, Toronto ON M5T 2S8
UHN PROJECT NO.: SAP #110022016

TITLE:

ELECTRICAL RISER DIAGRAM AND
LUMINARIE SCHEDULE

PROJECT NO:

MRK-23004289

CHECKED:

M.S.

DRAWING NO:

C-E301