


NOTES:

- 1. * DENOTES HALLWAY EXTINGUISHER & CABINET - SEE SPECIFICATION
- 2. * DENOTES RISING COLUMN. SEE P.S. # 11-30 & P.S. # 11-30 & DIVISION 10 SPECIFICATION

NOTES:

- 1. WASHROOMS #2-75, #2-76, #2-81A, #2-102, #2-103, #2-104 & #2-111A PROVIDE A 3/4\"/>

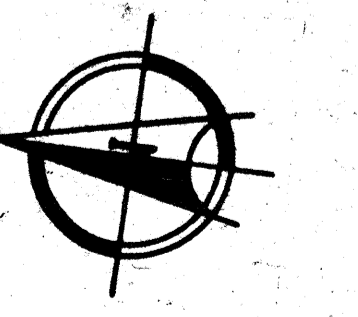

AS BUILT DRAWING
BY
COMSTOCK INTERNATIONAL LTD.

PLUMBING

TORONTO WESTERN HOSPITAL
SOUTH ADDITION-CONTRACT NO. 3
399 BATHURST STREET TORONTO ONTARIO

SECOND FLOOR PLAN
(PREVIOUSLY MAIN FLOOR PLAN)




GOVAN KAMIKER KEENEYSIDE WIL
SLAUNWHITE STEVENSON ARCHITECT
1295 BELLAMY RD. N. SCARBOROUGH, ONTARIO


PROJECT NO. 712-3
DRAWING NO. M-11
M020



THE CONTRACTOR SHALL CHECK AND VERIFY ALL DIMENSIONS ON THE JOB

REVISIONS				PRINT ISSUE RECORD			
NO.	DATE	DESCRIPTION	BY	NO.	DATE	TO	BY
1	MAY 1986	REVISED TO REFLECT AS BUILT CONDITIONS	J.H. ANGUS	1	APRIL 1984	TENDER	J.H. ANGUS
2	JULY 1987	REVISED TO REFLECT AS BUILT CONDITIONS	J.H. ANGUS				

THIS DRAWING HAS BEEN REVISED TO AS BUILT CONDITIONS.
J.H. ANGUS & ASSOC.
DATE: JULY 87

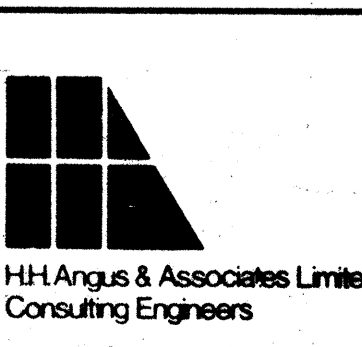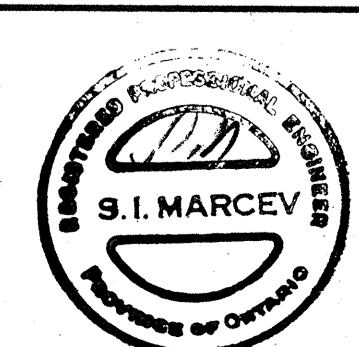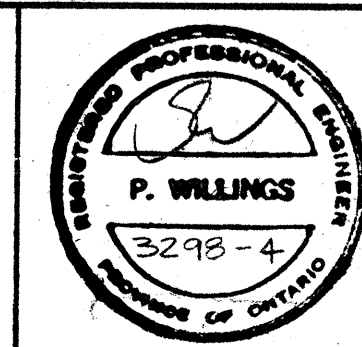

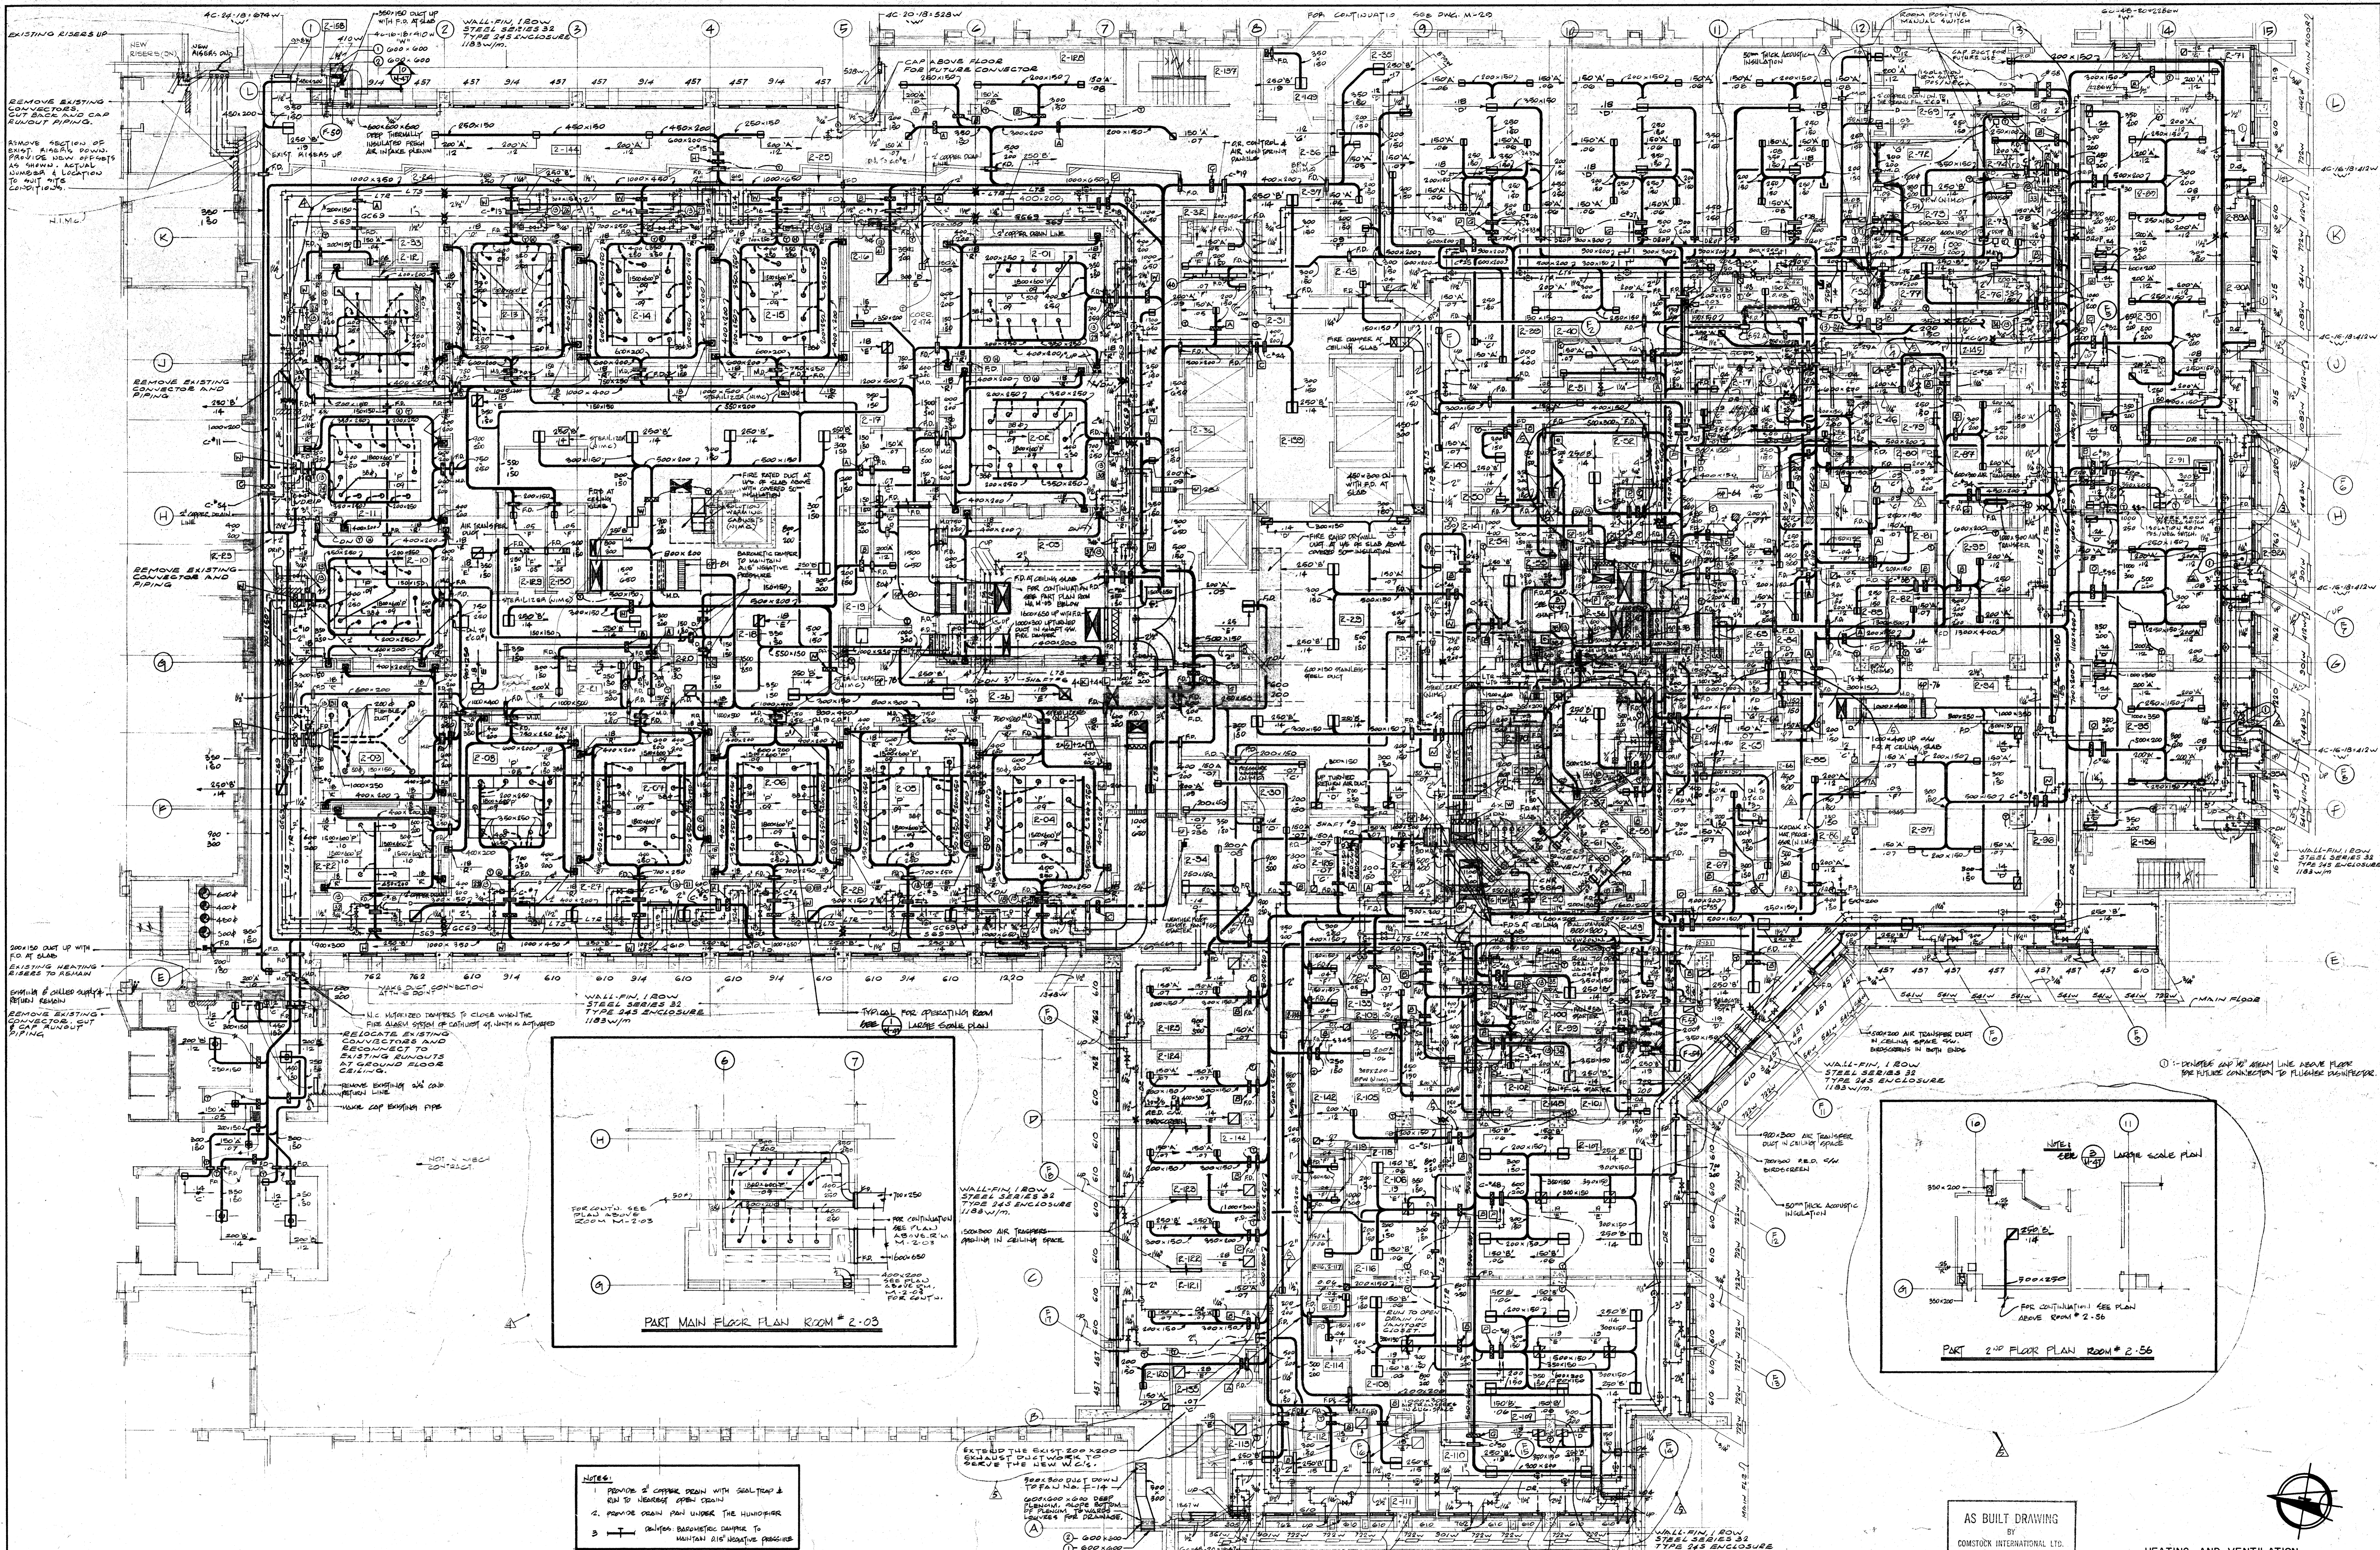

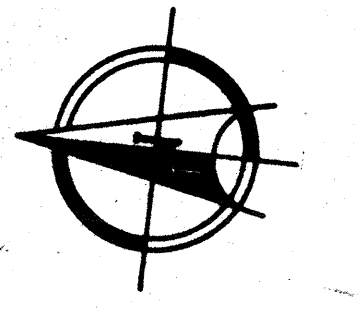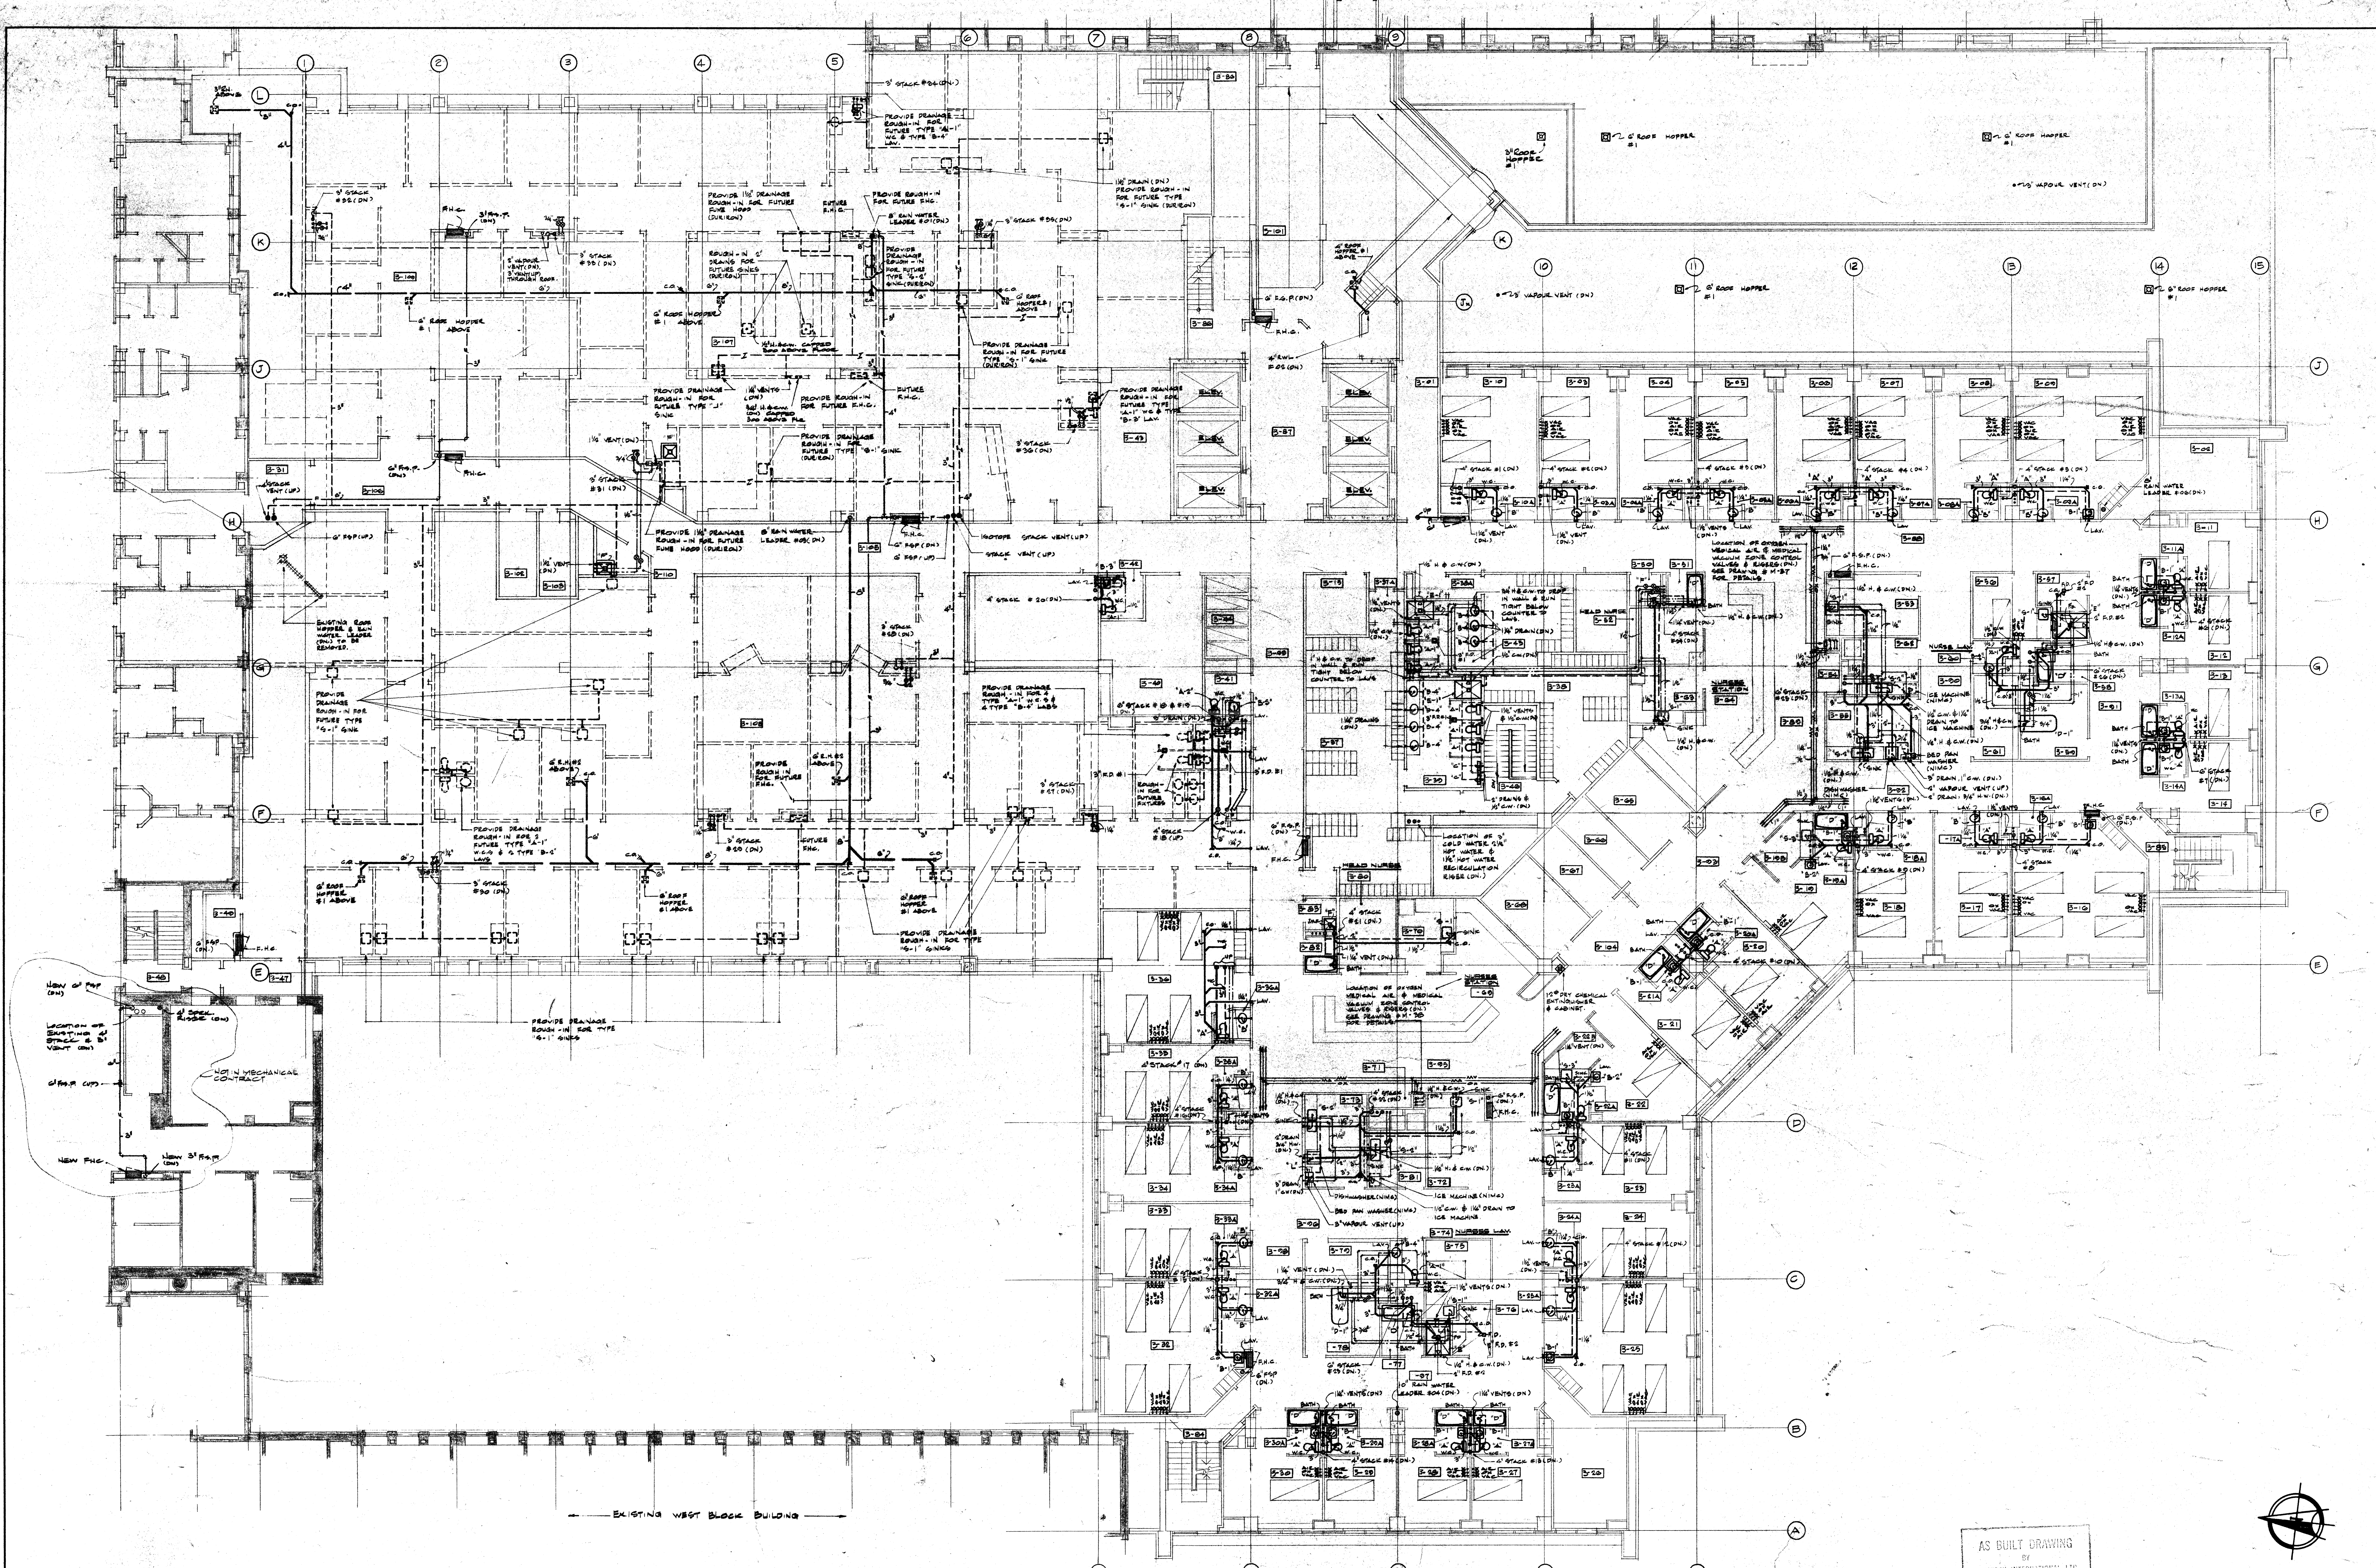

AS BUILT DRAWING
BY
COMTECH INTERNATIONAL LTD.


PLUMBING

TORONTO WESTERN HOSPITAL
SOUTH ADDITION-CONTRACT NO. 3712-3
399 BATHURST STREET TORONTO ONTARIO
THIRD FLOOR PLAN
(PREVIOUSLY FIRST FLOOR PLAN)
GOVAN KAMINKER KEENEYSIDE WILSON
SLAUNWHITE STEVENSON ARCHITECTS
1285 BELLAMY RD. N. SCARBOROUGH, ONTARIO, C. M022

THIS DRAWING HAS
BEEN REVISED TO
AS BUILT CONDITIONS.
H.H. ANGUS & ASSOC.
DATE: JULY, 87

REVISIONS				PRINT ISSUE RECORD			
NO.	DATE	BY	TO	NO.	DATE	BY	TO
1	APR. 1984	J.W.	TENDER				

THE CONTRACTOR SHALL CHECK AND VERIFY ALL DIMENSIONS ON THE JOB

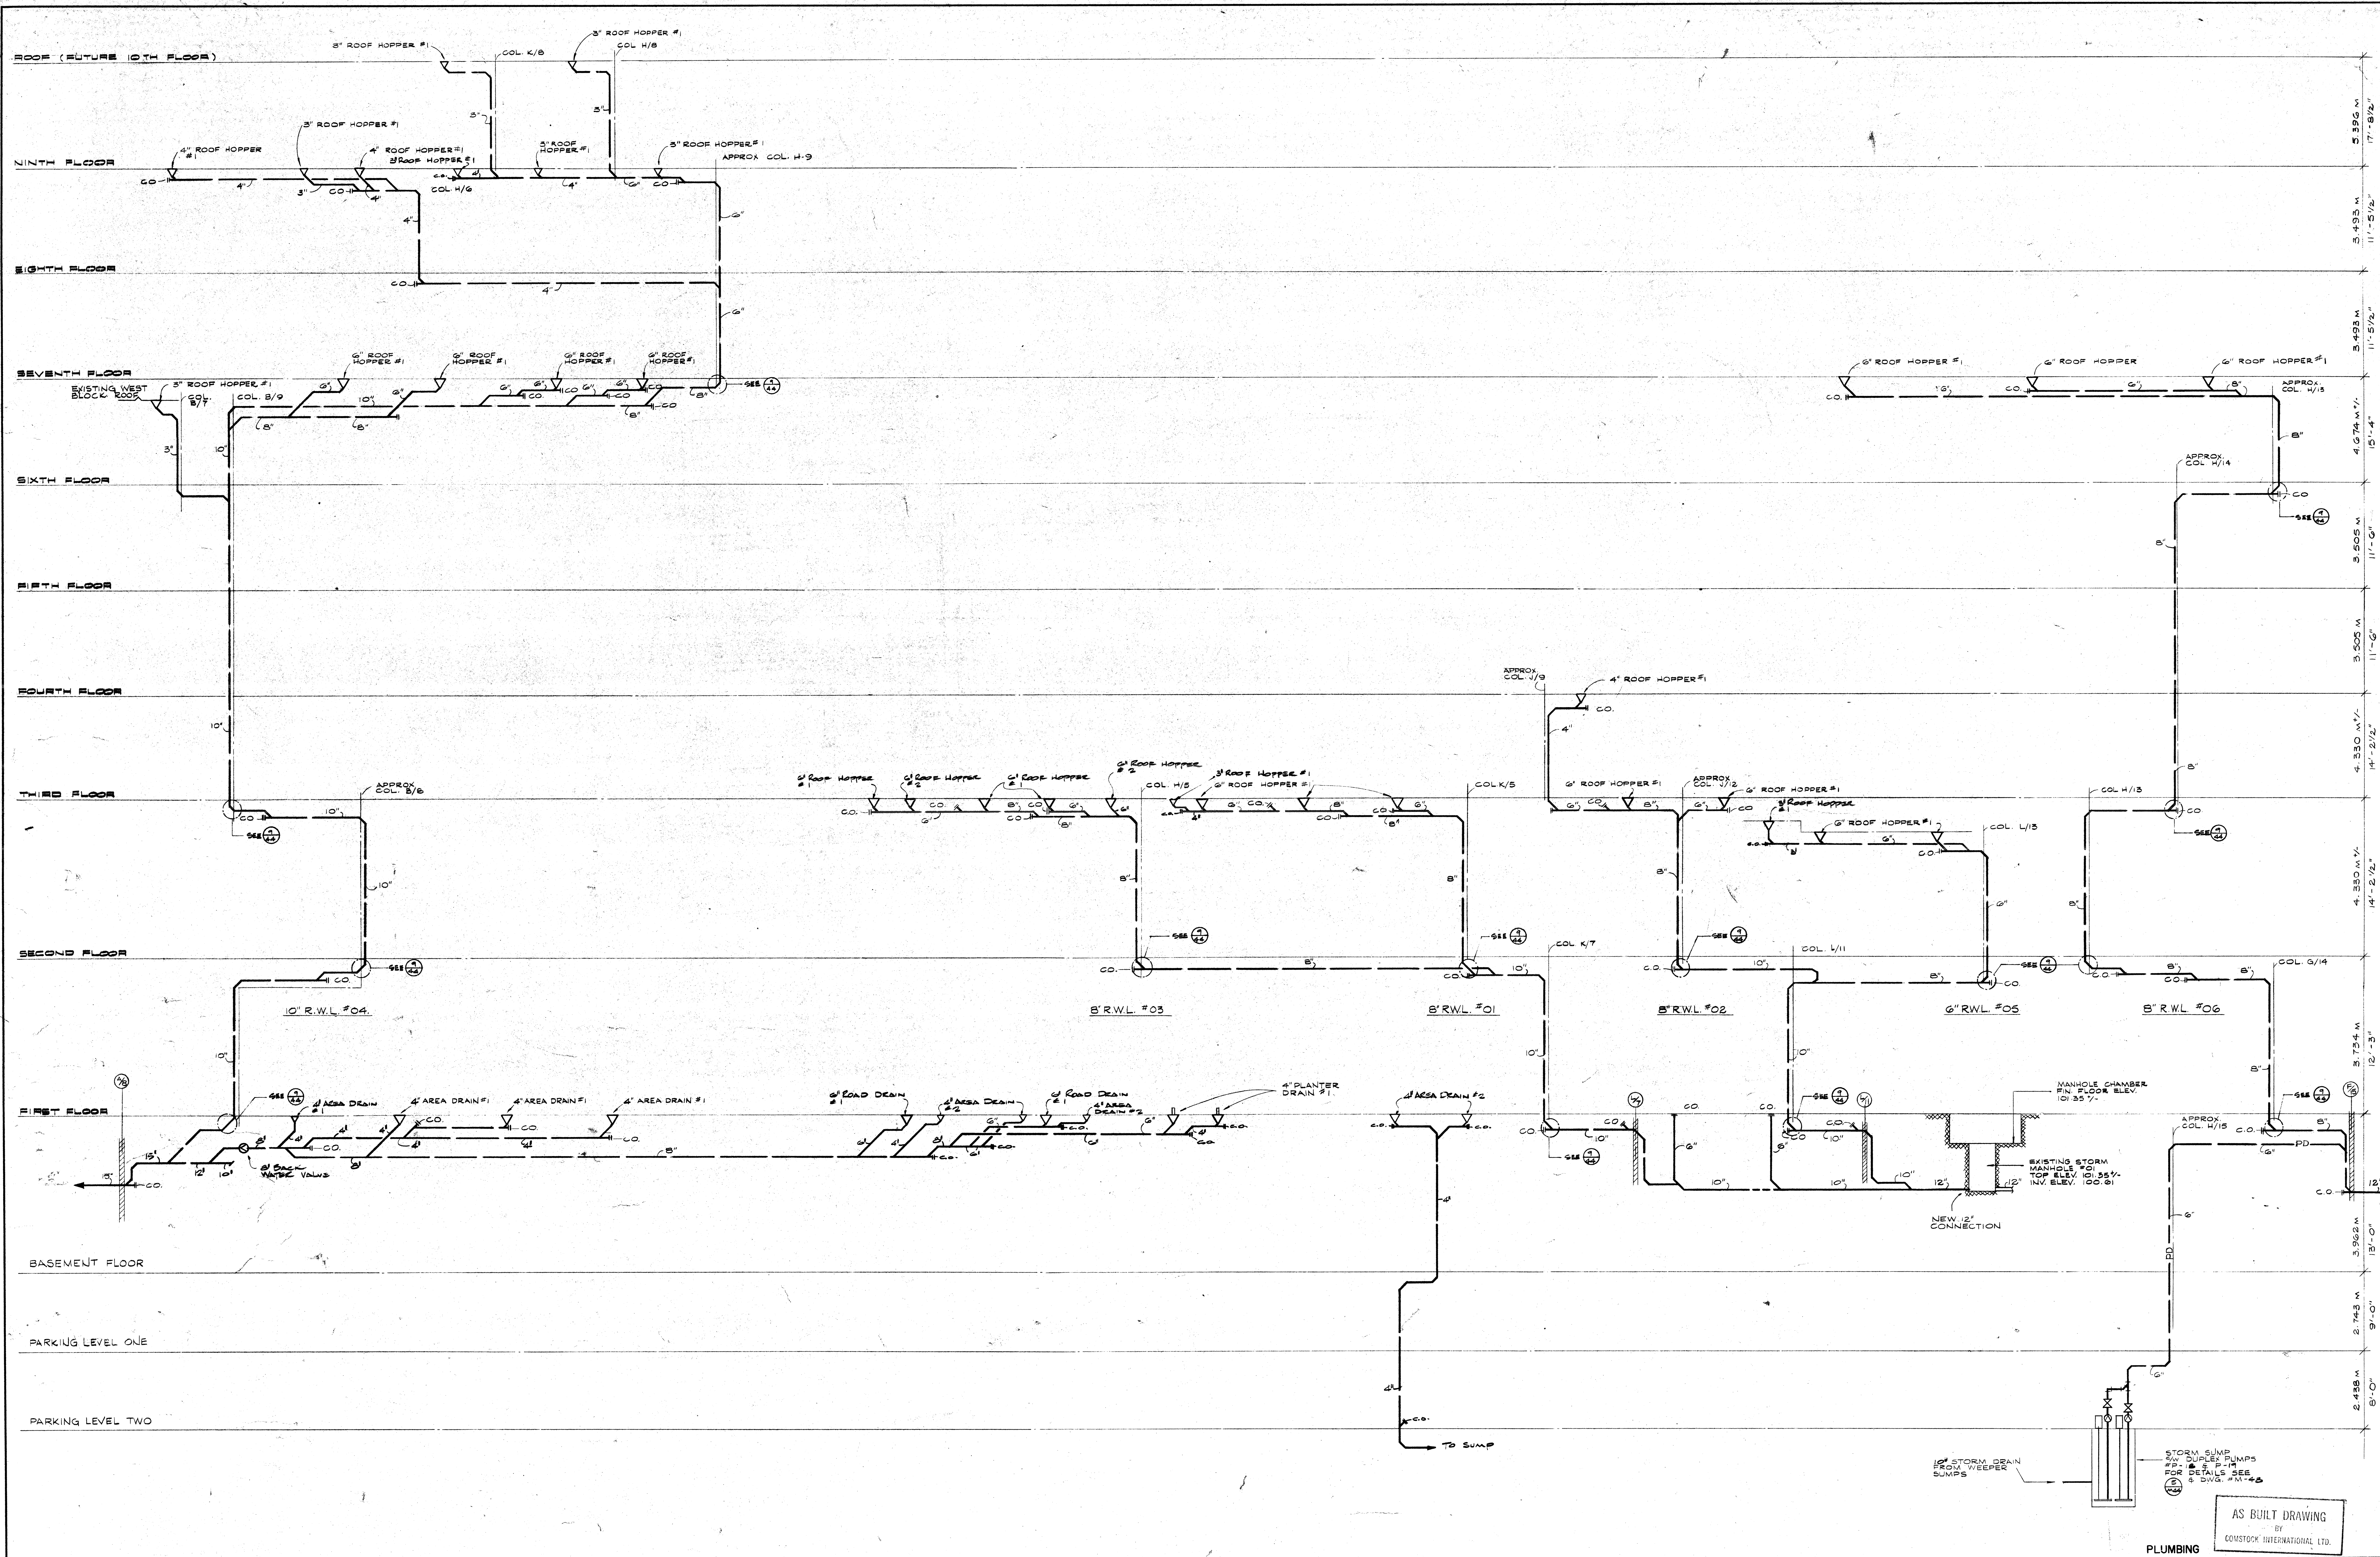

ROOF (FUTURE 10TH FLOOR)

NINTH FLOOR

EIGHTH FLOOR

SEVENTH FLOOR

SIXTH FLOOR

FIFTH FLOOR

FOURTH FLOOR

THIRD FLOOR

SECOND FLOOR




FIRST FLOOR

BASEMENT FLOOR

UPPER PARKING



LOWER PARKING

PARKING LEVEL 3

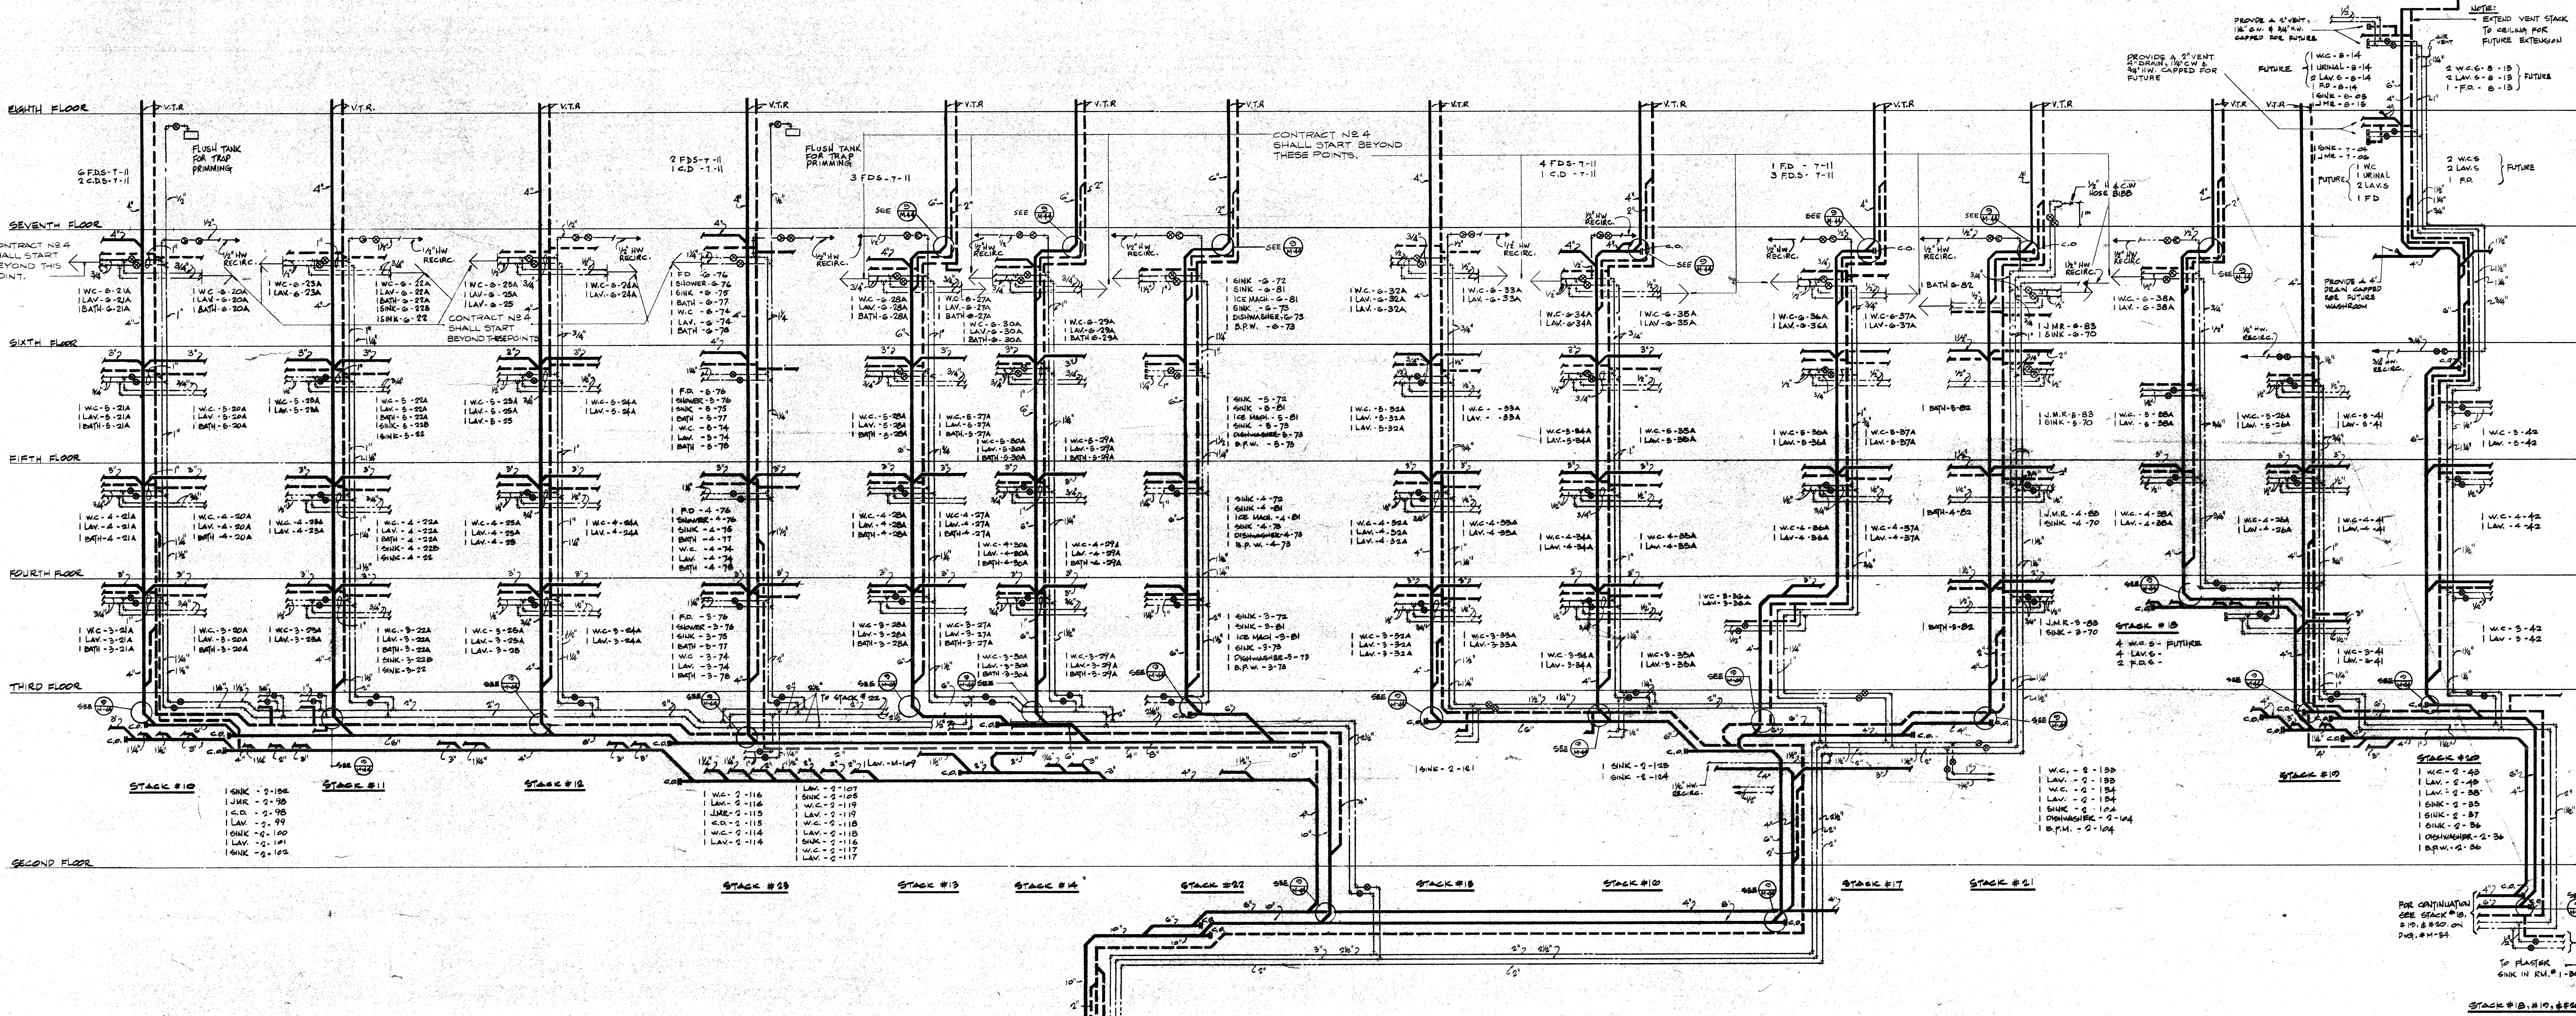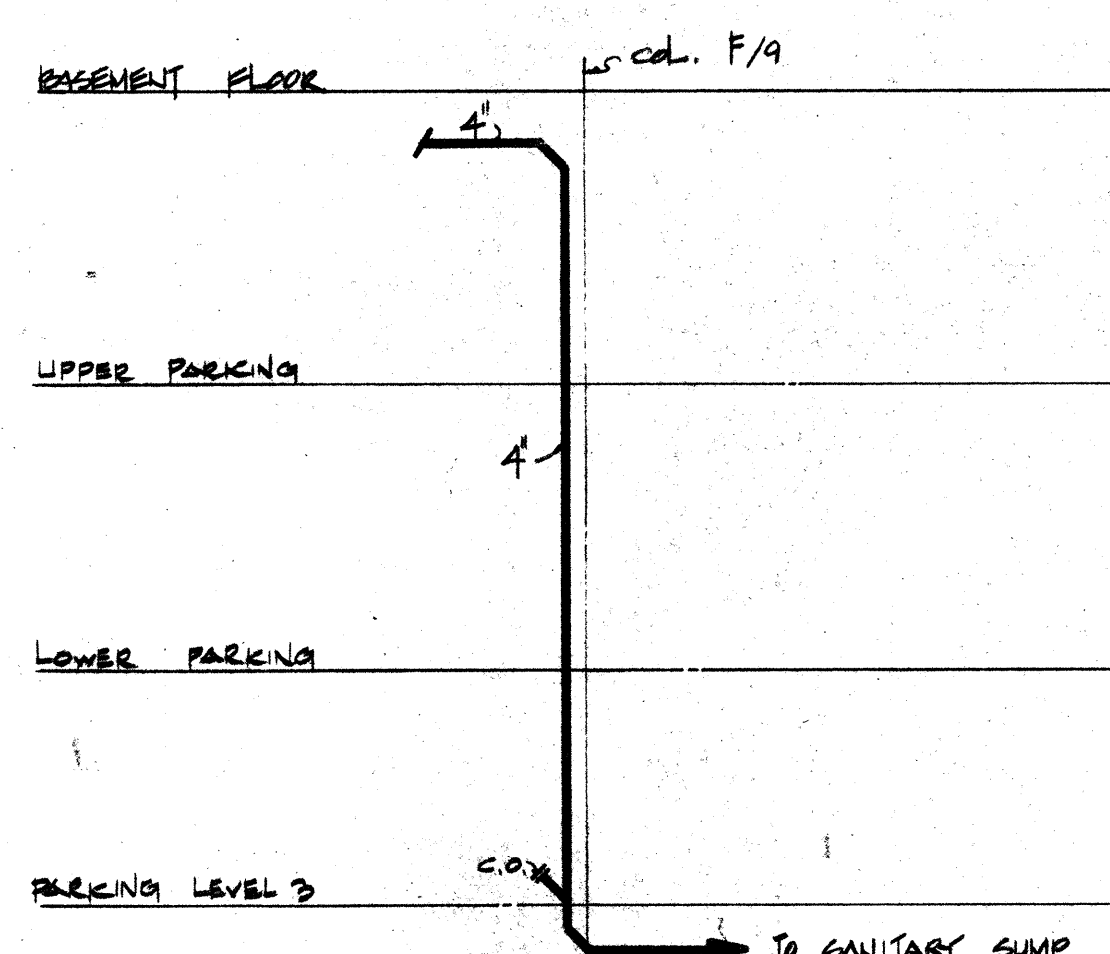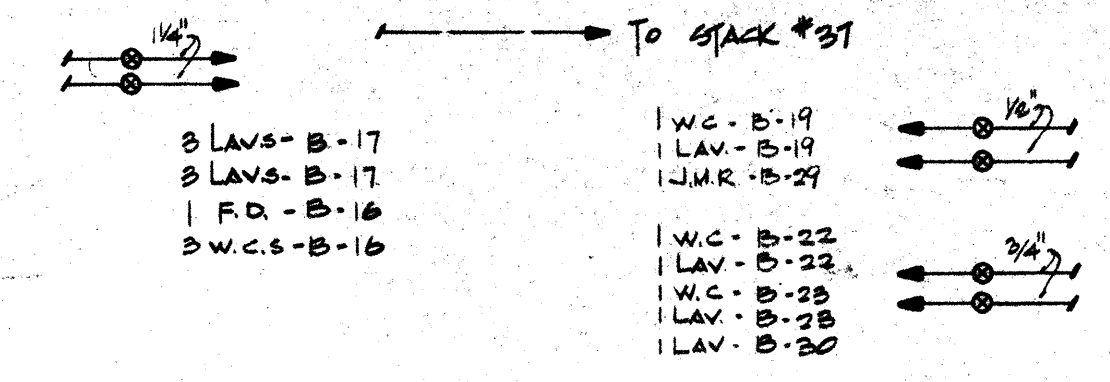

NOTES:
1. ROUGH IN OF DRAINS AND ASSOCIATED VENTS FOR FIXTURES LOCATED ON THE SIXTH FLOOR WILL BE PROVIDED UNDER CONTRACT NO. 3. ALL FINAL CONNECTIONS TO FIXTURES SHALL BE DONE UNDER THIS CONTRACT NO. 4.
2. DOMESTIC HOT & COLD WATER CAPPED CONNECTIONS WITH VALVES AT THE MAIN RISERS AS INDICATED ON RISER DIAGRAM ABOVE WILL BE PROVIDED UNDER CONTRACT NO. 3. BEYOND THESE POINTS, PIPING & DISTRIBUTION FOR THE FIXTURES LOCATED ON THE SIXTH FLOOR SHALL BE PROVIDED UNDER THIS CONTRACT NO. 4.

NOTE:
PROVIDE ROUGH-IN OF DRAINS & ASSOCIATED VENTS ONLY. FOR FIXTURES LOCATED ON SIXTH FLOOR.

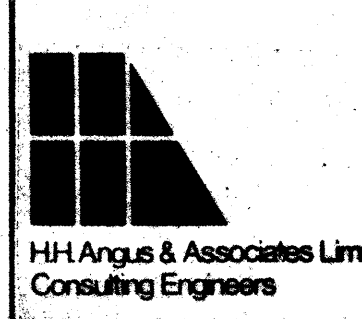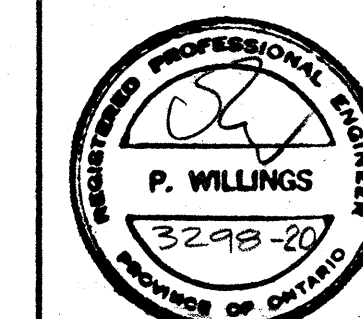

THE CONTRACTOR SHALL CHECK AND VERIFY ALL DIMENSIONS ON THE JOB

REVISIONS			
NO.	DATE	BY	TO

PRINT ISSUE RECORD			
DATE	NO.	TO	DATE


THIS DRAWING HAS BEEN REVISED TO AS BUILT CONDITIONS.
H.H. ANGUS & ASSOC.
DATE: JULY, 87

AS BUILT DRAWING
BY
CONSTRUCT INTERNATIONAL LTD.

PLUMBING

TORONTO WESTERN HOSPITAL
SOUTH ADDITION-CONTRACT NO. 4
399 BATHURST STREET TORONTO ONTARIO
SANITARY STACK RISER
DIAGRAM No. 2
GOVAN KAMINKER KEENE/LEYSIDE WILSON
BLAUENWITTE STEVENSON ARCHITECT
1295 BELLARY RD. N. SCARBOROUGH, ONTARIO, CA

PROJECT NO.
712-4
DRAWING NO.
M-35A
M040

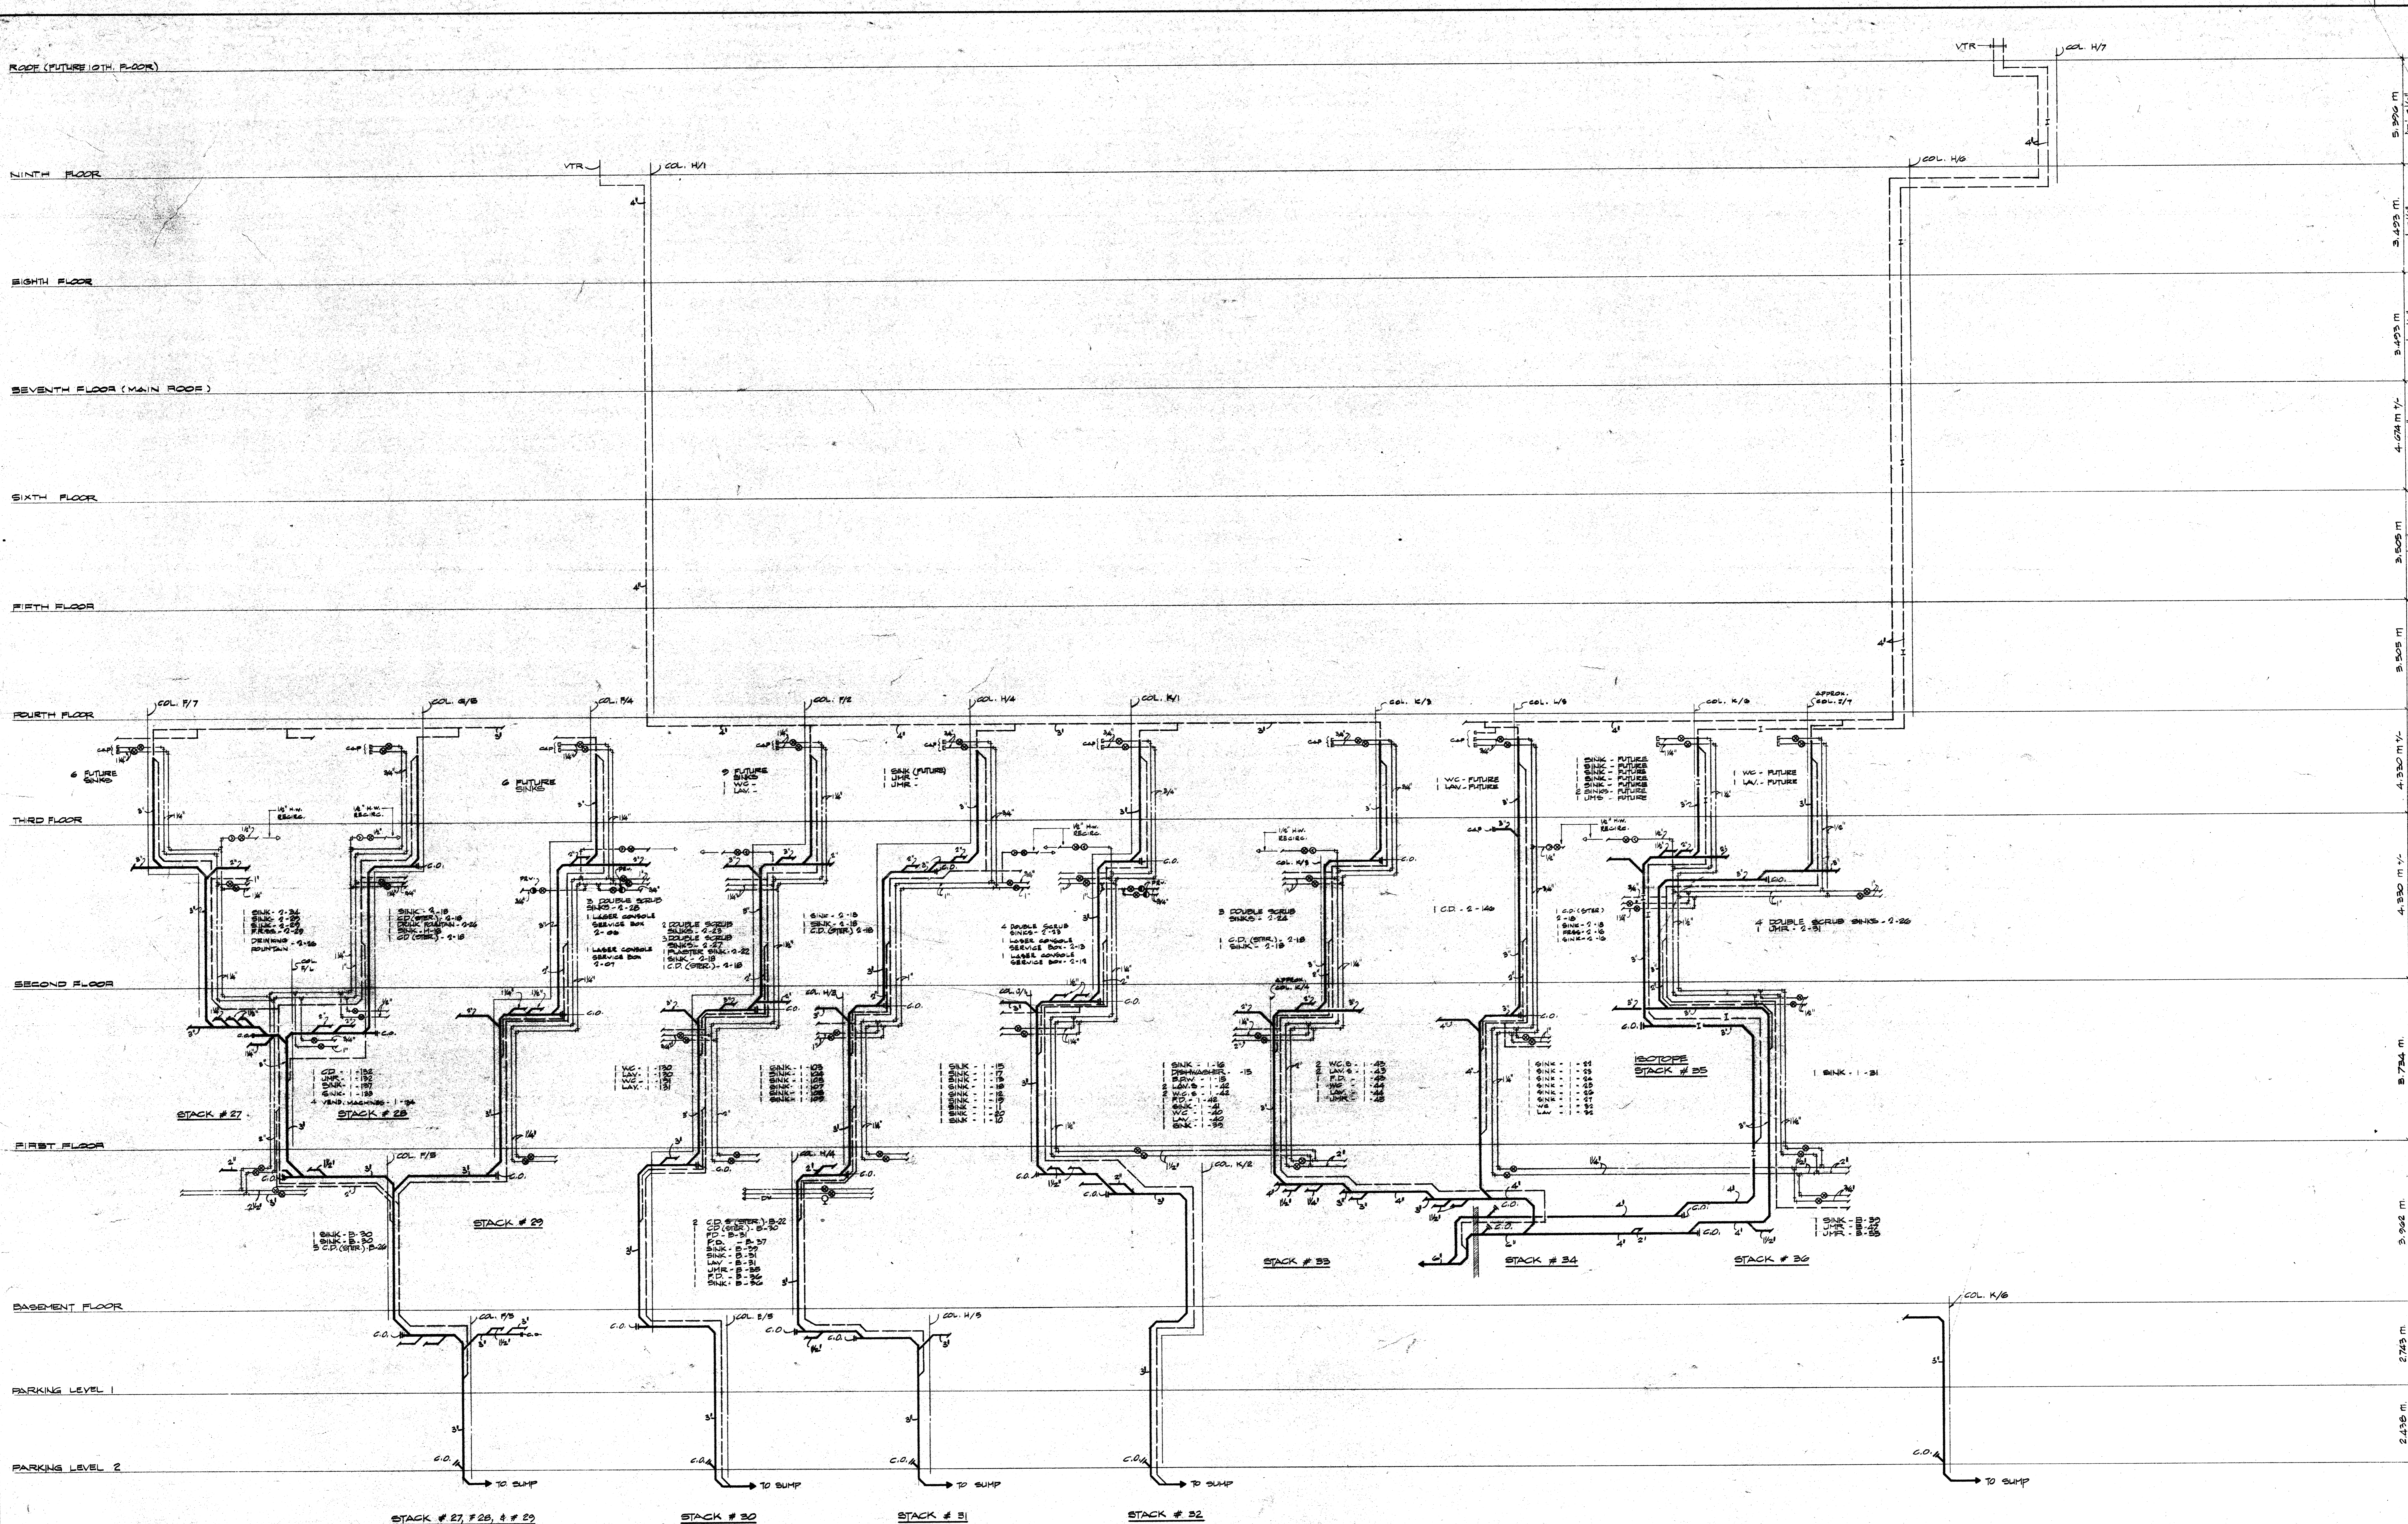

THE CONTRACTOR SHALL CHECK AND VERIFY ALL DIMENSIONS ON THE JOB

REVISIONS	
NO.	DESCRIPTION
1	AS BUILT

PRINT ISSUE RECORD			
DATE	NO.	TO	FROM
APRIL 1984	1	TENDER	

THIS DRAWING HAS BEEN REVISED TO AS BUILT CONDITIONS.
H.H. ANGUS & ASSOC.
DATE: JULY 27


GOVAN KAMINKER KEENLEYSIDE WILSON
SLAUENWHITE STEVENSON ARCHITECTS
1255 BELLAMY RD. N., SCARBOROUGH, ONTARIO, CAN.

AS BUILT DRAWING
BY
CONASTOCK INTERNATIONAL LTD.

PLUMBING

PROJECT NO.	TORONTO WESTERN HOSPITAL SOUTH ADDITION-CONTRACT NO. 3
DRAWING NO.	SANITARY STACK RISER DIAGRAM No. 3
DATE	MAR / 84
CHECKED BY	J.W.

712-3
M-36

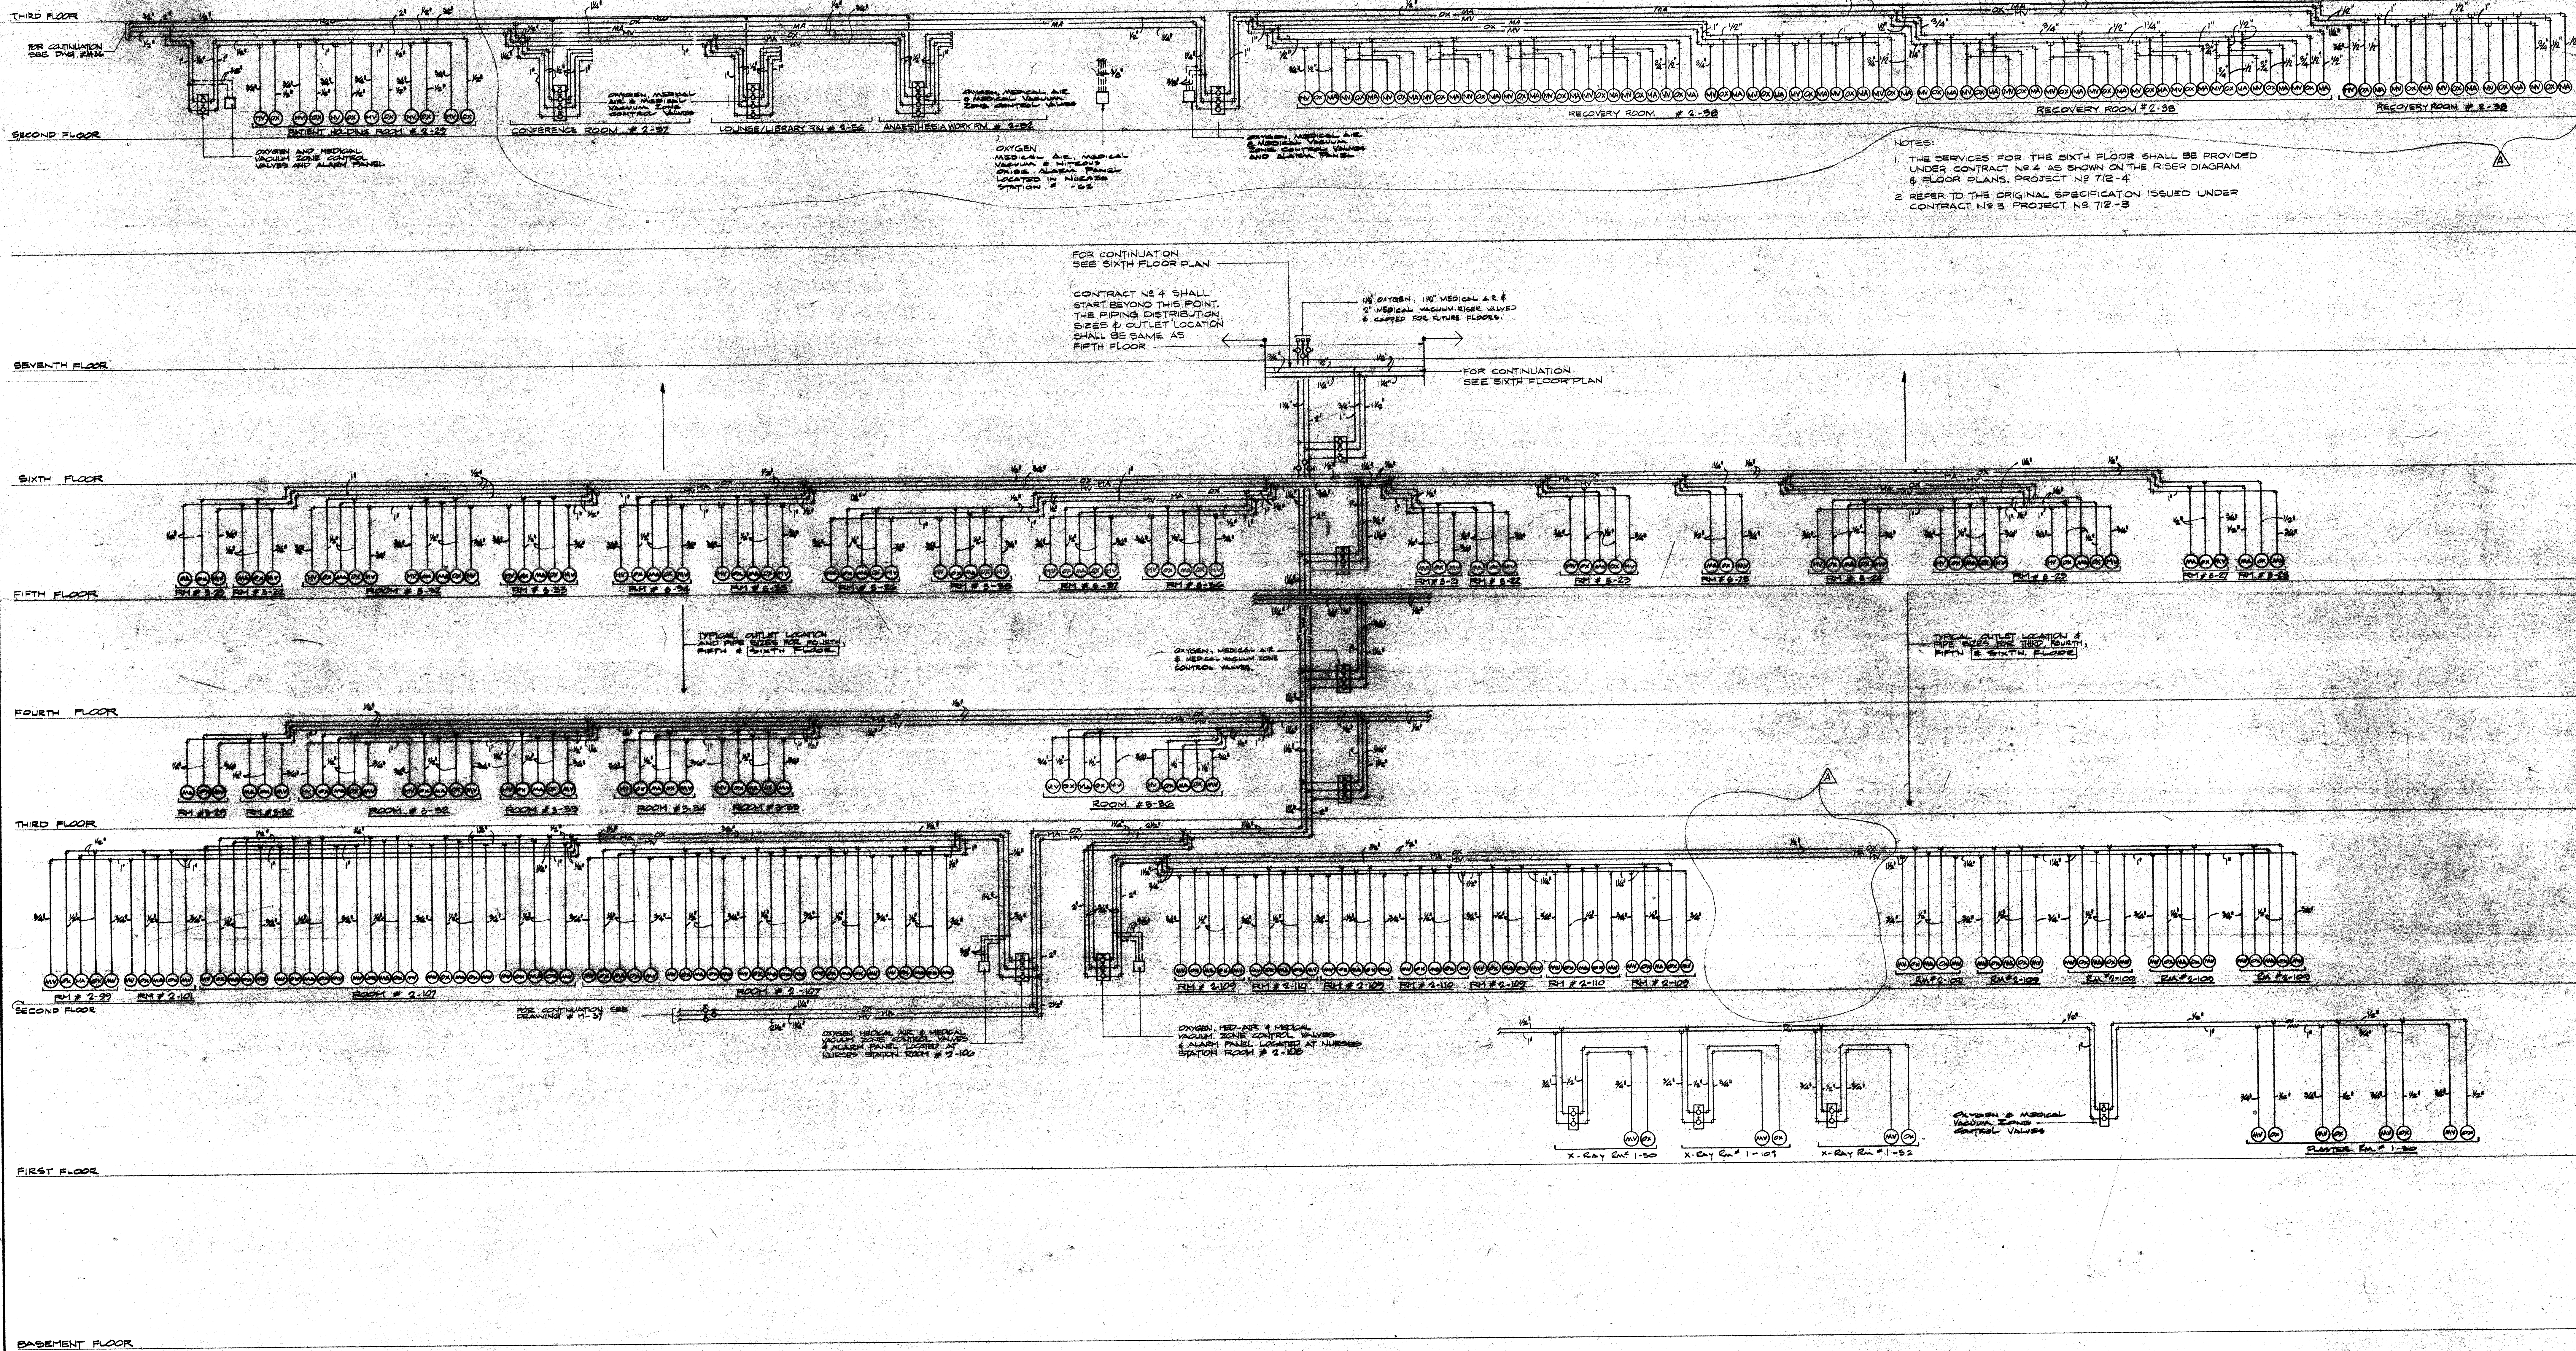


AS-BUILT DRAWING
BY
COMSTOCK INTERNATIONAL LTD.


PLUMBING		TORONTO WESTERN HOSPITAL SOUTH ADDITION-CONTRACT NO. 4		PROJECT NO.
DATE	JULY, 1984	299 BATHURST STREET	TORONTO, ONTARIO	712-4
DRAWN BY	S.I.	MEDICAL GAS RISER		DRAWING NO.
CHECKED BY	J.W.	DIAGRAM No. 2		M-38A
Govan Kammer, Keenleyside Wilson SLAUGHTERWHITE STEVENSON ARCHITECTS 1296 BELLAMY RD. N. SCARBOROUGH, ONTARIO, CAN.		M043		

THIS DRAWING HAS
BEEN REVISED TO
AS BUILT CONDITIONS.
H.H. ANGUS & ASSOC.
DATE: JULY, 87

REVISIONS			PRINT ISSUE RECORD		
NO.	DATE	DESCRIPTION	DATE	NO.	TO
1	JULY 1984	REV. TO SUTARCH REV.			

THE CONTRACTOR SHALL CHECK AND VERIFY ALL DIMENSIONS ON THE JOB

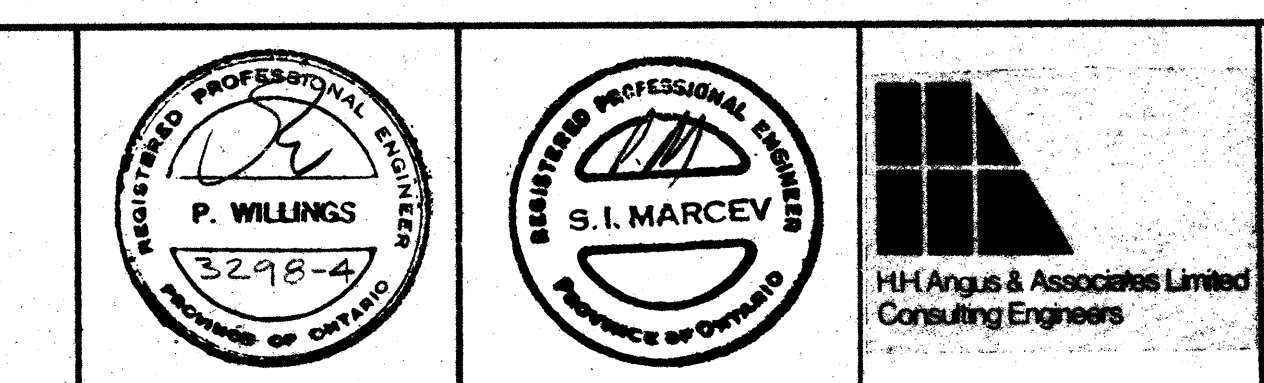

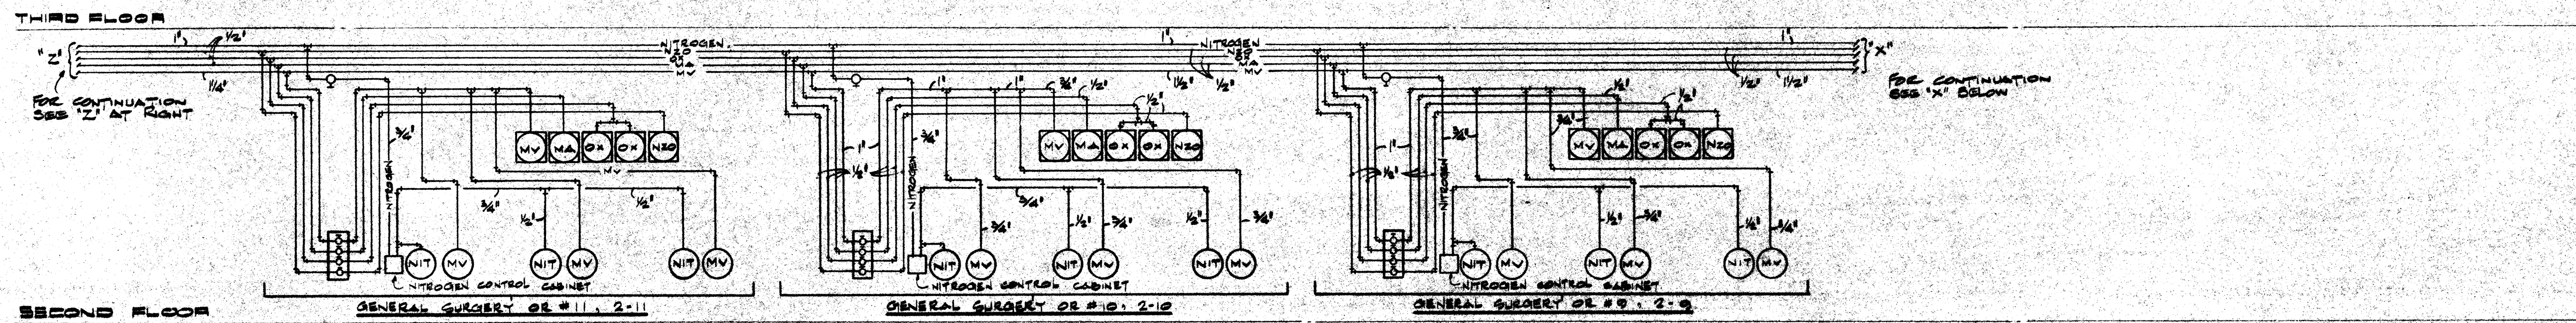

MEDICAL GAS LEGEND

- DENOTES WALL MOUNTED MEDICAL GAS OUTLET
- DENOTES GAS OUTLET MOUNTED IN CEILING COLUMN
- BALL VALVE
- ZONE CONTROL VALVE & BOX
- OXYGEN LINE
- MEDICAL AIR LINE
- MEDICAL VACUUM LINE
- NITROGEN LINE
- NITROGEN LINE

MEDICAL GAS BALL VALVES

- 1/2" - 211251
- 3/4" - 211252
- 1" - 211253
- 1 1/2" - 211254
- 2" - 211255
- 2 1/2" - 211256
- 3" - 211257
- 4" - 211258

MEDICAL GAS VALVES SHALL BE FUJITA-BENNETT

MEDICAL GAS ZONE CONTROL VALVES & BOXES

- 1/2" - 1/2" : 140250
- 1/2" - 3/4" : 140251
- 1/2" - 1" : 140252
- 3/4" - 3/4" : 140253
- 3/4" - 1" : 140254
- 1/2" ONLY : 140251
- 3/4" ONLY : 140252
- 1" ONLY : 140253
- 1 1/2" ONLY : 140254
- 2" ONLY : 140255
- 3" ONLY : 140256

MEDICAL GAS VALVE BOXES SHALL BE FUJITA-BENNETT

MEDICAL GAS OUTLETS - WALL MOUNTED

PATIENT ROOMS
WALL MOUNTED 5 GANG D.I.S. OUTLETS IN PEDS FROM LEFT TO RIGHT - MEDICAL VACUUM, OXYGEN, MEDICAL AIR, MEDICAL VACUUM. SHALL BE FUJITA-BENNETT NO. 125104

OPERATING ROOMS
WALL MOUNTED 5 GANG D.I.S. OUTLETS IN PEDS FROM LEFT TO RIGHT - MEDICAL VACUUM, OXYGEN, MEDICAL AIR, MEDICAL VACUUM. SHALL BE FUJITA-BENNETT NO. 125104

ONLY CASES, PATIENT ROOMS
WALL MOUNTED 2 GANG D.I.S. OUTLETS IN PEDS FROM LEFT TO RIGHT - MEDICAL VACUUM, OXYGEN. SHALL BE FUJITA-BENNETT NO. 125104

RECOVERY ROOM
WALL MOUNTED 5 GANG D.I.S. OUTLETS IN PEDS FROM LEFT TO RIGHT - MEDICAL VACUUM, OXYGEN, MED. AIR, MED. VACUUM. SHALL BE FUJITA-BENNETT NO. 125104

OPERATING ROOM
WALL MOUNTED 2 GANG D.I.S. OUTLETS IN PEDS FROM LEFT TO RIGHT - NITROGEN, MEDICAL VACUUM. SHALL BE FUJITA-BENNETT NO. 125105 (PROVIDE COMMON BUSHED STAINLESS STEEL COVER PLATE)

NOTES:
1. ALL WALL MOUNTED OUTLETS SHALL BE LOCATED ON 4 1/2" CENTERS.
2. NO OUTLET SUPPORTS SHALL BE FASTENED DIRECTLY TO WALL.




MEDICAL GAS OUTLETS - CEILING MOUNTED

ALL OUTLETS SHALL BE FUJITA-BENNETT D.I.S. TYPE, OXYGEN NO. 125100, MEDICAL VACUUM NO. 125101, MEDICAL AIR NO. 125102, NITROGEN NO. 125103 & NITROGEN NO. 125104.

NOTES:
1. DIVISION 1600 CONTRACTOR SHALL PURCHASE OUTLETS THEN TURN THEM OVER TO DIVISION 1600 CONTRACTOR FOR INSTALLATION BY MANUFACTURER'S REPRESENTATIVE.

NITROGEN CONTROL CABINET
NITROGEN CONTROL CABINET SHALL BE FUJITA-BENNETT PART NUMBER 130201 7/8 D.I.S. NITROGEN OUTLET

COVERPLATE INSETS
PROVIDE A COVERPLATE INSET FOR EACH MEDICAL GAS OUTLET WHOSE COVERPLATE IS PROVIDED BY FUJITA-BENNETT DIVISION 1600, OXYGEN PART NO. 435105, NITROGEN PART NO. 435101, MEDICAL AIR PART NO. 435102, MEDICAL VACUUM PART NO. 435206. COORDINATE FULLY WITH DIV. 1600.

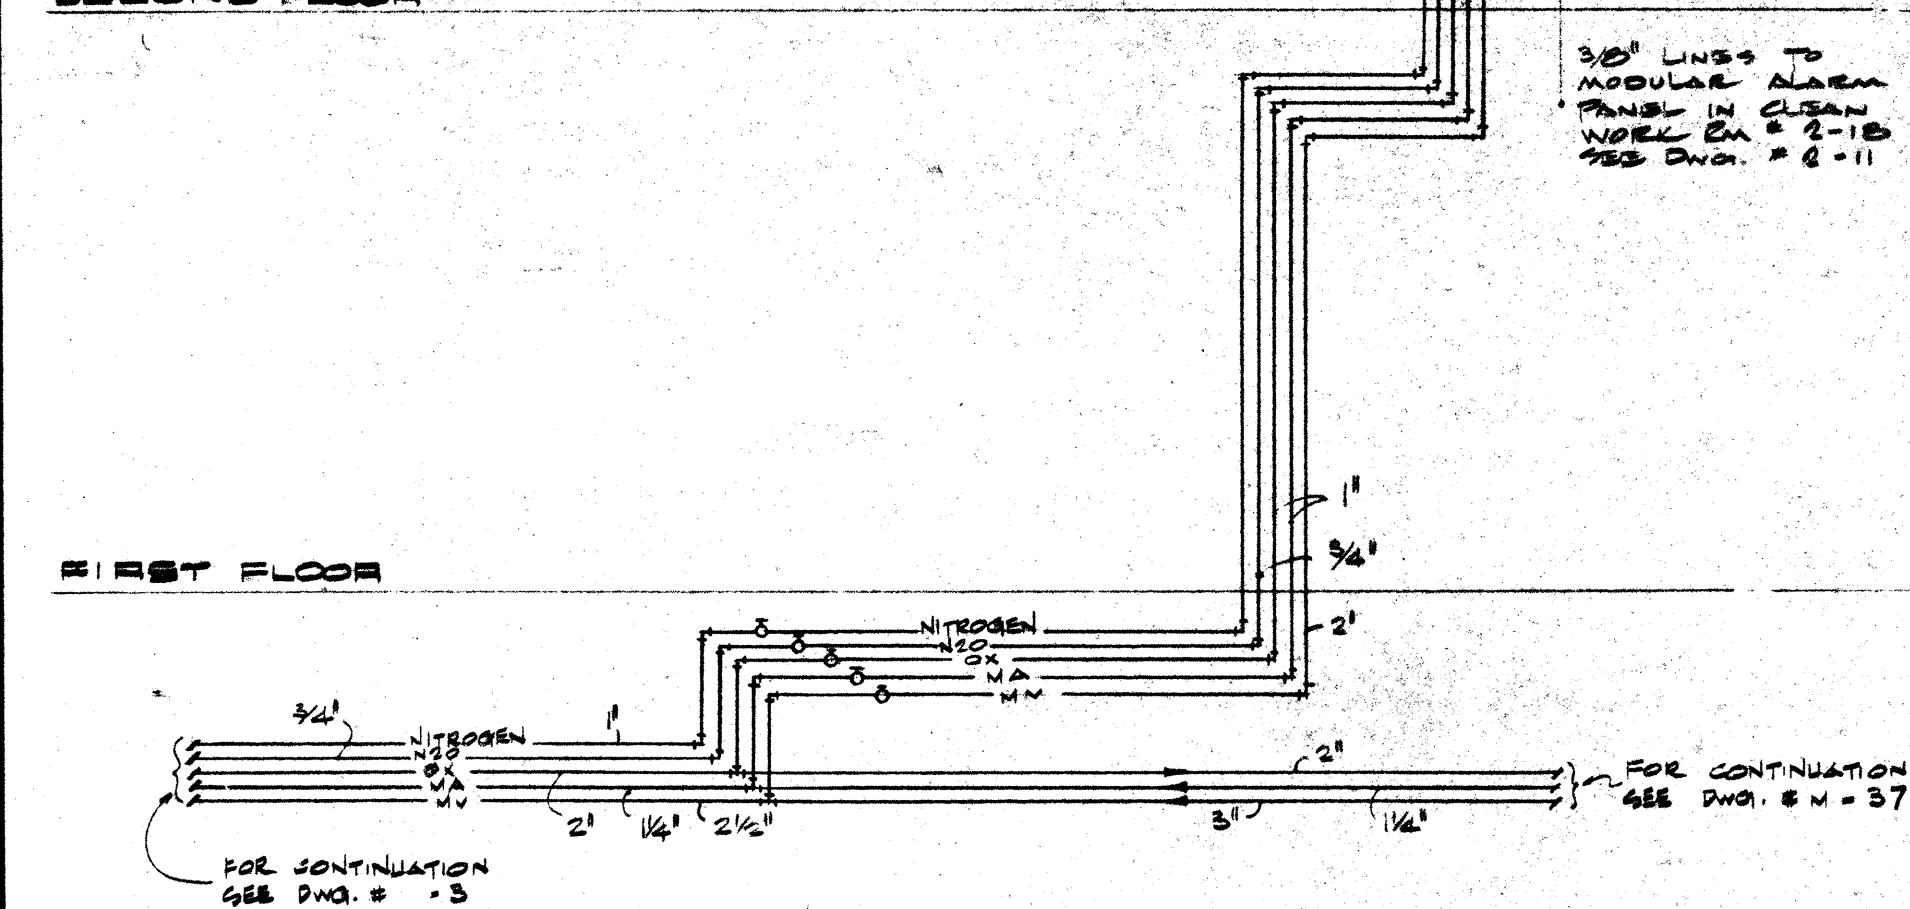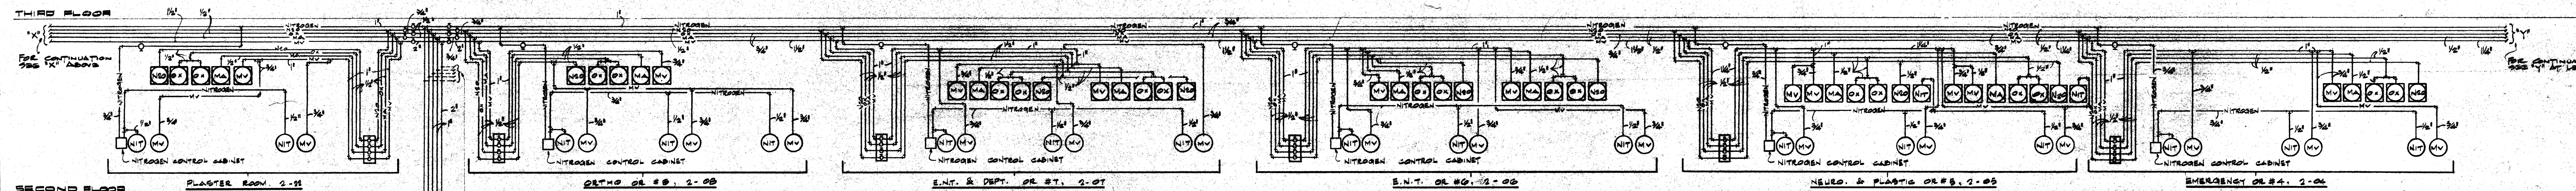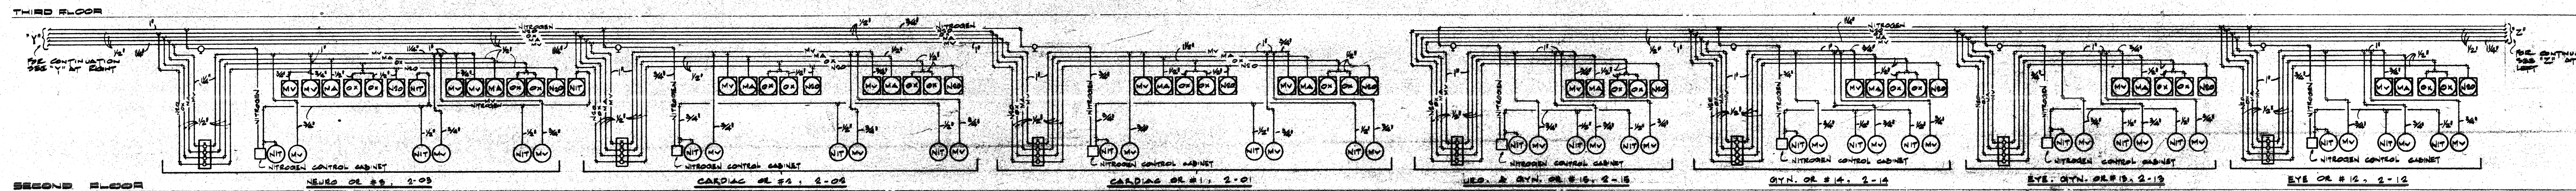

AS BUILT DRAWING
BY
CONSTRUX INTERNATIONAL LTD.

PLUMBING

TORONTO WESTERN HOSPITAL
SOUTH ADDITION-CONTRACT NO. 3
399 BATHURST STREET TORONTO ONTARIO

MEDICAL GAS RISER
DIAGRAM No. 3

GOVAN KAMNICKER KEENEYSIDE WIL
SLAUGHTER STEVENSON ARCHIT. M044

1200 BELLAMY RD. N. SCARBOROUGH ONTARIO

THE CONTRACTOR SHALL CHECK AND VERIFY ALL DIMENSIONS ON THE JOB



REVISIONS



NO.	DATE	TO	DATE	NO.	TO
1	APRIL 1984	TENDER			

PRINT ISSUE RECORD


DATE	NO.	TO	DATE	NO.	TO

THIS DRAWING HAS
BEEN REVISED TO
AS BUILT CONDITIONS.
H.H. ANGUS & ASSOC.
DATE: JULY, 87

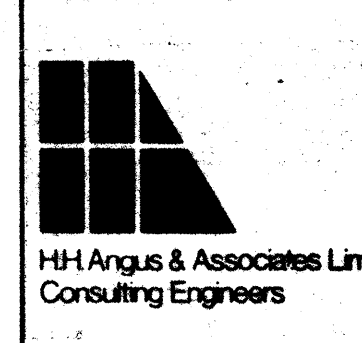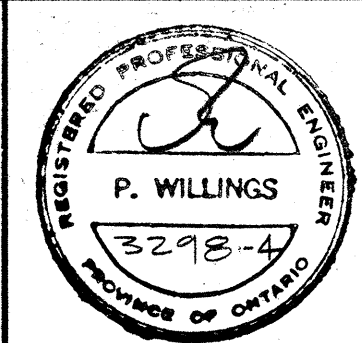


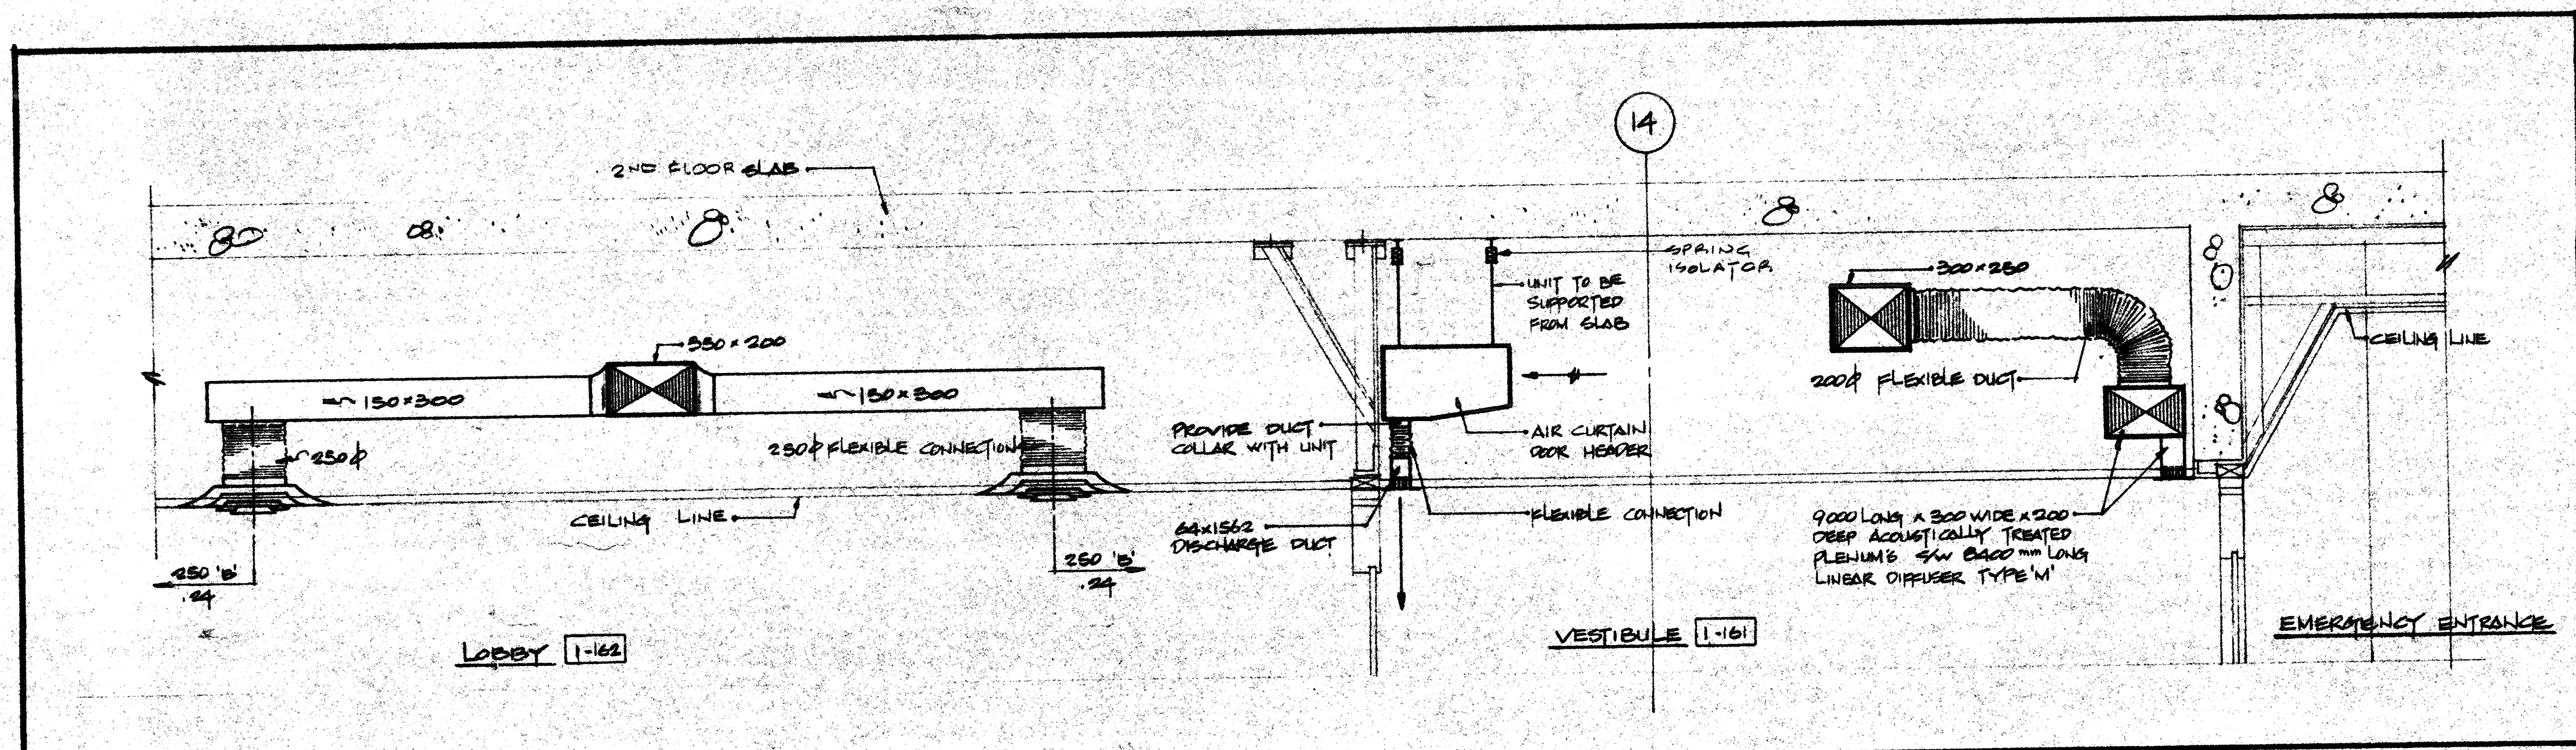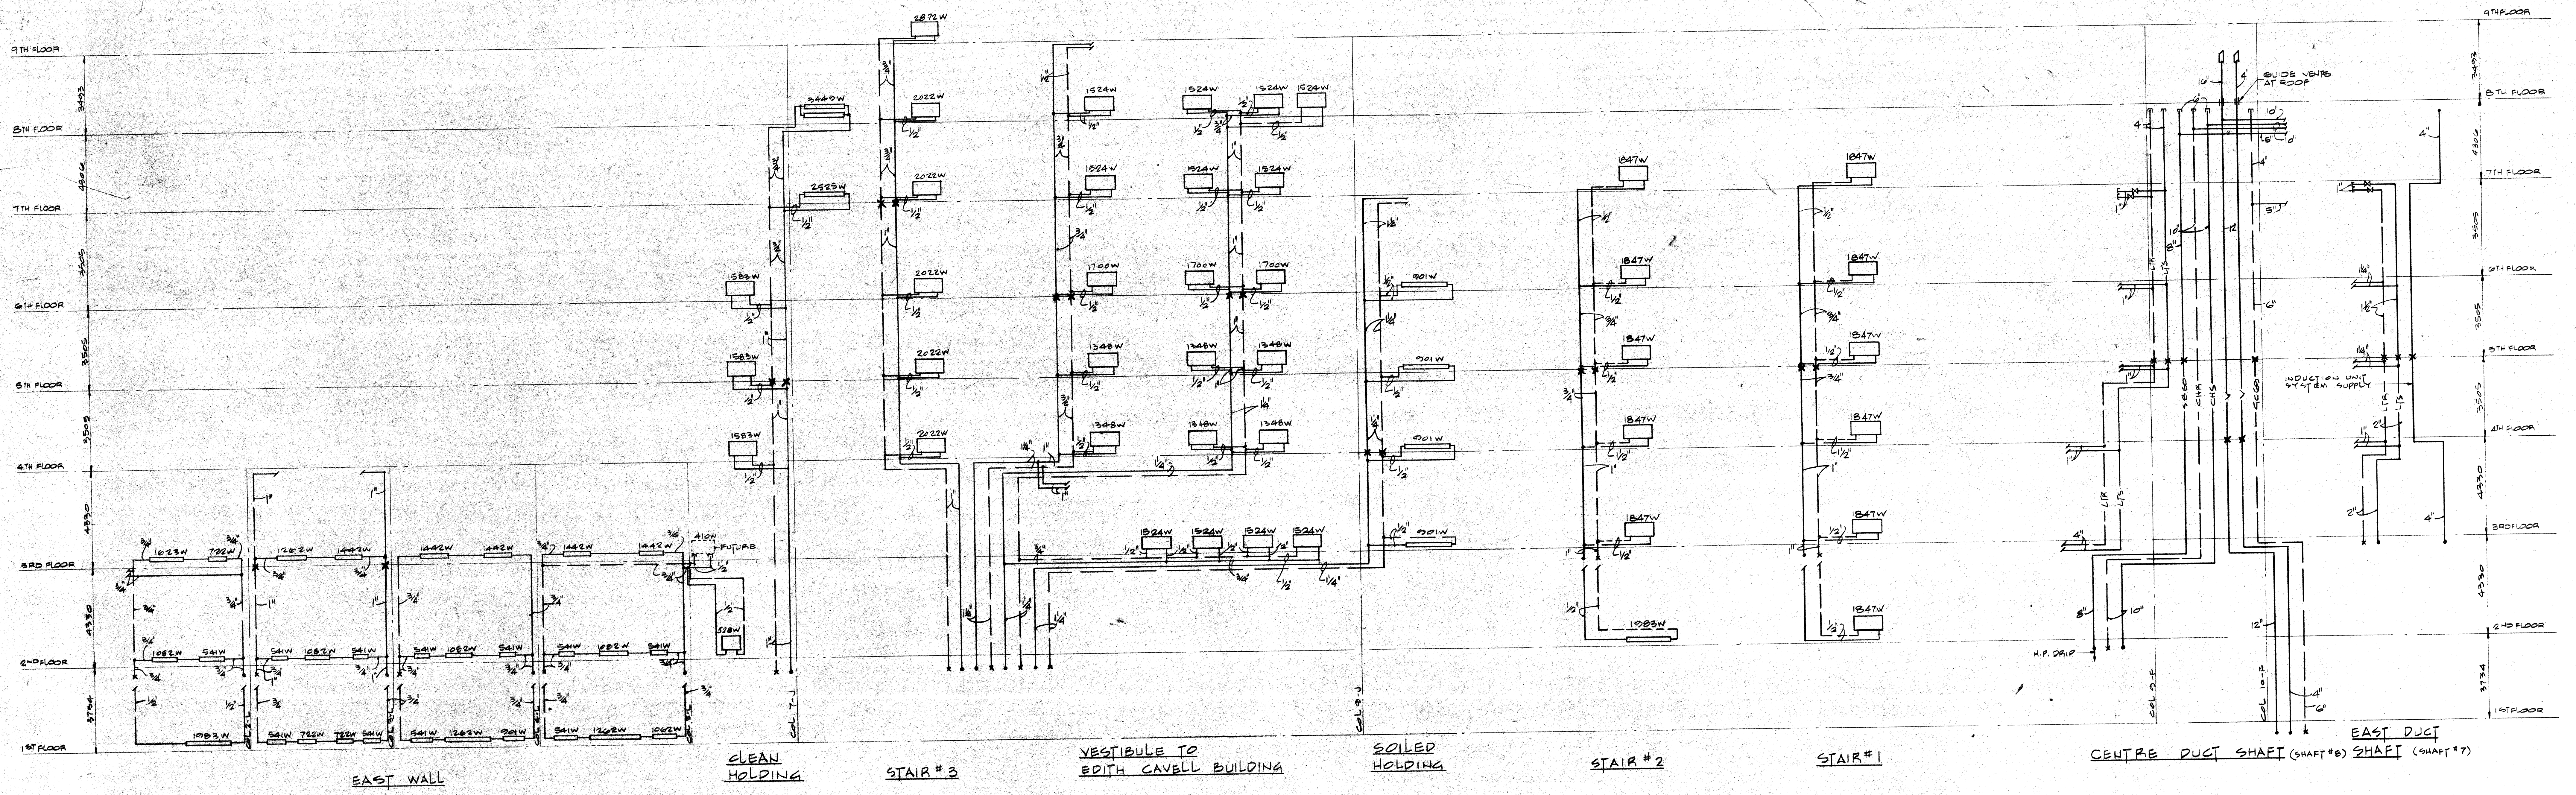

1-40 SECTION THROUGH EMERGENCY ENTRANCE 1:20

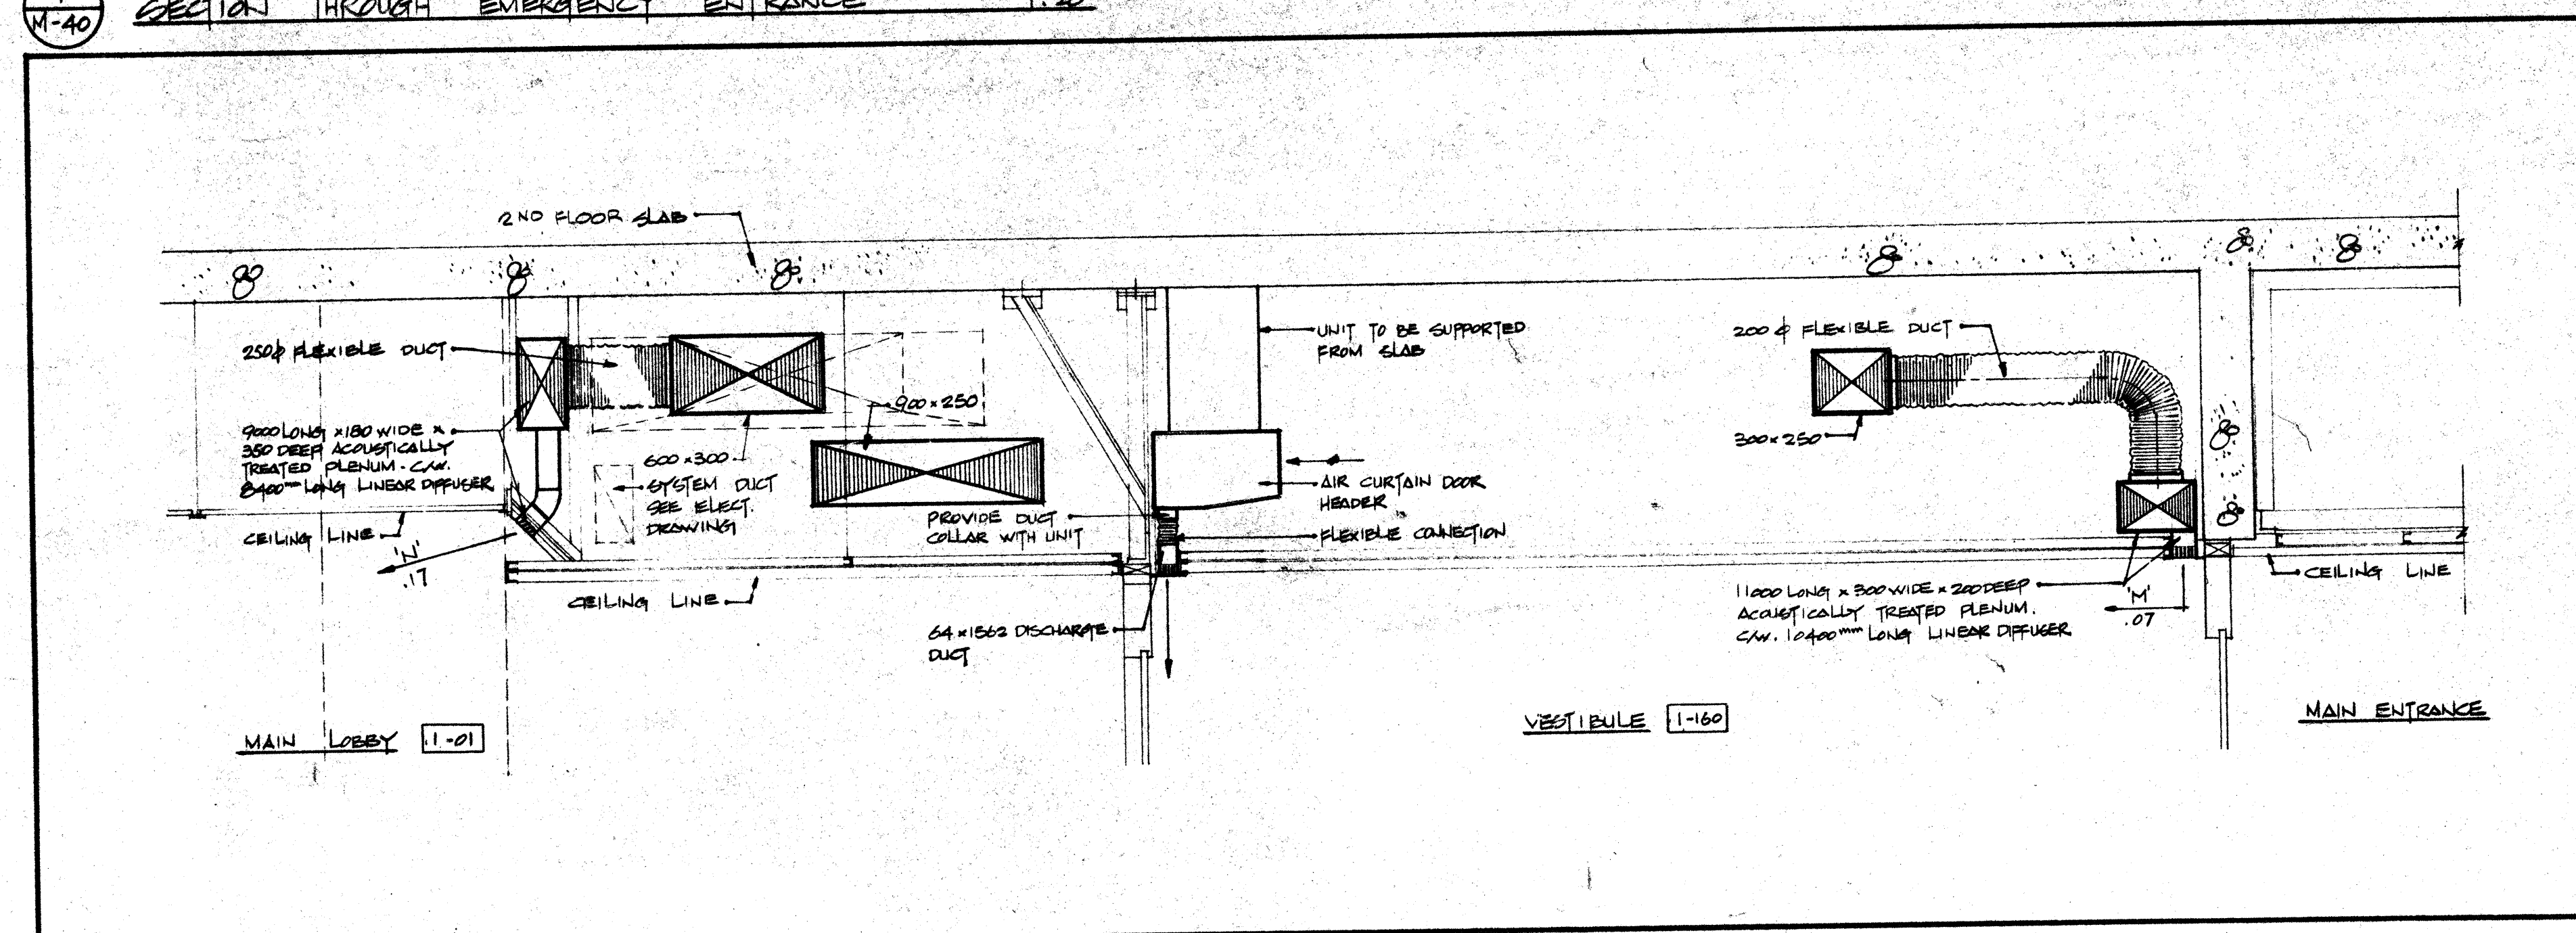

2-40 SECTION THROUGH MAIN ENTRANCE 1:20

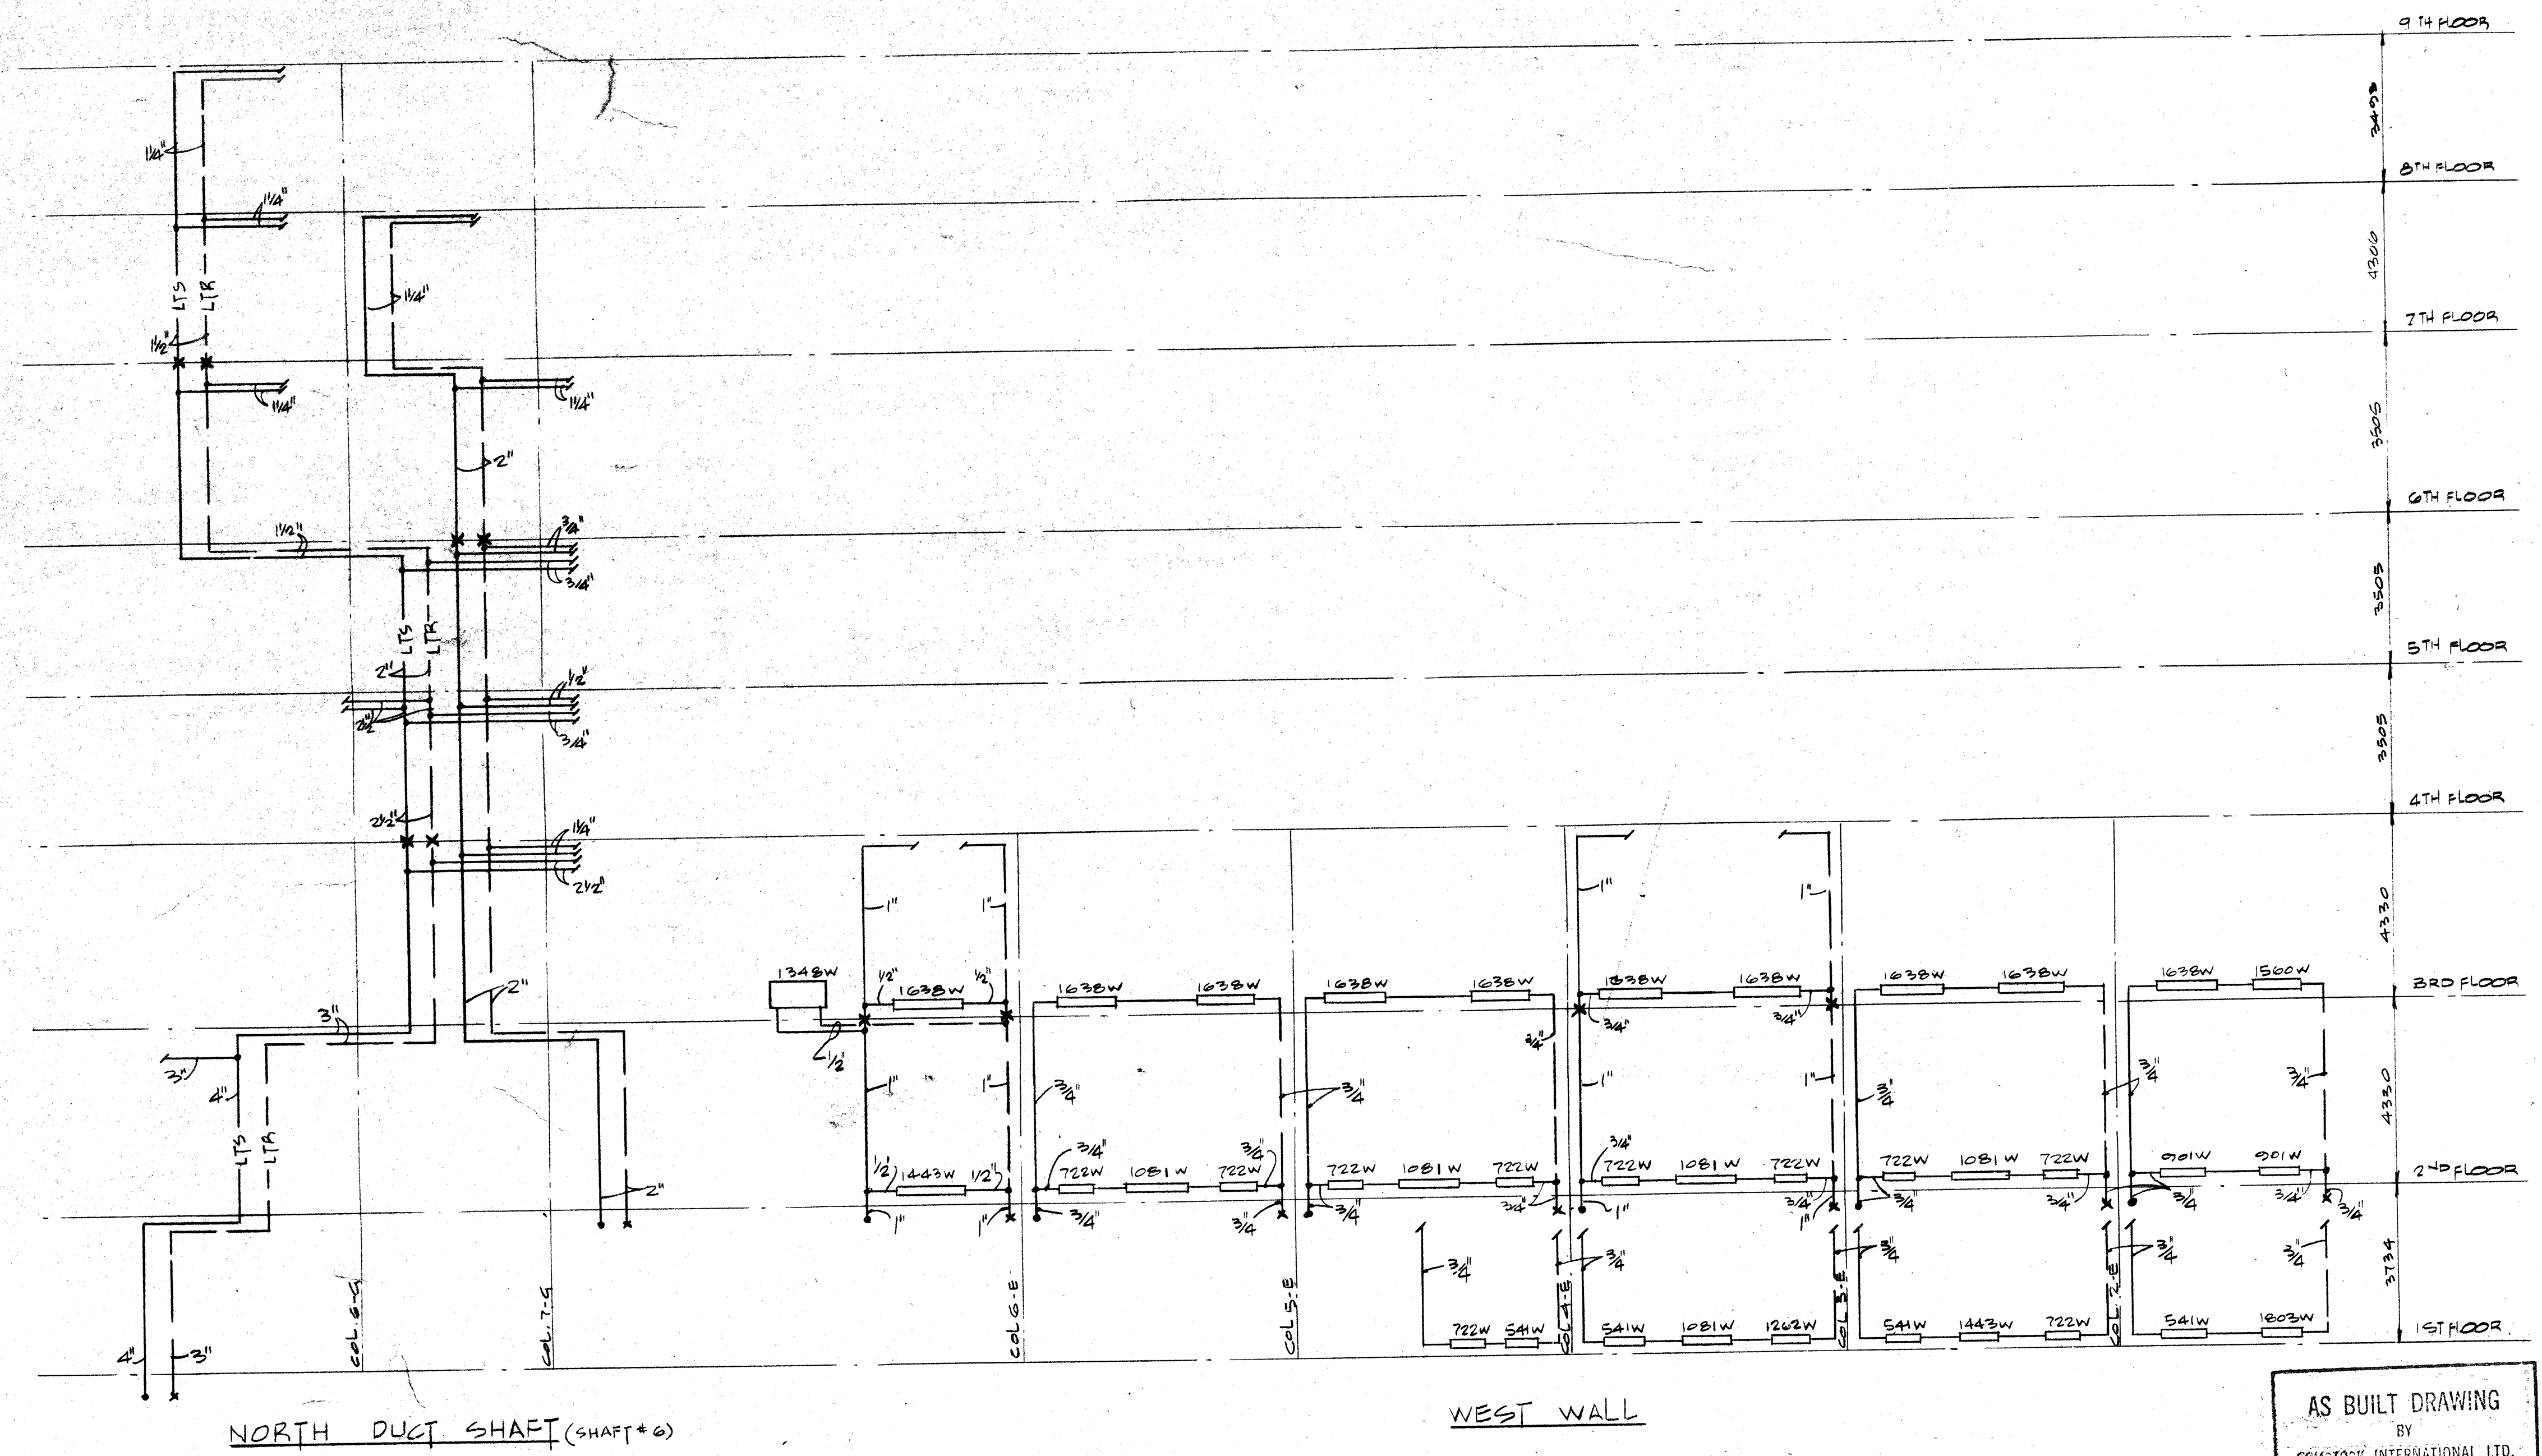

NORTH DUCT SHAFT (SHAFT #6)

WEST WALL

THE CONTRACTOR SHALL CHECK AND VERIFY ALL DIMENSIONS ON THE JOB

REVISIONS	
NO.	DESCRIPTION

PRINT ISSUE RECORD					
DATE	NO.	TO	DATE	NO.	TO

THIS DRAWING HAS BEEN REVISED TO AS BUILT CONDITIONS.
DATE: JULY, 87

AS BUILT DRAWING
 BY
 COM-TACK INTERNATIONAL LTD.


HEATING
 TORONTO WESTERN HOSPITAL
 399 BATHURST STREET TORONTO ONTARIO
 HEATING RISER
 DIAGRAMS & DETAILS
 GOVAN KAMINKER KEENEYSIDE WILSON
 SLAUGHTER STEVENSON ARCHITECTS
 1285 BELLAMY RD. N. SCARBOROUGH ONTARIO, CAN.

PROJECT NO. 712-3
 DRAWING NO. M-40
 M045

P. WILLINGS
 2296-4
 PROFESSIONAL ENGINEER
 PROVINCE OF ONTARIO

S.I. MARCEV
 2296-4
 PROFESSIONAL ENGINEER
 PROVINCE OF ONTARIO


H.H. Angus & Associates Limited
 Consulting Engineers

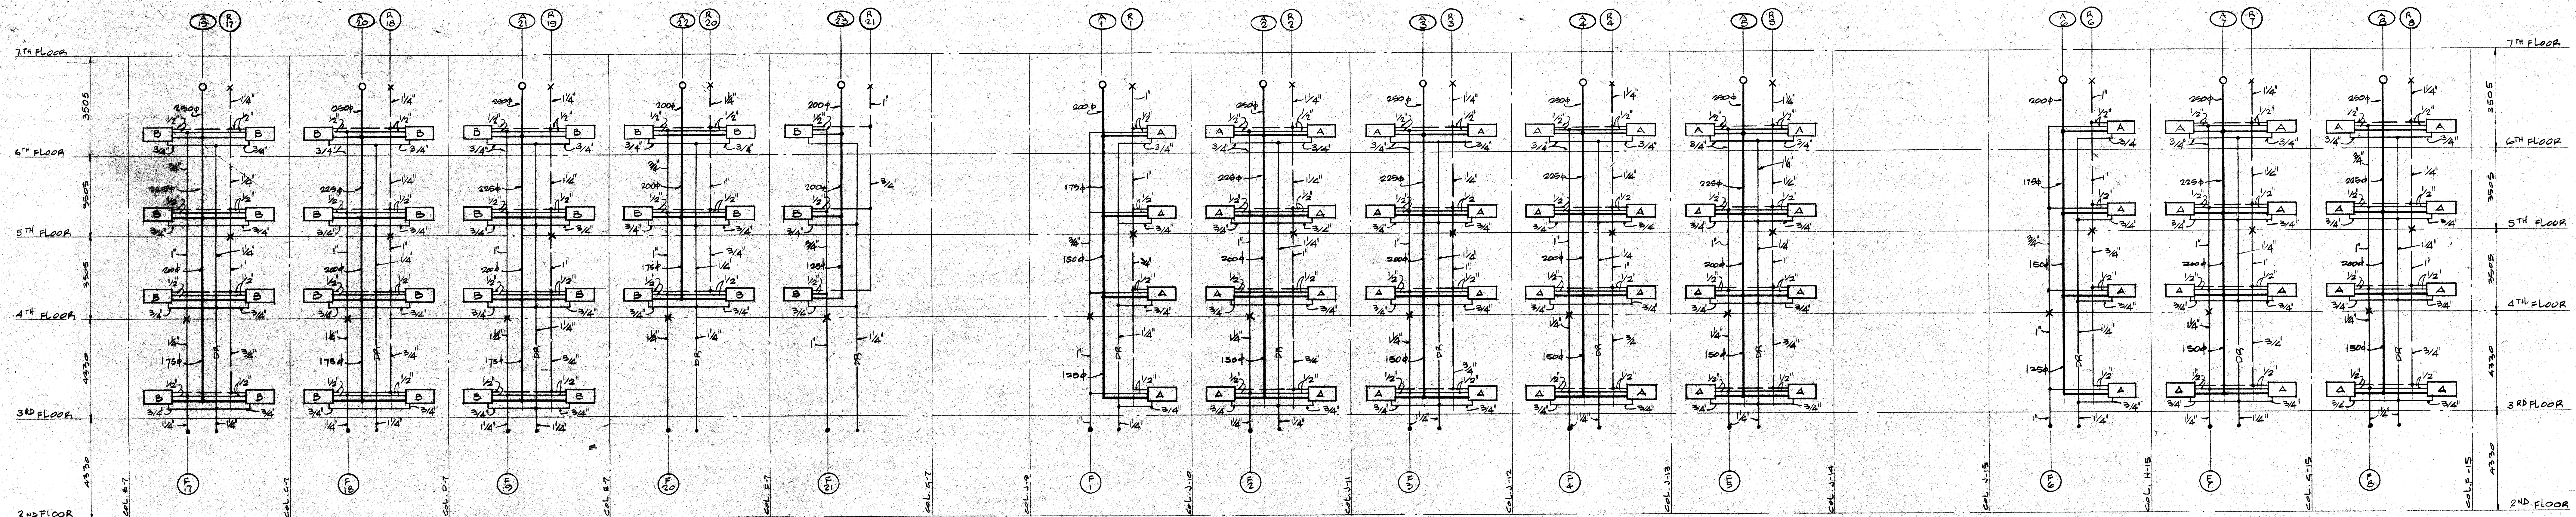

NORTH EXPOSURE

EAST EXPOSURE

SOUTH EXPOSURE

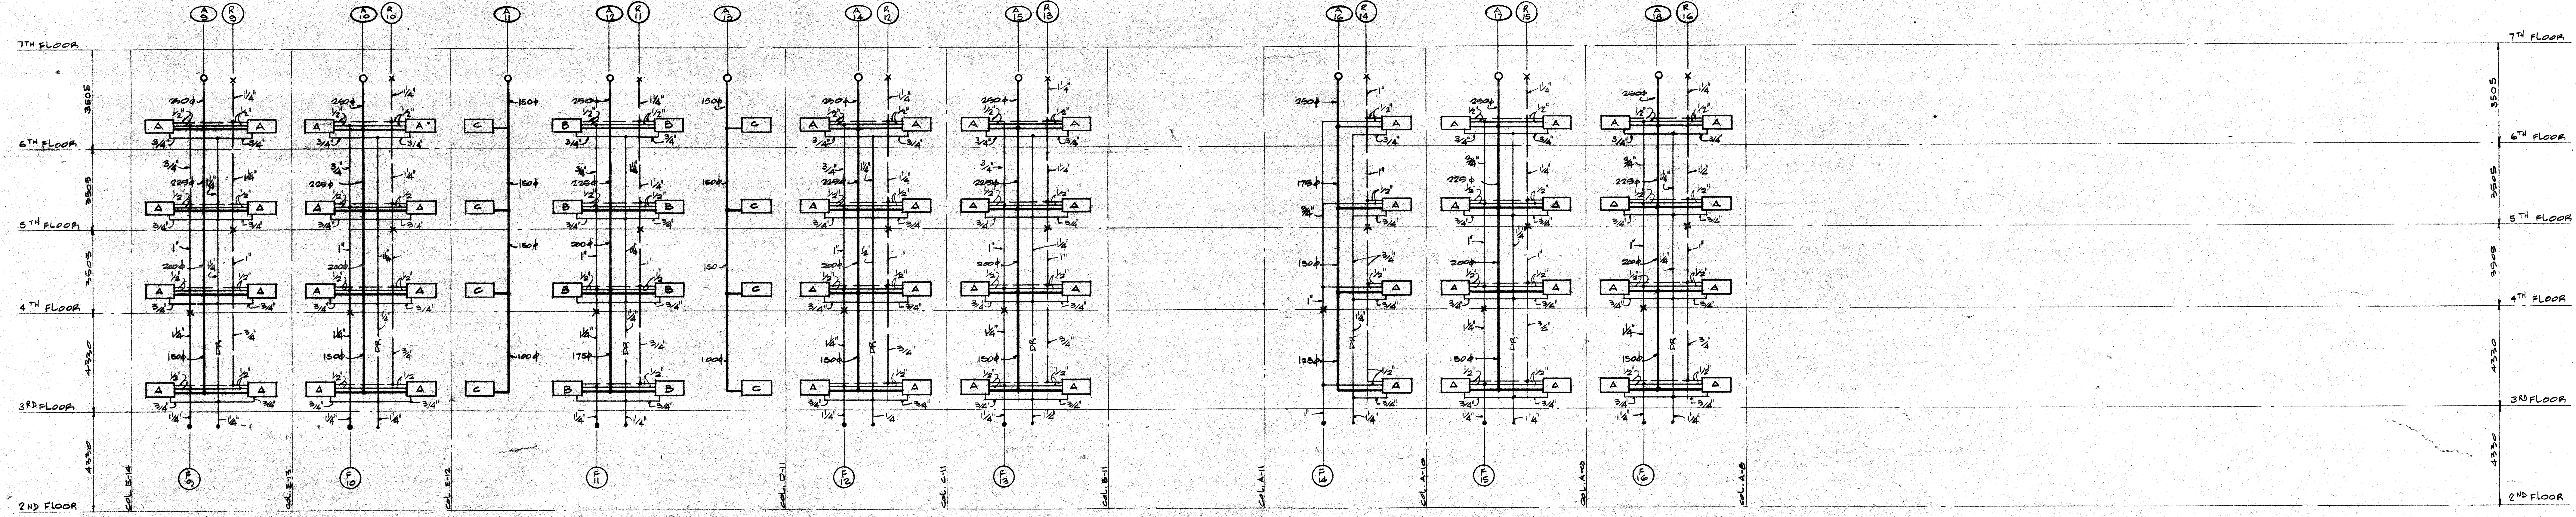

WEST EXPOSURE

SOUTH-WEST EXPOSURE

SOUTH EXPOSURE

WEST EXPOSURE




AS BUILT DRAWING
COMSTOCK INTERNATIONAL LTD.


HEATING AND VENTILATION
TORONTO WESTERN HOSPITAL
SOUTH ADDITION-CONTRACT NO. 3
369 BATHURST STREET TORONTO ONTARIO
INDUCTION UNIT
RISER DIAGRAM
GOVAN KAMINKER KEENEYSIDE WILSON
SLAUENWHITE STEVENSON ARCHITECT
1295 BELLAMY RD. N. SCARBOROUGH, ONTARIO, CAN. M046

THIS DRAWING HAS
BEEN REVISED TO
AS BUILT CONDITIONS.
H.H. ANGUS & ASSOC.
DATE: JULY, 87


REVISIONS				PRINT ISSUE RECORD			
NO.	DATE	DESCRIPTION	BY	NO.	DATE	DESCRIPTION	BY
1	APRIL 1984	ISSUED FOR TENDER		1			

THE CONTRACTOR SHALL CHECK AND VERIFY ALL DIMENSIONS ON THE JOB

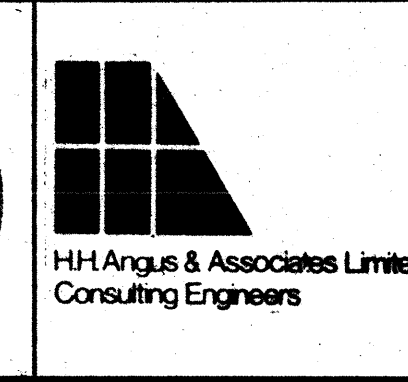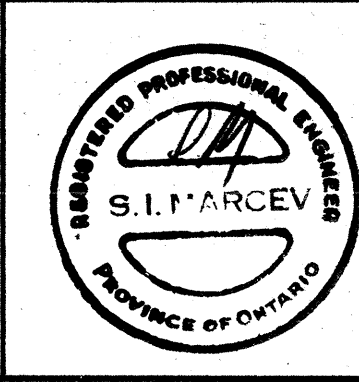
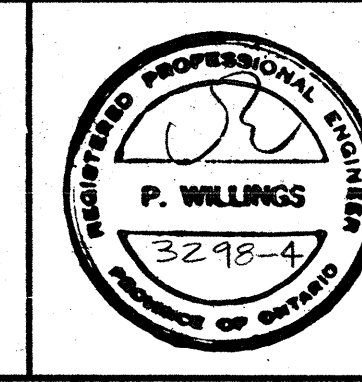


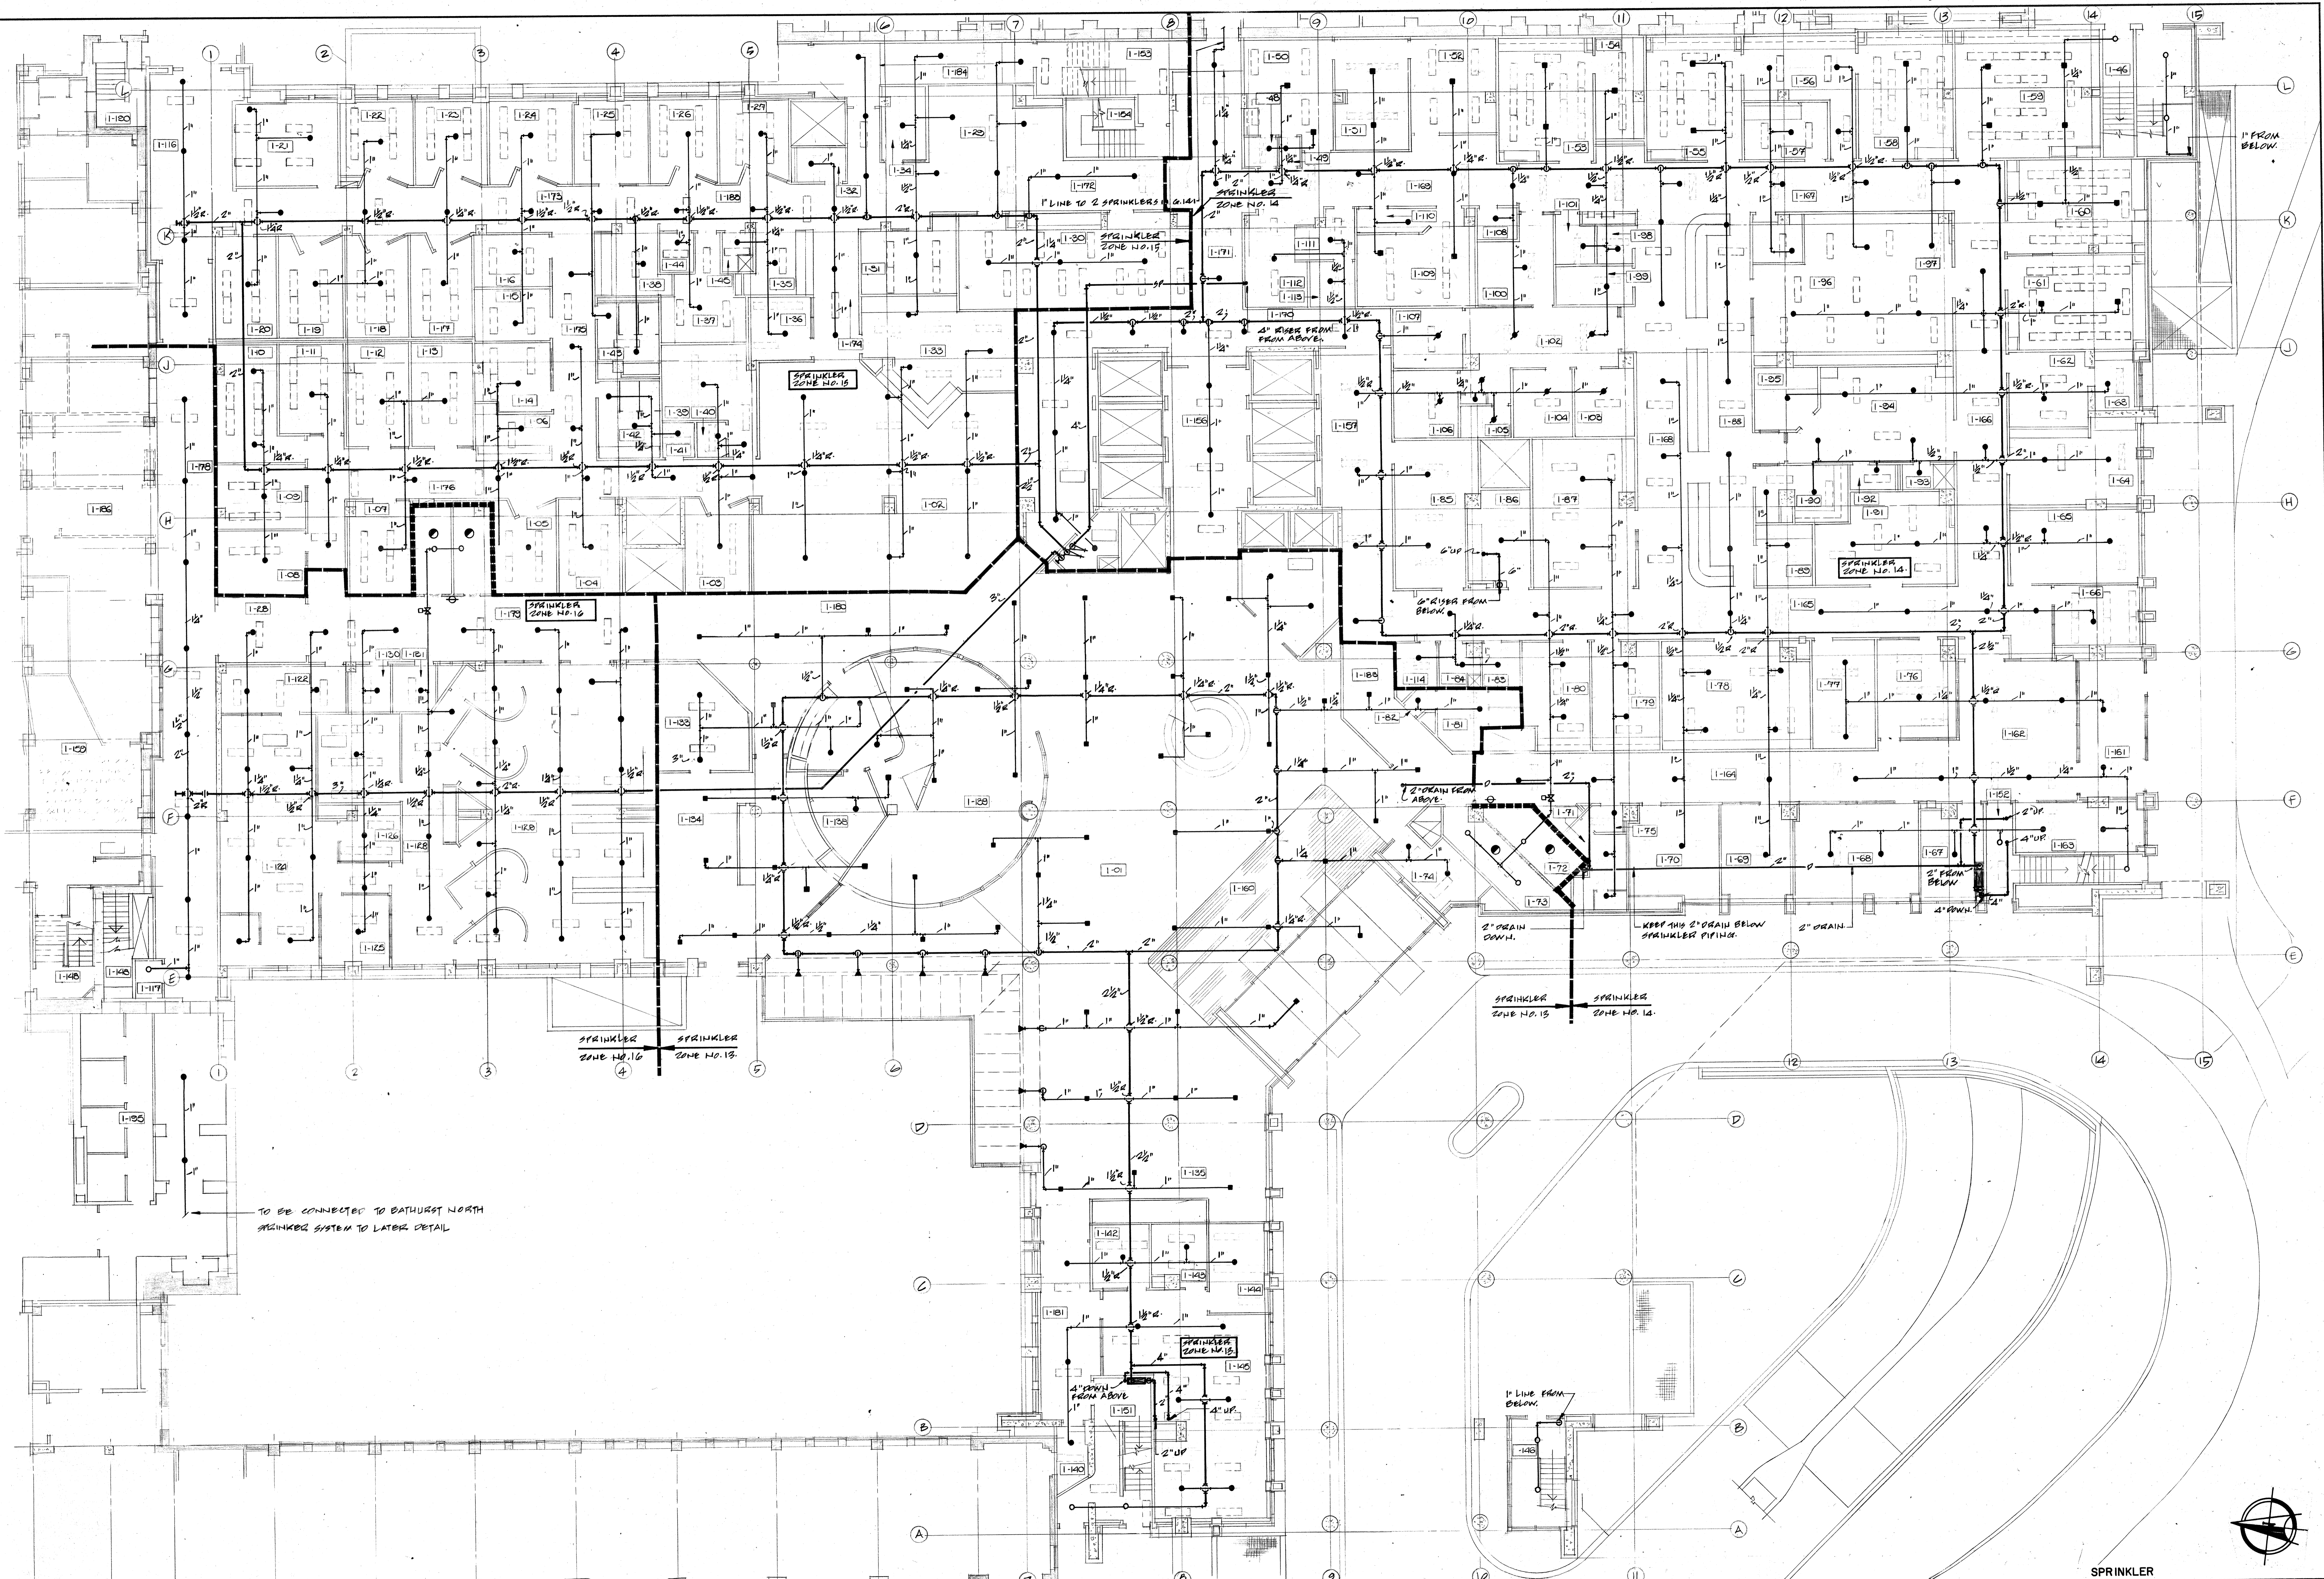


TO BE CONNECTED TO BATHURST NORTH
SPRINKLER SYSTEM TO LATER DETAIL

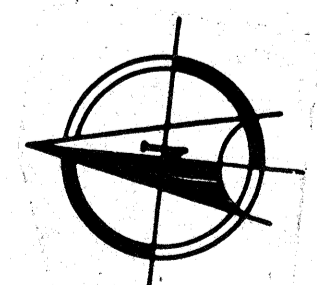

 	THE CONTRACTOR SHALL CHECK AND VERIFY ALL DIMENSIONS ON THE JOB	REVISIONS 1. CORRECTED TO CORRECT 2. CORRECTED TO CORRECT 3. CORRECTED TO CORRECT	PRINT ISSUE RECORD <table border="1" style="width: 100%; border-collapse: collapse;"> <tr> <th>DATE</th> <th>NO.</th> <th>TO</th> <th>DATE</th> <th>NO.</th> <th>TO</th> </tr> <tr> <td>APR 1/84</td> <td>1</td> <td>TENDER</td> <td></td> <td></td> <td></td> </tr> </table>			DATE	NO.	TO	DATE	NO.	TO	APR 1/84	1	TENDER				SCALE 1/8" = 1'-0" DATE MAR. 1/84 DRAWN BY D.B. CHECKED BY P.J.	TORONTO WESTERN HOSPITAL SOUTH ADDITION-CONTRACT NO. 3 399 BATHURST STREET TORONTO, ONTARIO FIRST FLOOR PLAN (PREVIOUSLY GROUND FLOOR PLAN) GOVAN KAMINKER KEENEYSIDE WILSON SLAUENWHITE STEVENSON ARCHITECT 1295 BELLAMY RD. N., SCARBOROUGH, ONTARIO, CAN.	PROJECT NO. 712-3 DRAWING NO. SP-4 M003
		DATE	NO.	TO	DATE	NO.	TO													
APR 1/84	1	TENDER																		

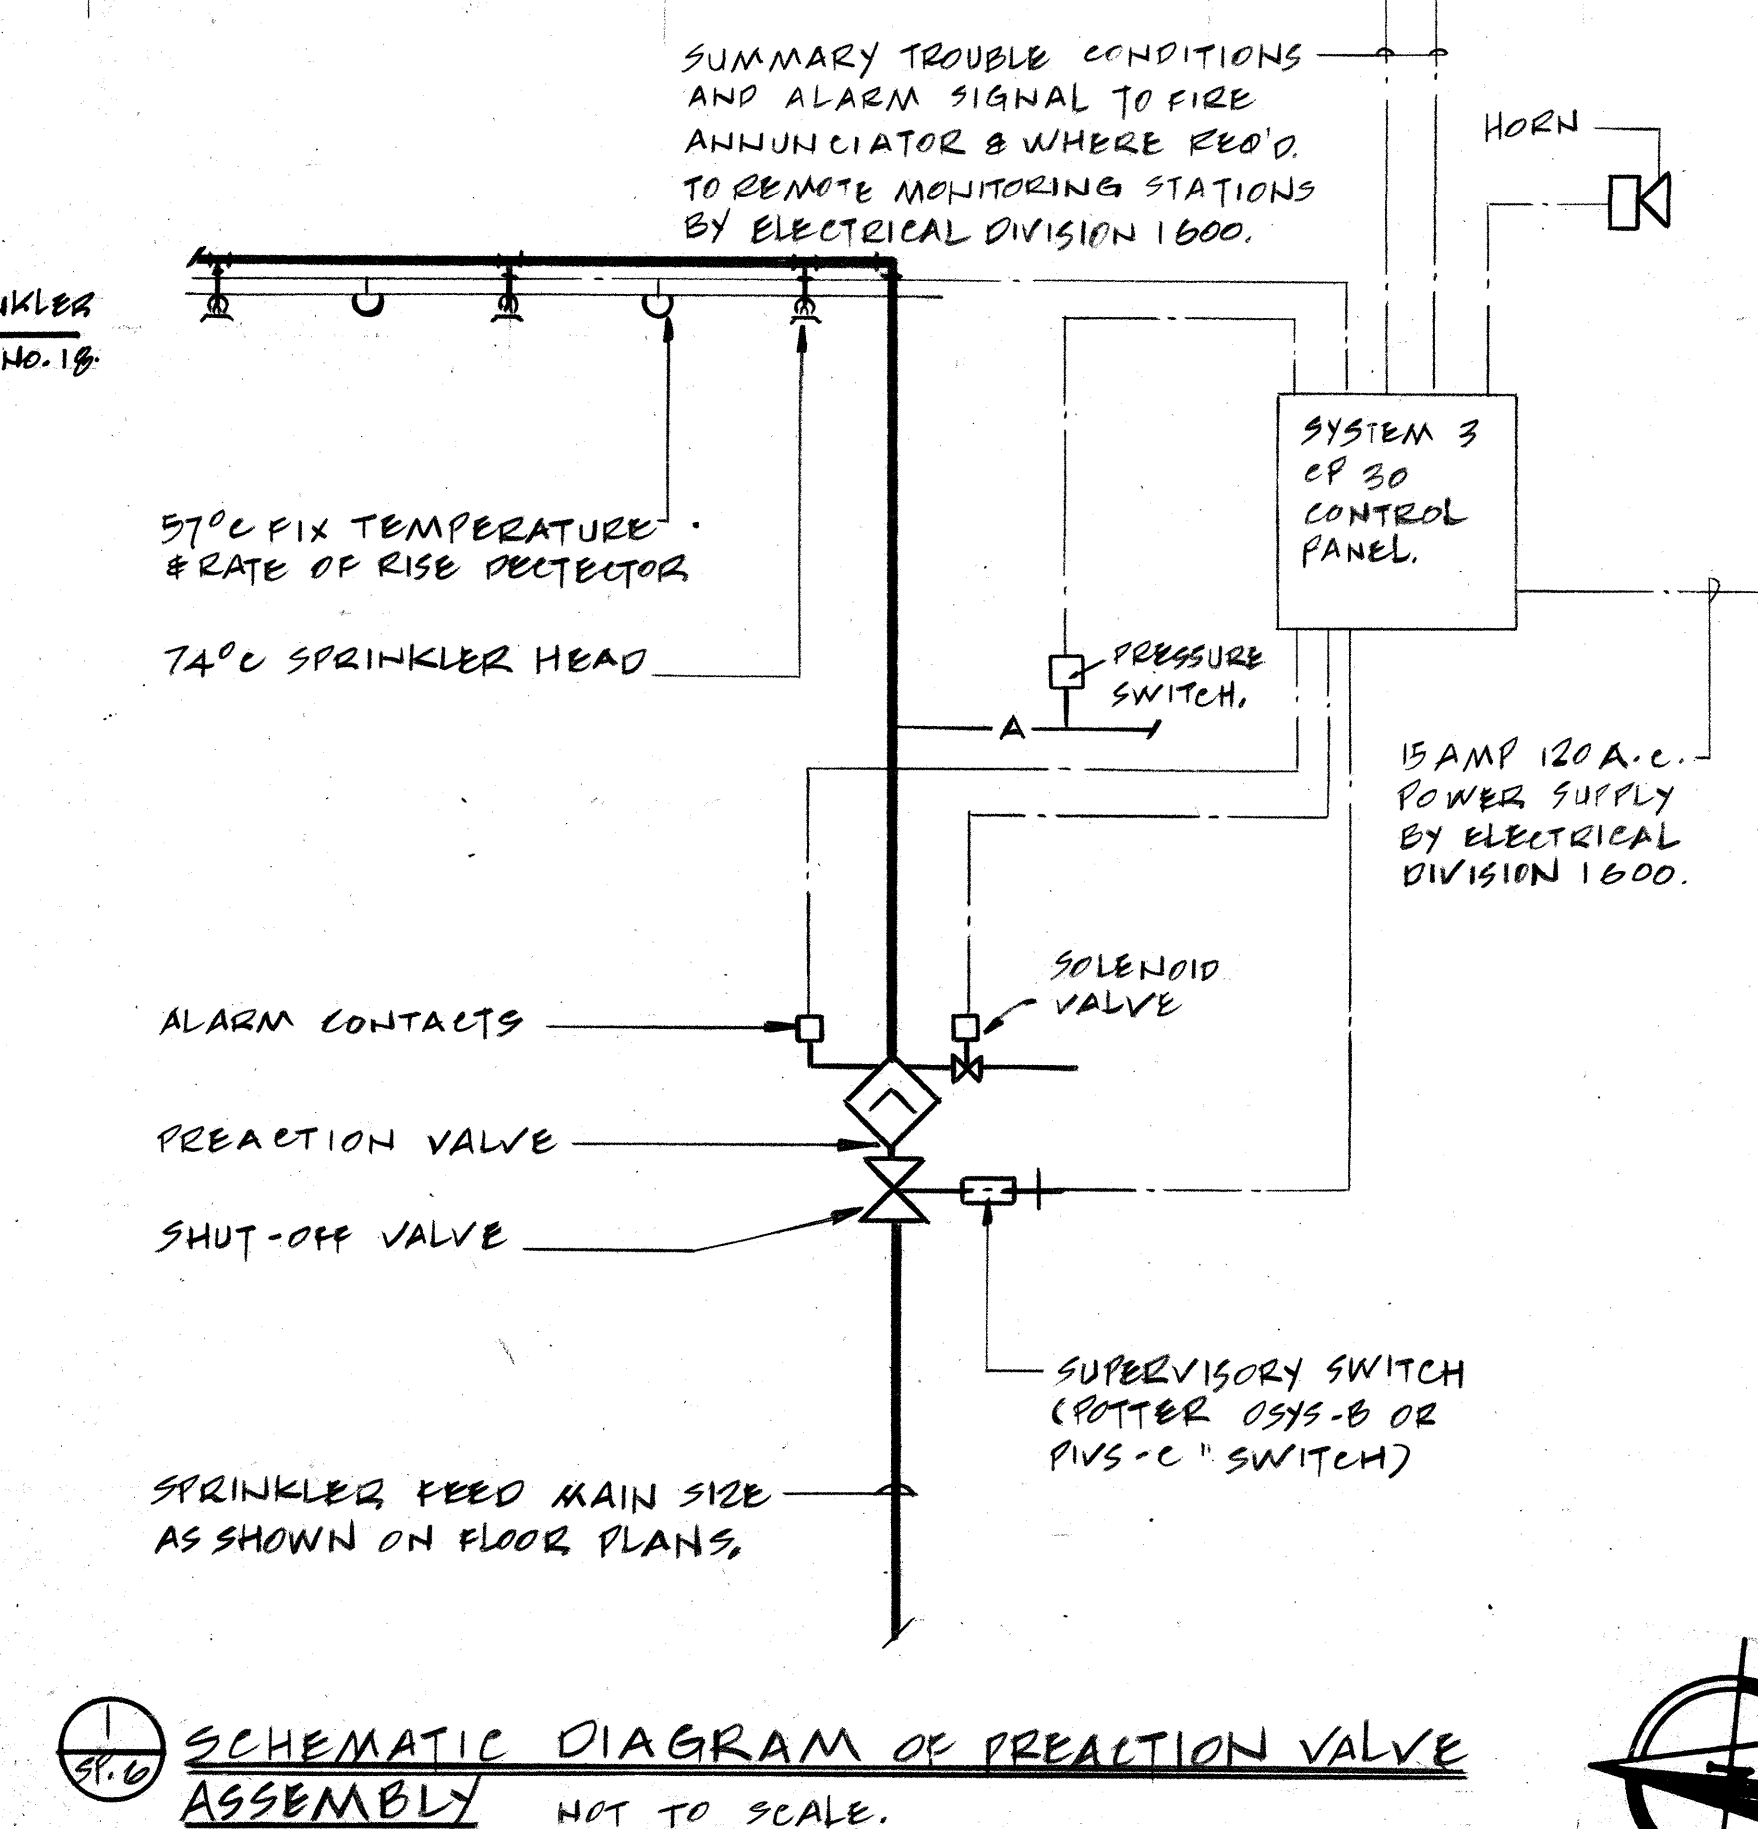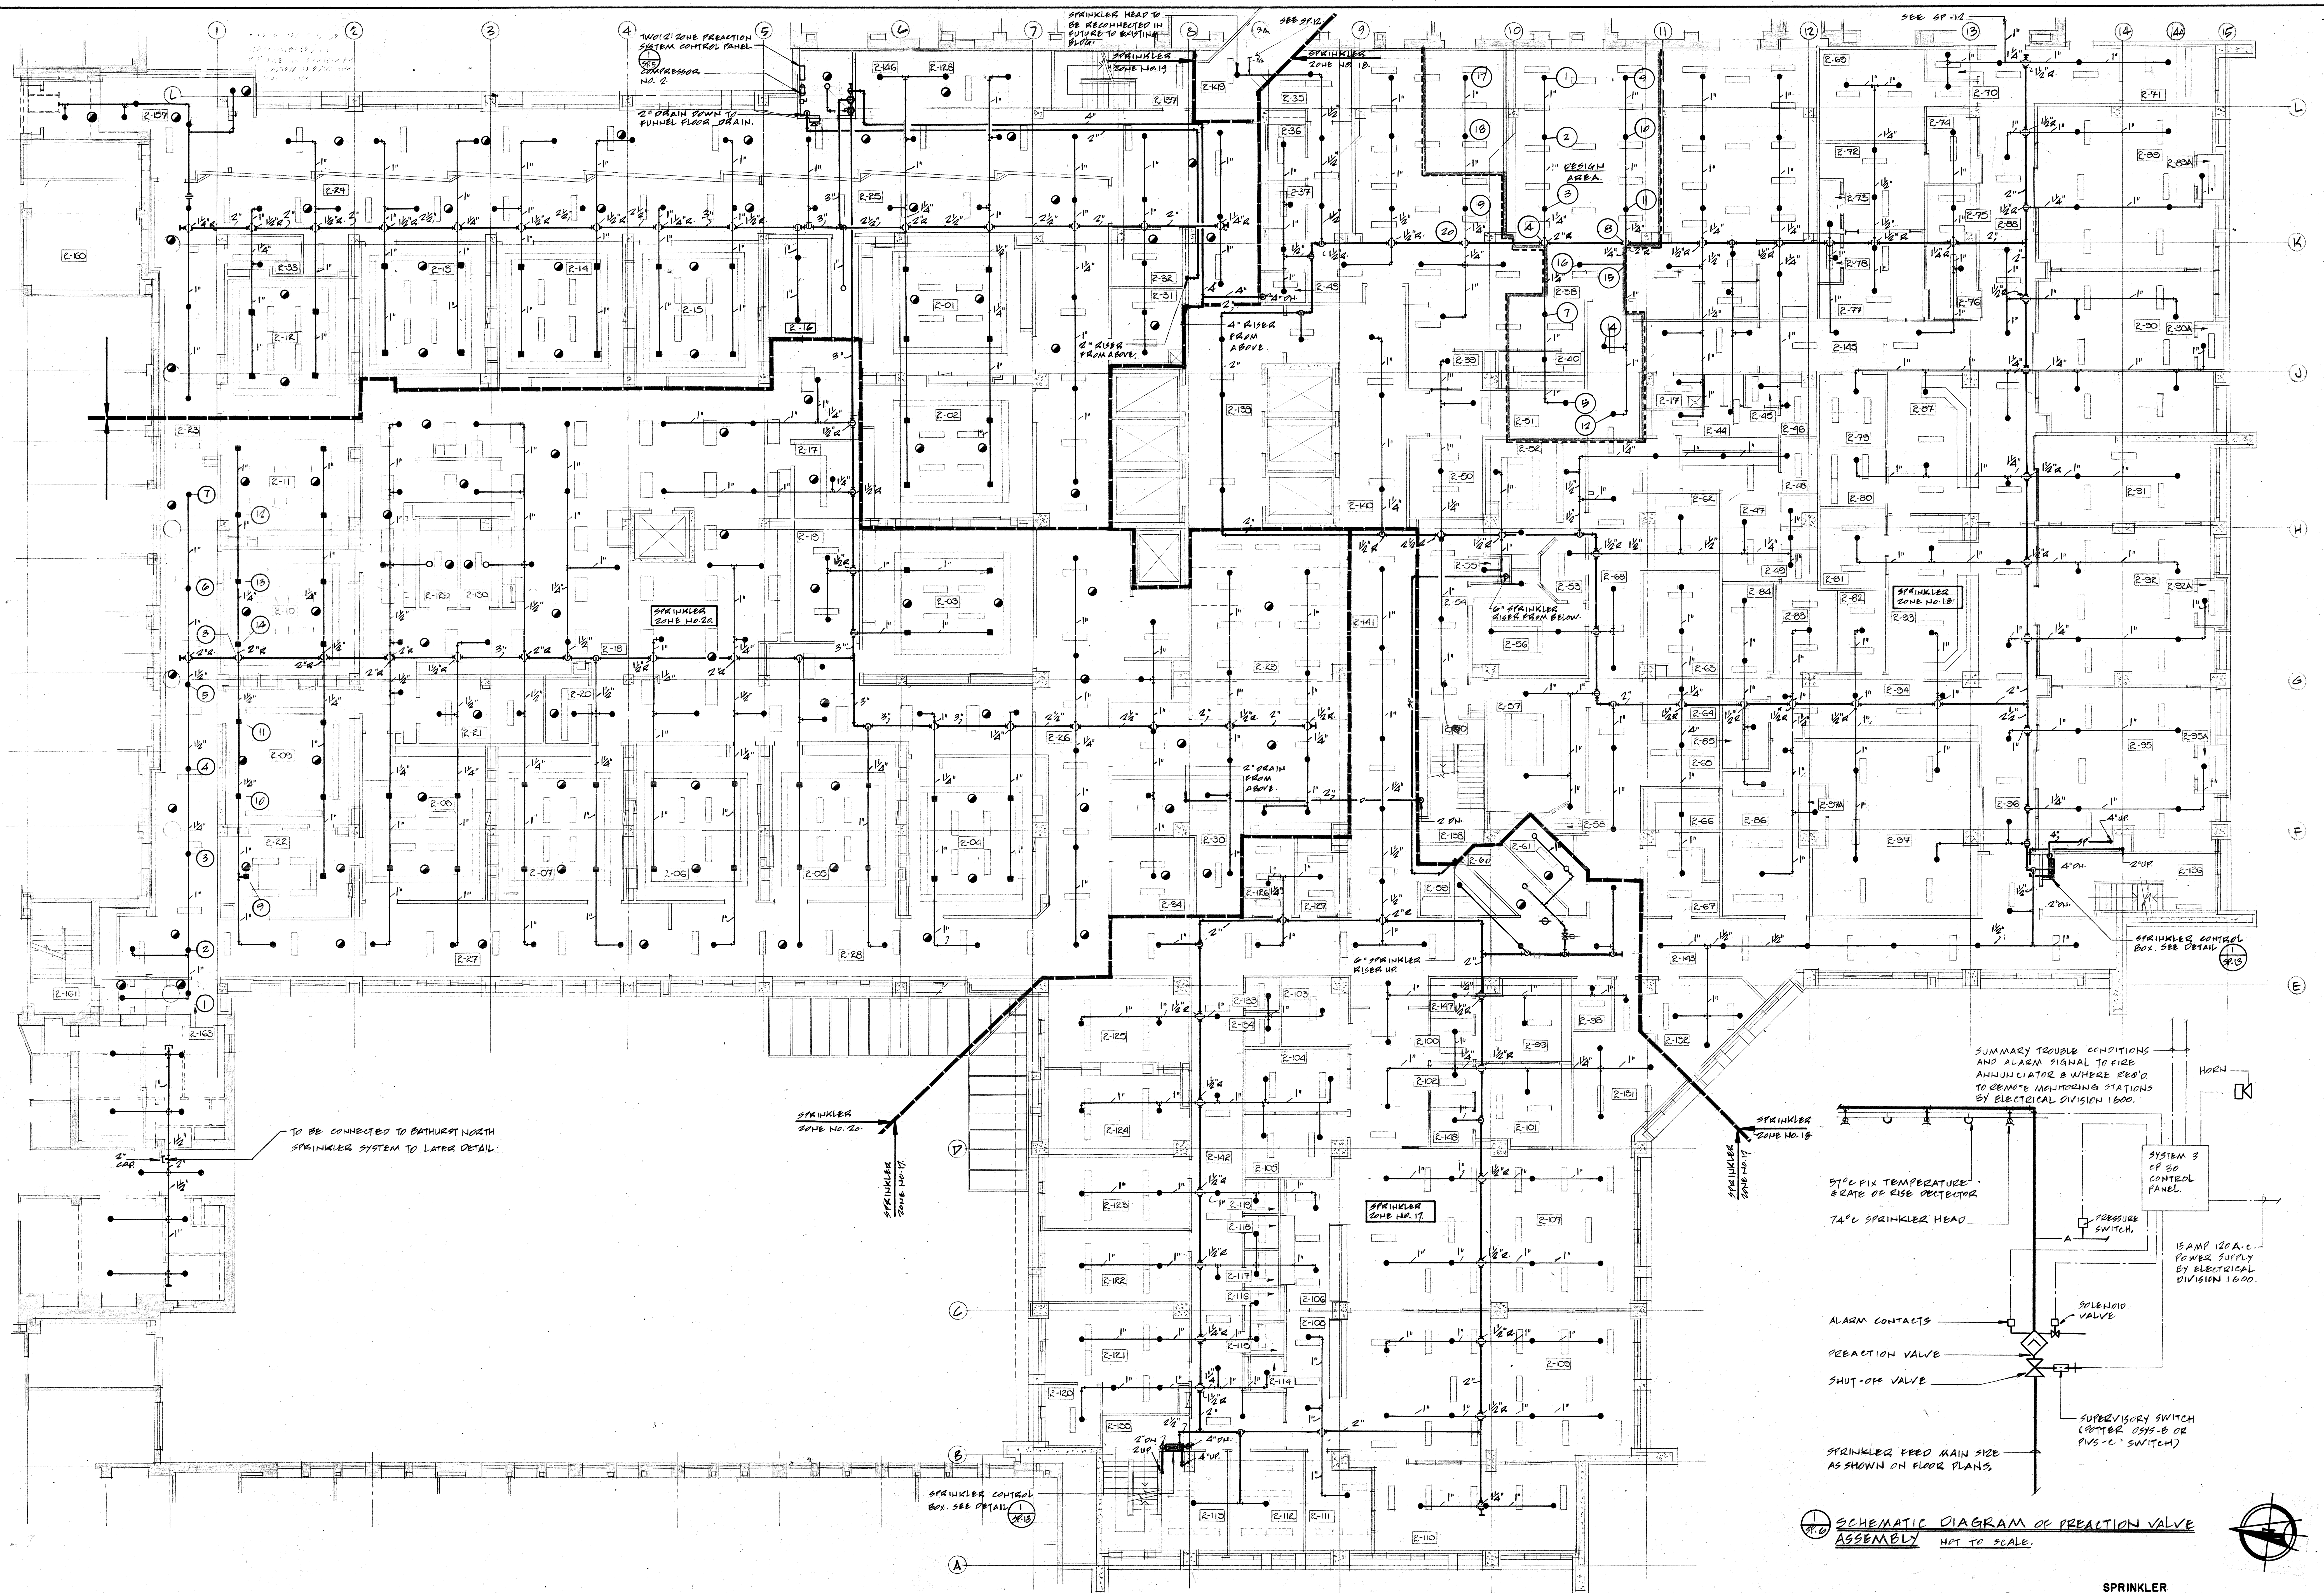

SCHEMATIC DIAGRAM OF PREACTION VALVE ASSEMBLY NOT TO SCALE.

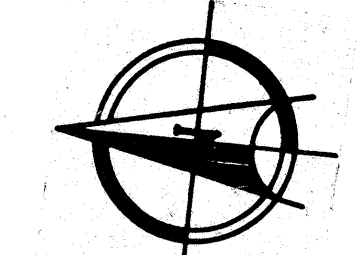


DESIGNATION	DESCRIPTION
E.P. NO.1	EXCESS PRESSURE PUMP AS ALBANY MODEL CEP-67, 0.18 KW, 120V, 10 C/W MANUAL START.
COMPRESSOR TYPE 1.	COMPRESSOR AS MANUFACTURED BY WEBSTER AIR EQUIPMENT LTD. MODEL 60-11 WITH 227 L. TANK, STARTER AS SPECIFIED AND PRESSURE REGULATOR FOR DRY PIPE AND PREACTION TYPE SPRINKLER SYSTEMS. MOTOR 1.12 KW, 550V, 3P POWER SUPPLY FROM MCC-2E-B.
COMPRESSOR TYPE 2.	COMPRESSOR AS MANUFACTURED BY WEBSTER AIR EQUIPMENT LTD. AS MODEL 60-9 BUT WITH 38 L. TANK STARTER AS SPECIFIED. MOTOR 0.18 KW, 120V, 10 PENTHOUSE POWER SUPPLY FROM MCC-4B-4.

EQUIPMENT SCHEDULE

1. PROVIDE 1" VALVED AND CAPTED INSPECTORS TEST CONNECTION WITH HOSE ENDS IN EACH AND EVERY SPRINKLER ZONE FOR INITIAL FLUSHING OUT OF THE SYSTEMS AND REMOTE TESTING OF ALARM DEVICES. PROVIDE 1" DIA HOSE AS REQUIRED.
2. PROVIDE FOR MINIMUM OF 90 (NINETY) SPRINKLER HEADS INCLUDING THIN MECHANICAL RAMMS FOR SPRINKLERING UNDER DUCTS, ANY OTHER UNOBSERVED OBSTRUCTION AND OR BLIND SPACES.
3. PROVIDE AUXILIARY DRAINS AS PER LATEST ISSUE OF NFPA 15.
4. PERFORM ACTUAL WATER TEST ON STREET HYDRANTS EXCEPT FOR PARKING LEVELS (DRY PIPE SYSTEMS) ALL SYSTEMS WILL BE HYDRAULICALLY TESTED.
5. WHERE SPRINKLER CONTROL CABINETS ARE TO BE INSTALLED ABOVE FIRE HOSE CABINETS, COORDINATE AND CO-ORDINATE ALL WORK WITH PLUMBING DIVISION.
6. ADVISE AND ARRANGE WITH TORONTO FIRE DEPARTMENT THE DATES OF TESTING OF ALARM DEVICES. COORDINATE THIS WORK WITH THE TRADE UNDER ELECTRICAL DIVISION.
7. ARCHITECTURAL REFLECTED CEILING PLANS AND ASSOCIATED DETAILS MUST BE READ IN CONJUNCTION WITH SPRINKLER LAYOUTS TO COORDINATE EACH AND EVERY SPRINKLER HEAD LOCATION.

GENERAL NOTES

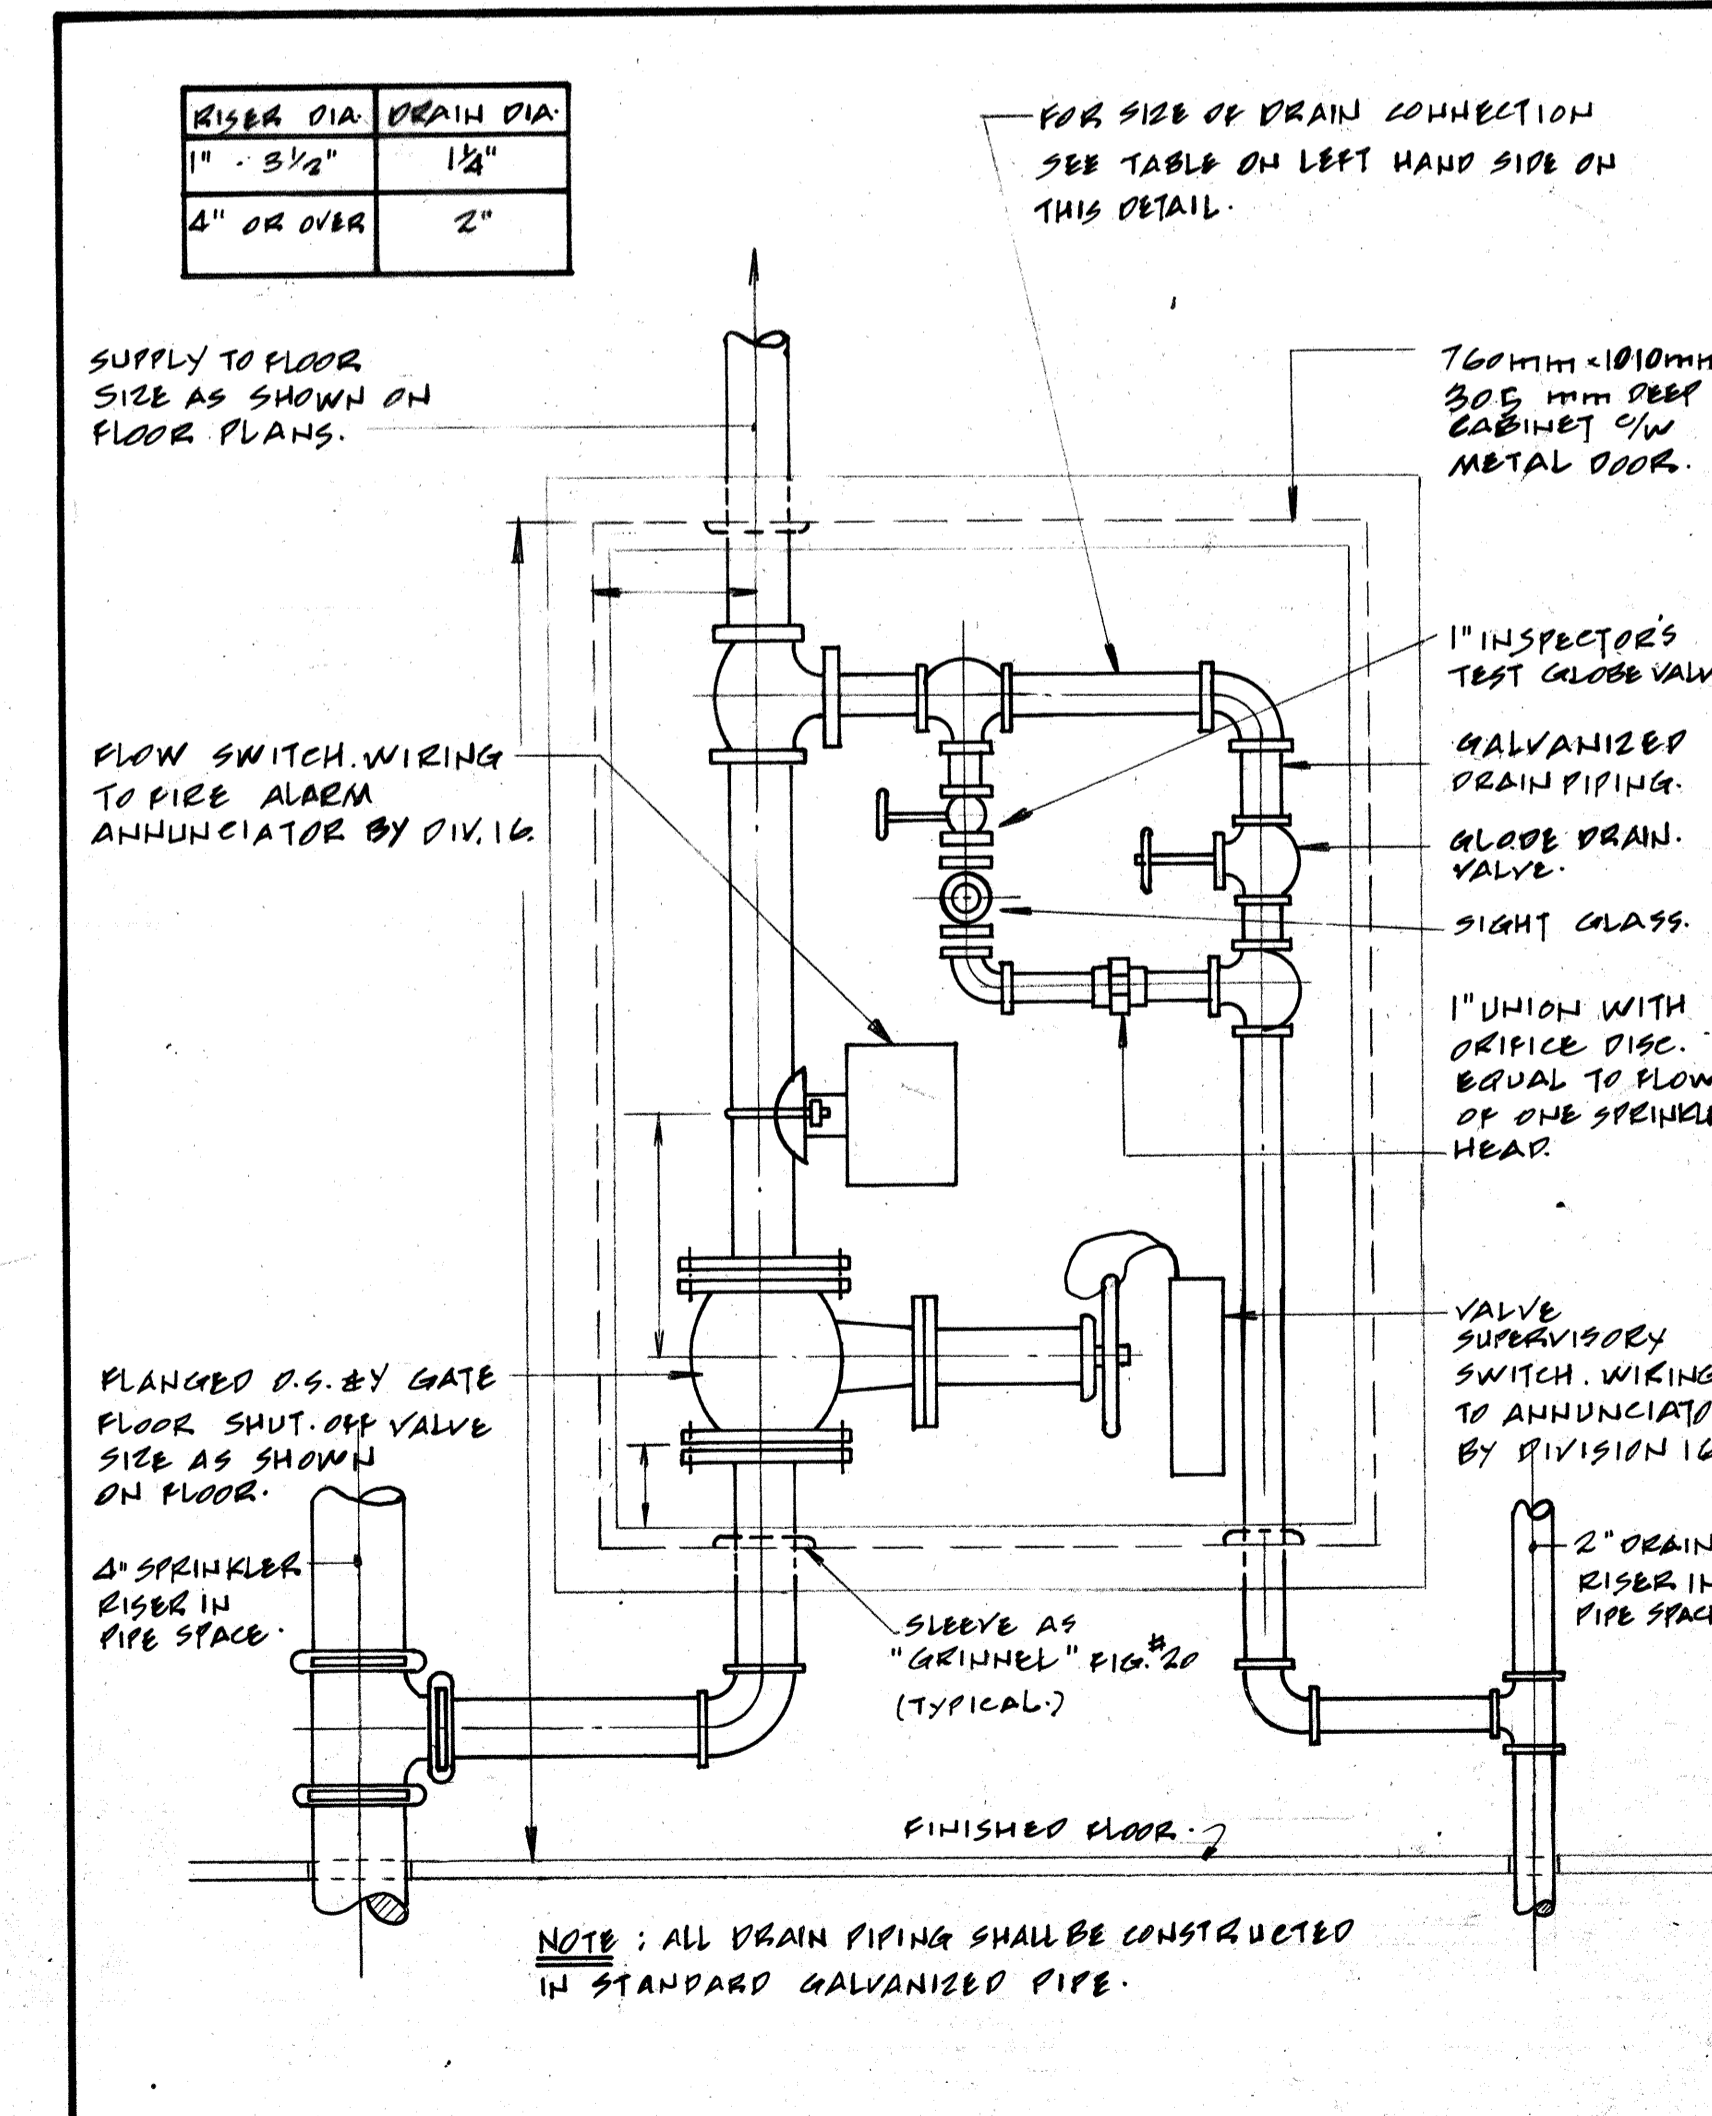


SPRINKLER CONTROL CABINET FOR FLOOR SHUT-OFF TYPE 'A' SCALE: 1:75


ITEM NO.	DESIGNATION	AREA PROTECTED	EQUIPMENT LOCATION	ANNUNCIATION		REMARKS
				ALARM	TROUBLE	
				F.S. REV. PRE. CK. V.	F.S. ACK. E.C.	
1	ZONE NO. 1	PARK LEVEL 2	BASEMENT			
2	ZONE NO. 2	PARK LEVEL 2	BASEMENT			
3	ZONE NO. 3	PARK LEVEL 2	BASEMENT			
4	ZONE NO. 4	PARK LEVEL 2	BASEMENT			
5	ZONE NO. 5	PARK LEVEL 1	BASEMENT			
6	ZONE NO. 6	PARK LEVEL 1	BASEMENT			
7	ZONE NO. 7	PARK LEVEL 1	BASEMENT			
8	ZONE NO. 8	PARK LEVEL 1	BASEMENT			
9	ZONE NO. 9	BASEMENT	BASEMENT			
10	ZONE NO. 10	BASEMENT	BASEMENT			
11	ZONE NO. 10A	BASEMENT	BASEMENT			
12	ZONE NO. 11	BASEMENT	BASEMENT			
13	ZONE NO. 12	BASEMENT	BASEMENT			
14	ZONE NO. 13	FIRST FLOOR	FIRST FLOOR			
15	ZONE NO. 14	FIRST FLOOR	FIRST FLOOR			
16	ZONE NO. 15	FIRST FLOOR	FIRST FLOOR			
17	ZONE NO. 16	FIRST FLOOR	FIRST FLOOR			
18	ZONE NO. 17	SECOND FLOOR	SECOND FLOOR			
19	ZONE NO. 18	SECOND FLOOR	SECOND FLOOR			
20	ZONE NO. 19	SECOND FLOOR	SECOND FLOOR			
21	ZONE NO. 20	SECOND FLOOR	SECOND FLOOR			
22	ZONE NO. 21	THIRD FLOOR	THIRD FLOOR			
23	ZONE NO. 22	THIRD FLOOR	THIRD FLOOR			
24	ZONE NO. 23	THIRD FLOOR	THIRD FLOOR			
25	ZONE NO. 24	THIRD FLOOR	THIRD FLOOR			
26	ZONE NO. 25	FOURTH FLOOR	FOURTH FLOOR			
27	ZONE NO. 26	FOURTH FLOOR	FOURTH FLOOR			
28	ZONE NO. 27	FIFTH FLOOR	FIFTH FLOOR			
29	ZONE NO. 27A	SIXTH FLOOR	SIXTH FLOOR			
30	ZONE NO. 28A	SIXTH FLOOR	SIXTH FLOOR			
31	ZONE NO. 29	SEVENTH FLOOR	SEVENTH FLOOR			
32	ZONE NO. 30	EIGHTH FLOOR	EIGHTH FLOOR			
33	ZONE NO. 31	EIGHTH FLOOR	EIGHTH FLOOR			
34	ZONE NO. 32	ELEV. MACH. RM.	ELEV. MACH. RM.			
35	ZONE NO. 33	NINTH FLOOR	NINTH FLOOR			VALVE NO. 35
36	ZONE NO. 34	SOUTHWEST ZONE	SOUTHWEST ZONE			VALVE NO. 36
37	ZONE NO. 35	NORTHWEST ZONE	NORTHWEST ZONE			VALVE NO. 37
38	ZONE NO. 36	SOUTHEAST ZONE	SOUTHEAST ZONE			VALVE NO. 38
39	ZONE NO. 37	SOUTHEAST ZONE	SOUTHEAST ZONE			VALVE NO. 39
40	ZONE NO. 38	SOUTHEAST ZONE	SOUTHEAST ZONE			VALVE NO. 40
41	ZONE NO. 39	SOUTHEAST ZONE	SOUTHEAST ZONE			VALVE NO. 41
42	ZONE NO. 40	SOUTHEAST ZONE	SOUTHEAST ZONE			VALVE NO. 42
43	ZONE NO. 41	SOUTHEAST ZONE	SOUTHEAST ZONE			VALVE NO. 43
44	ZONE NO. 42	SOUTHEAST ZONE	SOUTHEAST ZONE			VALVE NO. 44
45	ZONE NO. 43	SOUTHEAST ZONE	SOUTHEAST ZONE			VALVE NO. 45

ABBREVIATIONS	
F.S.	FLOW SWITCH
REV.	RETRACTOR CHECK VALVE
D.P.V.	DRY PIPE VALVE
C.V.	CONTROL VALVE (O.S.B.Y. GATE OR BUTTERFLY VALVE)
P.S.	PRESSURE SWITCH
A.C.V.	ALARM CHECK VALVE
E.C.	ELECTRICAL CIRCUITS (TO DETECTORS AND TO SOLENOID VALVE.)

SPRINKLER ANNUNCIATION SCHEDULE

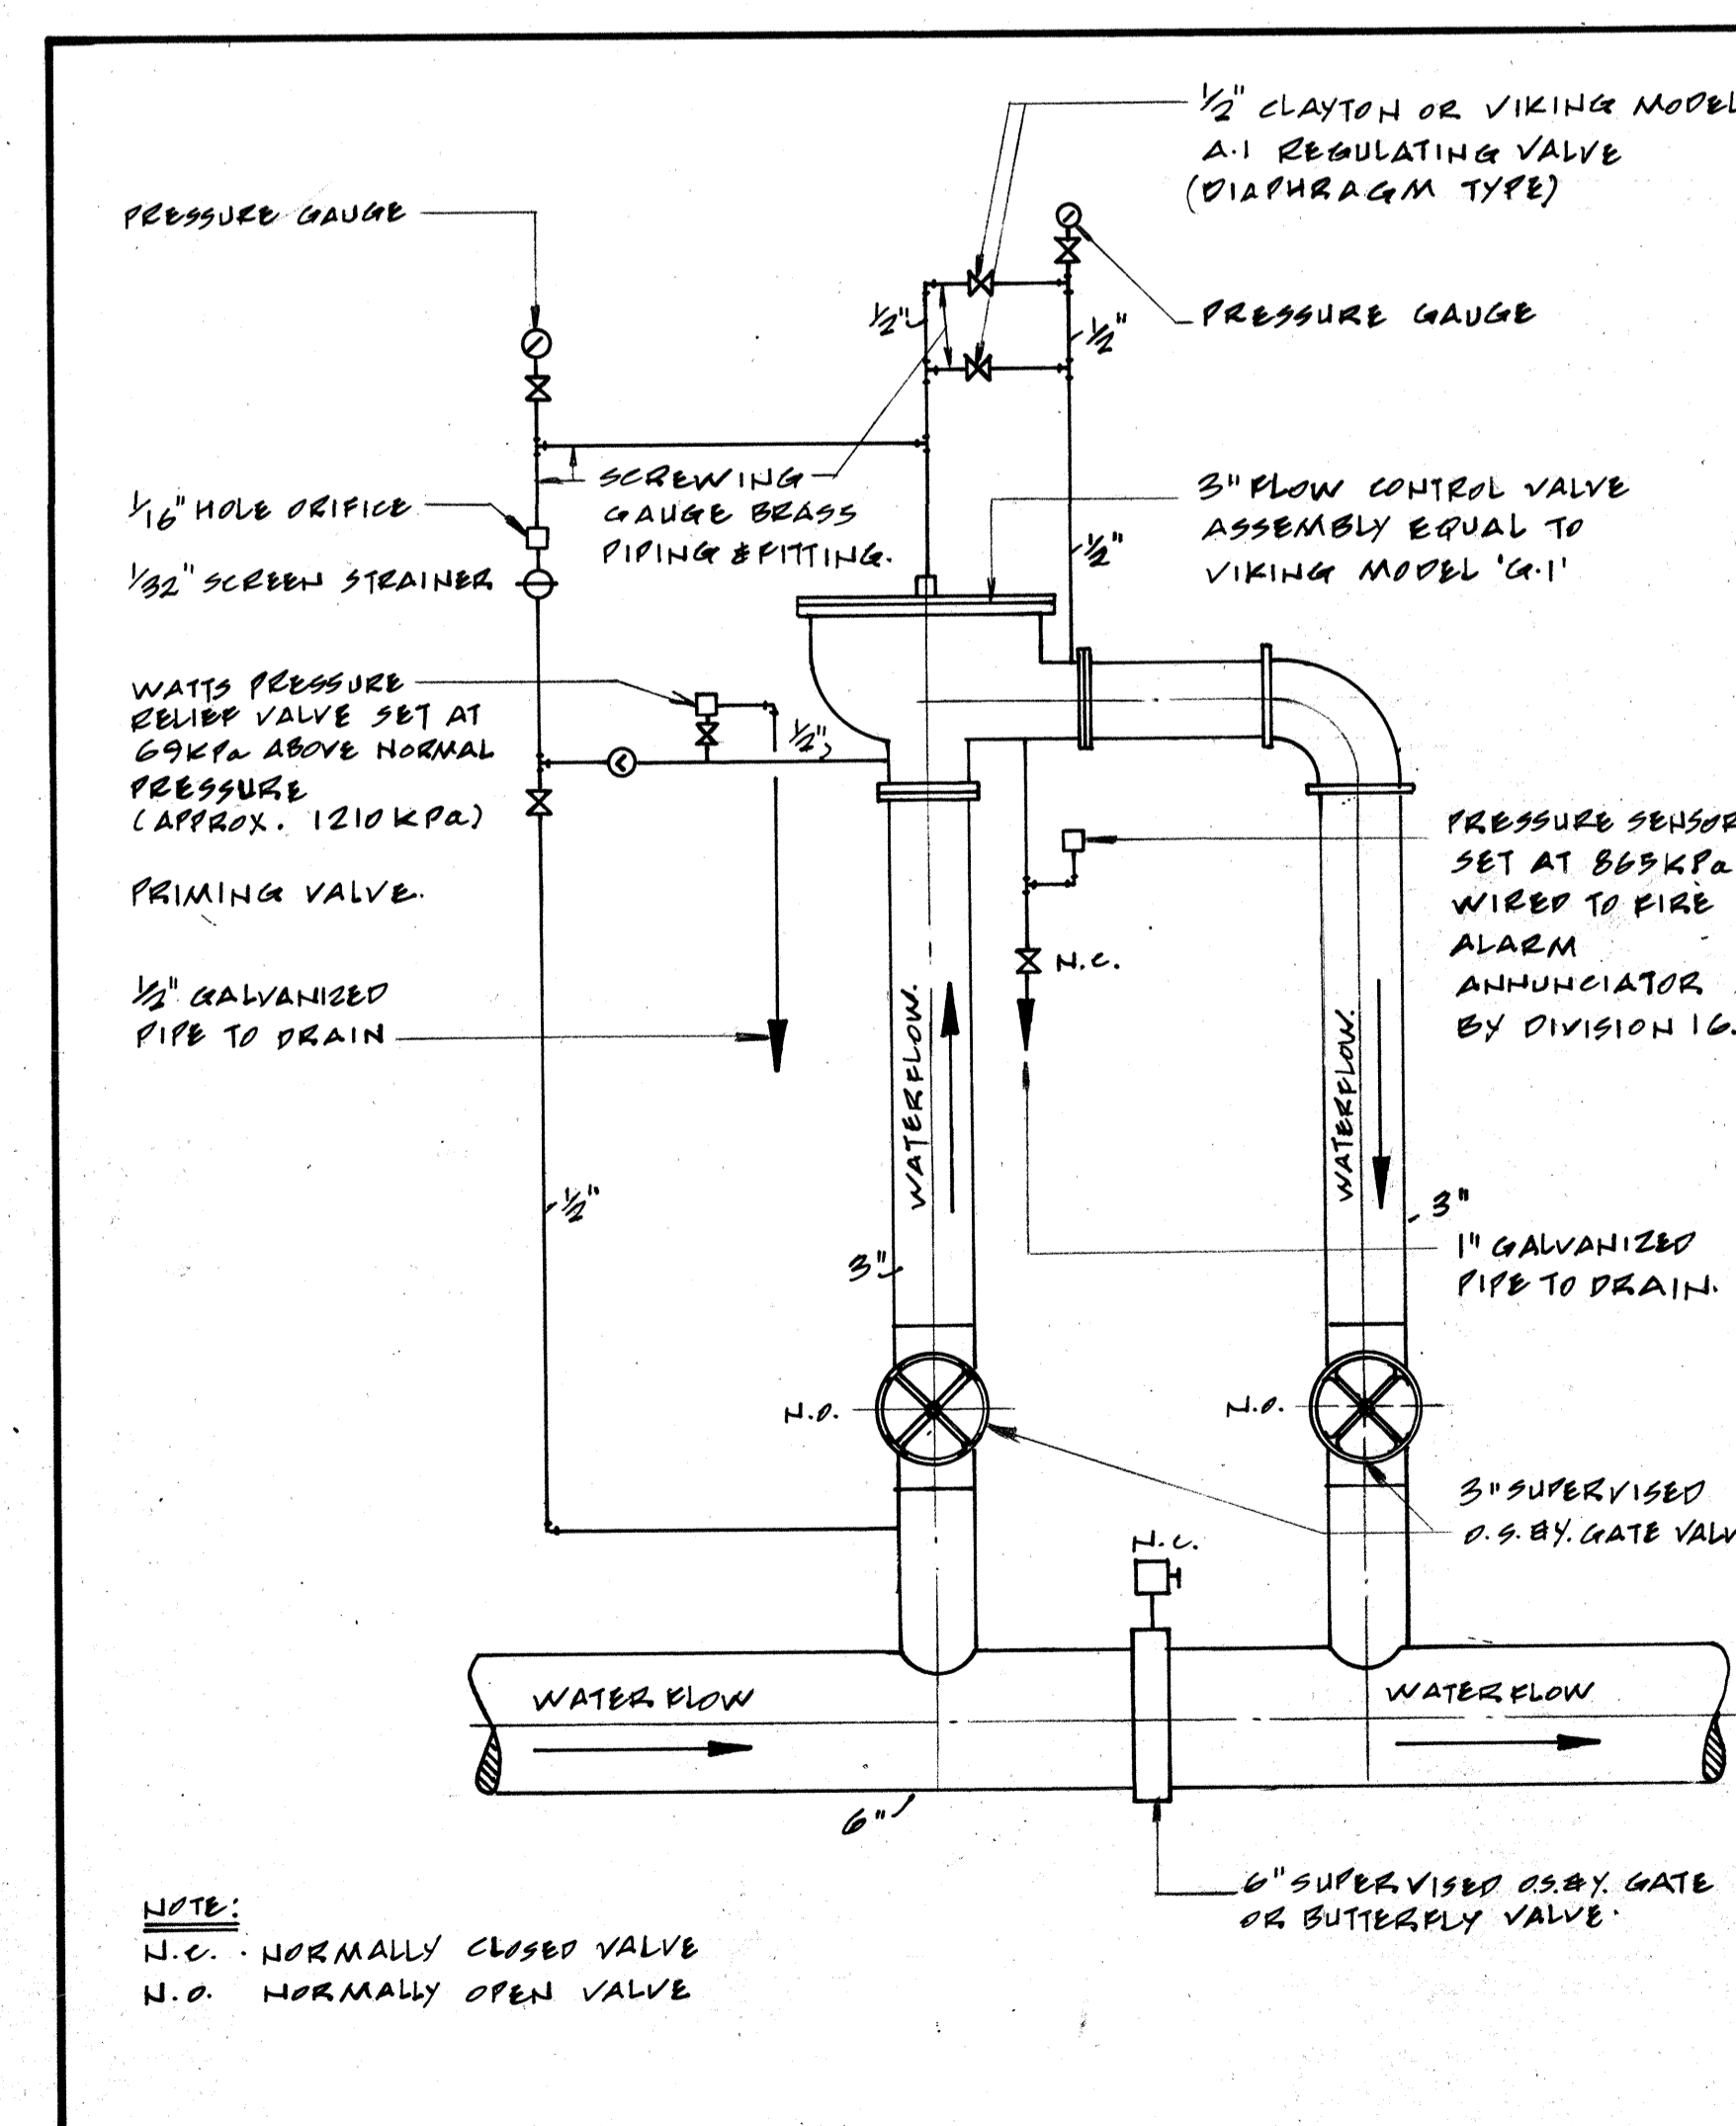

PRESSURE REDUCING VALVE ASSEMBLY NOT TO SCALE.

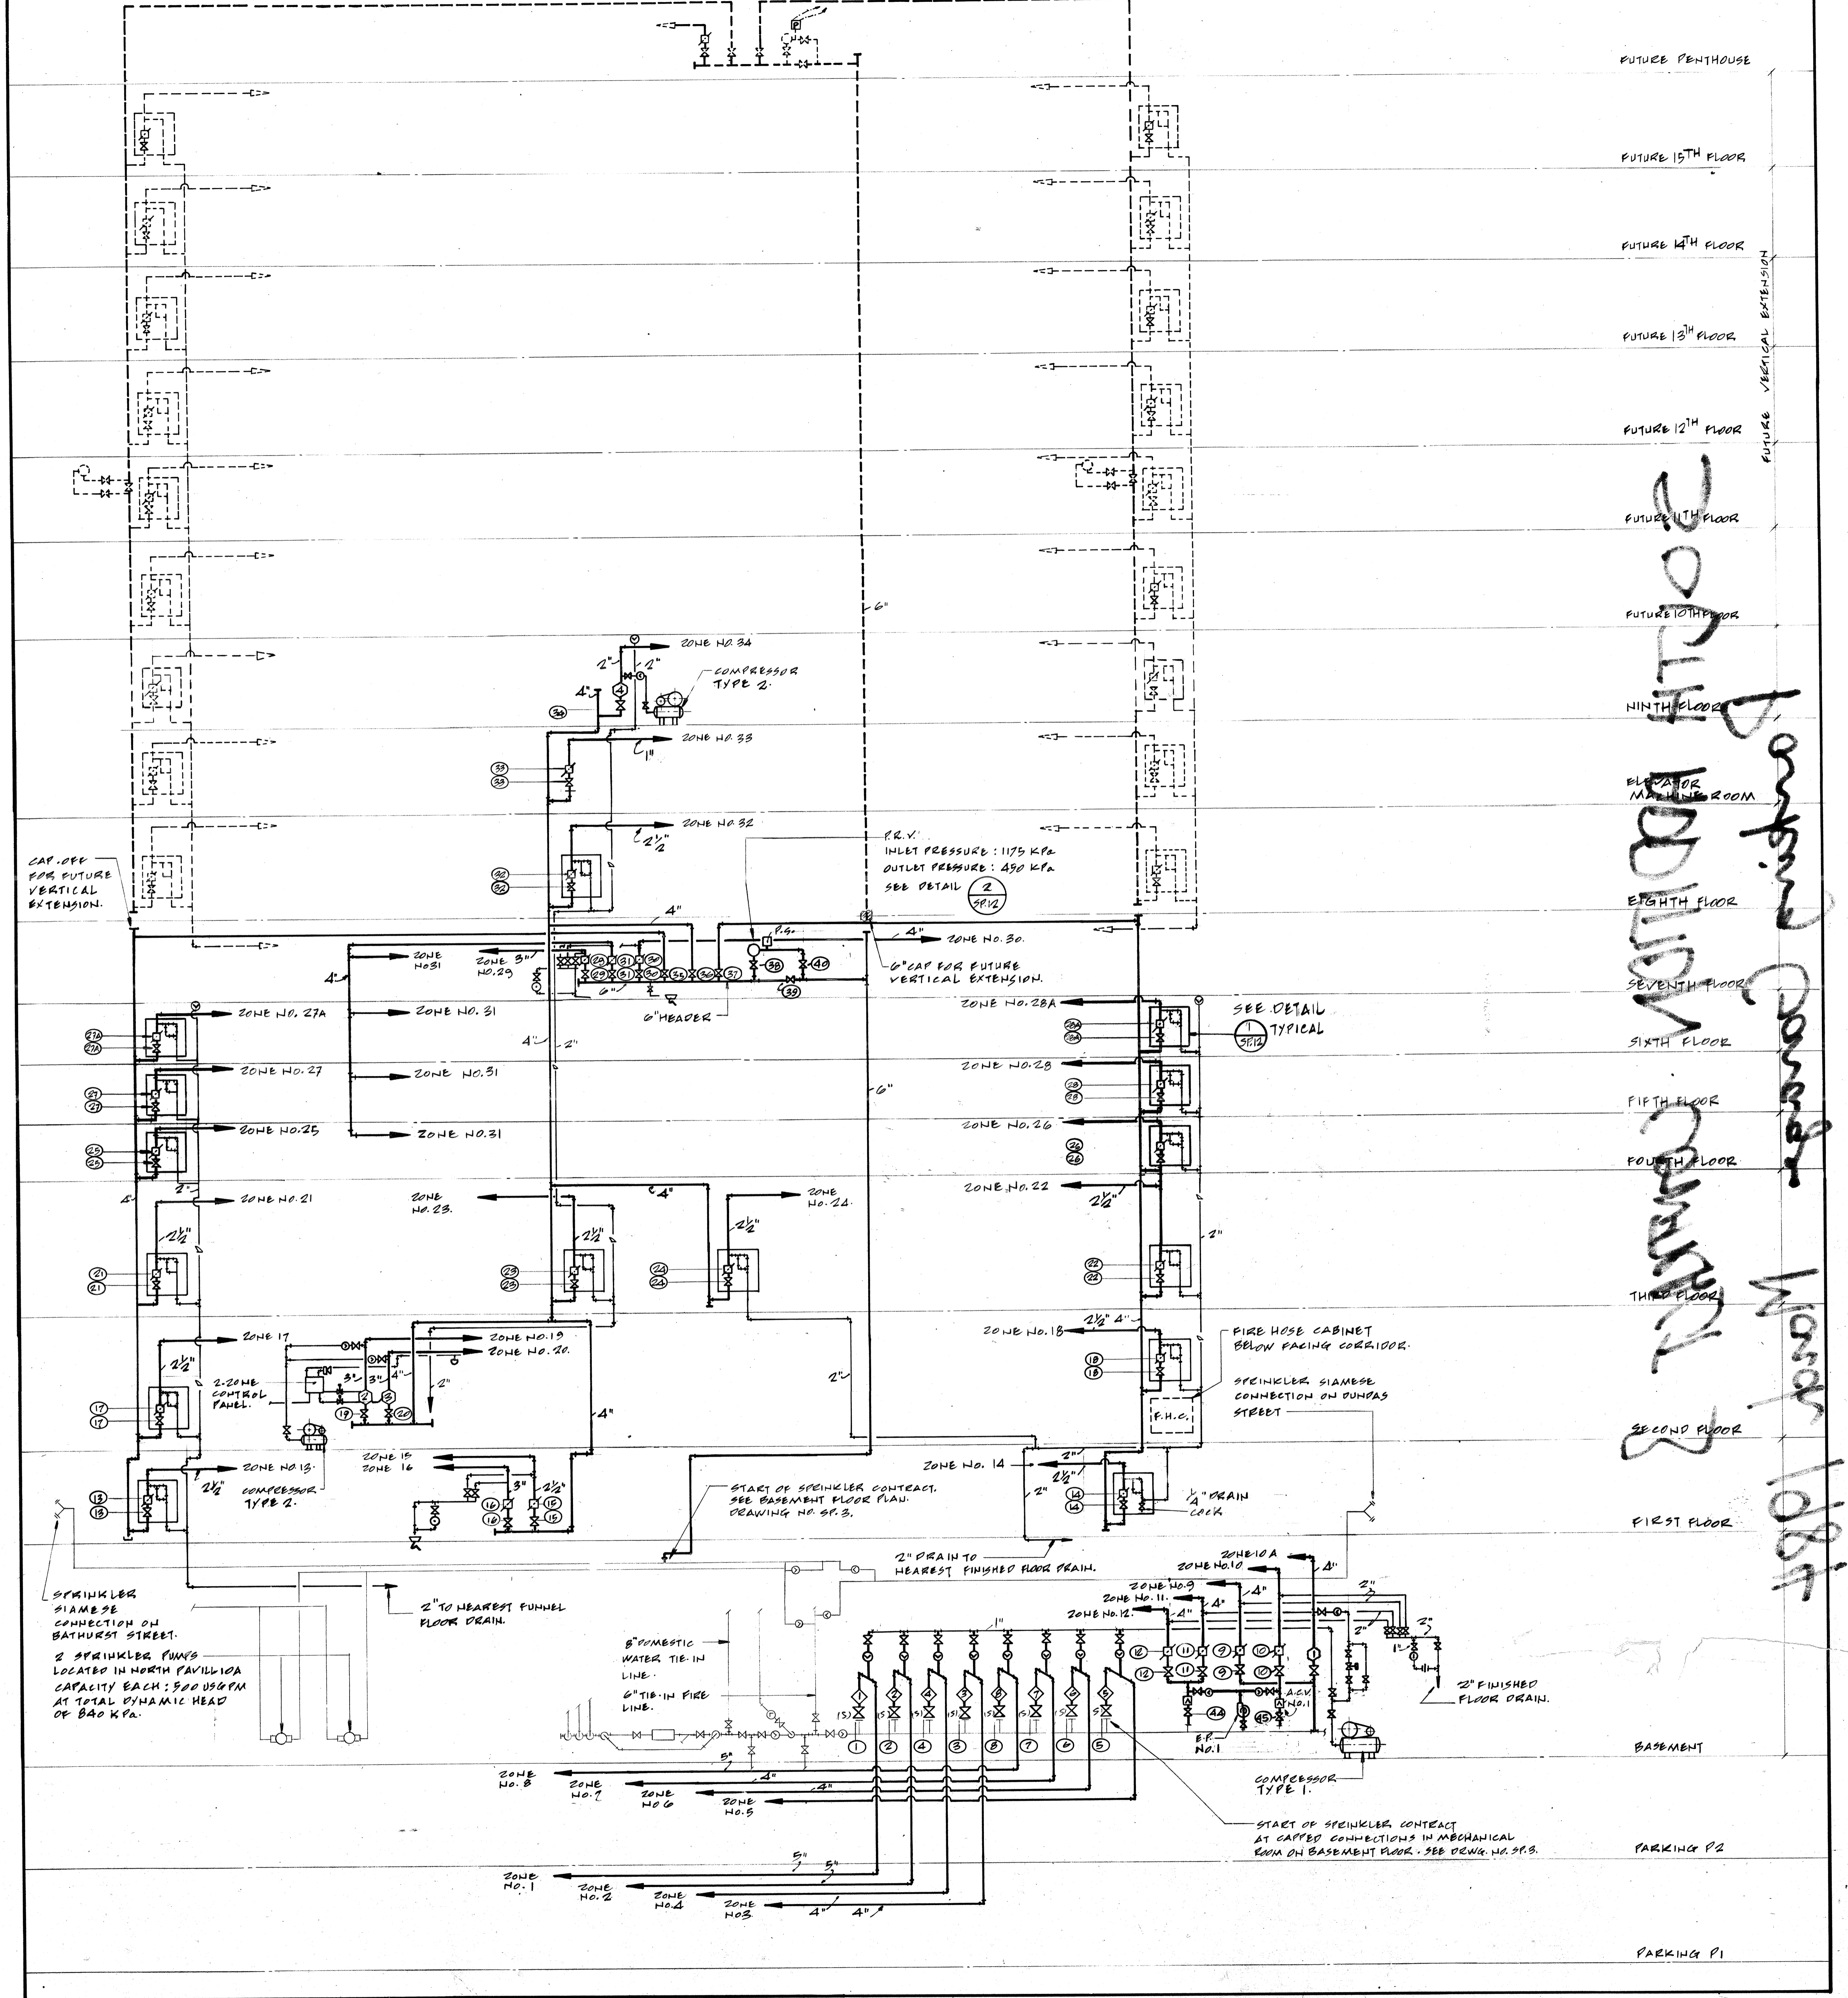

SPRINKLER RISER DIAGRAM NOT TO SCALE

THE CONTRACTOR SHALL CHECK AND VERIFY ALL DIMENSIONS ON THE JOB

REVISIONS		PRINT ISSUE RECORD	
NO.	DESCRIPTION	DATE	BY
1	ISSUED FOR TENDER		

PROJECT NO. 712-3

TORONTO WESTERN HOSPITAL SOUTH ADDITION-CONTRACT NO. 3

SPRINKLER RISER DIAGRAM, DETAILS & SCHEDULES SP-14

GOVAN KAMINKER KEENEYSIDE WIL

SLAUNWHITE STEVENSON ARCHITECTS

1295 BELLAMY RD. N. SCARBOROUGH, ONTARIO, CANADA