

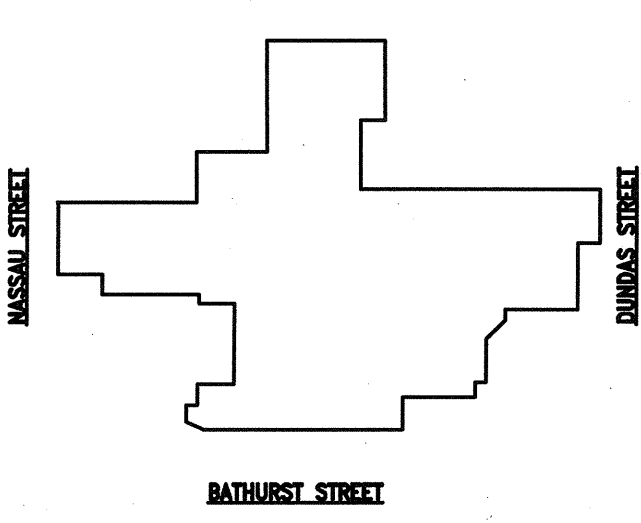


6-BR
W





University Health Network
Toronto General Hospital, Toronto Western Hospital, Princess Margaret Hospital

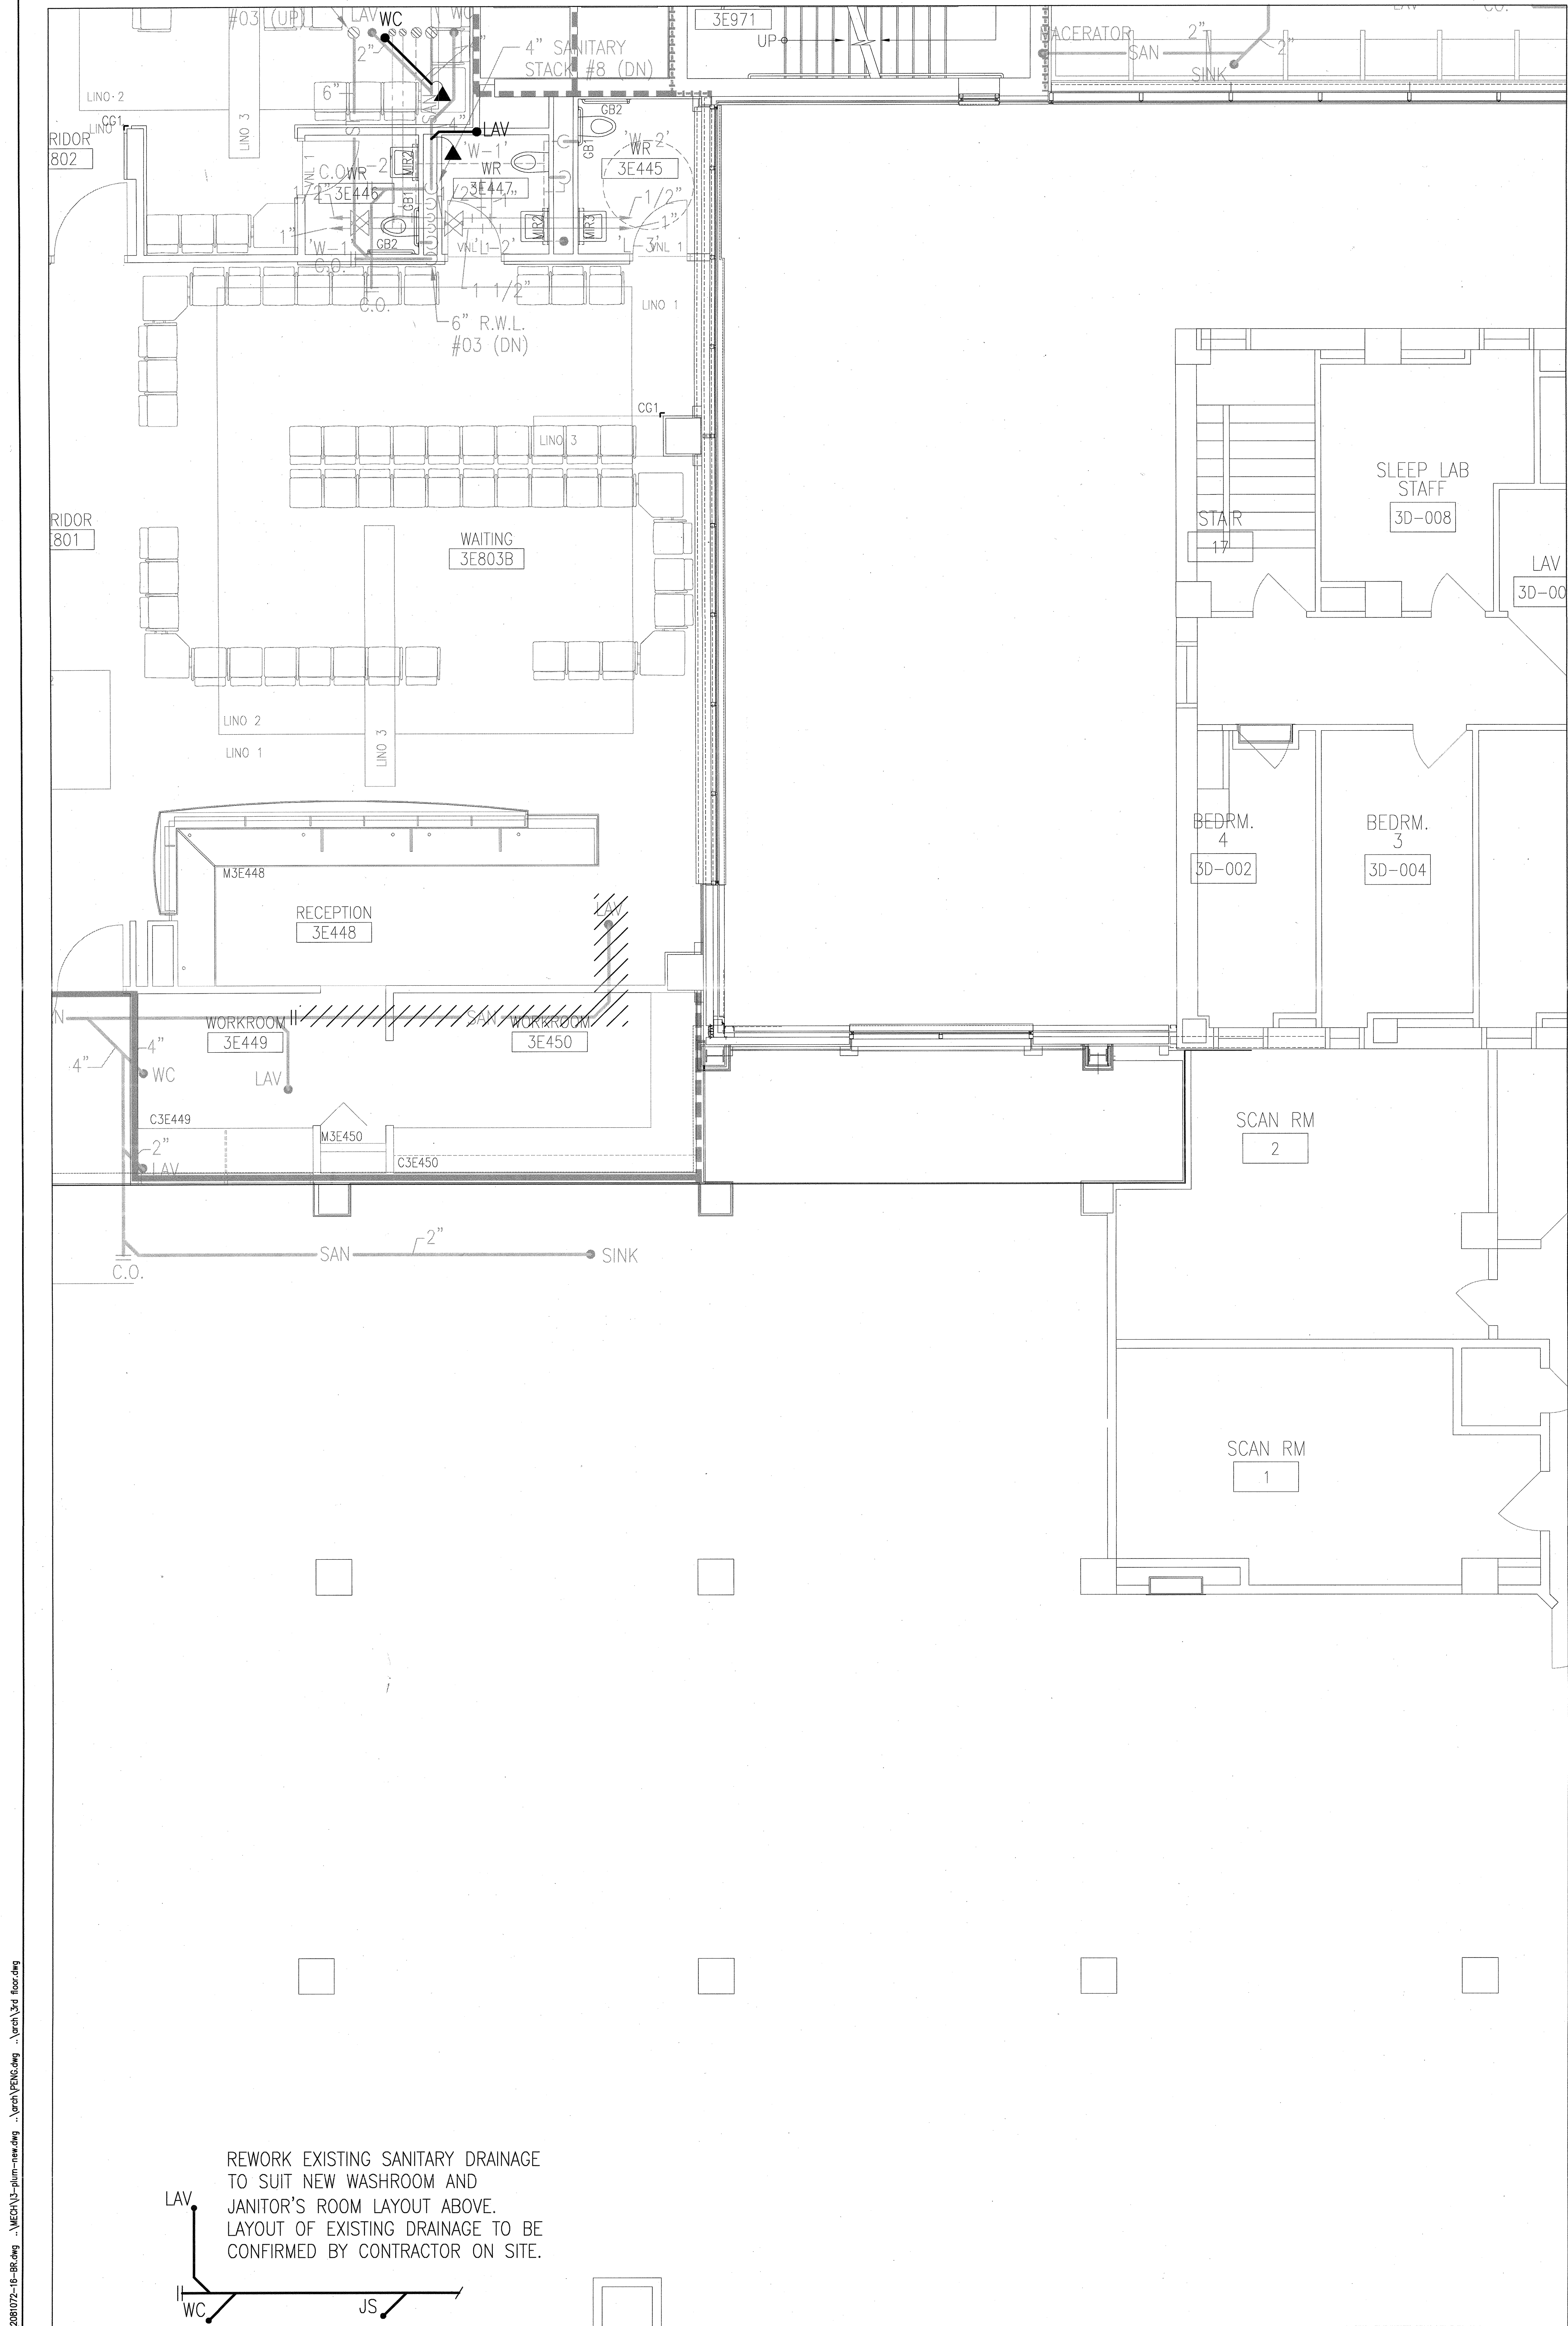


KEY PLAN

TRUE NORTH PROJECT NORTH


No.	Description	Date
1.	ISSUED FOR TENDER - PERMIT	08/12/09

Revisions:

All measurements are to be checked and verified on site by the contractor before proceeding with the work. Do not scale the drawings.

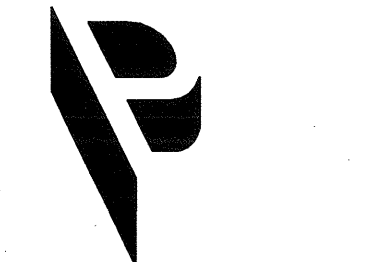


PARKIN
ARCHITECTS LIMITED

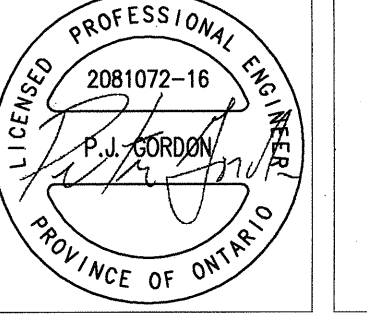

PROFESSIONAL ENGINEER
2001072-10
Parkin
PROVINCE OF ONTARIO

Consultants:

 H.A. Angus & Associates Limited Consulting Engineers
1127 Leslie Street, Toronto, Ontario, M3C 2B6 Canada
T (416) 443 8200 F (416) 443 8200 www.haangus.com

Project:

UNIVERSITY HEALTH NETWORK
TORONTO WESTERN HOSPITAL
BARIATRIC PROGRAM
RENOVATION PROJECT

Drawn By: R.D. Date: DECEMBER 2009

Checked By: P.G. Scale: 1:50


Sheet Title:

THIRD FLOOR PLAN
PLUMBING
DEMOLITION & NEW WORK


Sheet Number:

M-201


FILENAME: J:\2009\072-10\dwg\Map\M-201.dwg
PLOTDATE: Dec 08, 2009 - 12:16pm

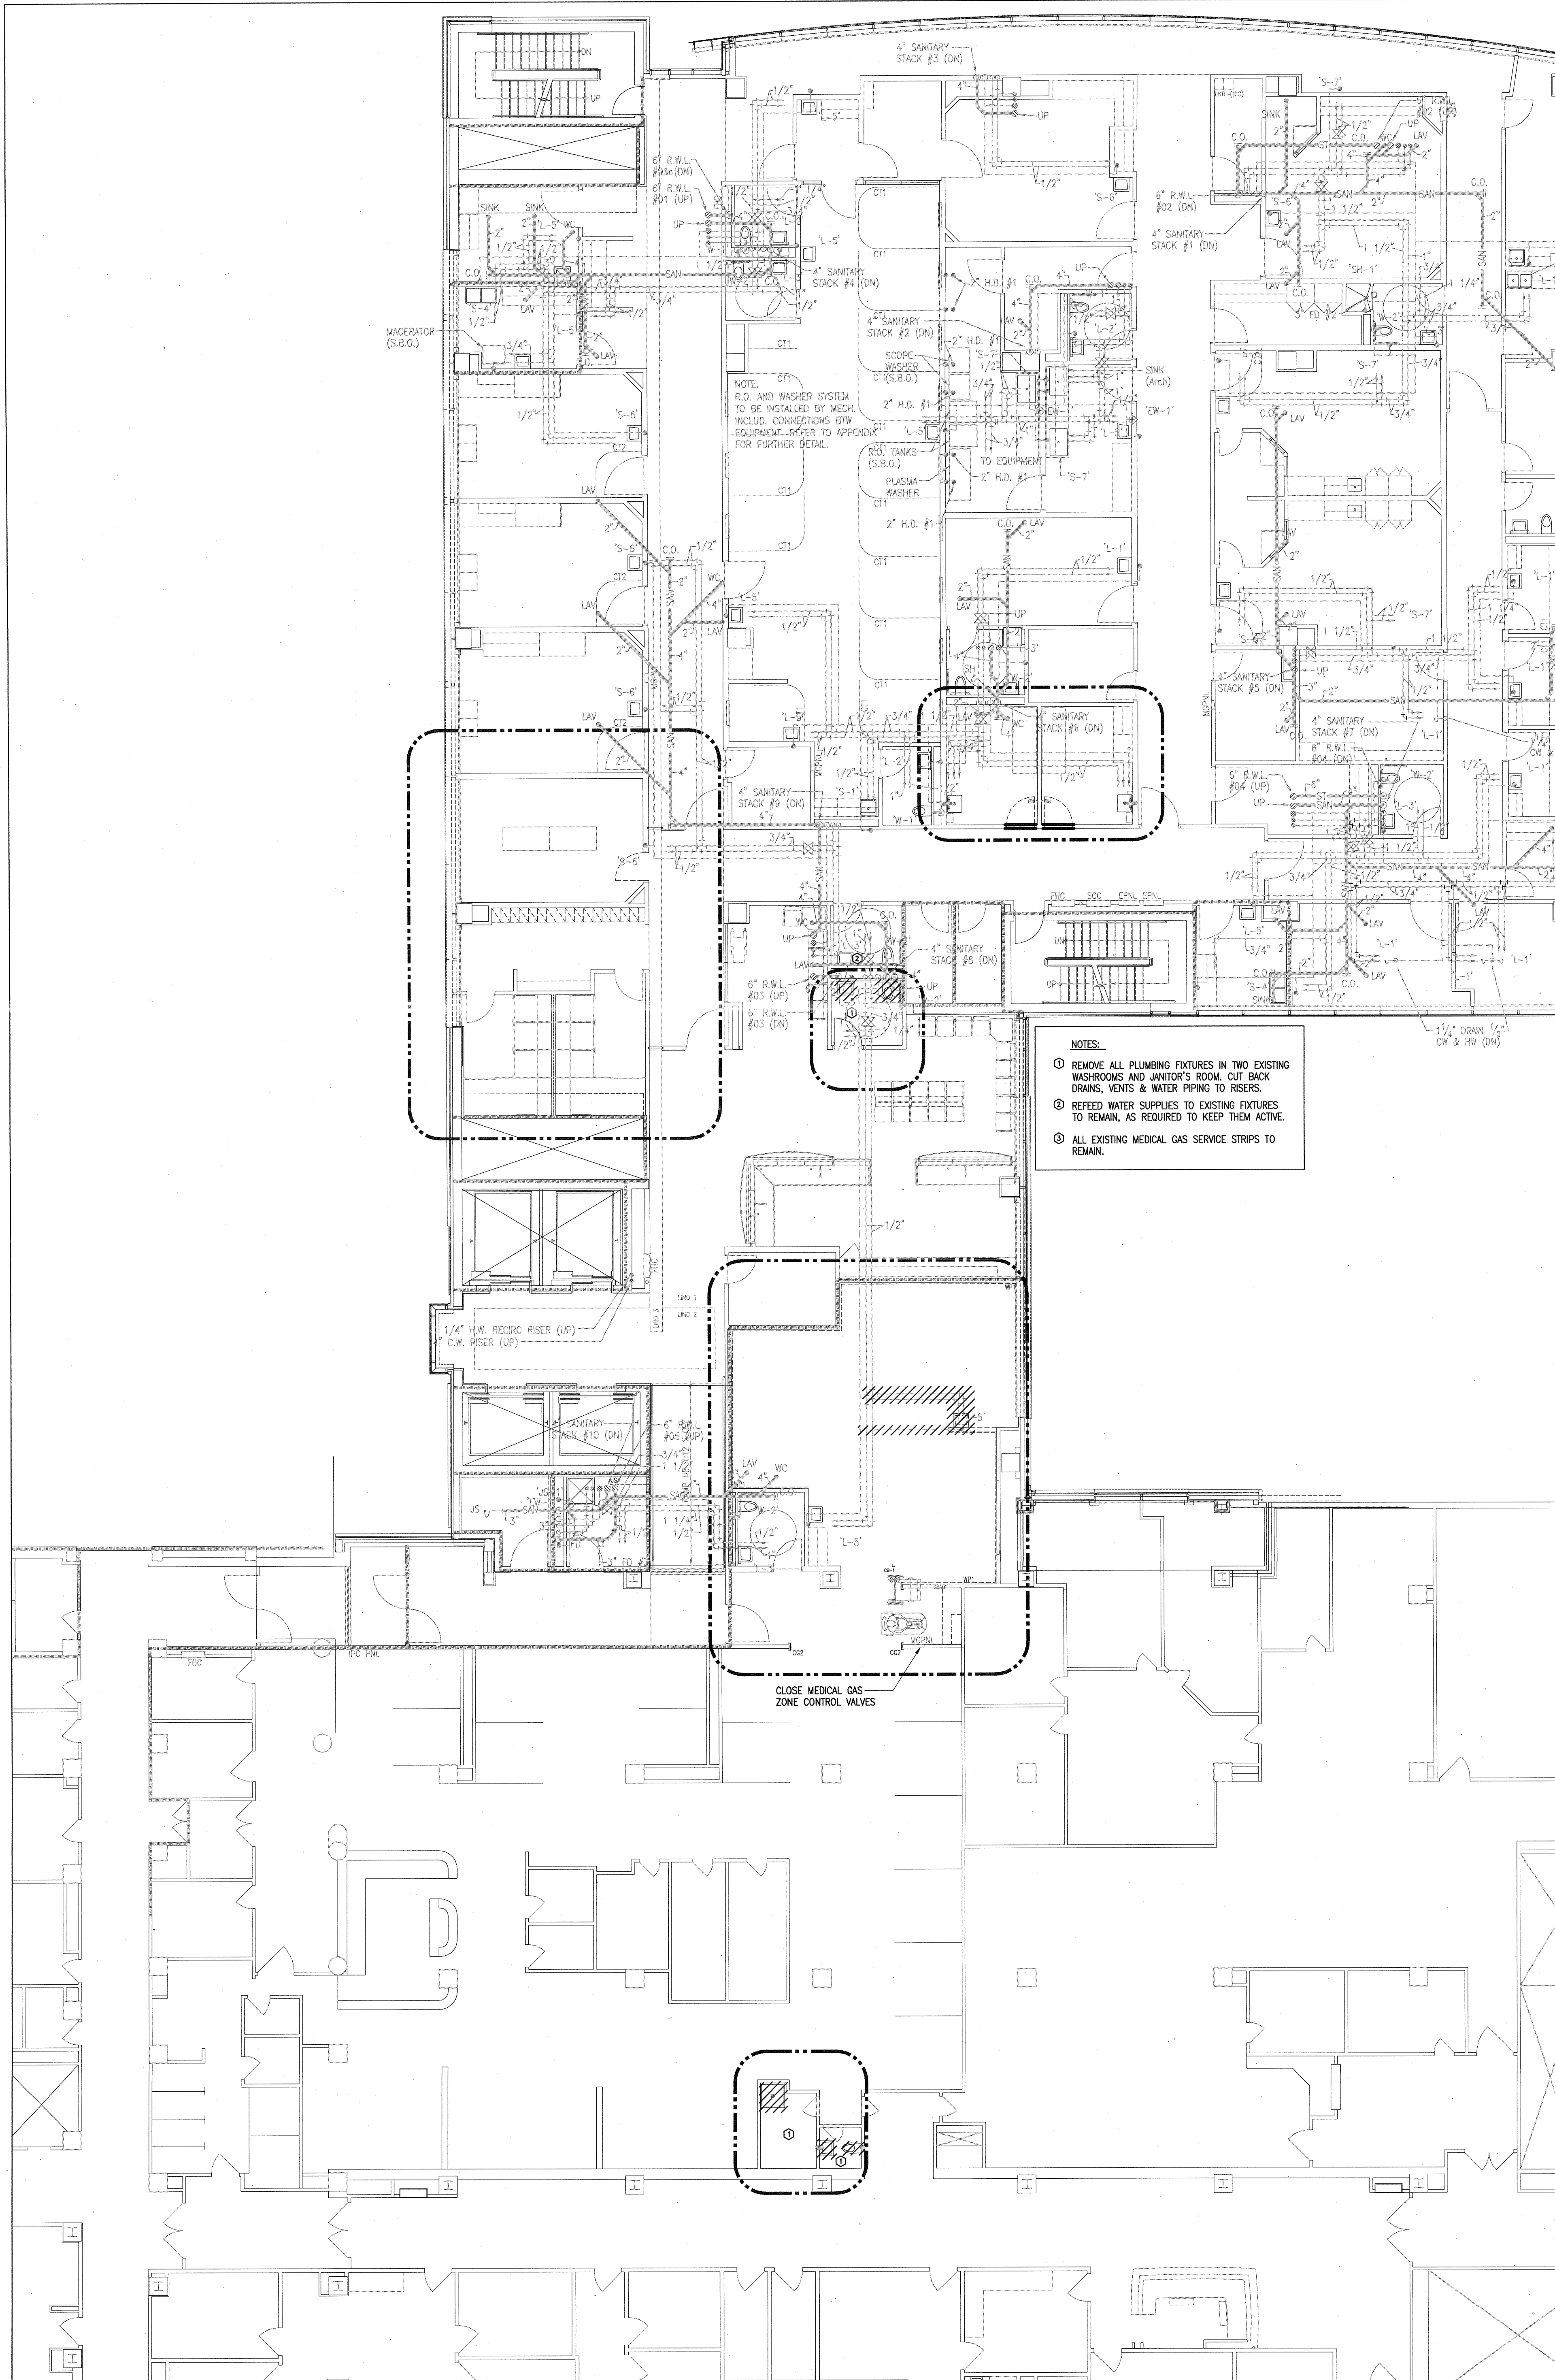

1 FOURTH FLOOR PLUMBING DEMOLITION PLAN
M202 1:100

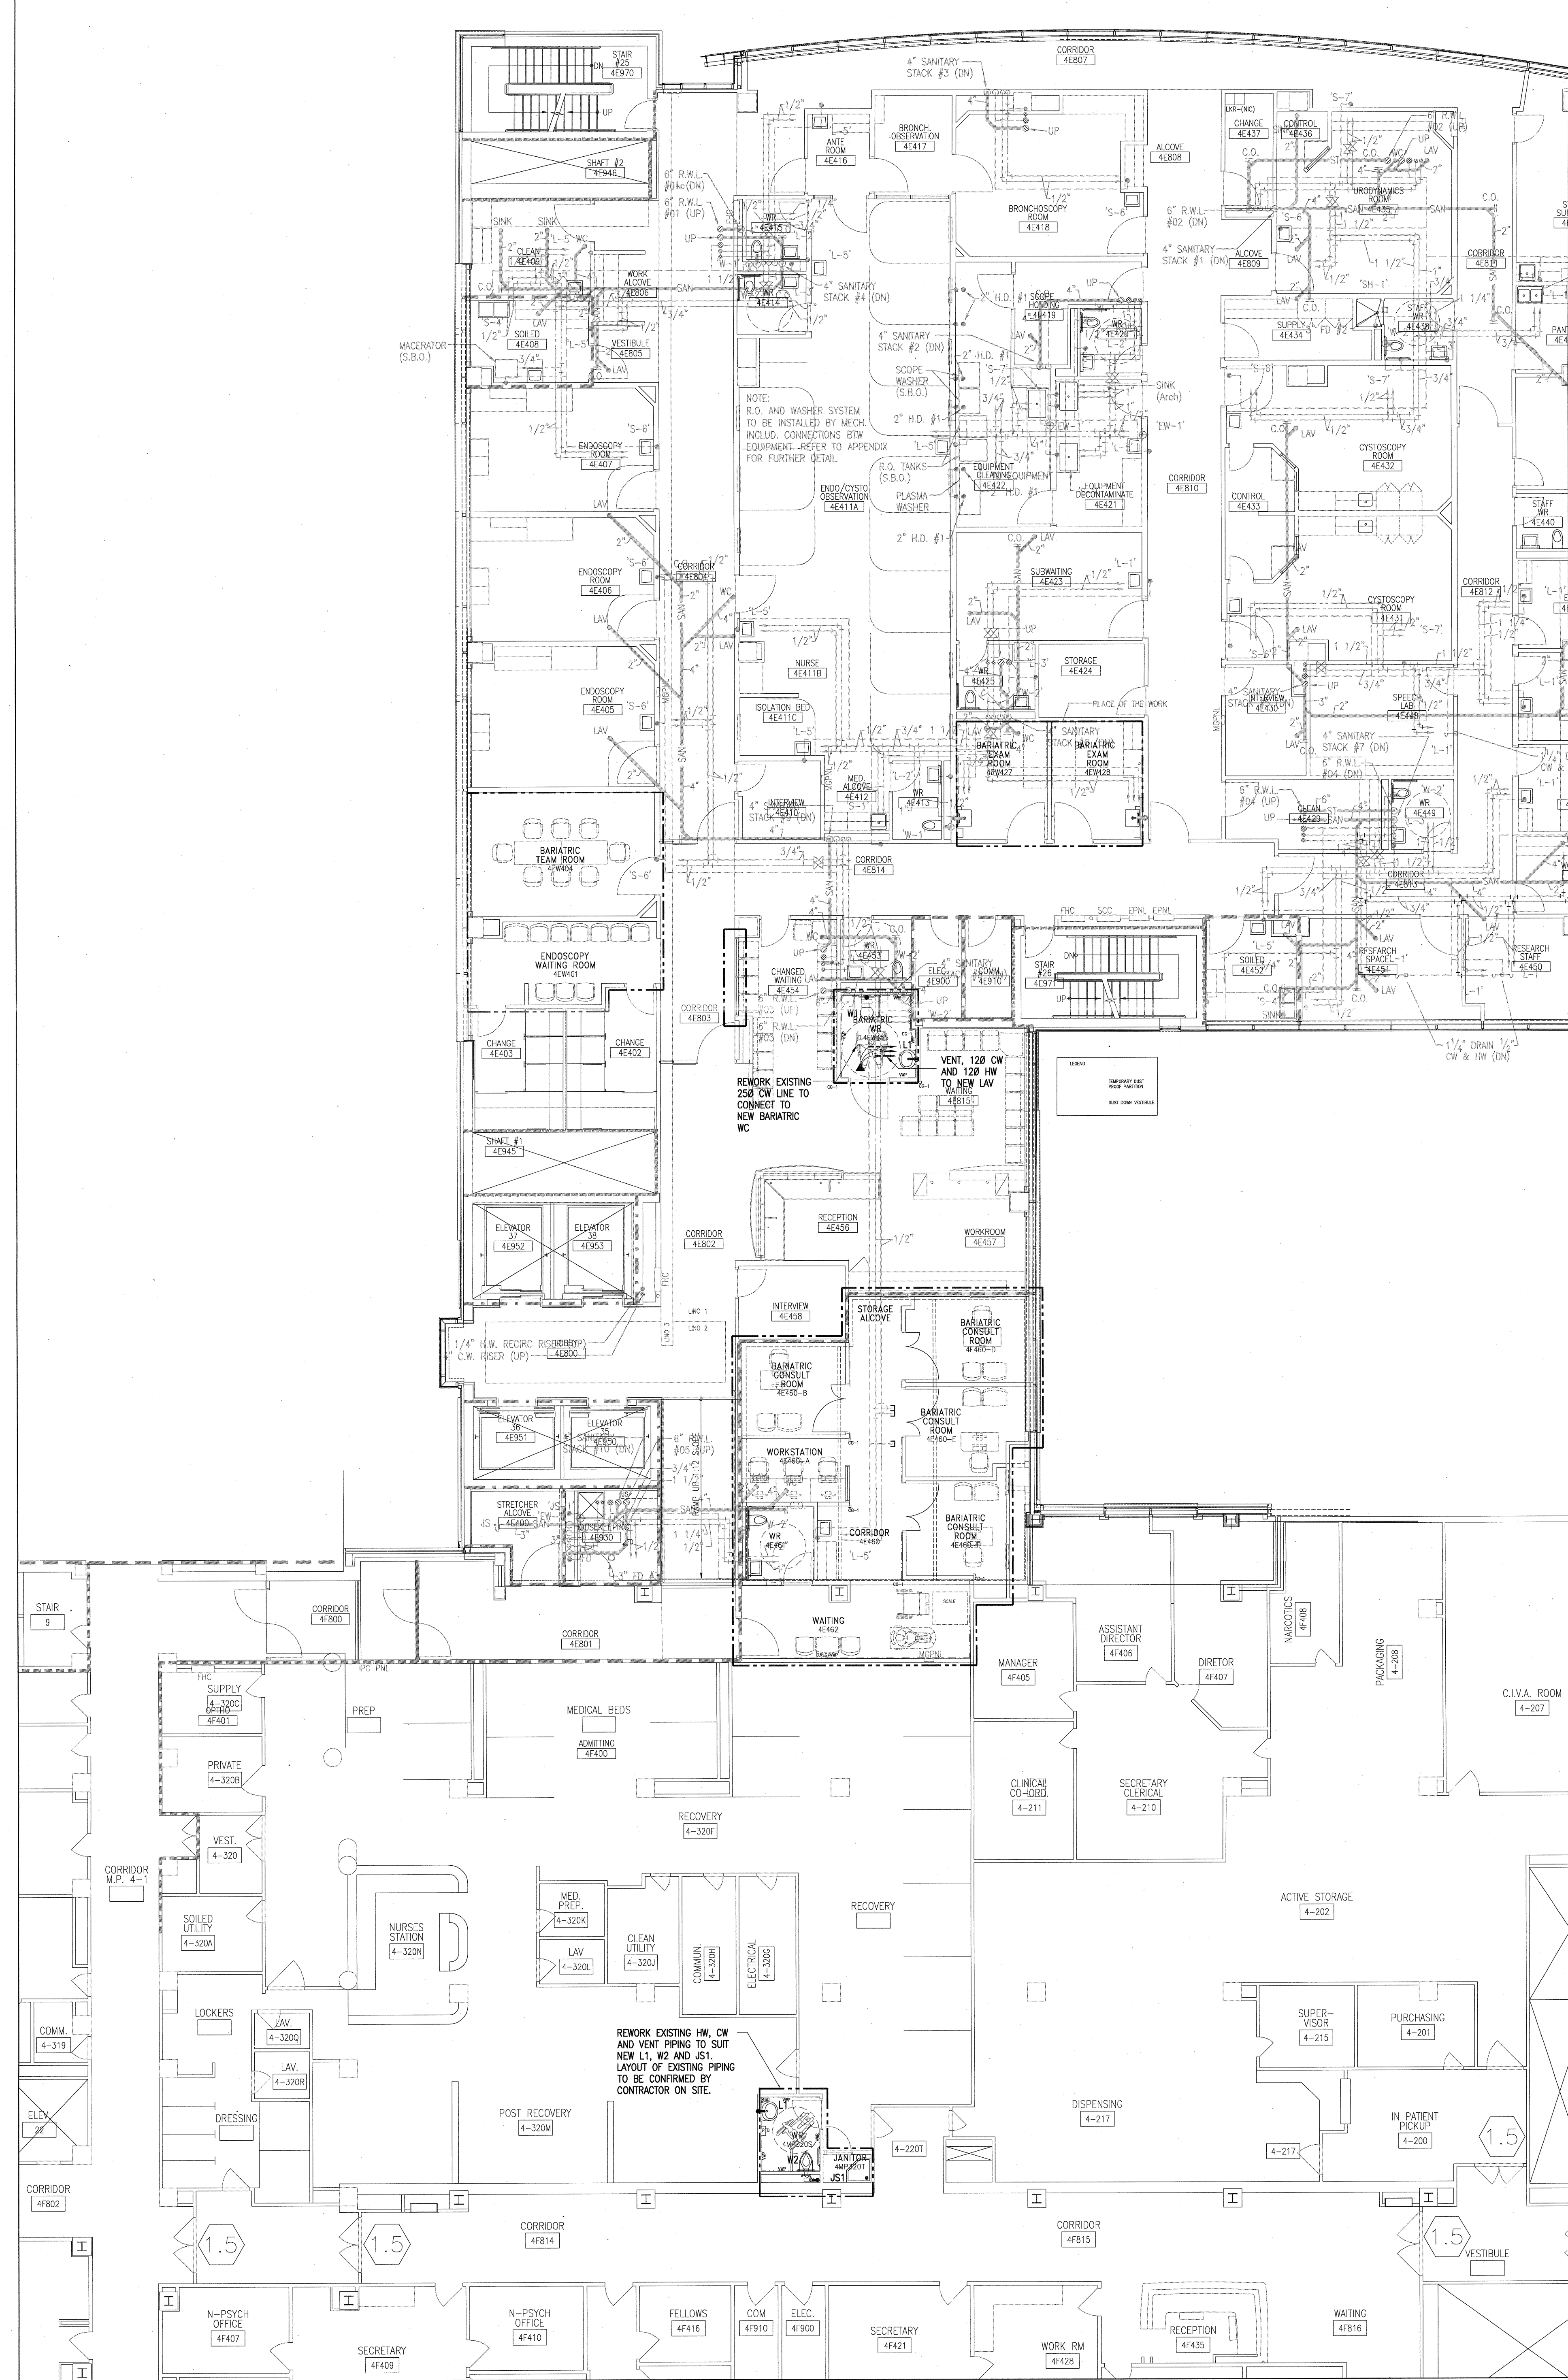


2 FOURTH FLOOR PLUMBING NEW WORK PLAN
M202 1:100

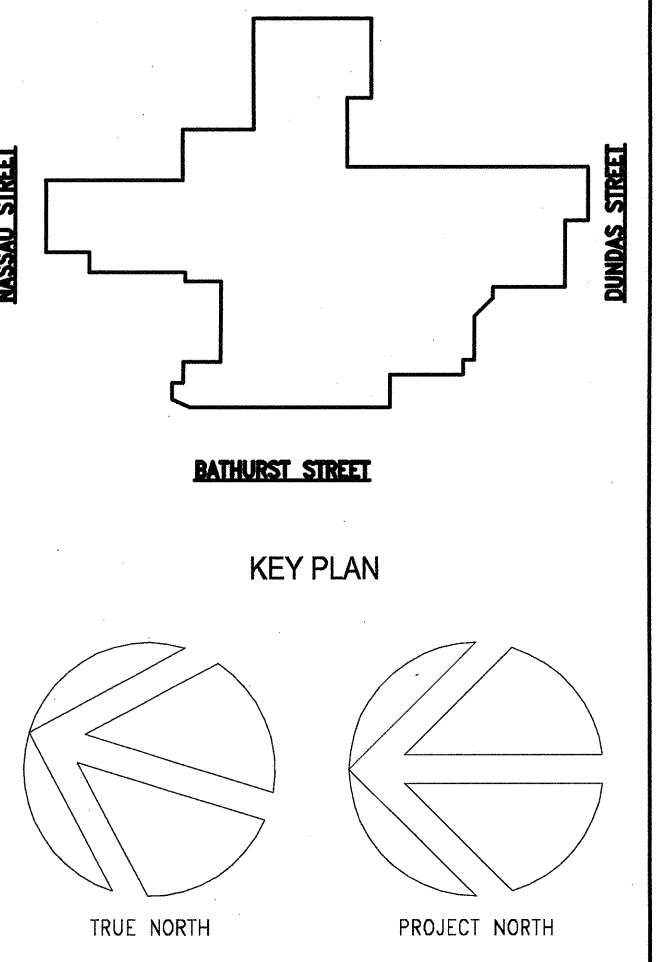

No.	Description	Date
1.	ISSUED FOR TENDER - PERMIT	08/12/09
Revisions:		

All measurements are to be checked and verified on site by the contractor before proceeding with the work.
Do not scale the drawings.

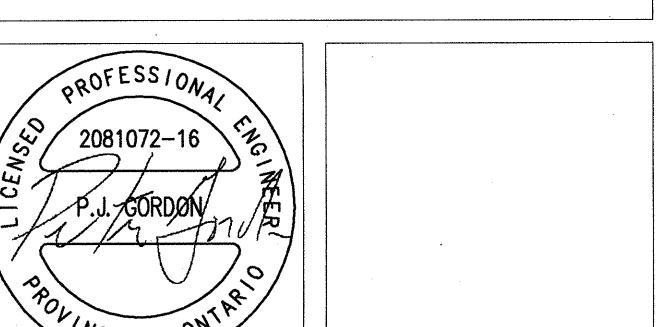


Consultants:
R.H. Angus & Associates Limited Consulting Engineers
1127 Leslie Street, Toronto, Ontario, M3C 2J6 Canada
T: (416) 443-8200 F: (416) 443-8290 www.rhangu.com

Project:
UNIVERSITY HEALTH NETWORK
TORONTO WESTERN HOSPITAL
BARIATRIC PROGRAM
RENOVATION PROJECT

Drawn By: R.D. Date: DECEMBER 2009
Checked By: P.G. Scale: 1:100

Sheet Title:
FOURTH FLOOR PLAN
PLUMBING
DEMOLITION & NEW WORK


Sheet Number:
M-202

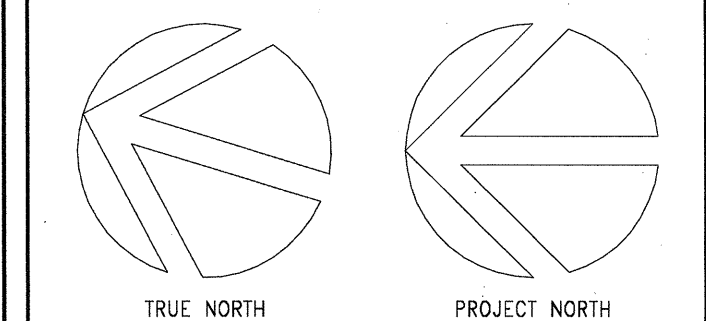

I..	ISSUED FOR TENDER - PERMIT	08/12/09
No.	Description	Date
Revisions:		

All measurements are to be checked and verified on site by the contractor before proceeding with the work.

Do not scale the drawings.

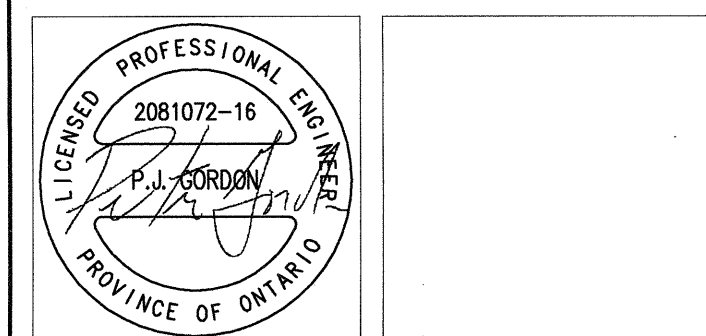

Consultants:

 **H.H. Angus & Associates Limited Consulting Engineers**
1127 Leslie Street, Toronto, Ontario, M3C 2J8 Canada
T (416) 416 443 8200 F (416) 416 443 8290 www.hhangus.com



Project:


UNIVERSITY HEALTH NETWORK
TORONTO WESTERN HOSPITAL
BARIATRIC PROGRAM
RENOVATION PROJECT

Drawn By: R.D.	Date: DECEMBER 2009
Checked By: P.G.	Scale: 1:50


9TH FLOOR PLAN
PLUMBING & MEDICAL GASES
DEMOLITION & NEW WORK

Sheet Number:
M-203

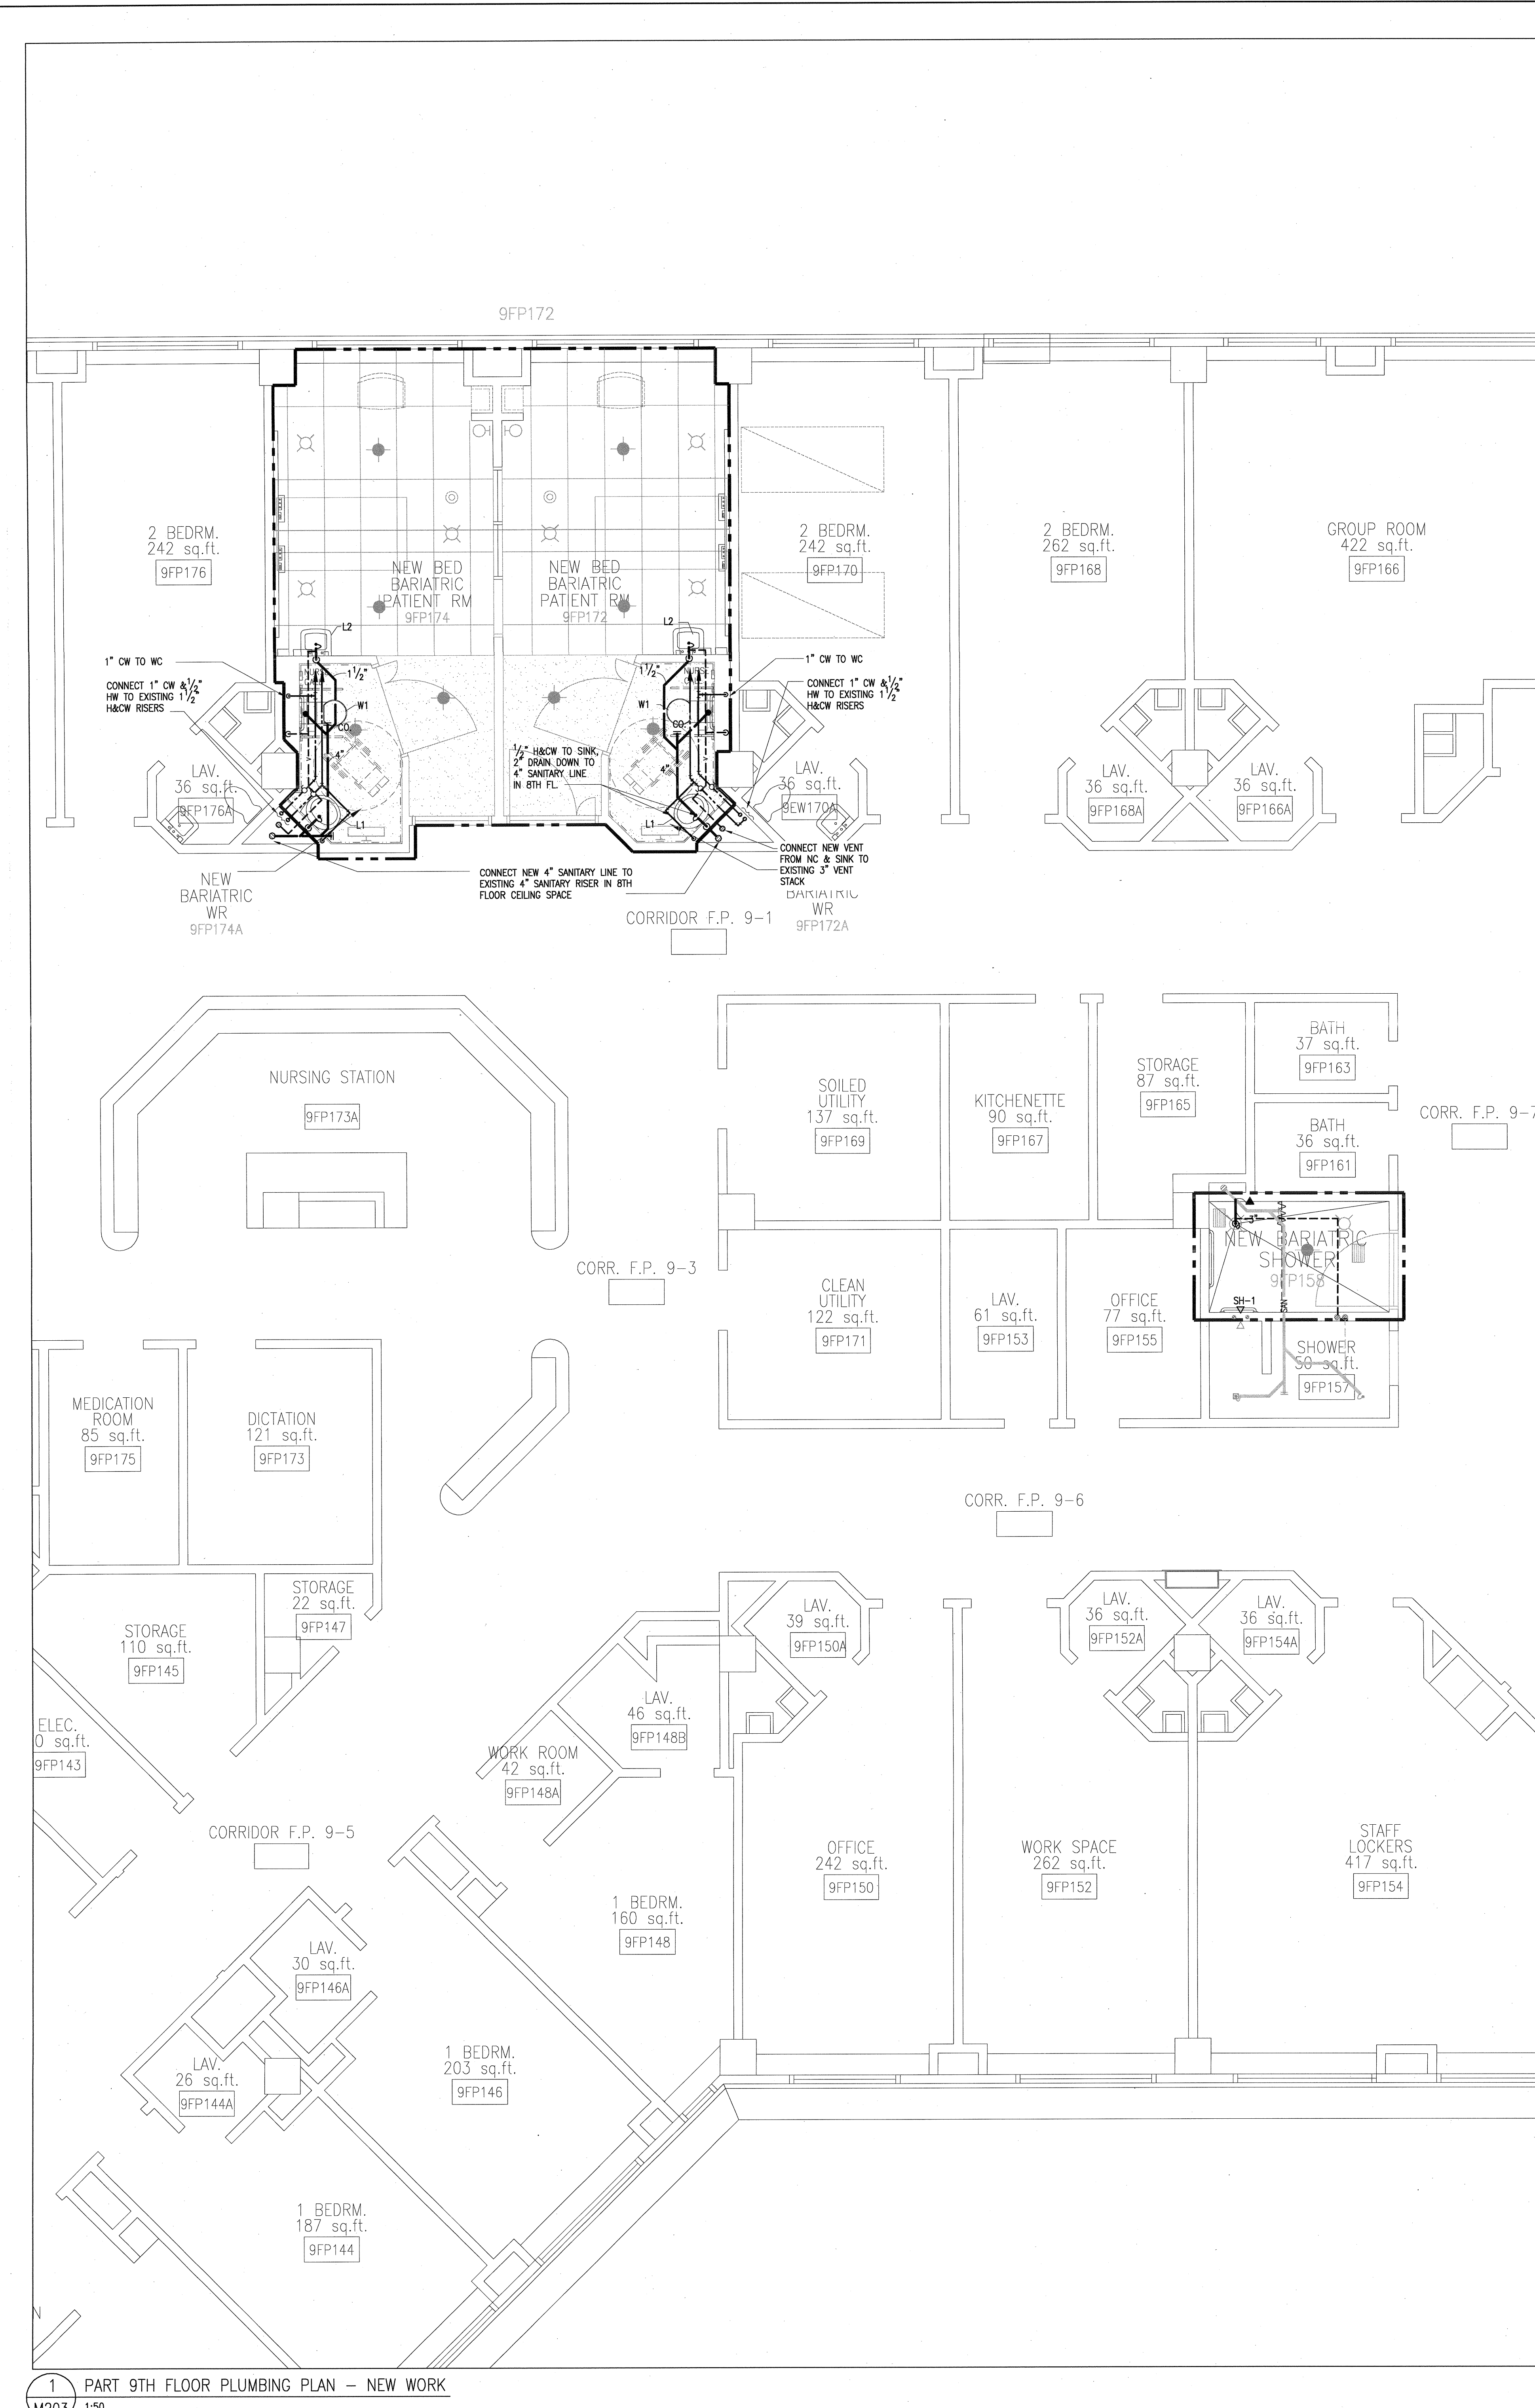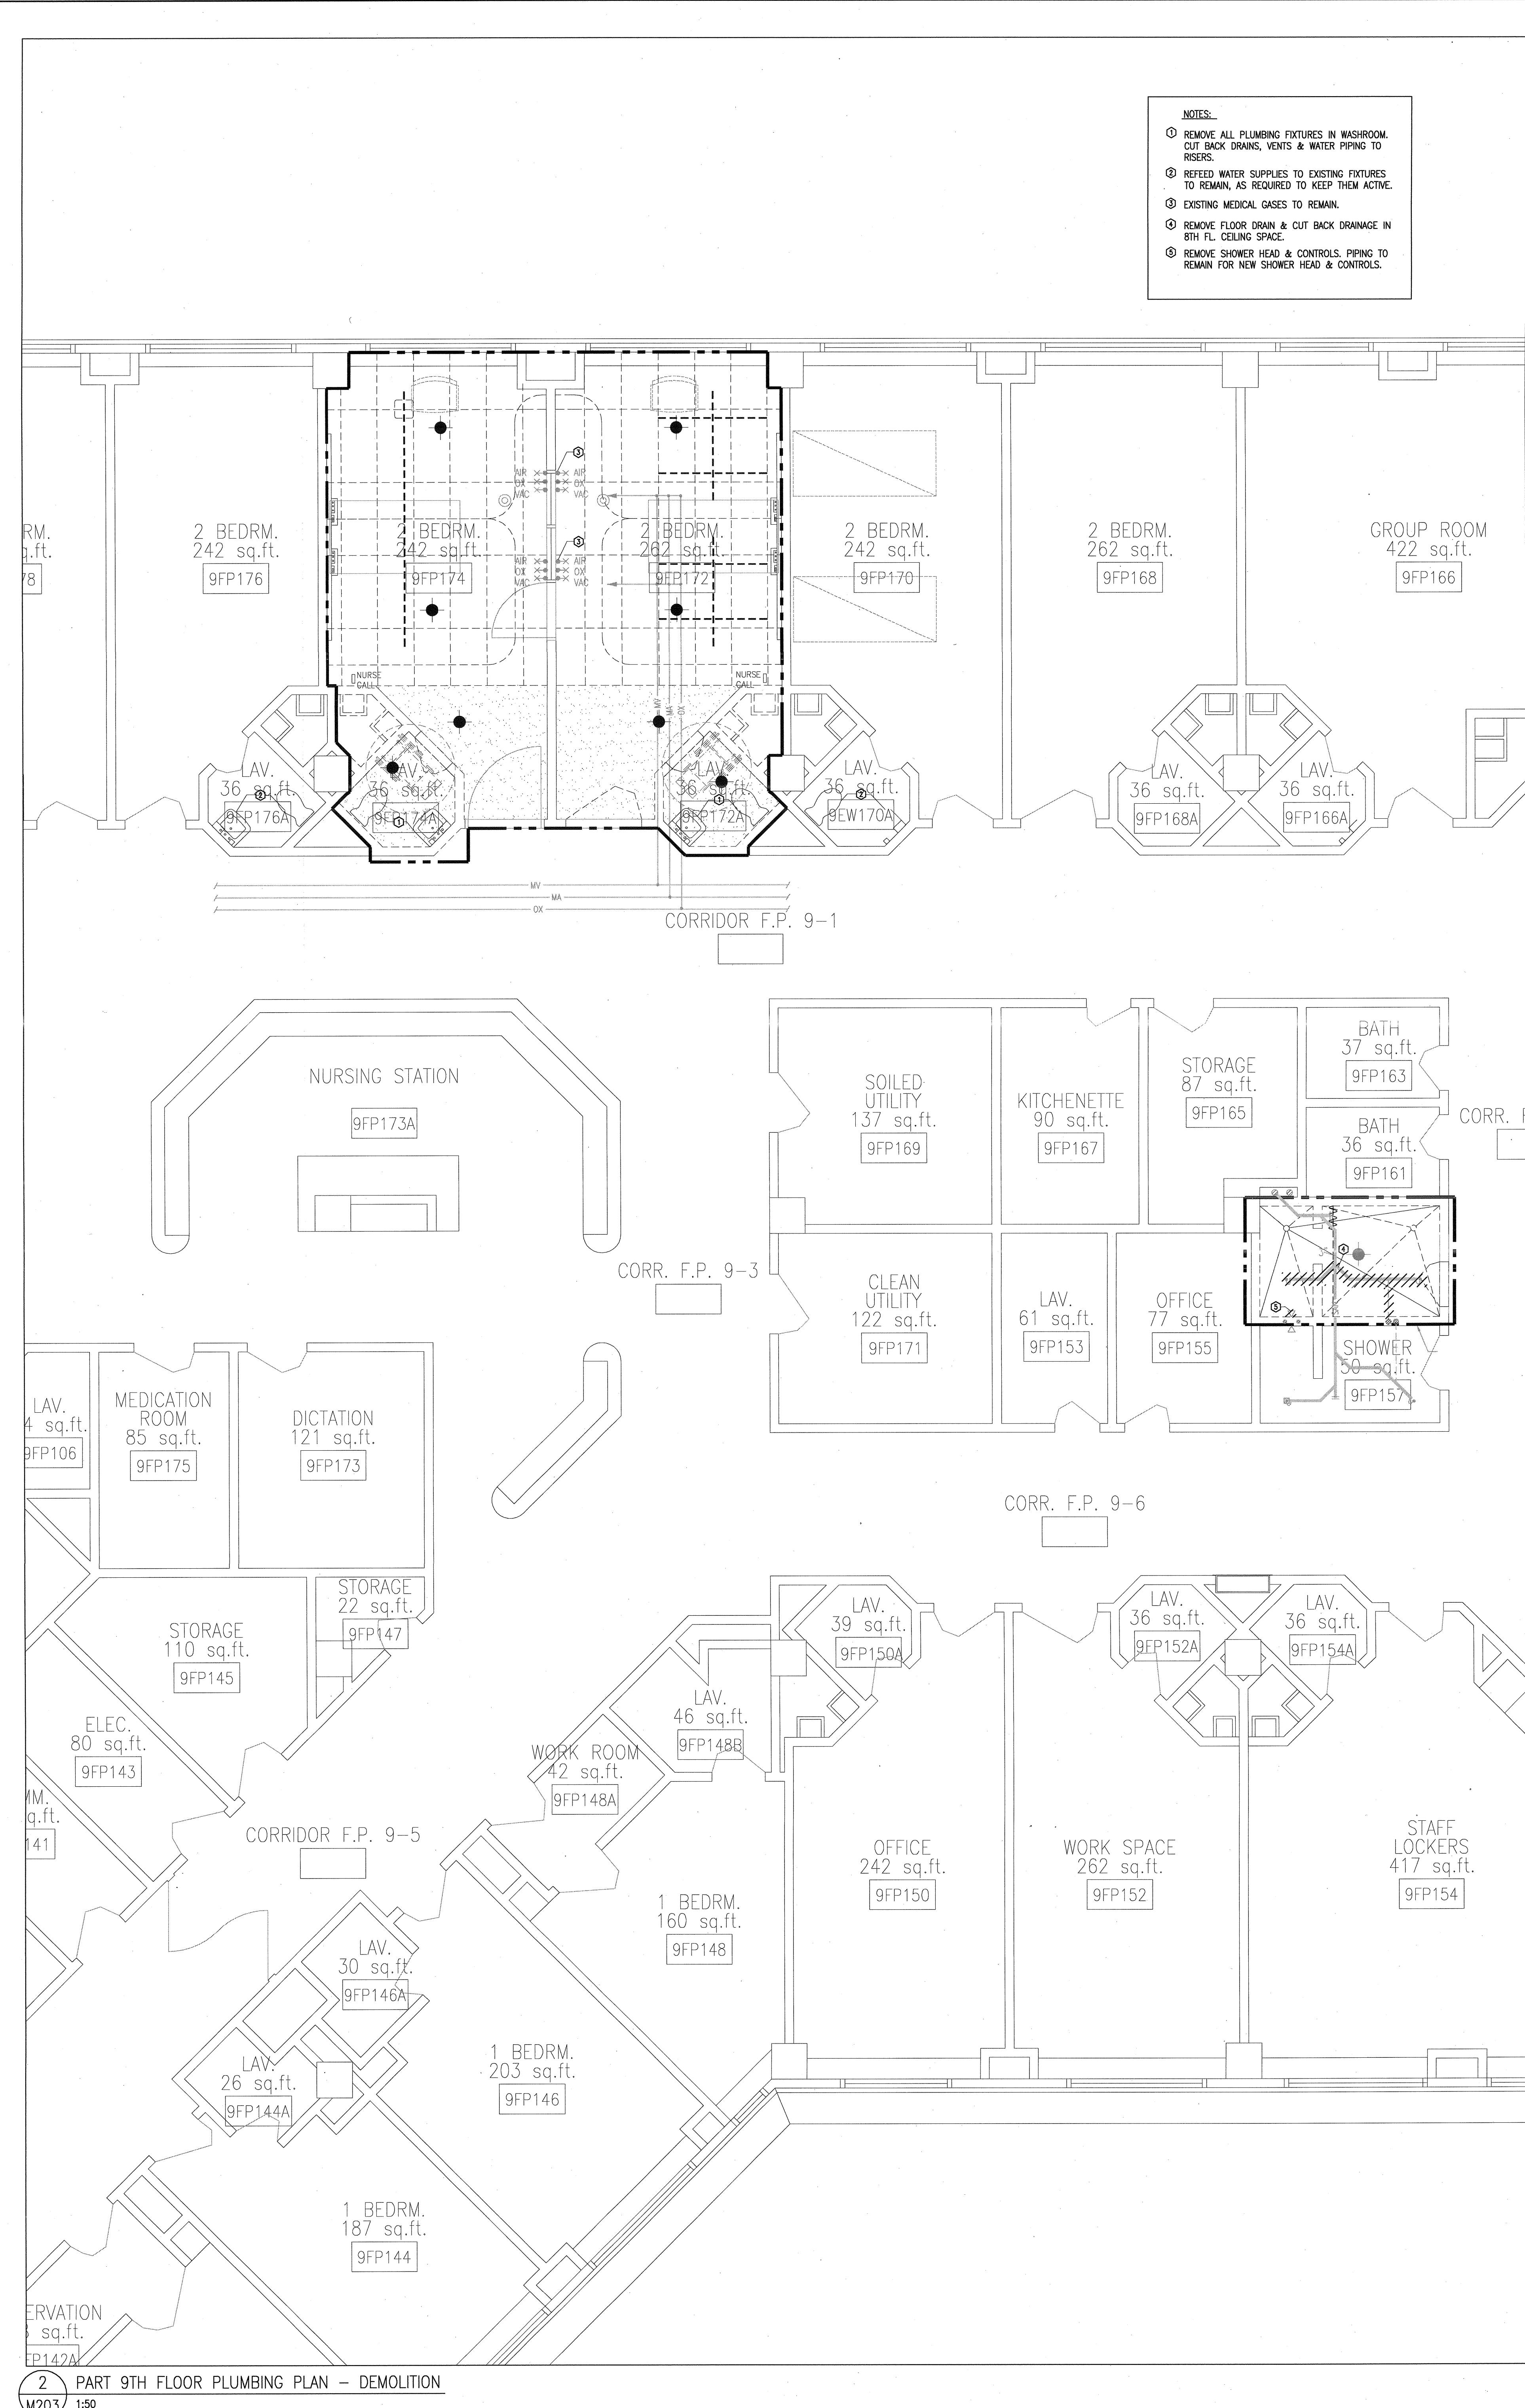


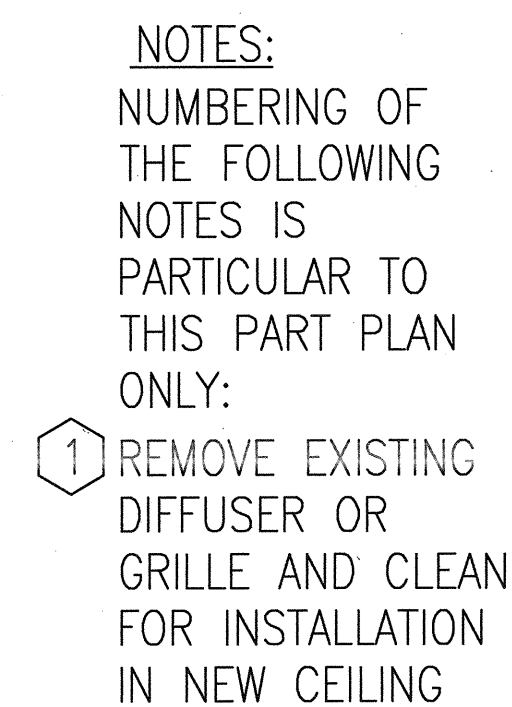

1 FOURTH FLOOR VENTILATION DEMOLITION PLAN
M301 1:50

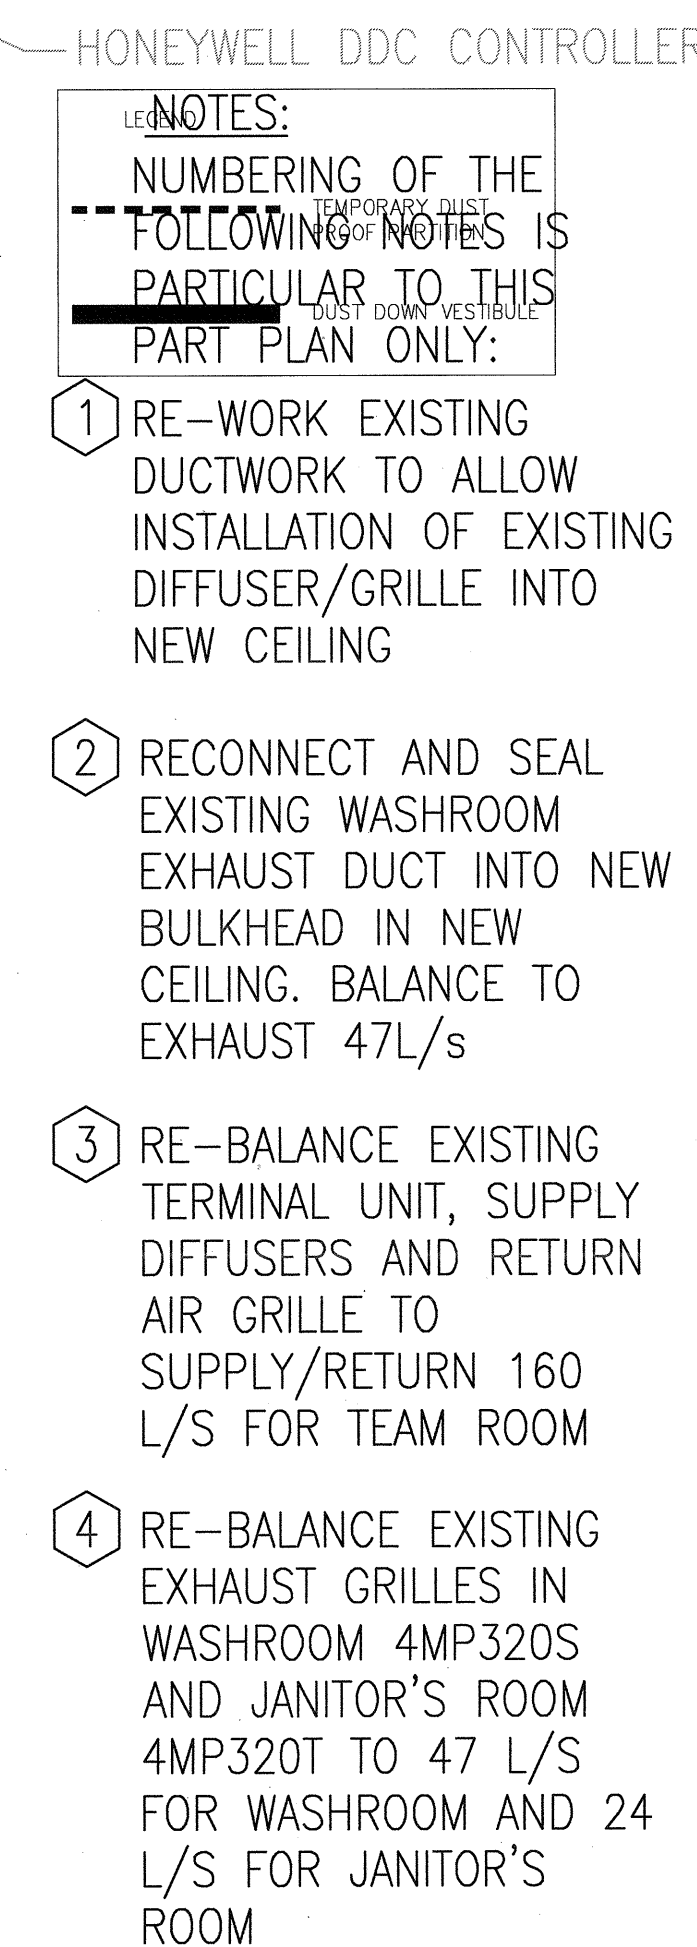

2 FOURTH FLOOR VENTILATION NEW WORK PLAN
M301 1:50

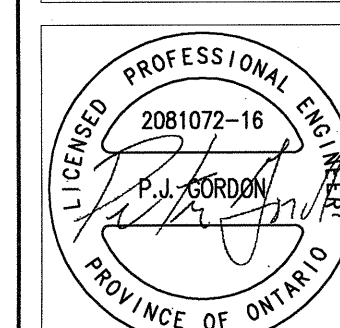

Consultants:

 **H.H. Angus & Associates Limited Consulting Engineers**
1127 Leslie Street, Toronto, Ontario, M3C 2J6 Canada
T (1) 416 443 8200 F (1) 416 443 8290 www.hhangry.com

Project:

UNIVERSITY HEALTH NETWORK
TORONTO WESTERN HOSPITAL
BARIATRIC PROGRAM
RENOVATION PROJECT


Drawn By: ????	Date: DECEMBER 2009
Checked By: P.G.	Scale: 1:50


Sheet Title:

FOURTH FLOOR PLAN
VENTILATION
DEMOLITION & NEW WORK


Sheet Number:
M-301

M271

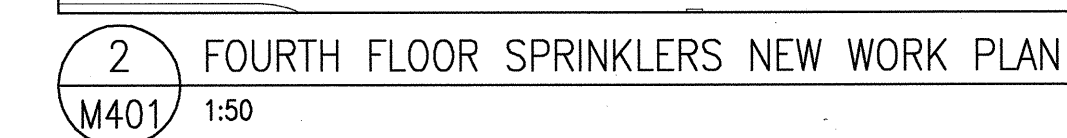

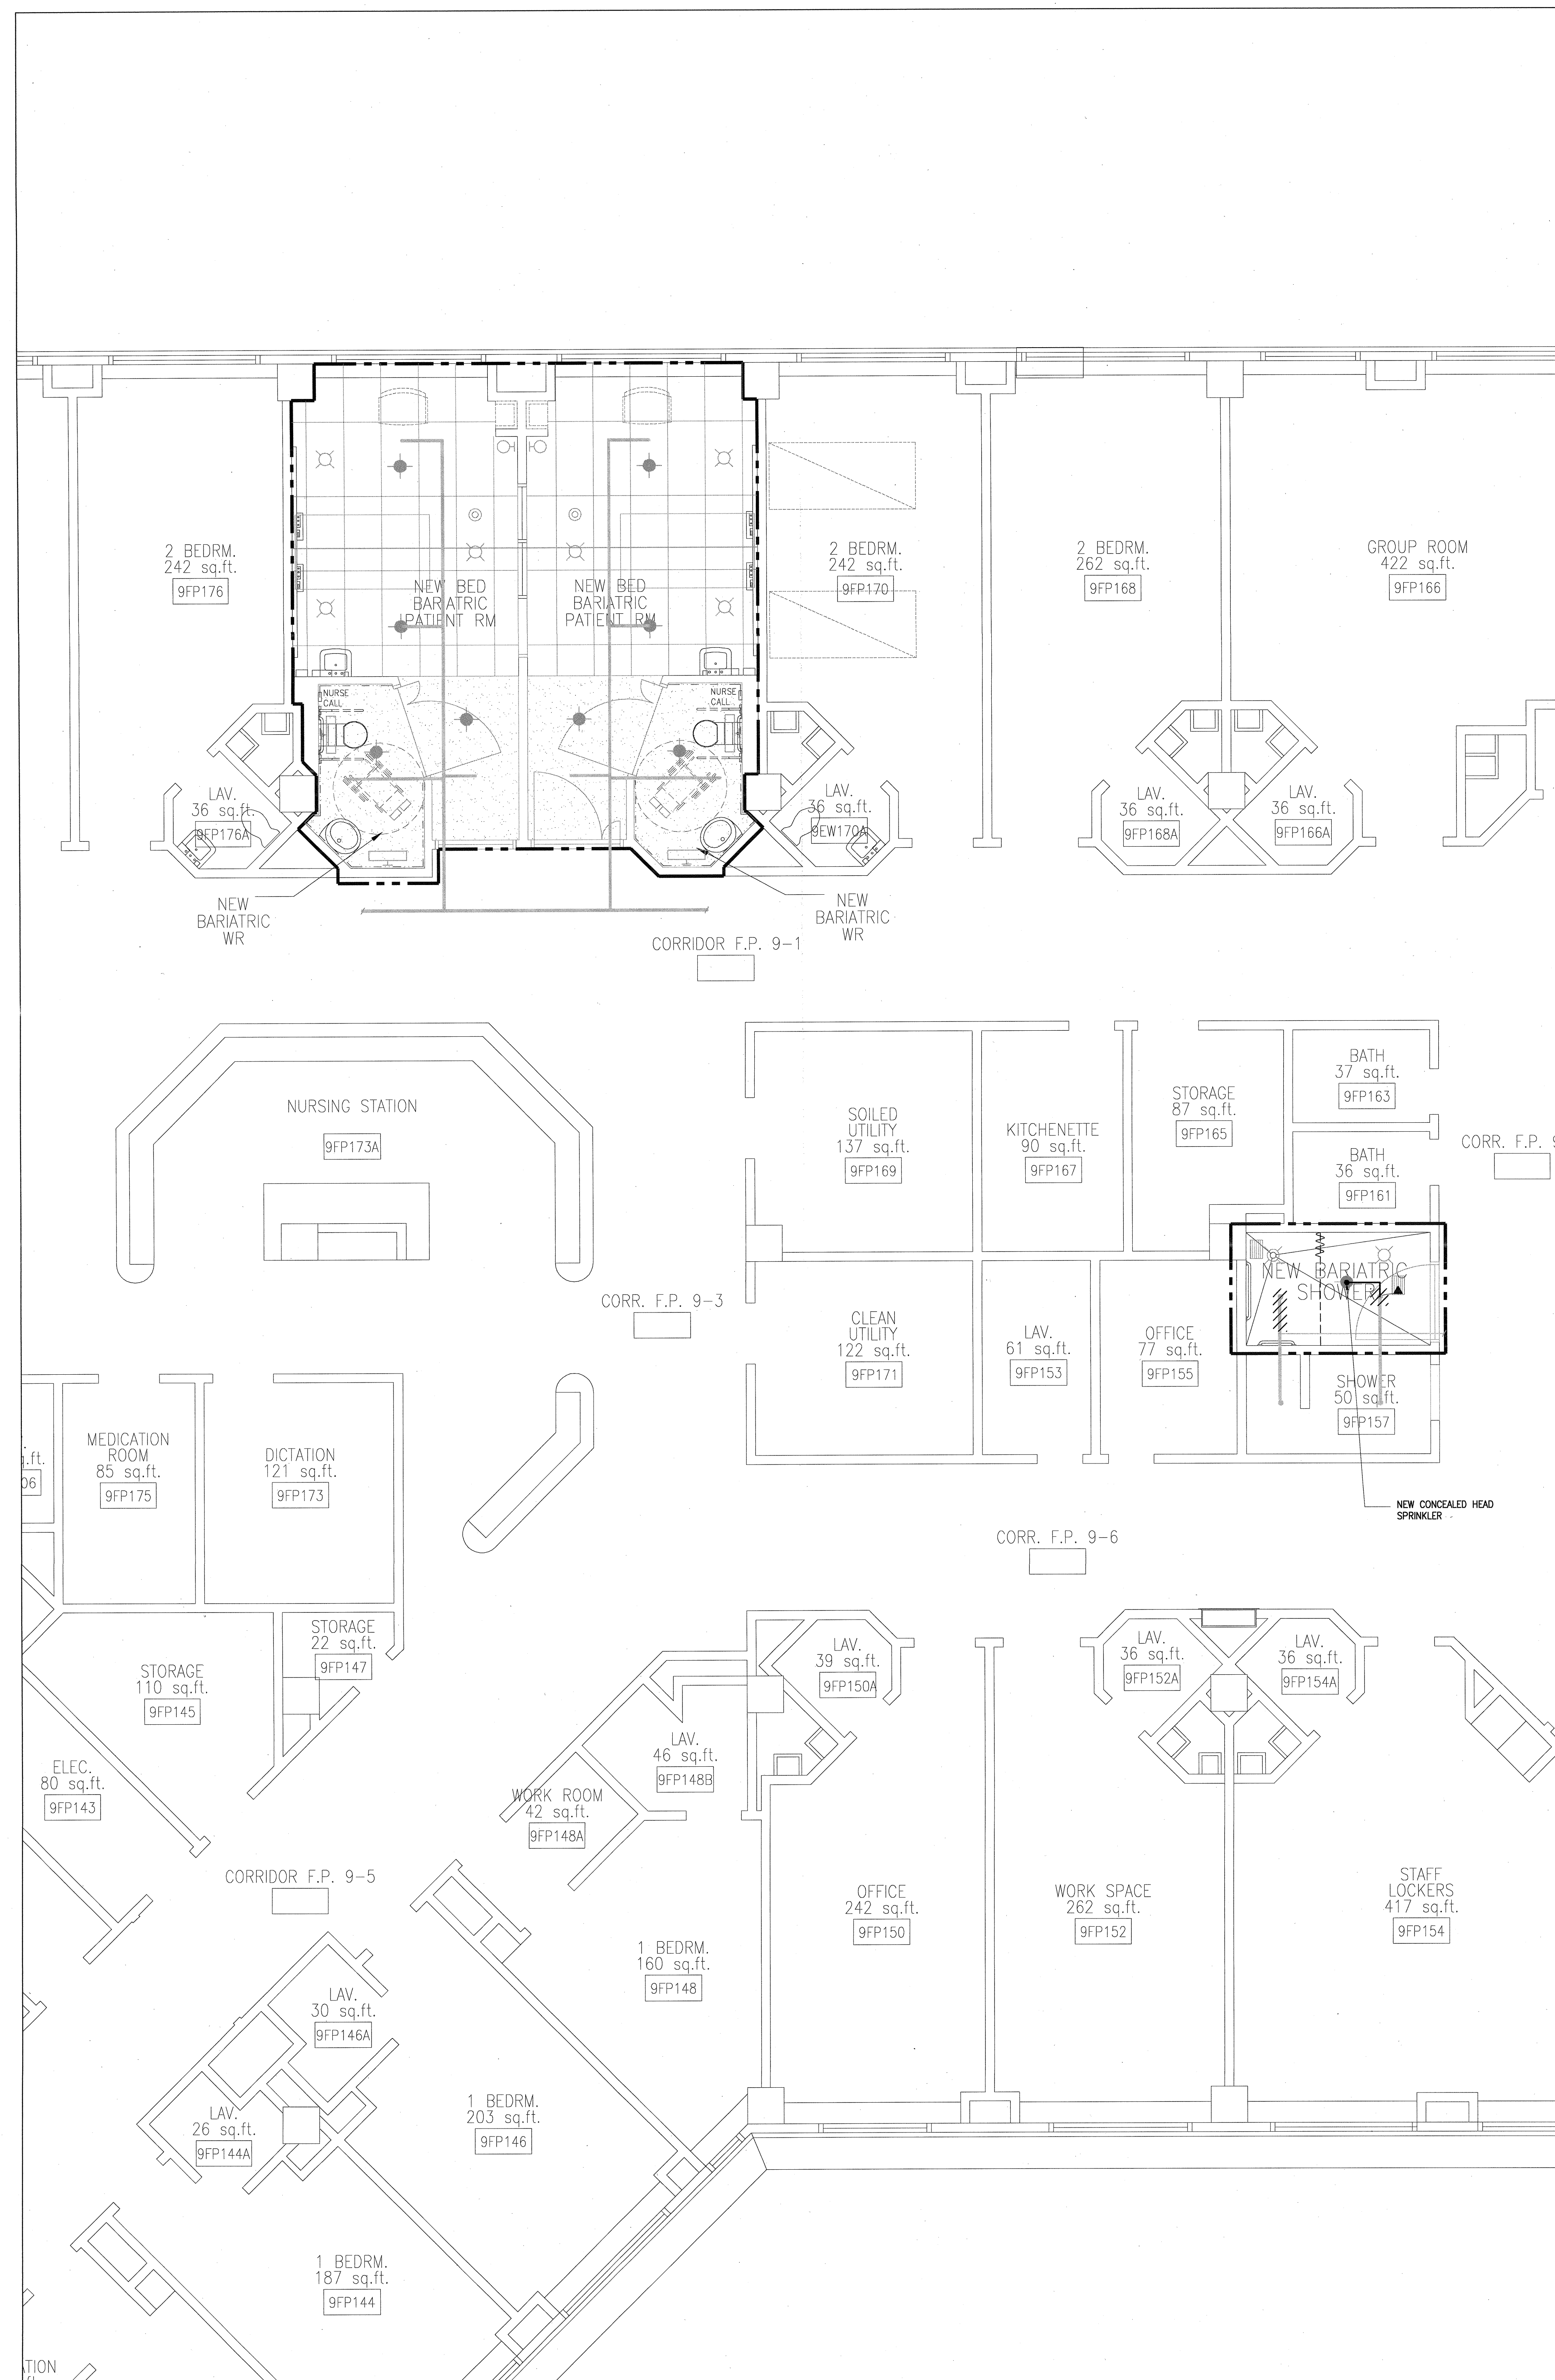

1 PART 9TH FLOOR SPRINKLER PLAN - DEMOLITION & NEW WORK
M402 1:50

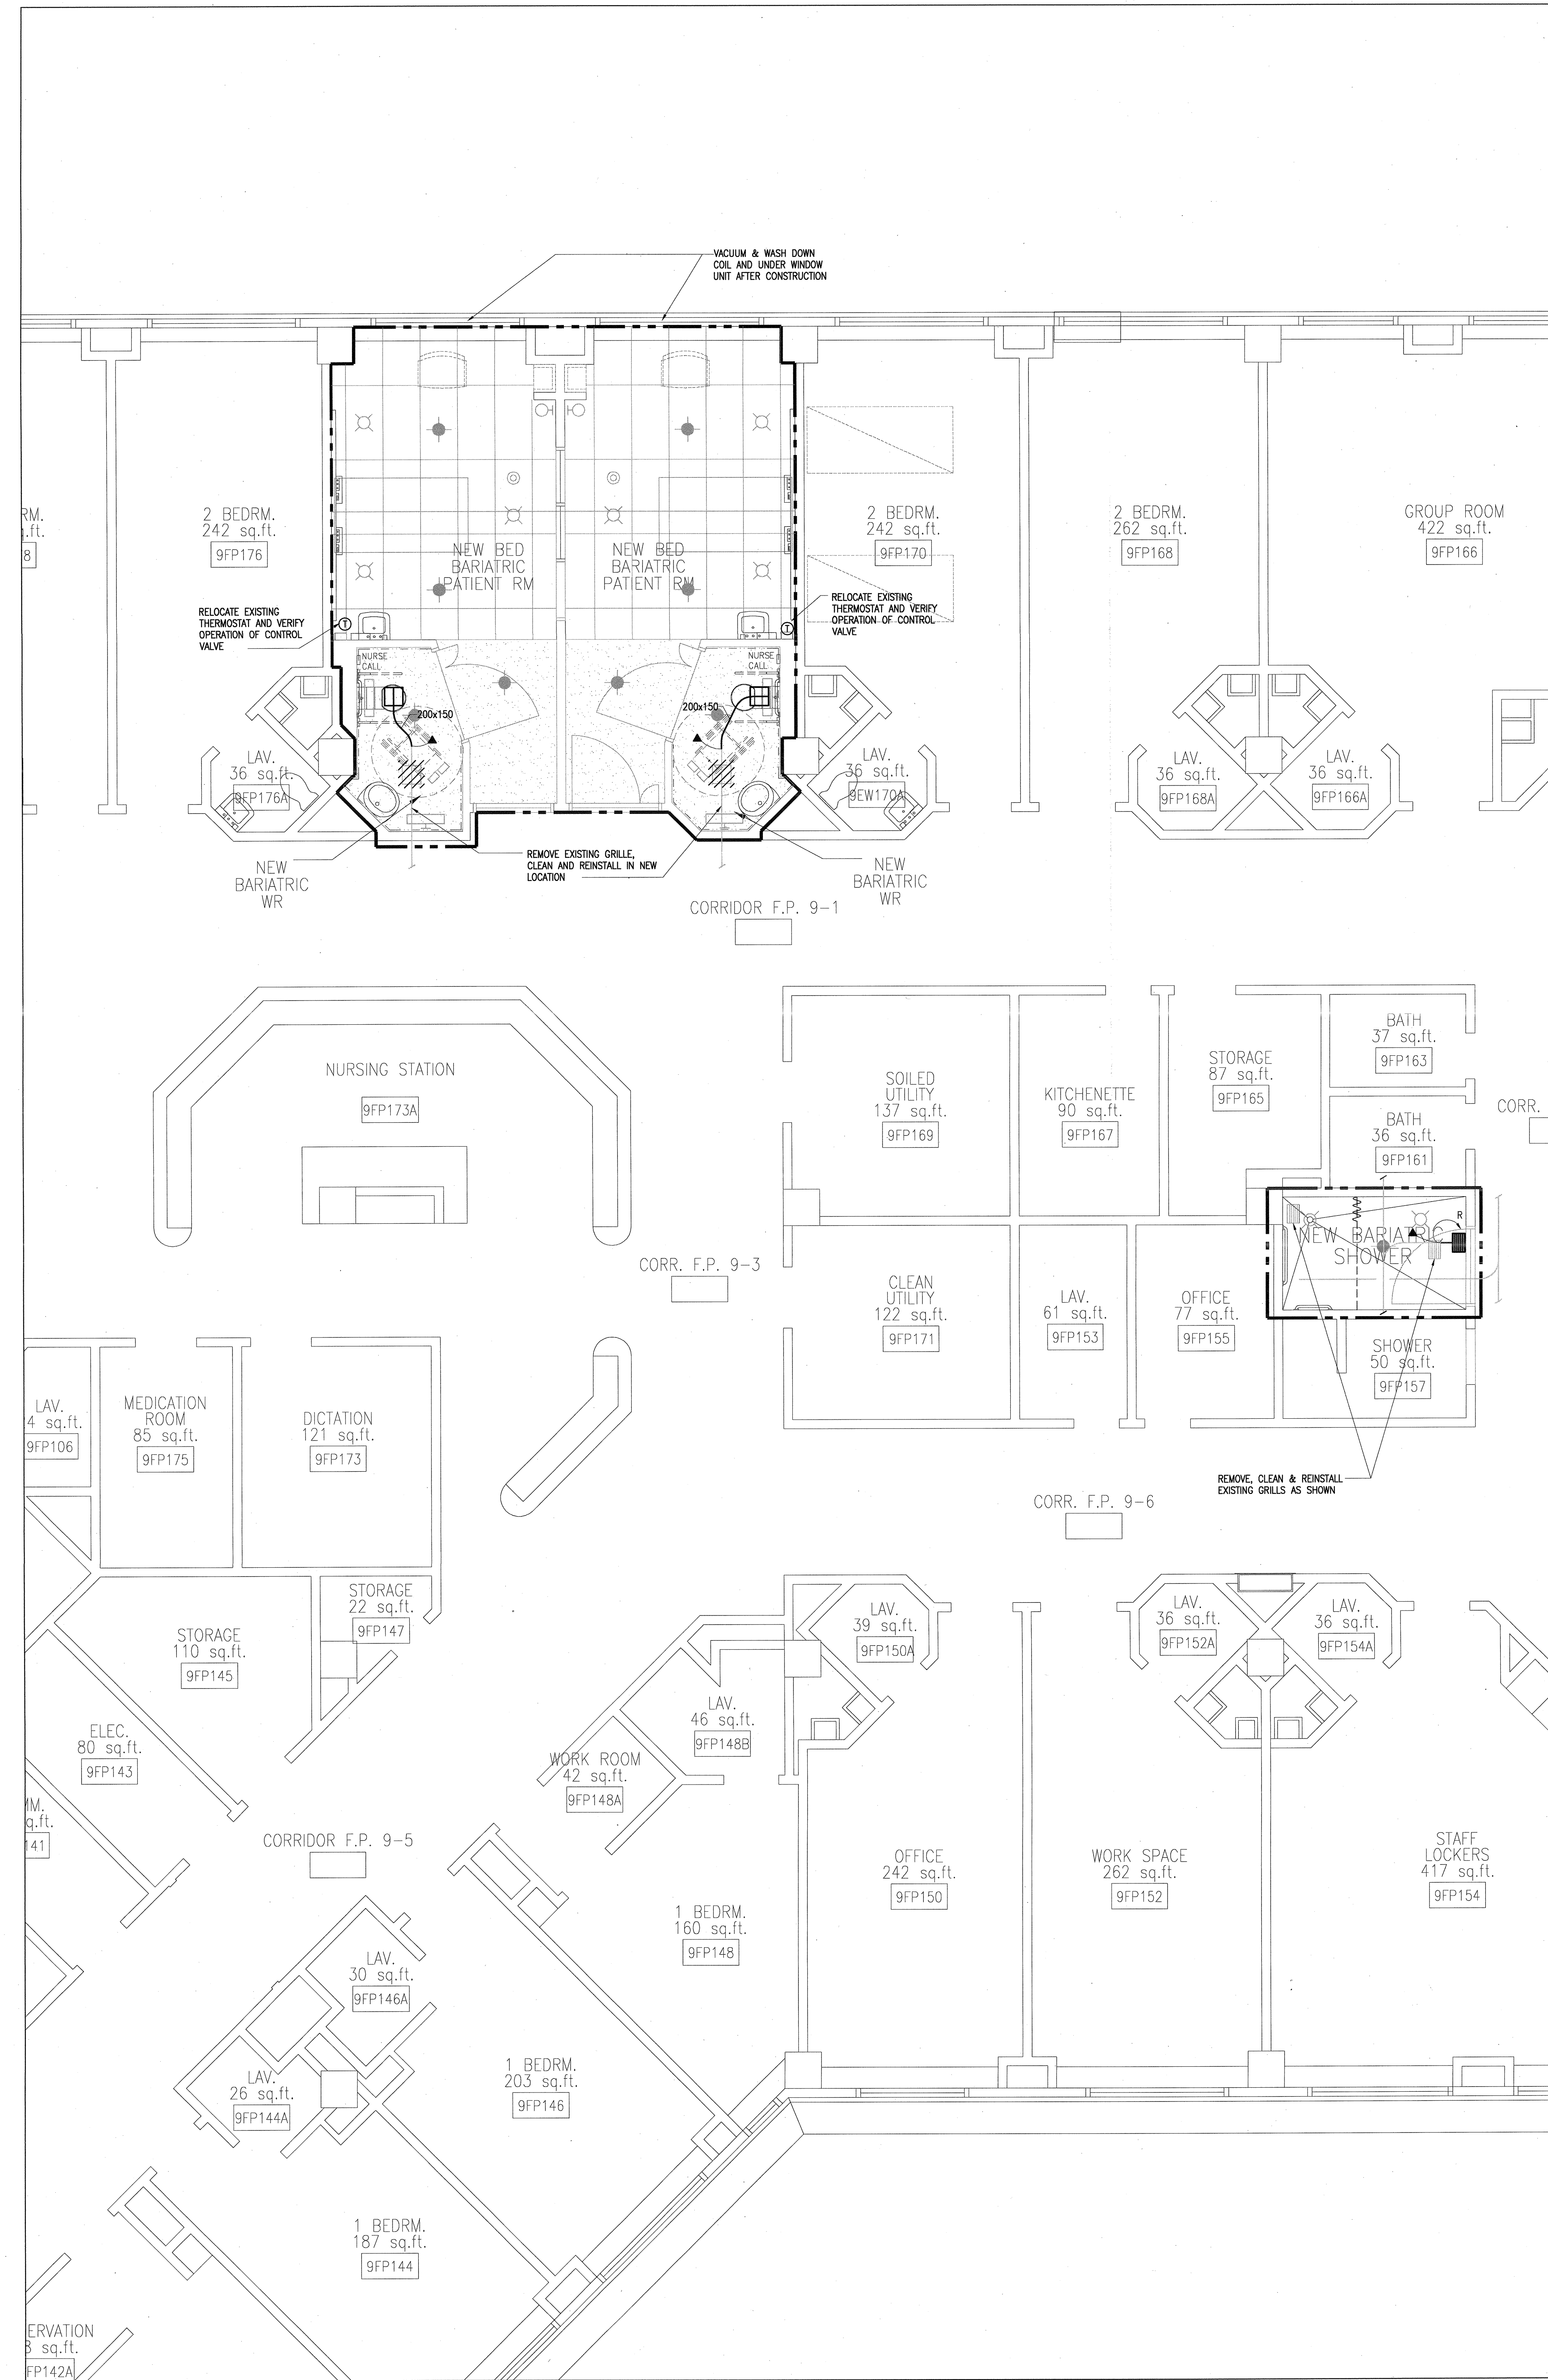

2 PART 9TH FLOOR VENTILATION PLAN - DEMOLITION & NEW WORK
M402 1:50

University Health Network
Toronto General Hospital, Toronto Western Hospital, Princess Margaret Hospital

KEY PLAN

TRUE NORTH PROJECT NORTH

No.	Description	Date
1.	ISSUED FOR TENDER - PERMIT	08/12/09

Revisions:

All measurements are to be checked and verified on site by the contractor before proceeding with the work.
Do not scale the drawings.

PARKIN
ARCHITECTS LIMITED

11000172-16-BR-000

CONSULTANTS:

R.H. Angus & Associates Limited Consulting Engineers
1127 Leslie Street, Toronto, Ontario, M4C 2J6, Canada
T: (416) 443-8200 F: (416) 443-8206 www.rhangu.com

Project:

**UNIVERSITY HEALTH NETWORK
TORONTO WESTERN HOSPITAL
BARIATRIC PROGRAM
RENOVATION PROJECT**

Drawn By: R.D. Date: DECEMBER 2009
Checked By: P.G. Scale: 1:50


Sheet Title:

**9TH FLOOR PLAN
SPRINKLER & VENTILATION
DEMOLITION & NEW WORK**

Sheet Number:


M-402

FILENAME: 210081072-16-BR-000.dwg
PLOTDATE: Dec 08, 2009 - 12:25pm

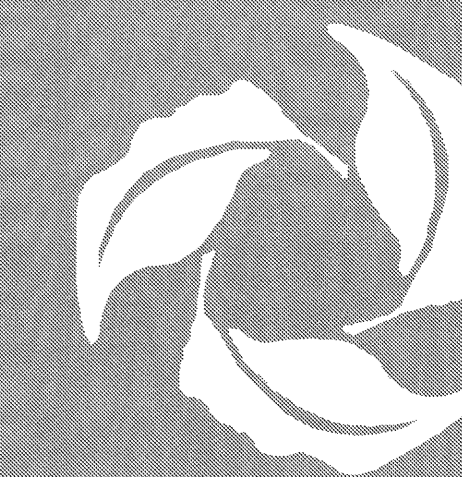

Toronto Western Hospital


University Health Network

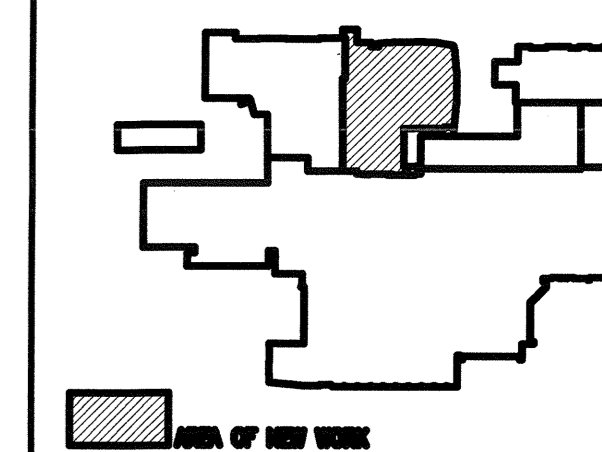

REF PLAN (12-2)

DATE	DESCRIPTION
15/07/04/30	ISSUED FOR AS-BUILT DRAWINGS
14/03/07/23	REVISED FOR CHANGE NOTICE M8
13/03/07/11	REVISED FOR SITE INSTRUCTION M5
12/03/06/20	ISSUED FOR CONSTRUCTION
11/03/06/12	REVISED FOR POST TENDER ADDENDUM M4
10/03/05/19	REVISED FOR POST TENDER ADDENDUM M1
9/03/05/8	REVISED FOR ADDENDUM M8
8/03/04/38	REVISED FOR ADDENDUM M8
7/03/04/11	REVISED FOR ADDENDUM M1
6/03/03/27	ISSUED FOR BUILDING PERMIT
5/03/03/27	ISSUED FOR GENERAL TENDER
4/03/03/18	ISSUED FOR GENERAL TENDER
3/03/02/29	ISSUED FOR BOX COSTING
2/02/11/7	ISSUED FOR BOX REVIEW
1/02/08/16	ISSUED FOR COSTING

CHECK AND VERIFY ALL DIMENSIONS BEFORE PROCEEDING WITH THE WORK.

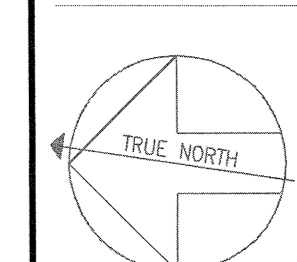

AS-BUILT DRAWINGS


PROJECT NAME:
TORONTO WESTERN HOSPITAL
EAST WING REDEVELOPMENT
MAIN BUILDING - STAGE TWO
TORONTO ONTARIO

DRAWING TITLE:
LOWER LEVEL FLOOR PLAN
LEVEL 1 FLOOR PLAN
PLUMBING

SCALE:
1 : 100
DATE:
MARCH 2003
DRAWN BY:
CHECKED BY:


PROJECT NUMBER:
2011210

DRAWING NUMBER:
M2-301

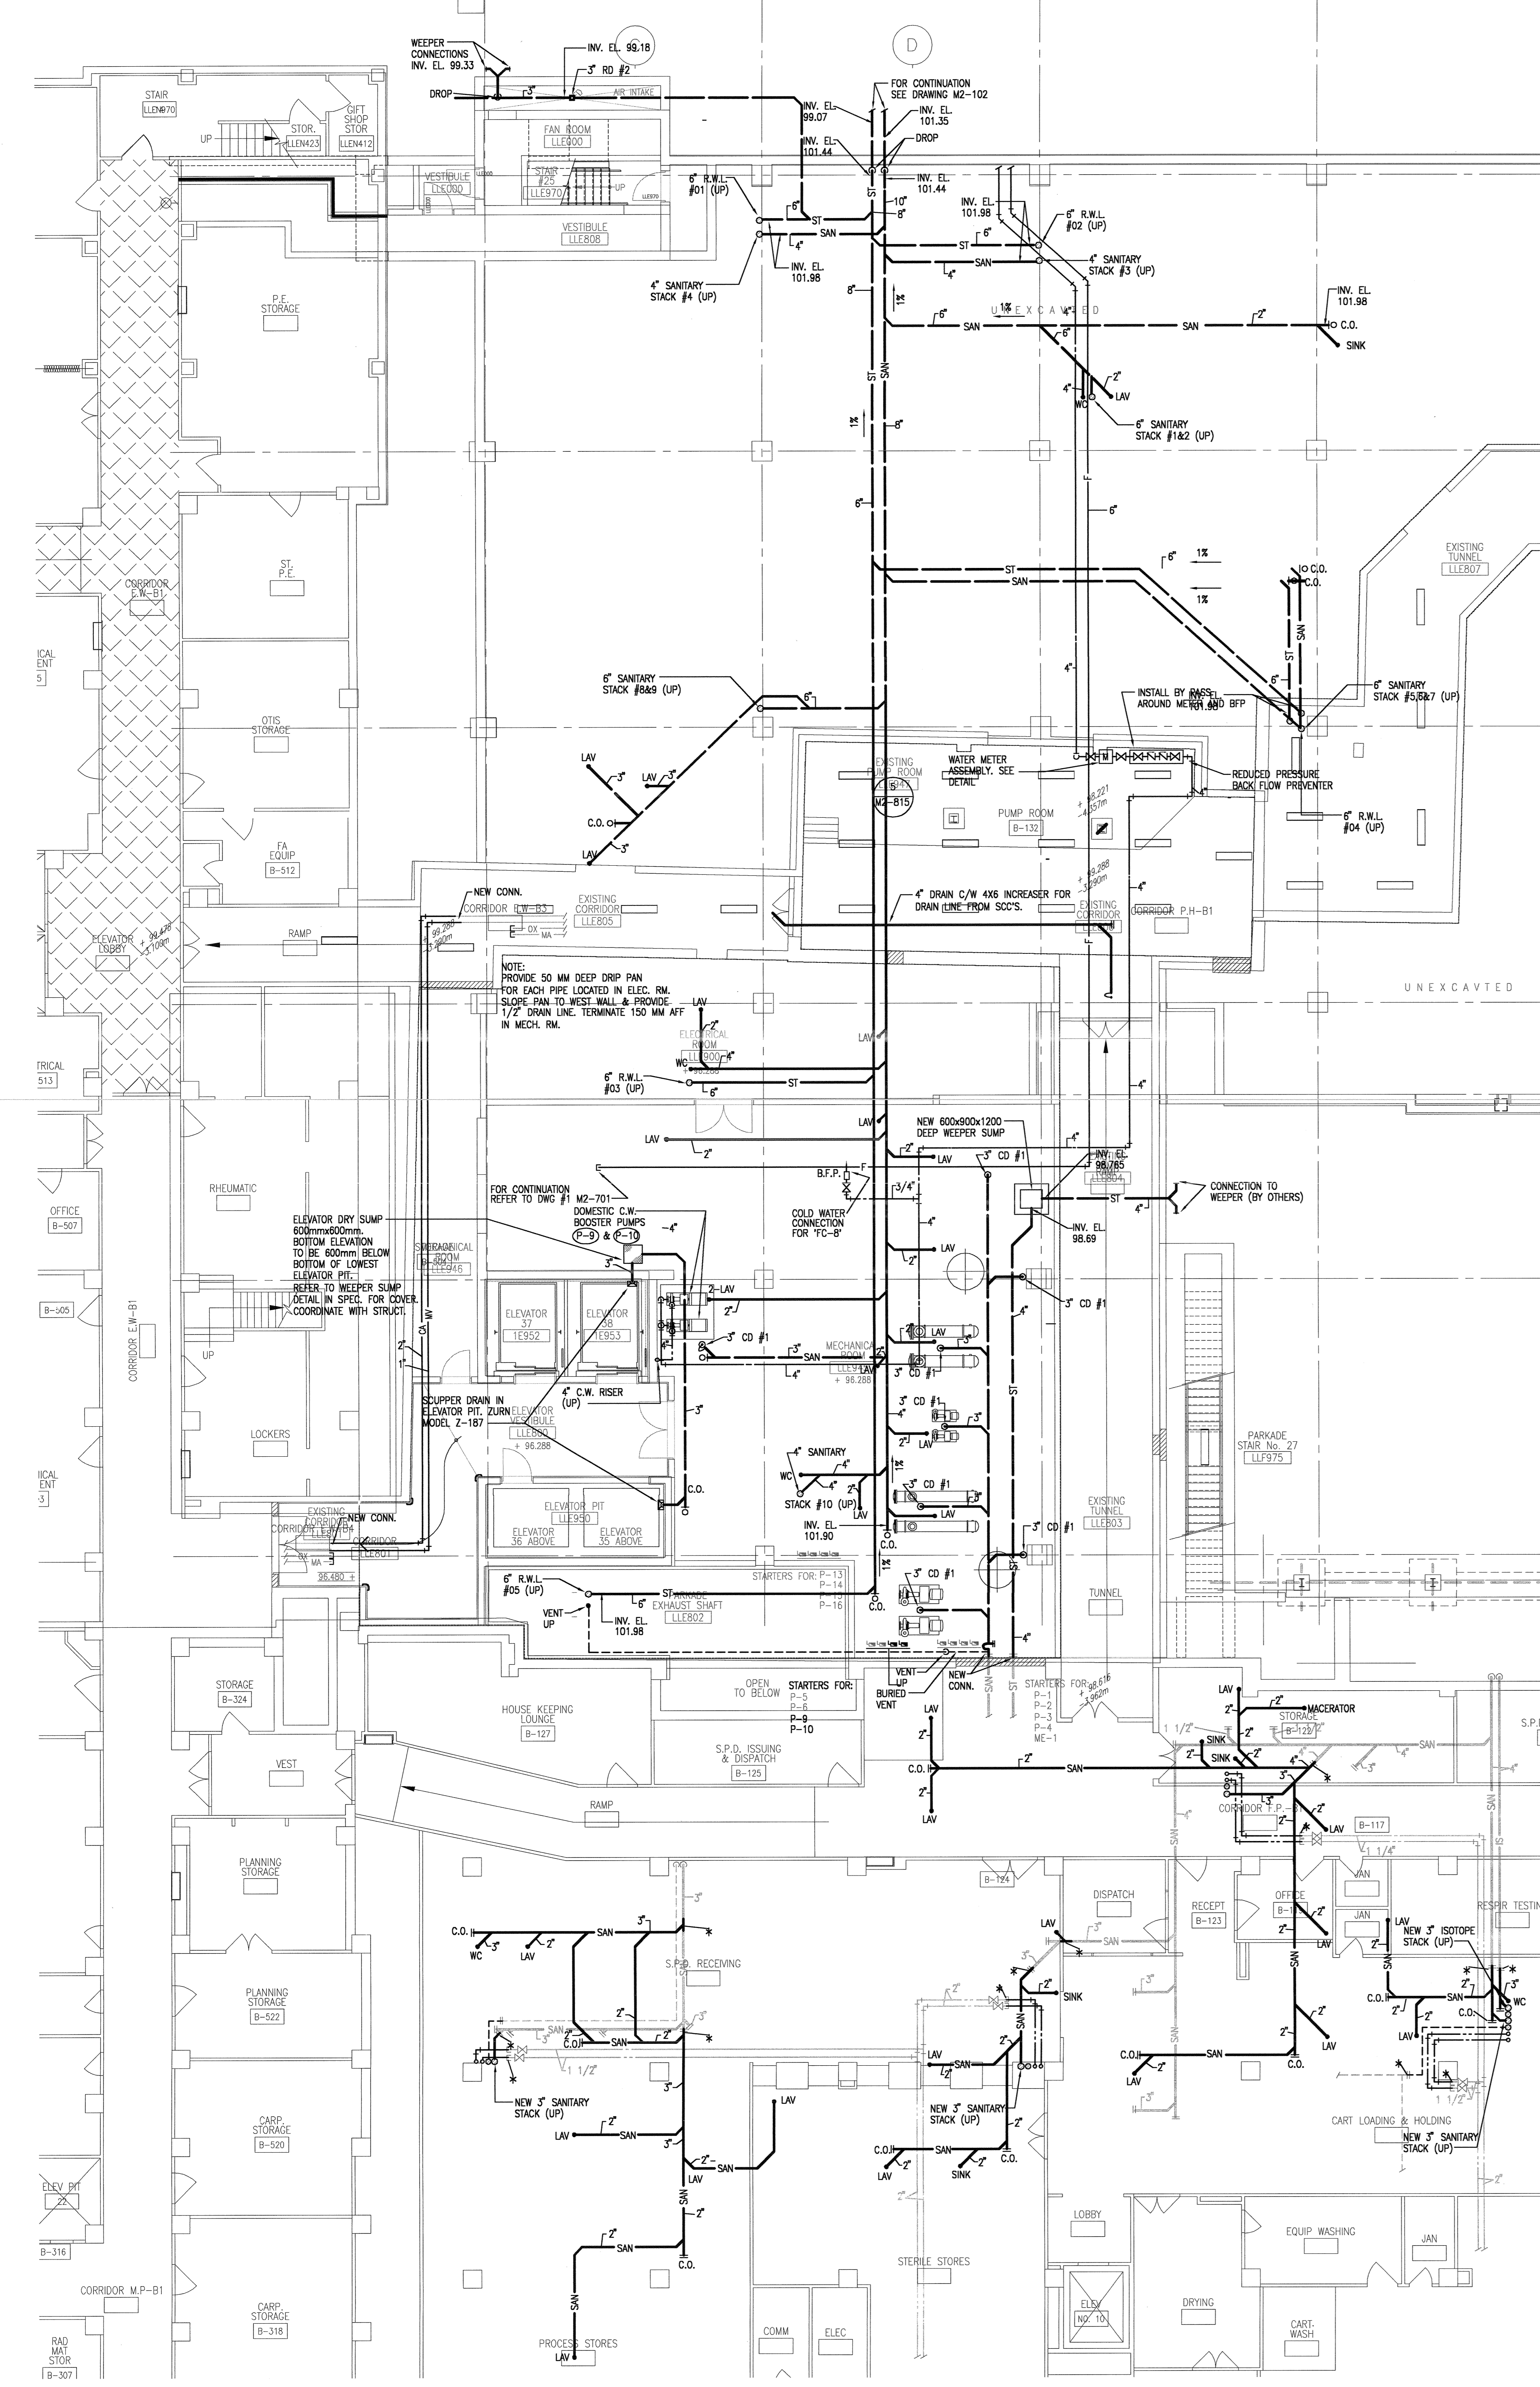


1 LOWER LEVEL FLOOR PLAN
Scale: 1:100

301

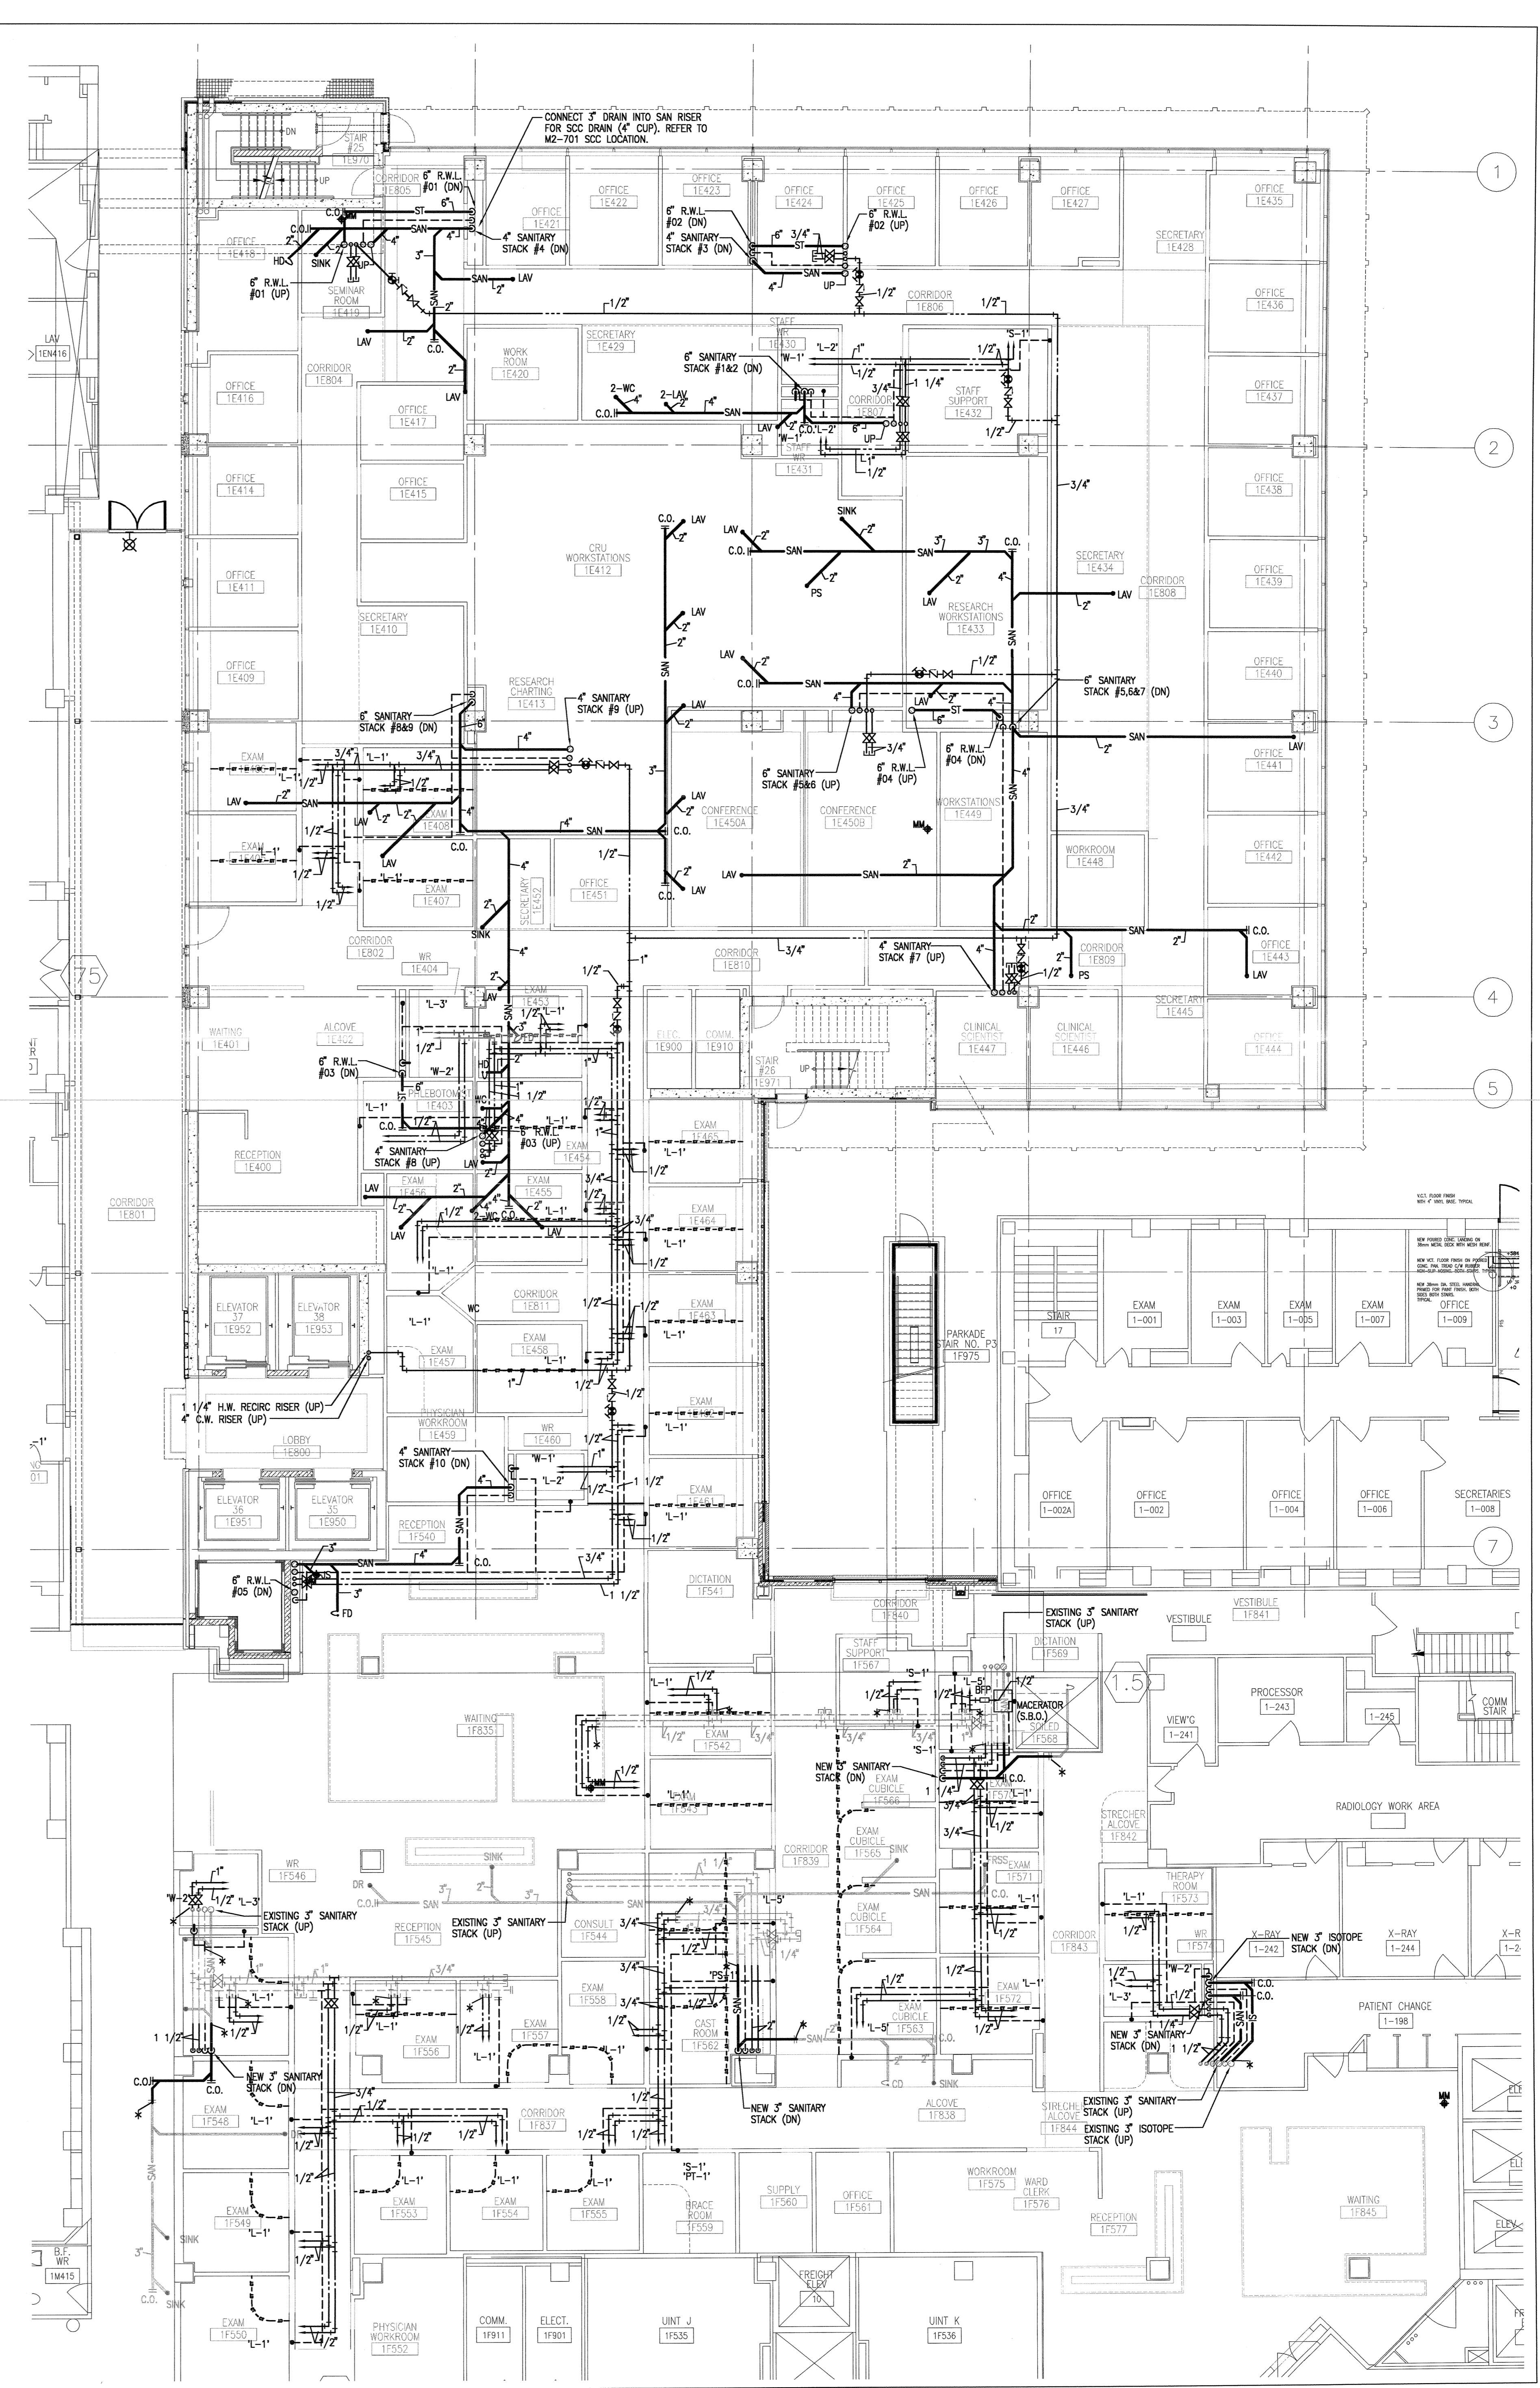


2 LEVEL ONE FLOOR PLAN
Scale: 1:100

301

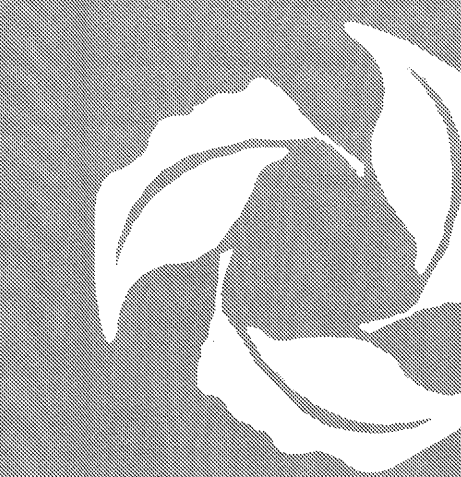

Toronto Western Hospital

University Health Network

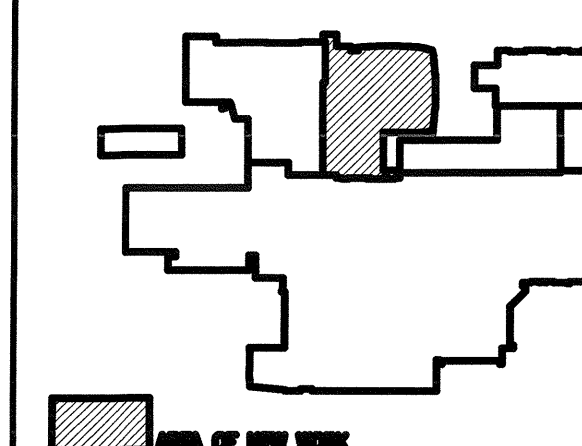


NEW PLAN (302)

- 12 07/04/00 ISSUED FOR AS BUILT DRAWINGS
- 11 03/06/00 ISSUED FOR CONSTRUCTION
- 10 03/05/01 REVISED FOR ADDENDUM M5
- 9 03/05/01 REVISED FOR ADDENDUM M4
- 8 03/04/01 REVISED FOR ADDENDUM M2
- 7 03/04/01 REVISED FOR ADDENDUM M1
- 6 03/03/01 ISSUED FOR BUILDING PERMIT
- 5 03/03/01 ISSUED FOR GENERAL TENDER
- 4 03/01/01 APPLICATION FOR BUILDING PERMIT
- 3 02/12/01 APPLICATION FOR BUILDING PERMIT
- 2 02/11/01 ISSUED FOR REVIEW
- 1 02/08/01 ISSUED FOR COSTING

REF. DATE DESCRIPTION

03/05/01 (03/05/01) CHECK AND VERIFY ALL DIMENSIONS BEFORE PROCEEDING WITH THE WORK.

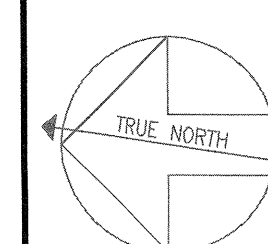

CONSTRUCTION NORTH


AS-BUILT DRAWINGS

PROJECT NAME:
TORONTO WESTERN HOSPITAL
EAST WING REDEVELOPMENT
MAIN BUILDING - STAGE TWO
TORONTO ONTARIO


DRAWING TITLE:
LEVEL 2 FLOOR PLAN
LEVEL 3 FLOOR PLAN
PLUMBING

SCALE:
1 : 100
DATE:
MARCH 2003
DRAWN BY:
CHECKED BY:

PROJECT NUMBER:
2011210
DRAWING NUMBER:
M2-302

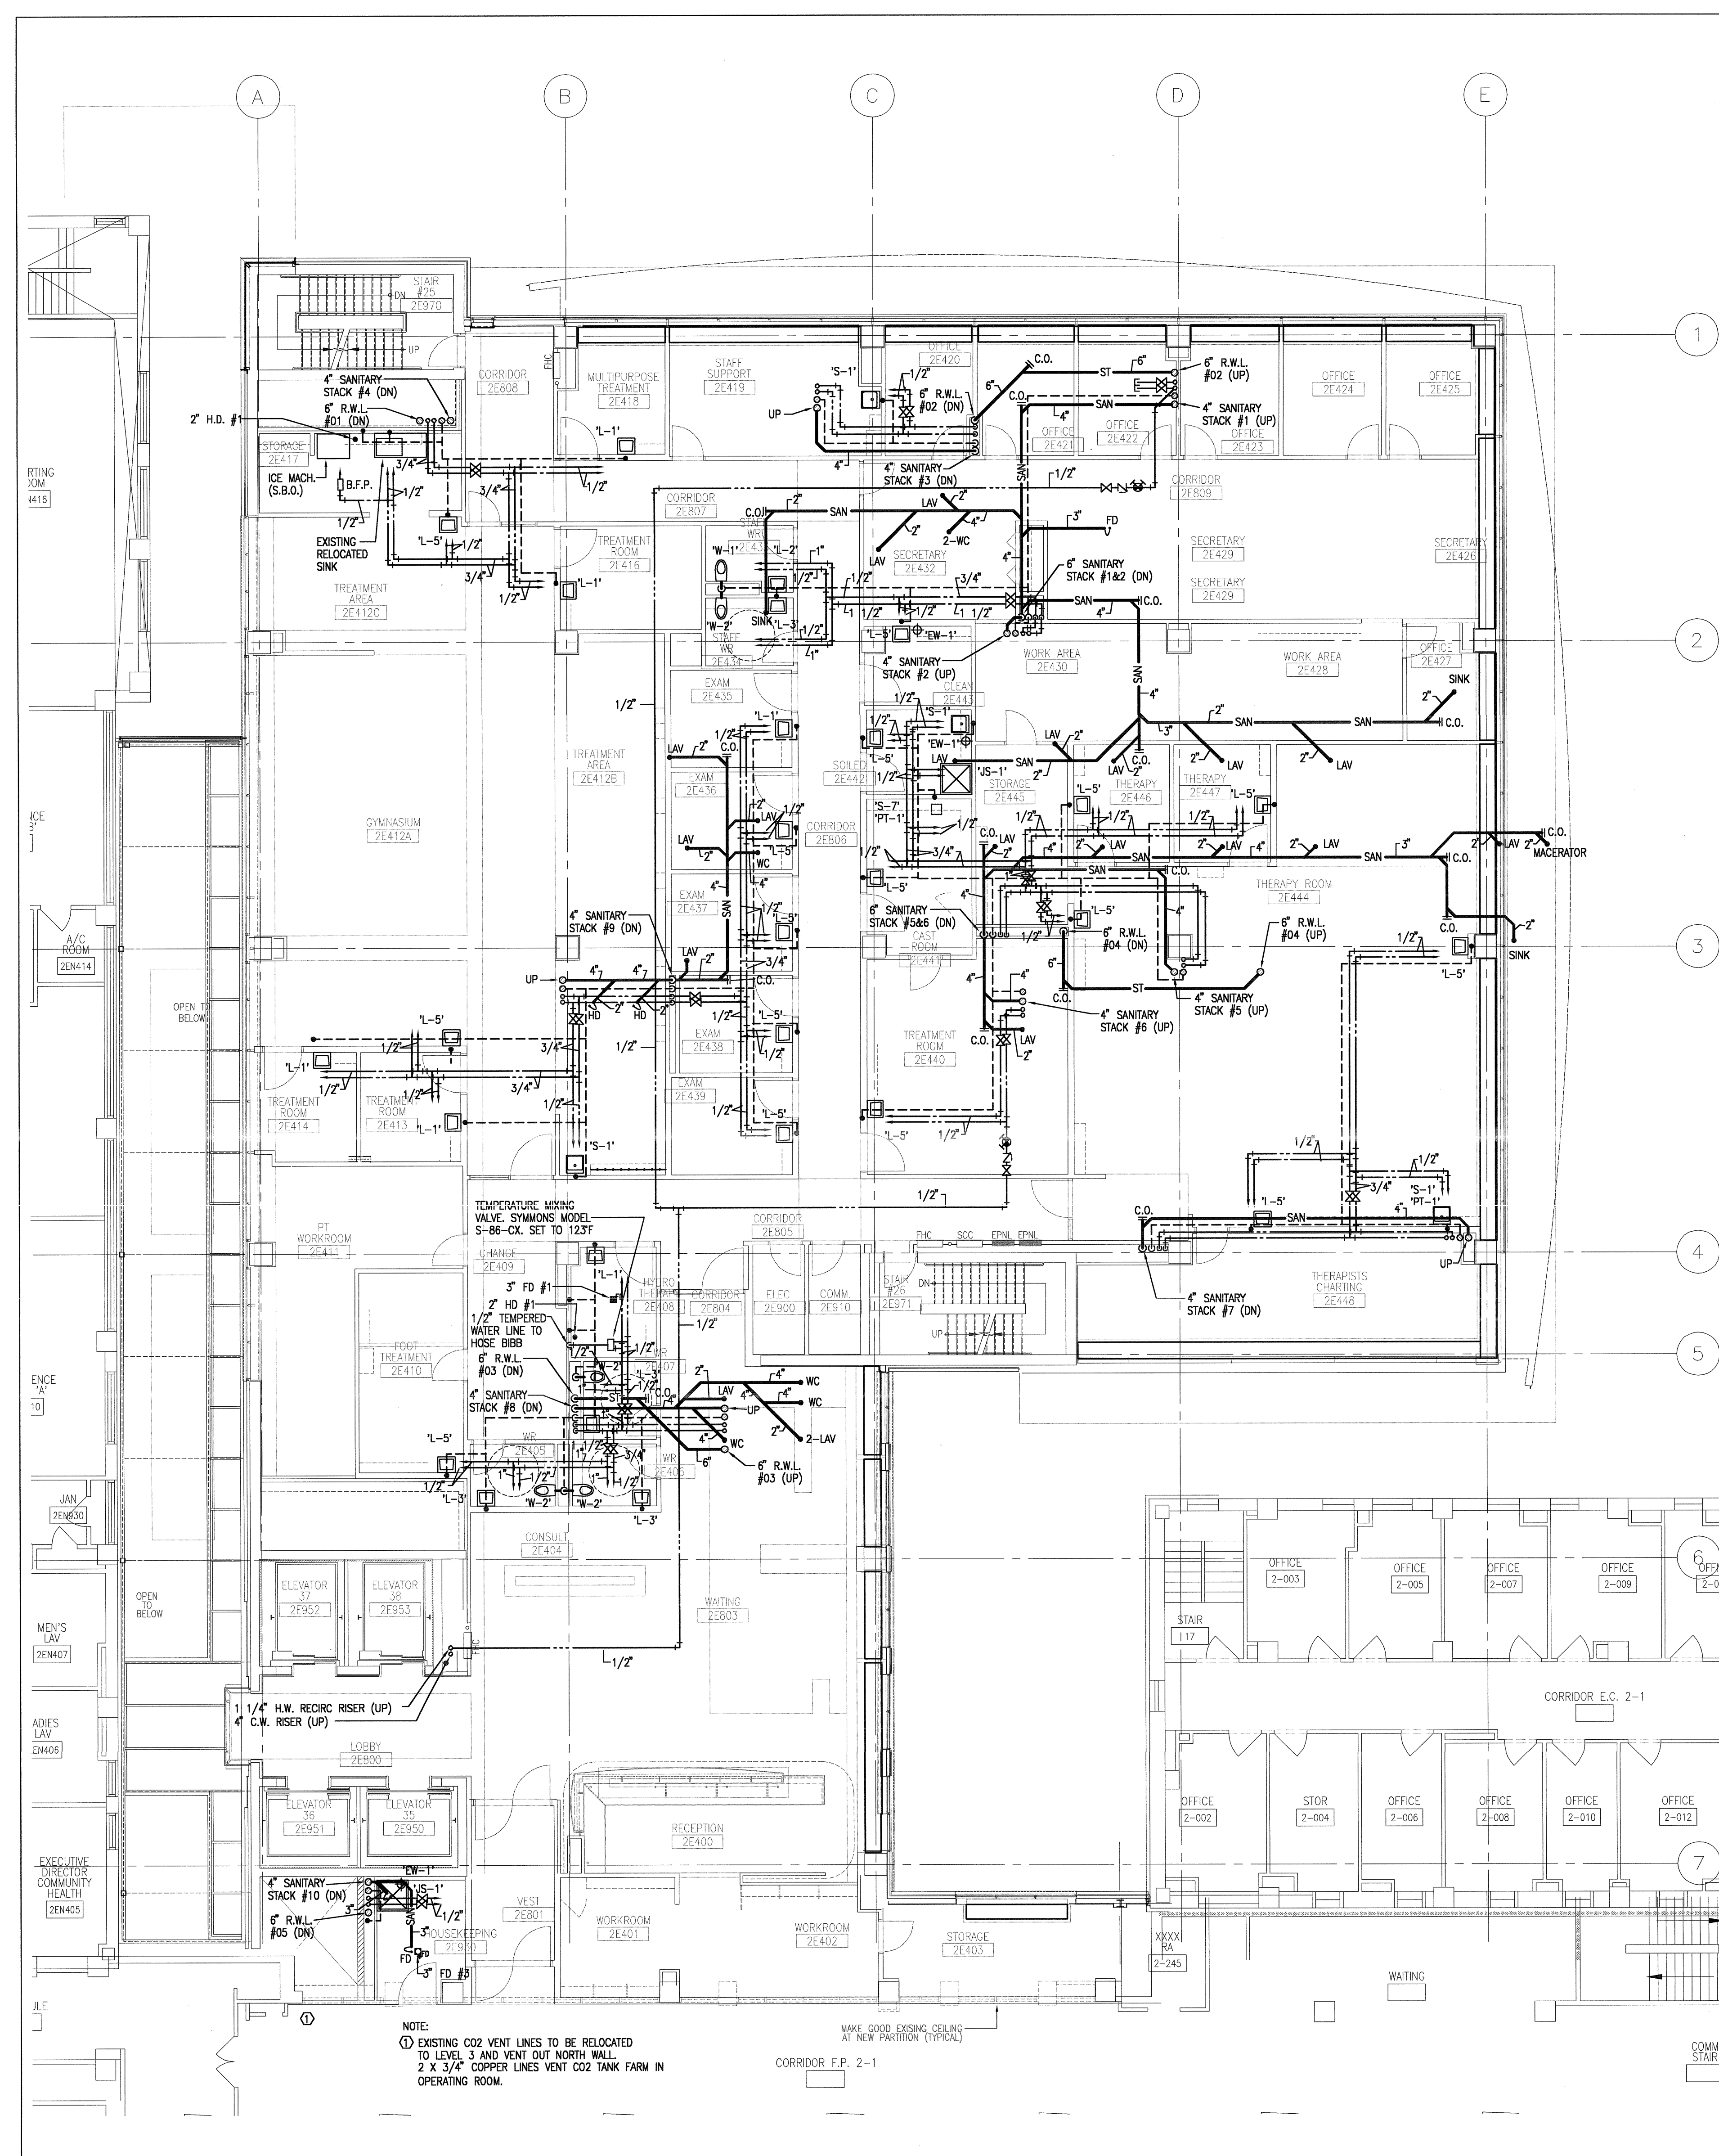

1 LEVEL TWO FLOOR PLAN
302 Scale: 1:100

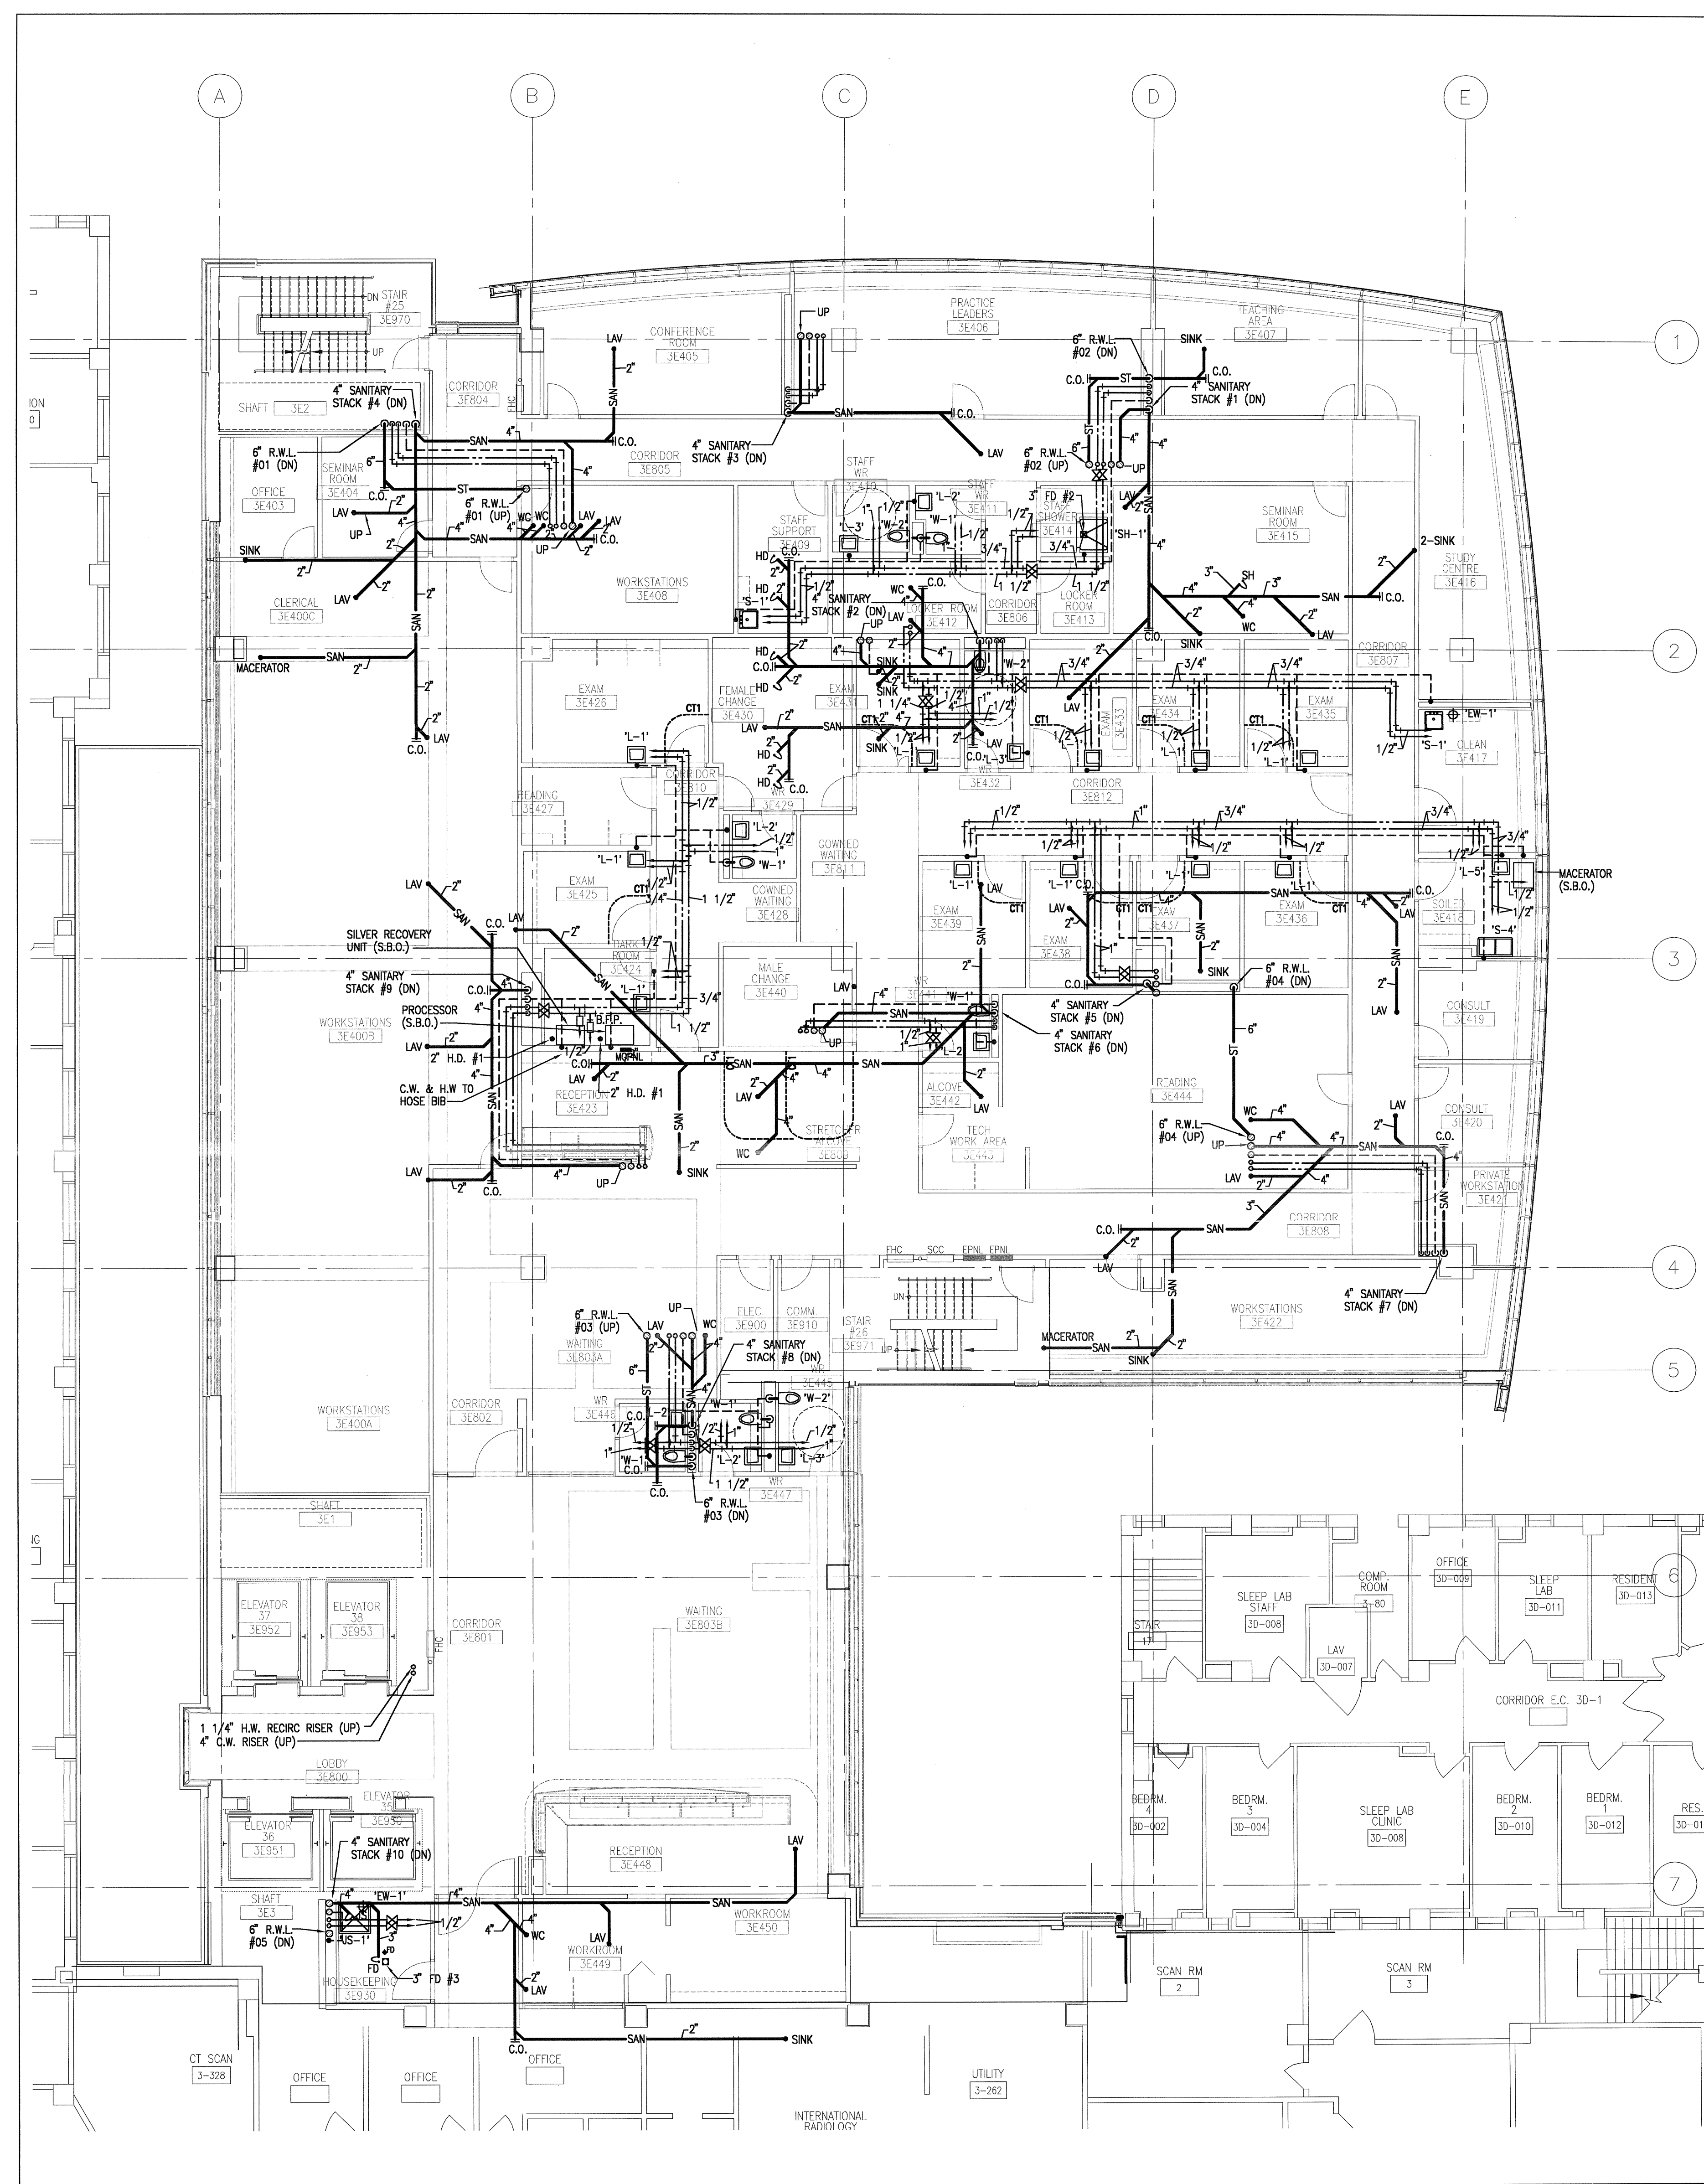


2 LEVEL THREE FLOOR PLAN
302 Scale: 1:100



Toronto Western Hospital

University Health Network

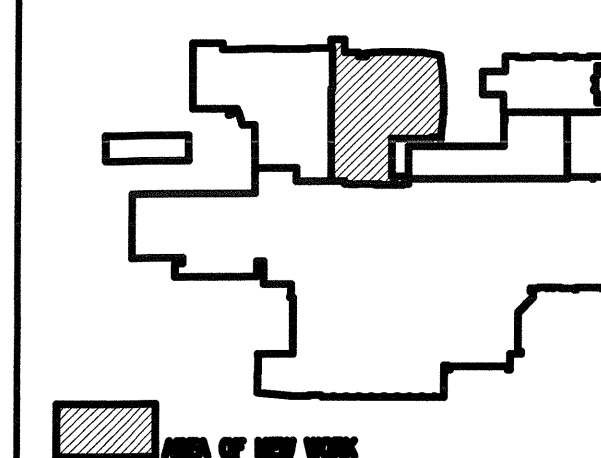


NEW PLAN (M2-303)

- 12 07/04/00 ISSUED FOR AS BUILT DRAWINGS
11 03/06/00 ISSUED FOR CONSTRUCTION
10 03/05/00 REVISED FOR POST TENDER ADDENDUM M1
9 03/05/00 REVISED FOR ADDENDUM M4
8 03/04/00 REVISED FOR ADDENDUM M2
7 03/04/00 REVISED FOR ADDENDUM M1
6 03/03/00 ISSUED FOR BUILDING PERMIT
5 03/03/00 ISSUED FOR GENERAL TENDER
4 03/01/00 ISSUED FOR GENERAL TENDER
3 02/12/00 APPLICATION FOR BUILDING PERMIT
2 02/11/00 ISSUED FOR BIDDING
1 02/08/00 ISSUED FOR CONSTRUCTION

REF: DATE DESCRIPTION
(yy/mm/dd)

CHECK AND VERIFY ALL DIMENSIONS BEFORE PROCEEDING TO CONSTRUCTION. DO NOT SCALE DRAWINGS.

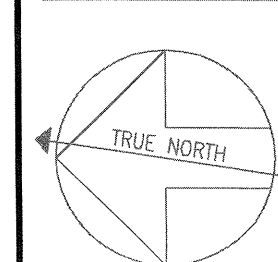


AS-BUILT DRAWINGS

PROJECT NAME:
TORONTO WESTERN HOSPITAL
EAST WING REDEVELOPMENT
MAIN BUILDING - STAGE TWO
TORONTO ONTARIO


DRAWING TITLE:
LEVEL 4 FLOOR PLAN
LEVEL 5 FLOOR PLAN
PLUMBING

SCALE:
1 : 100
DATE:
MARCH 2003
DRAWN BY:
CHECKED BY:


PROJECT NUMBER:
2011210
DRAWING NUMBER:
M2-303

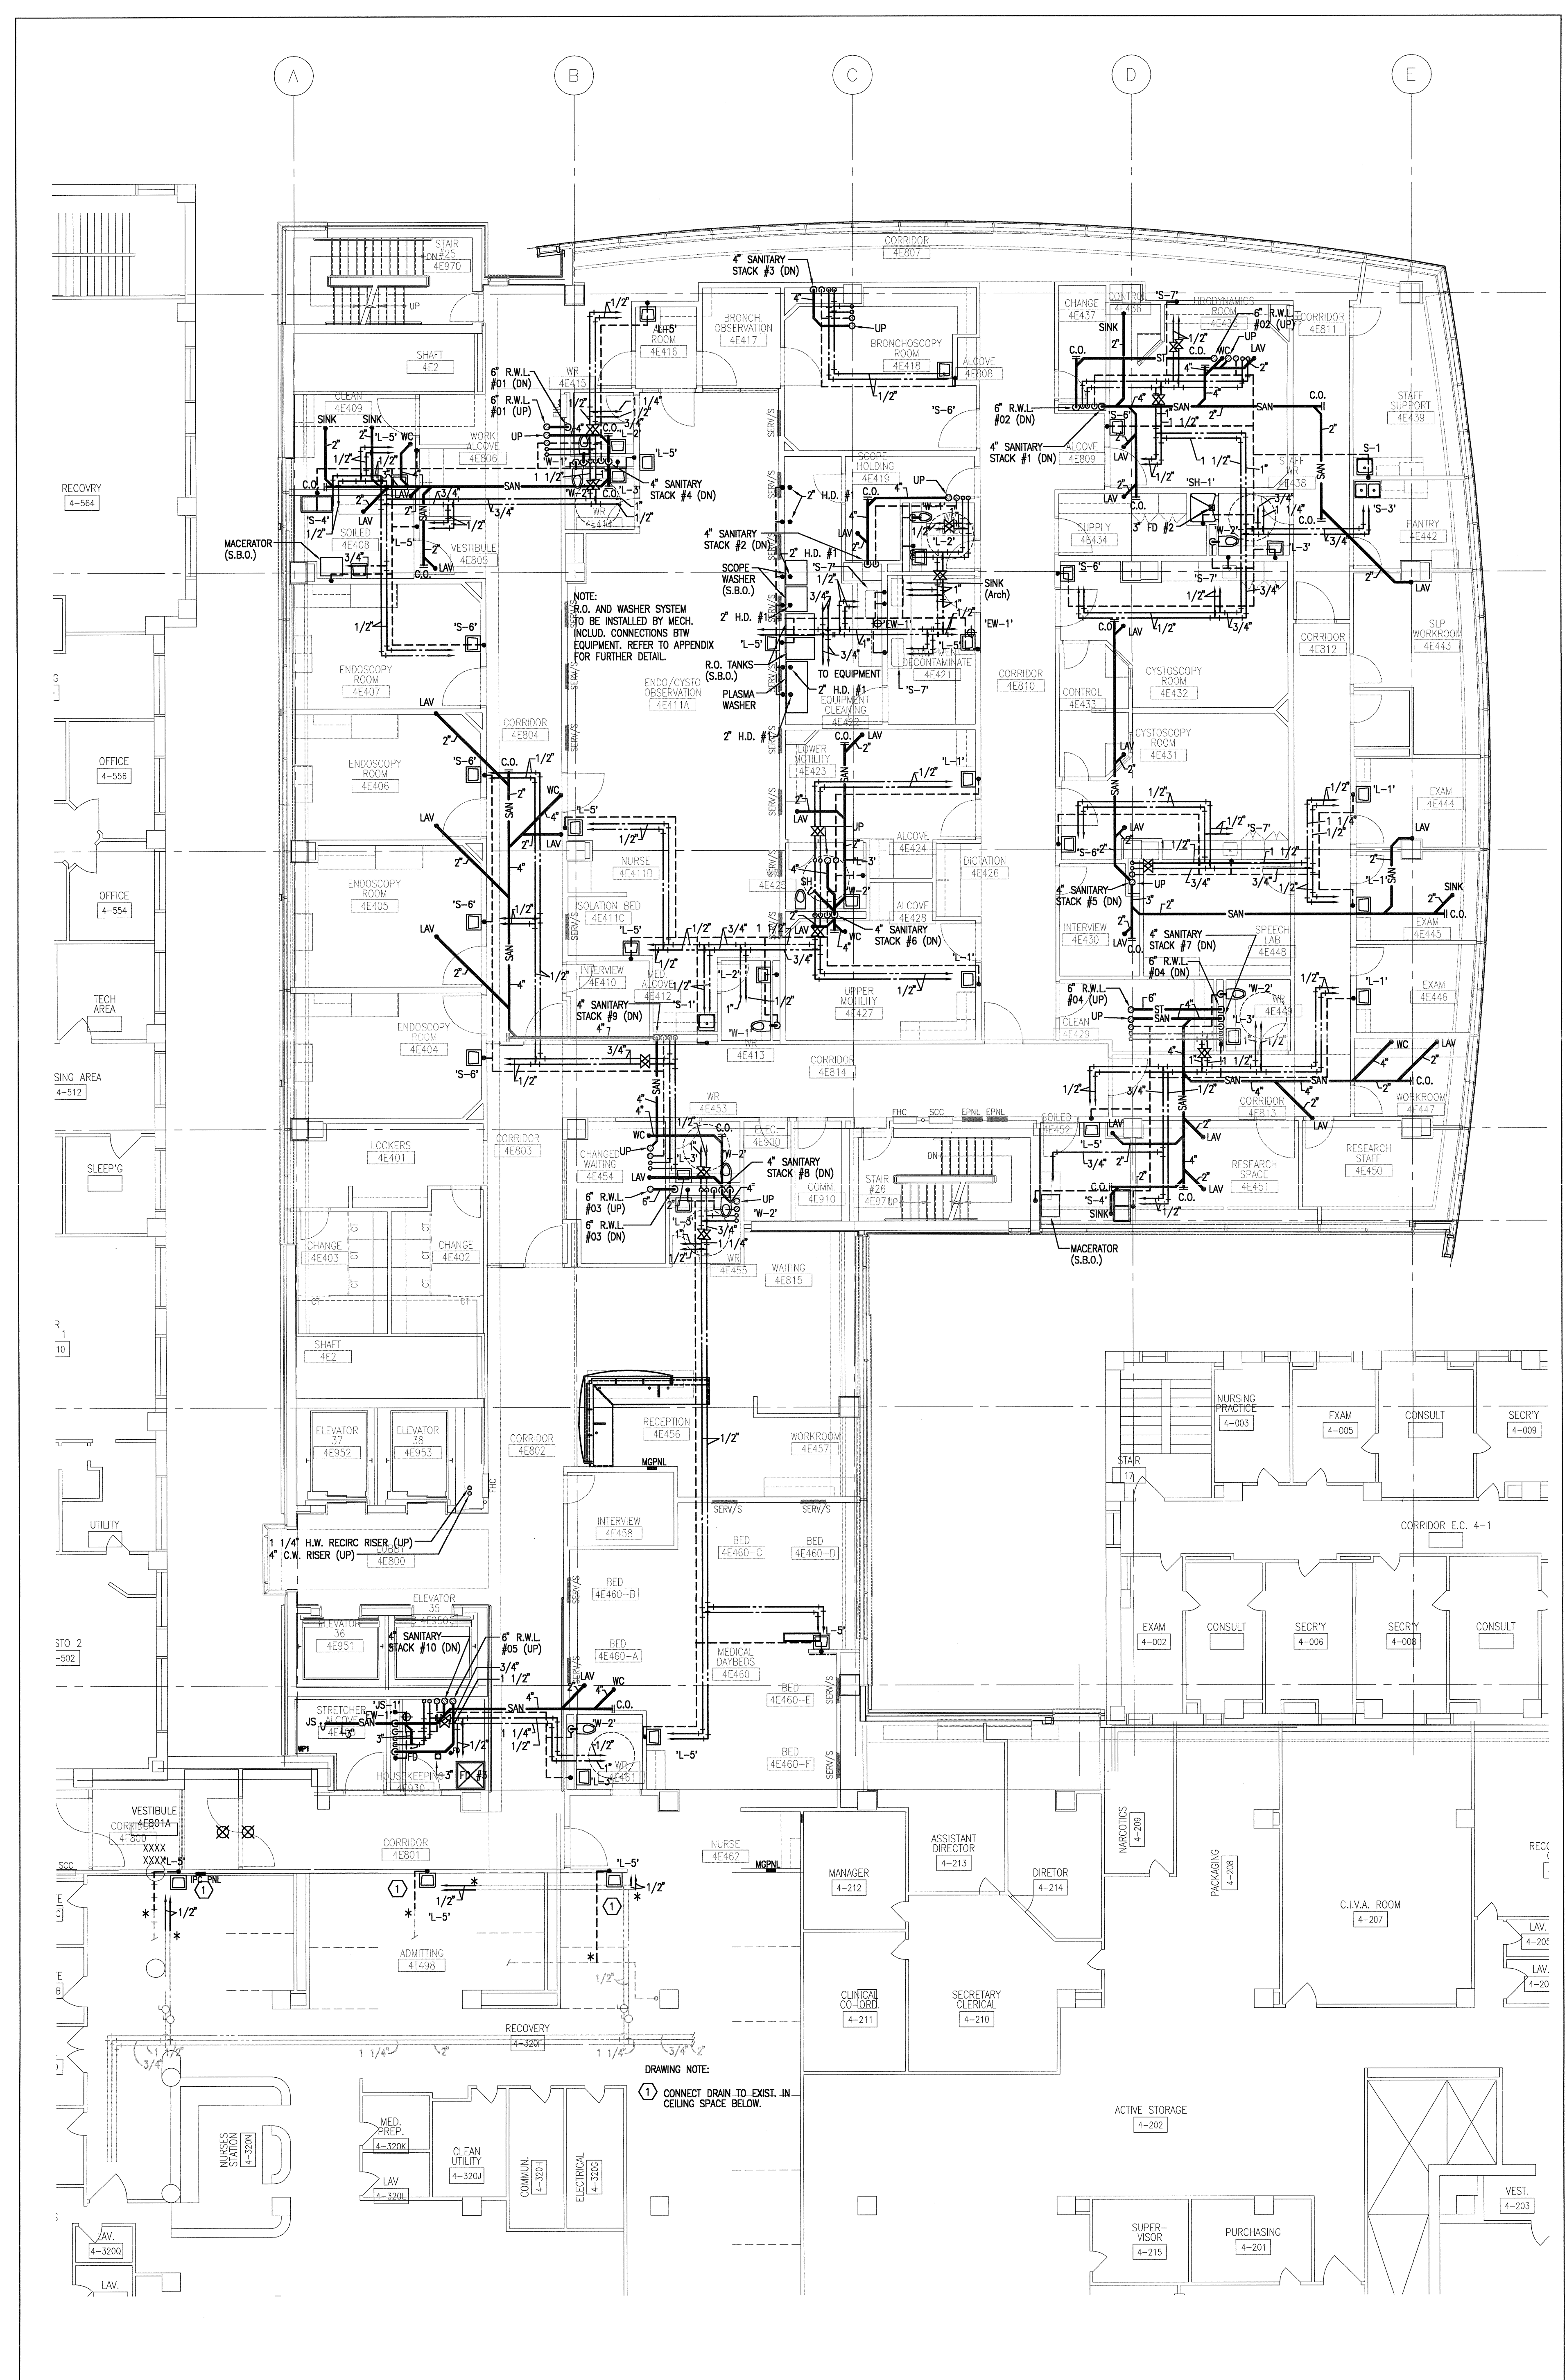

1 LEVEL FOUR FLOOR PLAN
303 Scale: 1:100

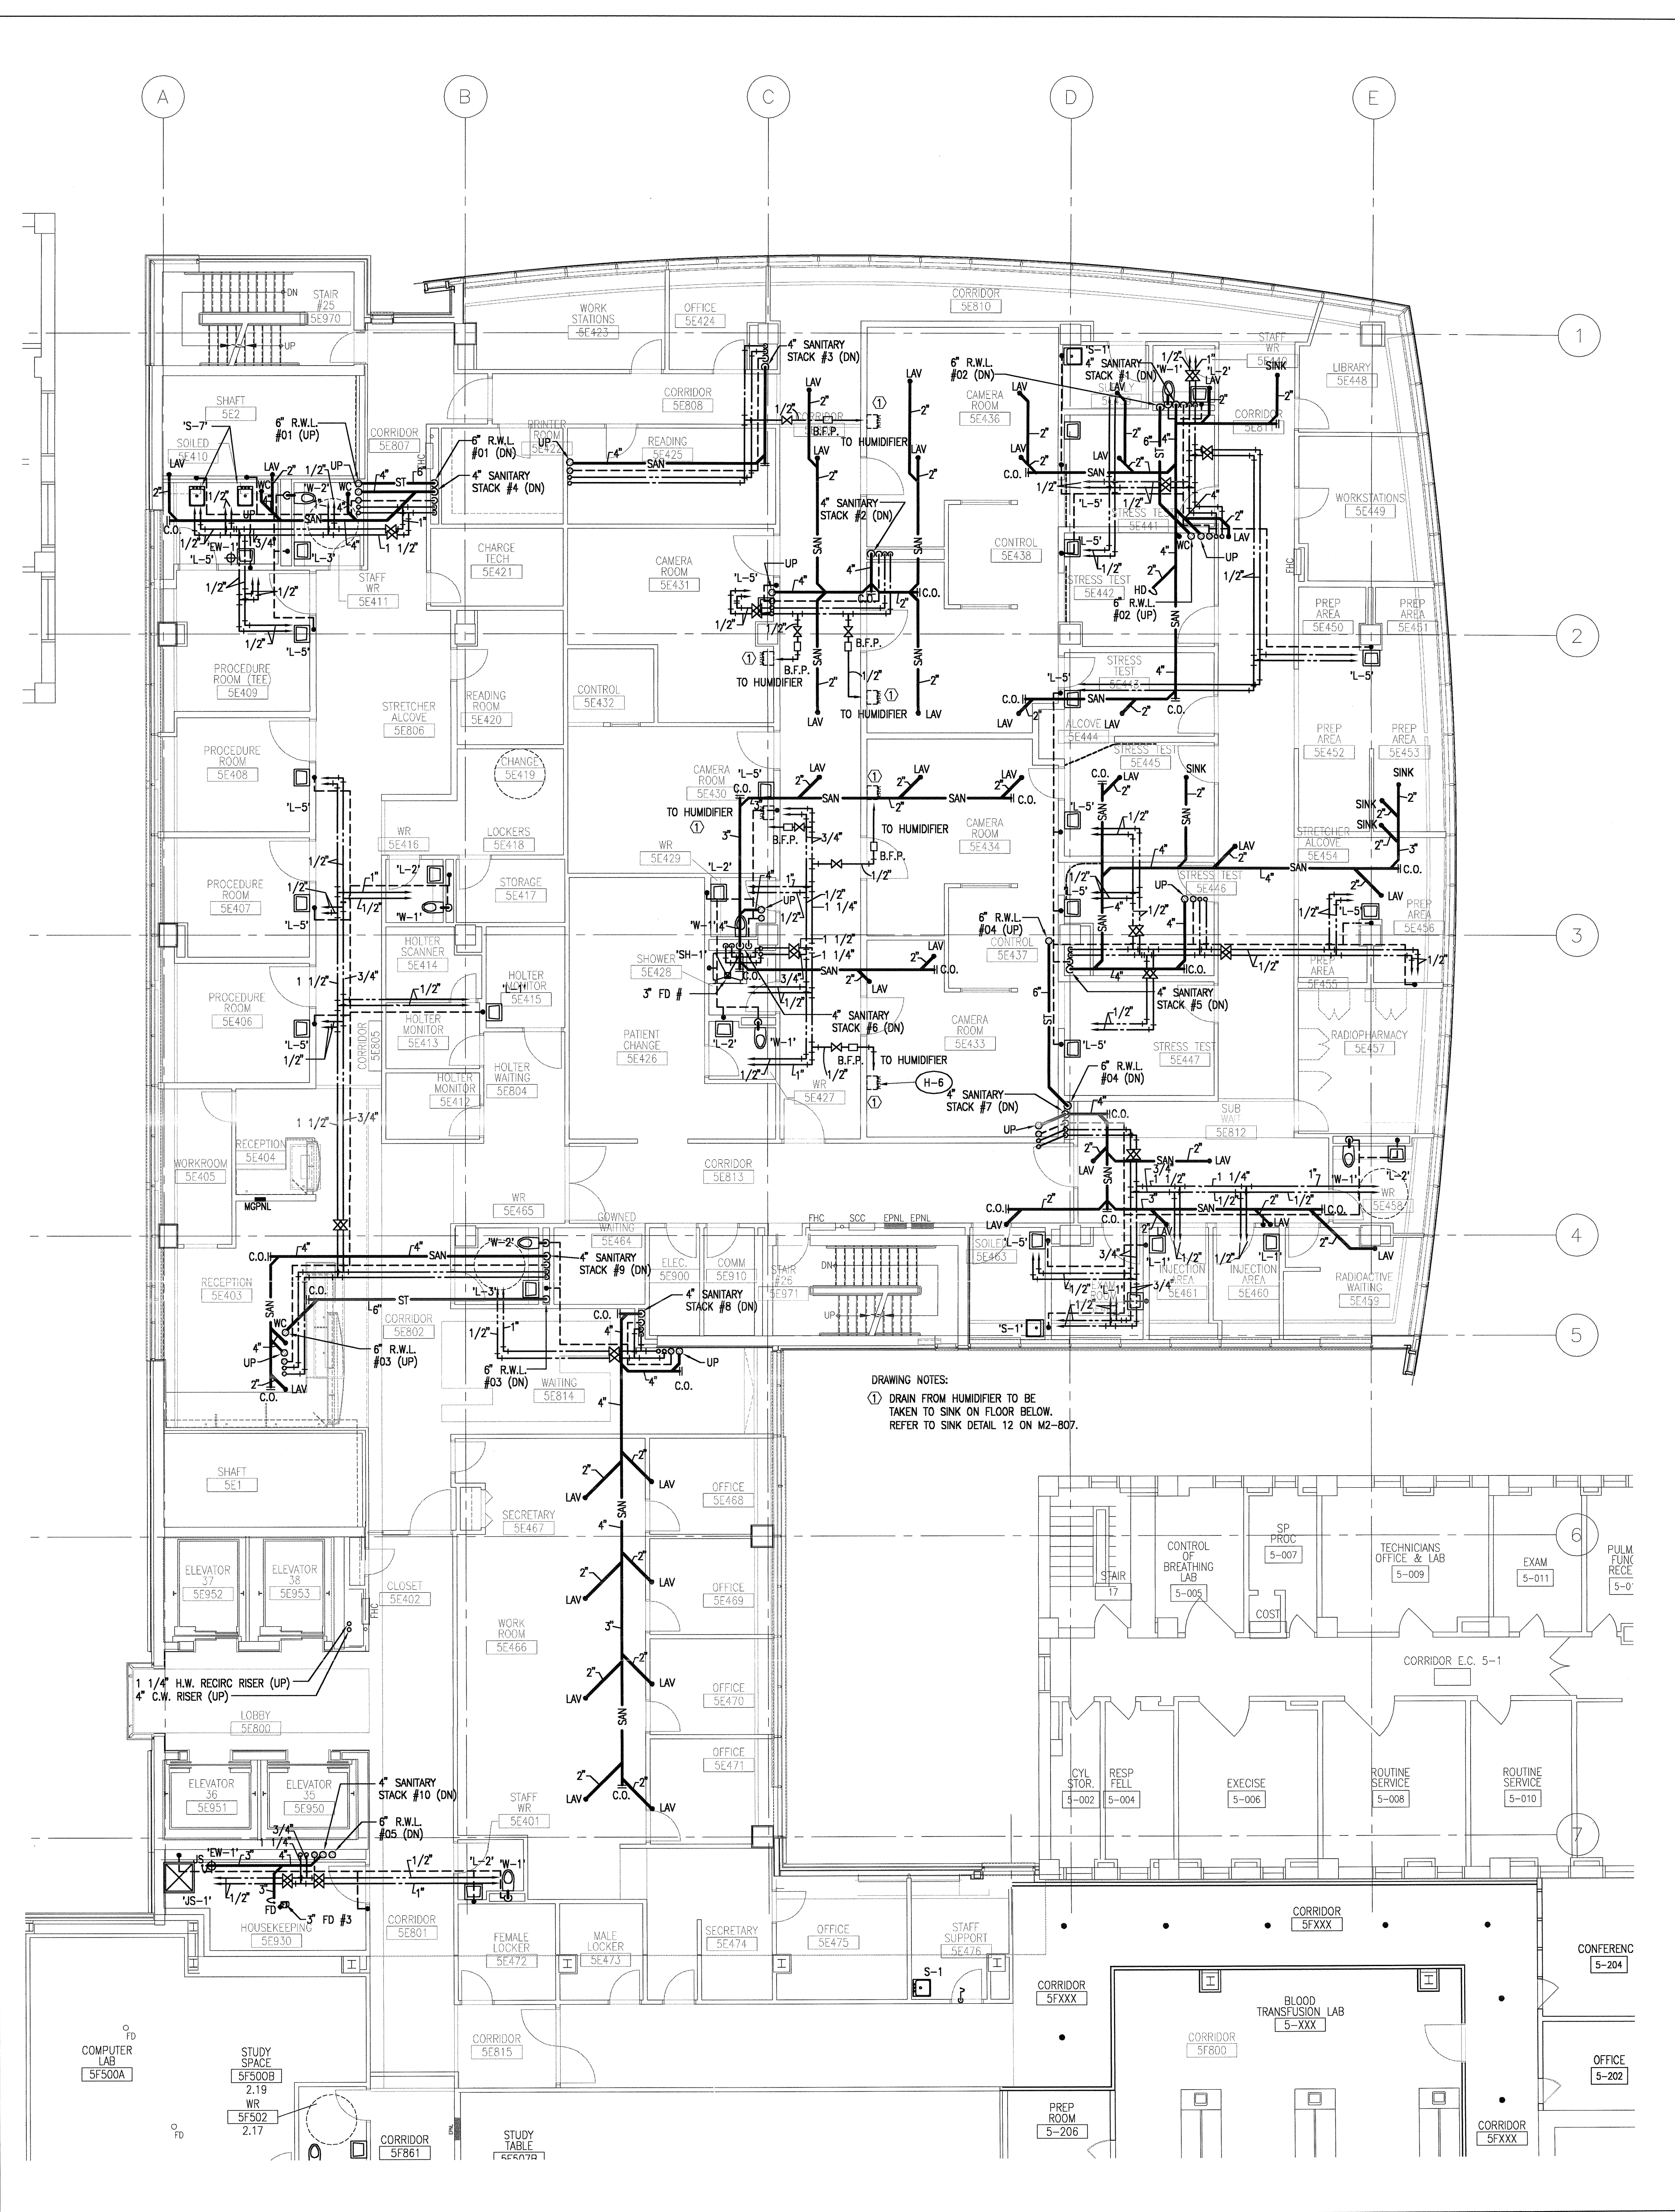


2 LEVEL FIVE FLOOR PLAN
303 Scale: 1:100

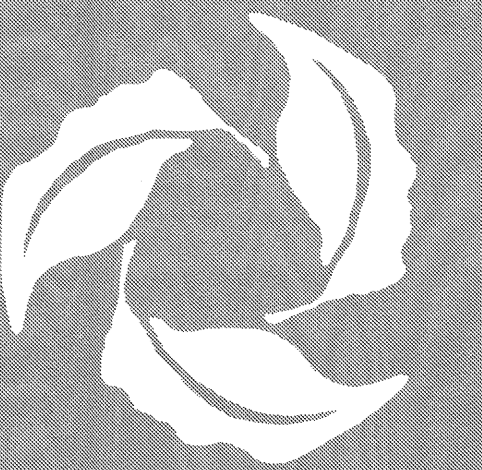

Toronto Western Hospital


University Health Network

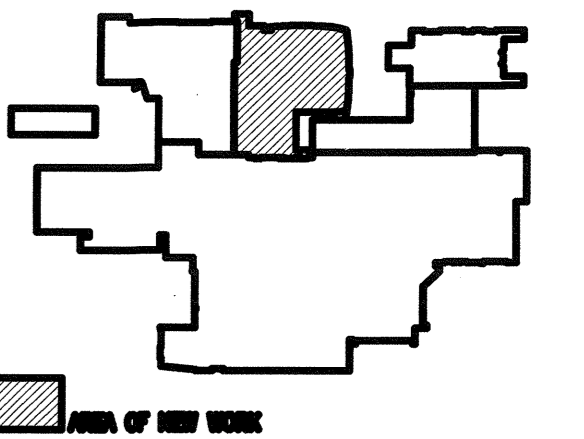

NEW PLAN (324)

10	07/04/20	ISSUED FOR AS-BUILT DRAWINGS
9	03/08/20	ISSUED FOR CONSTRUCTION
8	03/08/21	REVISED FOR ADDENDUM M4
7	03/04/21	REVISED FOR ADDENDUM M1
6	03/03/21	ISSUED FOR BUILDING PERMIT
5	03/03/18	ISSUED FOR GENERAL TENDER
4	03/01/20	ISSUED FOR BOX COSTING
3	02/12/18	APPLICATION FOR BUILDING PERMIT
2	02/11/17	ISSUED FOR BOX REVIEW
1	02/08/16	ISSUED FOR COSTING
REV	DATE	DESCRIPTION
	(yymm/da)	

CHECK AND VERIFY ALL DIMENSIONS BEFORE PROCEEDING WITH THE WORK. DO NOT SCALE DRAWINGS.

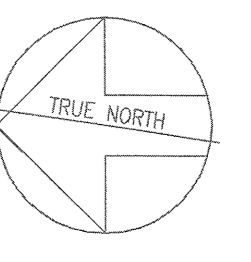

AS-BUILT DRAWINGS


PROJECT NAME:
TORONTO WESTERN HOSPITAL
EAST WING REDEVELOPMENT
MAIN BUILDING - STAGE TWO
TORONTO ONTARIO

DRAWING TITLE:
LEVEL 6 FLOOR PLAN
LEVEL 7 FLOOR PLAN
PLUMBING


SCALE:
1 : 100
DATE:
MARCH 2003
DRAWN BY:
CHECKED BY:

PROJECT NUMBER:
2011210


DRAWING NUMBER:
M2-304

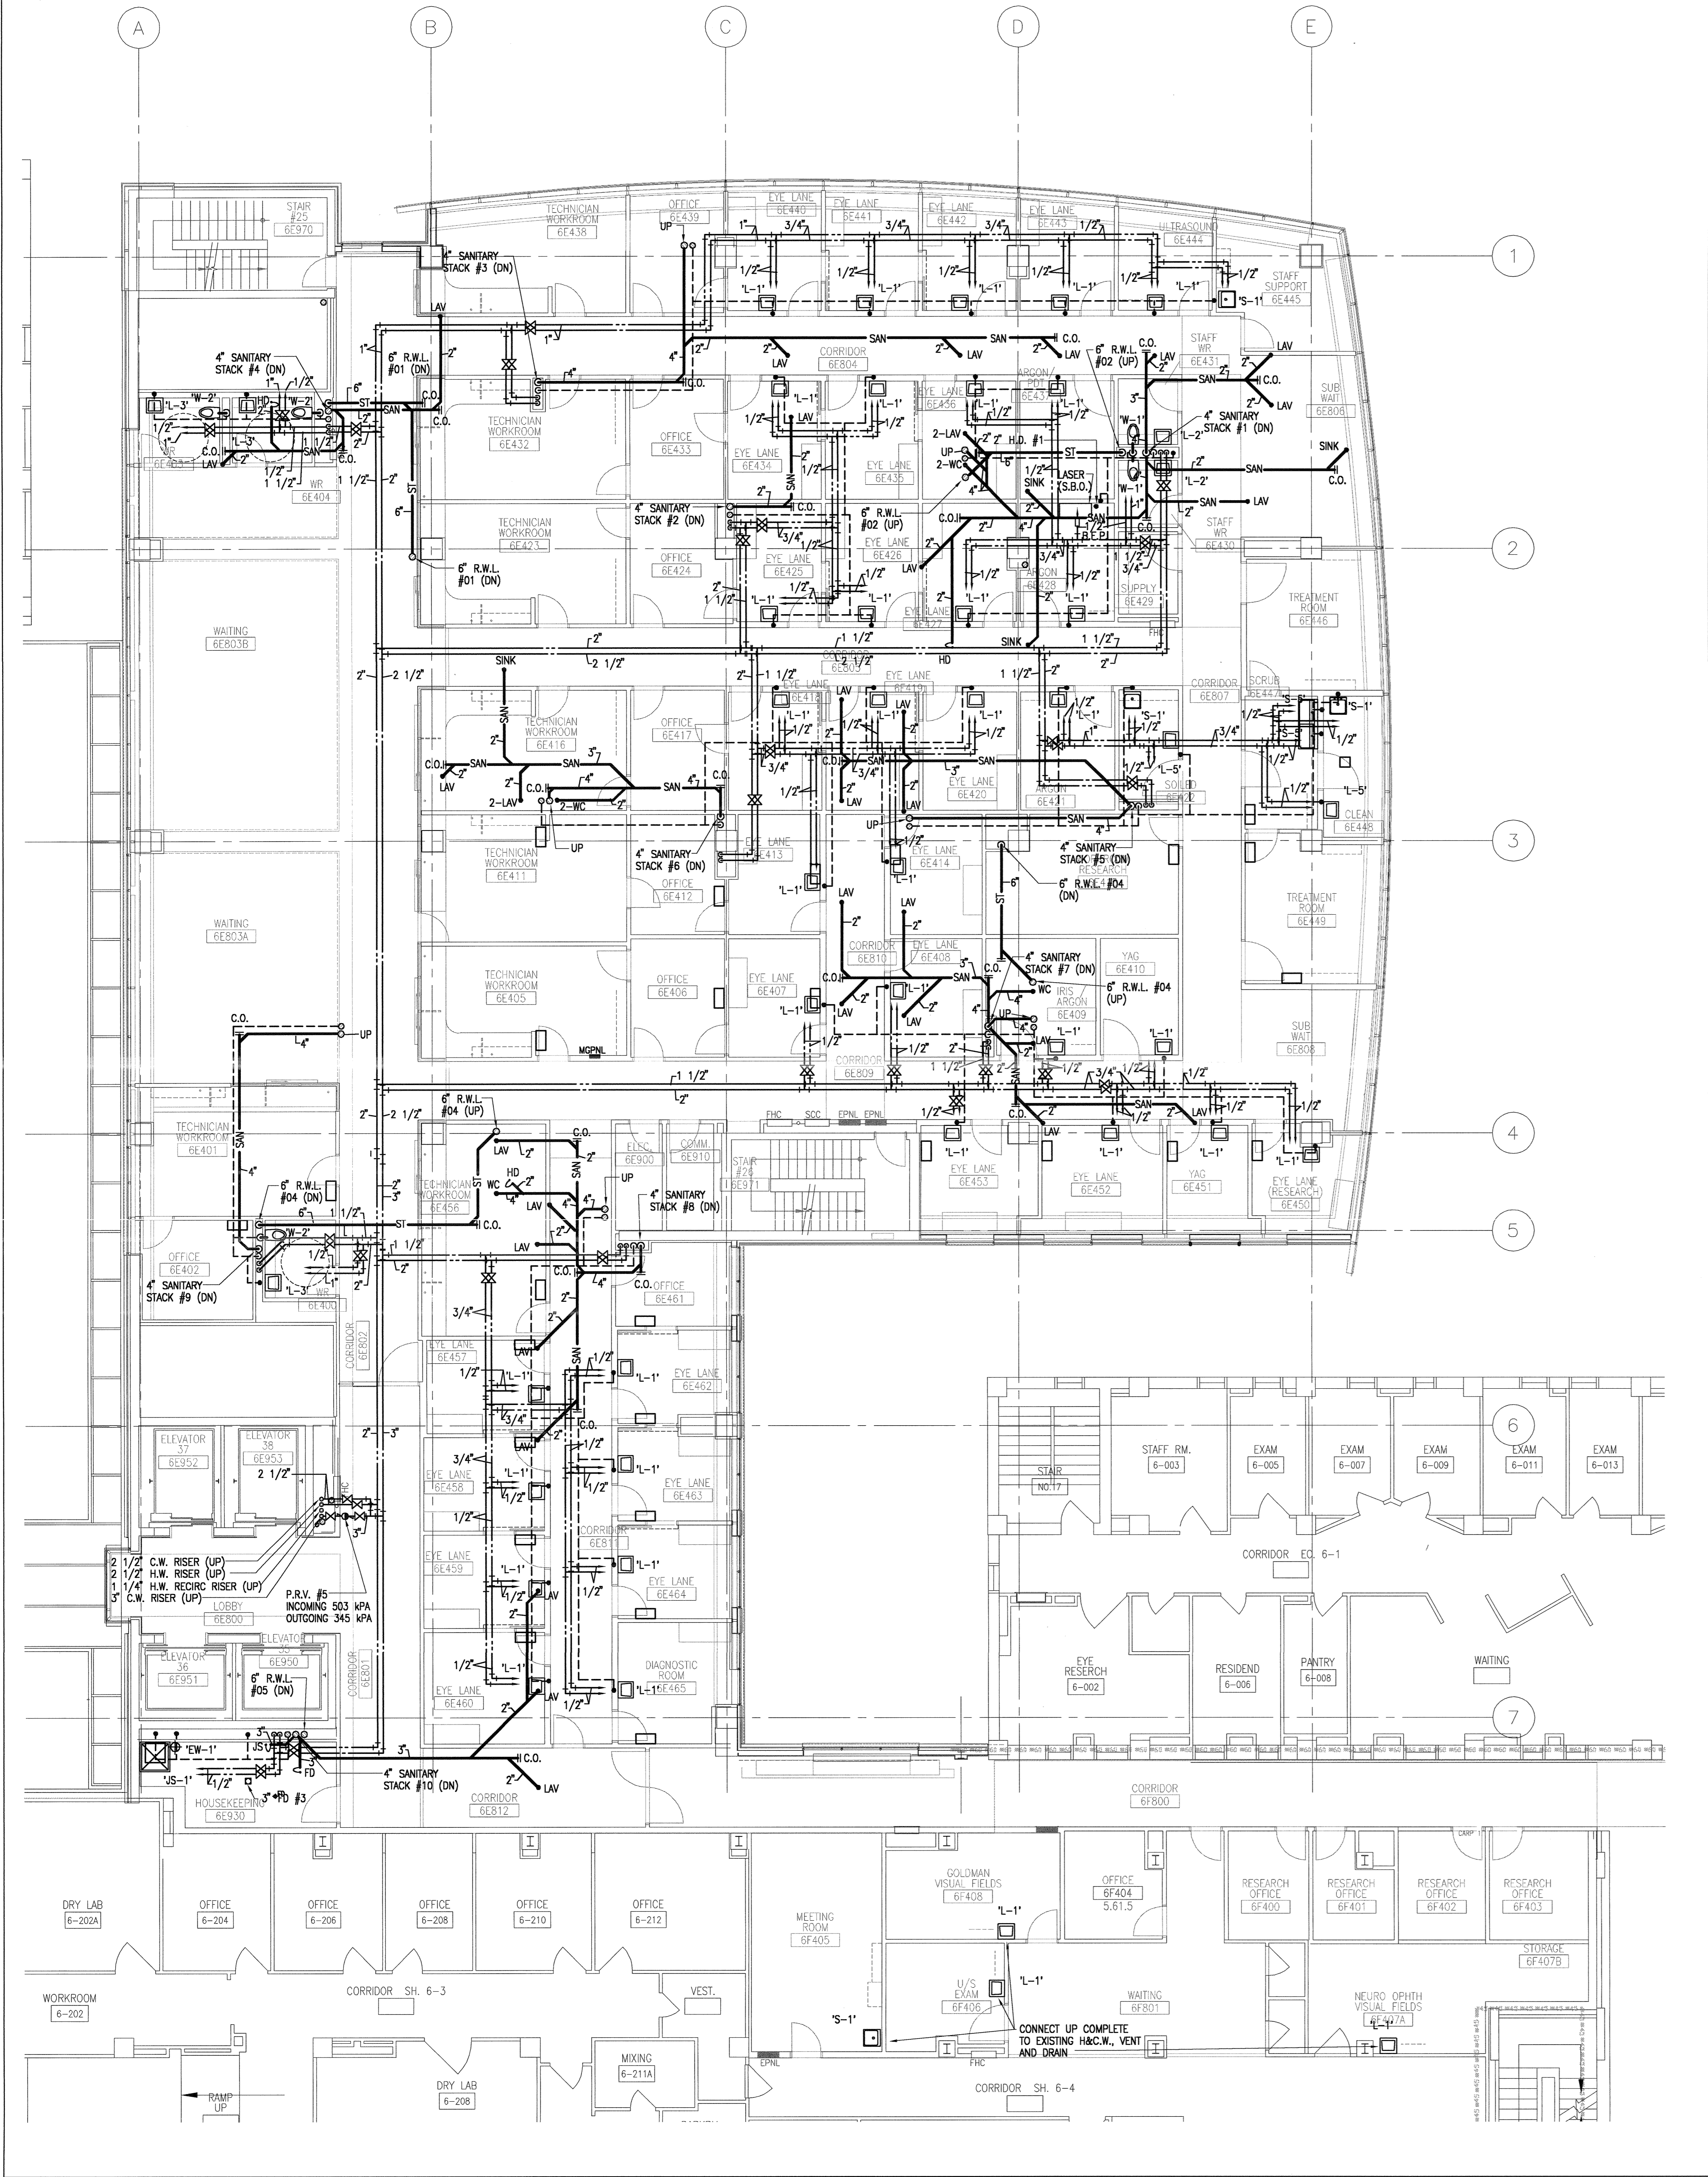


1 LEVEL SIX FLOOR PLAN
304 Scale: 1:100

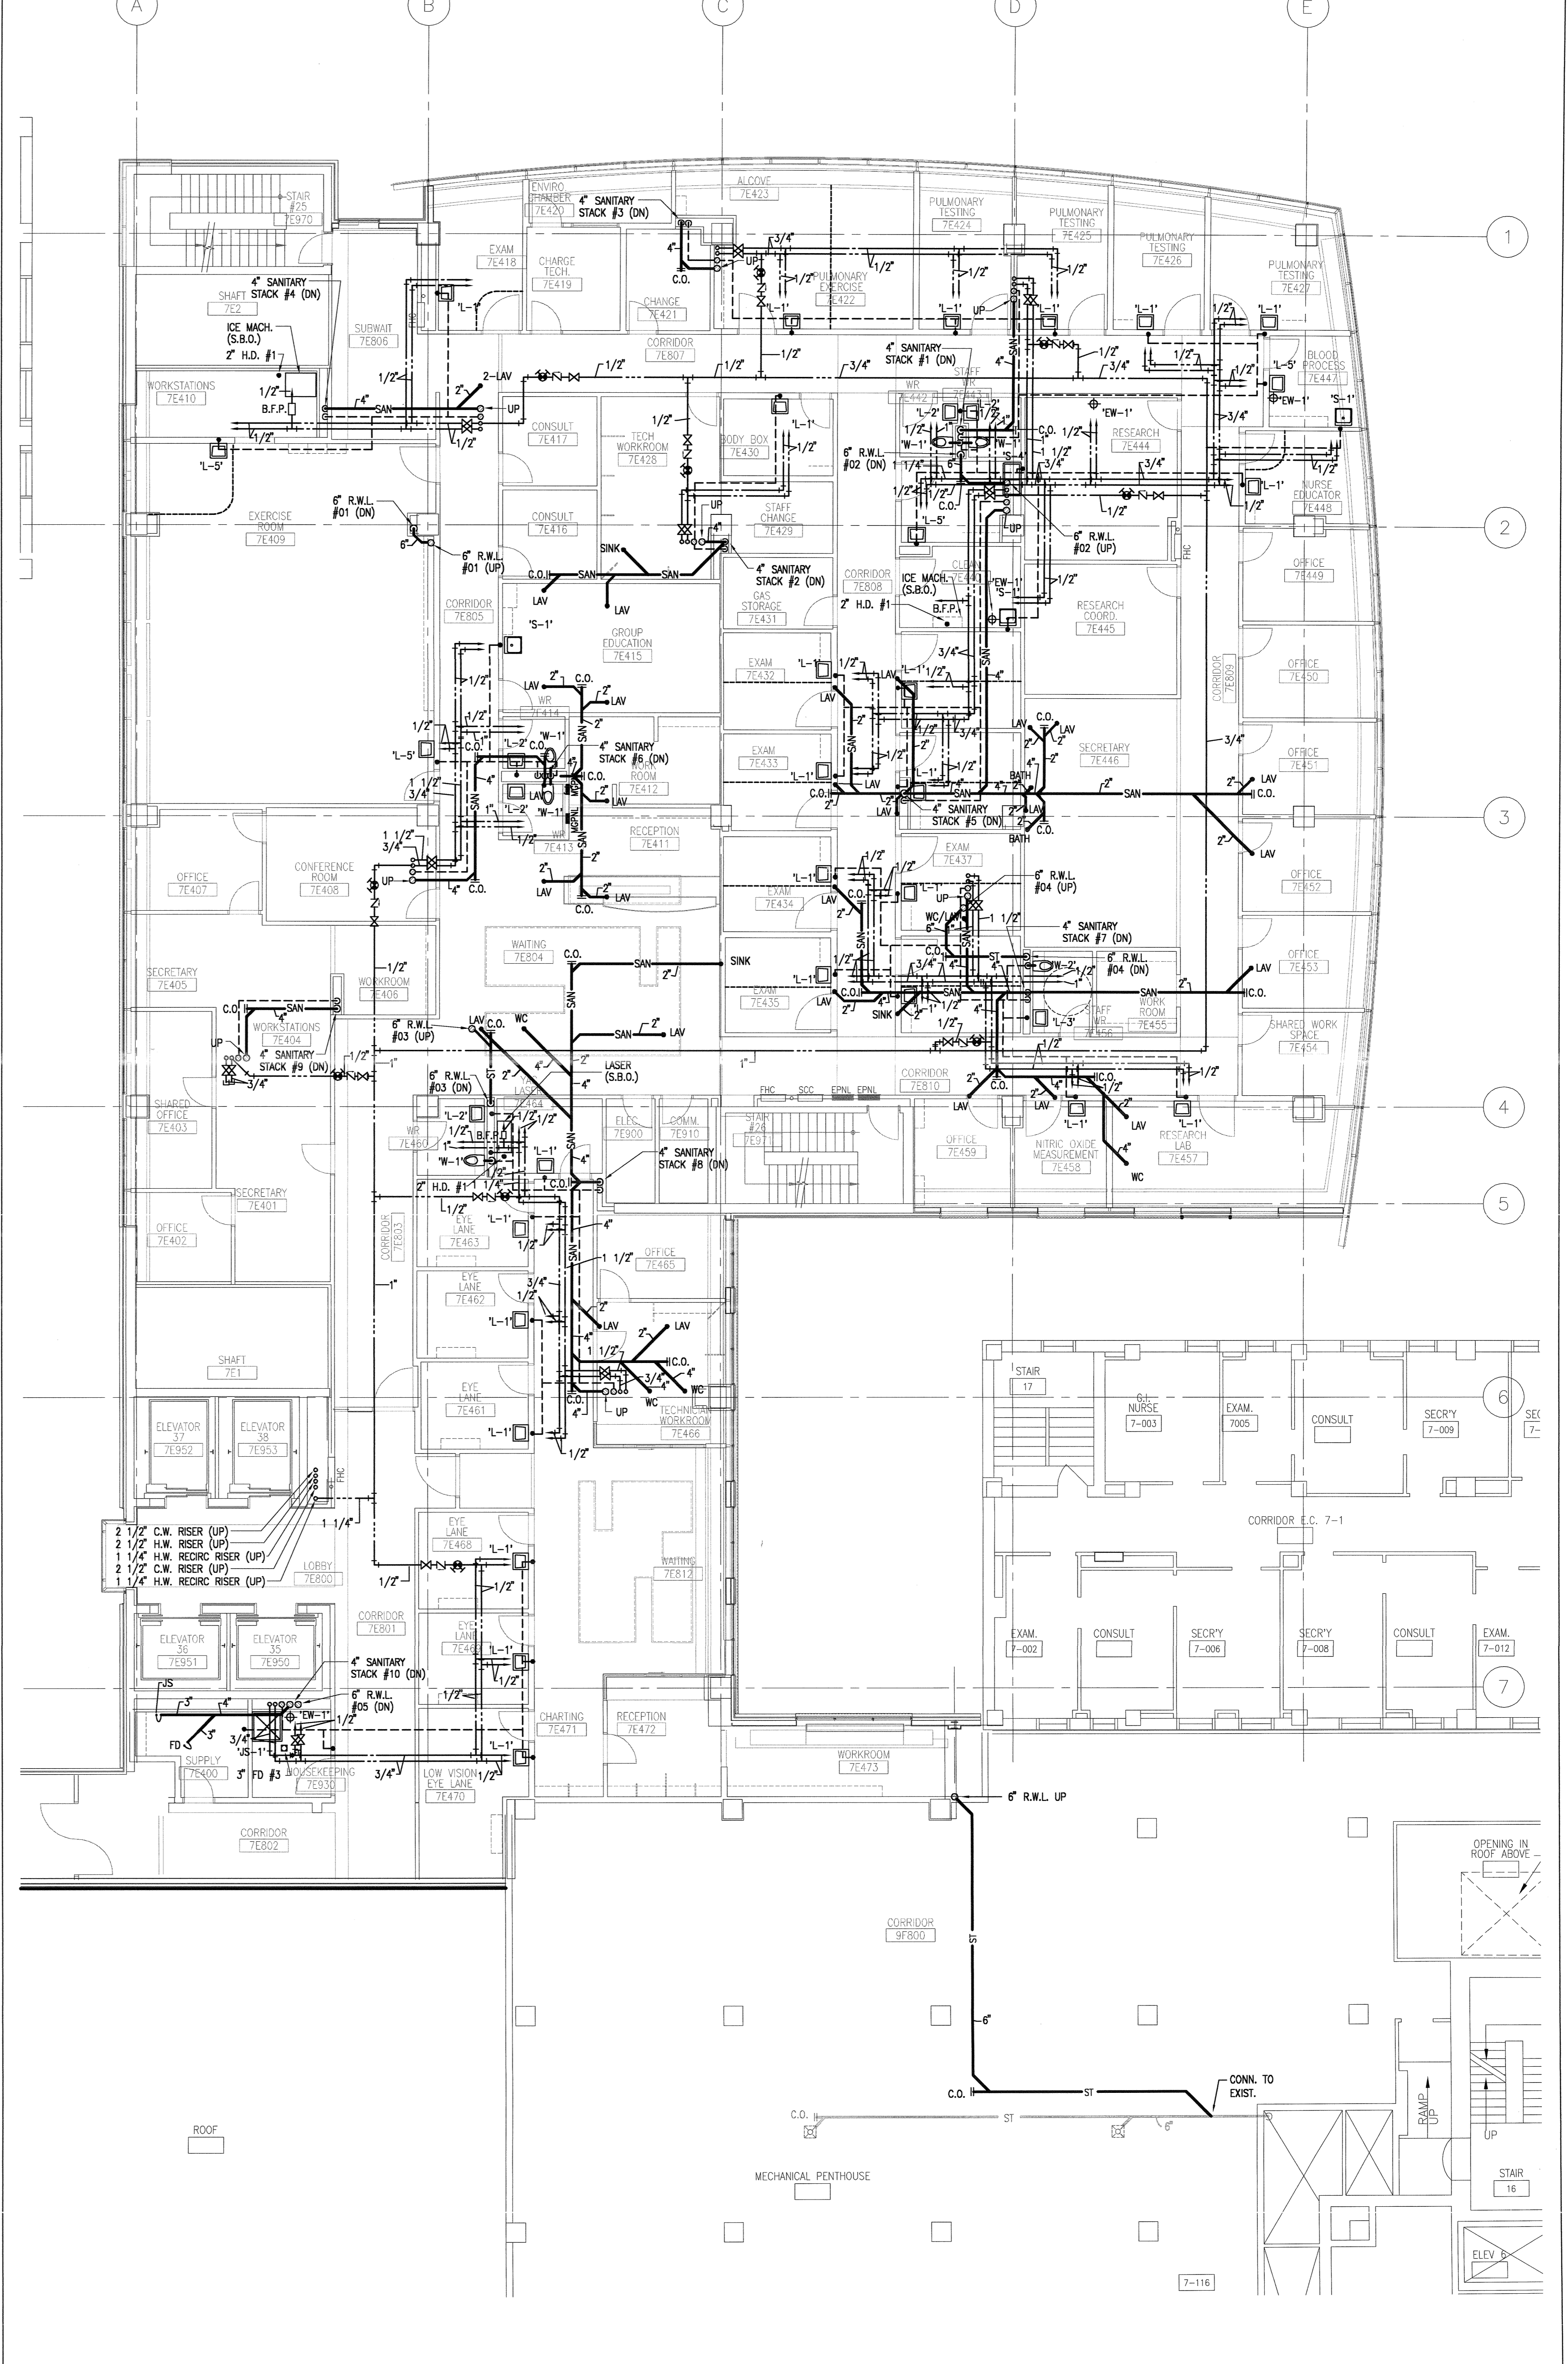


2 LEVEL SEVEN FLOOR PLAN
304 Scale: 1:100

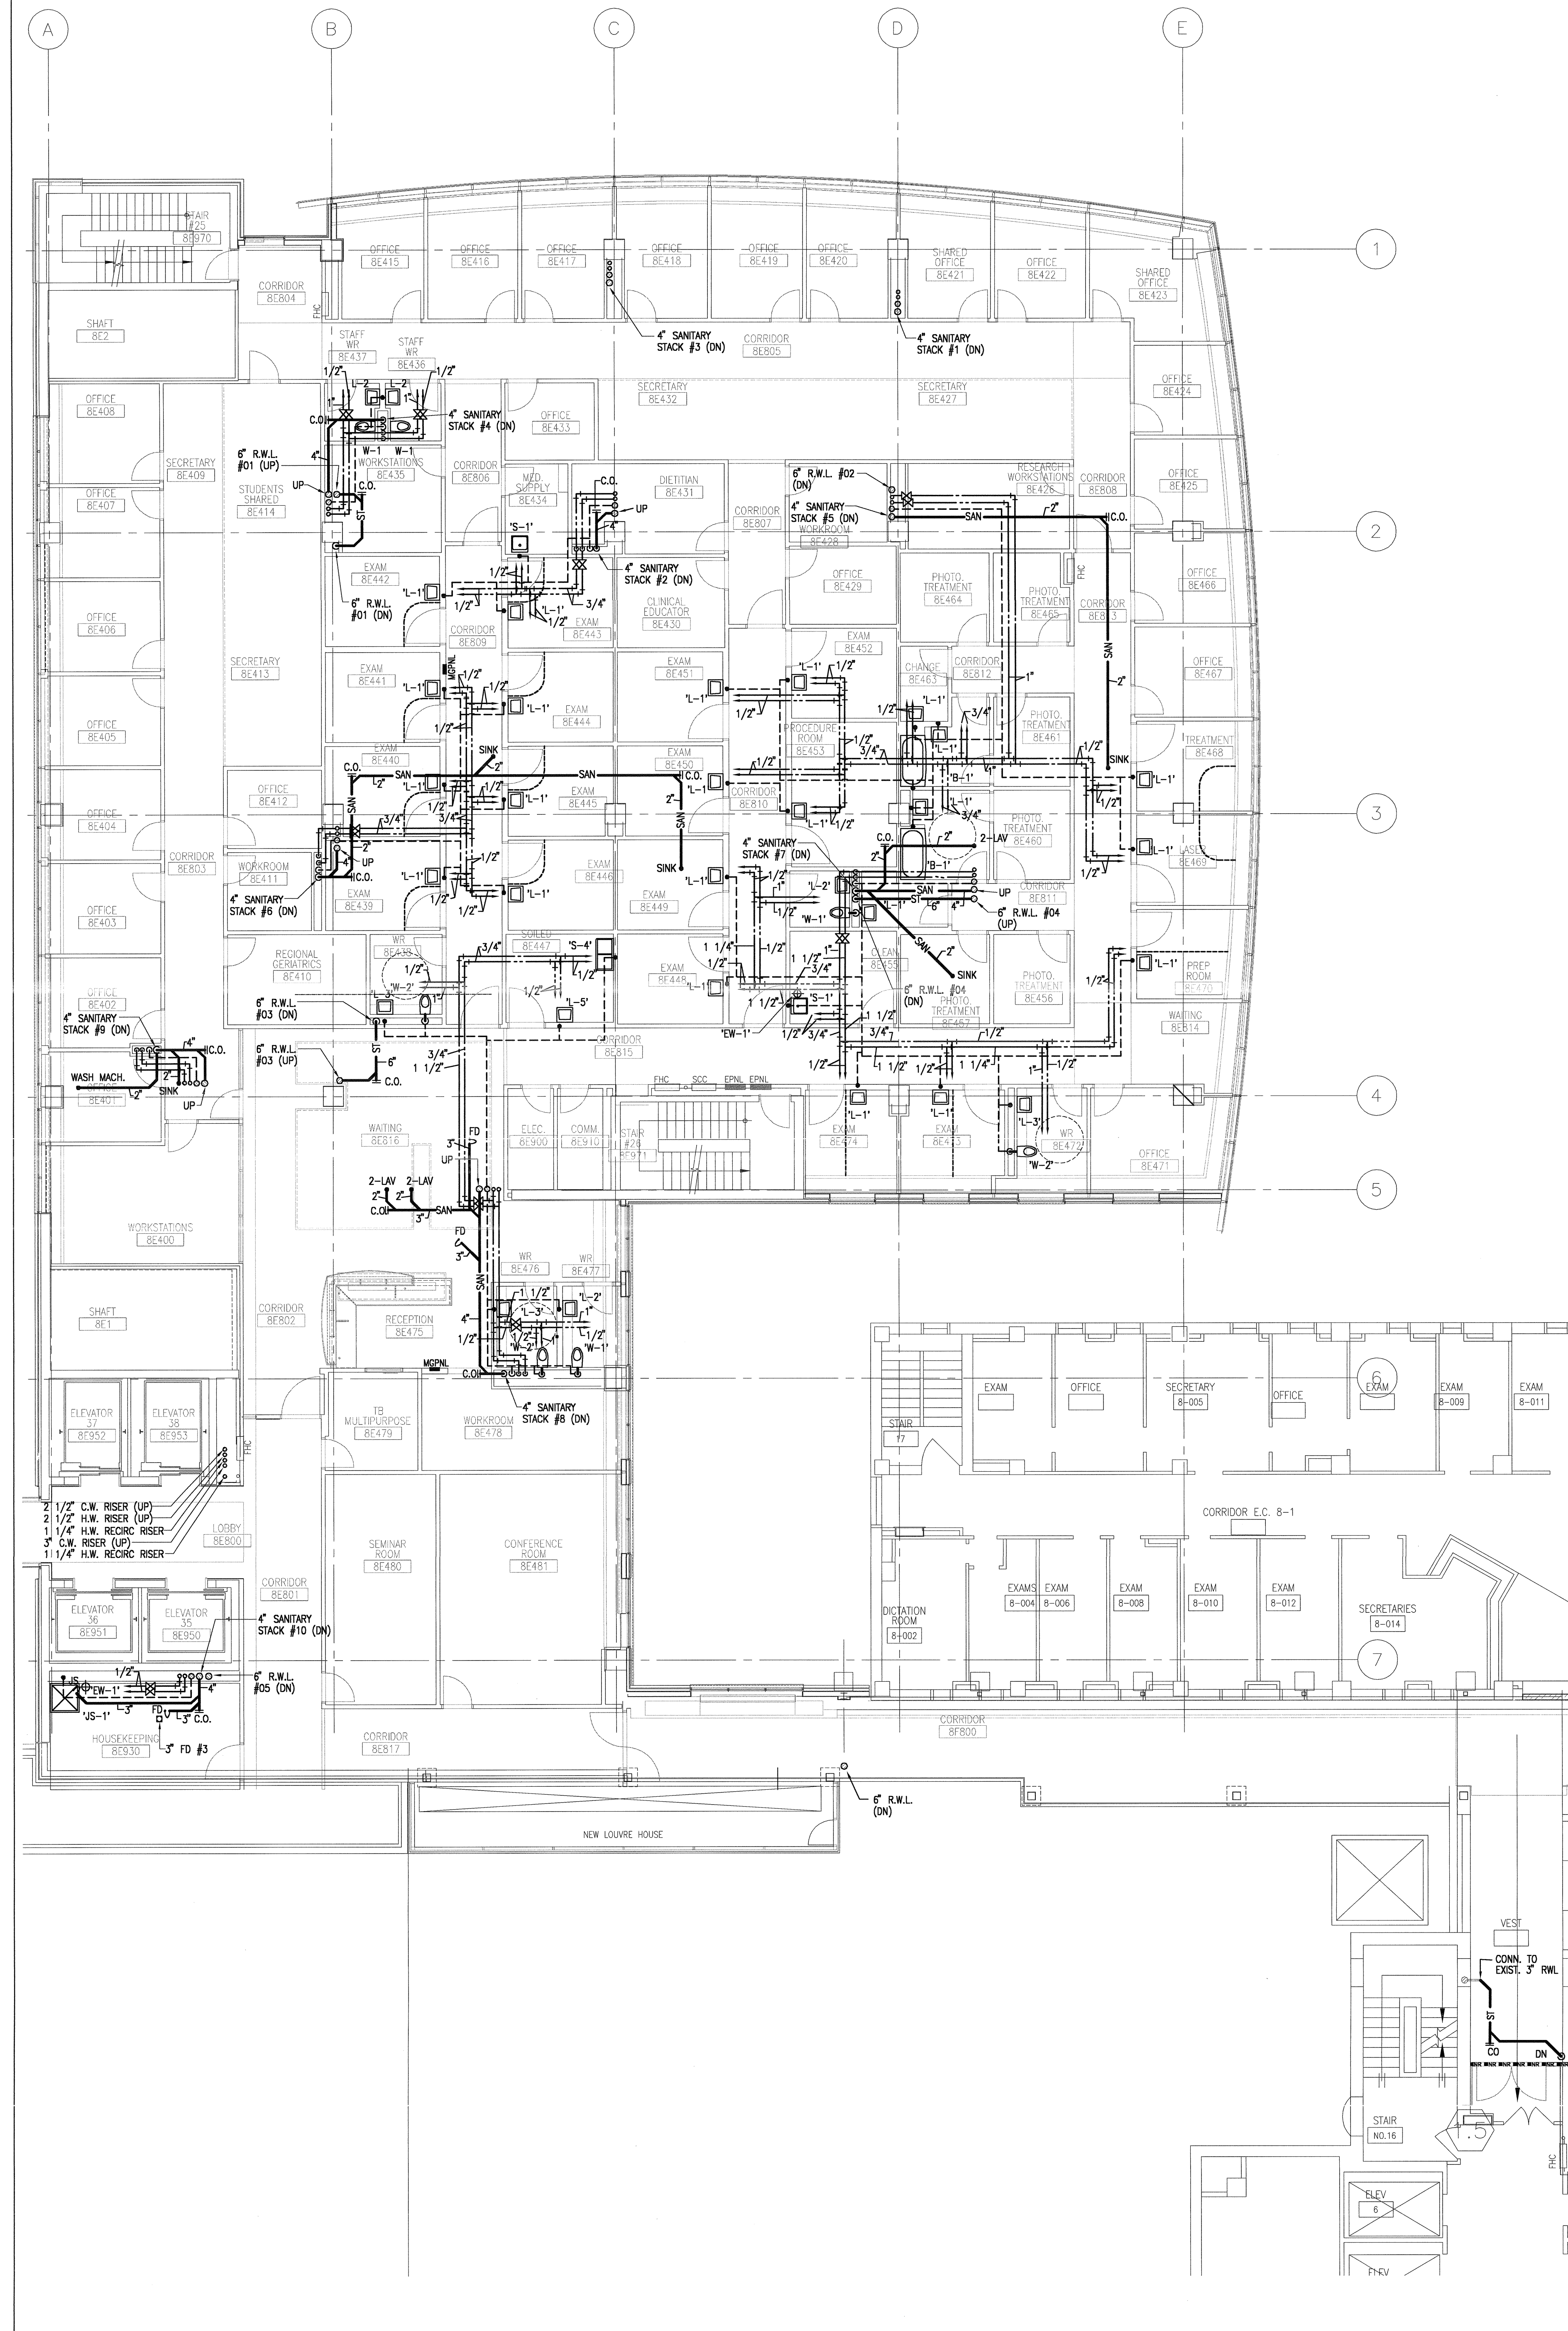

1 LEVEL EIGHT FLOOR PLAN
Scale: 1:100

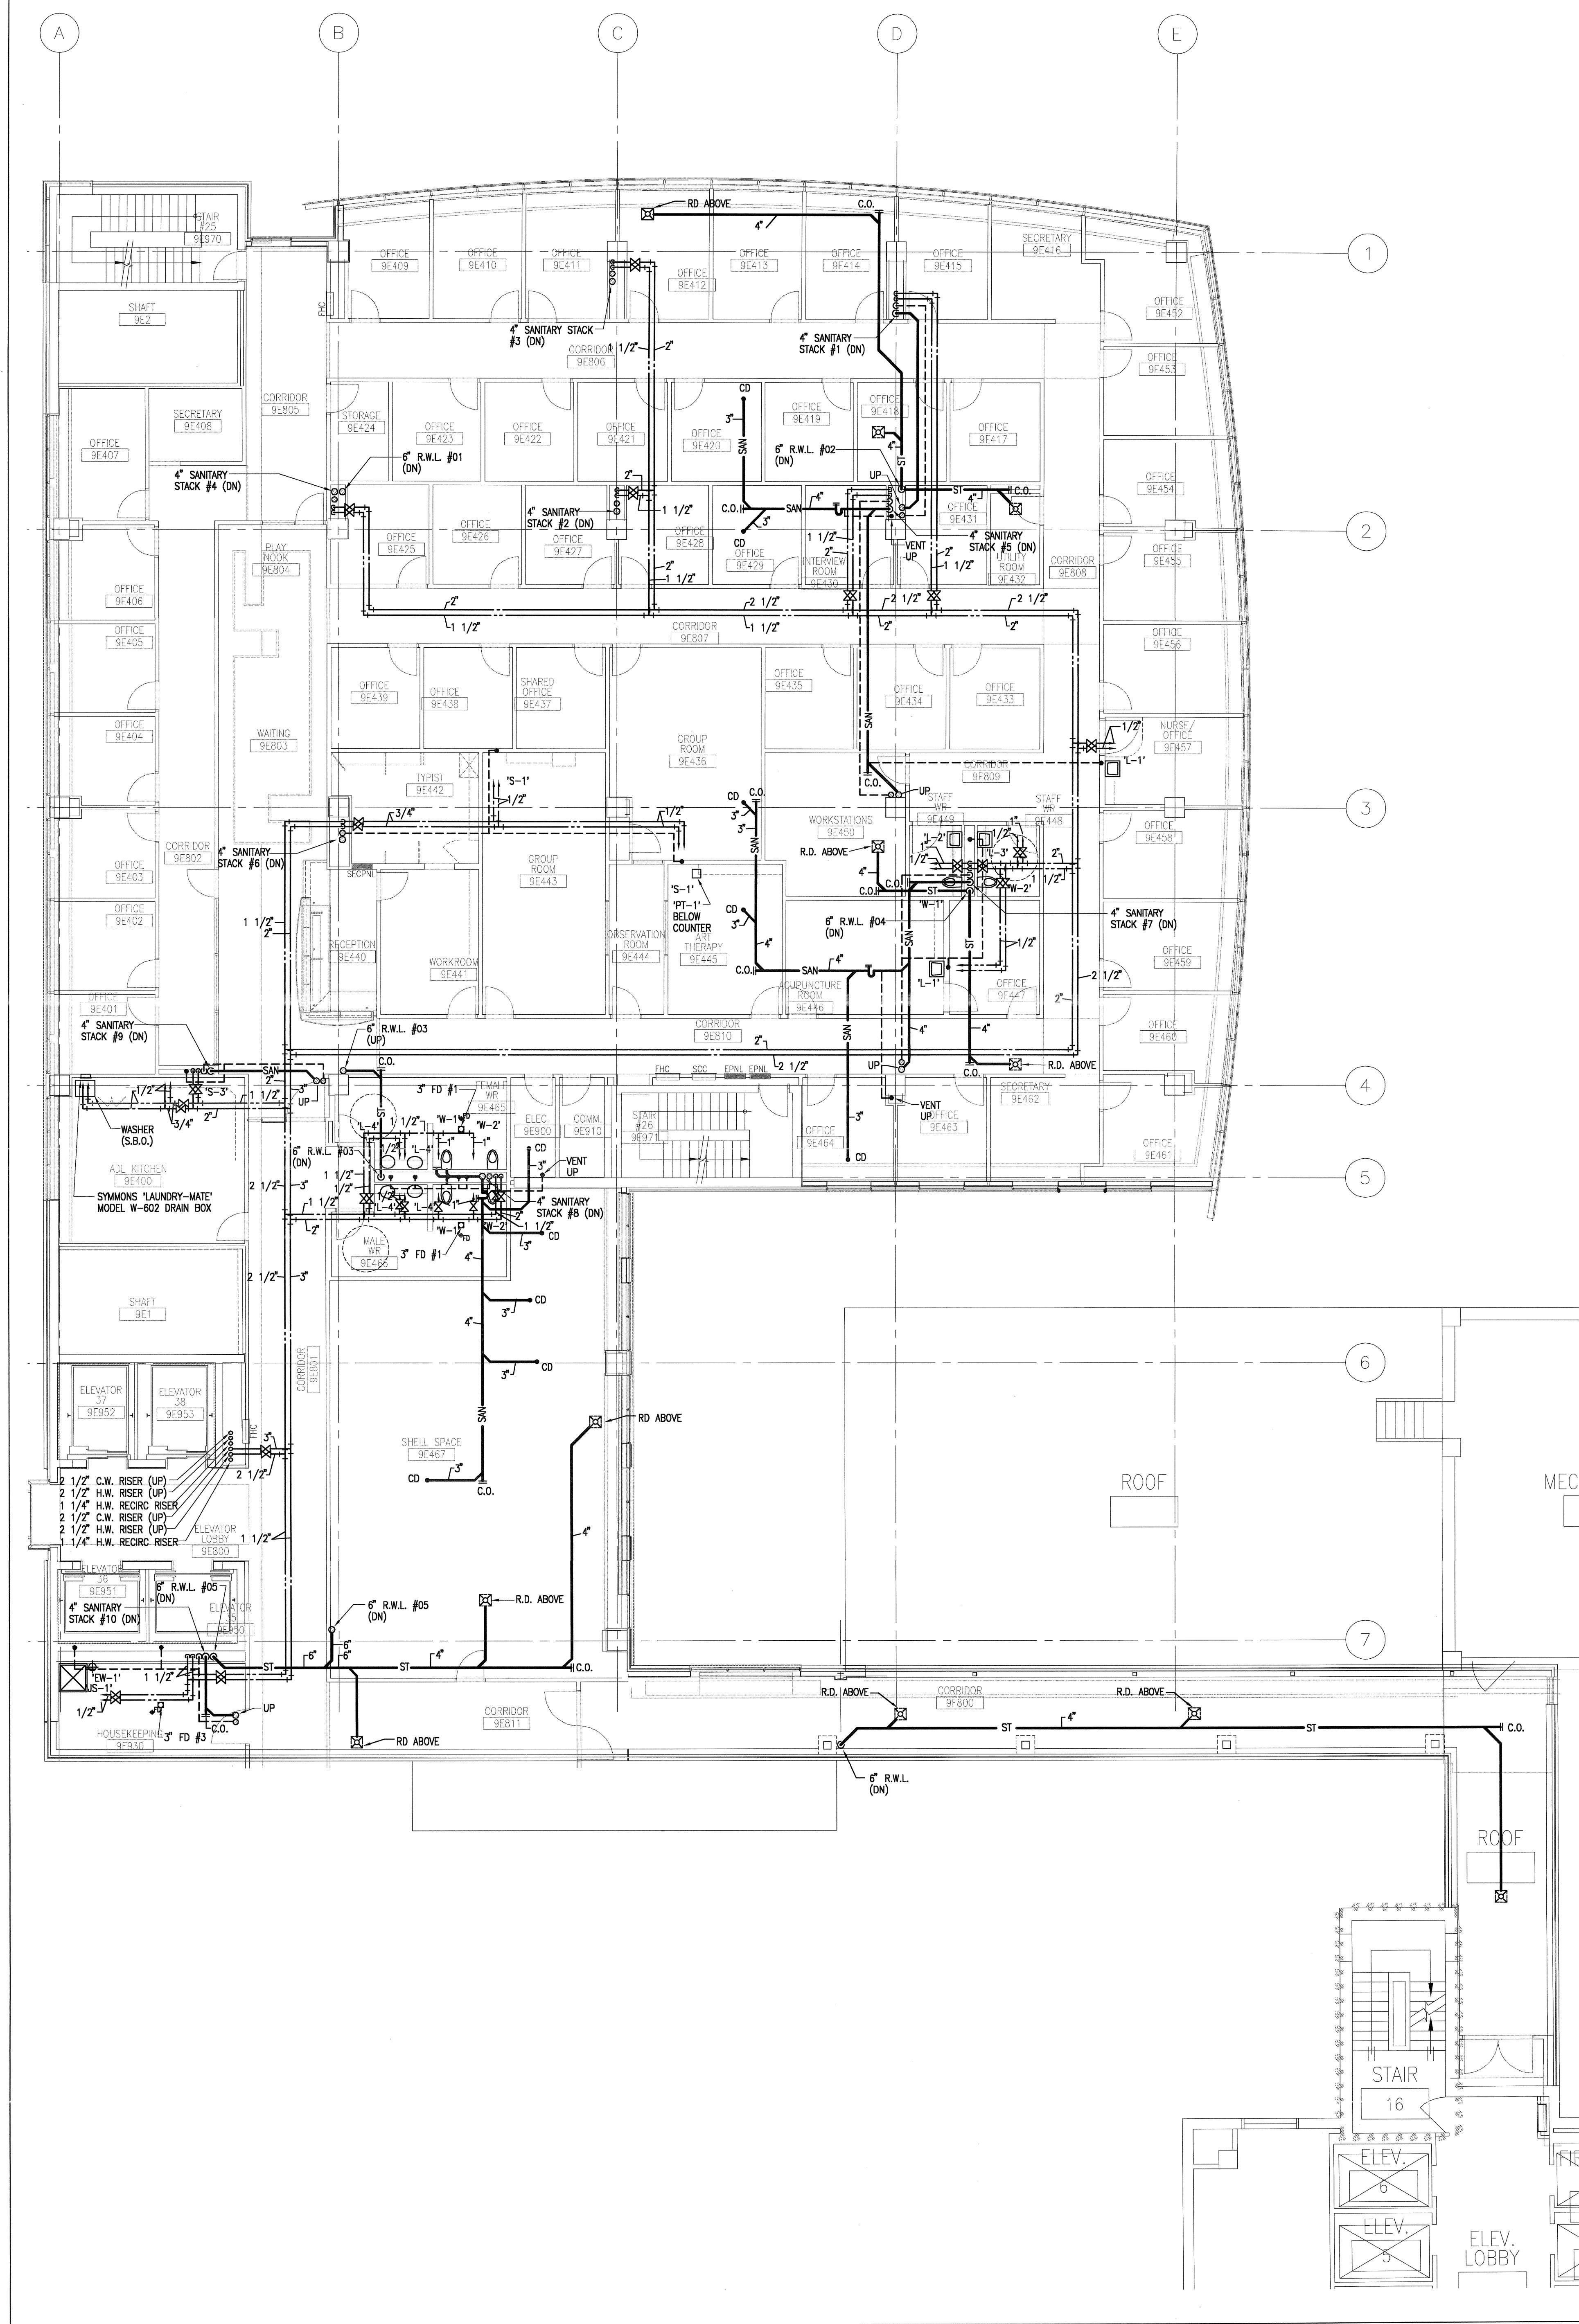


2 LEVEL NINE FLOOR PLAN
Scale: 1:100

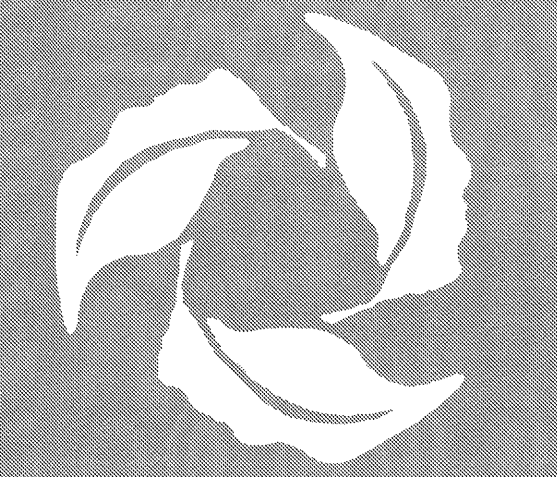

Toronto Western Hospital


University Health Network

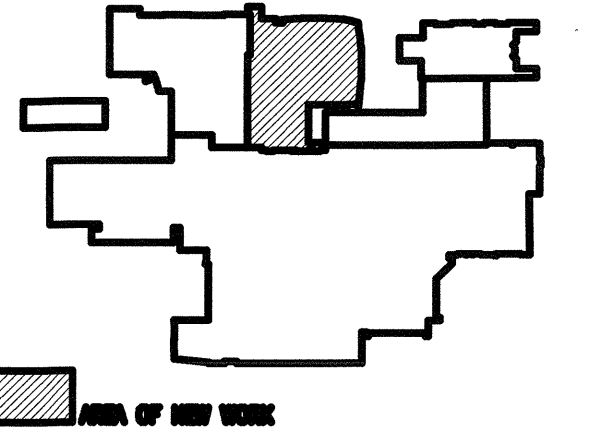

REV PLAN (305)

10	07/04/20	ISSUED FOR AS-BUILT DRAWINGS
9	03/06/20	ISSUED FOR CONSTRUCTION
8	03/06/21	REVISED FOR ADDENDUM M4
7	03/04/21	REVISED FOR ADDENDUM M1
6	03/03/21	ISSUED FOR BUILDING PERMIT
5	03/03/21	ISSUED FOR GENERAL TENDER
4	03/01/21	ISSUED FOR RISE COSTING
3	02/12/21	APPLICATION FOR BUILDING PERMIT
2	02/11/21	ISSUED FOR RISE REVIEW
1	02/08/21	ISSUED FOR COSTING
REV.	DATE	DESCRIPTION
	(yy/mm/dd)	

CHECK AND VERIFY ALL DIMENSIONS BEFORE PROCEEDING
DO NOT SCALE DRAWINGS.

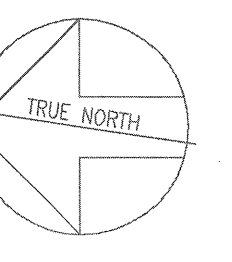

CONSTRUCTION
NORTH

AS-BUILT DRAWINGS


PROJECT NAME:
TORONTO WESTERN HOSPITAL
EAST WING REDEVELOPMENT
MAIN BUILDING - STAGE TWO
TORONTO ONTARIO

DRAWING TITLE:
LEVEL 8 FLOOR PLAN
LEVEL 9 FLOOR PLAN
PLUMBING


SCALE:
1 : 100
DATE:
MARCH 2023
DRAWN BY:
CHECKED BY:

PROJECT NUMBER:
2011210


DRAWING NUMBER:
M2-305

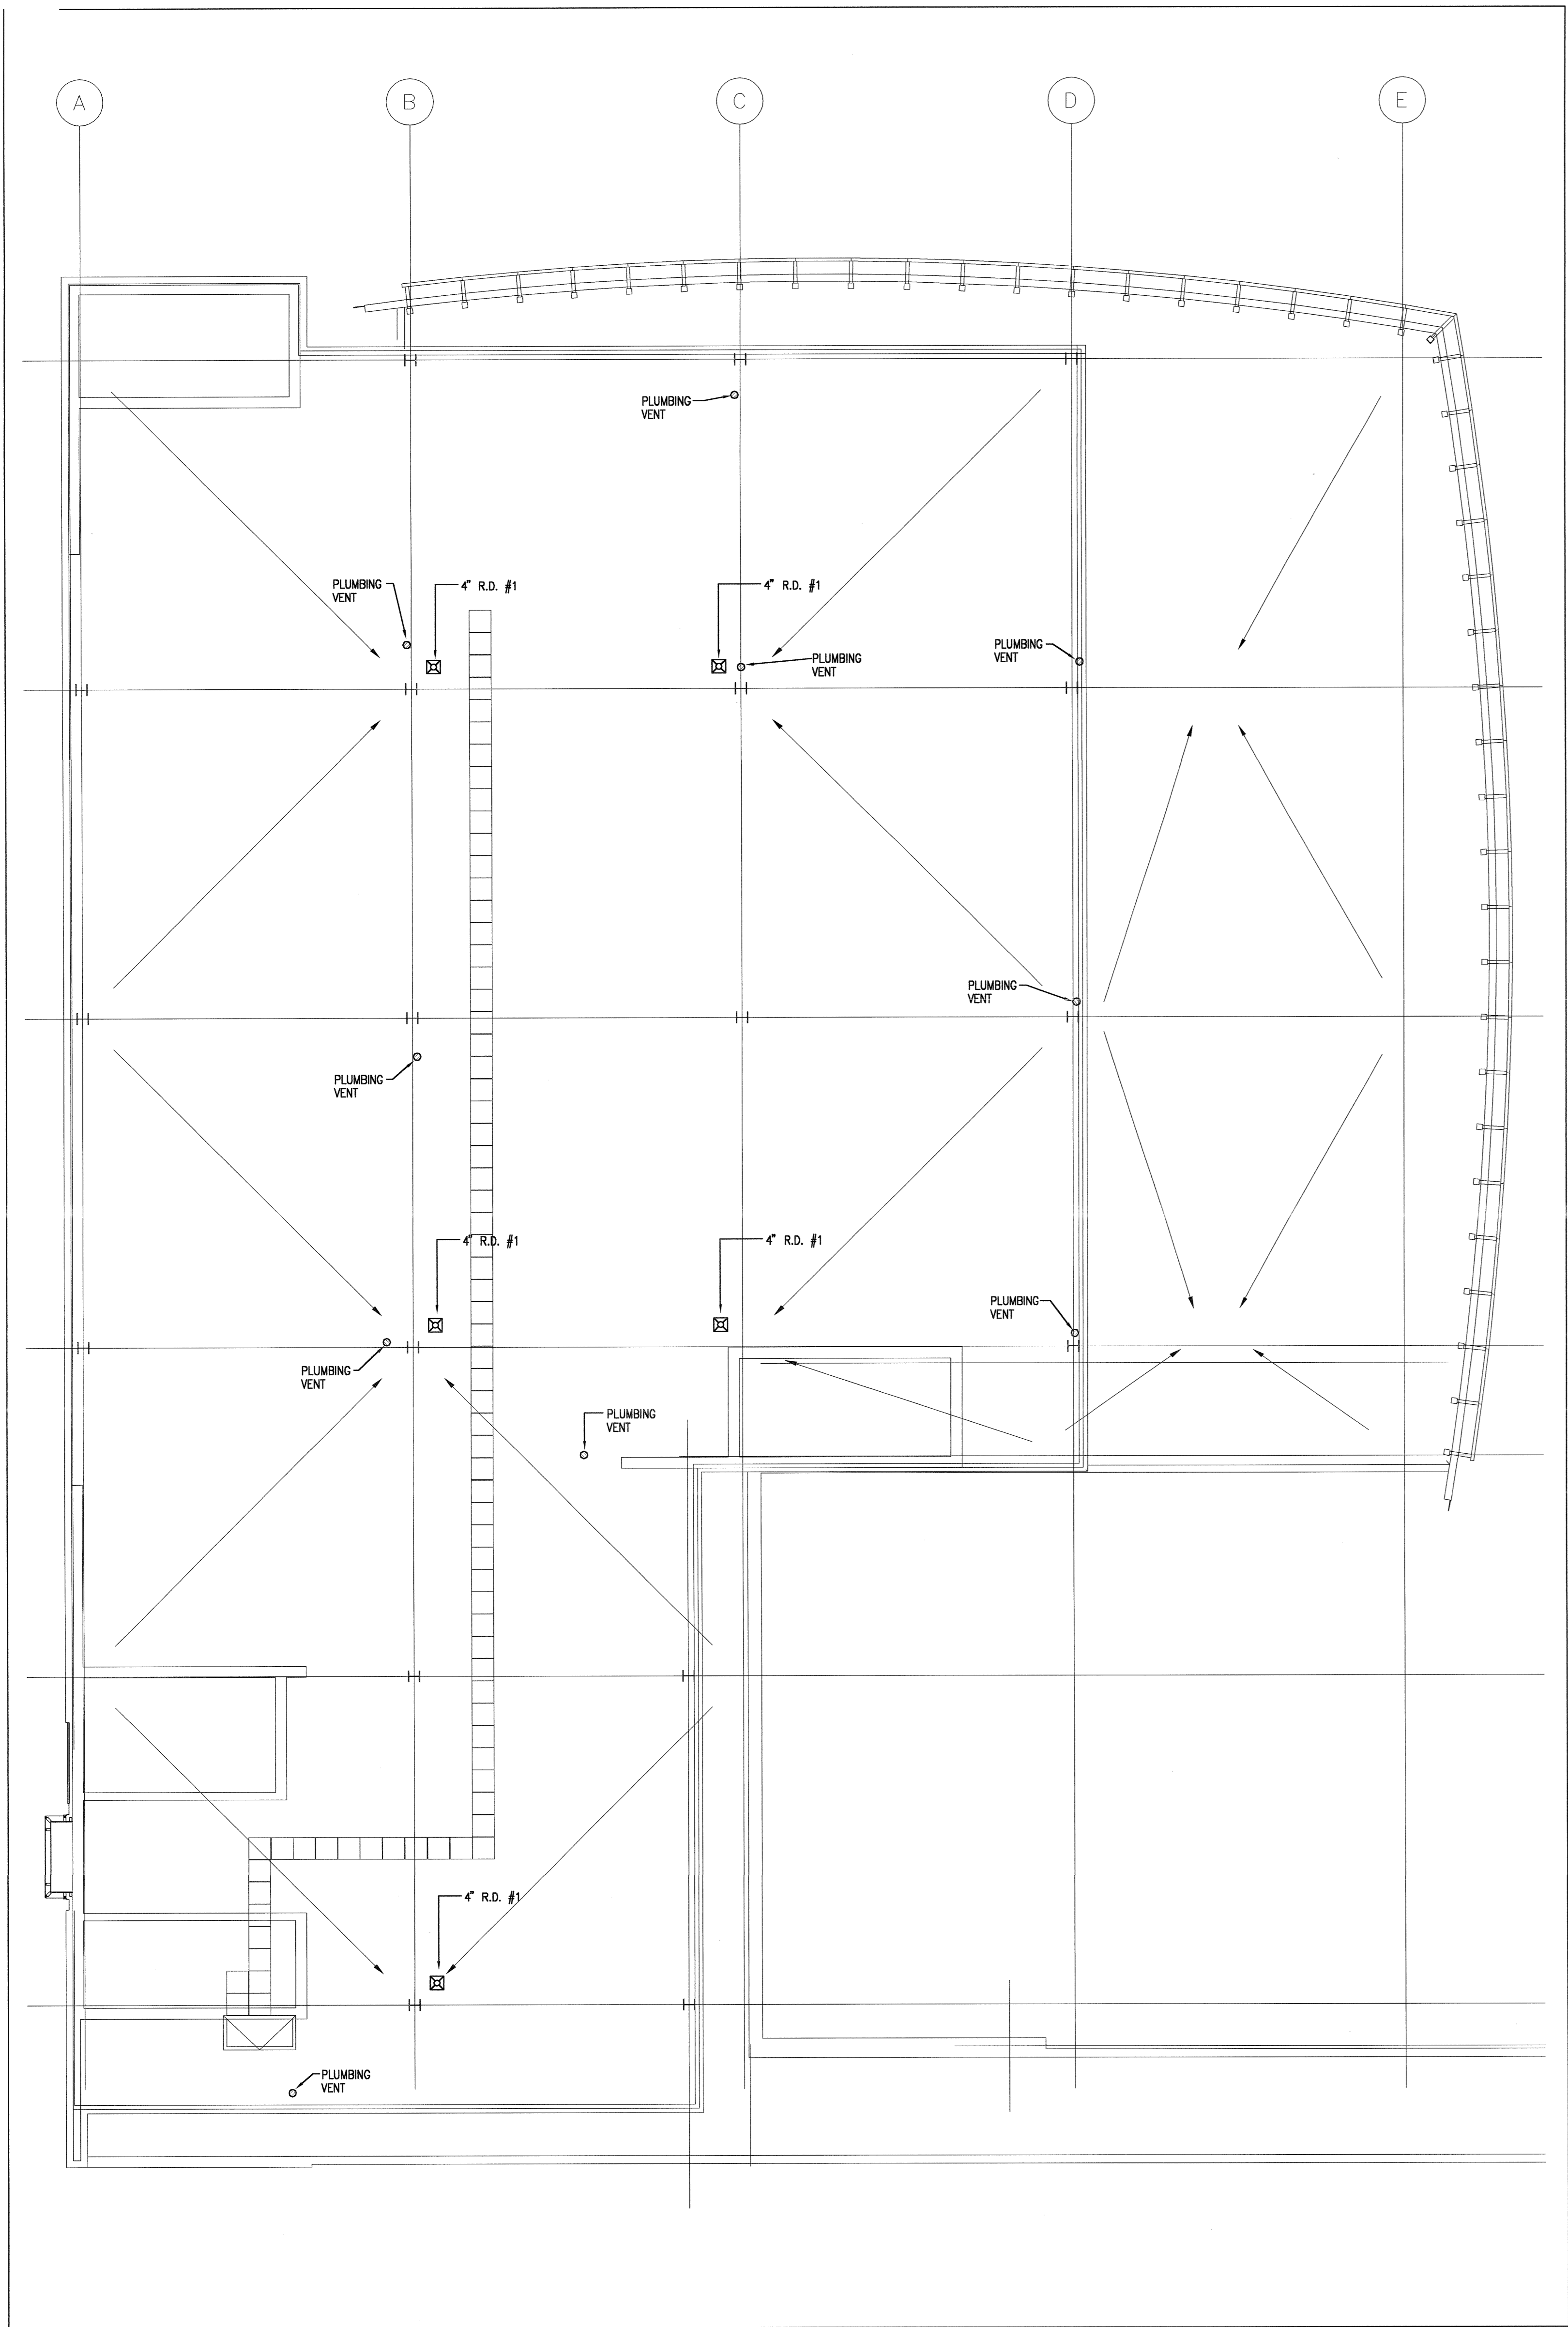

1 ROOF PLAN
306 Scale: 1:100

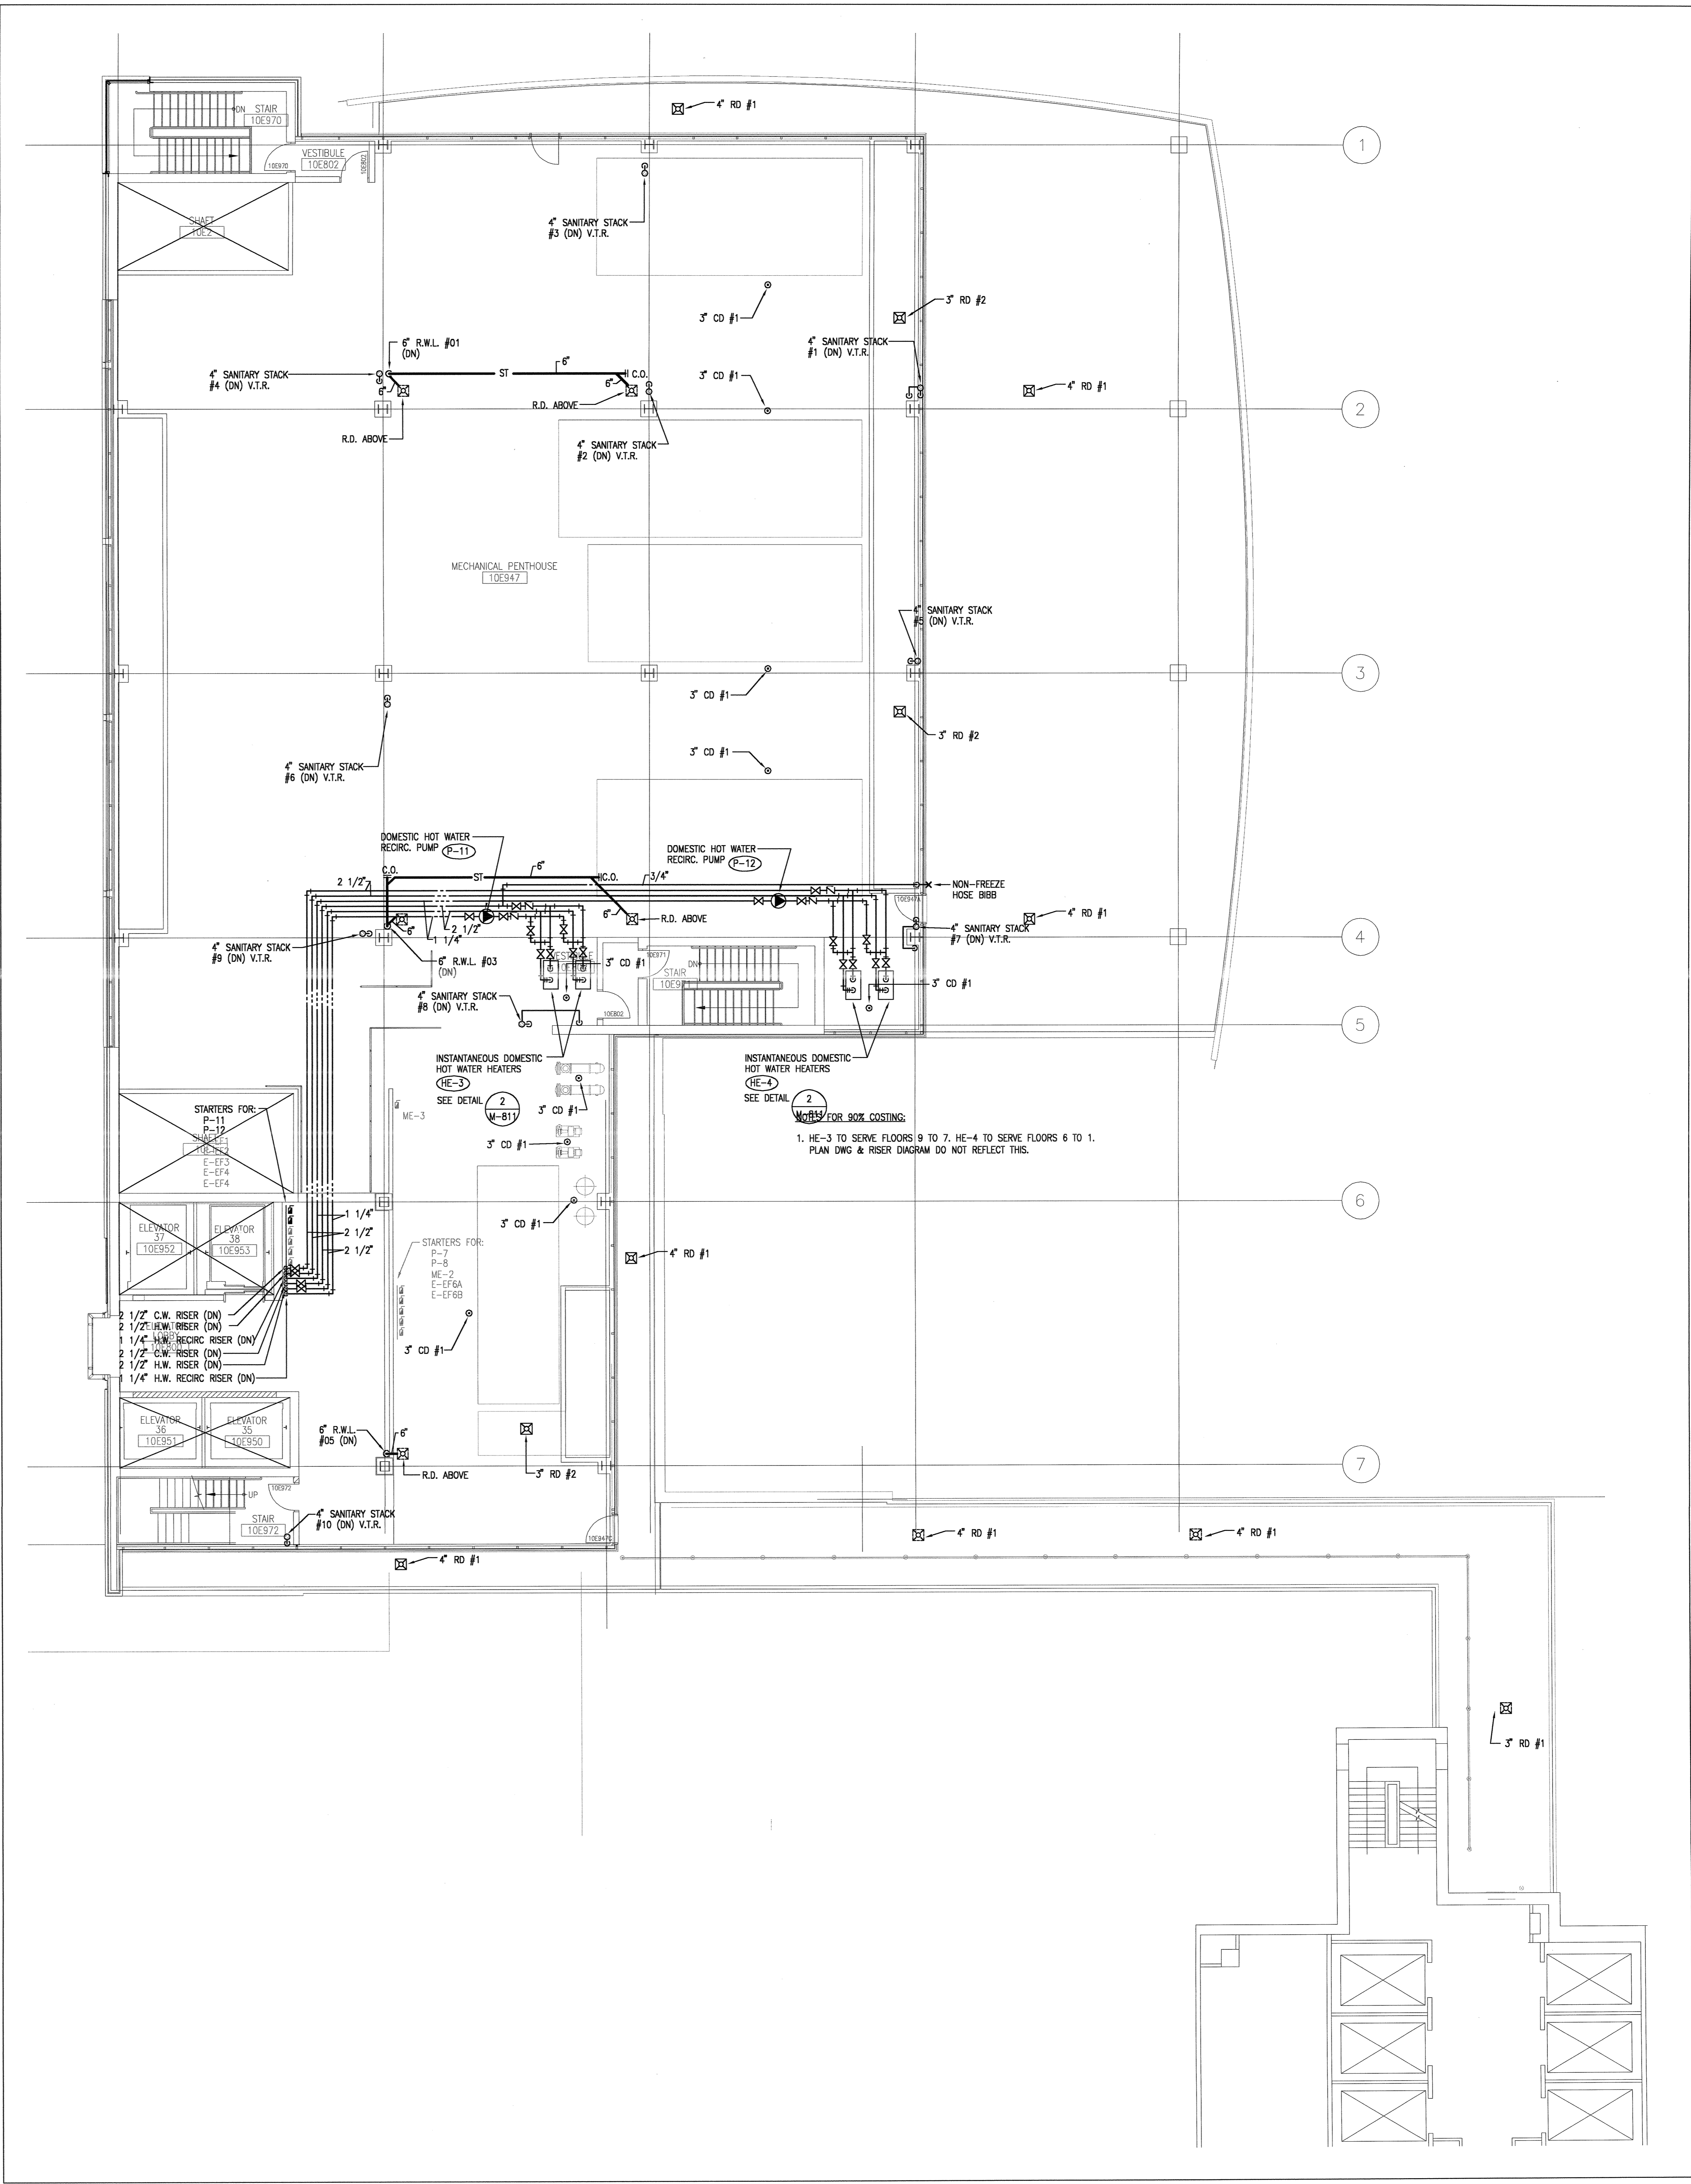


2 PENTHOUSE FLOOR PLAN
306 Scale: 1:100

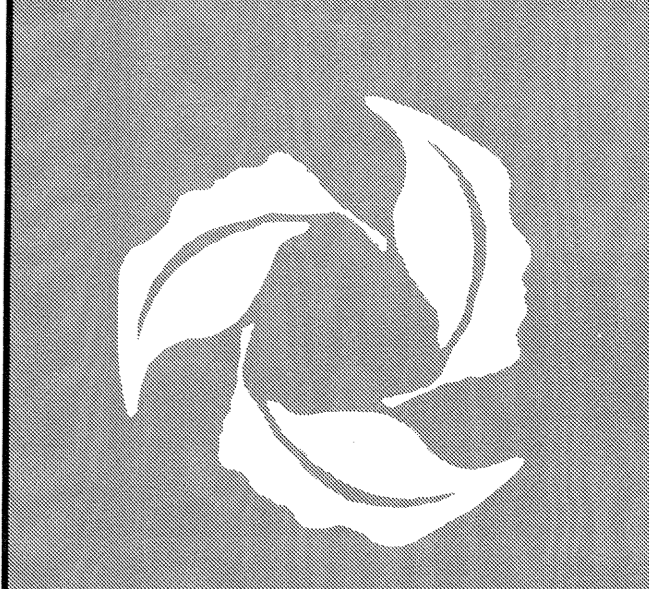

Toronto Western Hospital


University Health Network

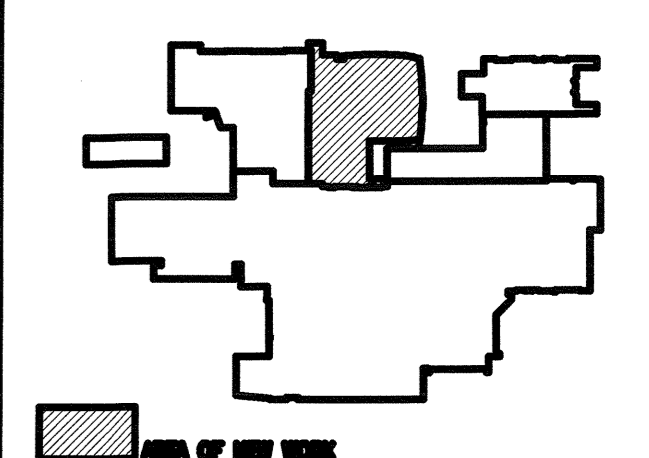

NEW PLAN (RCA)

REF.	DATE	DESCRIPTION
8	07/04/20	ISSUED FOR AS BUILT DRAWINGS
7	03/06/20	ISSUED FOR CONSTRUCTION
6	03/05/17	REVISED FOR ADDENDUM M4
5	03/05/17	REVISED FOR ADDENDUM M4
4	03/03/27	ISSUED FOR BUILDING PERMIT
3	03/03/18	ISSUED FOR GENERAL TENDER
2	03/01/28	ISSUED FOR BIDS COSTING
1	02/12/18	APPLICATION FOR BUILDING PERMIT

CHECK AND VERIFY ALL DIMENSIONS BEFORE PROCEEDING WITH THE WORK. DO NOT SCALE DRAWINGS.

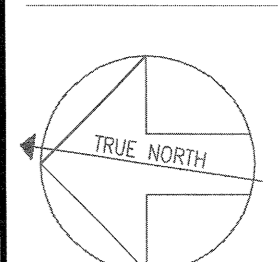

CONSTRUCTION NORTH

AS-BUILT DRAWINGS

PROJECT NAME:
TORONTO WESTERN HOSPITAL
EAST WING REDEVELOPMENT
MAIN BUILDING - STAGE TWO
TORONTO ONTARIO


DRAWING TITLE:
PENTHOUSE FLOOR PLAN
ROOF PLAN
PLUMBING

SCALE: 1 : 100	PROJECT NUMBER: 2011210
DATE: MARCH 2003	DRAWING NUMBER: M2-306
DRAWN BY:	CHECKED BY:



Toronto Western Hospital

University Health Network

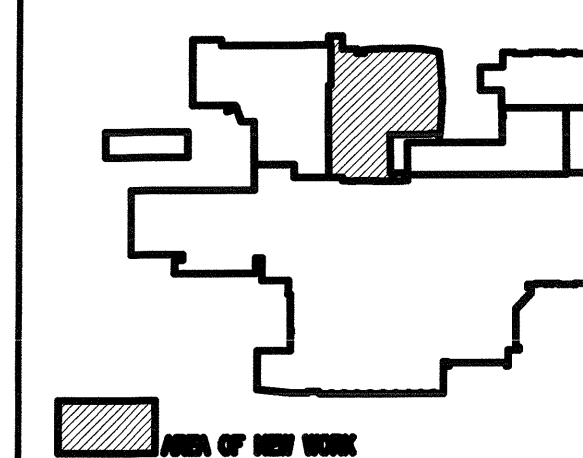


REF PLAN (B22)

- 8 07/04/20 ISSUED FOR AS-BUILT DRAWINGS
- 7 03/06/20 ISSUED FOR CONSTRUCTION
- 6 03/03/21 ISSUED FOR BUILDING PERMIT
- 5 03/03/18 ISSUED FOR GENERAL TENDER
- 4 03/01/20 ISSUED FOR BOK COSTING
- 3 02/12/19 APPLICATION FOR BUILDING PERMIT
- 2 02/11/17 ISSUED FOR BOK REVIEW
- 1 02/06/16 ISSUED FOR COSTING

REF. SHEET DESCRIPTION
(x/y/mm/yy)

CHECK AND VERIFY ALL DIMENSIONS BEFORE PROCEEDING WITH THE WORK.

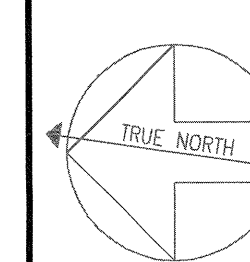

CONSTRUCTION NORTH

AS-BUILT DRAWINGS


PROJECT NAME:
TORONTO WESTERN HOSPITAL
EAST WING REDEVELOPMENT
MAIN BUILDING - STAGE TWO
TORONTO ONTARIO

DRAWING TITLE:
LOWER LEVEL FLOOR PLAN
LEVEL 1 FLOOR PLAN
MEDICAL GASES


SCALE:
1 : 100
DATE:
MARCH 2003
DRAWN BY:
CHECKED BY:

PROJECT NUMBER:
2011210

DRAWING NUMBER:
M2-401

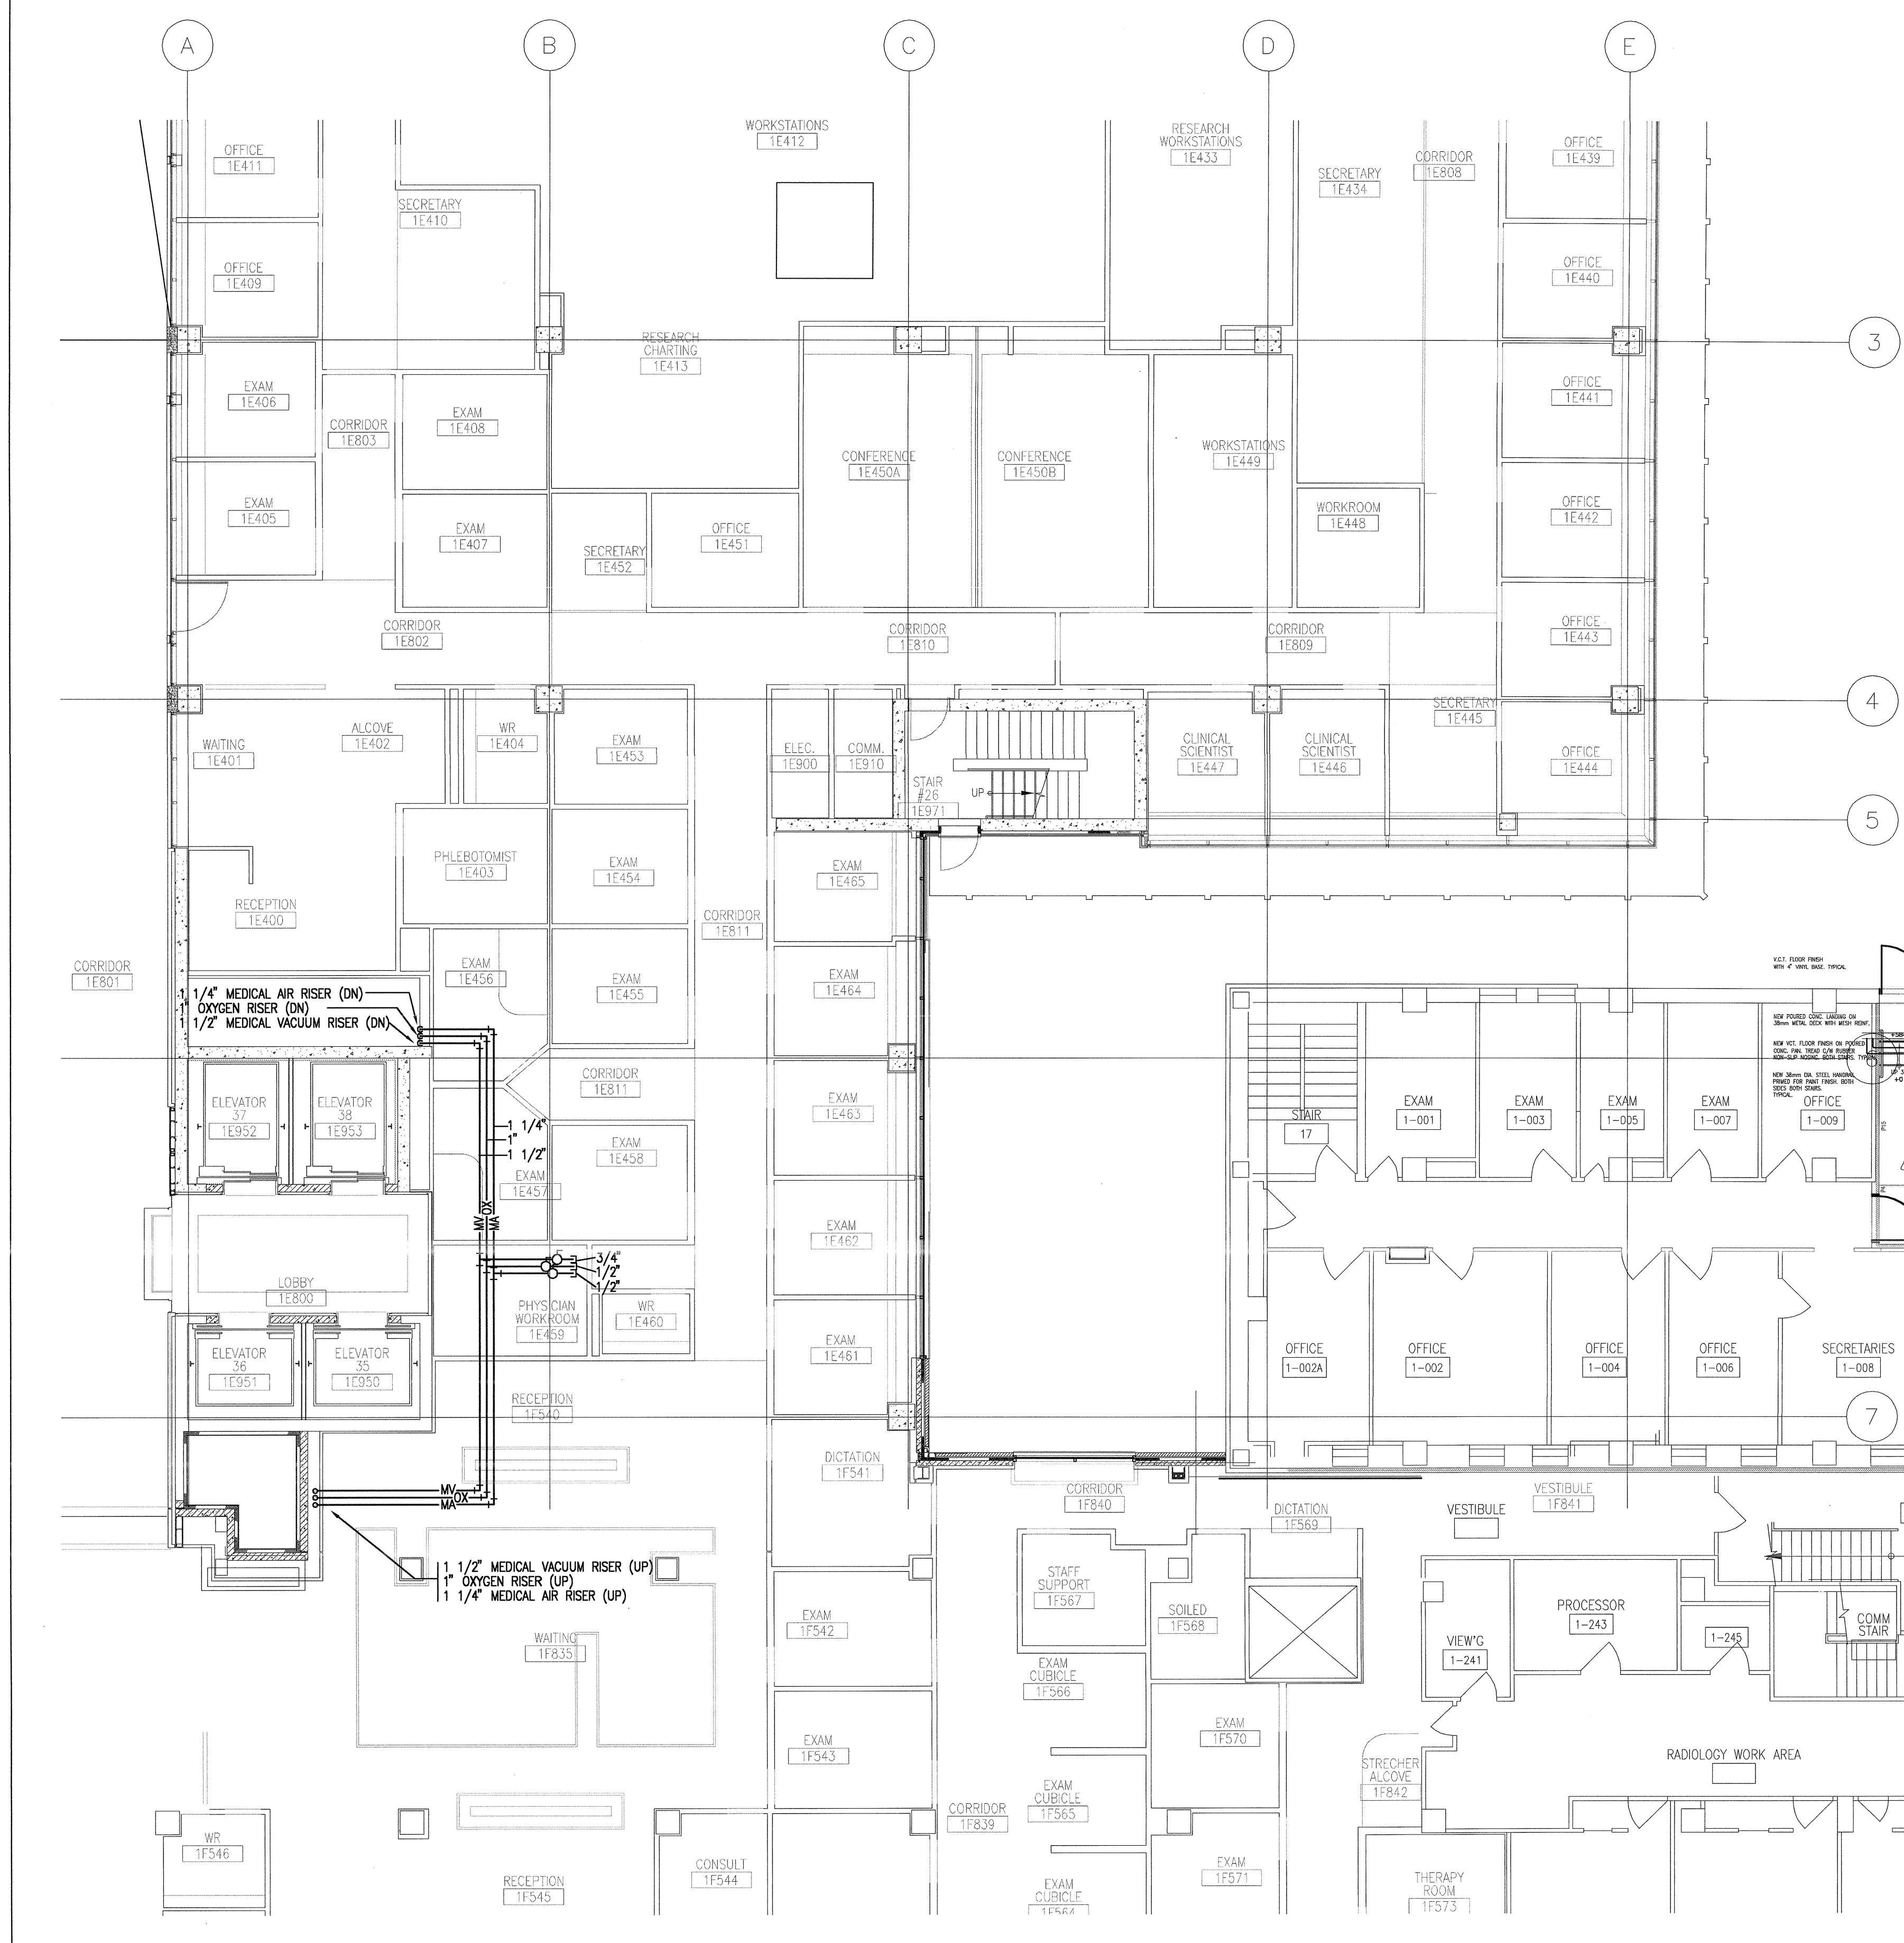

2 LEVEL ONE FLOOR PLAN
Scale: 1:100

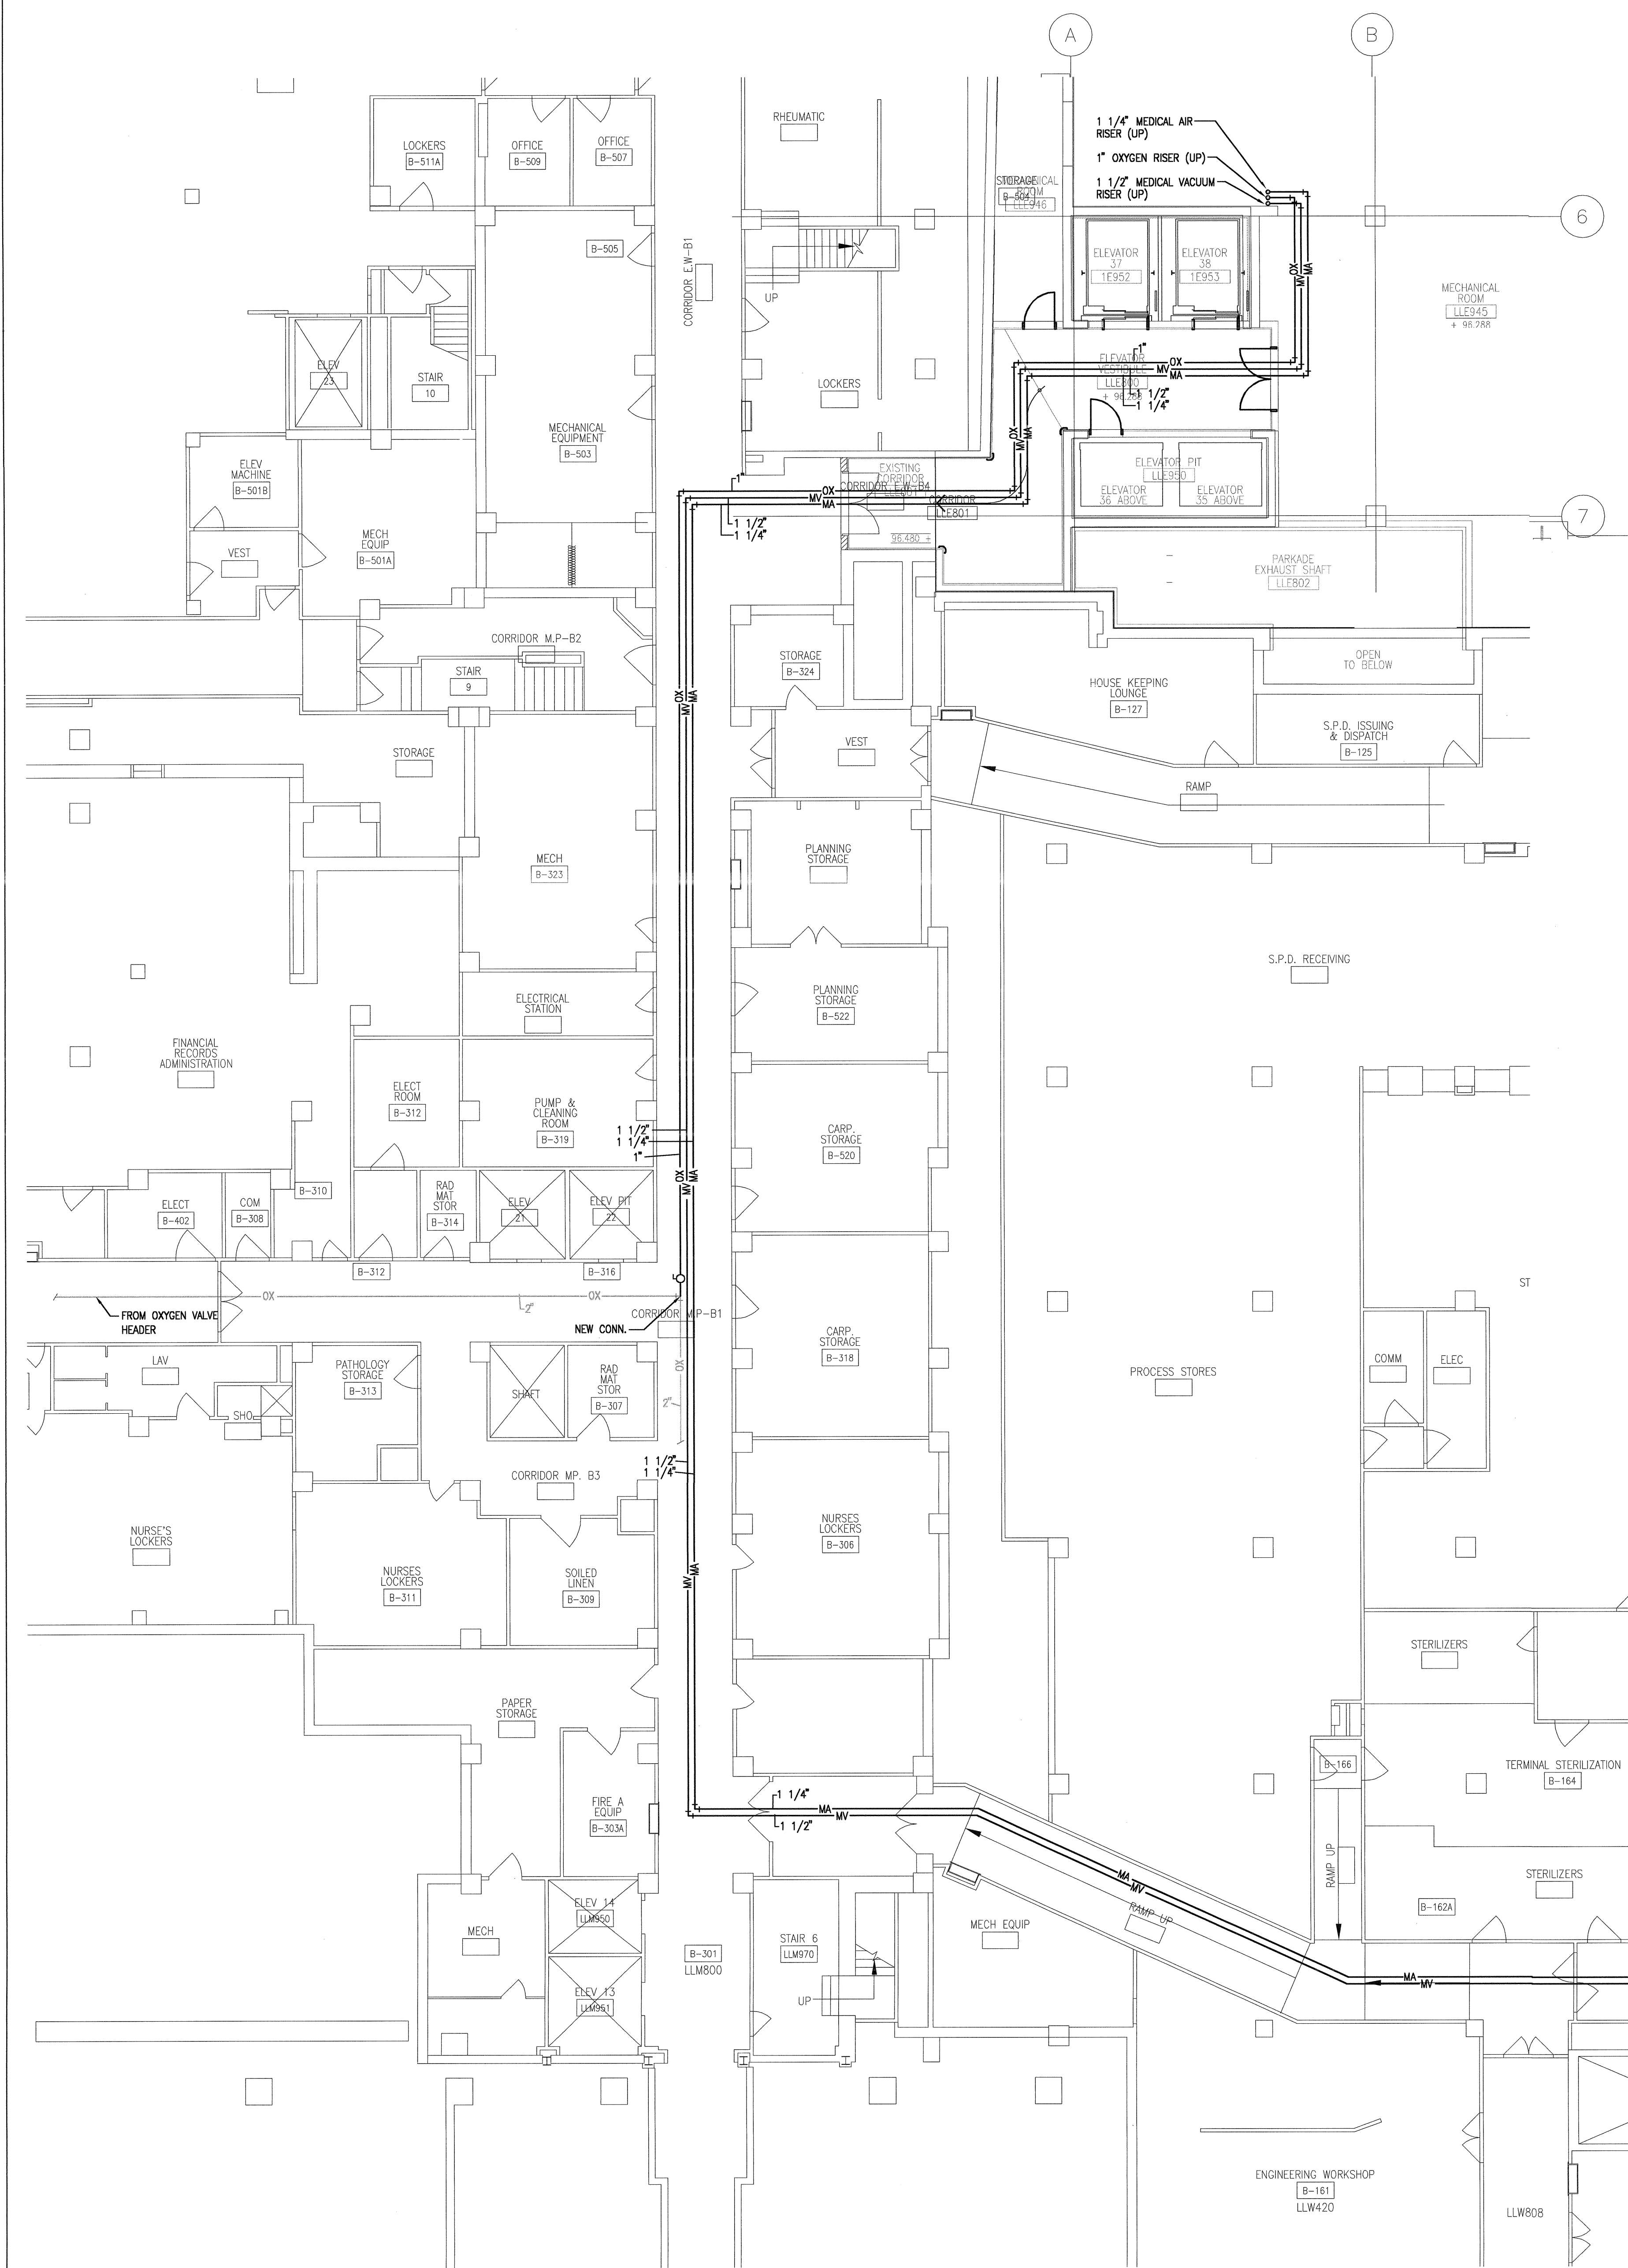


1 LOWER LEVEL FLOOR PLAN
Scale: 1:100



Toronto Western Hospital

University Health Network

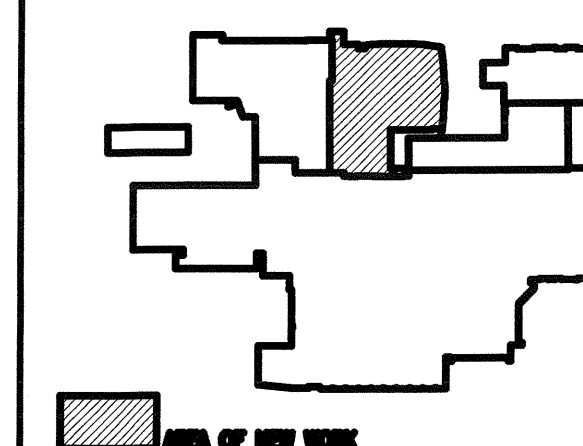


NOT FOR CONSTRUCTION

- 07/04/20 ISSUED FOR AS-BUILT DRAWINGS
- 03/06/20 ISSUED FOR CONSTRUCTION
- 03/03/27 ISSUED FOR BUILDING PERMIT
- 03/03/18 ISSUED FOR GENERAL TENDER
- 03/01/28 ISSUED FOR 90% COSTING
- 02/12/19 APPLICATION FOR BUILDING PERMIT
- 02/11/17 ISSUED FOR 60% REVIEW
- 02/08/16 ISSUED FOR COSTING

REF. DATE DESCRIPTION
(yy/mm/dd)

CHECK AND VERIFY ALL DIMENSIONS BEFORE PROCEEDING
WITH THE WORK.
DO NOT SCALE DRAWINGS.

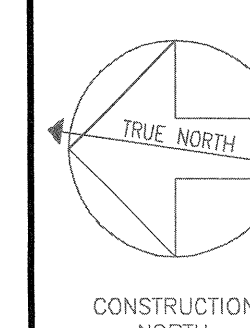


AS-BUILT DRAWINGS


PROJECT NAME:
TORONTO WESTERN HOSPITAL
EAST WING REDEVELOPMENT
MAIN BUILDING - STAGE TWO
TORONTO ONTARIO

DRAWING TITLE:
LEVEL 2 FLOOR PLAN
LEVEL 3 FLOOR PLAN
MEDICAL GASES

SCALE:
1 : 100
DATE:
MARCH 2023
DRAWN BY:
CHECKED BY:
PROJECT NUMBER:
2011210
DRAWING NUMBER:
M2-402

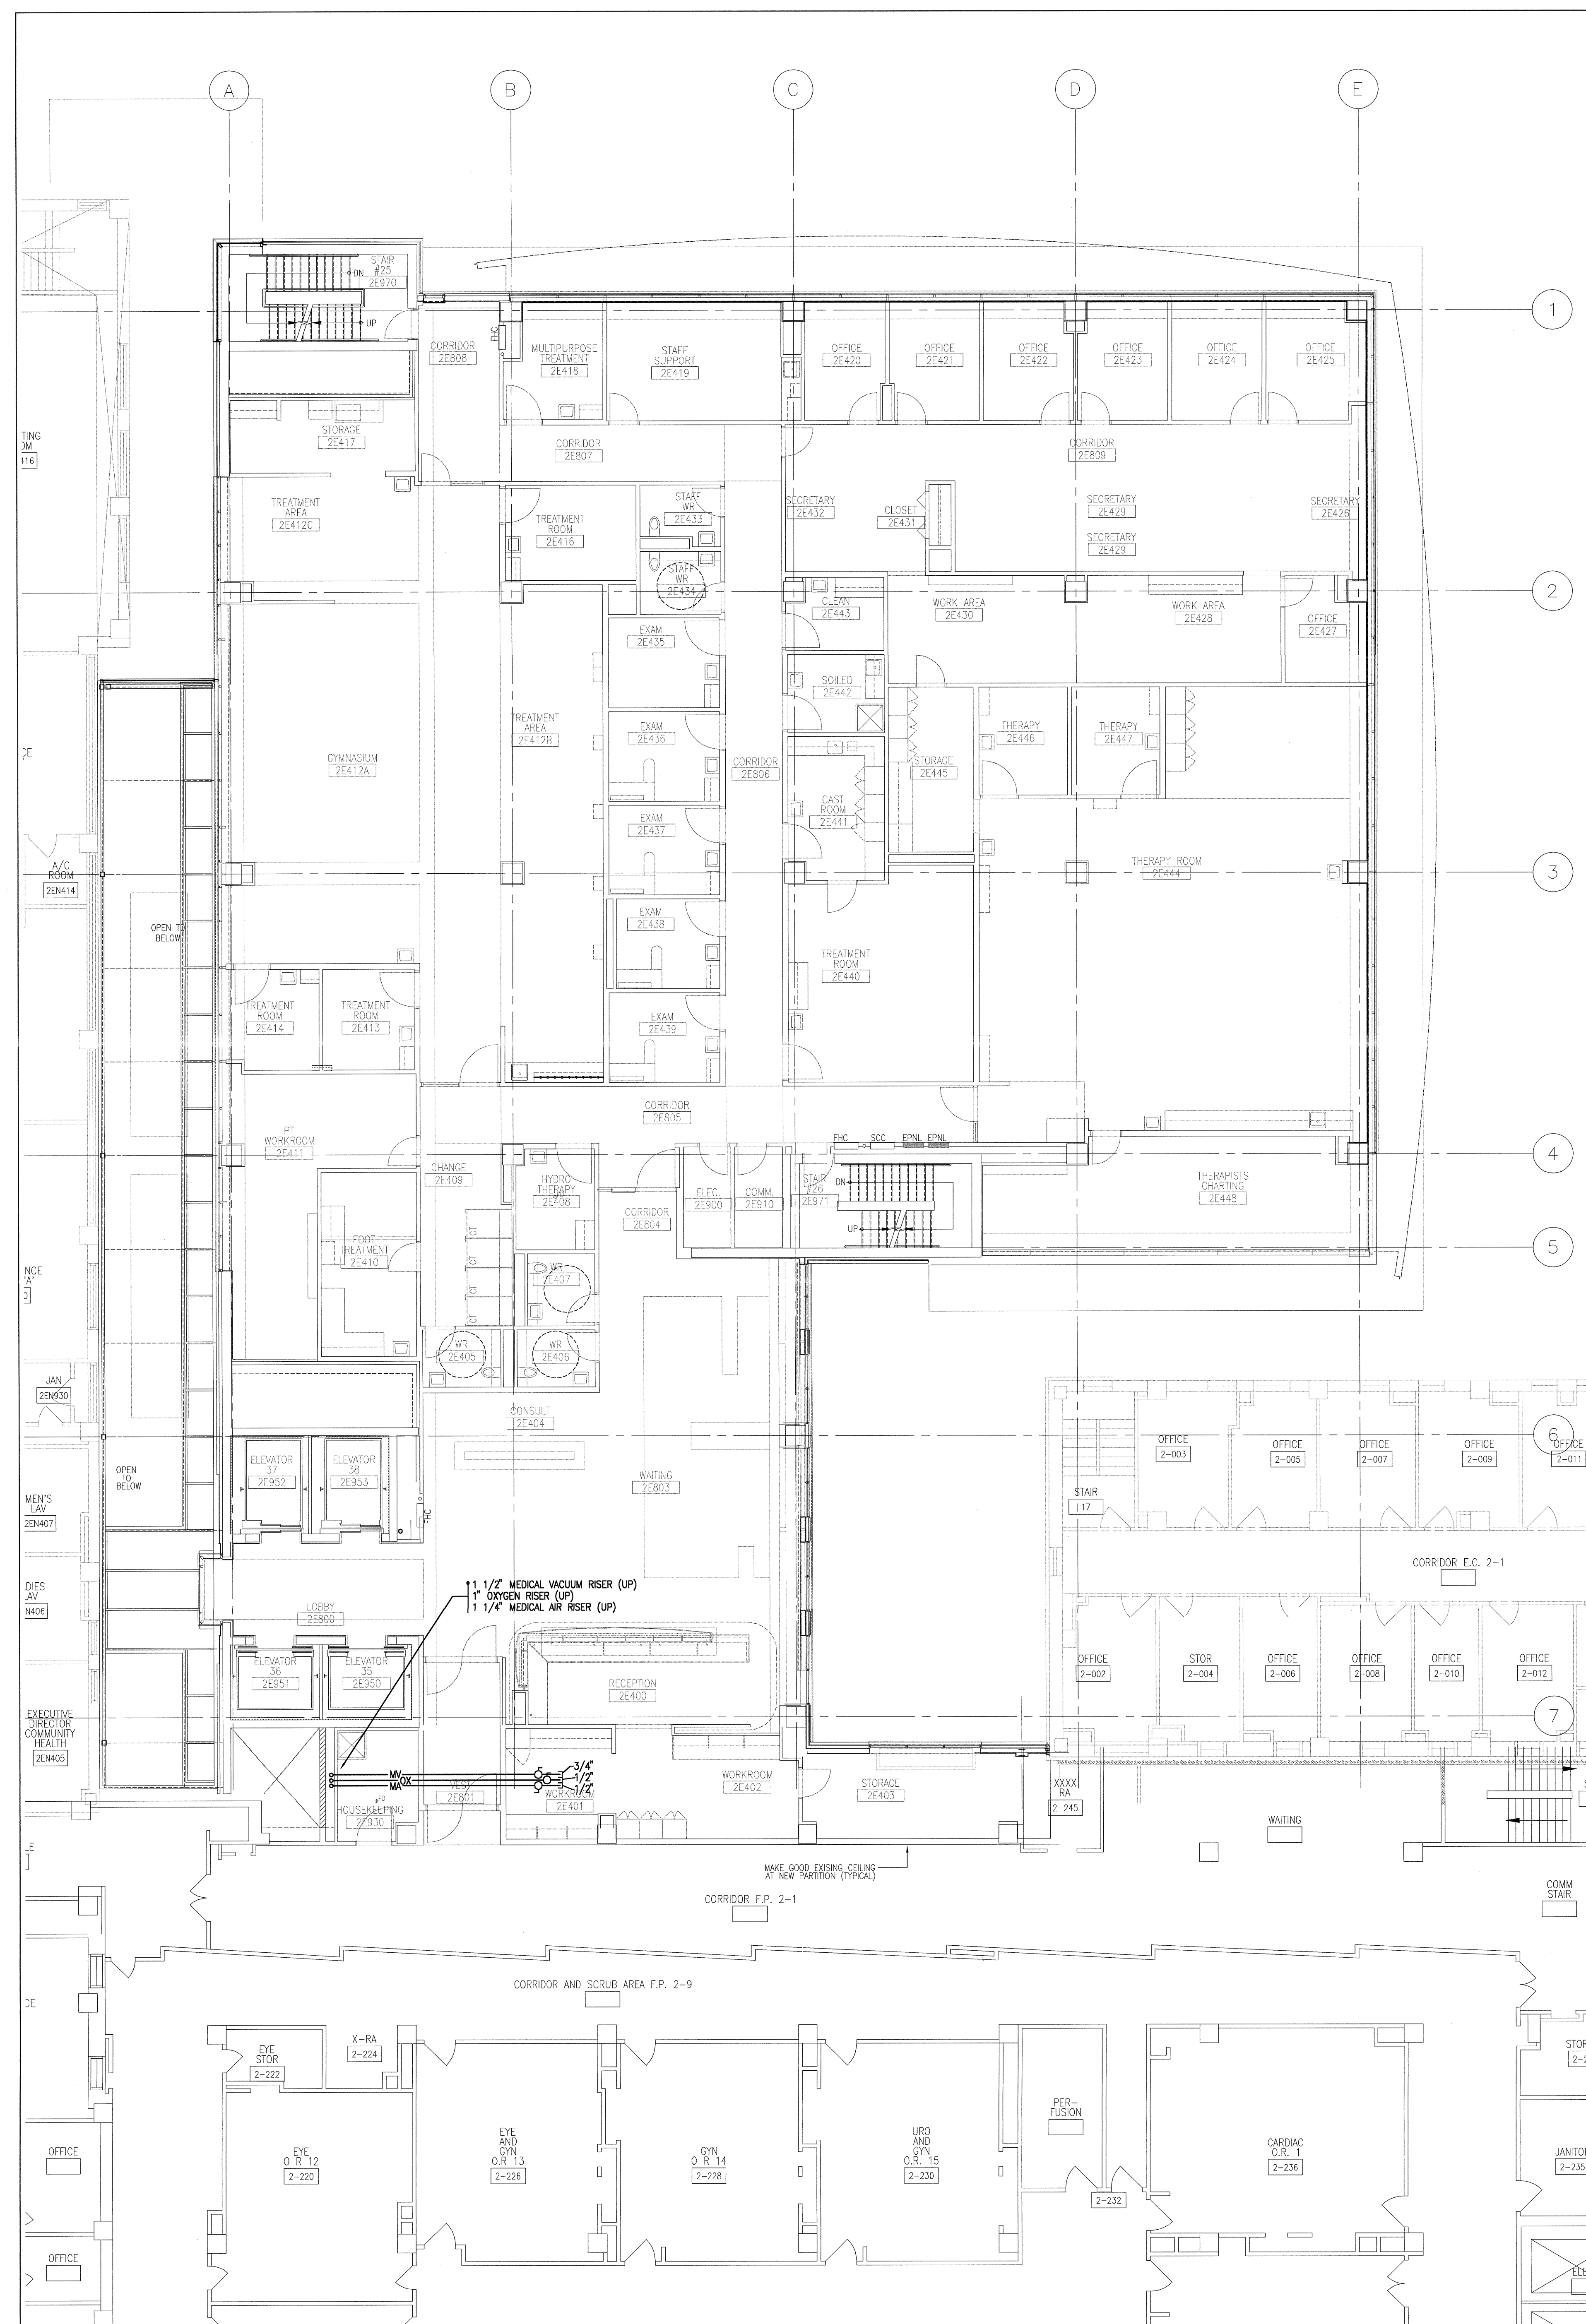

1 LEVEL TWO FLOOR PLAN
Scale: 1:100

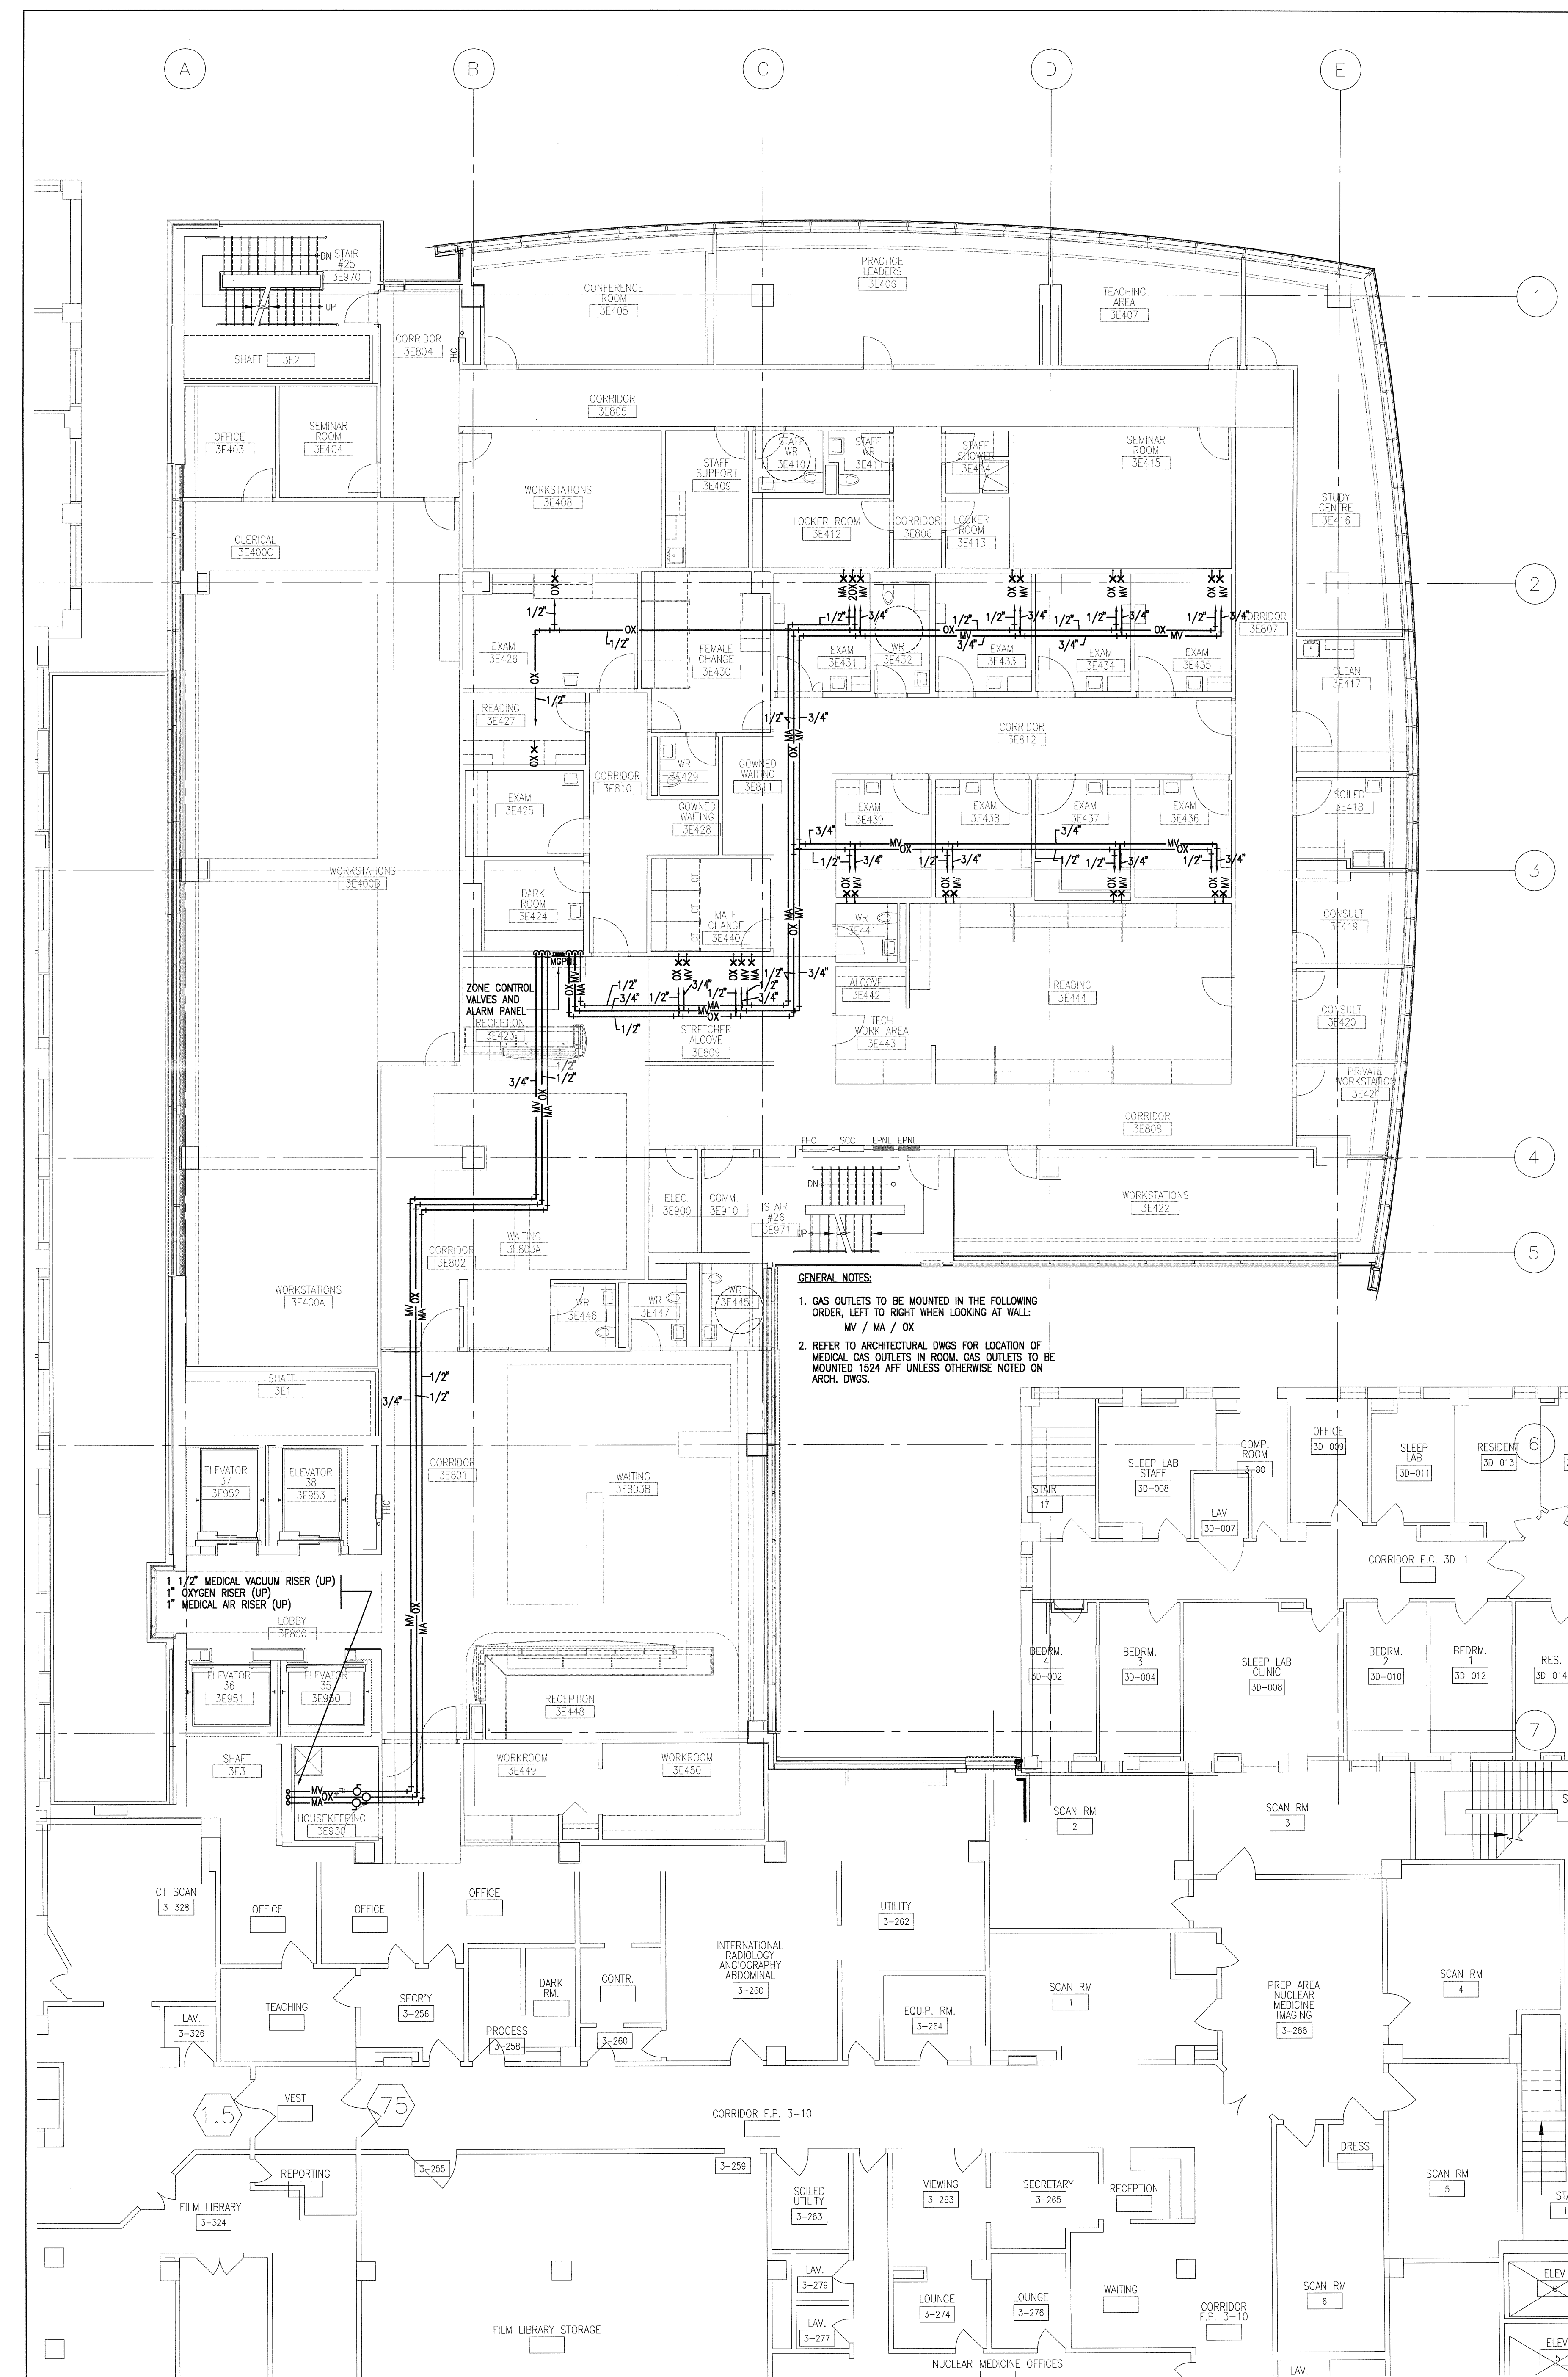


2 LEVEL THREE FLOOR PLAN
Scale: 1:100



Toronto Western Hospital

University Health Network

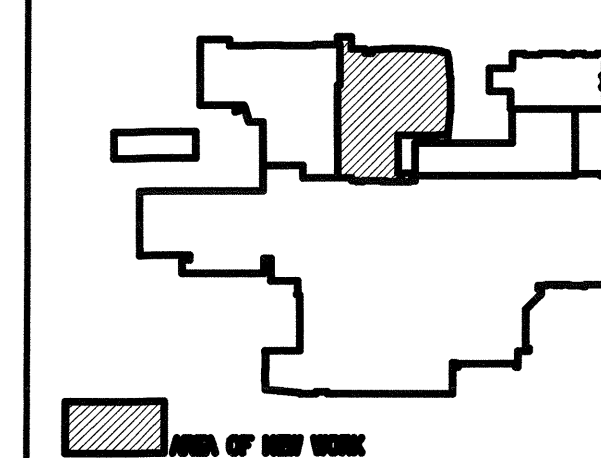


NEW PLAN (M2)

9	07/04/20	ISSUED FOR AS BUILT DRAWINGS
8	03/06/20	ISSUED FOR CONSTRUCTION
7	03/04/17	REVISED FOR ADDENDUM M2
6	03/03/27	ISSUED FOR BUILDING PERMIT
5	03/03/18	ISSUED FOR GENERAL TENDER
4	03/01/28	ISSUED FOR BOX COSTING
3	02/12/19	APPLICATION FOR BUILDING PERMIT
2	02/11/17	ISSUED FOR BOX COSTING
1	02/08/16	ISSUED FOR REVIEW

REF. DATE DESCRIPTION
(07/04/20)

CHECK AND VERIFY ALL DIMENSIONS BEFORE PROCEEDING WITH THE WORK. DO NOT SCALE DRAWINGS.

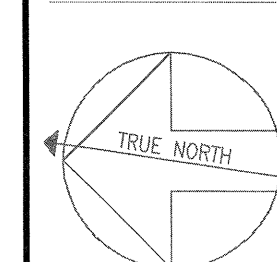


AS-BUILT DRAWINGS

PROJECT NAME:
TORONTO WESTERN HOSPITAL
EAST WING REDEVELOPMENT
MAIN BUILDING - STAGE TWO
TORONTO ONTARIO


DRAWING TITLE:
LEVEL 4 FLOOR PLAN
LEVEL 5 FLOOR PLAN
MEDICAL GASES

SCALE:
AS NOTED
DATE:
MARCH 2023
DRAWN BY:
D. MacVICAR
CHECKED BY:
A. CRESSMAN

PROJECT NUMBER:
2011210
DRAWING NUMBER:
M2-403

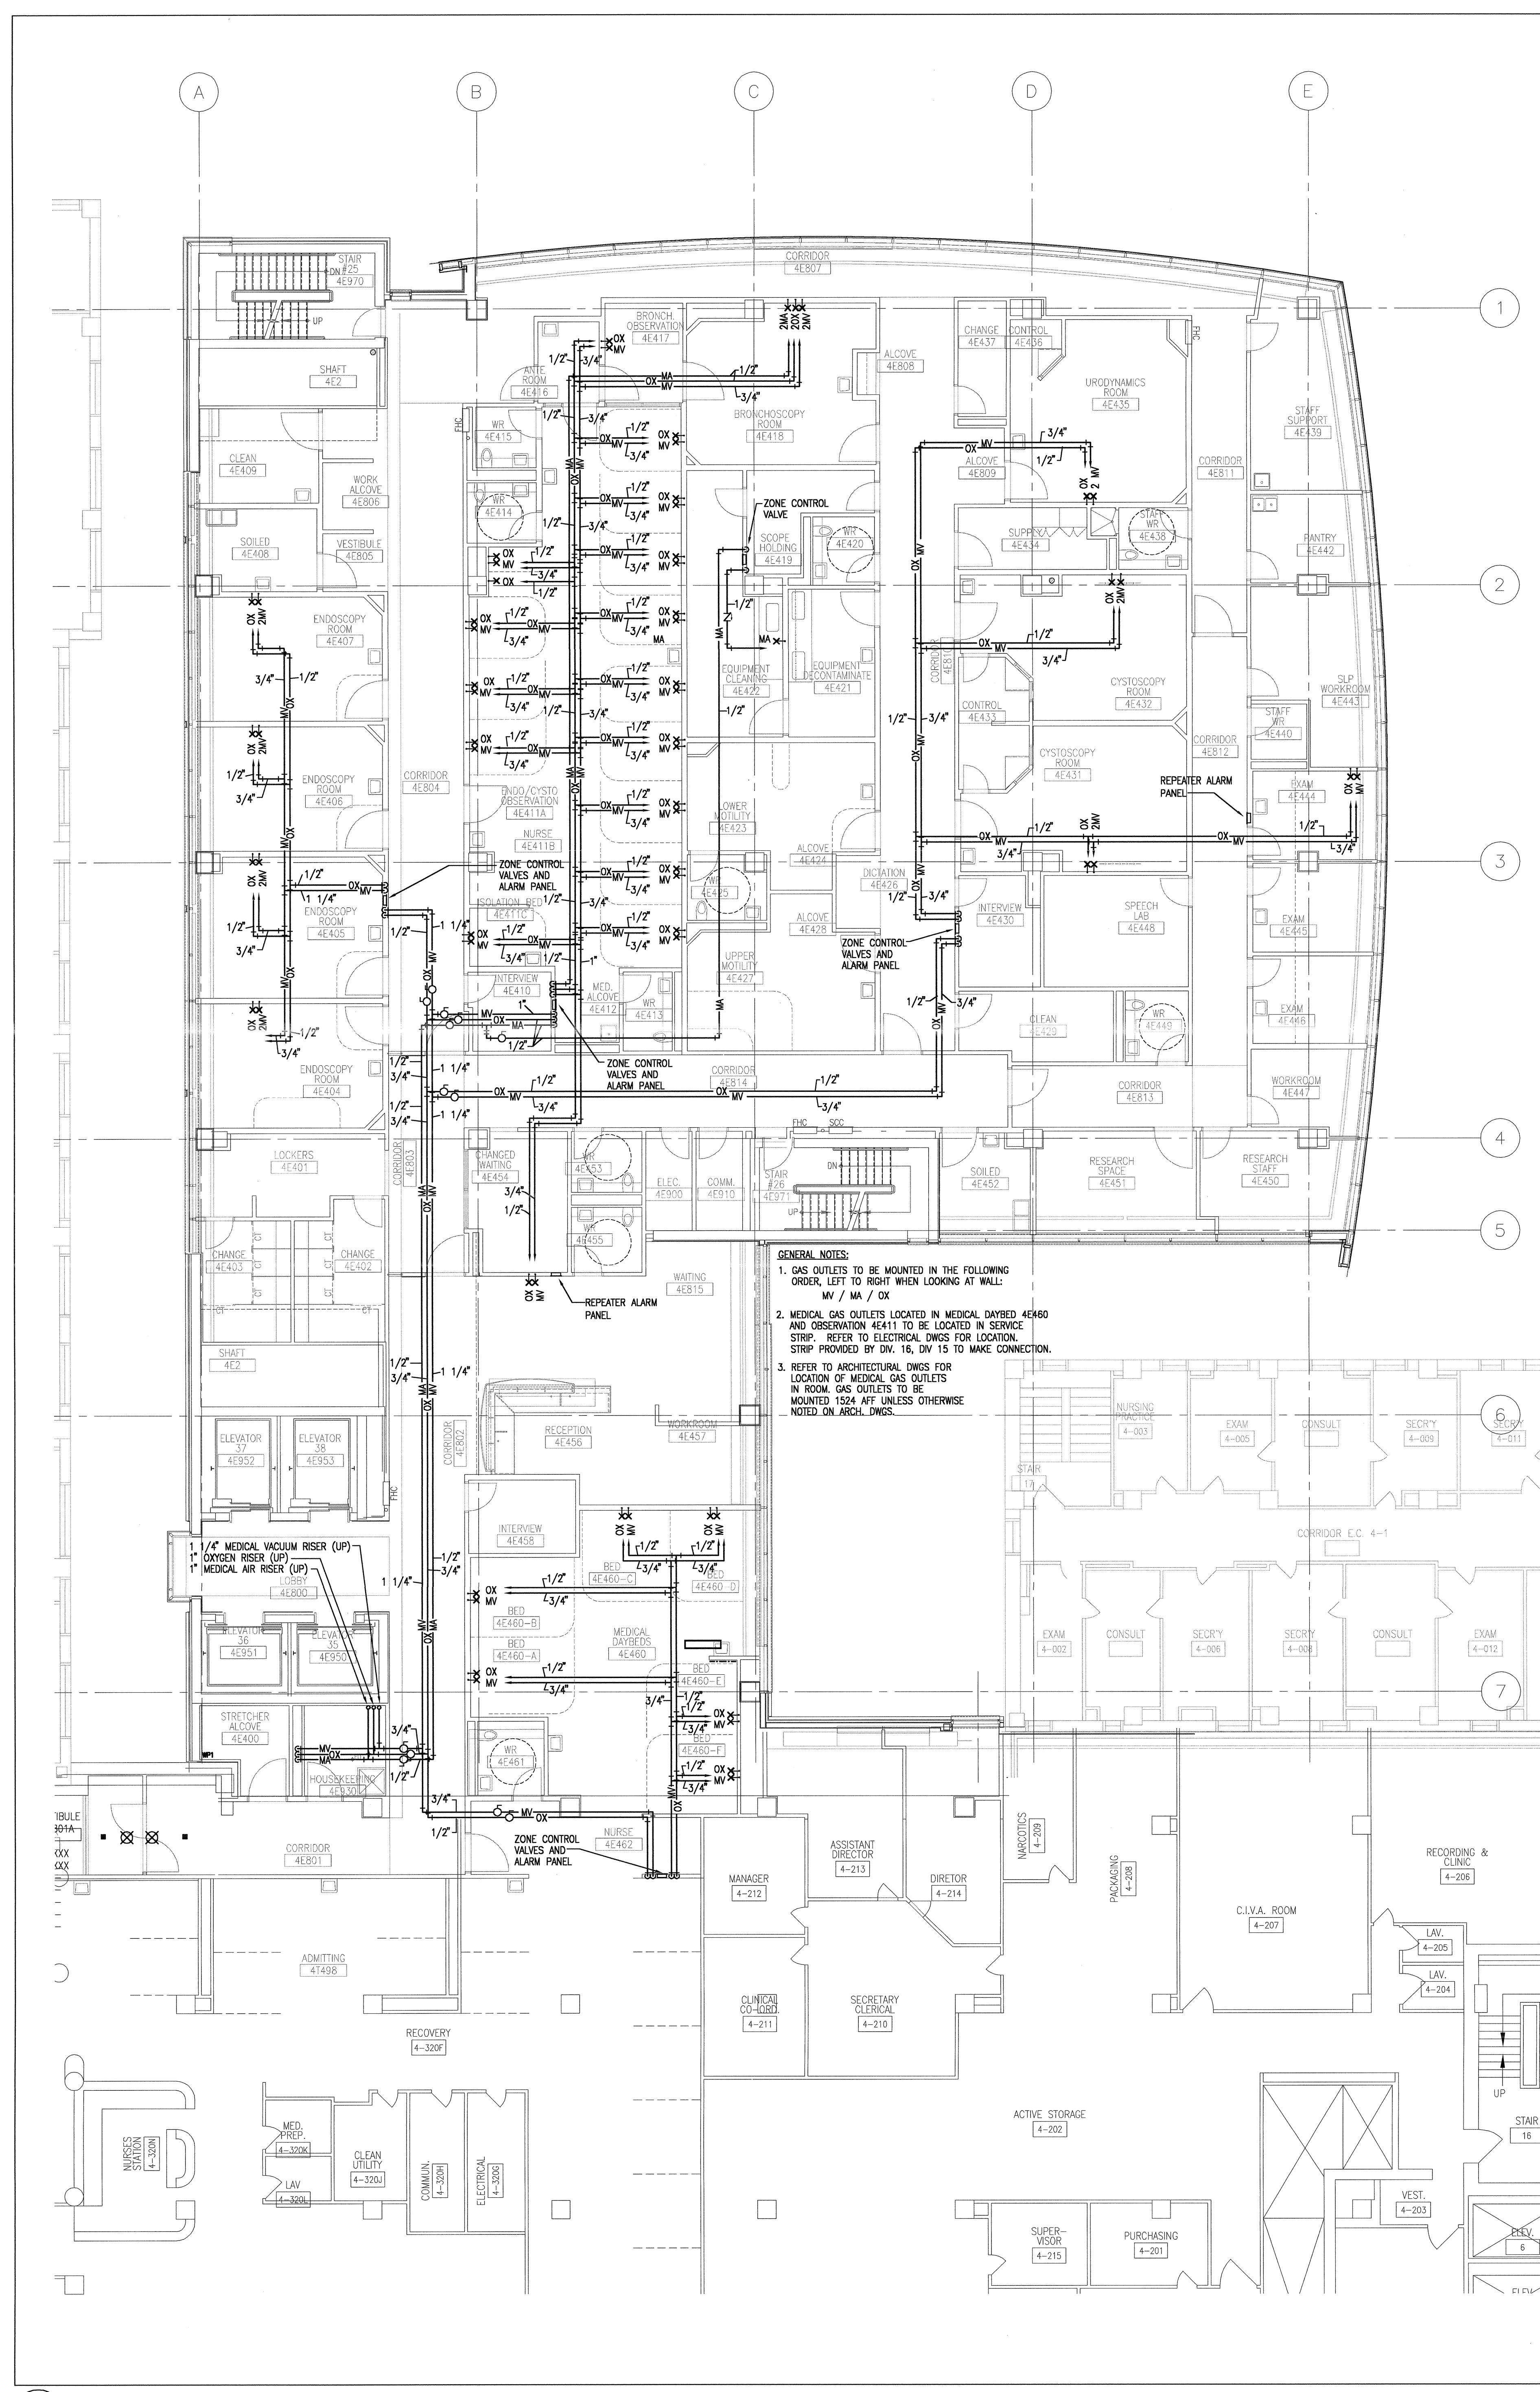

1 LEVEL FOUR FLOOR PLAN
403 Scale: 1:100

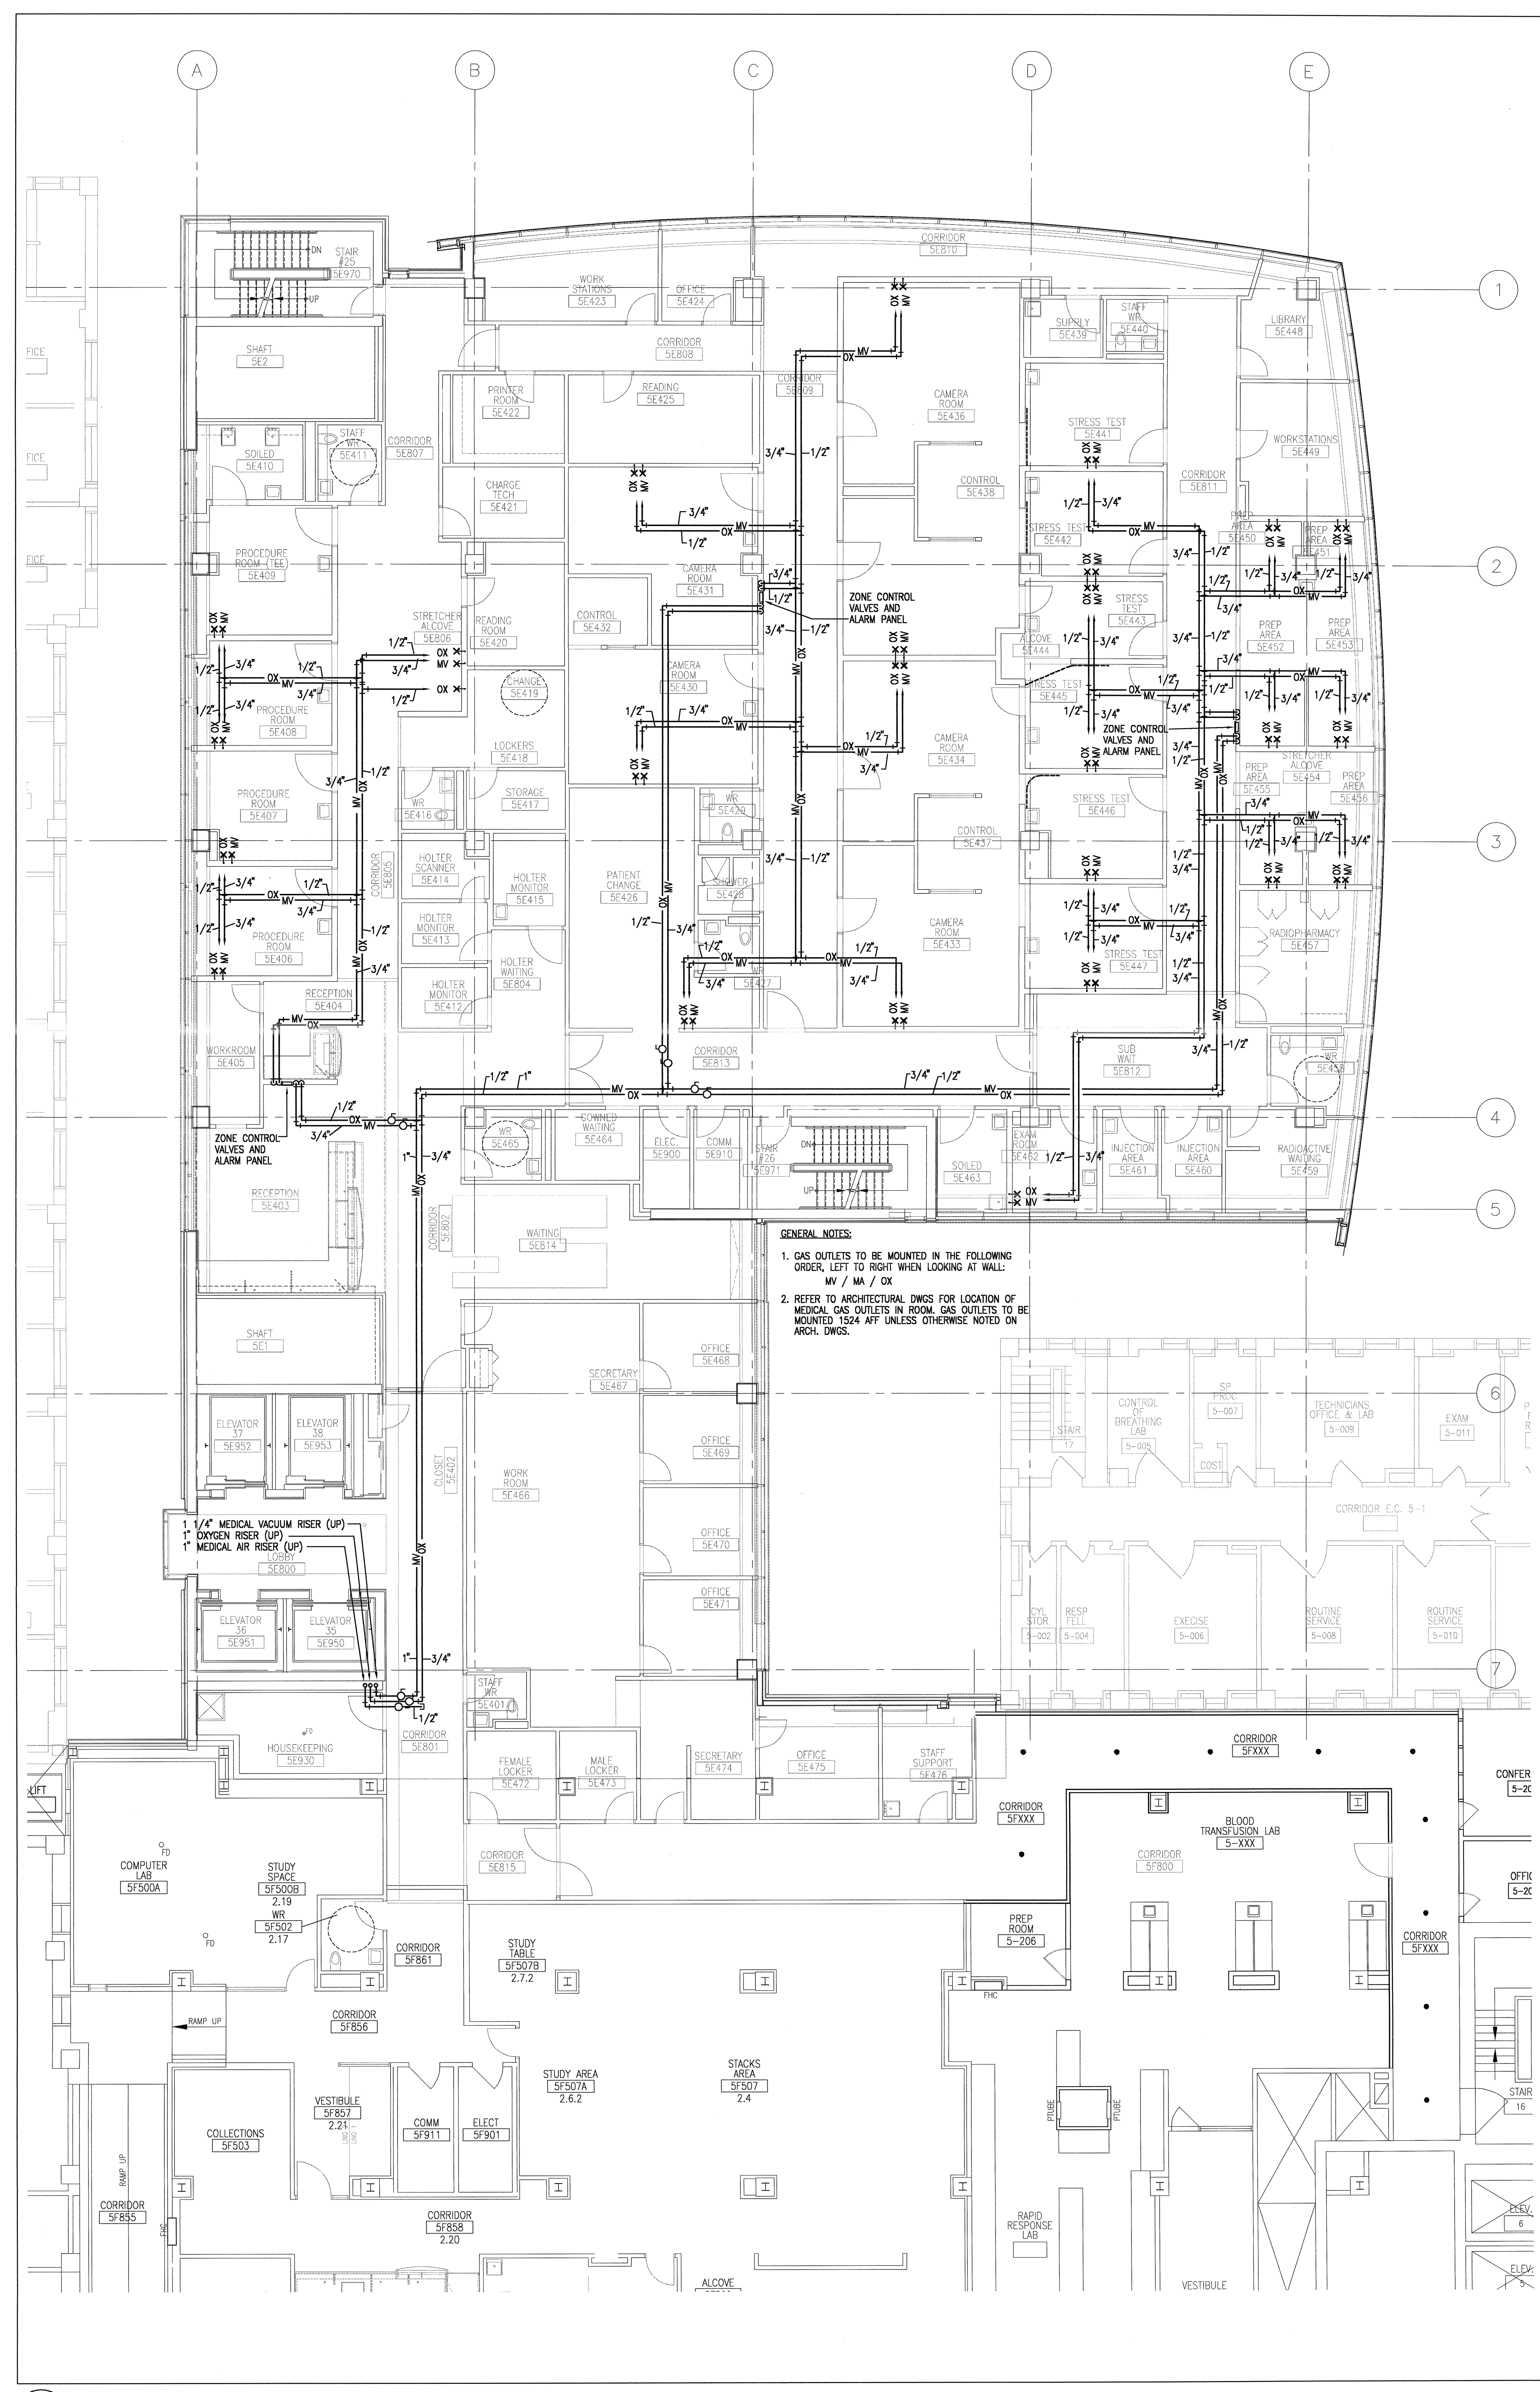


2 LEVEL FIVE FLOOR PLAN
403 Scale: 1:100



Toronto Western Hospital

University Health Network

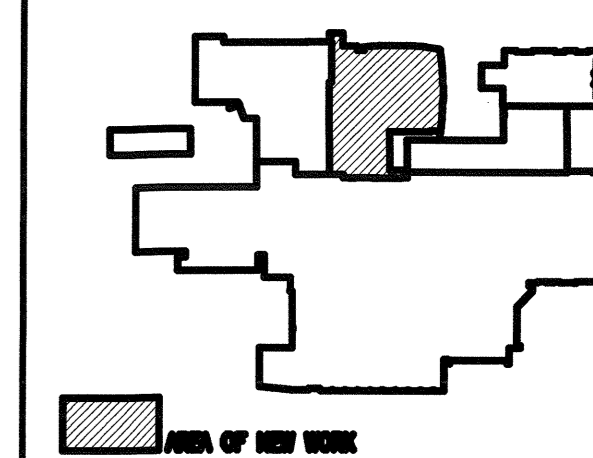


Floor Plan (6/22)

8	07/04/30	ISSUED FOR AS BUILT DRAWINGS
7	03/06/20	ISSUED FOR CONSTRUCTION
6	03/03/27	ISSUED FOR BUILDING PERMIT
5	03/03/18	ISSUED FOR GENERAL TENDER
4	03/01/29	ISSUED FOR BOM COSTING
3	02/12/19	APPLICATION FOR BUILDING PERMIT
2	02/11/17	ISSUED FOR BOM REVIEW
1	02/06/16	ISSUED FOR COSTING

REF. DATE DESCRIPTION
(yr/mo/day)

CHECK AND VERIFY ALL DIMENSIONS BEFORE PROCEEDING WITH THE WORK. DO NOT SCALE DRAWINGS.

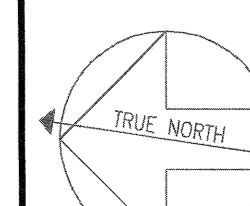

CONSTRUCTION NORTH

AS-BUILT DRAWINGS

PROJECT NAME:

DRAWING TITLE:

LEVEL 6 FLOOR PLAN
LEVEL 7 FLOOR PLAN
MEDICAL GASES

SCALE:

1 : 100

DATE:

MARCH 2003

DRAWN BY:


CHECKED BY:

PROJECT NUMBER:


2011210

DRAWING NUMBER:

M2-404

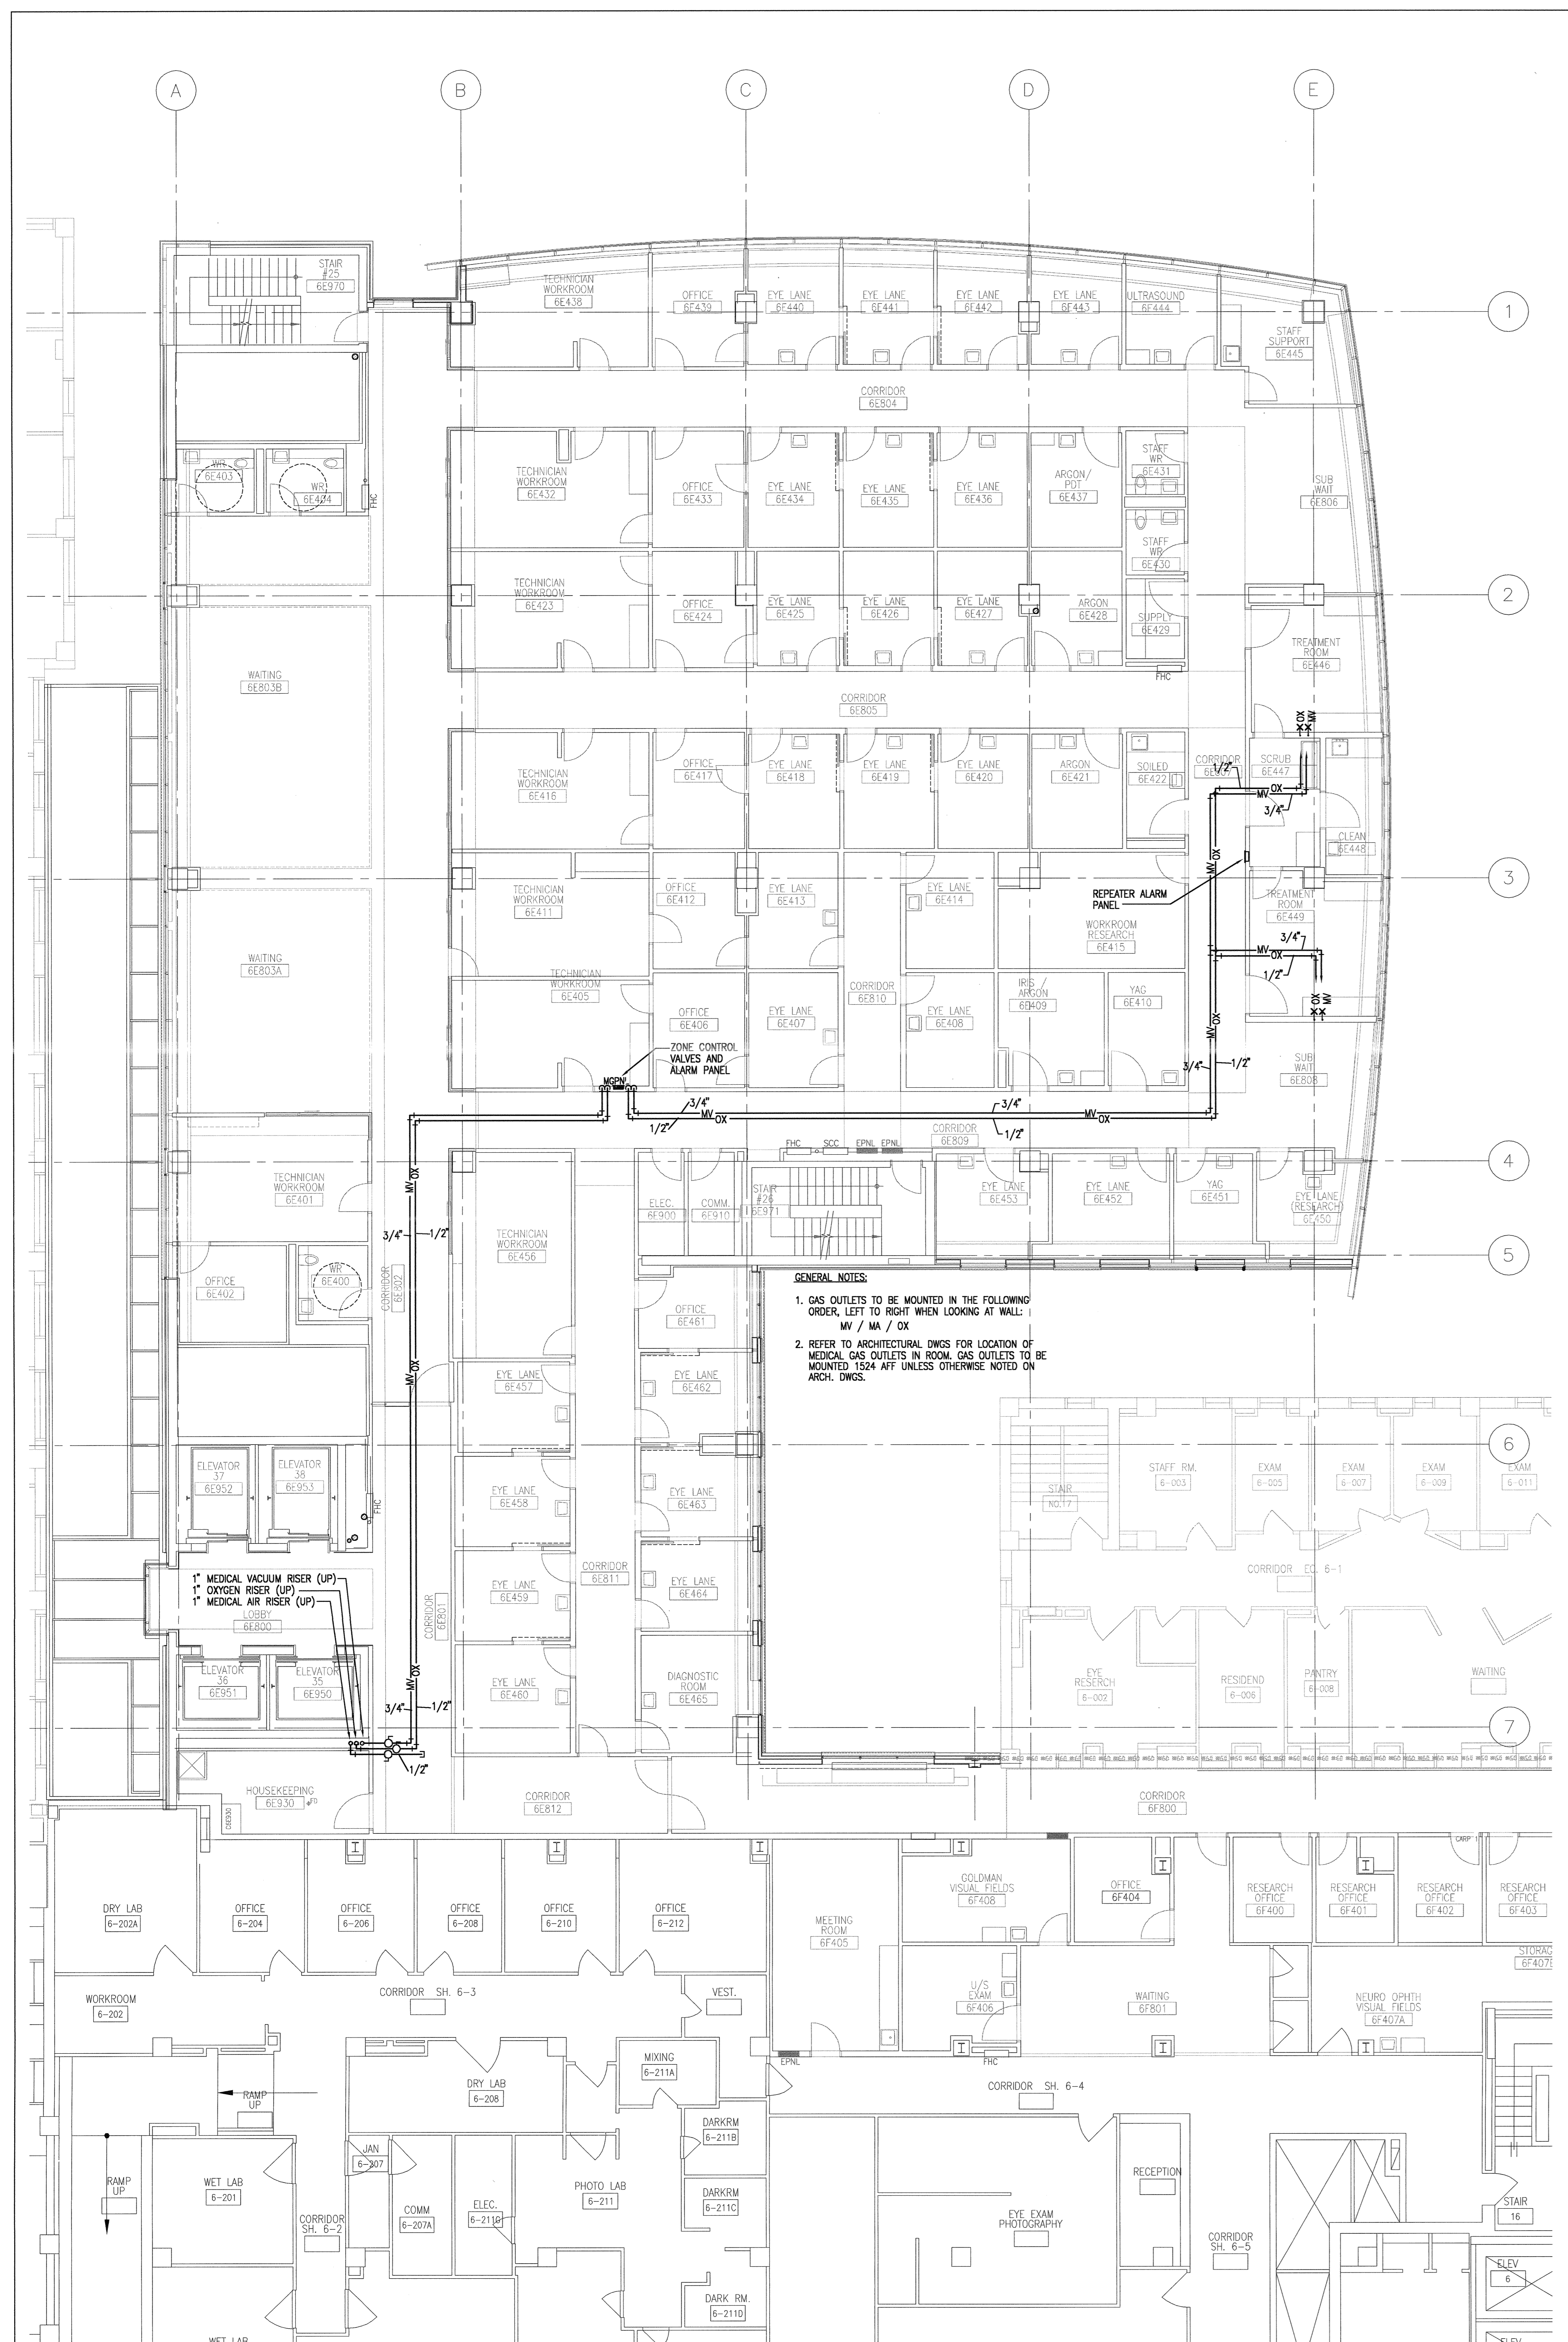

1 LEVEL SIX FLOOR PLAN
Scale: 1:100

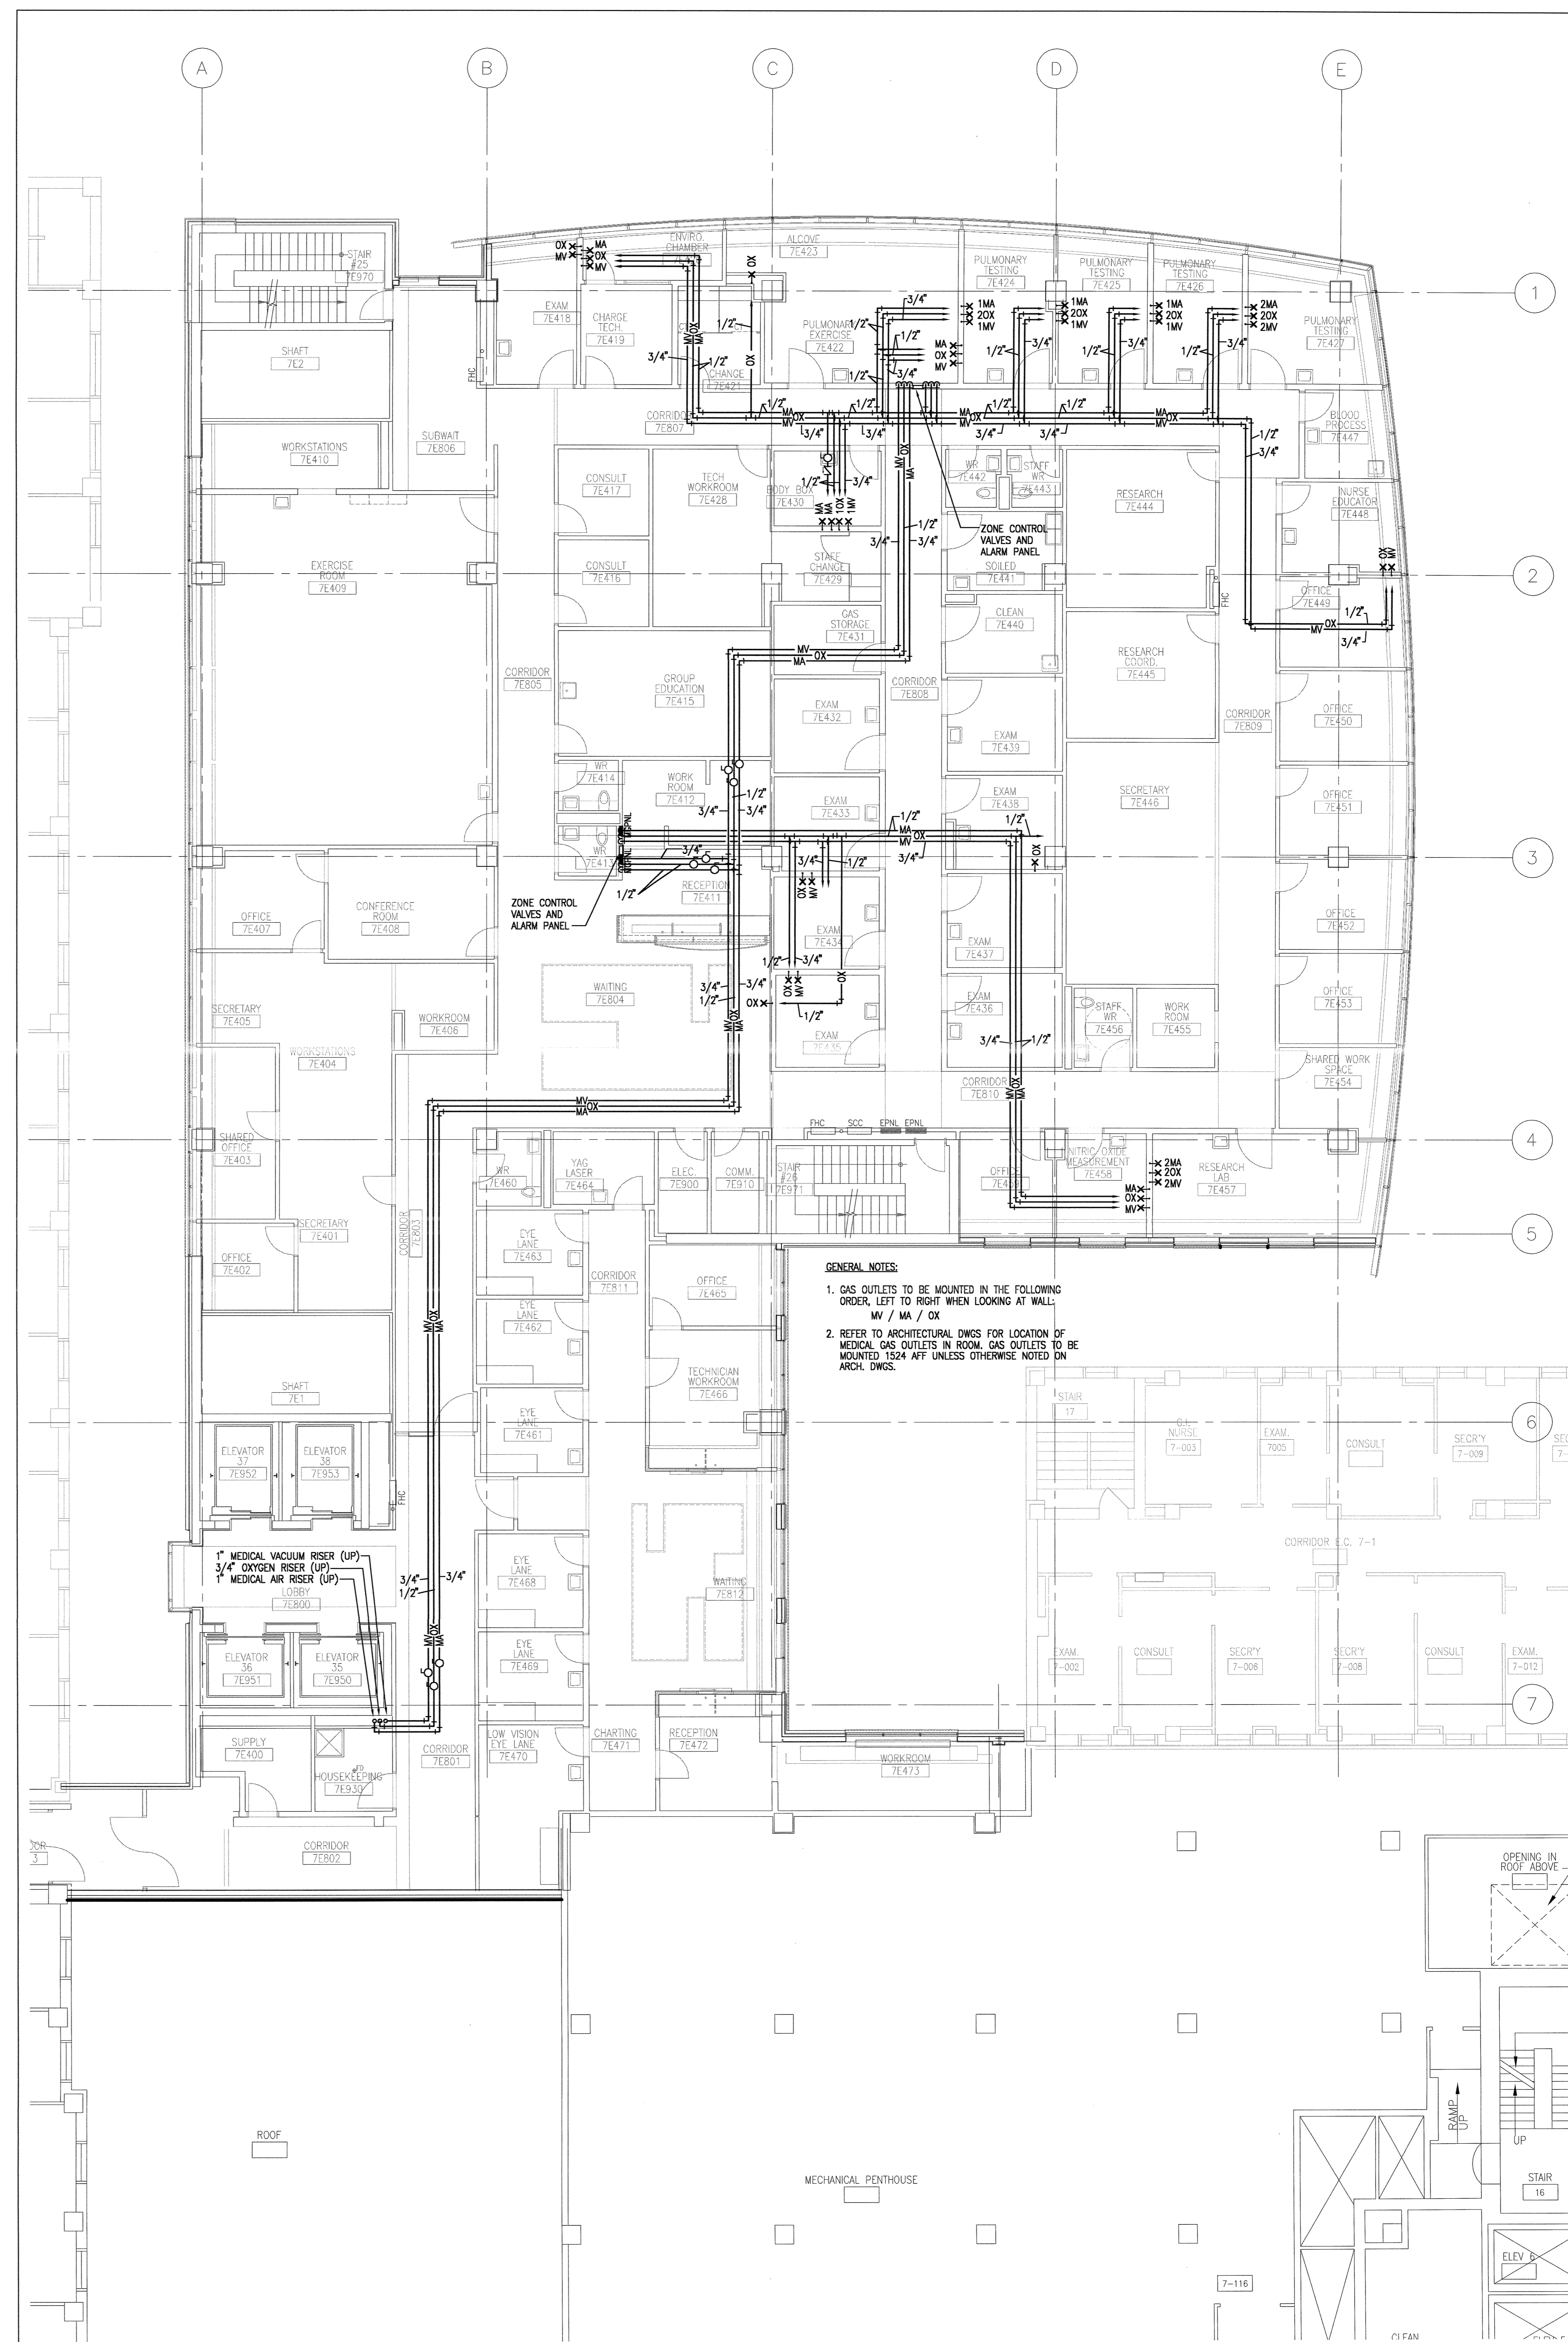


2 LEVEL SEVEN FLOOR PLAN
Scale: 1:100



Toronto Western Hospital

University Health Network

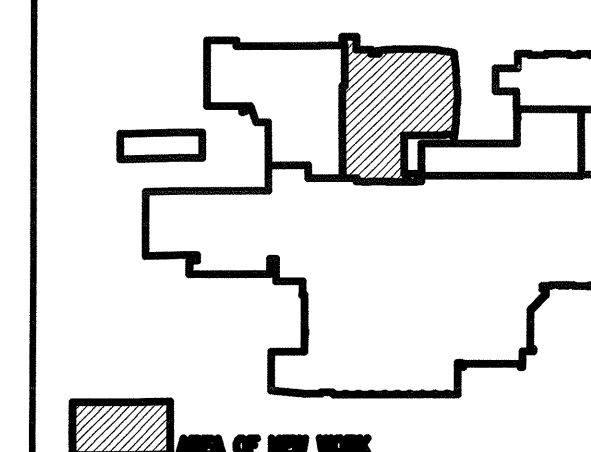


NEW PLAN (8-22)

- 9 07/04/20 ISSUED FOR AS-BUILT DRAWINGS
- 8 07/04/20 ISSUED FOR AS-BUILT
- 7 03/06/20 ISSUED FOR CONSTRUCTION
- 6 03/03/21 ISSUED FOR BUILDING PERMIT
- 5 03/03/18 ISSUED FOR GENERAL TENDER
- 4 03/01/20 ISSUED FOR 90% COSTING
- 3 02/12/19 APPLICATION FOR BUILDING PERMIT
- 2 02/11/17 ISSUED FOR 60% REVIEW
- 1 02/08/16 ISSUED FOR COSTING

REF. DATE DESCRIPTION
(Yr/Mo/Day)

CHECK AND VERIFY ALL DIMENSIONS BEFORE PROCEEDING WITH THE WORK. DO NOT SCALE DRAWINGS.

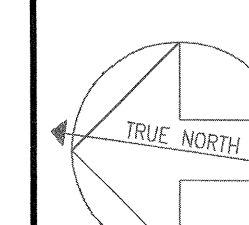


CONSTRUCTION NORTH

AS-BUILT DRAWINGS


PROJECT NAME:
TORONTO WESTERN HOSPITAL
EAST WING REDEVELOPMENT
MAIN BUILDING - STAGE TWO
TORONTO ONTARIO

DRAWING TITLE:
LEVEL 8 FLOOR PLAN
LEVEL 9 FLOOR PLAN
MEDICAL GASES


SCALE:
1 : 100
DATE:
MARCH 2003
DRAWN BY:
CHECKED BY:
PROJECT NUMBER:
2011210
DRAWING NUMBER:
M2-405

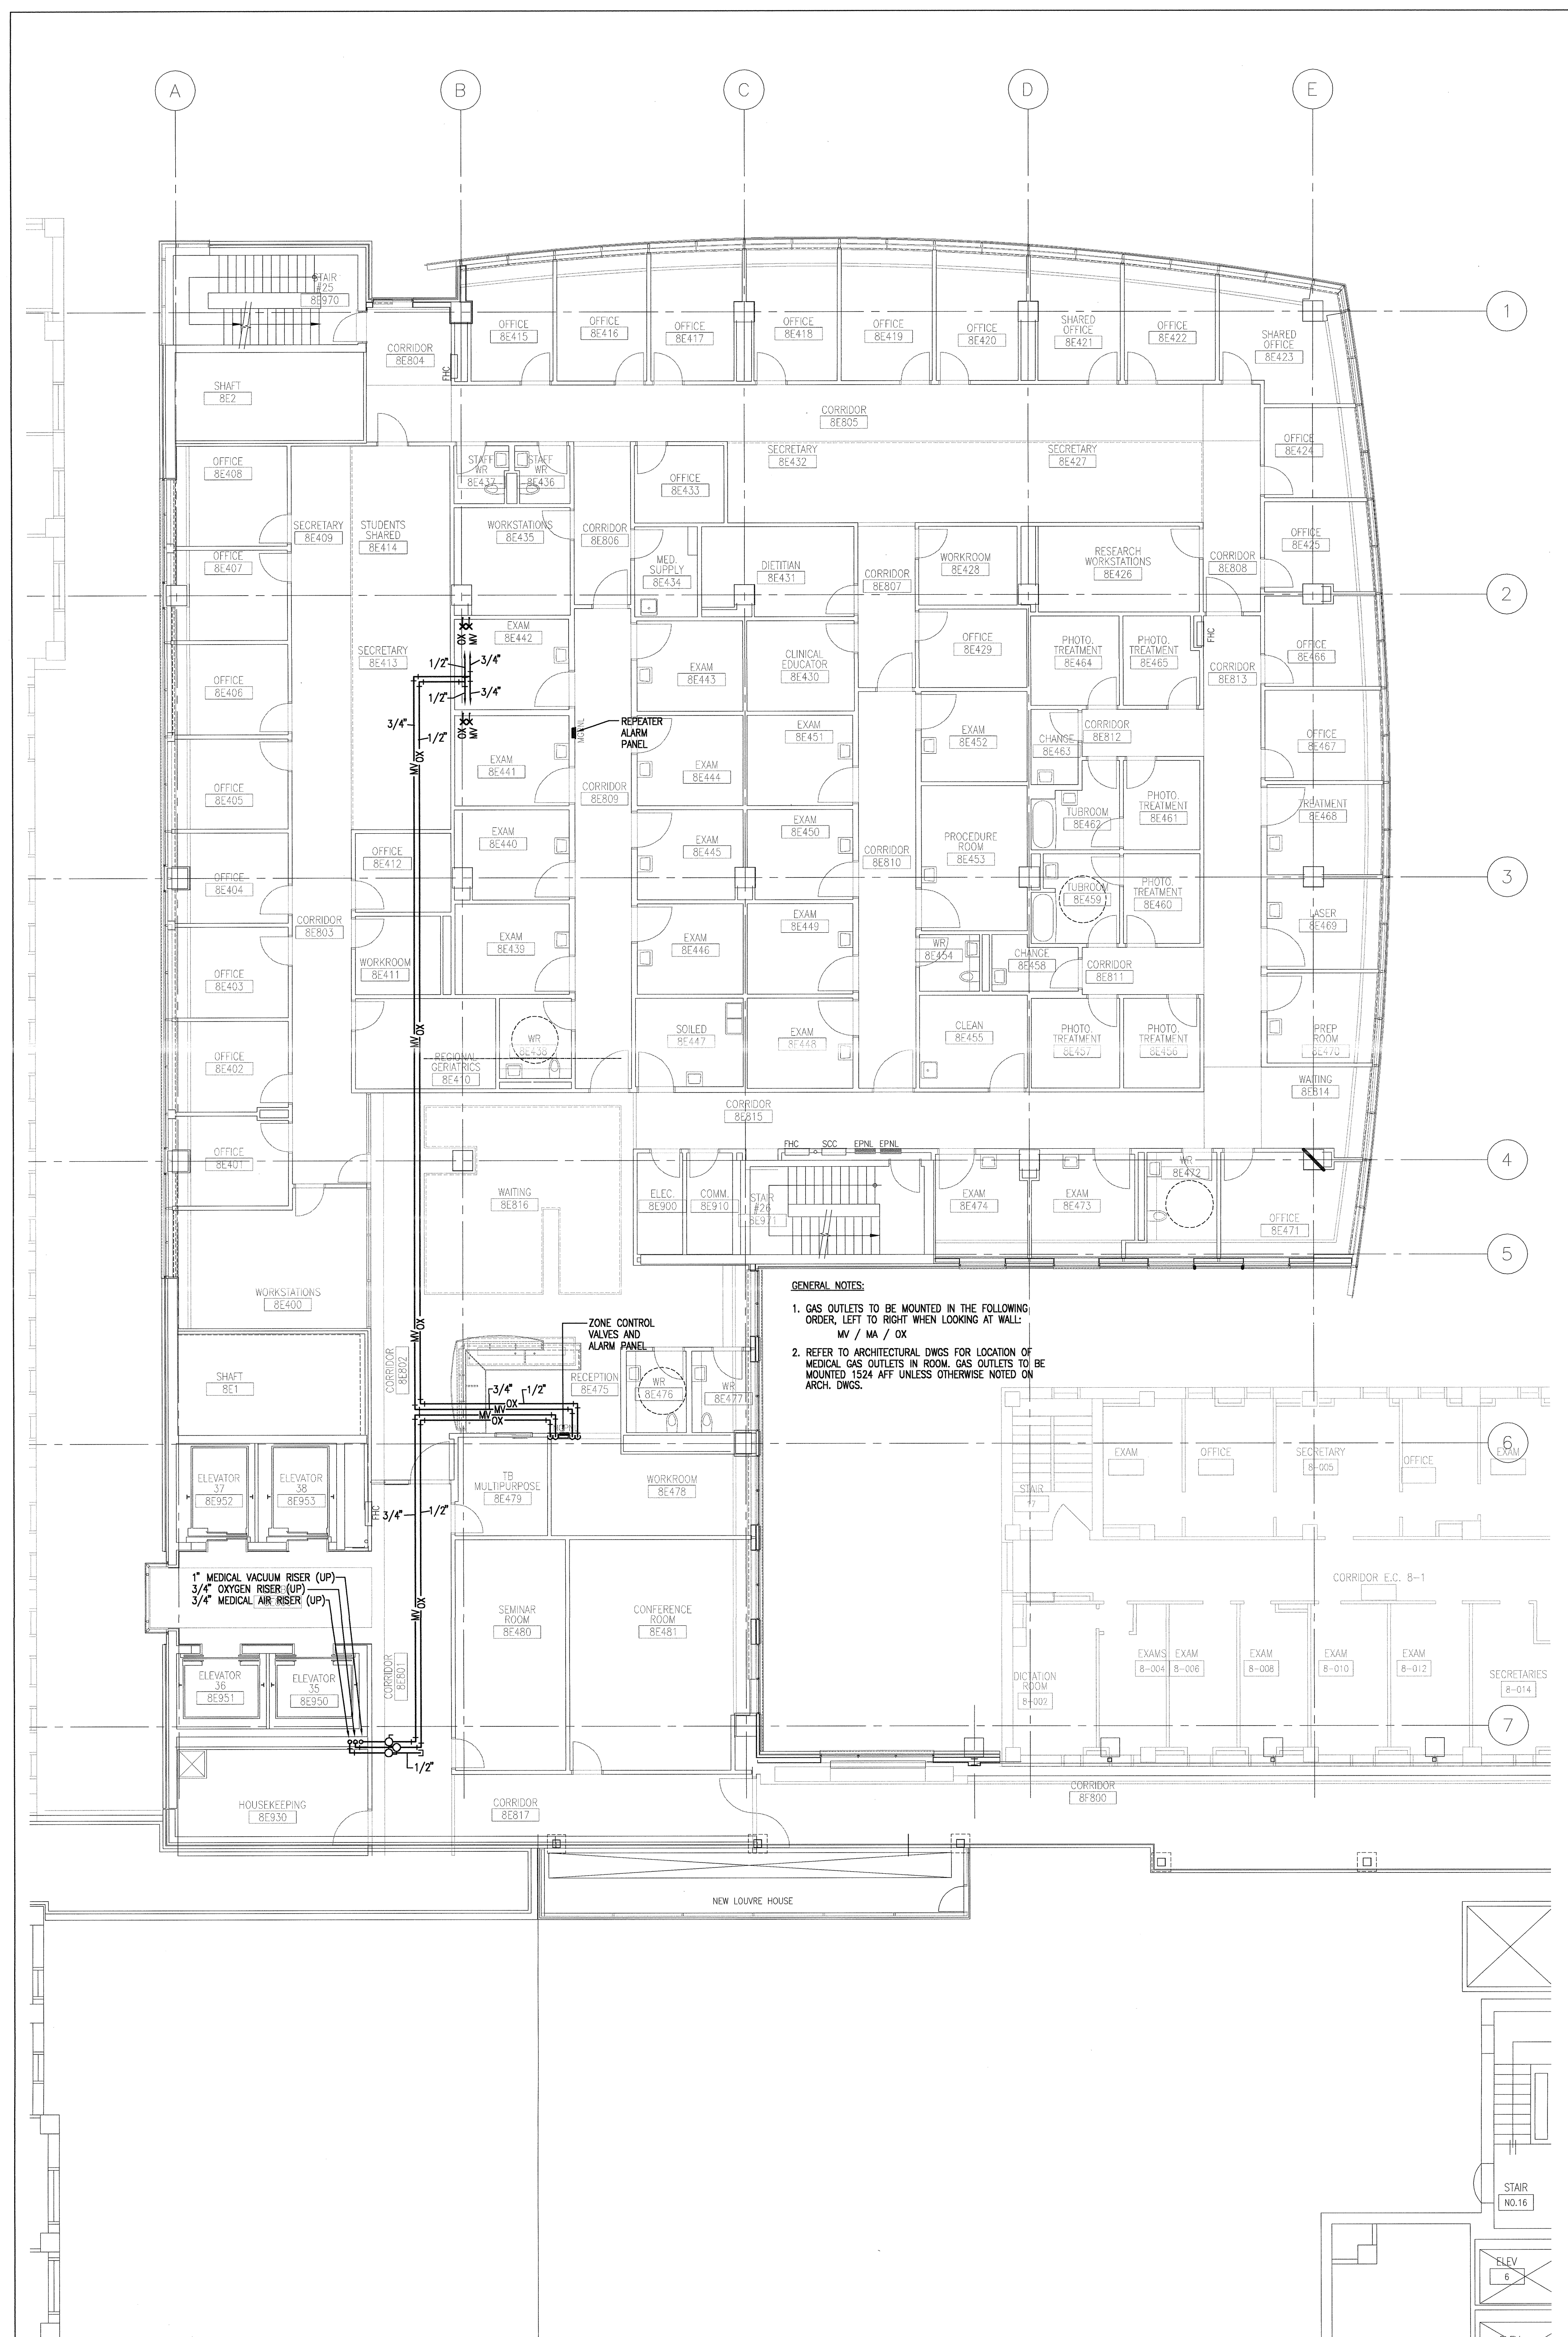


1 LEVEL EIGHT FLOOR PLAN
404 Scale: 1:100

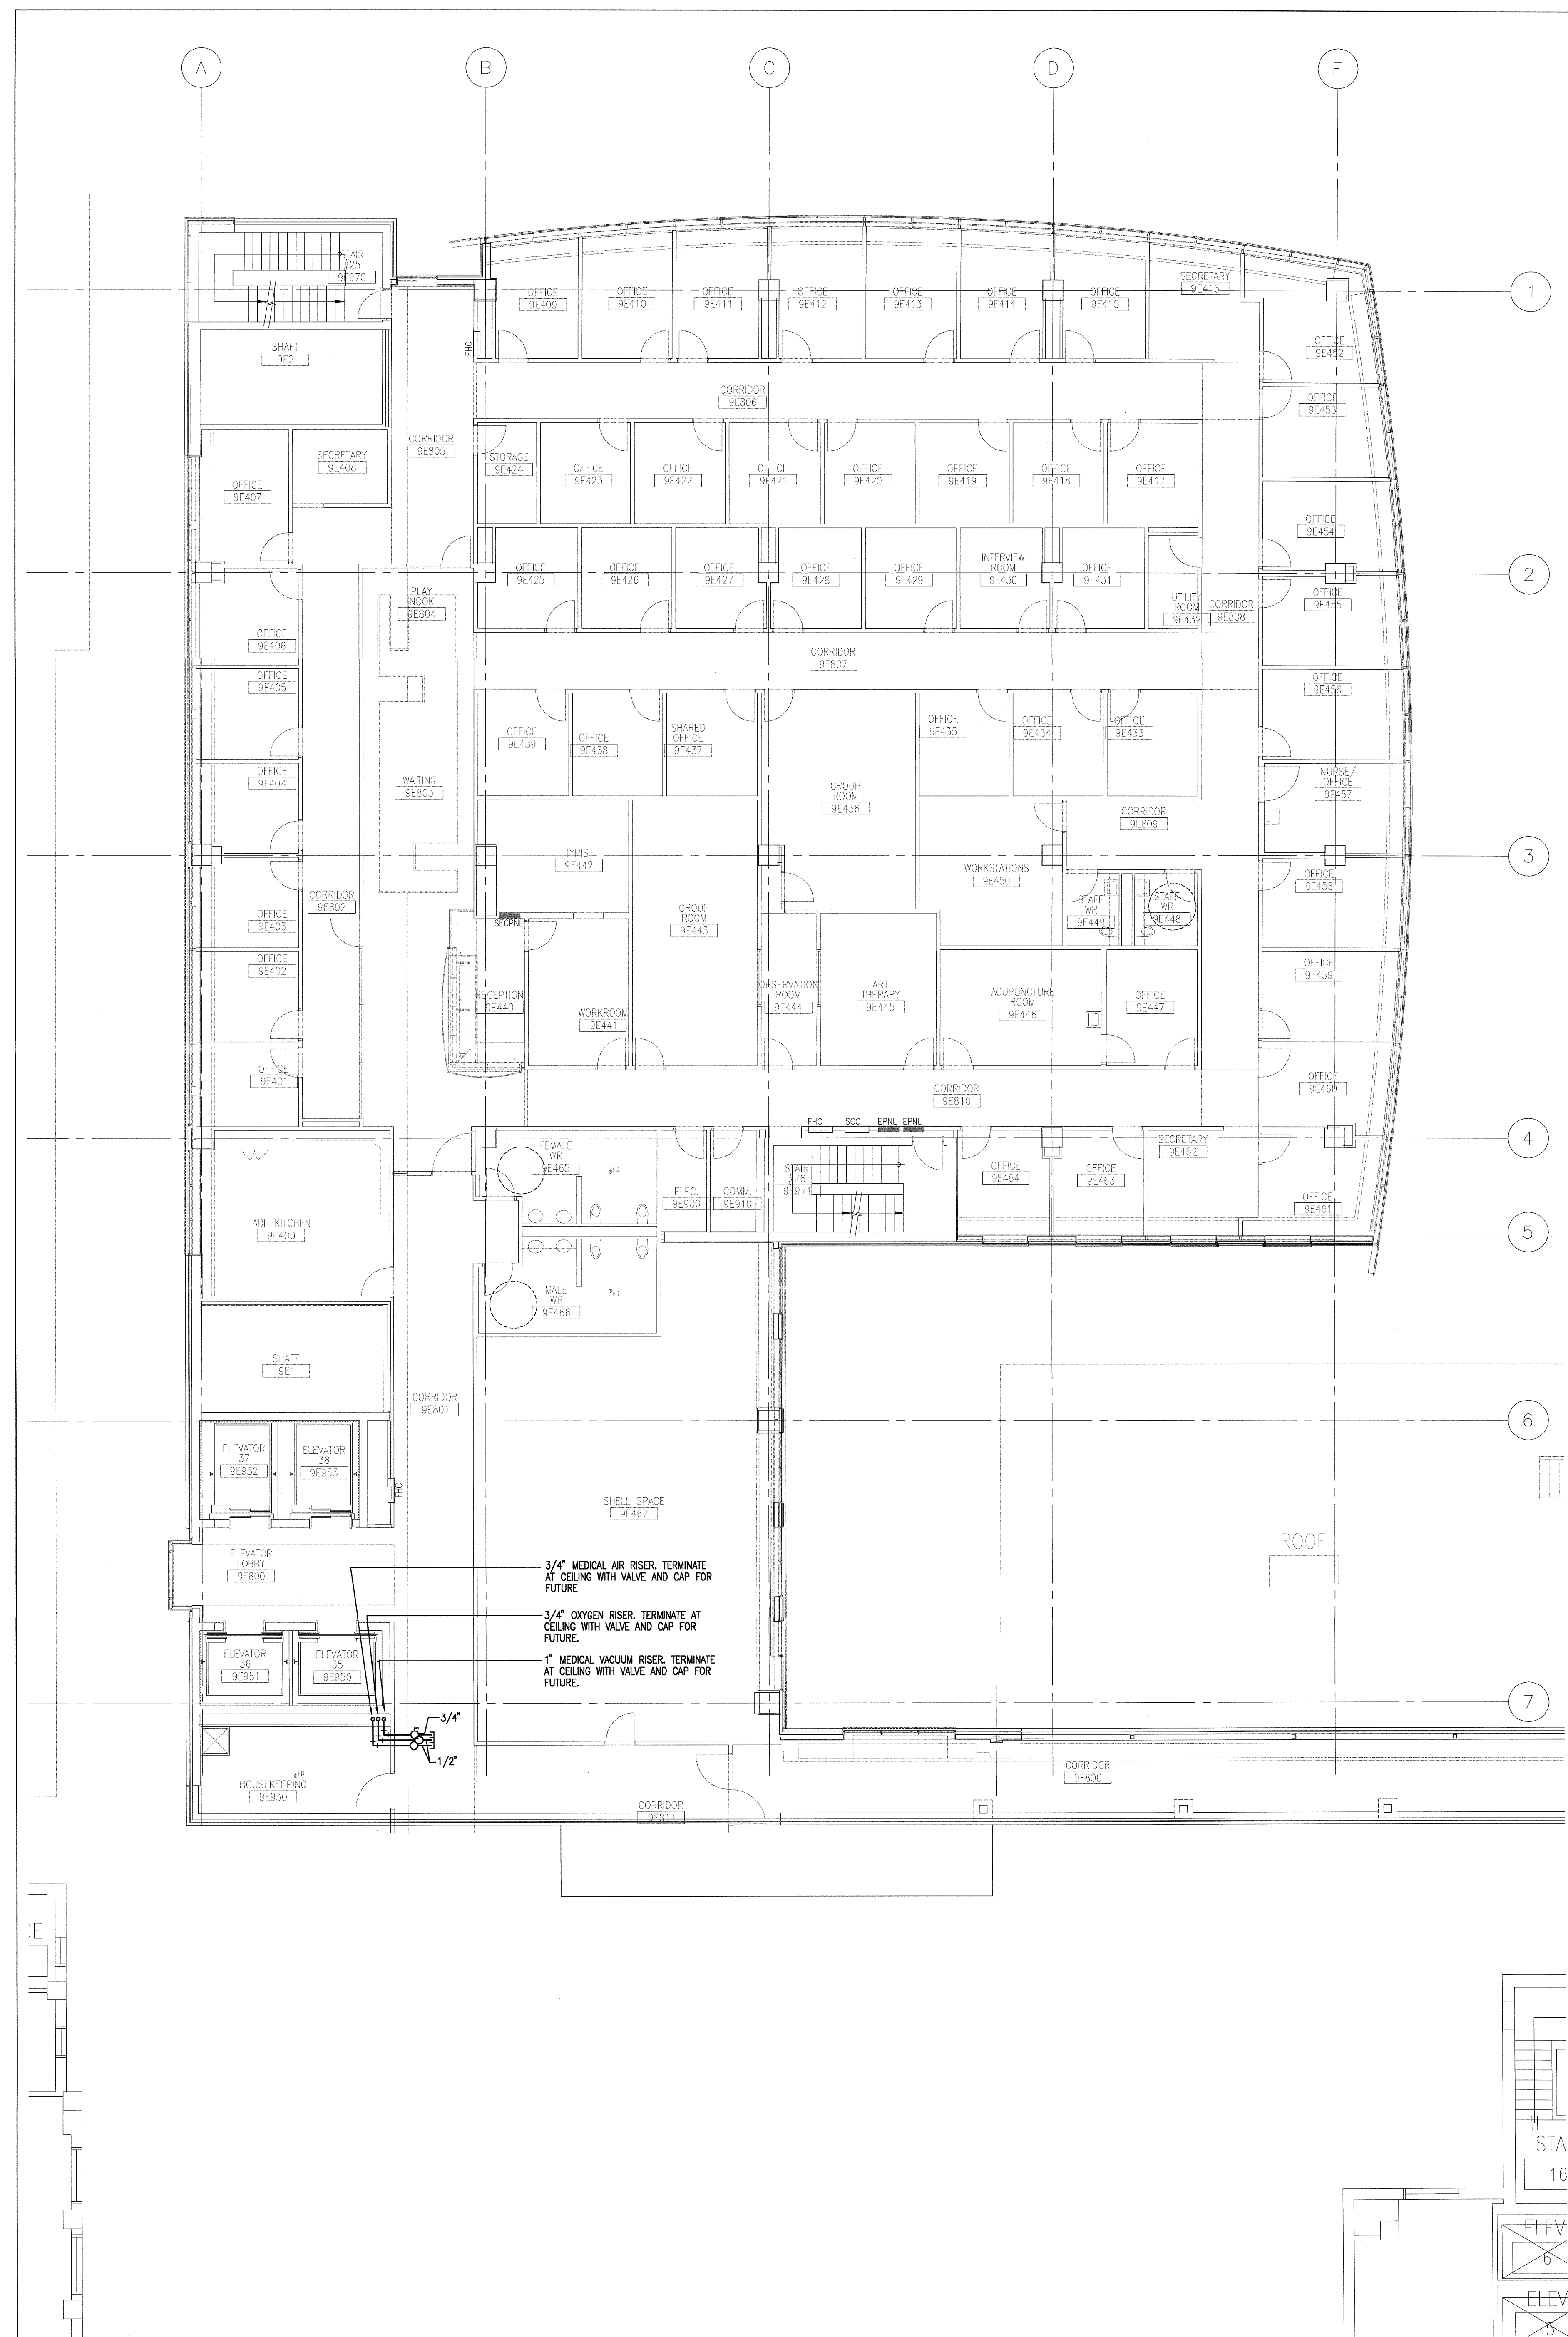


2 LEVEL NINE FLOOR PLAN
404 Scale: 1:100

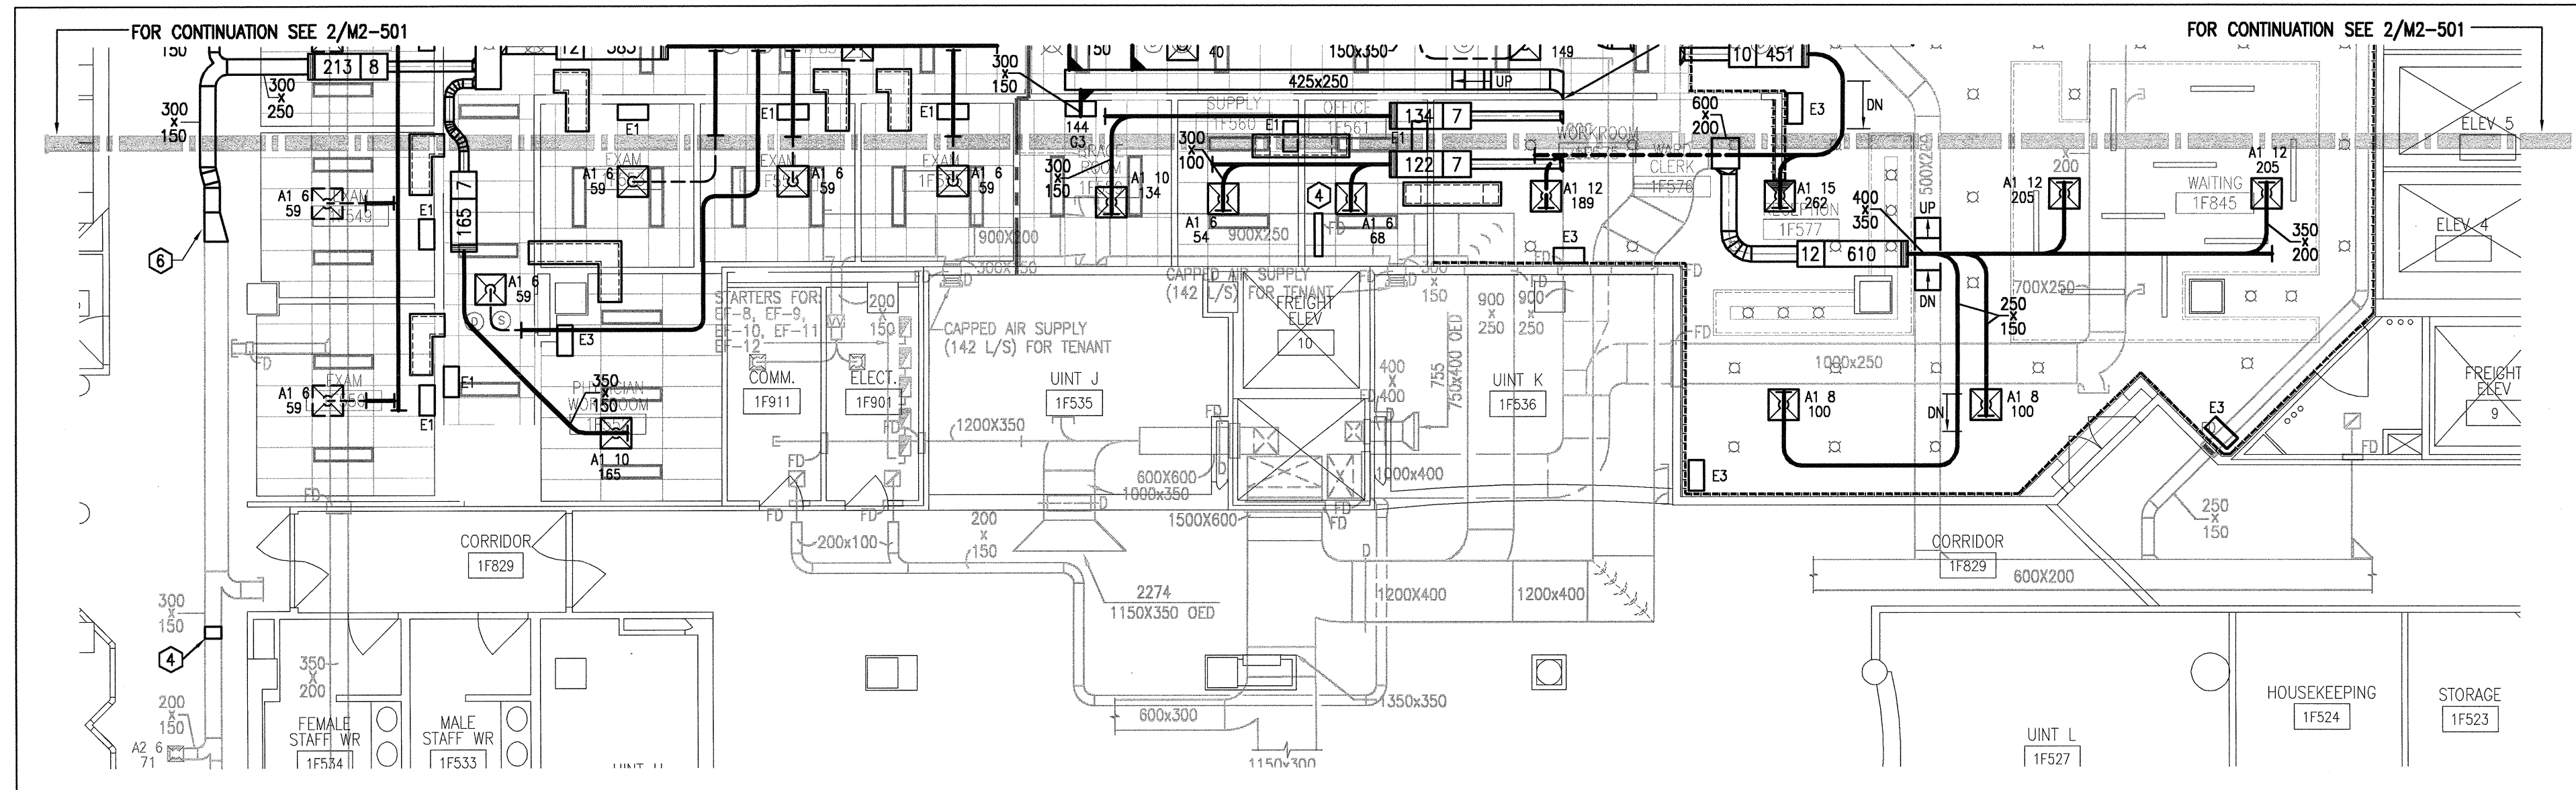


3 LEVEL ONE FLOOR PLAN
501 Scale: 1:100

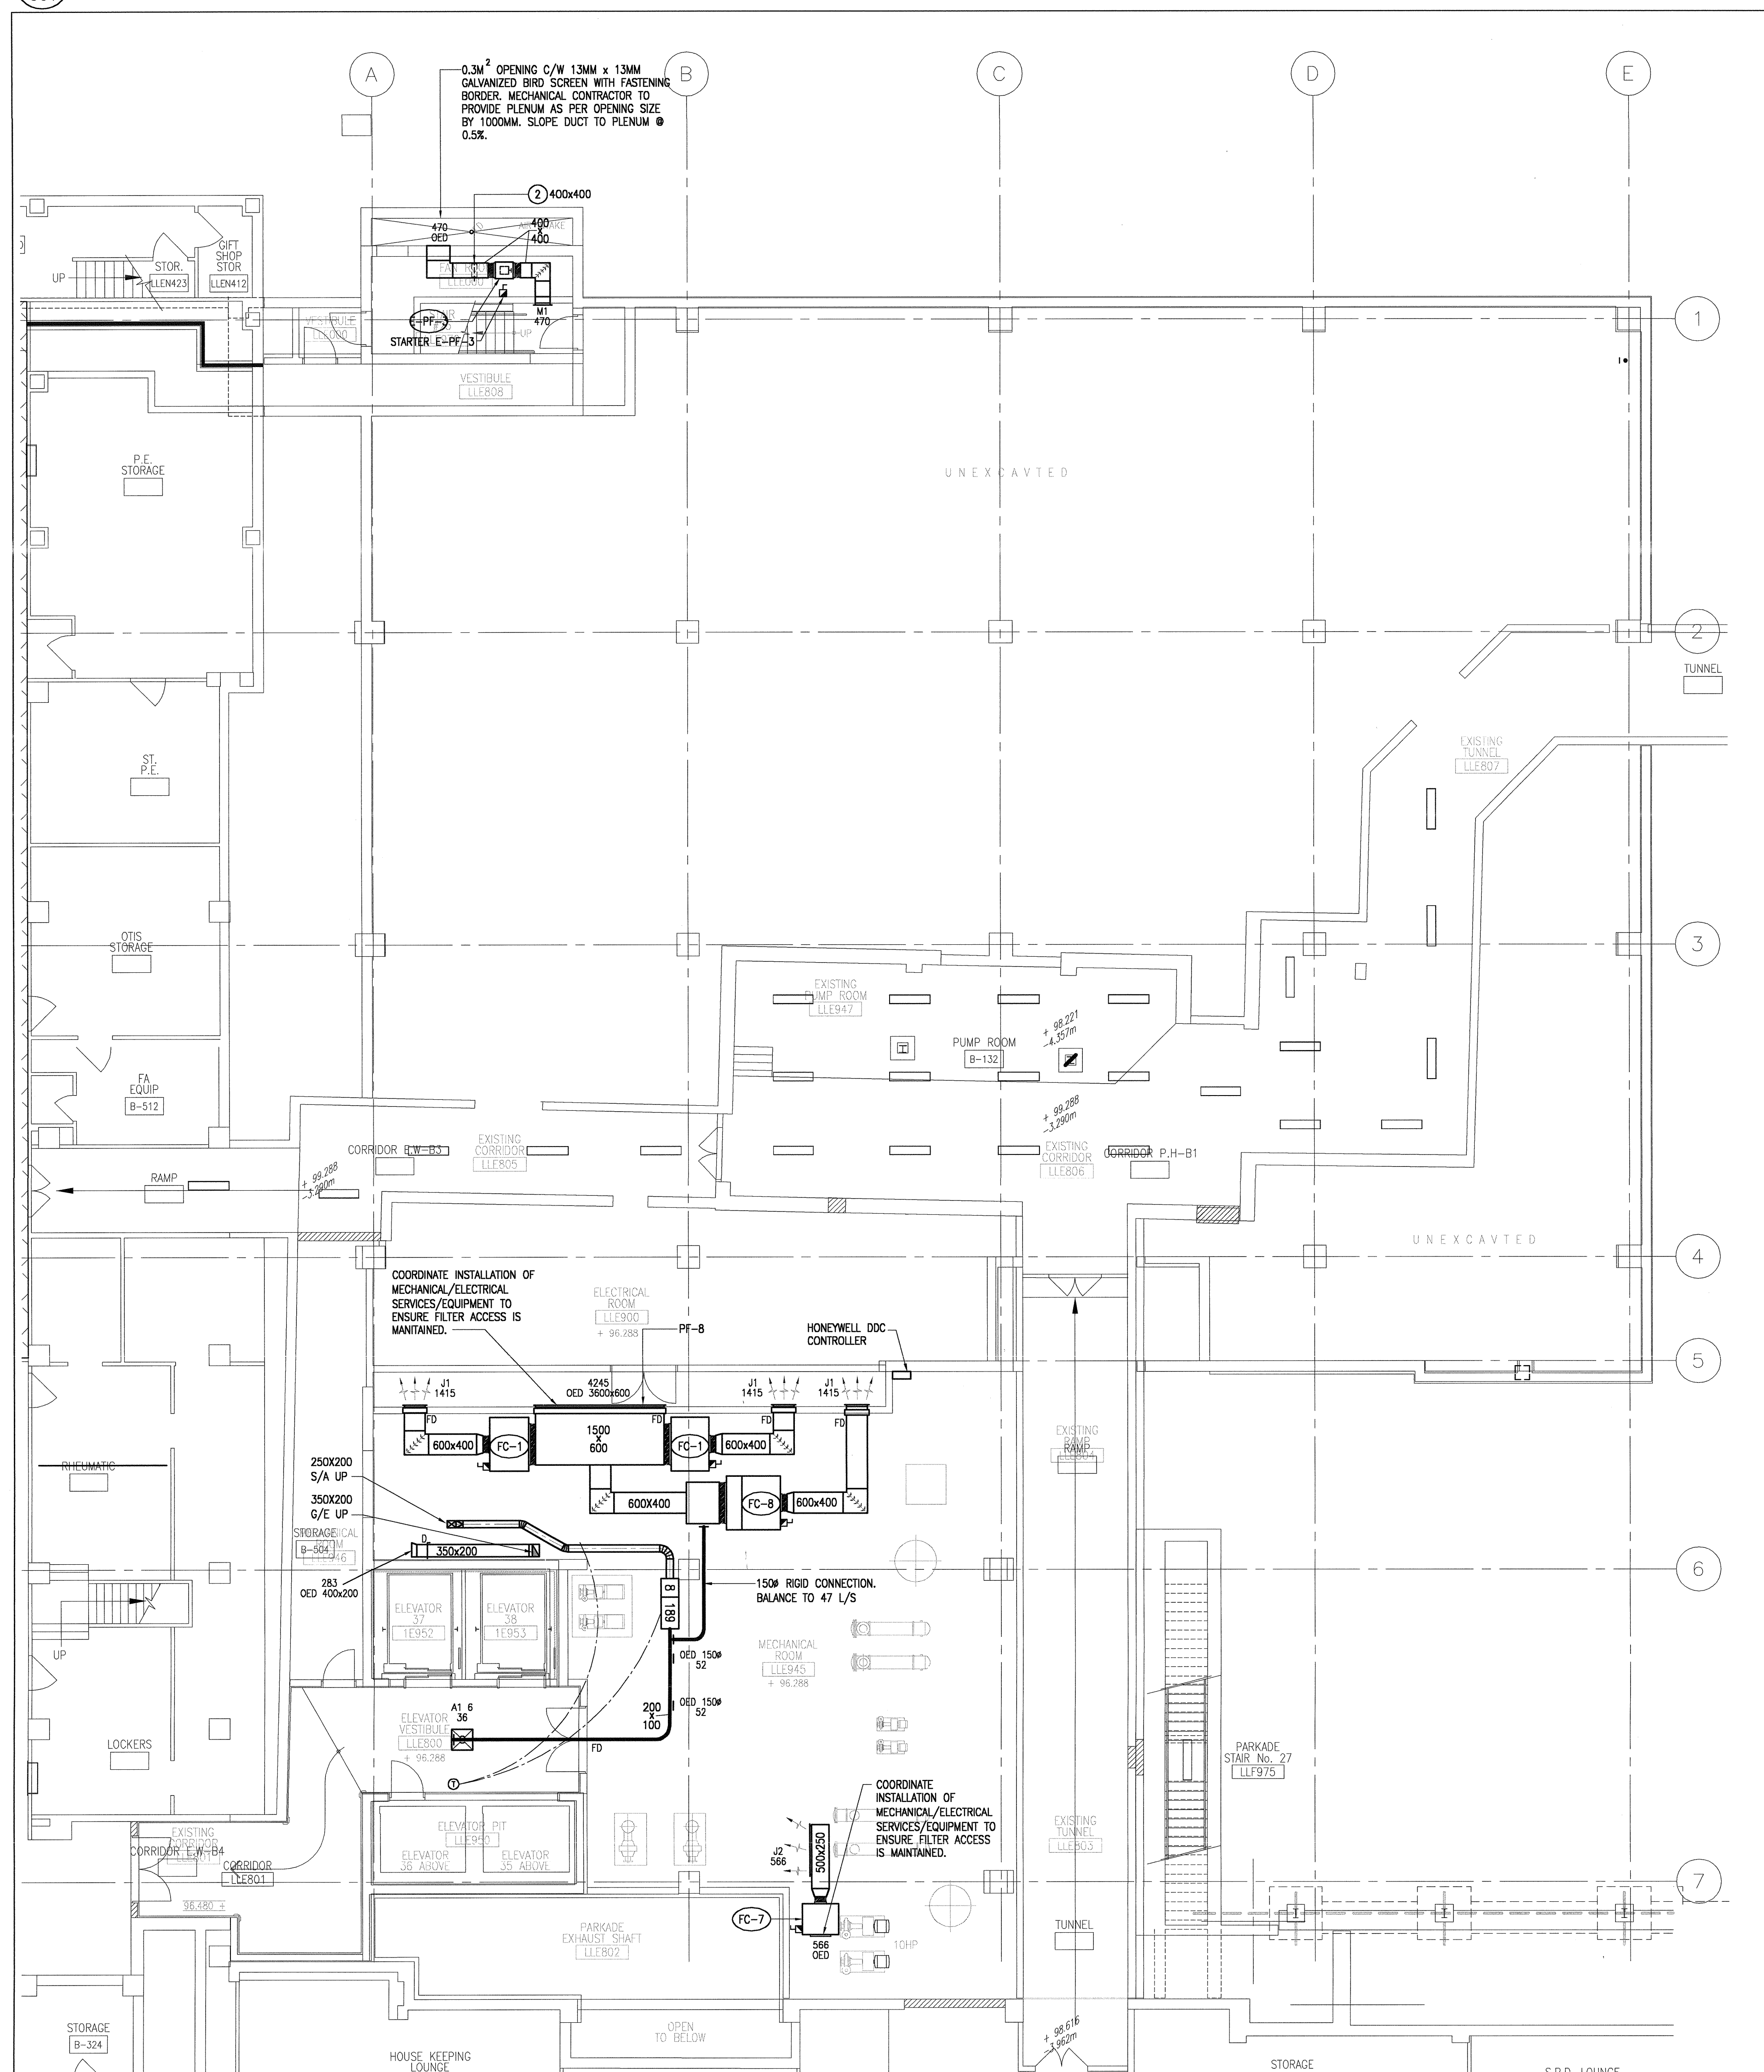


1 LOWER LEVEL FLOOR PLAN
501 Scale: 1:100

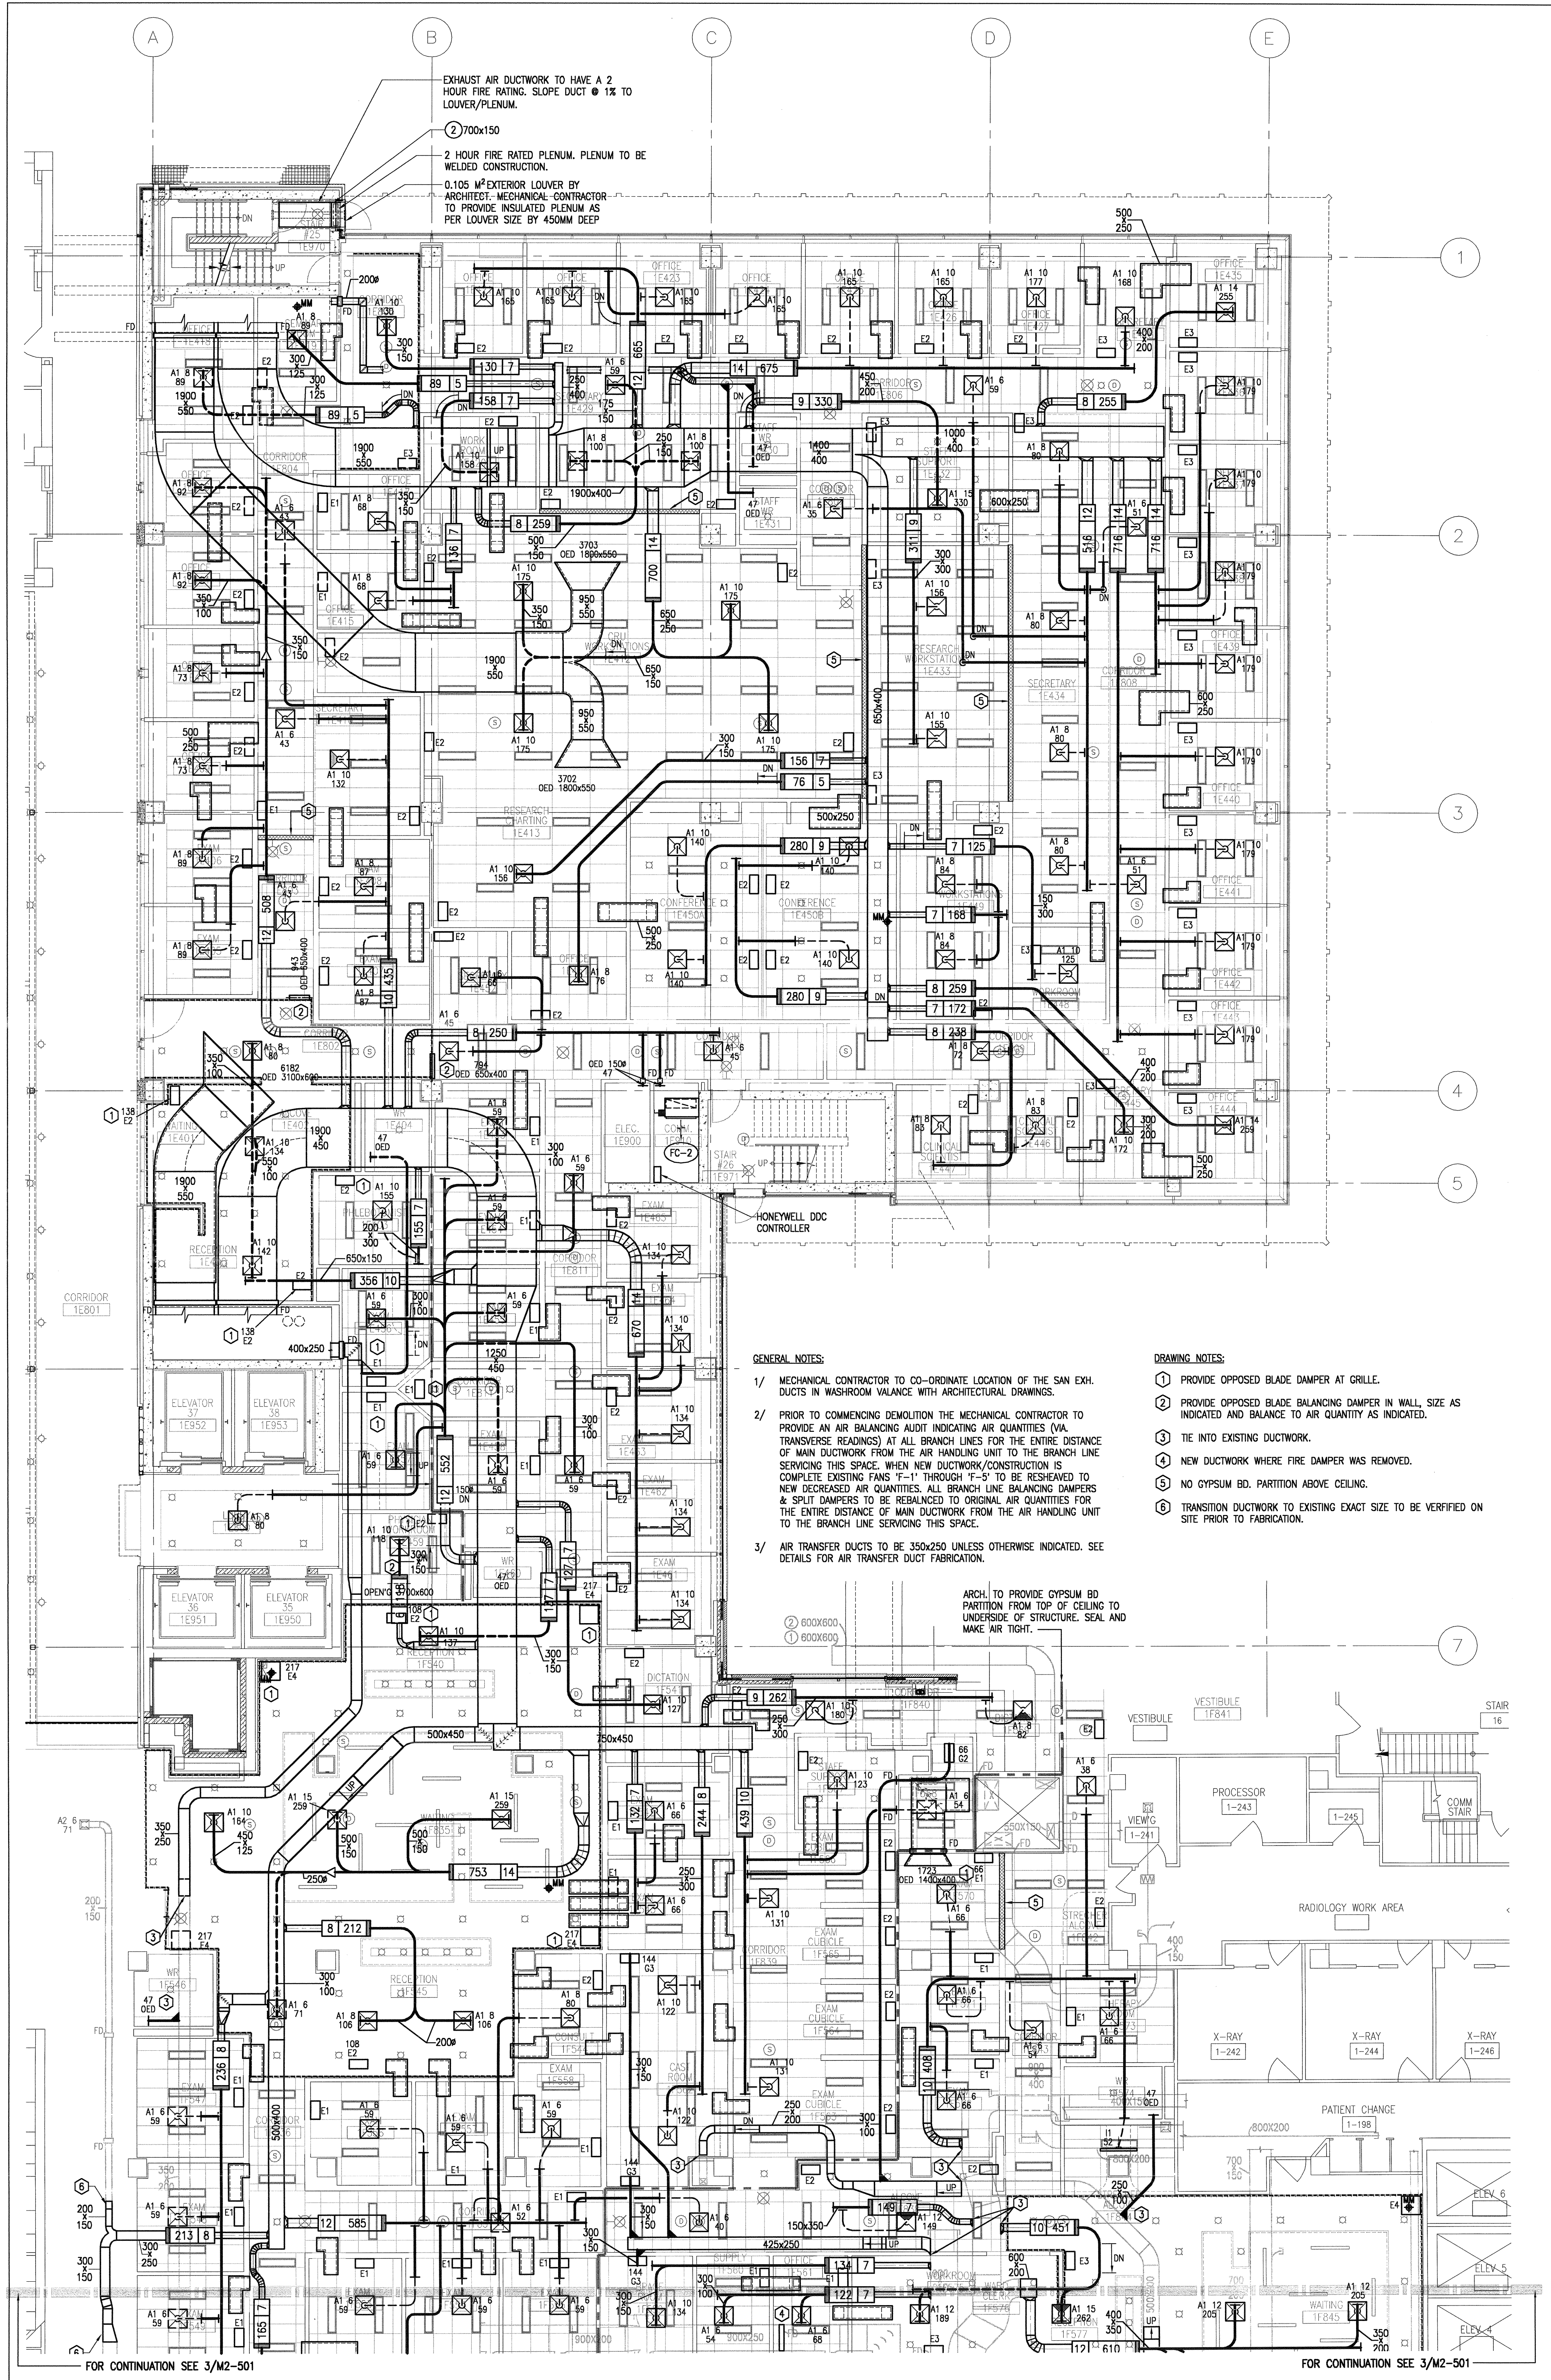

2 LEVEL ONE FLOOR PLAN
501 Scale: 1:100

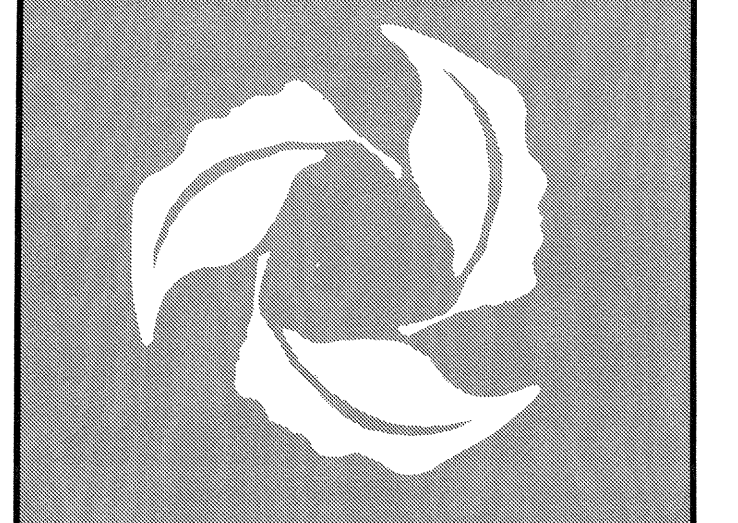


Toronto Western Hospital
University Health Network

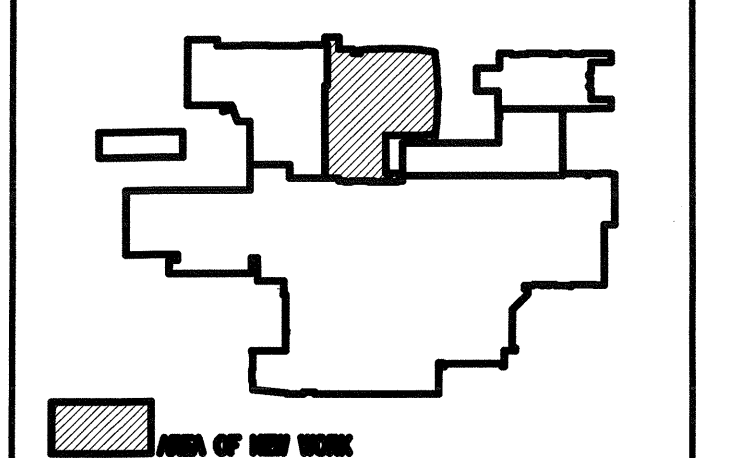

REF PLAN (3132)

REF.	DATE	DESCRIPTION
10	07/04/30	ISSUED FOR AS-BUILT DRAWINGS
9	03/08/19	REVISED FOR SITE INSTRUCTION M-10
8	03/08/20	ISSUED FOR CONSTRUCTION
7	03/04/11	ISSUED FOR ADD. M-1
6	03/03/27	ISSUED FOR BUILDING PERMIT
5	03/01/29	ISSUED FOR GENERAL TENDER
4	03/01/29	ISSUED FOR BIDDING COSTING
3	02/12/19	APPLICATION FOR BUILDING PERMIT
2	02/11/17	ISSUED FOR BIDDING COSTING
1	02/08/16	ISSUED FOR COSTING

CHECK AND VERIFY ALL DIMENSIONS BEFORE PROCEEDING WITH THE WORK. DO NOT SCALE DRAWINGS.

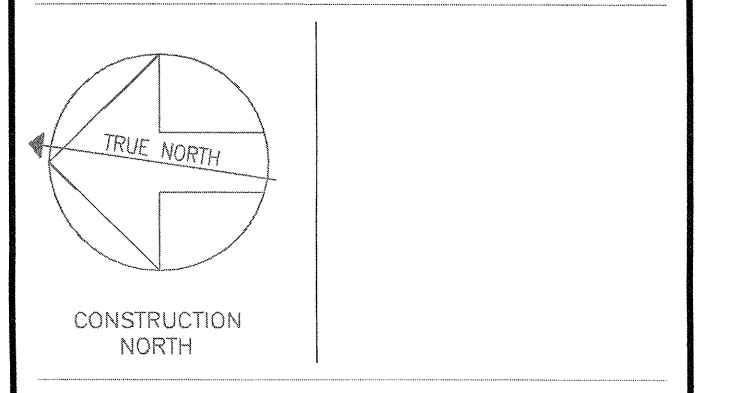

AS-BUILT DRAWINGS

PROJECT NAME:
TORONTO WESTERN HOSPITAL
EAST WING REDEVELOPMENT
MAIN BUILDING - STAGE TWO
TORONTO ONTARIO

DRAWING TITLE:
LOWER LEVEL FLOOR PLAN
LEVEL 1 FLOOR PLAN
VENTILATION

SCALE:
1 : 100


DATE:
MARCH 2003

DRAWN BY:
M2-501

CHECKED BY:


PROJECT NUMBER:
2011210

DRAWING NUMBER:

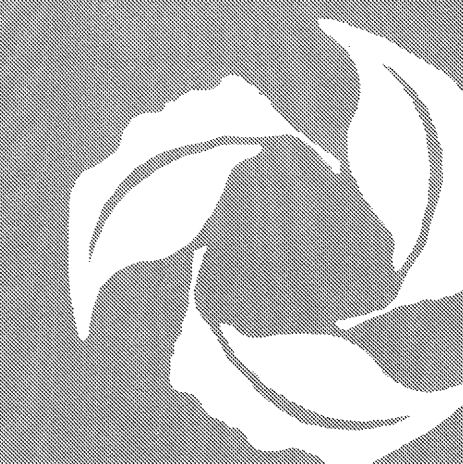

Toronto Western Hospital

University Health Network

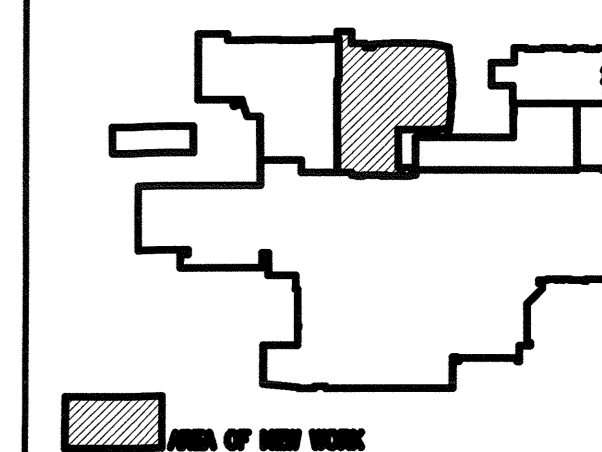


KEY PLAN (201)

10	07/04/30	ISSUED FOR AS-BUILT DRAWINGS
9	03/07/18	REVISED FOR SITE INSTRUCTION M7
8	03/06/20	ISSUED FOR CONSTRUCTION
7	03/04/11	ISSUED FOR ADD. M-1
6	03/03/27	ISSUED FOR BUILDING PERMIT
5	03/03/18	ISSUED FOR GENERAL TENDER
4	03/01/29	ISSUED FOR BOM COSTING
3	02/12/19	APPLICATION FOR BUILDING PERMIT
2	02/11/17	ISSUED FOR BOM REVIEW
1	02/09/16	ISSUED FOR COSTING

REF. DATE DESCRIPTION
(yy/mm/dd)

CHECK AND VERIFY ALL DIMENSIONS BEFORE PROCEEDING WITH THE WORK. DO NOT SCALE DRAWINGS.

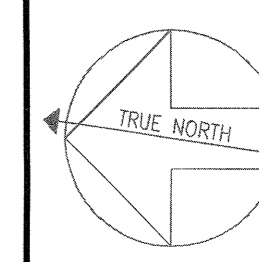


AS-BUILT DRAWINGS


PROJECT NAME:
TORONTO WESTERN HOSPITAL
EAST WING REDEVELOPMENT
MAIN BUILDING - STAGE TWO
TORONTO ONTARIO

DRAWING TITLE:
LEVEL 2 FLOOR PLAN
LEVEL 3 FLOOR PLAN
VENTILATION

SCALE:
1 : 100
DATE:
MARCH 2003
DRAWN BY:
M2-502
PROJECT NUMBER:
2011210
DRAWING NUMBER:

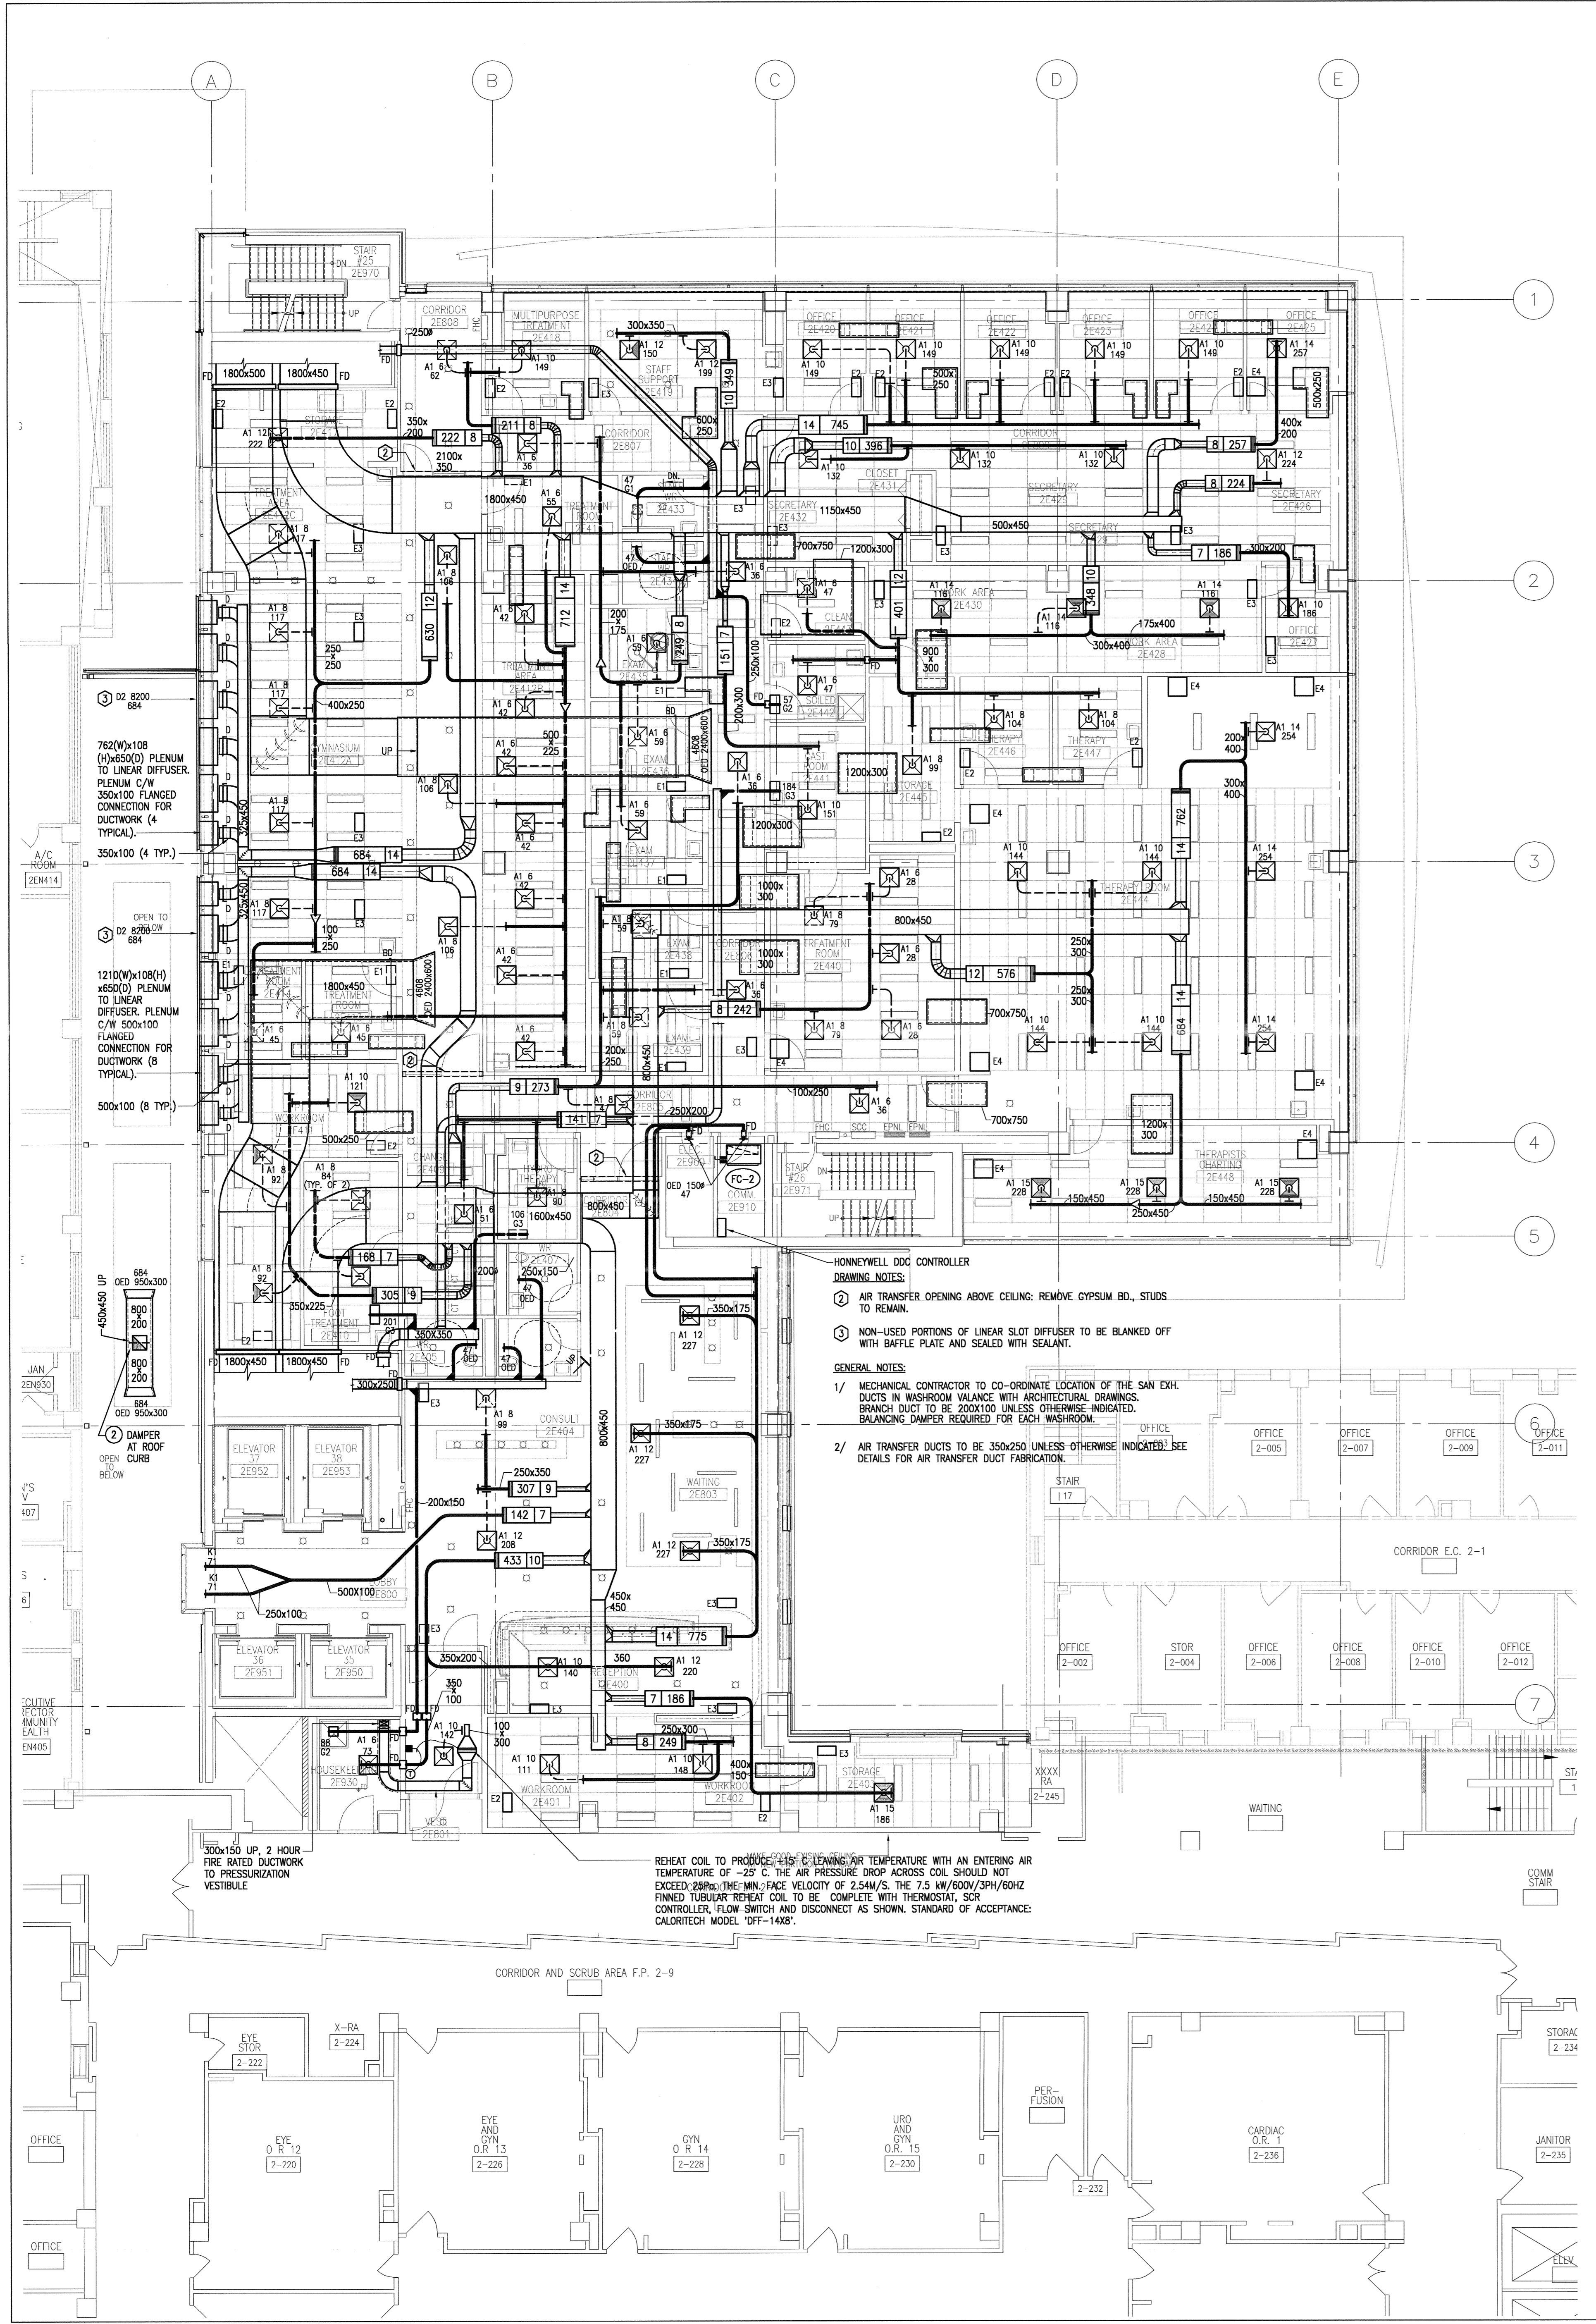

1 LEVEL TWO FLOOR PLAN
Scale: 1:100

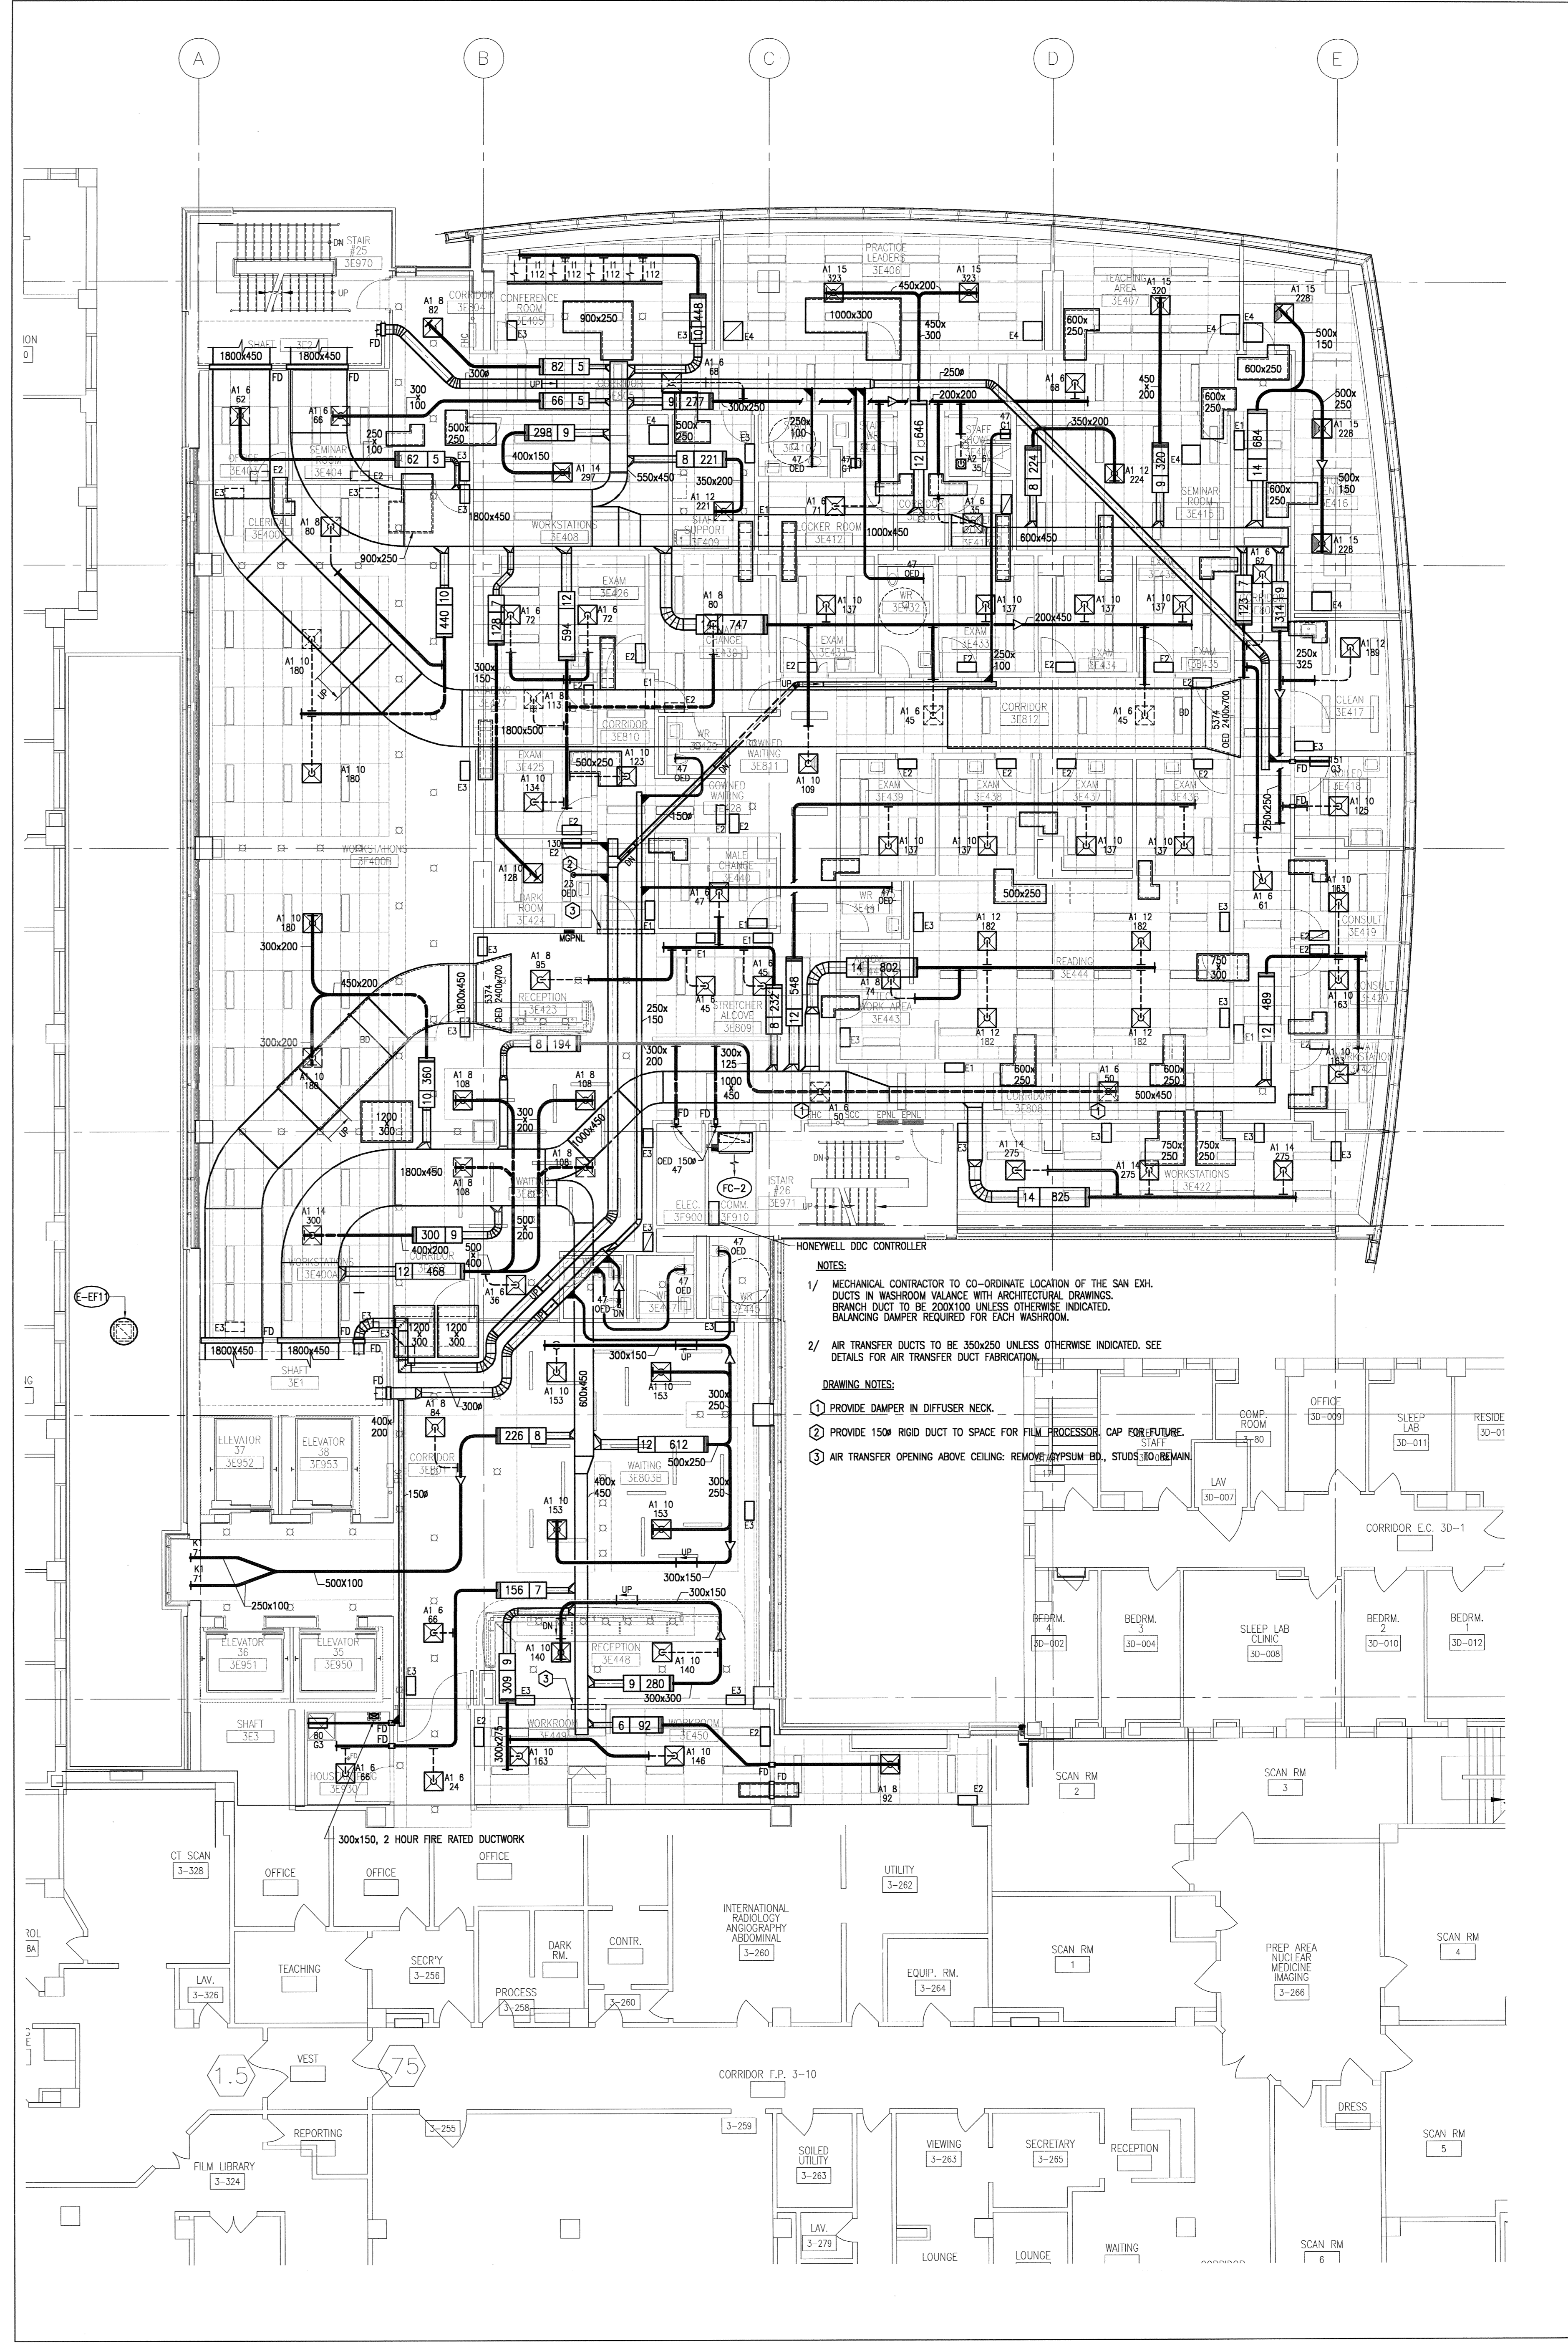


2 LEVEL THREE FLOOR PLAN
Scale: 1:100



Toronto Western Hospital


University Health Network

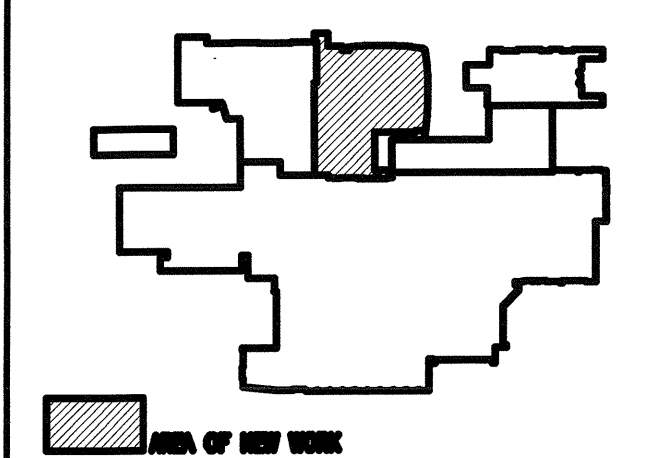

503 PLAN (M2)

REF.	DATE	DESCRIPTION
11	07/04/30	ISSUED FOR AS-BUILT DRAWINGS
10	03/06/20	ISSUED FOR CONSTRUCTION
9	03/05/11	REVISED FOR ADD. M-5
8	03/04/24	REVISED FOR ADD. M-3
7	03/04/11	REVISED FOR ADD. M-1
6	03/03/27	ISSUED FOR BUILDING PERMIT
5.1	03/03/27	ISSUED FOR GENERAL TENDER
5	03/03/18	ISSUED FOR GENERAL TENDER
4	03/01/29	ISSUED FOR BOM COSTING
3	02/12/19	APPLICATION FOR BUILDING PERMIT
2	02/11/17	ISSUED FOR BOM REVIEW
1	02/09/16	ISSUED FOR COSTING

CHECK AND VERIFY ALL DIMENSIONS BEFORE PROCEEDING WITH THE WORK. DO NOT SCALE DRAWINGS.

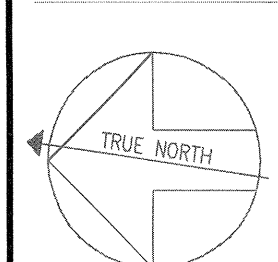

AS-BUILT DRAWINGS

PROJECT NAME:
TORONTO WESTERN HOSPITAL
EAST WING REDEVELOPMENT
MAIN BUILDING - STAGE TWO
TORONTO ONTARIO

DRAWING TITLE:
LEVEL 4 FLOOR PLAN
LEVEL 5 FLOOR PLAN
VENTILATION

SCALE:
1:100


DATE:
MARCH 2003

DRAWN BY:
M2-503


CHECKED BY:

PROJECT NUMBER:
2011210


DRAWING NUMBER:

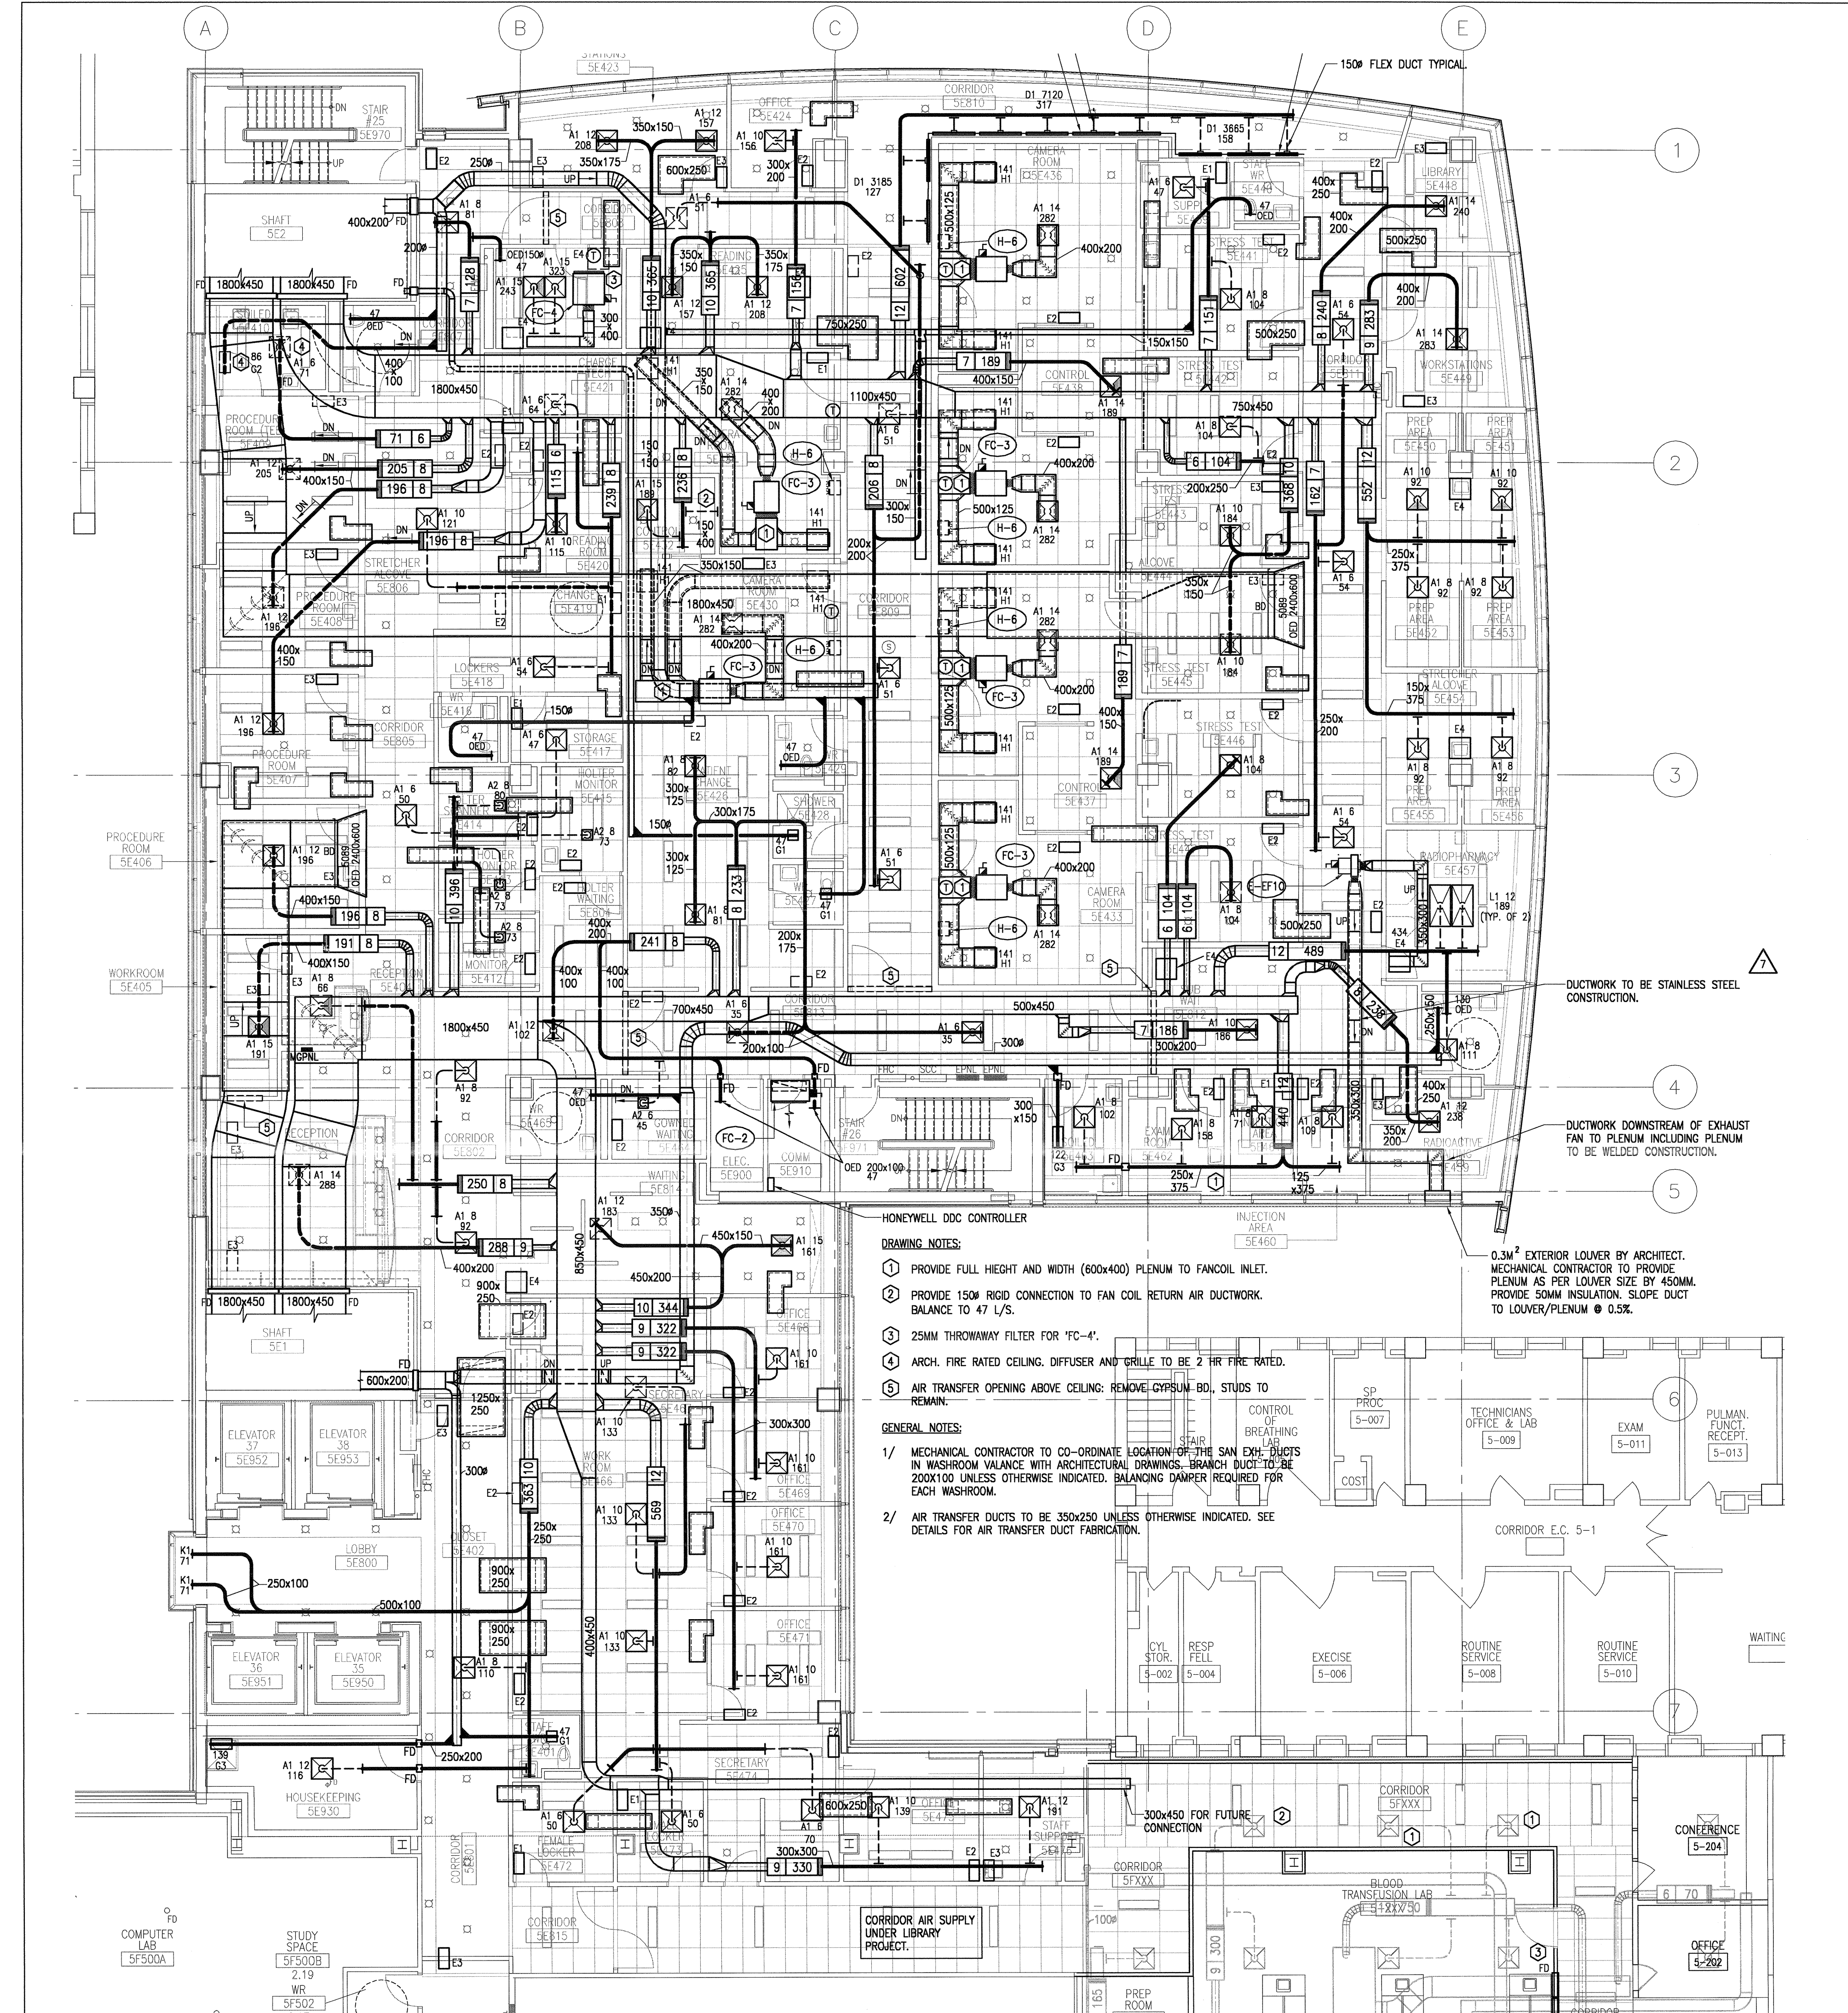


2 LEVEL FIVE FLOOR PLAN
503 Scale: 1:100

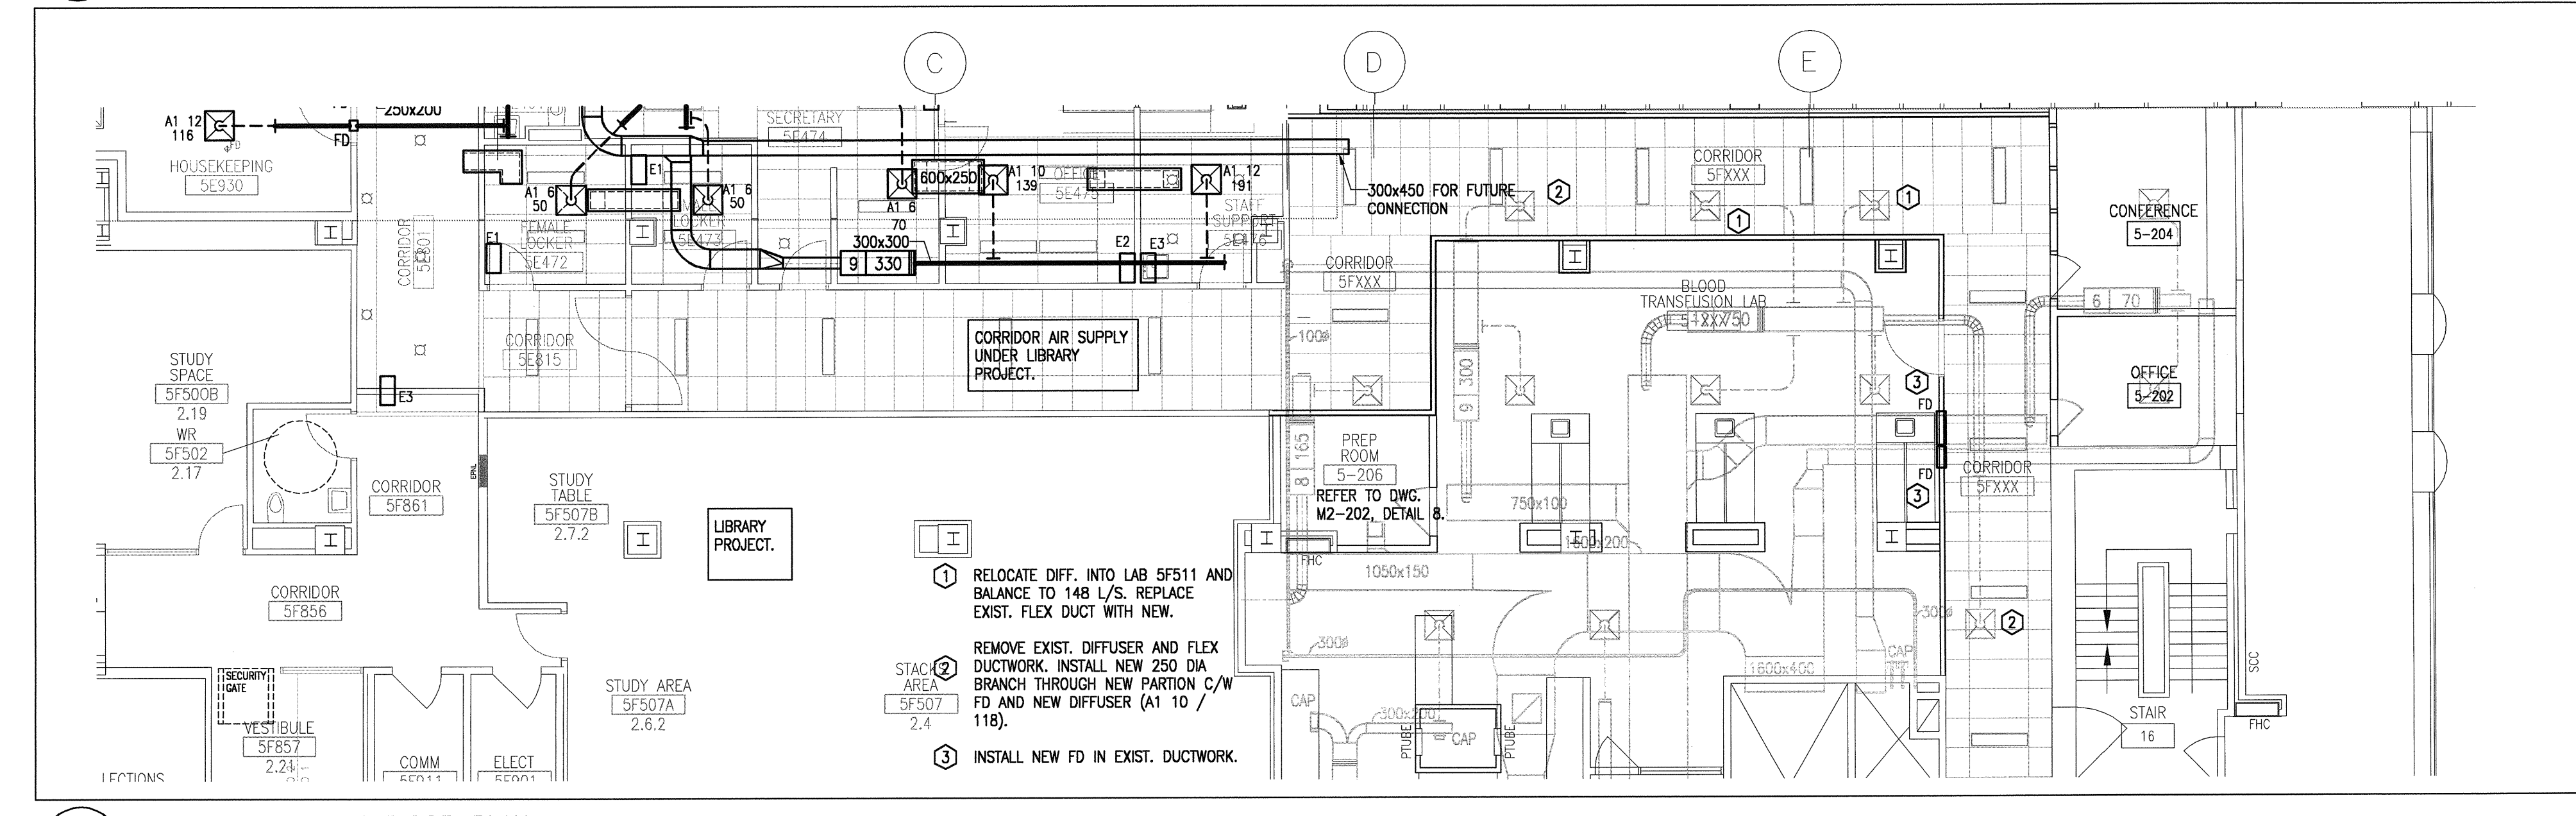

1 PARTIAL LEVEL FIVE FLOOR PLAN
503 Scale: 1:100

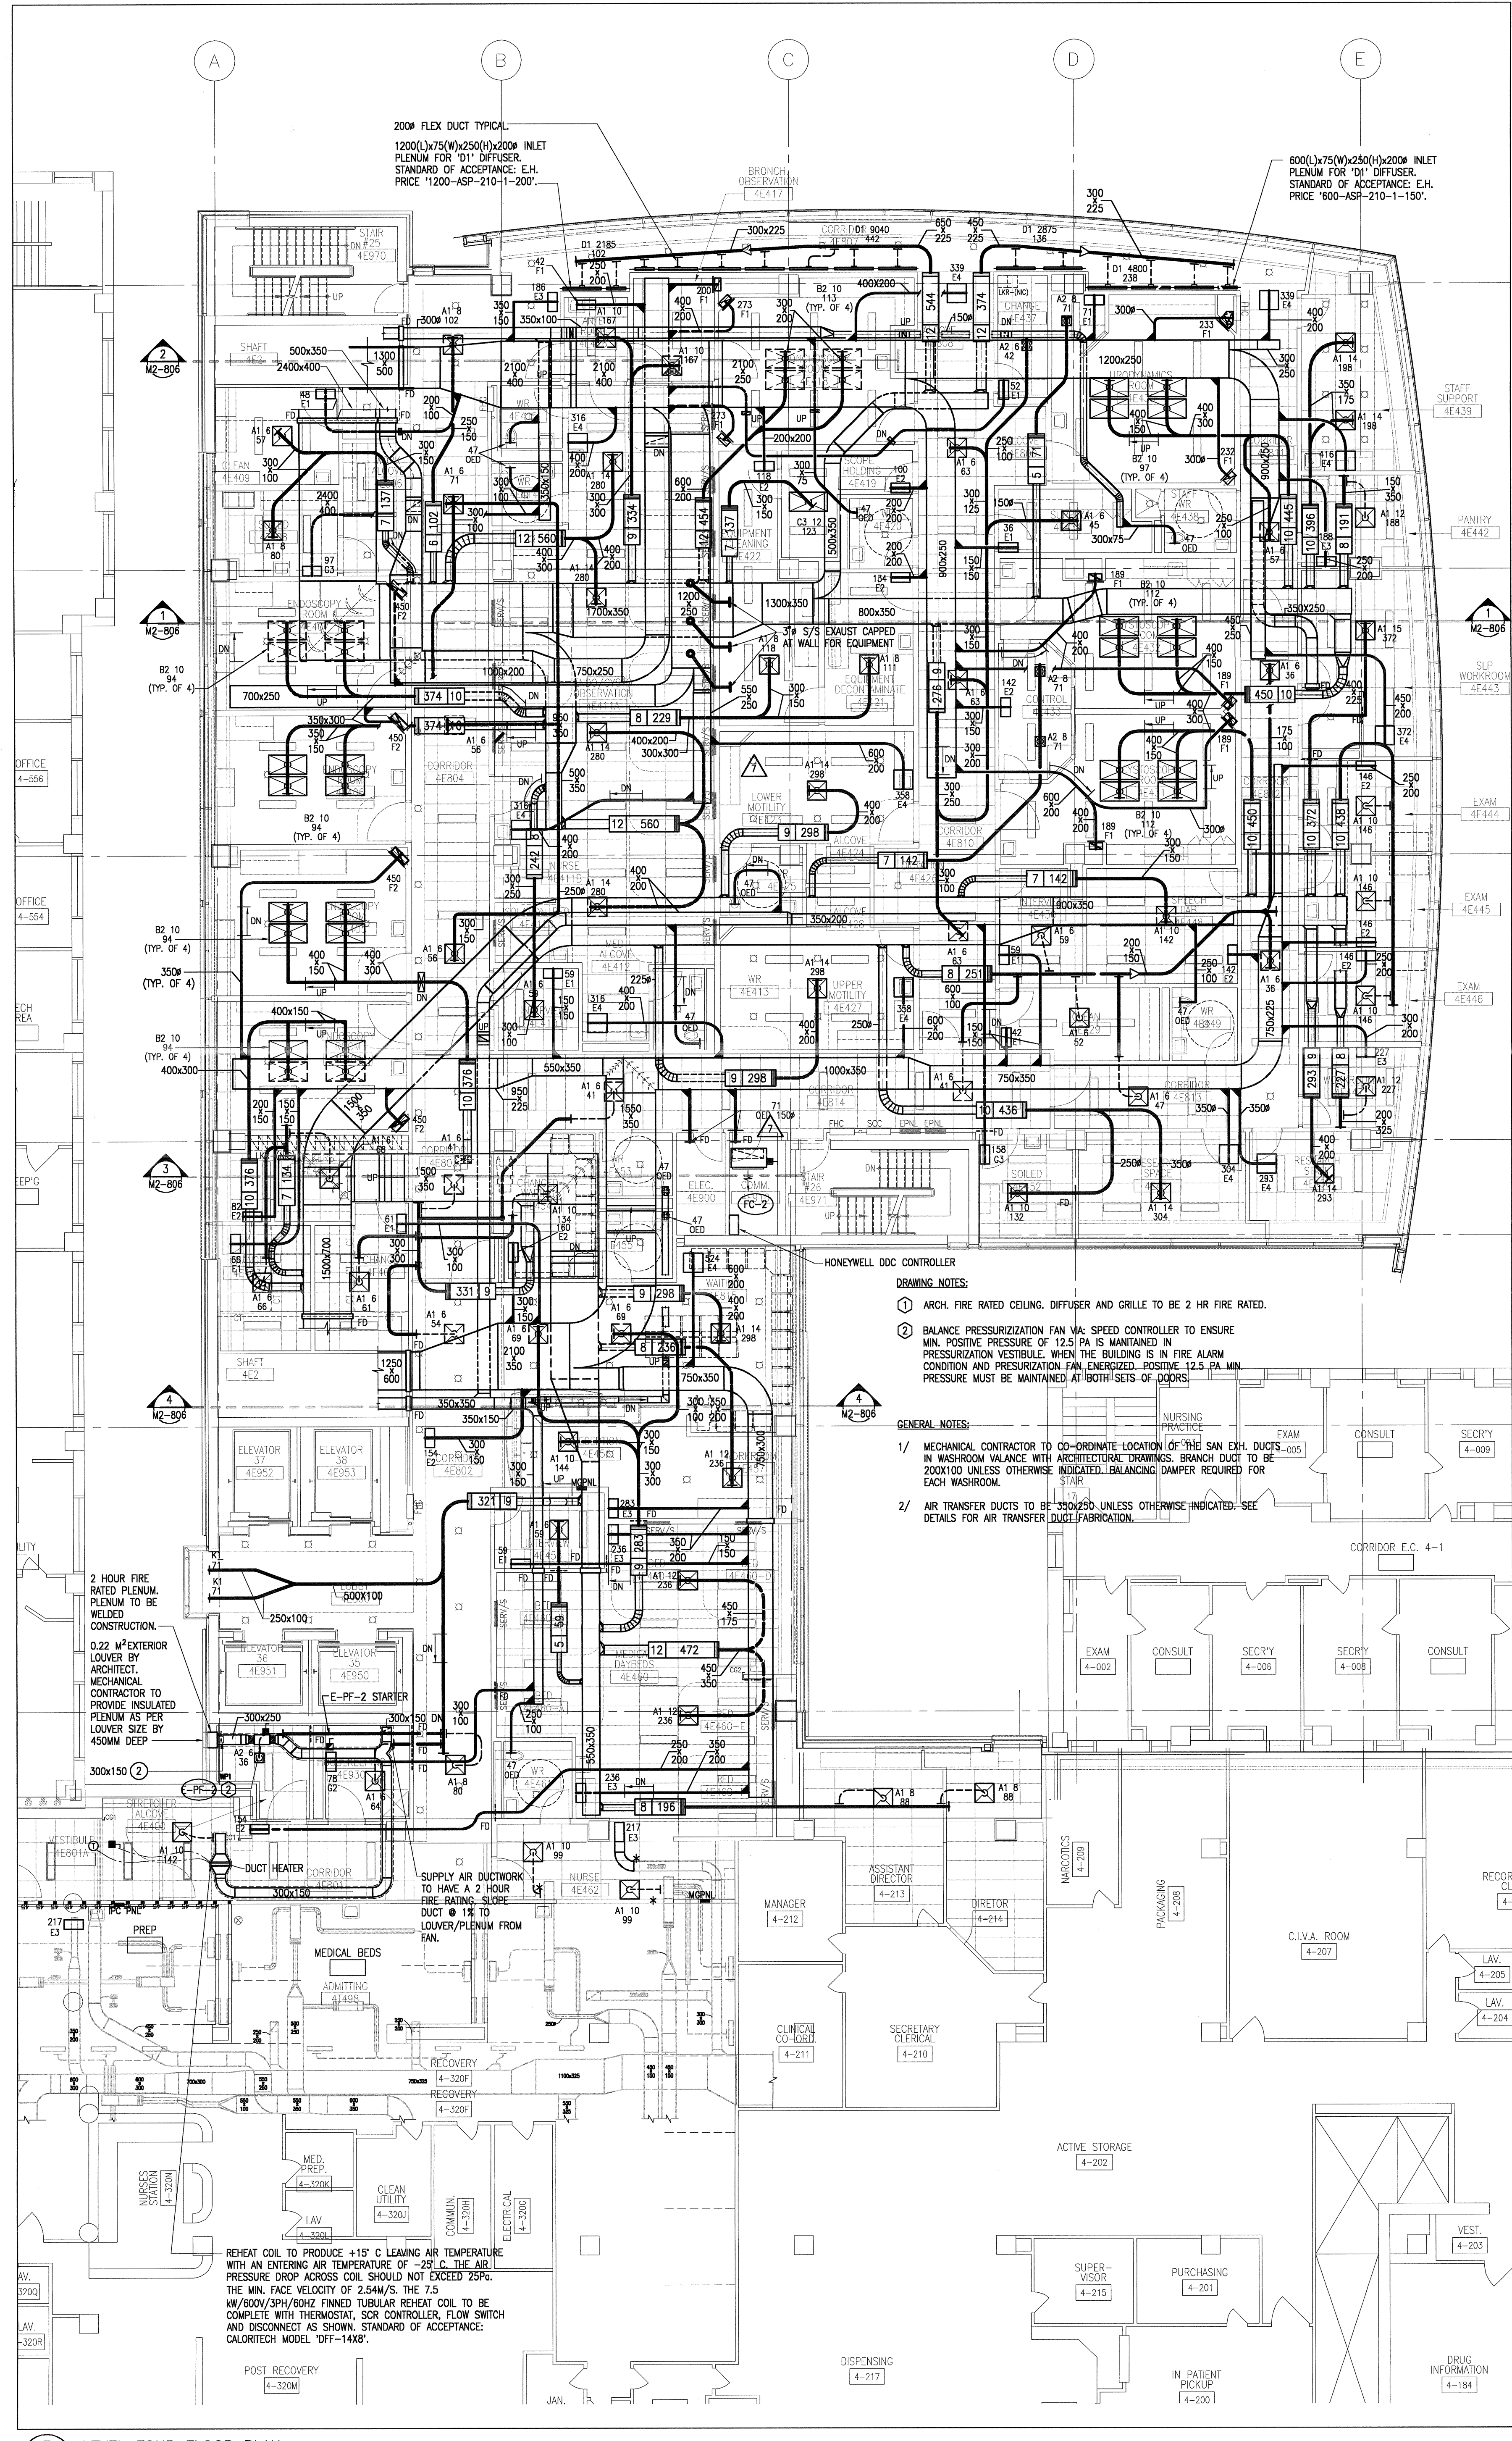


3 LEVEL FOUR FLOOR PLAN
503 Scale: 1:100

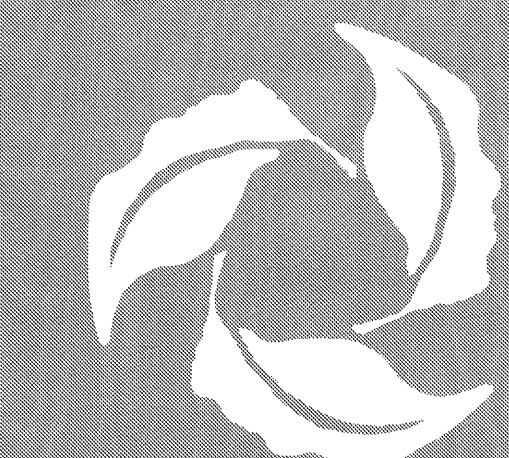

Toronto Western Hospital


University Health Network

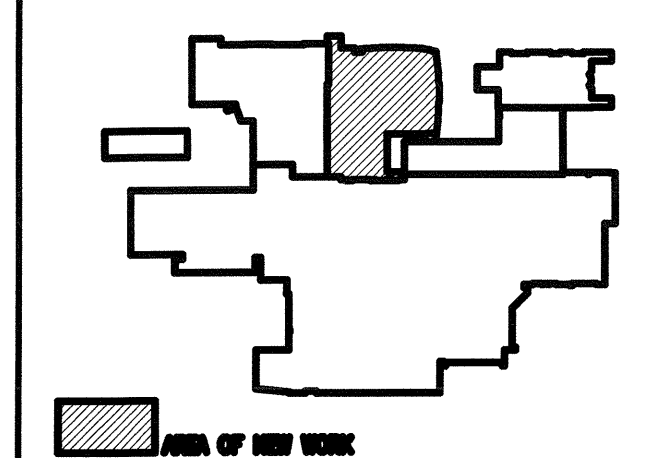

NEW PLAN (622)

NO.	DATE	DESCRIPTION
10	07/04/00	ISSUED FOR AS-BUILT DRAWINGS
9	03/06/00	ISSUED FOR CONSTRUCTION
8	03/05/01	REVISED FOR ADD. W-5
7	03/04/01	REVISED FOR ADD. W-1
6	03/03/01	ISSUED FOR BUILDING PERMIT
5.1	03/03/01	ISSUED FOR GENERAL TENDER
5	03/03/01	ISSUED FOR GENERAL TENDER
4	03/01/01	ISSUED FOR BOX COSTING
3	02/12/01	APPLICATION FOR BUILDING PERMIT
2	02/11/01	ISSUED FOR BOX REVIEW
1	02/08/01	ISSUED FOR BOX REVIEW

CHECK AND VERIFY ALL DIMENSIONS BEFORE PROCEEDING WITH THE WORK. DO NOT SCALE DRAWINGS.

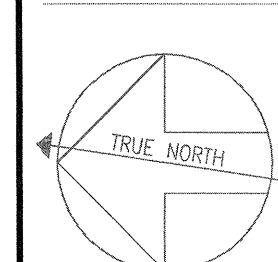

CONSTRUCTION NORTH

AS-BUILT DRAWINGS

PROJECT NAME:
TORONTO WESTERN HOSPITAL
EAST WING REDEVELOPMENT
MAIN BUILDING - STAGE TWO
TORONTO ONTARIO

DRAWING TITLE:
LEVEL 6 FLOOR PLAN
LEVEL 7 FLOOR PLAN
VENTILATION

SCALE:
1 : 100


DATE:
MARCH 2003

DRAWN BY:
M2-504


CHECKED BY:

PROJECT NUMBER:
2011210


DRAWING NUMBER:

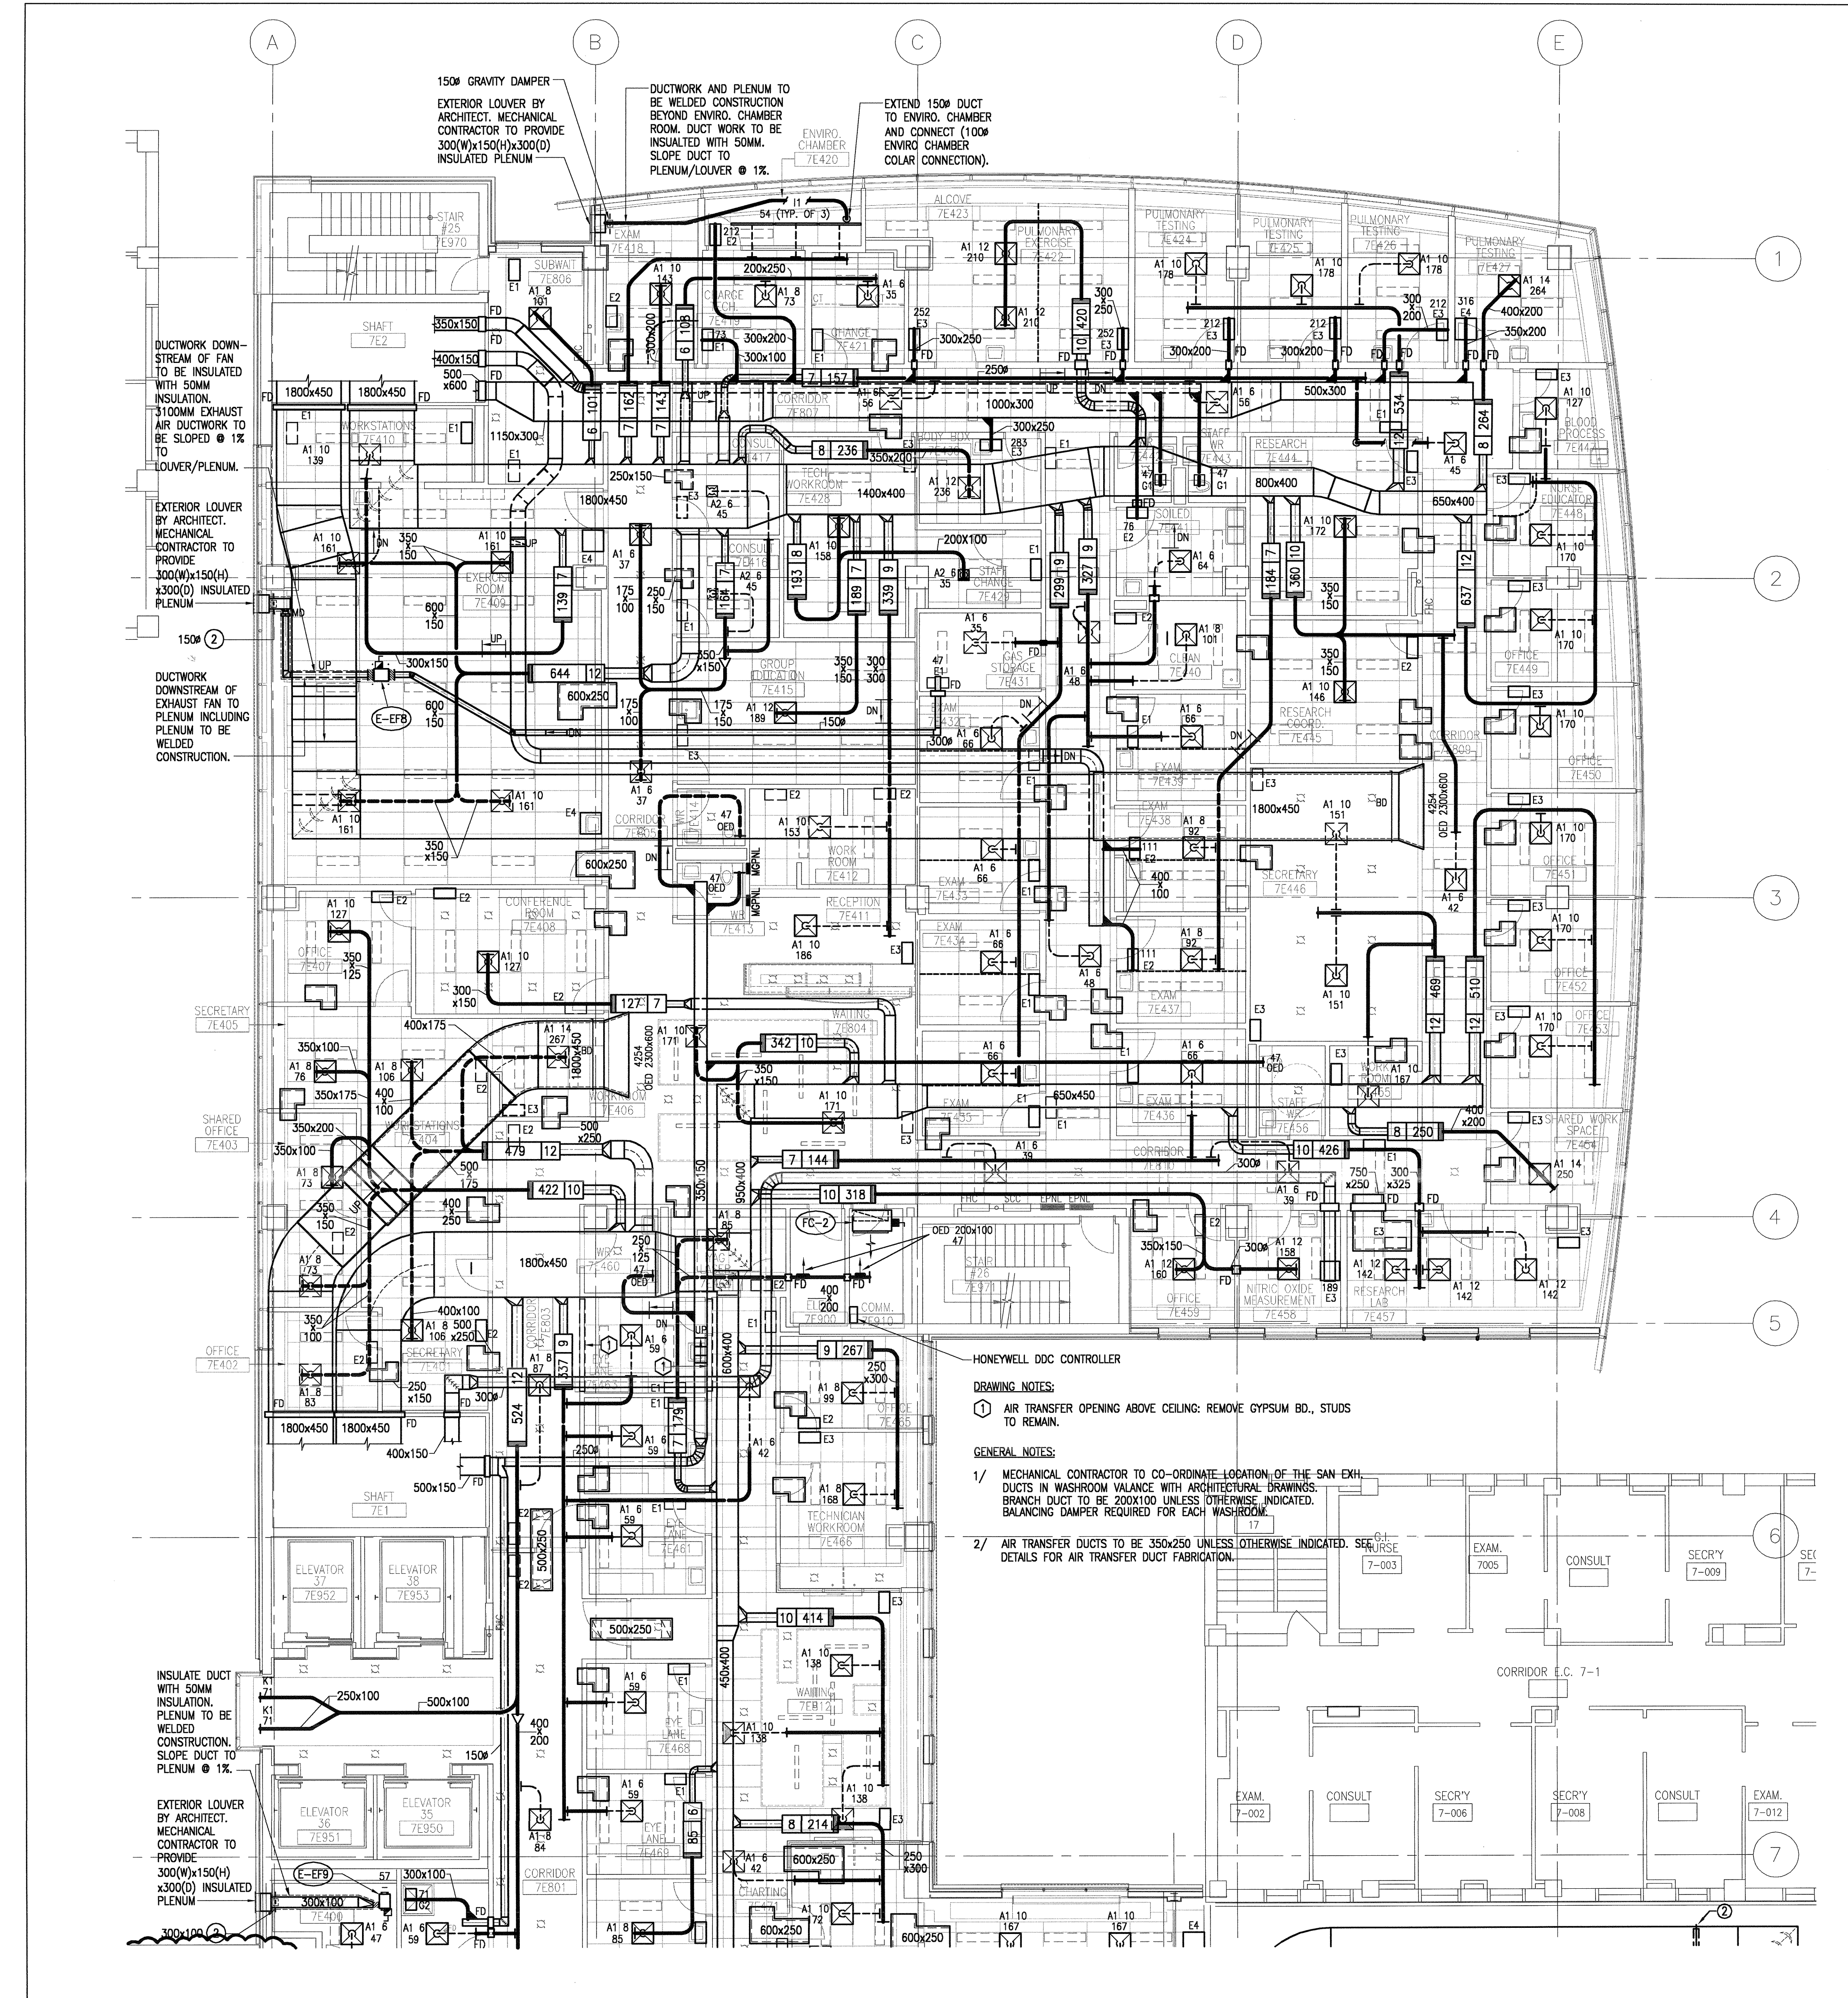

2 LEVEL SEVEN FLOOR PLAN
504 Scale: 1:100

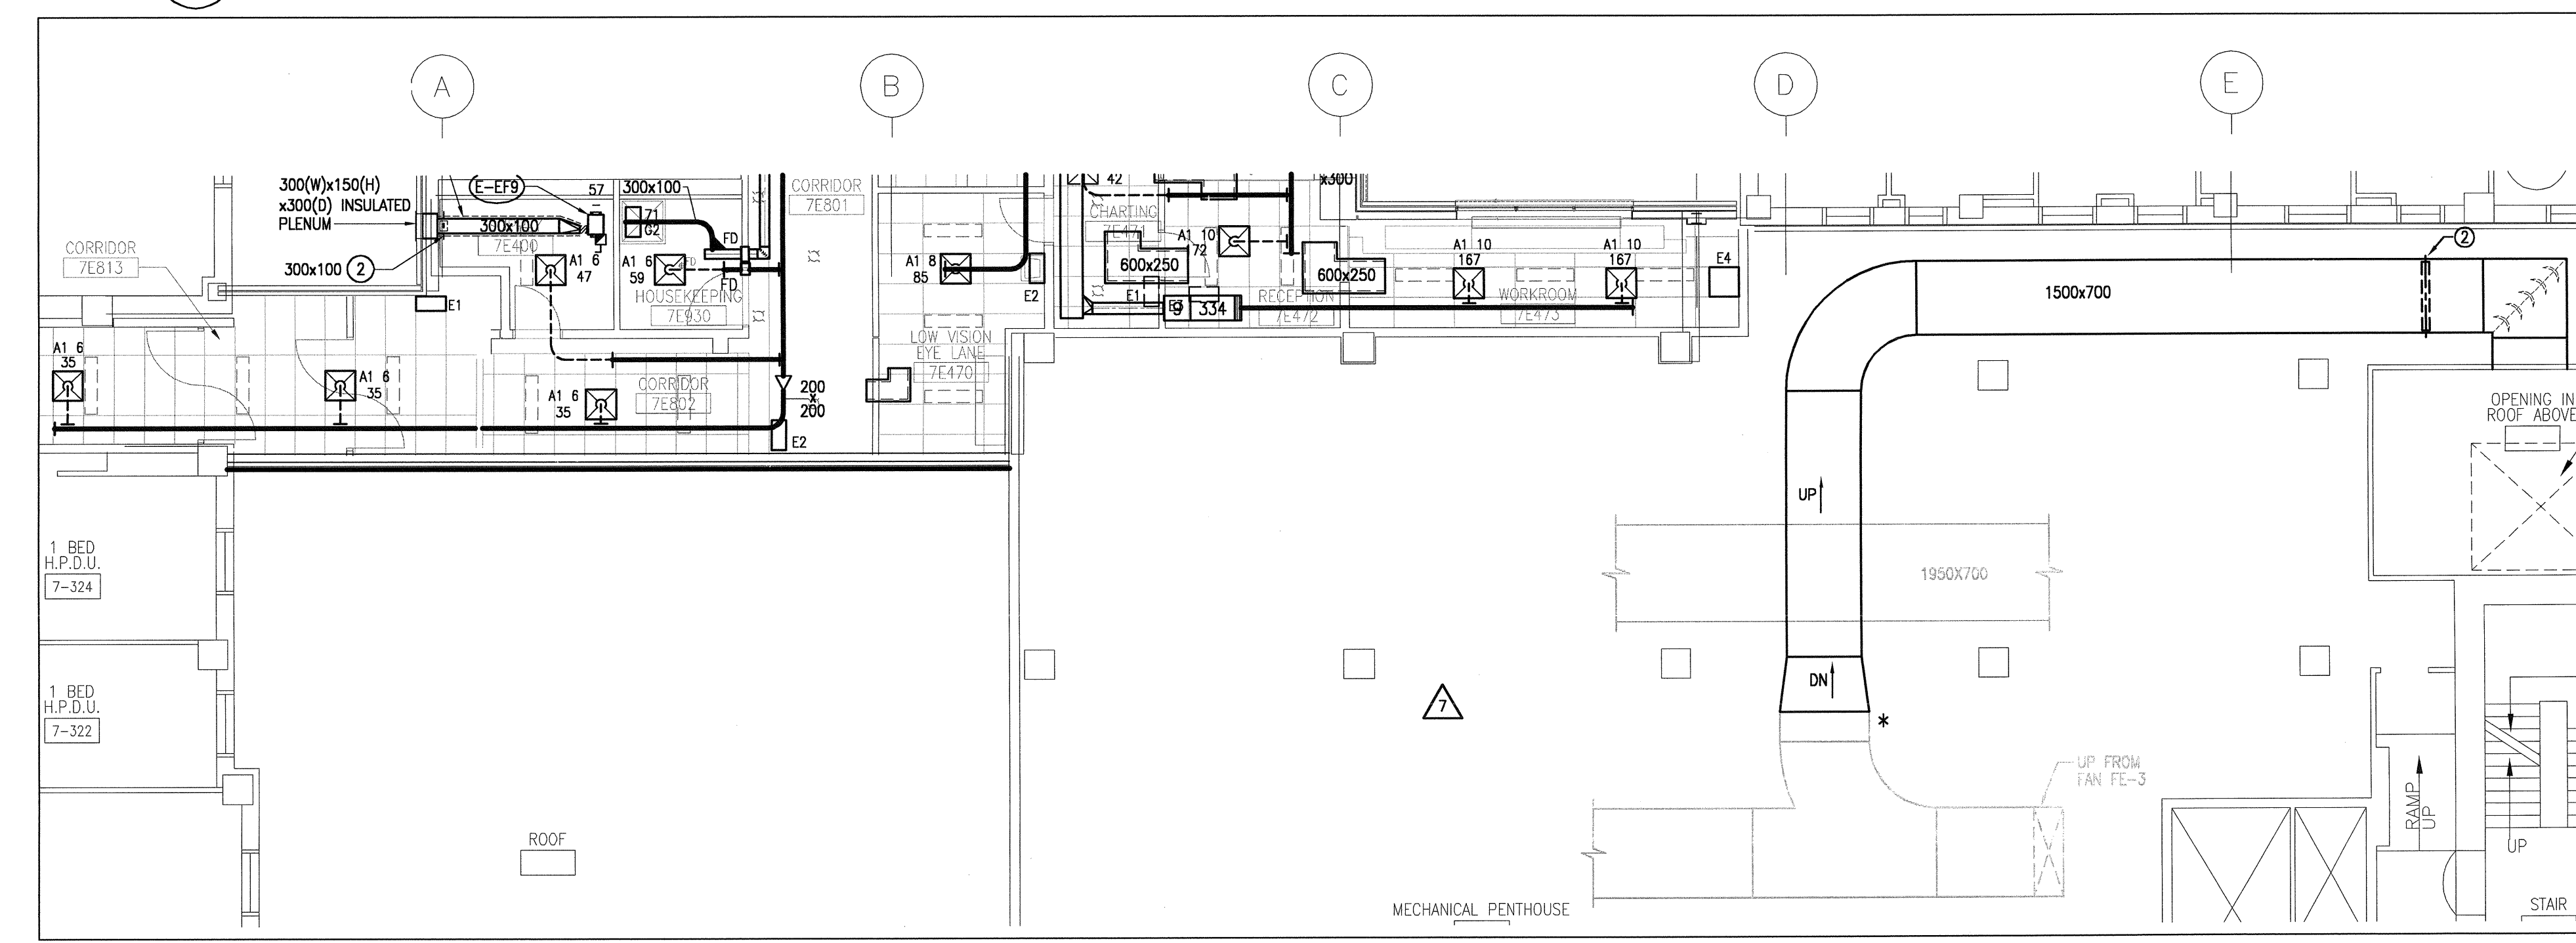

1 PARTIAL LEVEL SEVEN FLOOR PLAN
504 Scale: 1:100

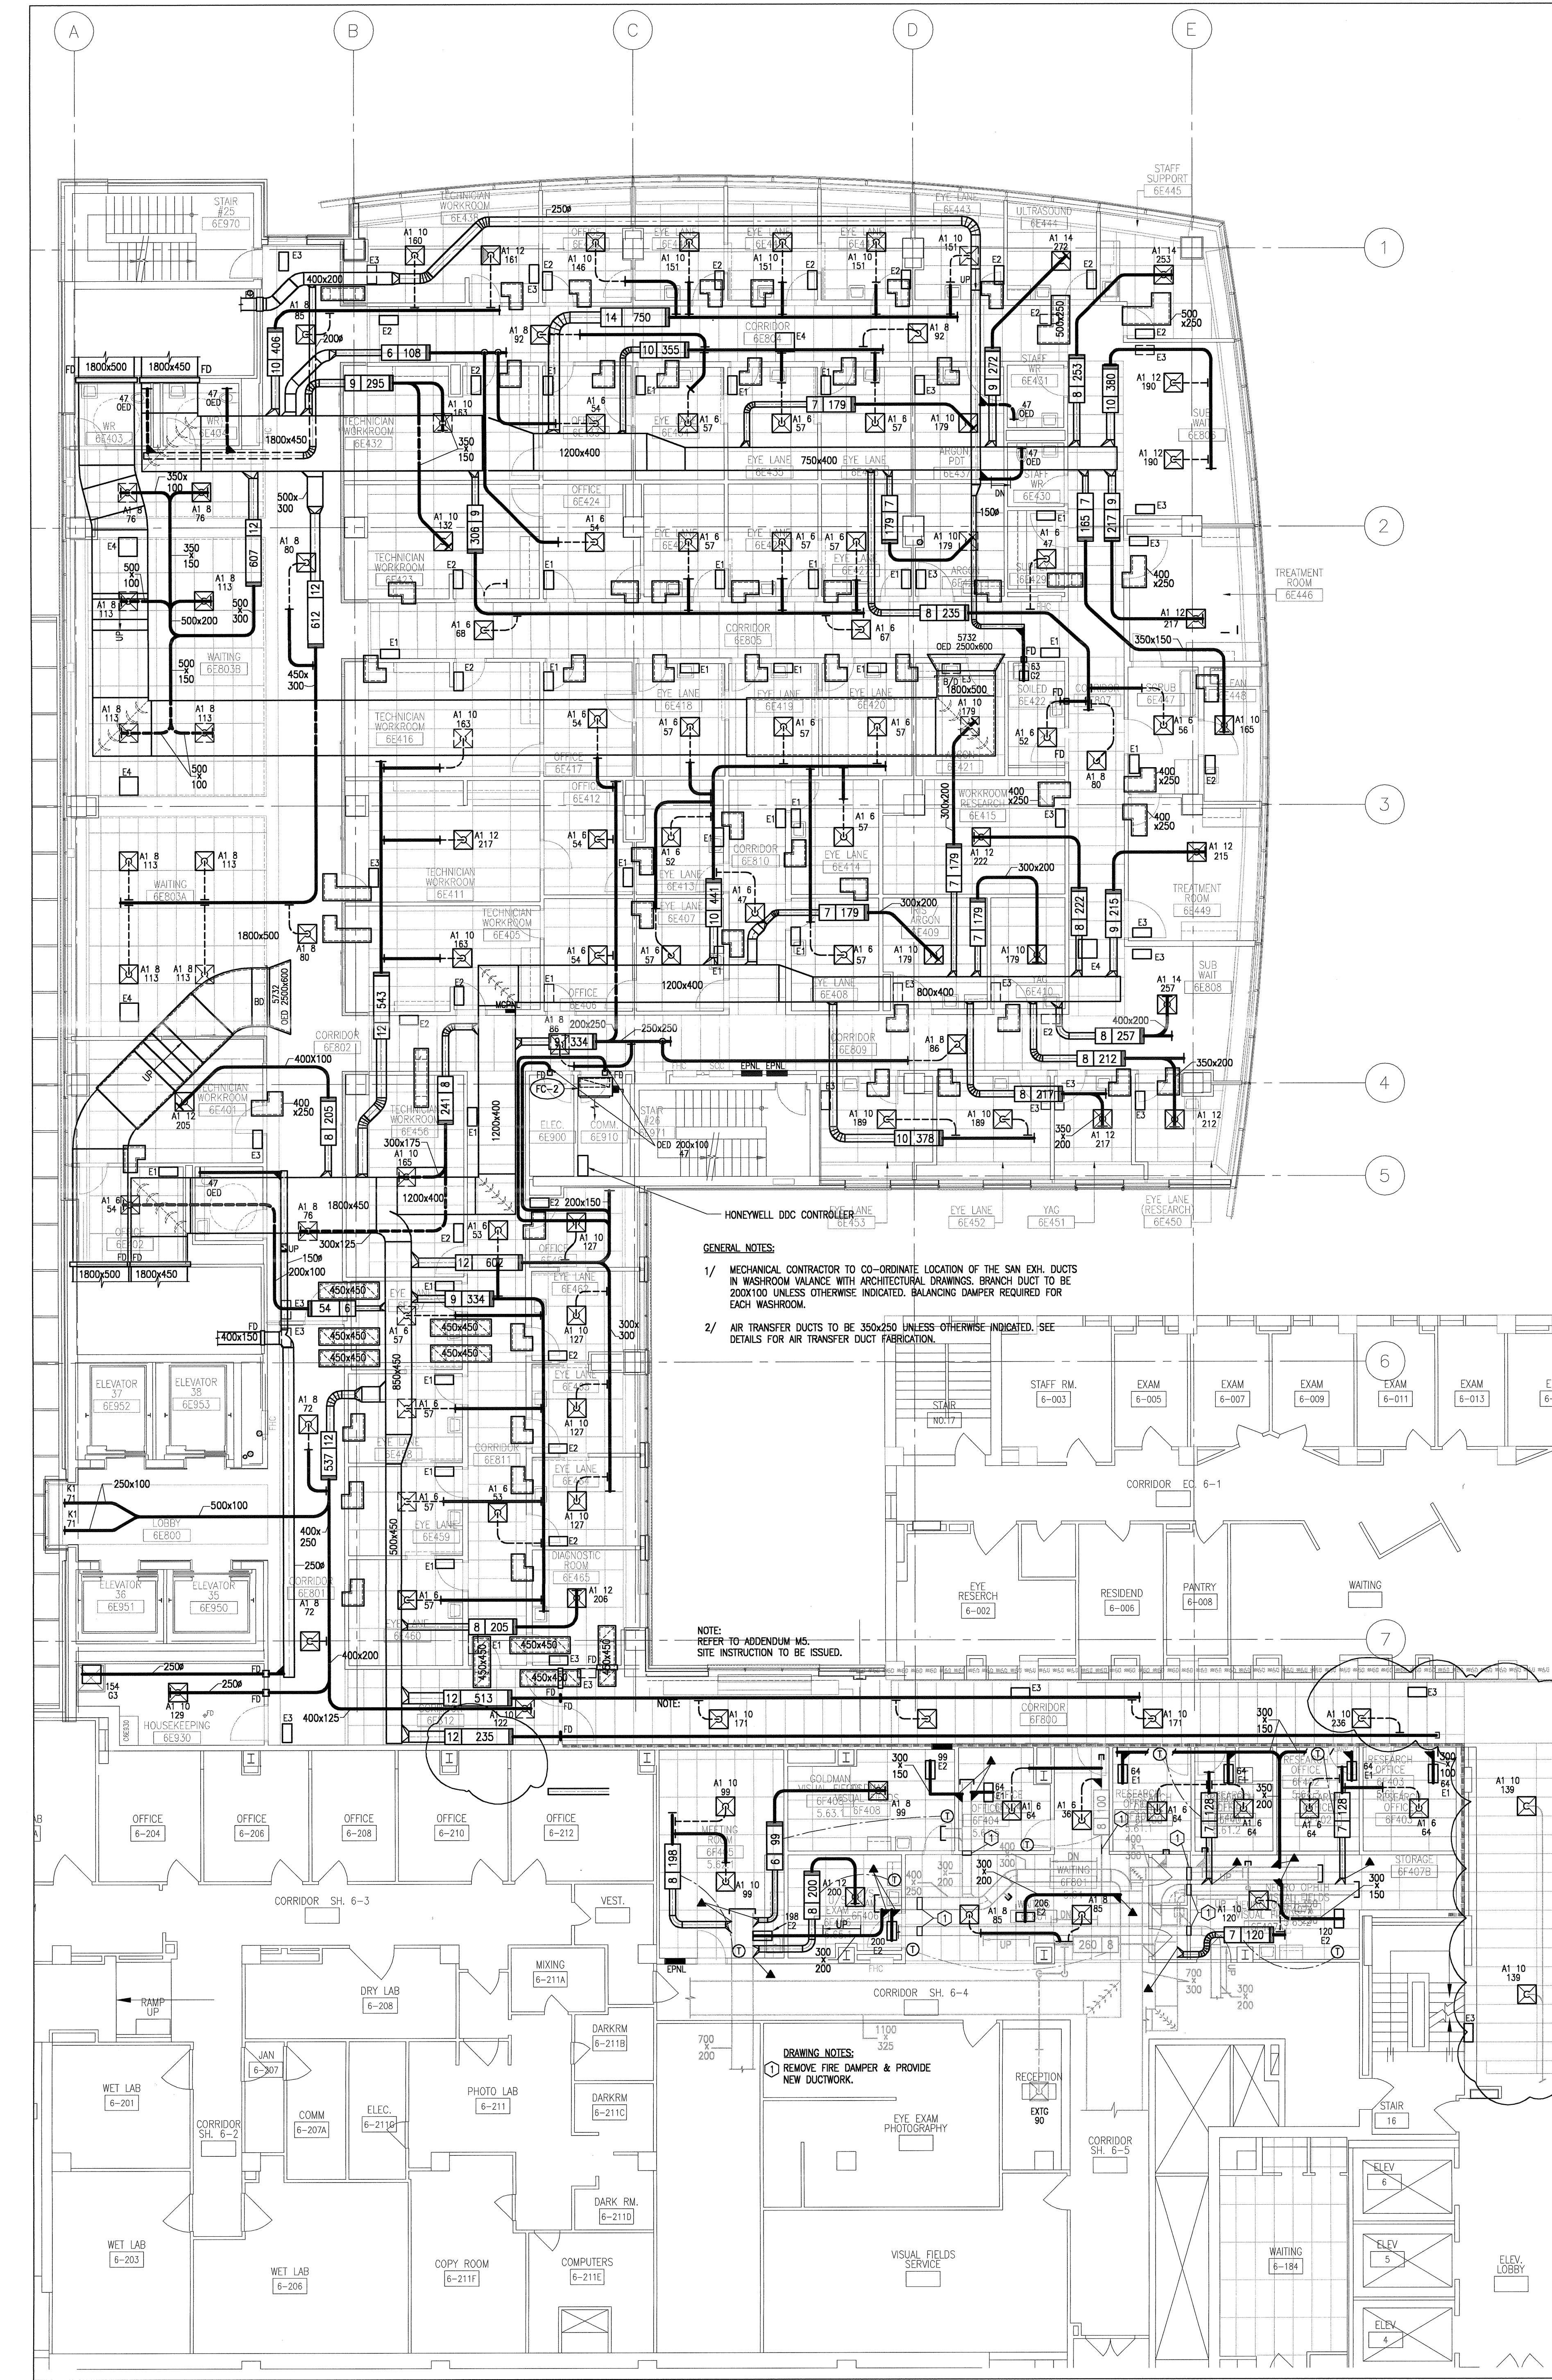


3 LEVEL SIX FLOOR PLAN
504 Scale: 1:100



Toronto Western Hospital

University Health Network

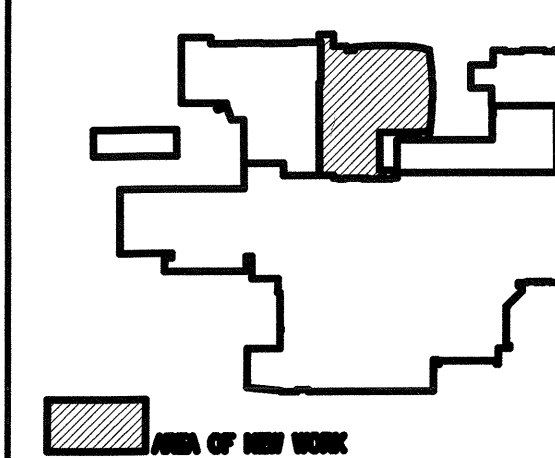


REF PLAN (M2)

9	07/04/20	ISSUED FOR AS-BUILT DRAWINGS
8	03/06/20	ISSUED FOR CONSTRUCTION
7	02/04/11	REVISED FOR ADDENDUM M1
6	03/03/07	ISSUED FOR BUILDING PERMIT
5.1	03/03/07	ISSUED FOR GENERAL TENDER
5	03/03/07	ISSUED FOR GENERAL TENDER
4	03/03/07	ISSUED FOR 90% COSTING
3	02/12/19	APPLICATION FOR BUILDING PERMIT
2	02/11/17	ISSUED FOR 60% REVIEW
1	02/08/16	ISSUED FOR COSTING

REF. DATE DESCRIPTION
(yr/mo/day)

CHECK AND VERIFY ALL DIMENSIONS BEFORE PROCEEDING WITH THE WORK.

DO NOT SCALE DRAWINGS.

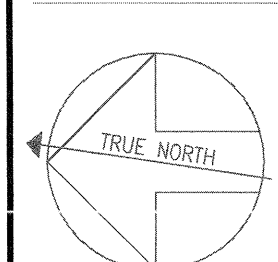

CONSTRUCTION NORTH

AS-BUILT DRAWINGS


PROJECT NAME:
TORONTO WESTERN HOSPITAL
EAST WING REDEVELOPMENT
MAIN BUILDING - STAGE TWO
TORONTO ONTARIO

DRAWING TITLE:
LEVEL 8 FLOOR PLAN
LEVEL 9 FLOOR PLAN
VENTILATION

SCALE:
1 : 100
DATE:
MARCH 2003
DRAWN BY:
CHECKED BY:

PROJECT NUMBER:
2011210


DRAWING NUMBER:
M2-505

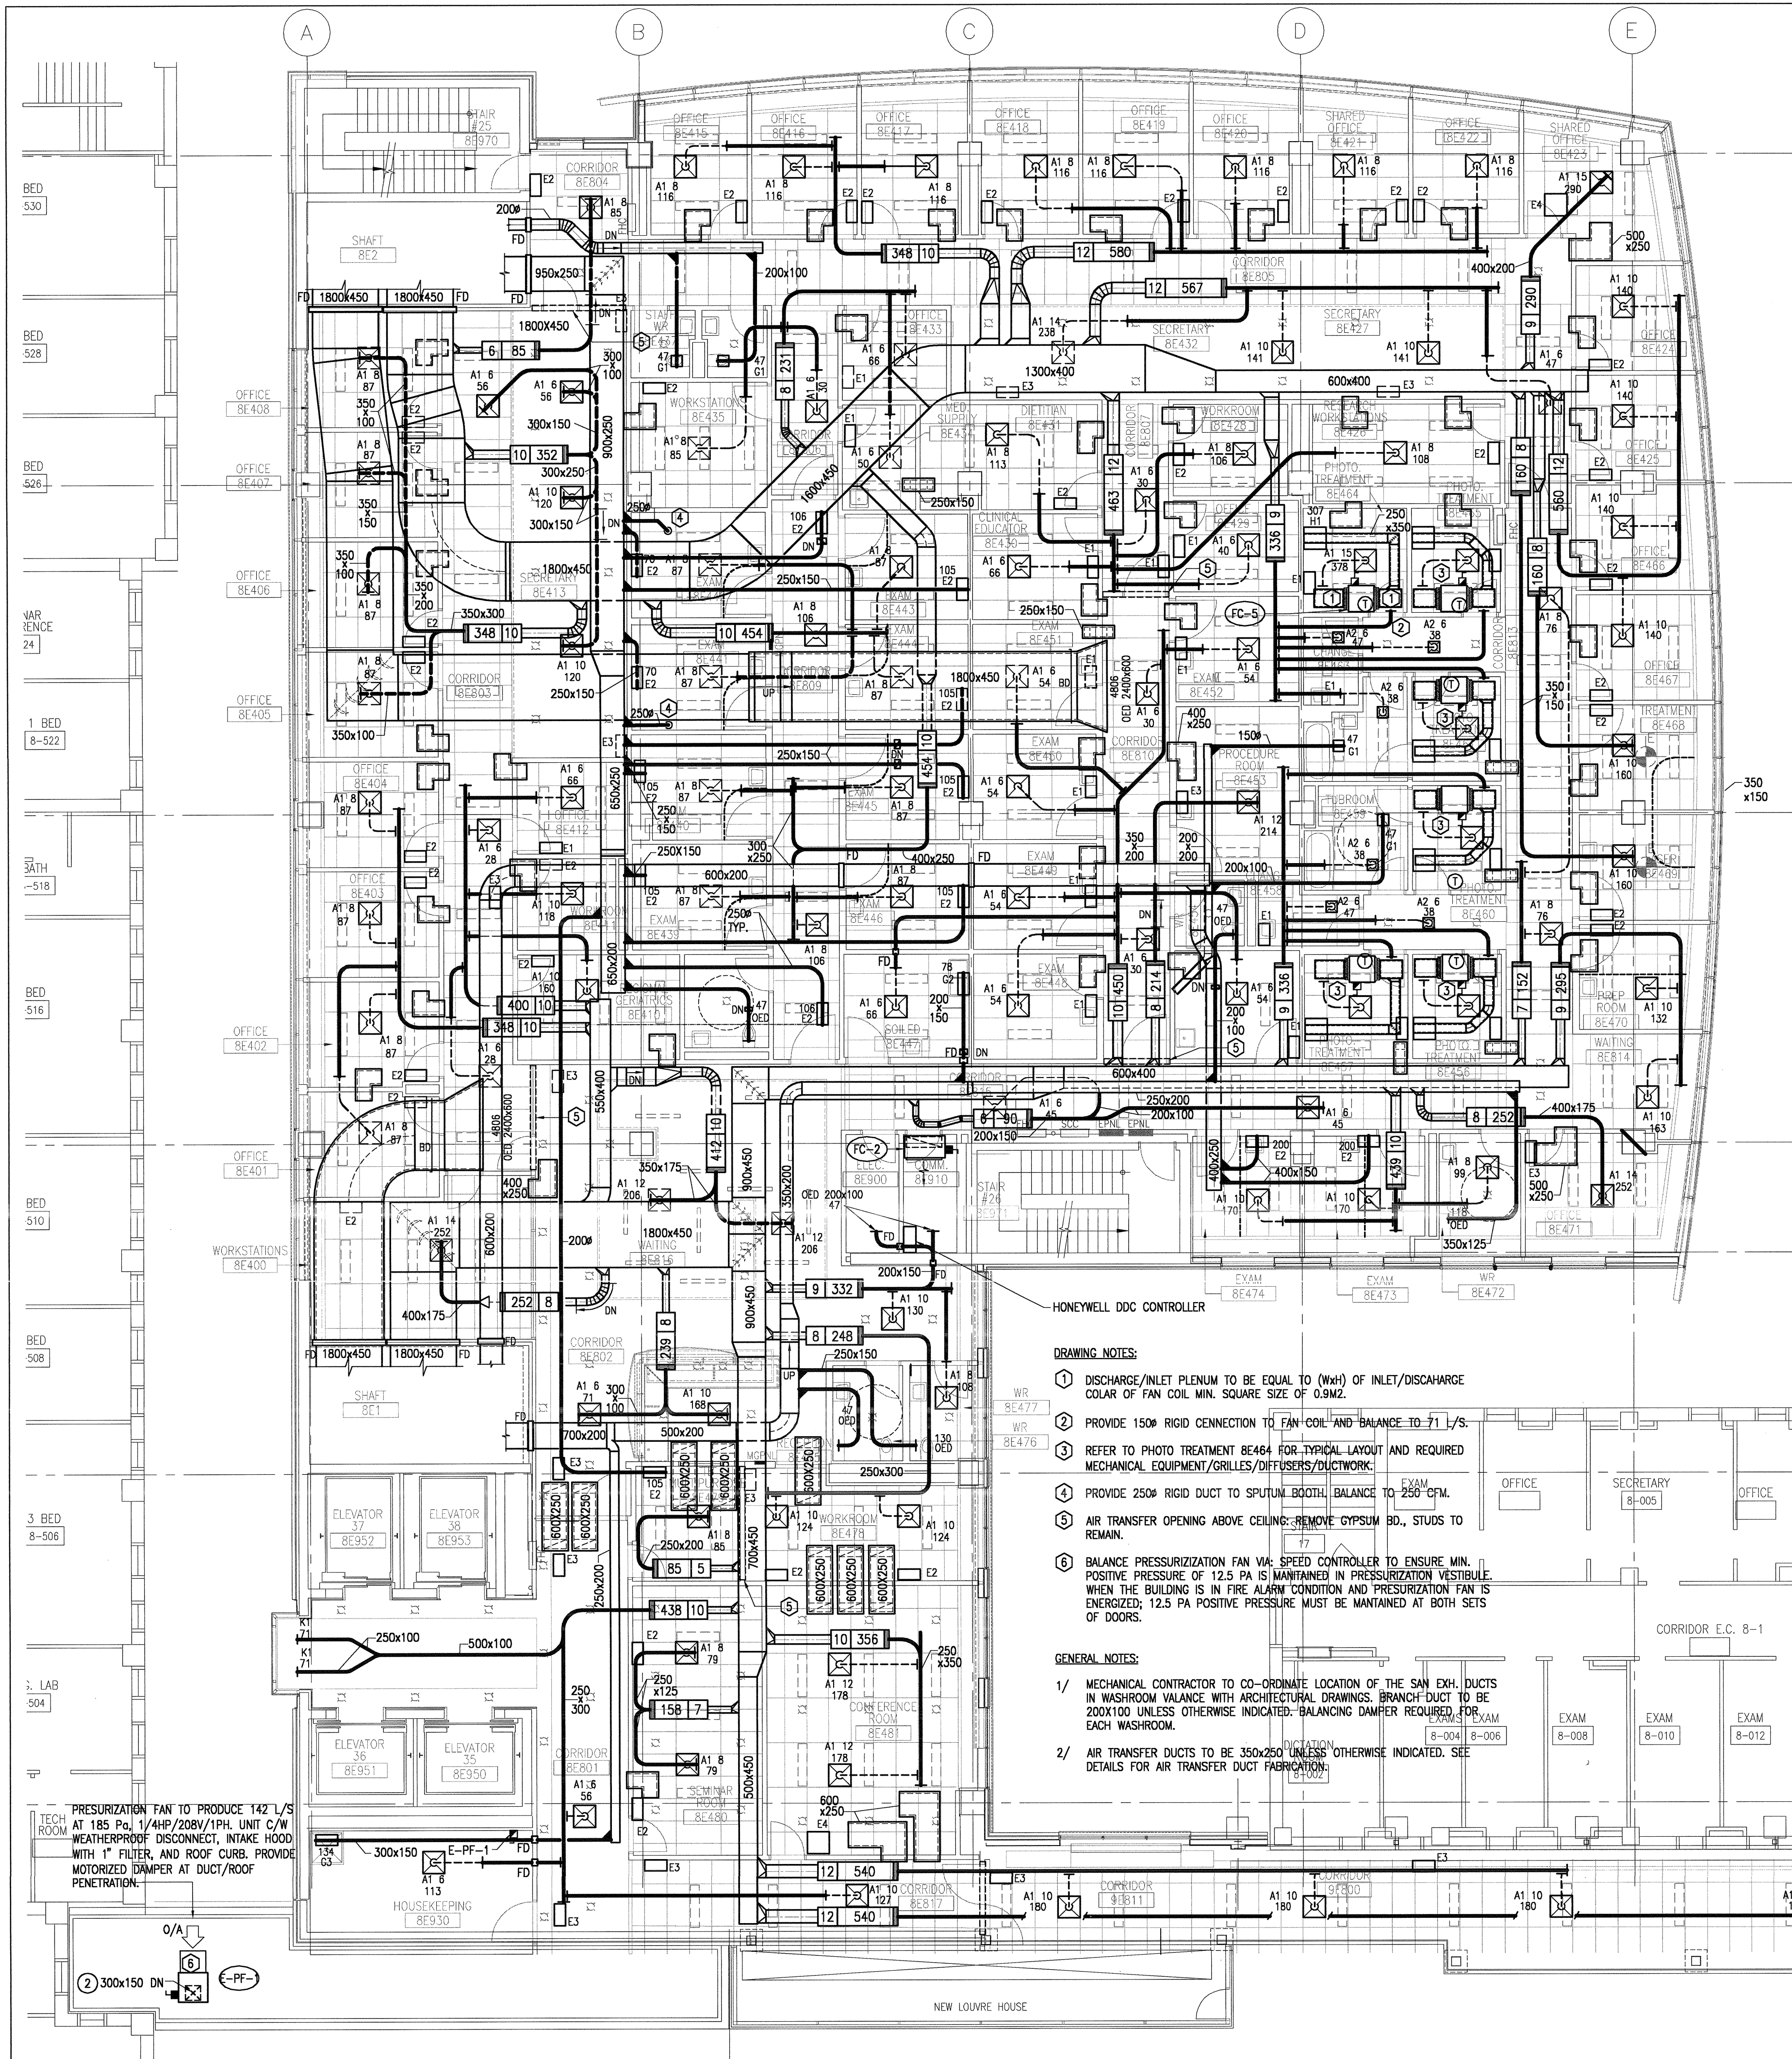

4 LEVEL EIGHT FLOOR PLAN

505


Scale: 1:100

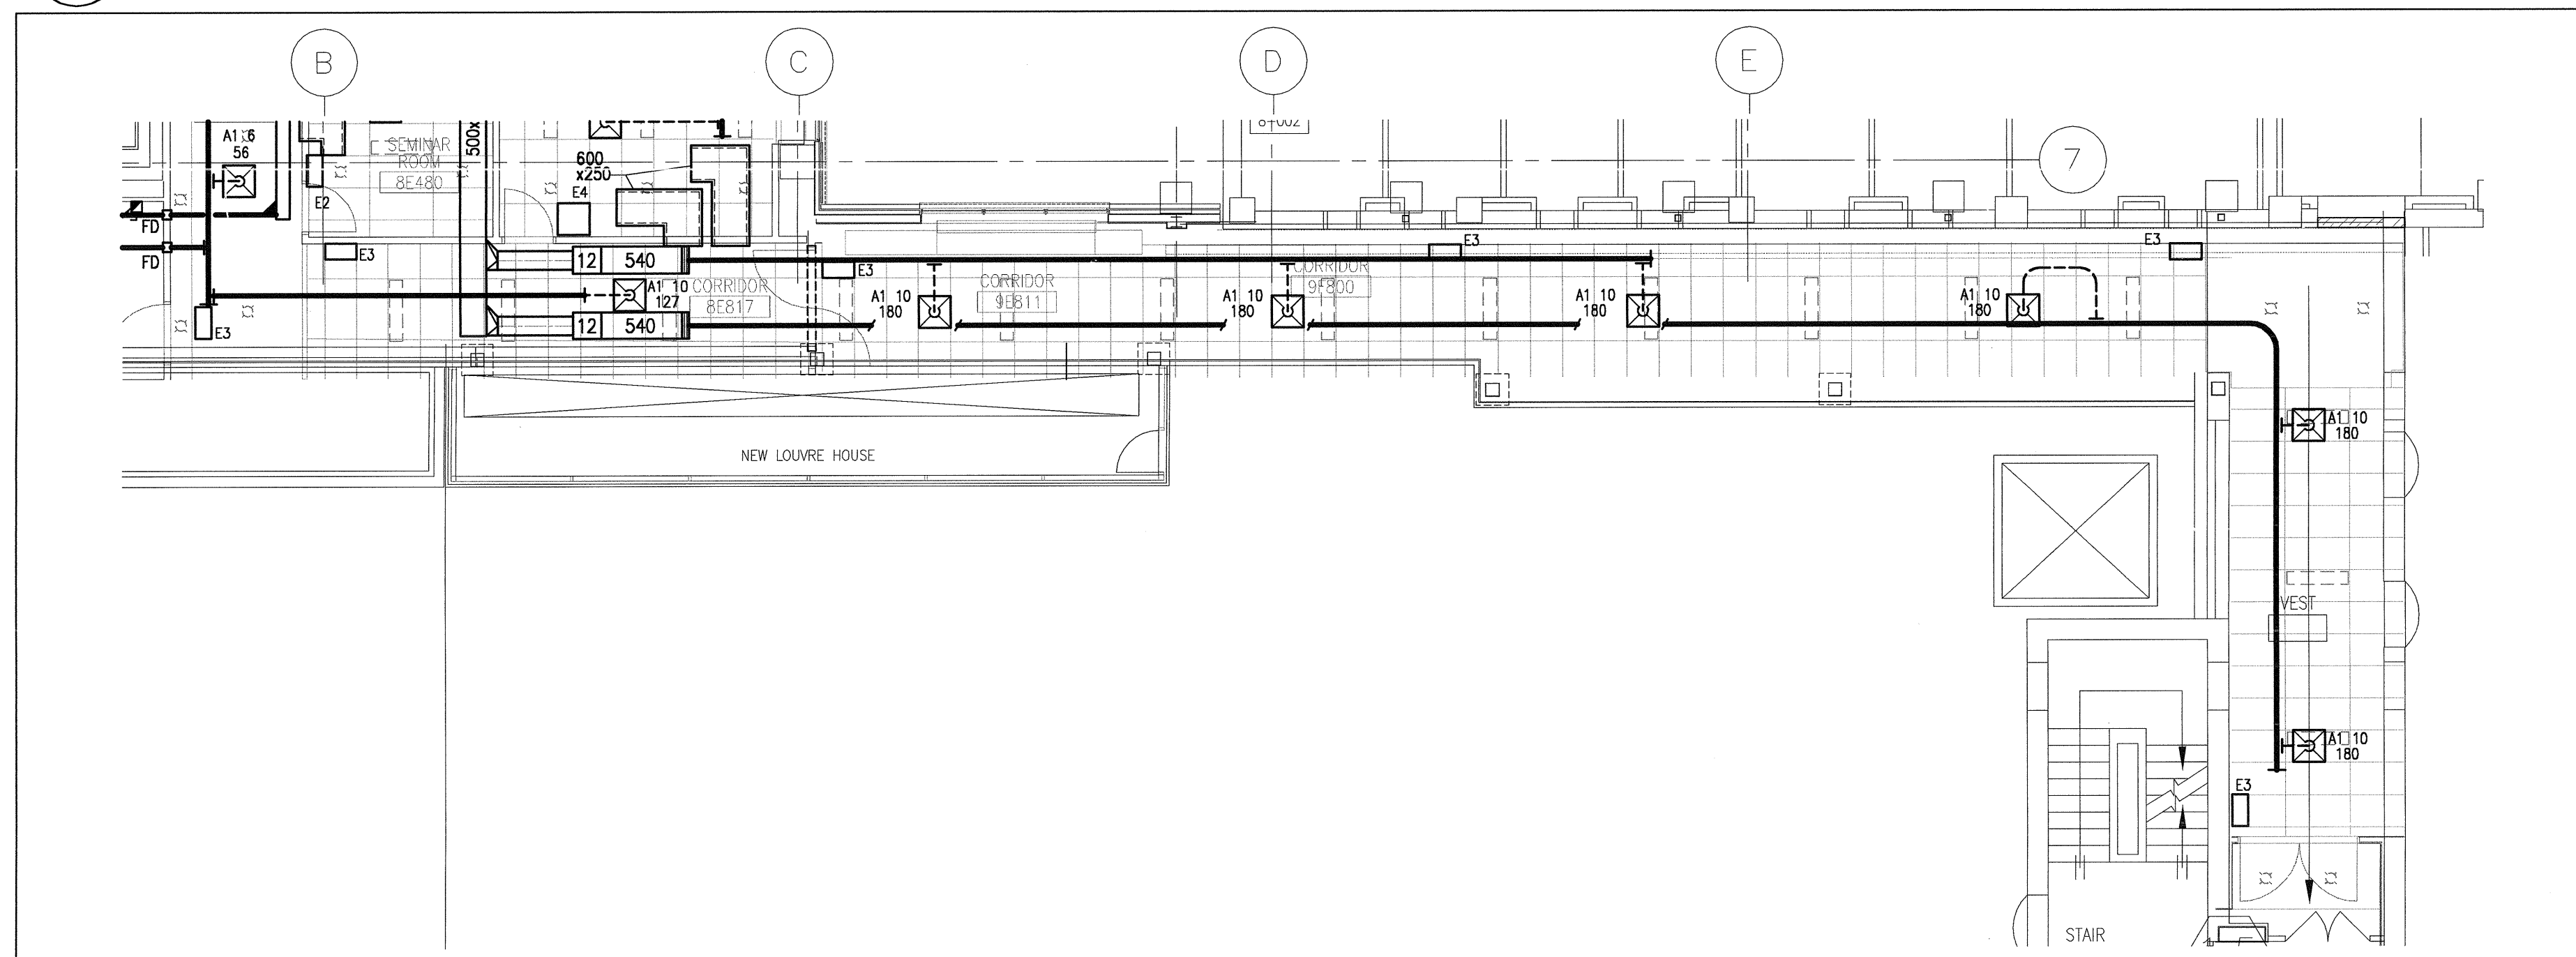

3 PARTIAL LEVEL EIGHT FLOOR PLAN

505


Scale: 1:100

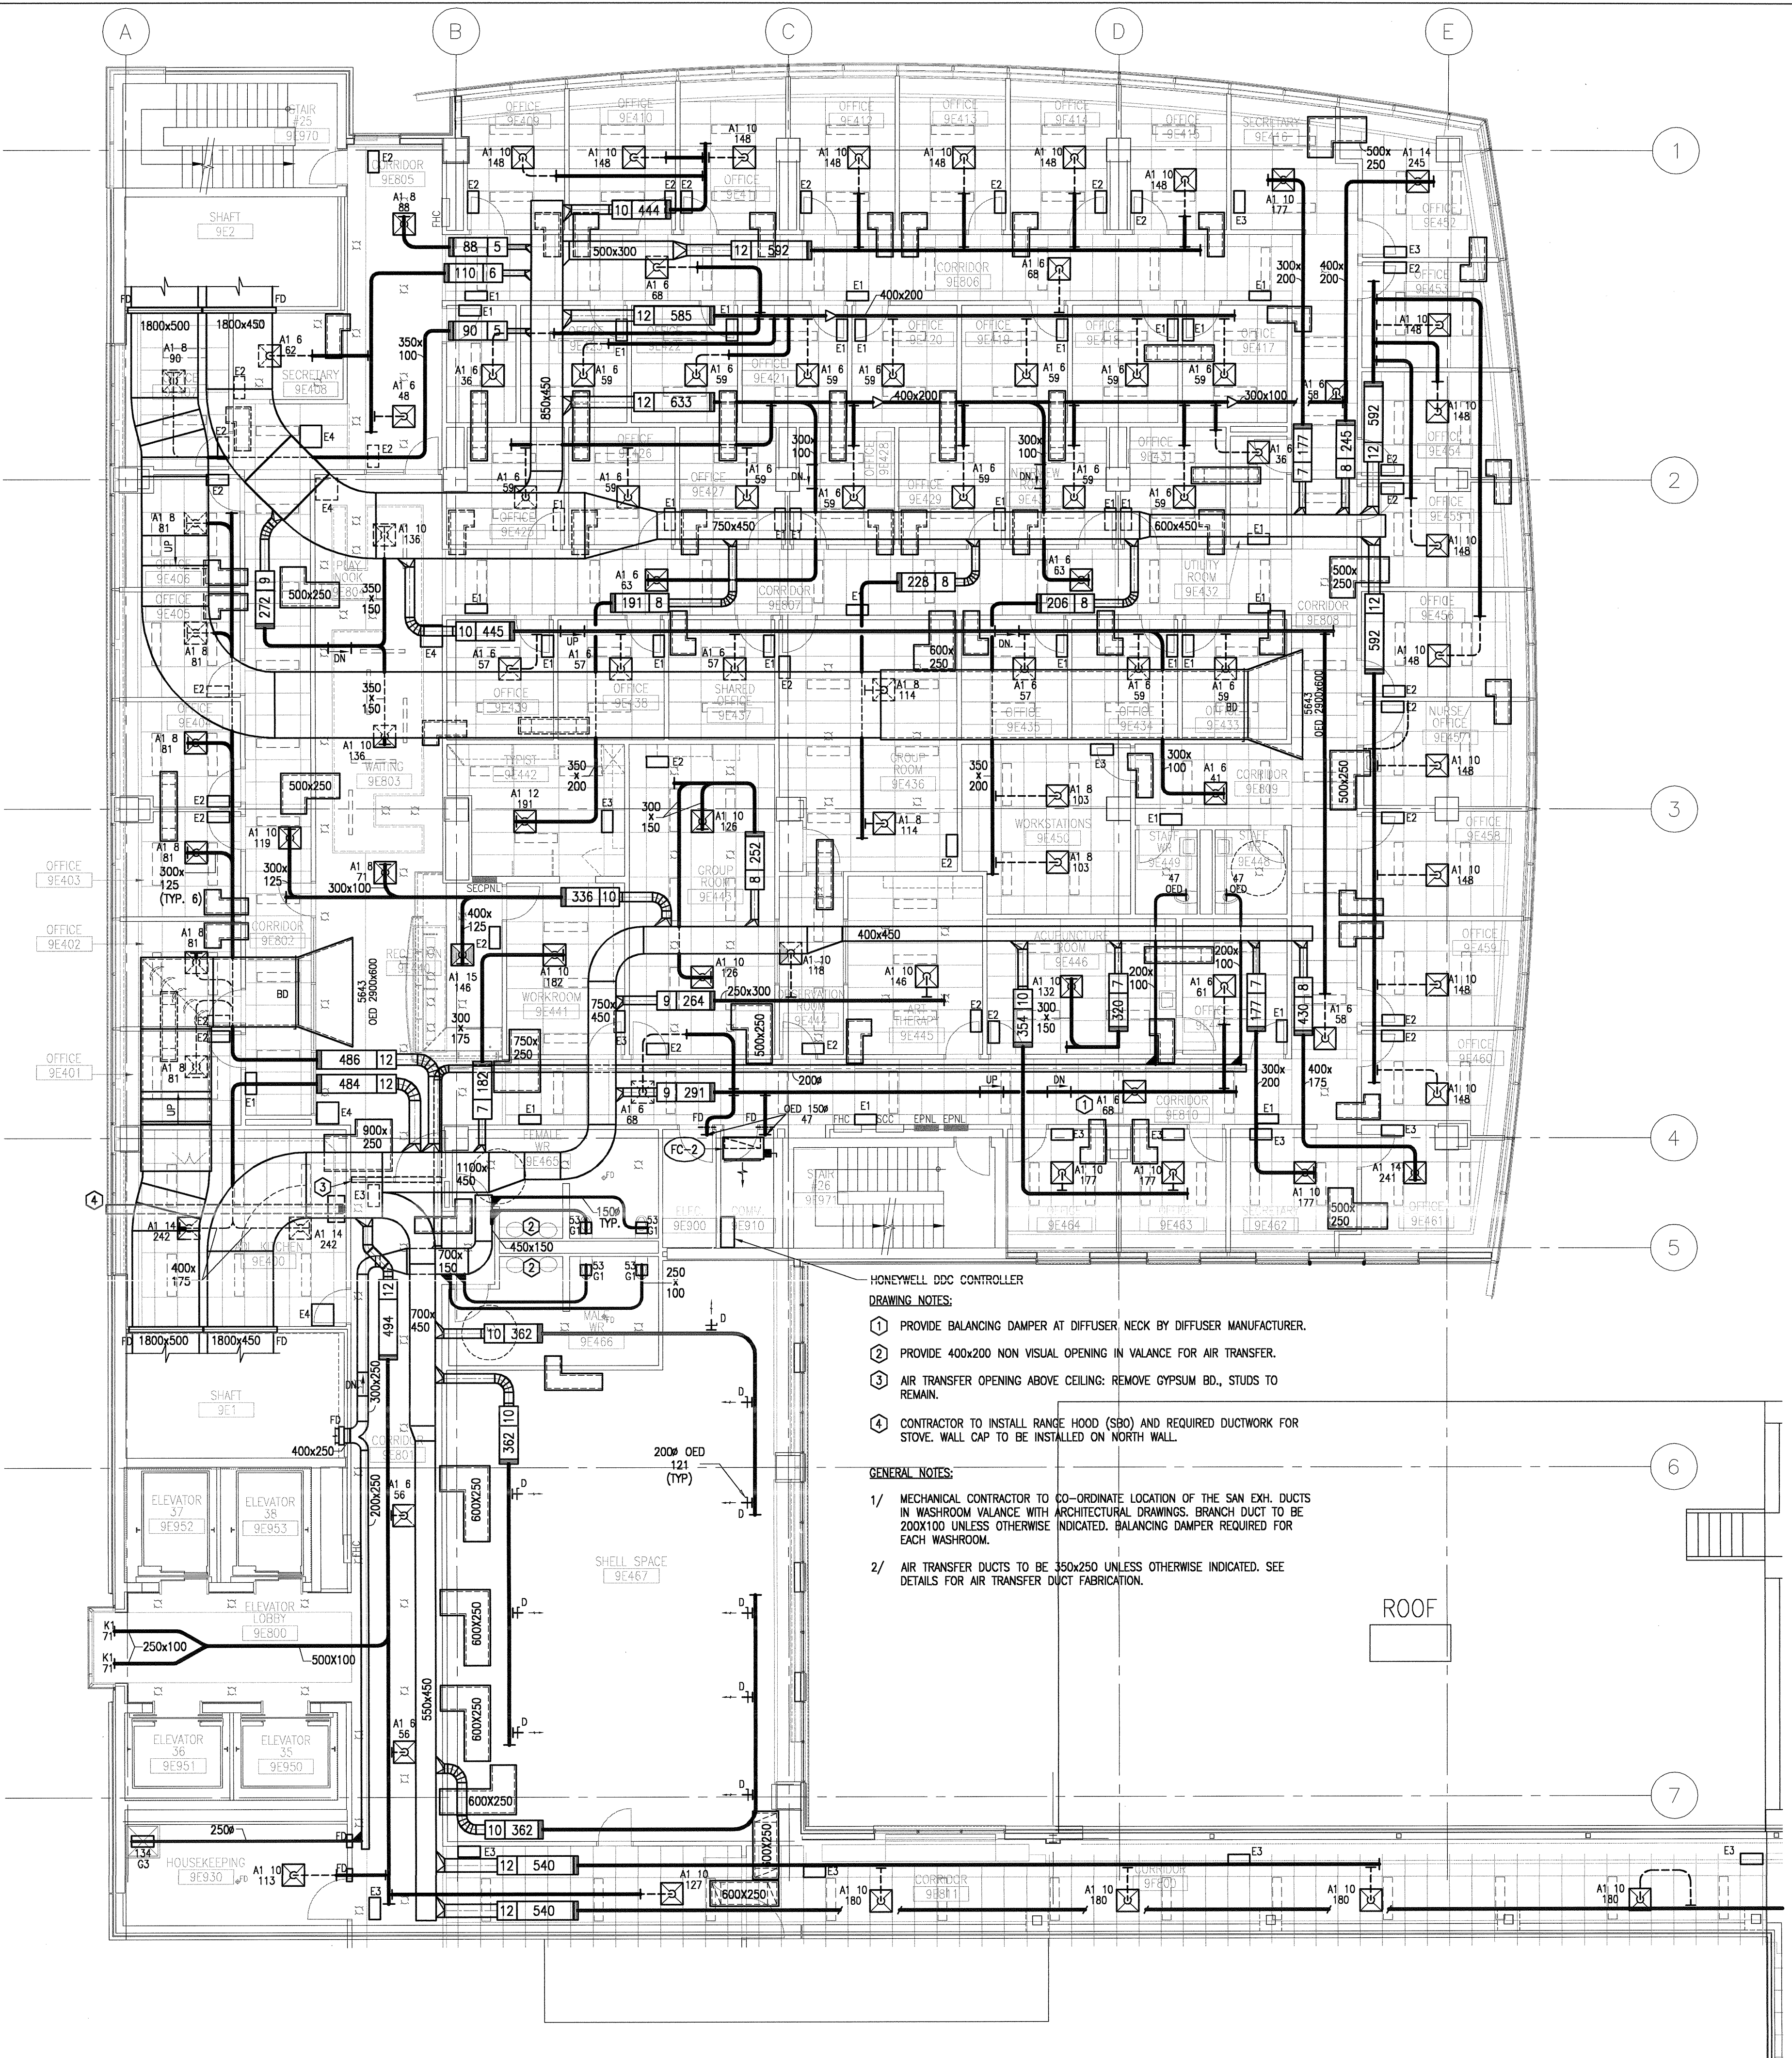

2 LEVEL NINE FLOOR PLAN

505

Scale: 1:100

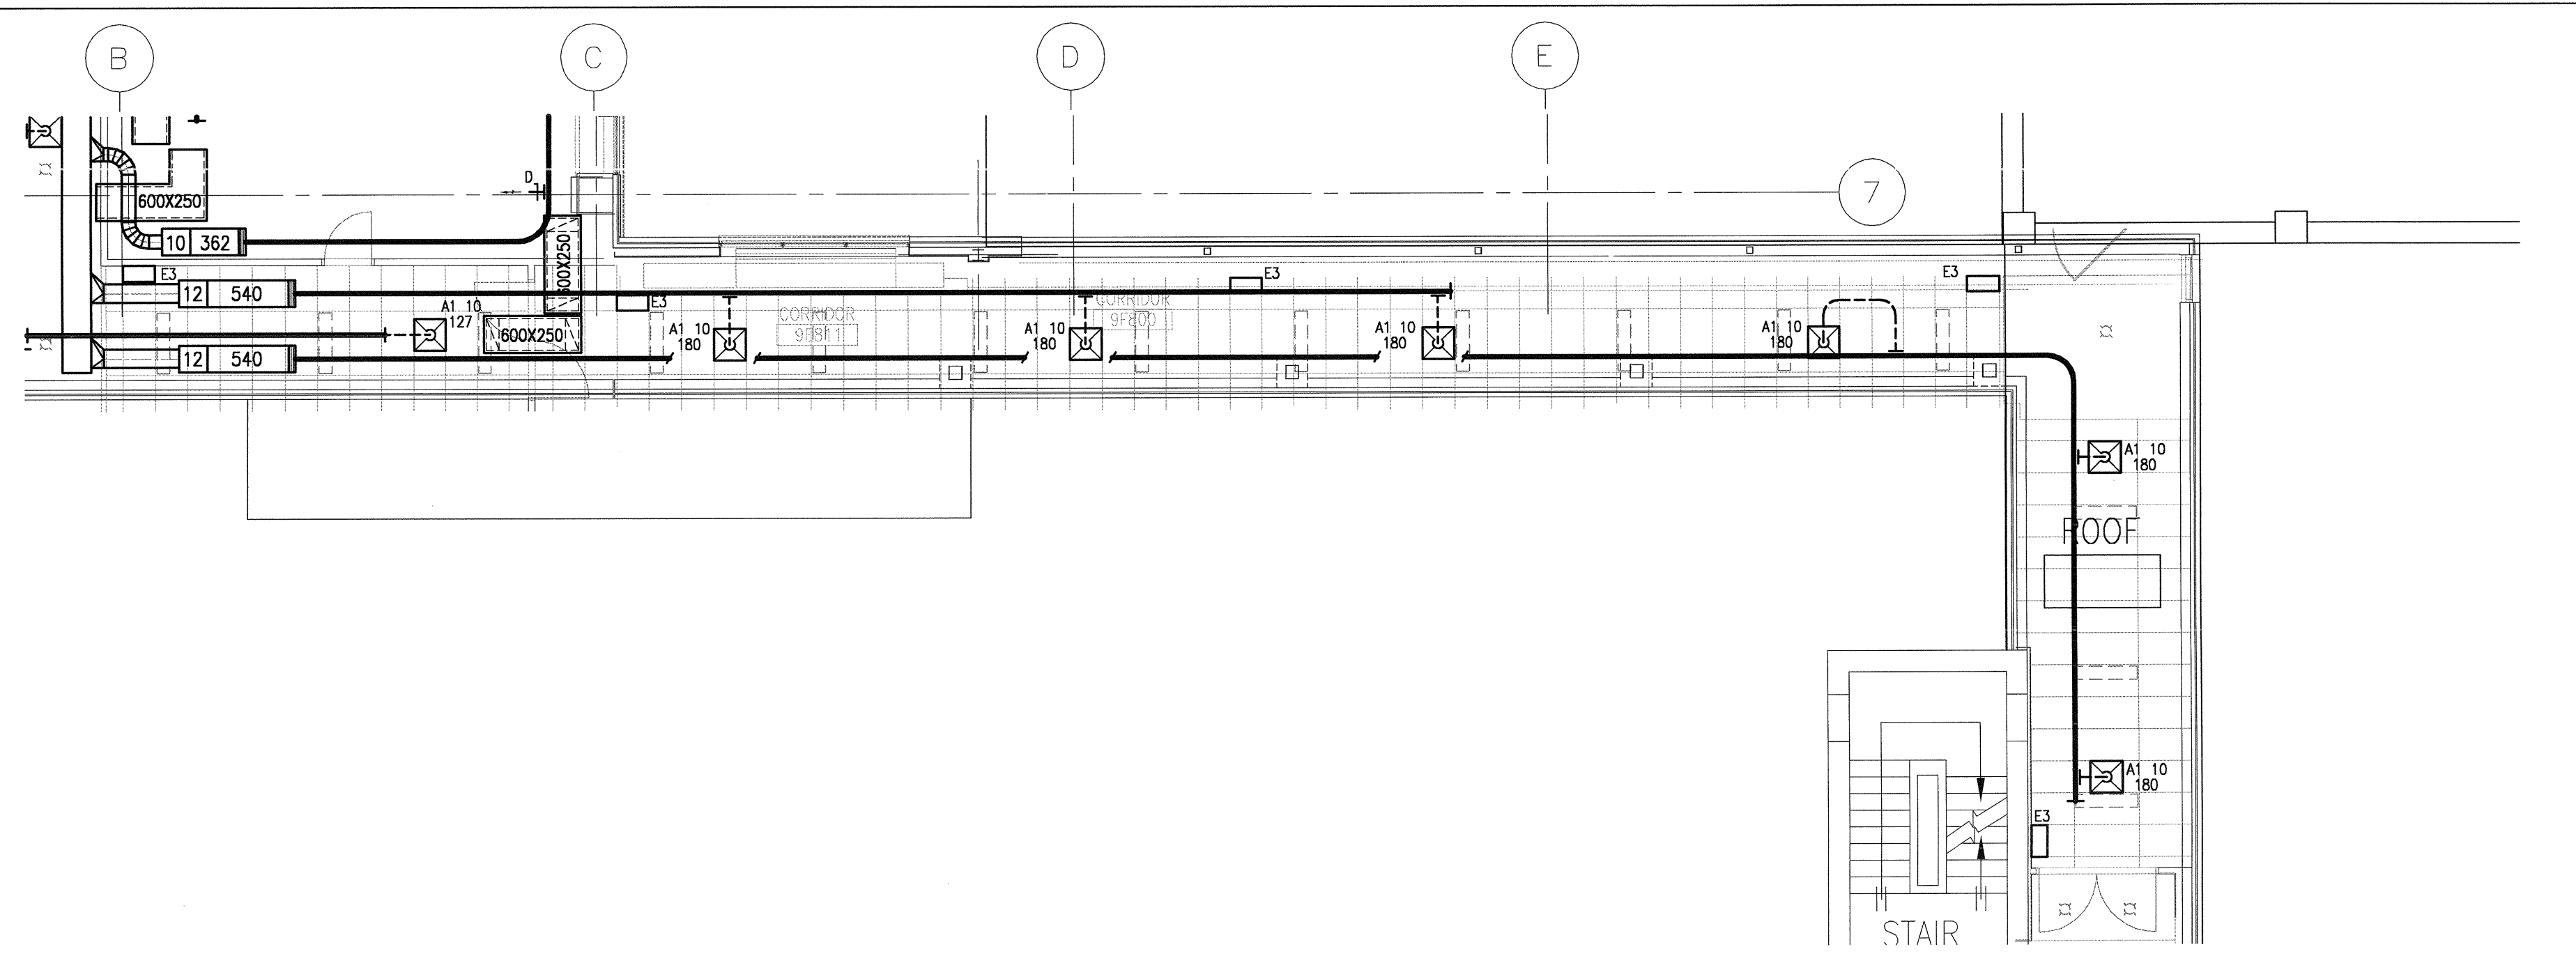

1 PARTIAL LEVEL NINE FLOOR PLAN


505

Scale: 1:100



Toronto Western Hospital

University Health Network

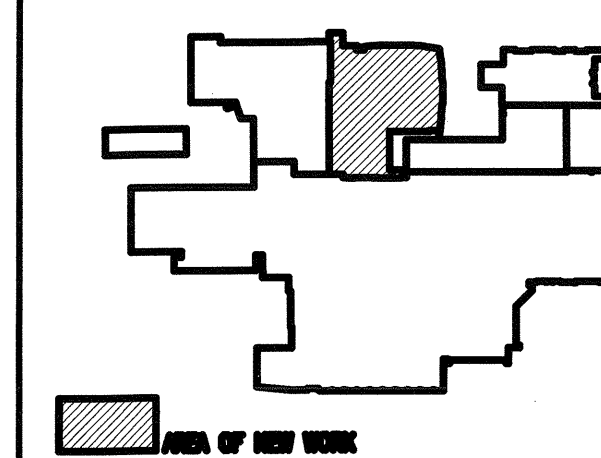


KEY PLAN (M2-506)

- 11 07/04/00 ISSUED FOR AS-BUILT DRAWINGS
- 10 03/06/00 ISSUED FOR CONSTRUCTION
- 9 03/29/04 REVISED FOR ADDENDUM M-4
- 8 03/04/04 REVISED FOR ADDENDUM M-3
- 7 03/04/11 REVISED FOR ADDENDUM M-1
- 6 03/03/07 ISSUED FOR BUILDING PERMIT
- 5.1 03/03/07 ISSUED FOR GENERAL TENDER
- 5 03/03/16 ISSUED FOR GENERAL TENDER
- 4 03/01/29 ISSUED FOR BOM COSTING
- 3 02/12/19 APPLICATION FOR BUILDING PERMIT
- 2 02/11/17 ISSUED FOR BOM REVIEW
- 1 02/08/16 ISSUED FOR COSTING

REF. DATE DESCRIPTION
(07/04/00)

CHECK AND VERIFY ALL DIMENSIONS BEFORE PROCEEDING WITH THE WORK. DO NOT SCALE DRAWINGS.

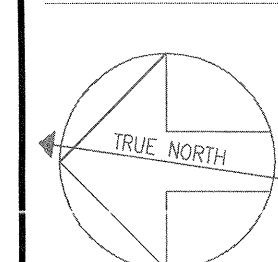


CONSTRUCTION NORTH

AS-BUILT DRAWINGS


PROJECT NAME:
TORONTO WESTERN HOSPITAL
EAST WING REDEVELOPMENT
MAIN BUILDING - STAGE TWO
TORONTO ONTARIO

DRAWING TITLE:
PENTHOUSE FLOOR PLAN
ELEVATOR MACHINE ROOM PLAN
VENTILATION


SCALE:
1 : 100
DATE:
MARCH 2003
DRAWN BY:
CHECKED BY:
PROJECT NUMBER:
2011210
DRAWING NUMBER:
M2-506

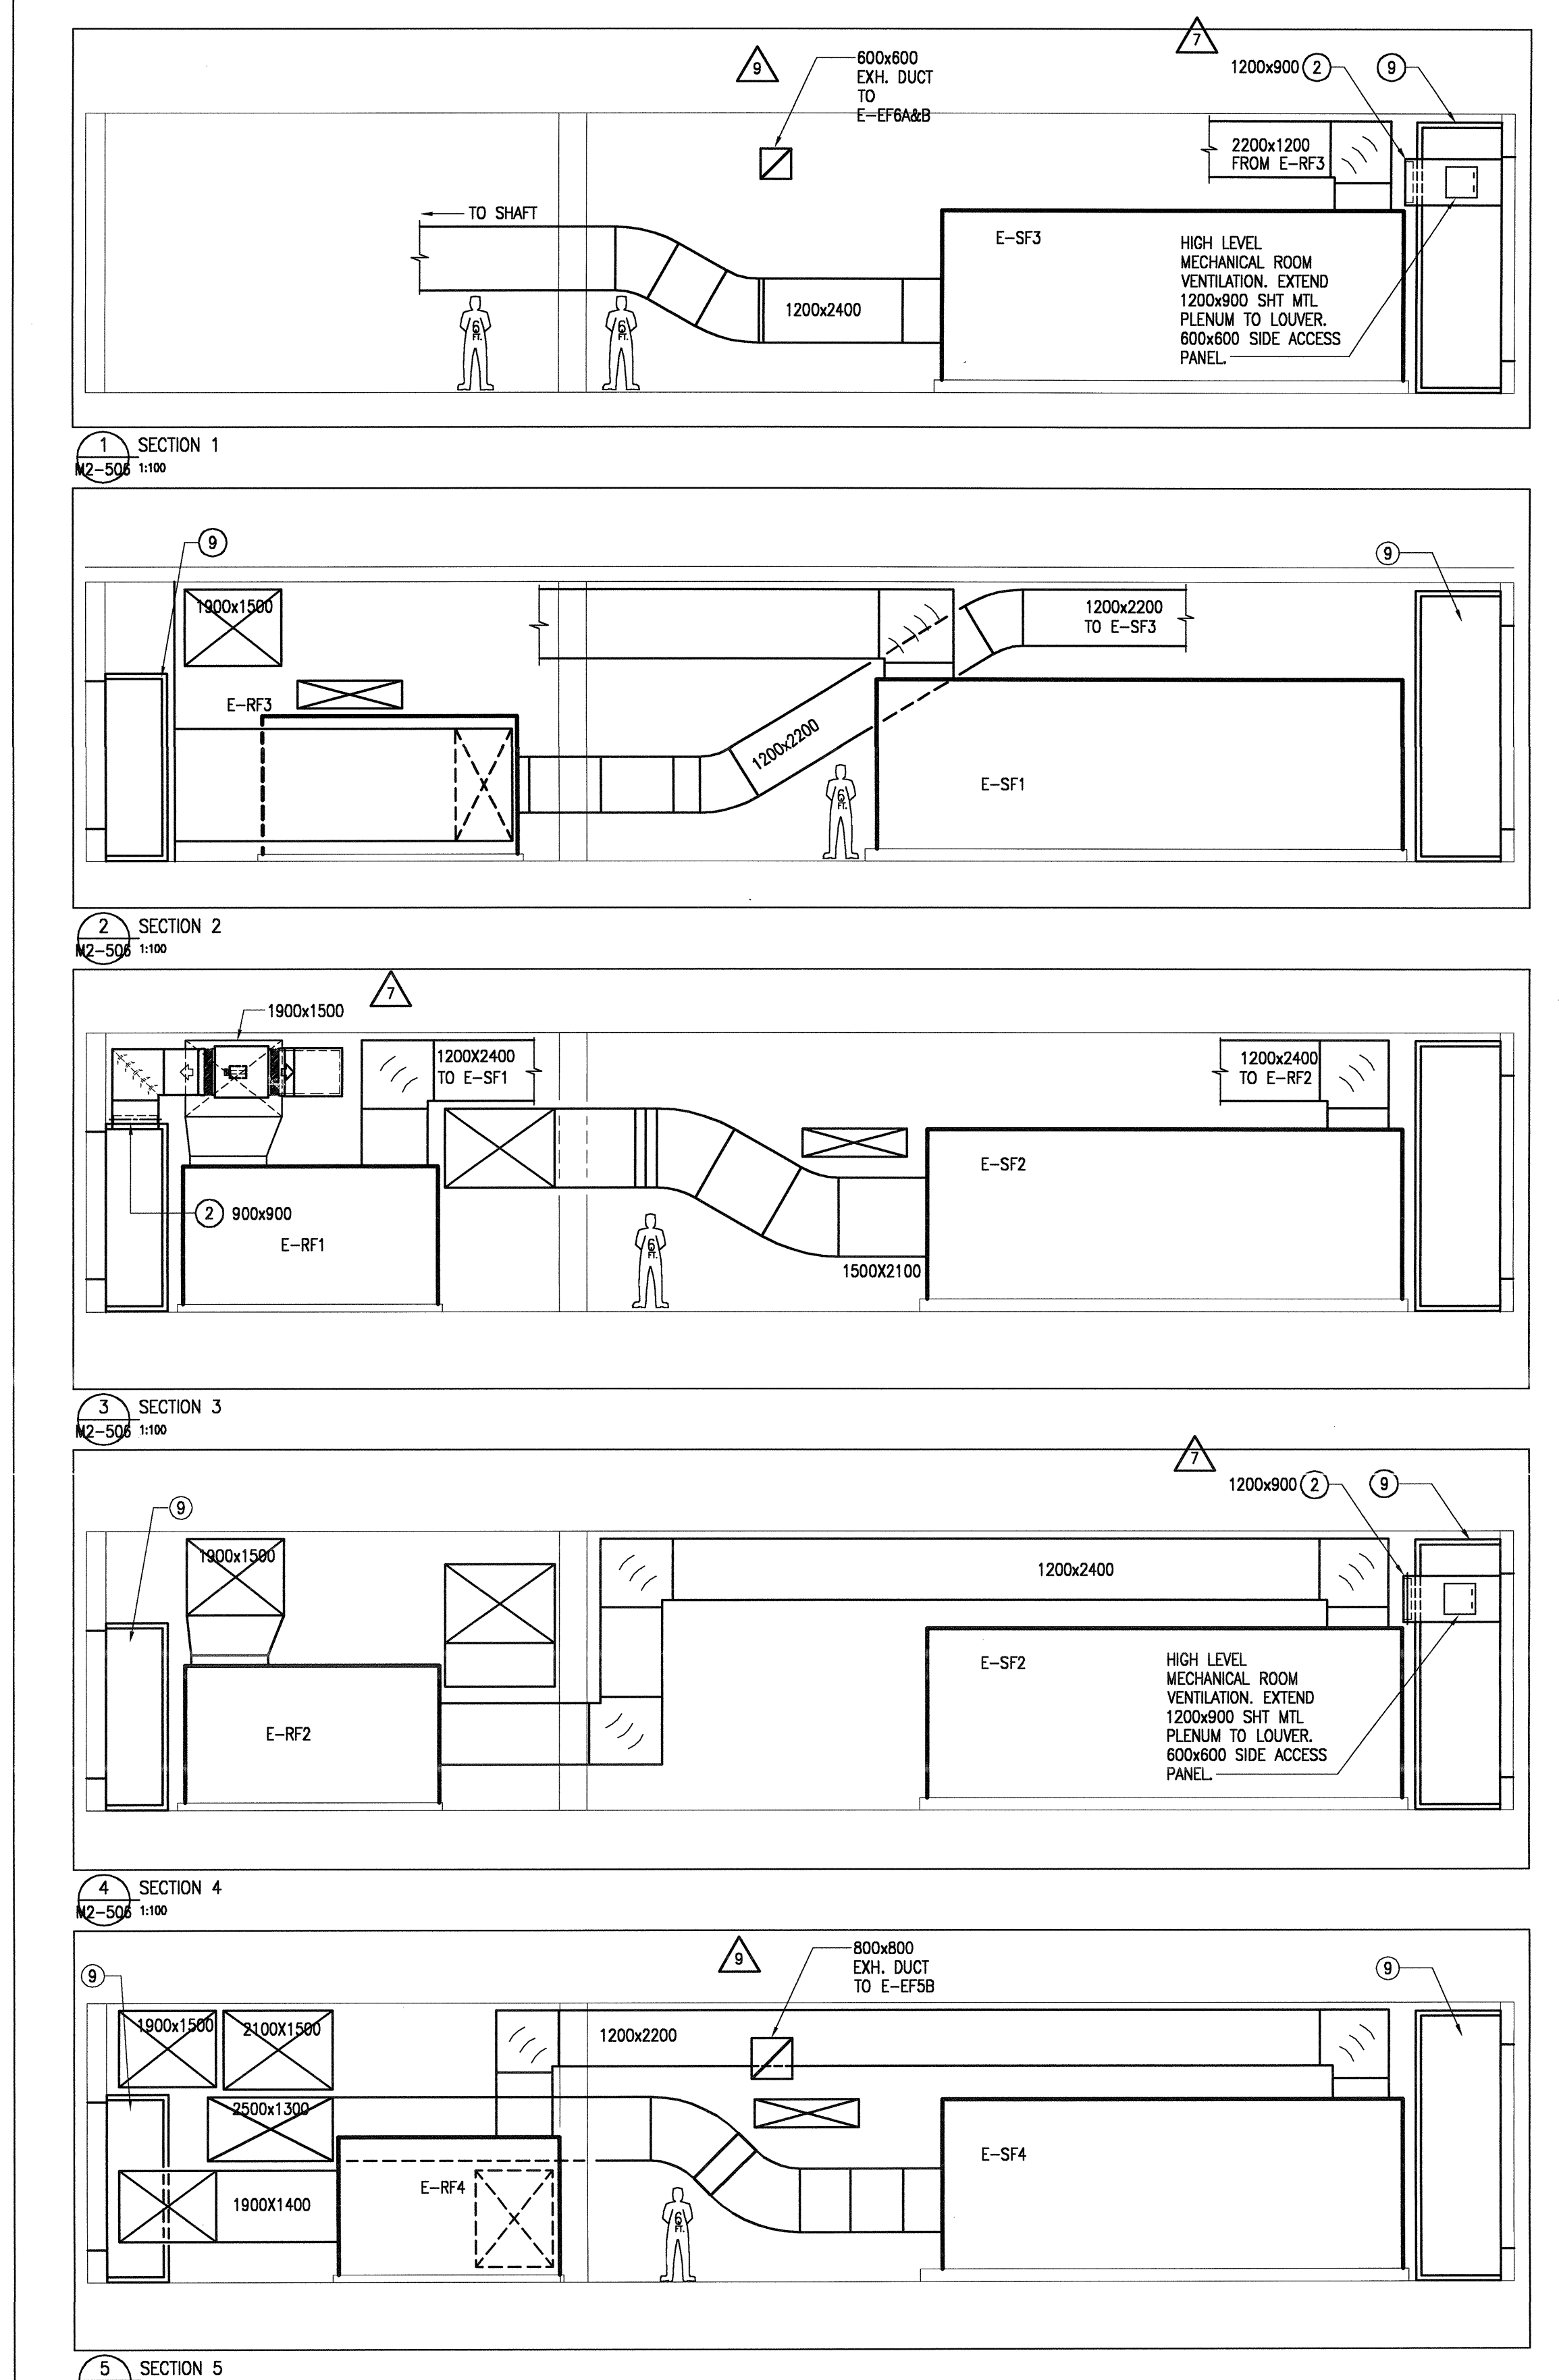


1 SECTIONS
506 Scale: 1:100

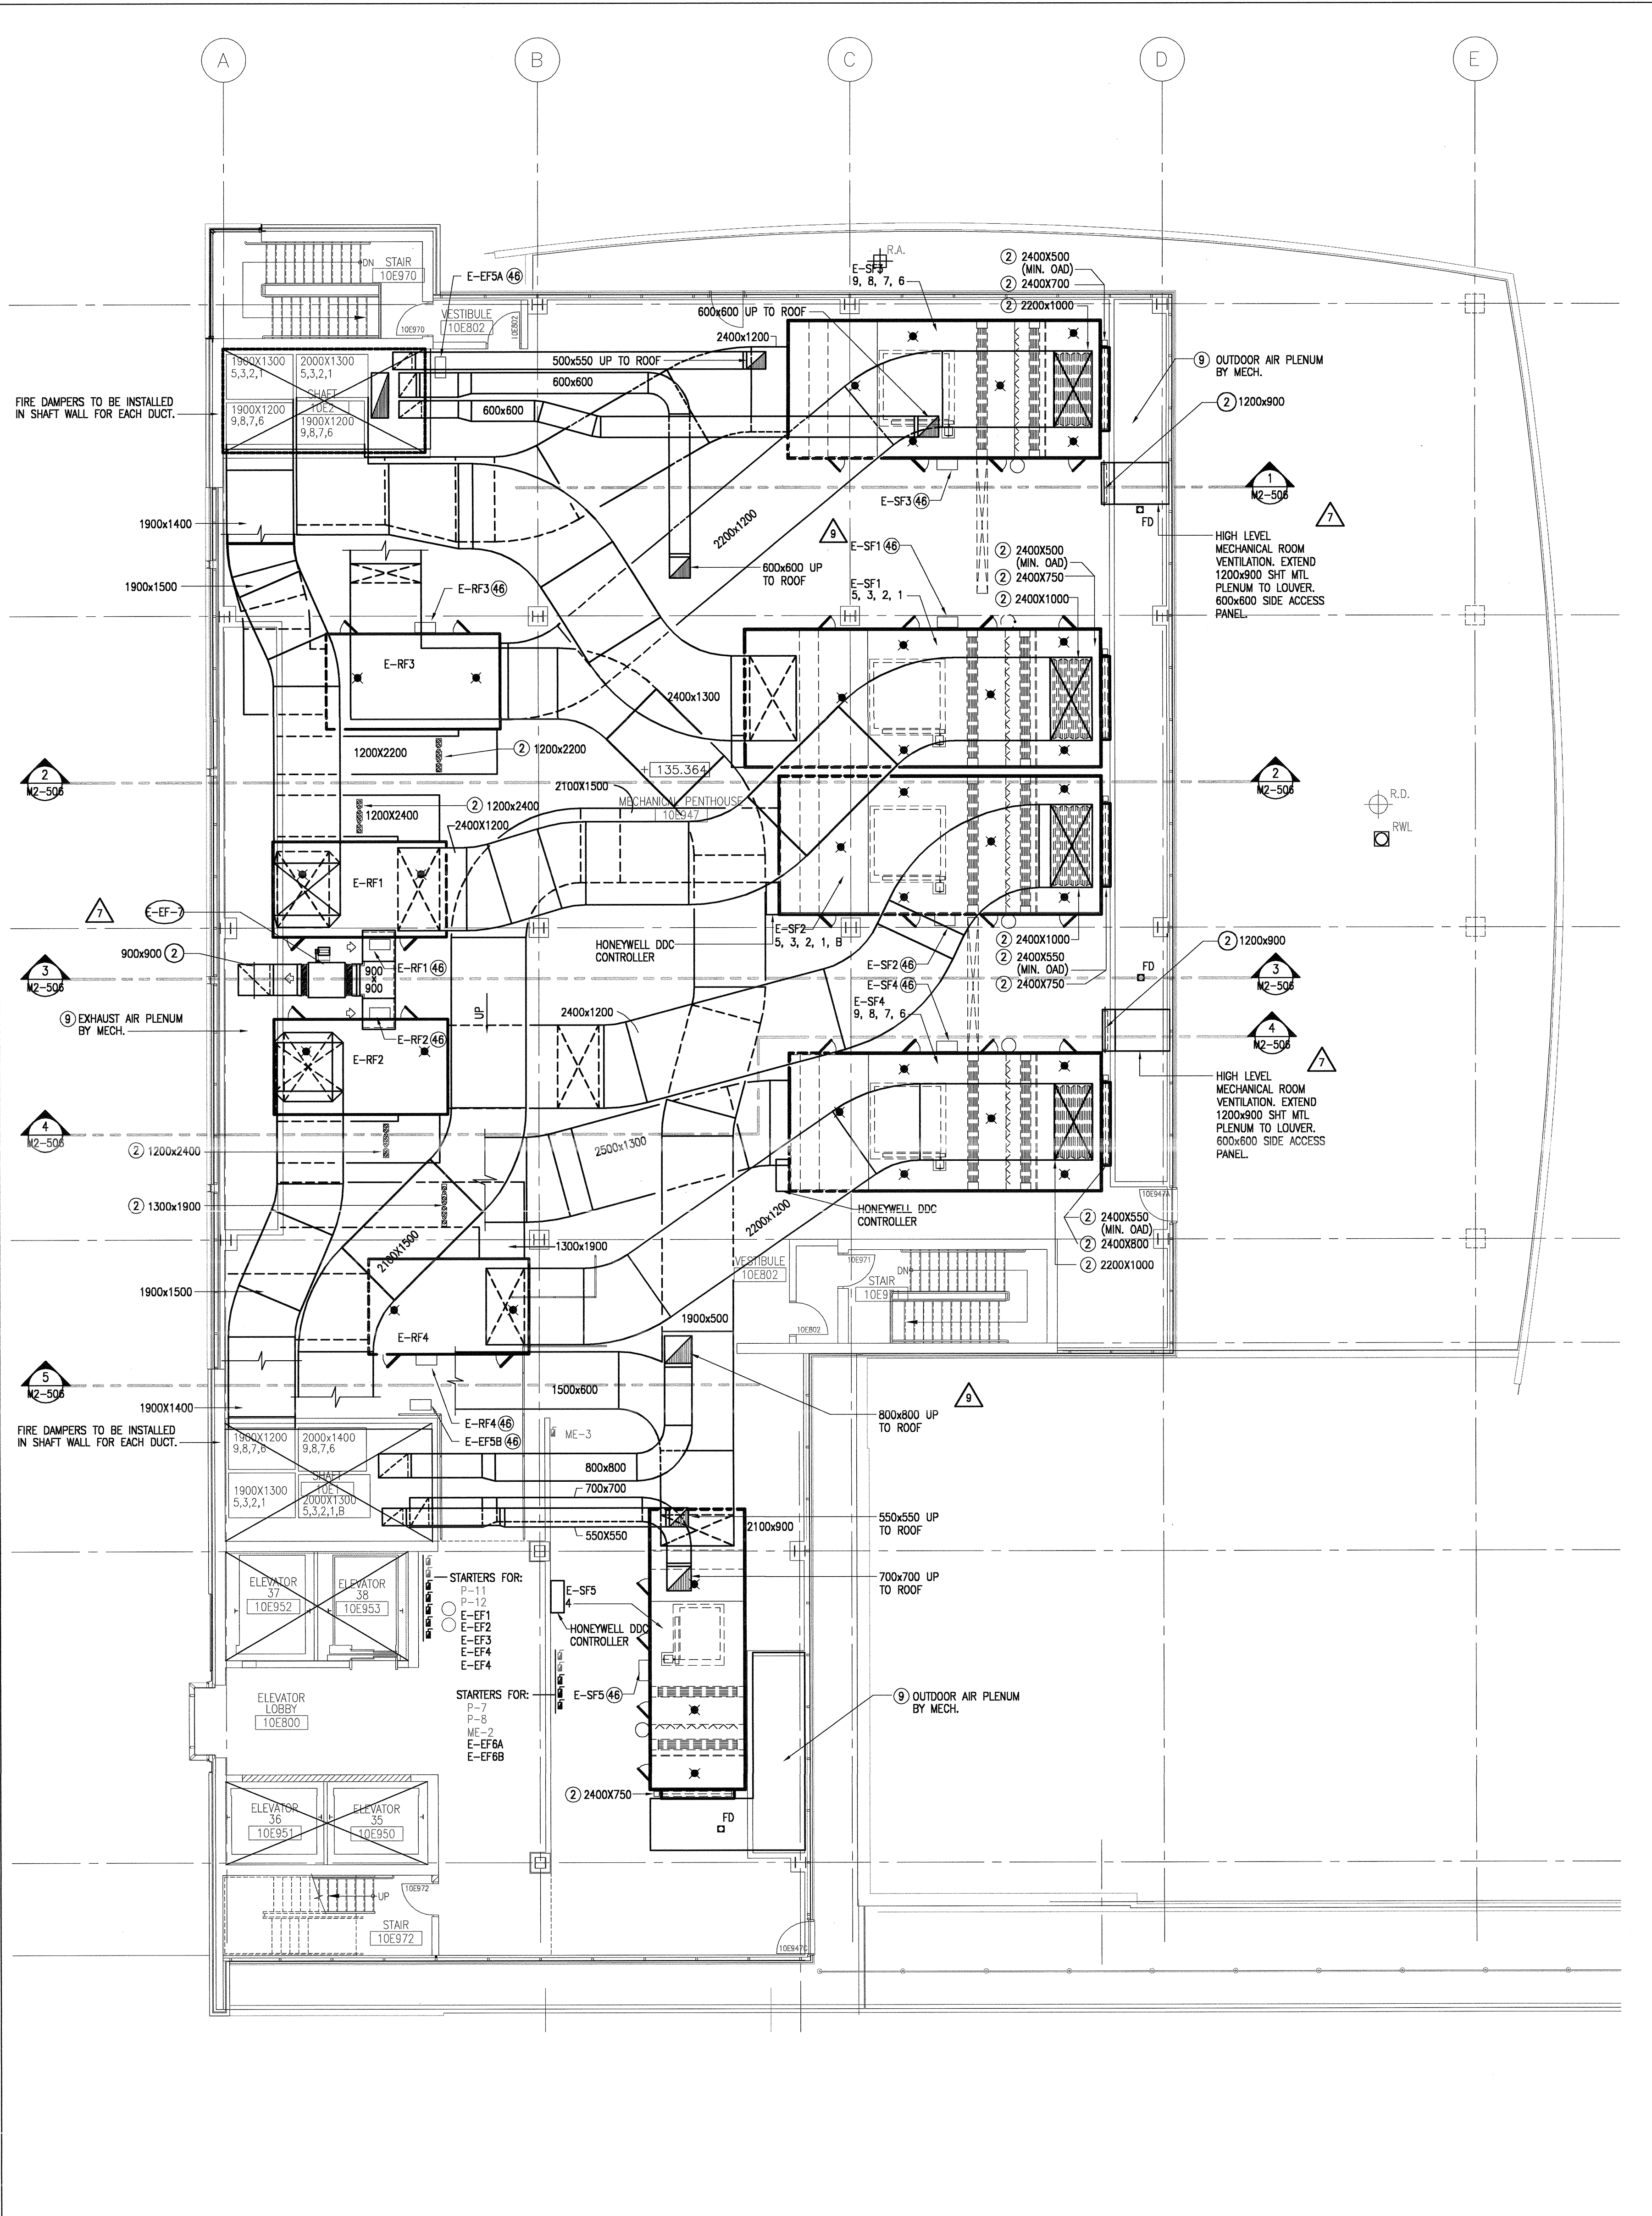

2 PENTHOUSE FLOOR PLAN
506 Scale: 1:100

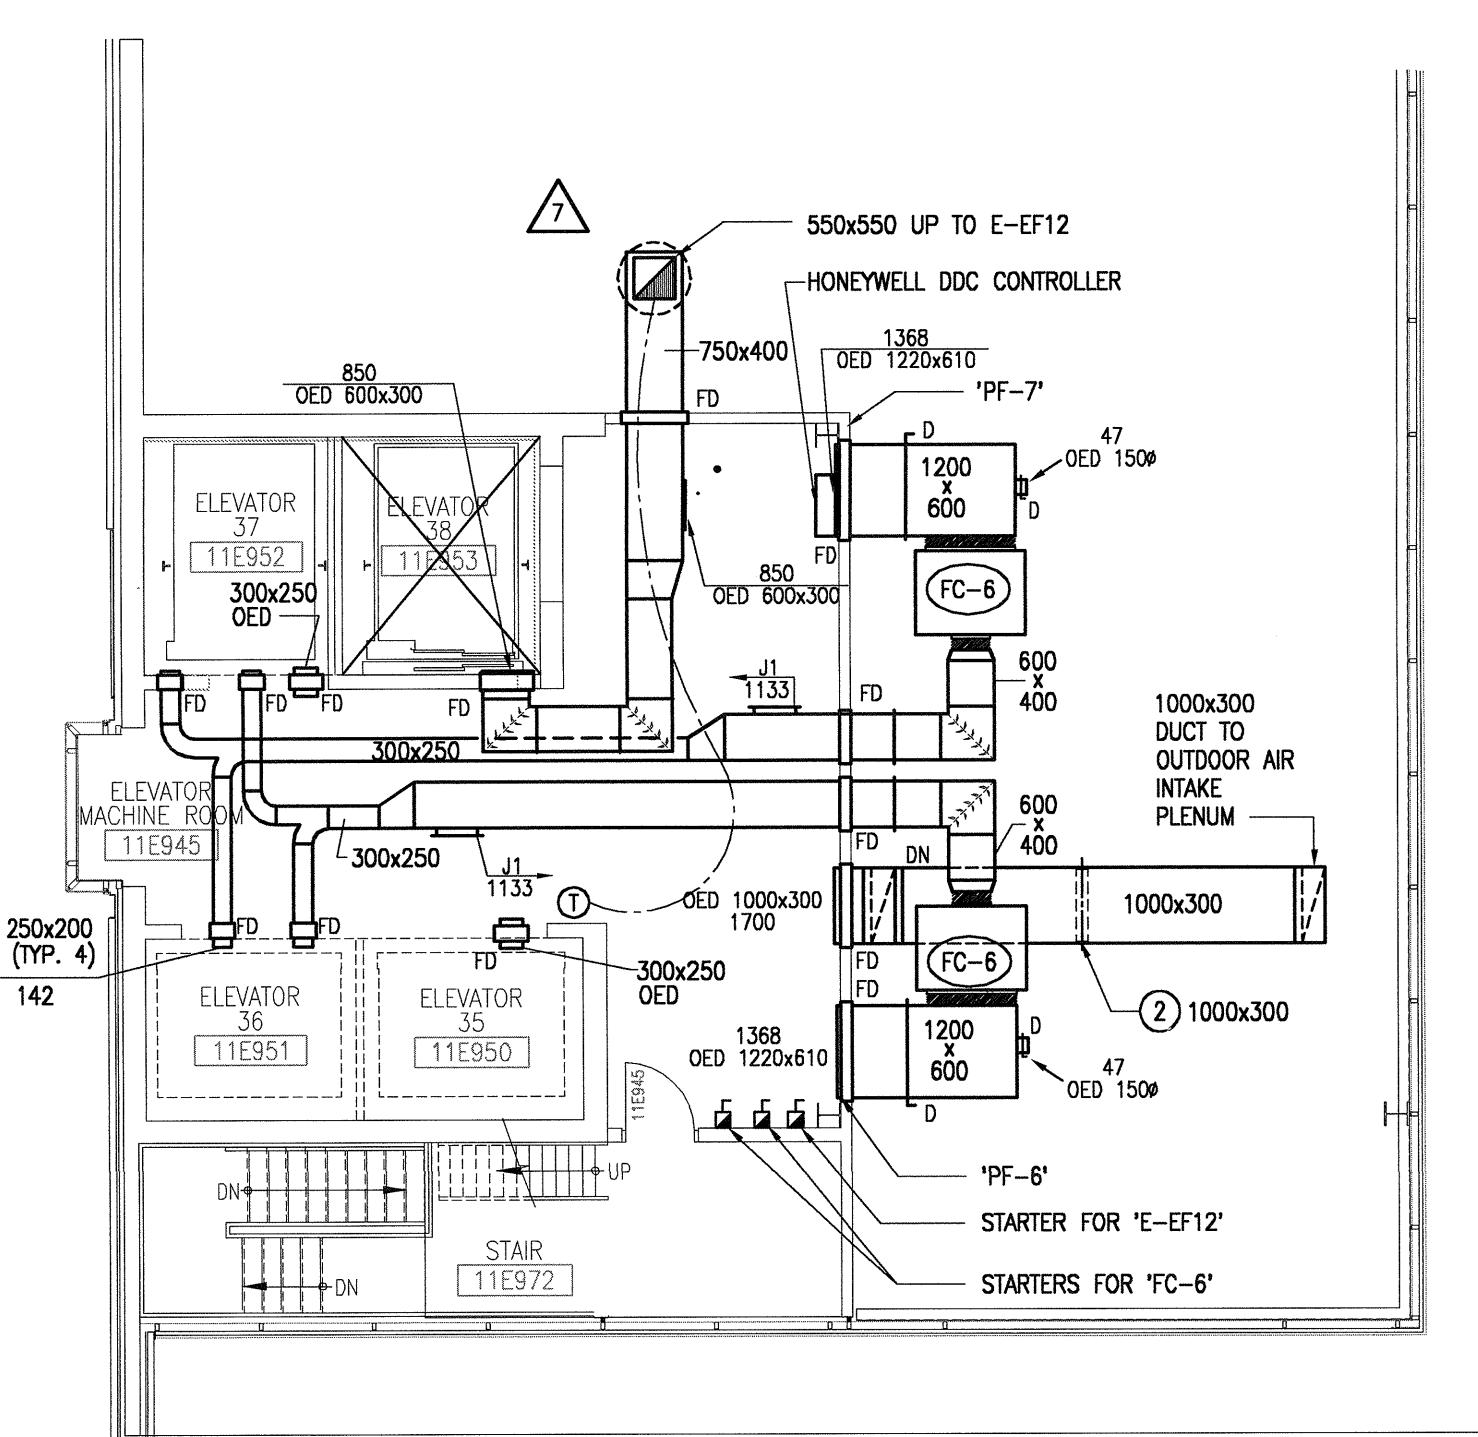


3 ELEVATOR MACHINE ROOM FLOOR PLAN
506 Scale: 1:100

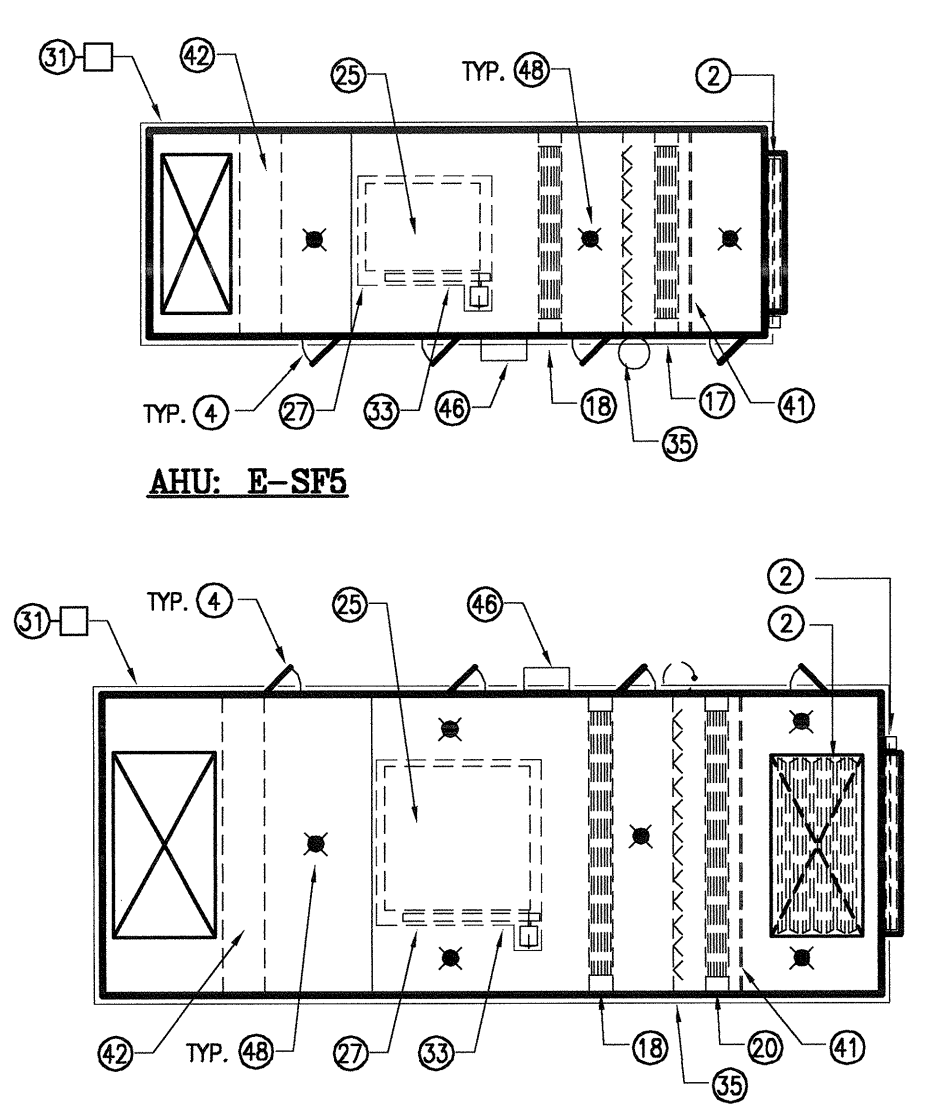

EQUIPMENT LEGEND

- ① MOTORIZED DAMPER (SIZE AS SHOWN)
- ② ACCESS SPACE WITH DOOR
- ③ ELIMINATOR
- ④ STEAM FACE & BYPASS COIL (NUMBER AS SHOWN)
- ⑤ GLYCOL COIL (NUMBER AS SHOWN)
- ⑥ COOLING COIL (NUMBER AS SHOWN)
- ⑦ 1" / 25mm NEOPRENE PAD
- ⑧ INTEGRAL STEEL FAN & MOTOR BASE
- ⑨ VIBRATION ISOLATORS (SEE SCHEDULE)
- ⑩ CONCRETE CURB (HEIGHT AS SHOWN)
- ⑪ FLEXIBLE CONNECTION
- ⑫ WIRE SCREEN GUARD
- ⑬ EQUIPMENT DRAIN (DRAIN TO NEAREST OPEN DRAIN)
- ⑭ STEAM HUMIDIFIER (NUMBER AS SHOWN)
- ⑮ PRE-FILTERS (NUMBER AS SHOWN)
- ⑯ FINAL FILTERS (NUMBER AS SHOWN)
- ⑰ VSD
- ⑱ MARINE LIGHT


4 AHU DETAIL
506 Scale: 1:100

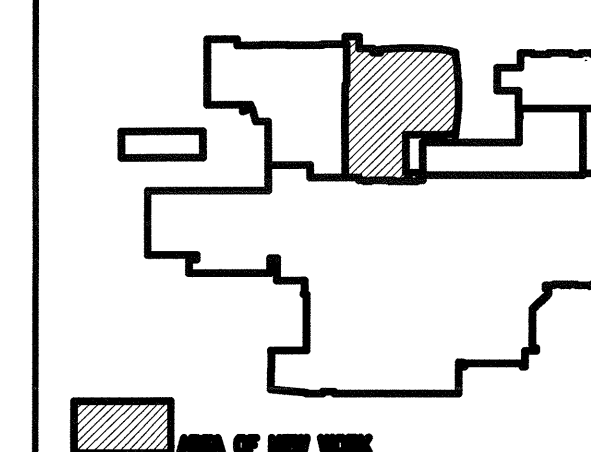

KEY FILM QUERIES

6	07/04/30	ISSUED FOR AS BUILT DRAWINGS
5	03/06/20	ISSUED FOR CONSTRUCTION
4	03/04/29	REVISED FOR ADDENDUM M-4
3	03/04/11	REVISED FOR ADD. M-1
2	03/03/27	ISSUED FOR BUILDING PERMIT
1	03/03/18	ISSUED FOR GENERAL TENDER
REF.	DATE (month/day)	DESCRIPTION

CHECK AND VERIFY ALL DIMENSIONS BEFORE PROCEEDING
WITH THE WORK. DO NOT SCALE DRAWING.

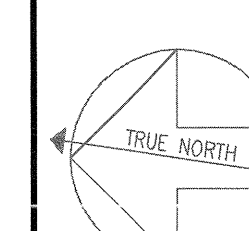

CONSTRUCTION

AS-BUILT DRAWINGS

PROJECT NAME:
TORONTO WESTERN HOSPITAL
EAST WING REDEVELOPMENT
MAIN BUILDING - STAGE TWO
TORONTO ONTARIO

DRAWING TITLE:
ROOF PLAN

VENTILATION

SCALE:
1 : 100

DATE:
MARCH 2


MARCH 2
DRAIN B

CHECKED

PROJECT NUMBER:
2011210


	DRAWING NUMBER:
--	-----------------

M2-50

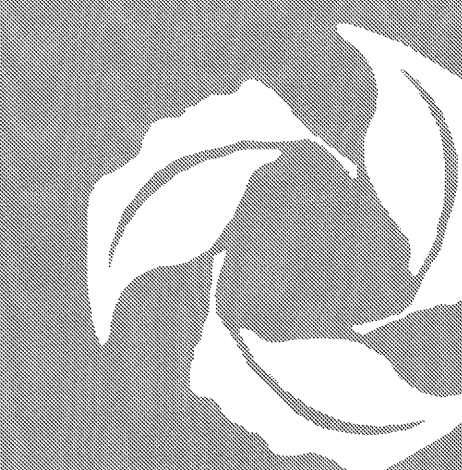

Toronto Western Hospital

University Health Network

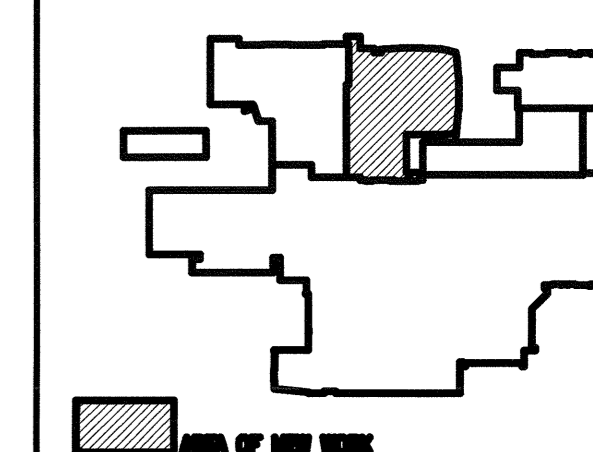


NEW PLAN (R21A)

10	07/04/30	ISSUED FOR AS-BUILT DRAWINGS
9	03/06/20	ISSUED FOR CONSTRUCTION
8	03/05/06	REVISED FOR ADDENDUM M5
7	03/04/24	REVISED FOR ADDENDUM M3
6	03/03/27	ISSUED FOR BUILDING PERMIT
5	03/03/16	ISSUED FOR GENERAL TENDER
4	03/01/29	ISSUED FOR BIDDING
3	02/12/19	APPLICATION FOR BUILDING PERMIT
2	02/11/17	ISSUED FOR BIDDING
1	02/08/16	ISSUED FOR BIDDING

REF. DATE DESCRIPTION
(01/01/00) (01/01/00)

CHECK AND VERIFY ALL DIMENSIONS BEFORE PROCEEDING WITH THE WORK. DO NOT SCALE DRAWINGS.

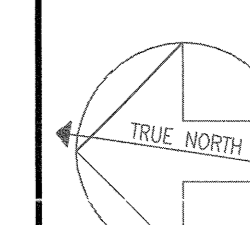


CONSTRUCTION NORTH

AS-BUILT DRAWINGS


PROJECT NAME:
TORONTO WESTERN HOSPITAL
EAST WING REDEVELOPMENT
MAIN BUILDING - STAGE TWO
TORONTO ONTARIO

DRAWING TITLE:
LOWER LEVEL FLOOR PLAN
HEATING

SCALE:
1 : 100
DATE:
MARCH 2003
DRAWN BY:
CHECKED BY:
PROJECT NUMBER:
2011210
DRAWING NUMBER:
M2-601

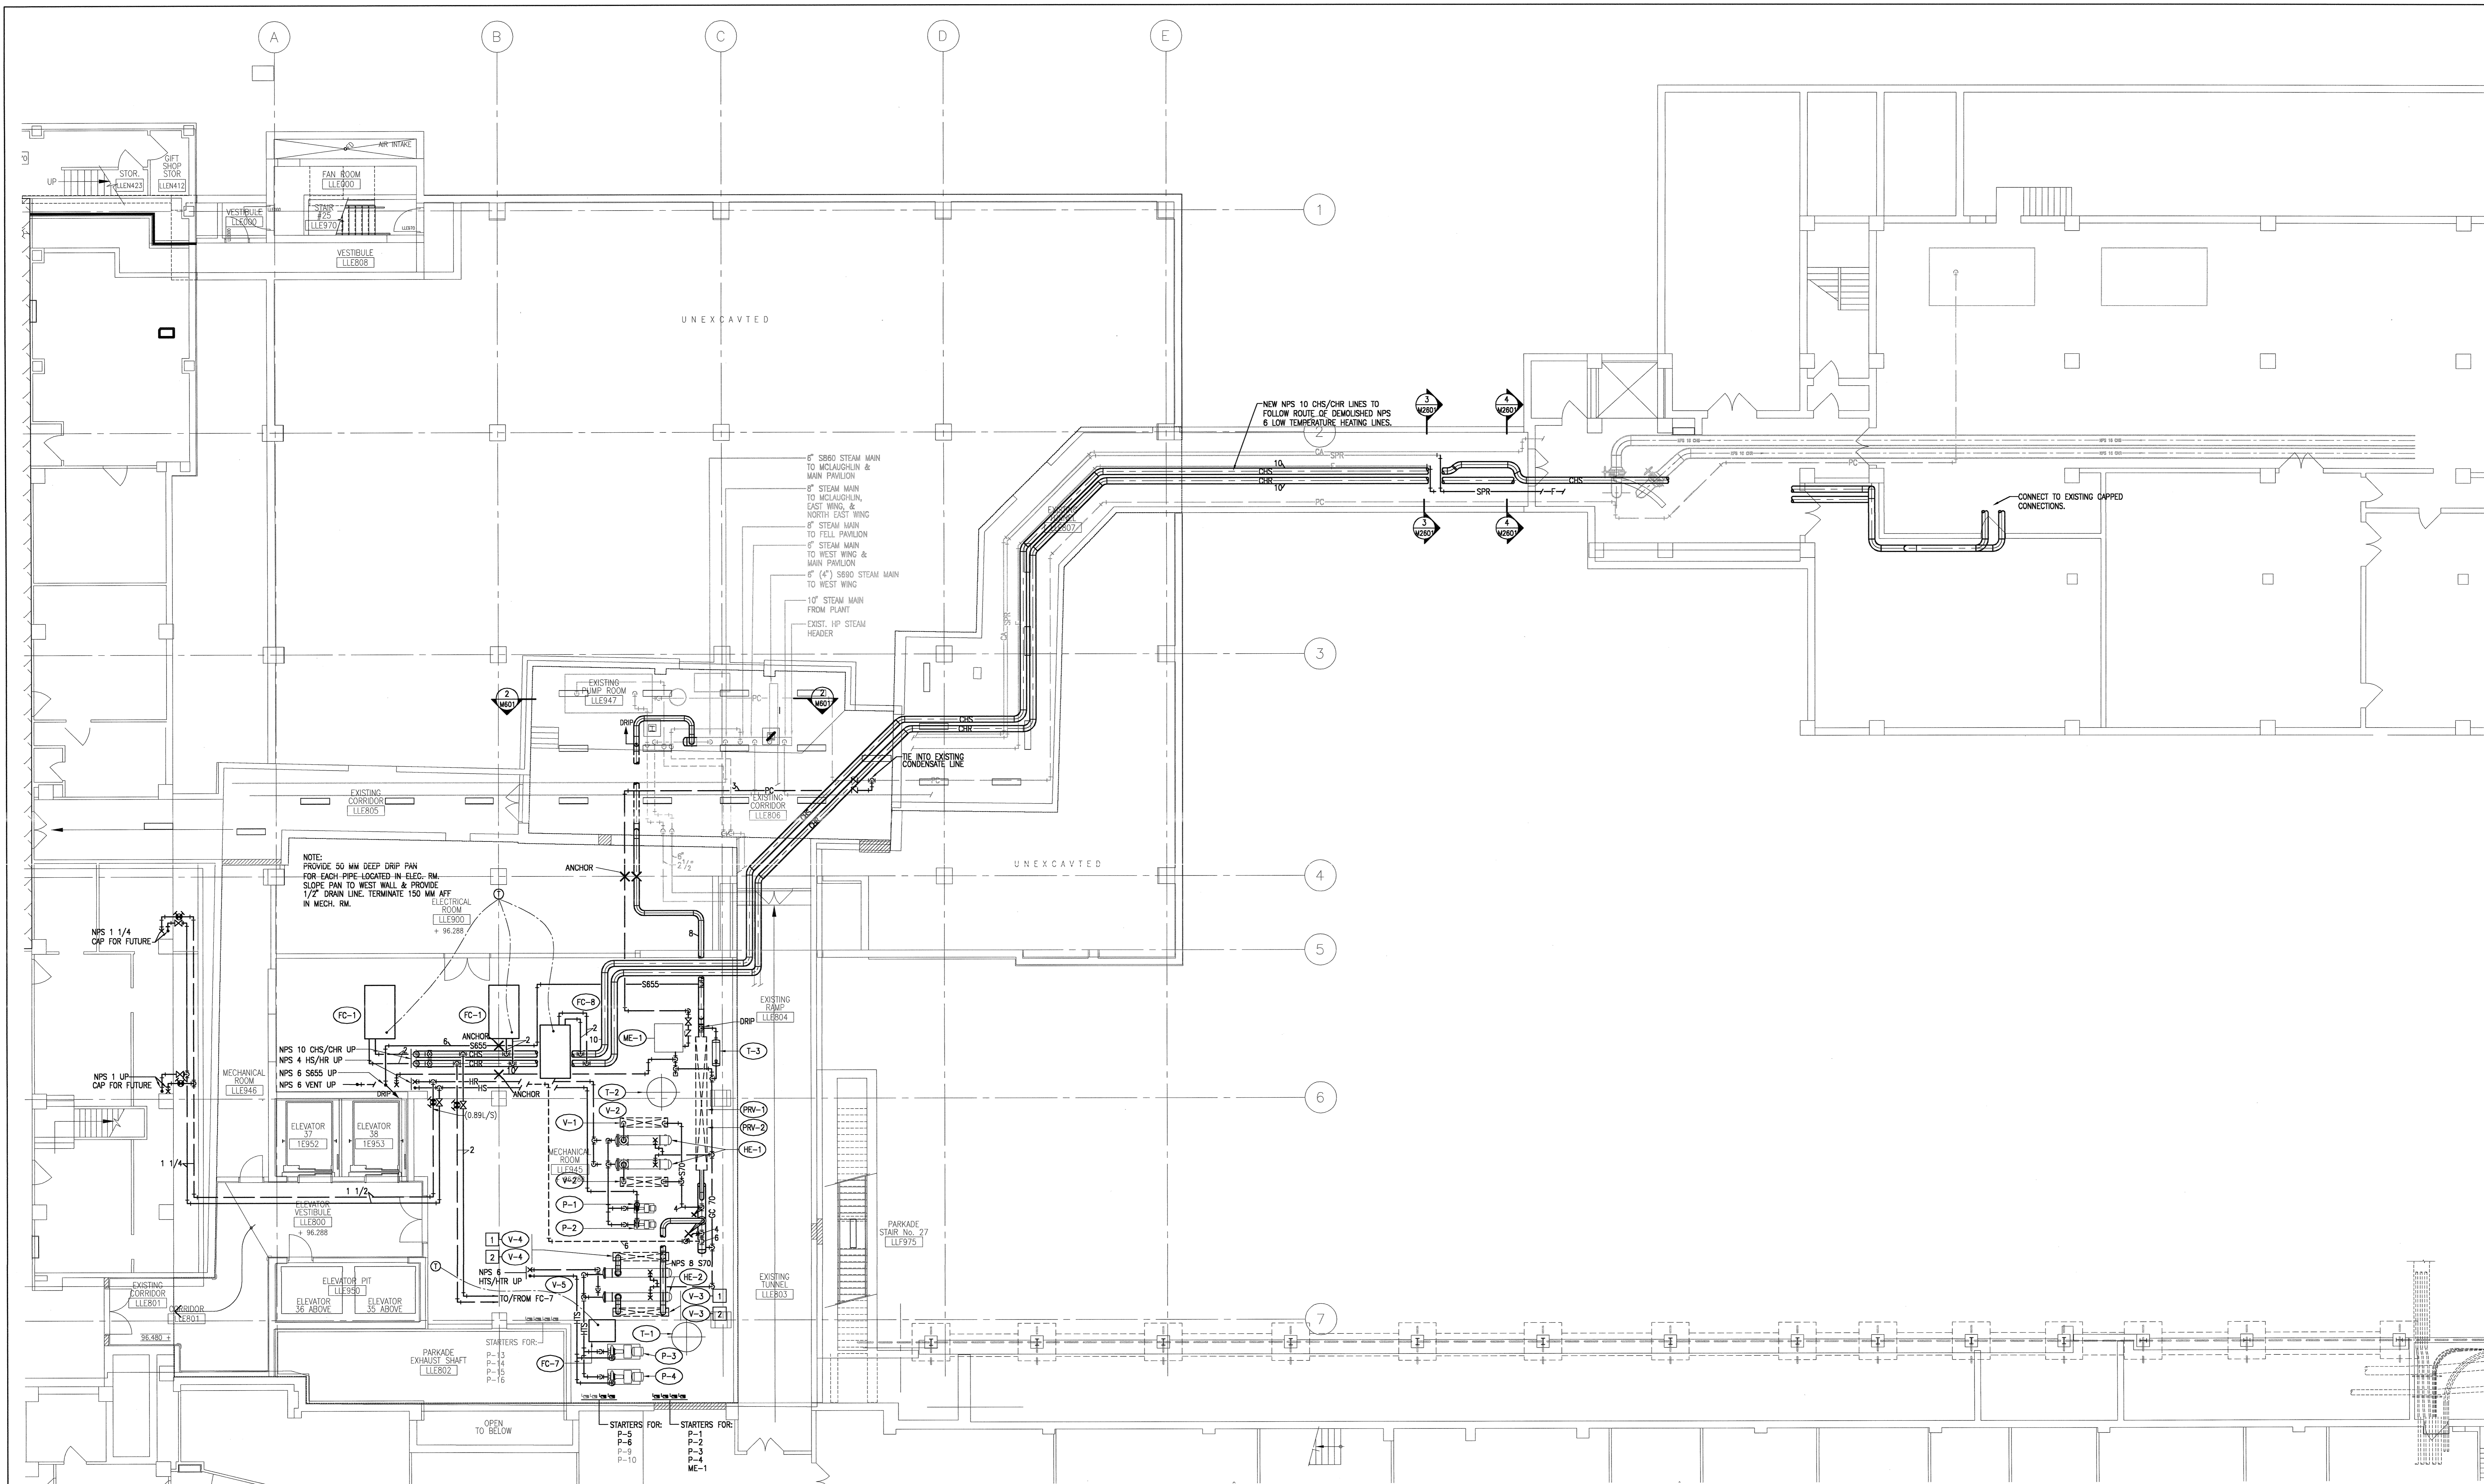


1 LOWER LEVEL FLOOR PLAN
M2601 Scale: 1:100

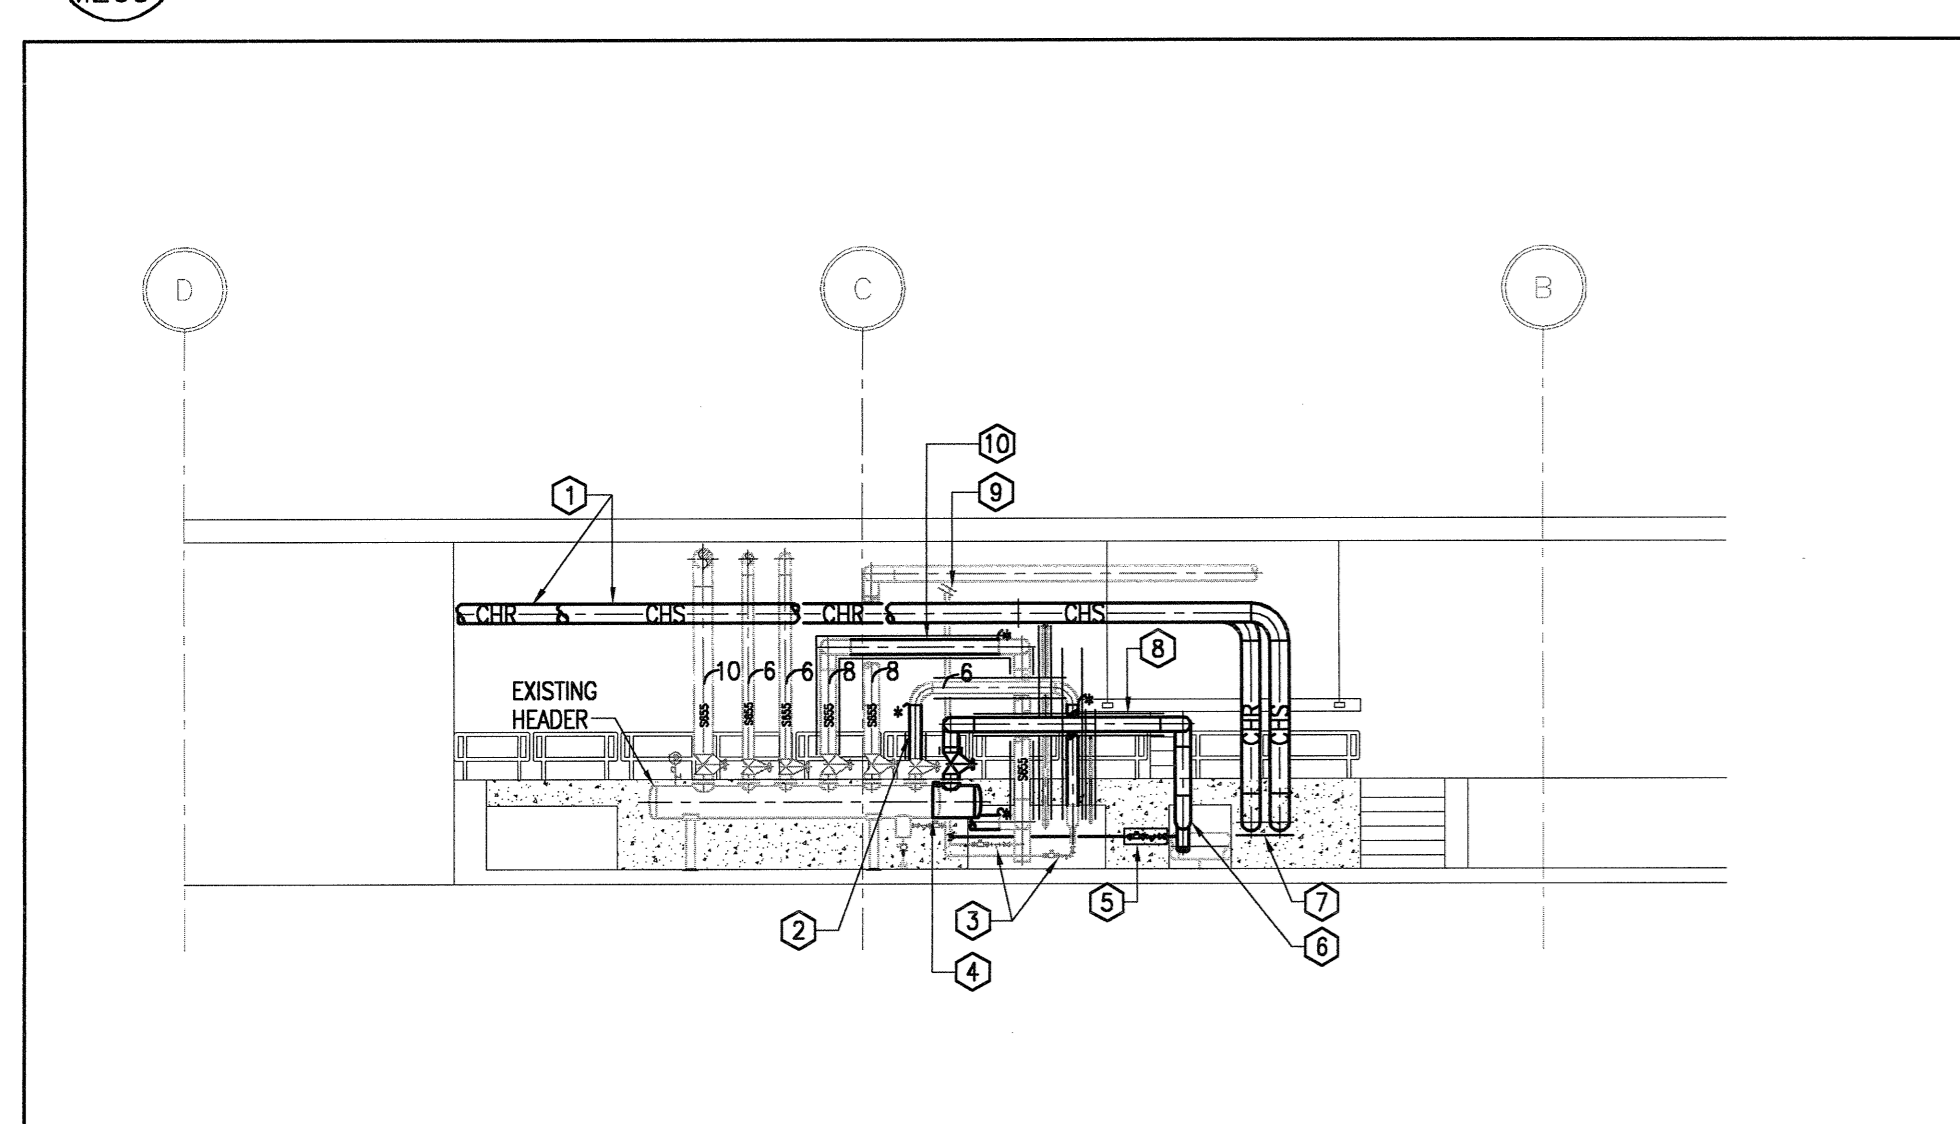


2 SECTION OF EXISTING STEAM HEADER
M2601 Scale: 1:100

- DRAWING NOTES:
- 1 NEW NPS 10 CHS/CHR LINES
 - 2 RAISE EXISTING NPS 6 LINE
 - 3 RELOCATE EXISTING DRIP TRAP ASSEMBLY
 - 4 EXTEND EXISTING HEADER
 - 5 NEW DRIP TRAP ASSEMBLY TO BE CONNECTED TO EXISTING H.P. COND. LINE
 - 6 NEW NPS 8 S885 STEAM SERVICE TO RUN UNDER LANDING
 - 7 NEW NPS 10 CHS/CHR TO RUN UNDER LANDING
 - 8 NEW NPS 8 S885 FOR EAST WING
 - 9 H.P. CONDENSATE TO EXISTING FLASH TANK
 - 10 EXTEND EXISTING NPS 8 LINE TO ACCOMMODATE NEW HEADER EXTENSION

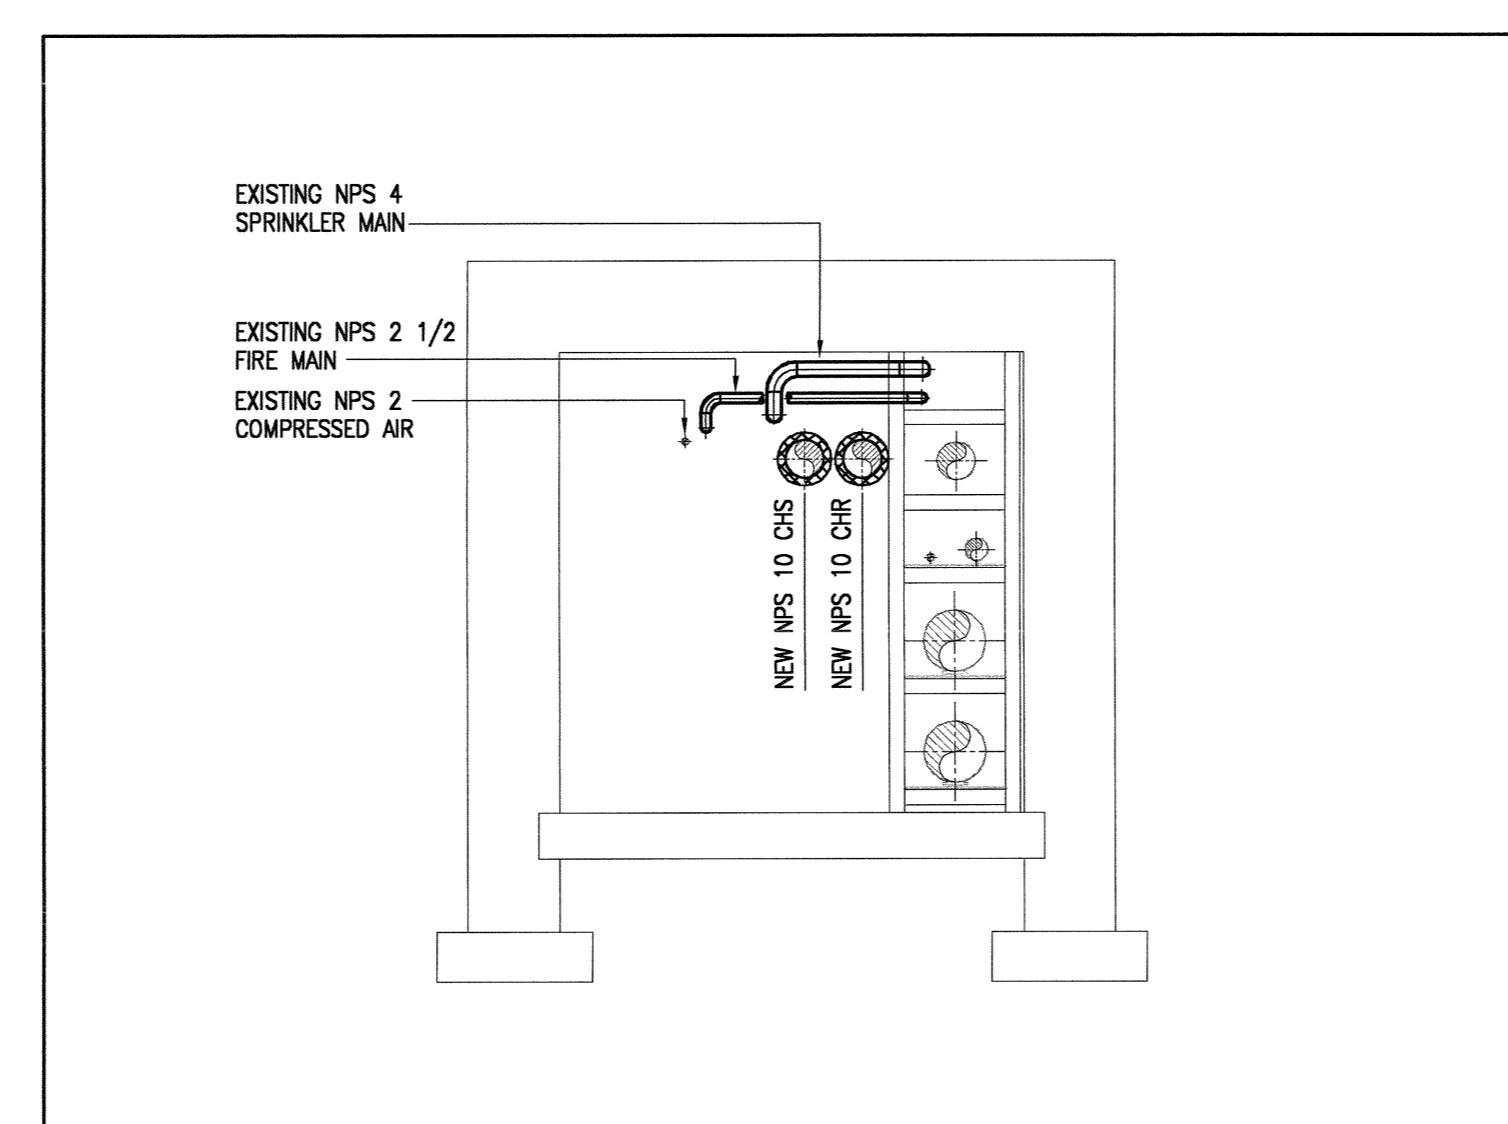

3 SECTION OF NEW NPS 10 CHILLED WATER LINES IN SERVICE TUNNEL
M2601 Scale: 1:50

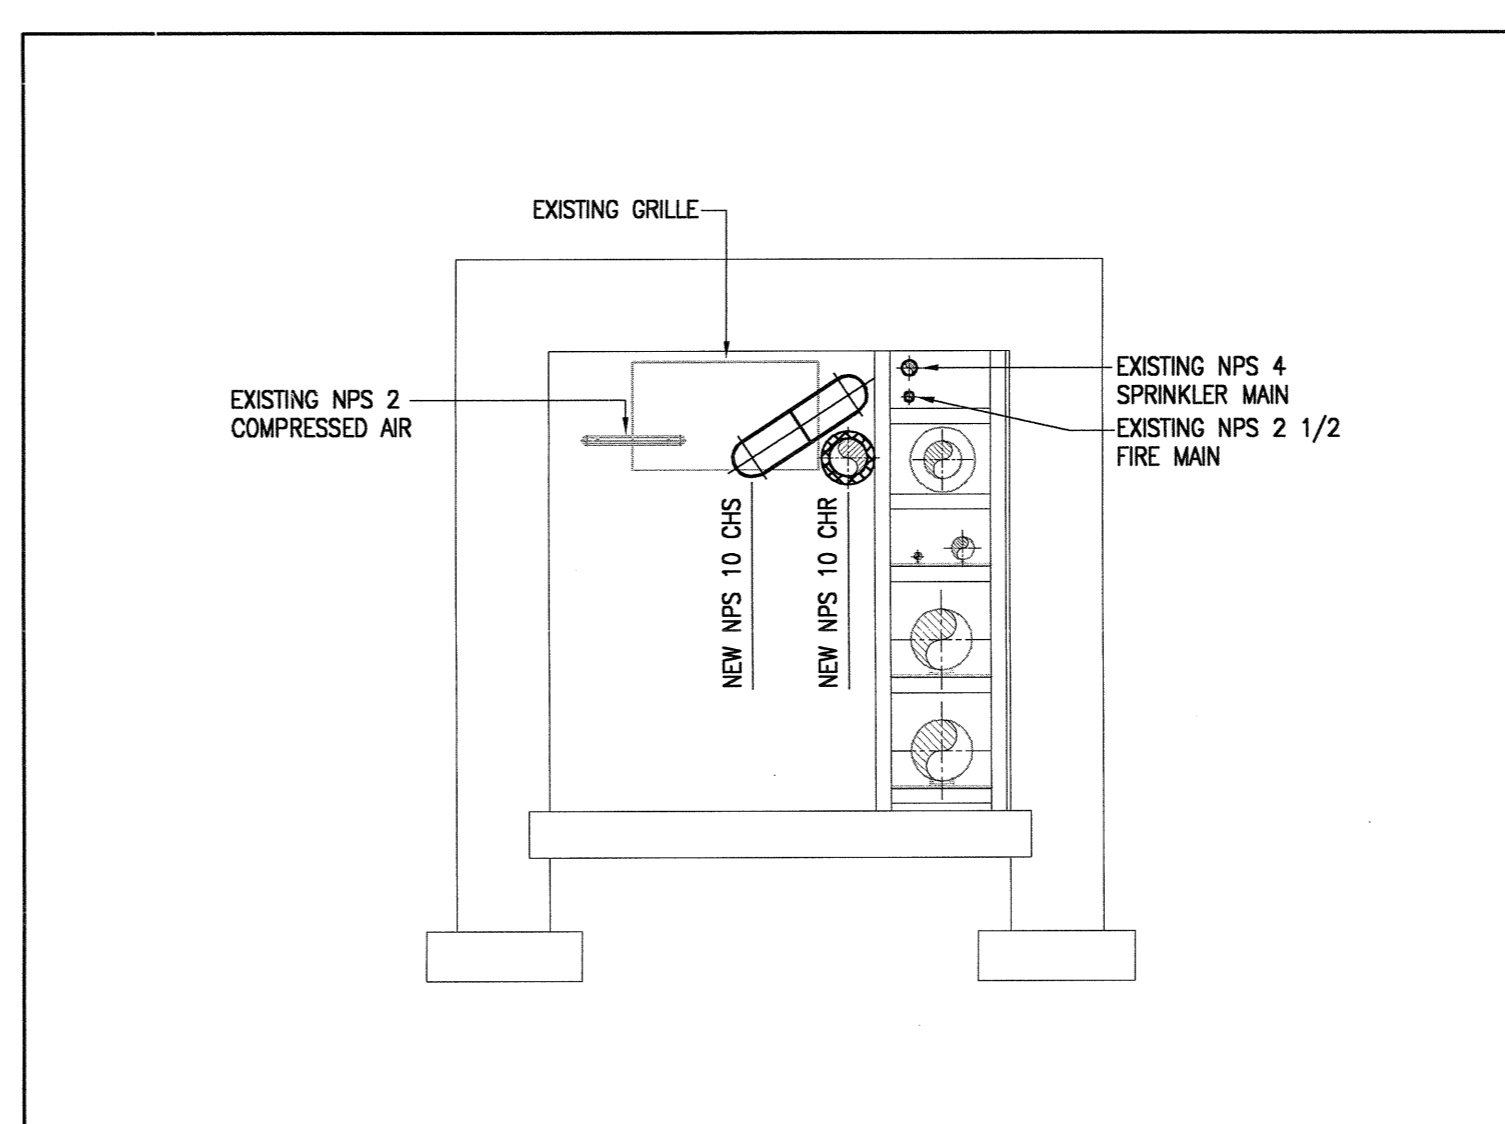


4 SECTION OF NEW NPS 10 CHILLED WATER LINES IN SERVICE TUNNEL
M2601 Scale: 1:50



Toronto Western Hospital


University Health Network

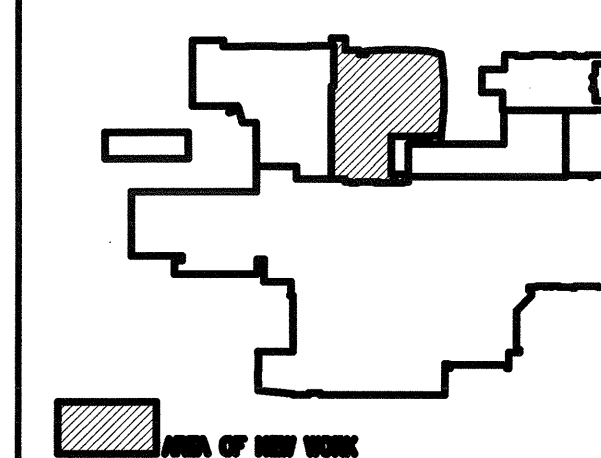

NEW PLAN (R22)

- 9 07/04/00 ISSUED FOR AS BUILT DRAWINGS
8 03/06/00 ISSUED FOR CONSTRUCTION
7 03/04/01 REVISED FOR ADDENDUM M1
6 03/03/01 ISSUED FOR BUILDING PERMIT
5 03/03/01 ISSUED FOR GENERAL TENDER
4 03/01/01 ISSUED FOR BOX COSTING
3 02/12/01 APPLICATION FOR BUILDING PERMIT
2 02/11/01 ISSUED FOR BOX REVIEW
1 02/08/01 ISSUED FOR COSTING
- REF. DATE DESCRIPTION
(07/04/00)

CHECK AND VERIFY ALL DIMENSIONS BEFORE PROCEEDING WITH THE WORK.

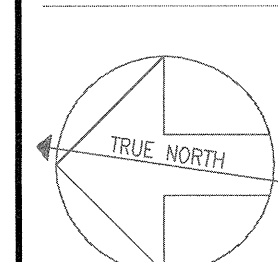


CONSTRUCTION NORTH
AS-BUILT DRAWINGS


PROJECT NAME:
TORONTO WESTERN HOSPITAL
EAST WING REDEVELOPMENT
MAIN BUILDING - STAGE TWO
TORONTO ONTARIO

DRAWING TITLE:
LEVEL 1 FLOOR PLAN
LEVEL 2 FLOOR PLAN
HEATING

SCALE:
1 : 100
DATE:
MARCH 2003
DRAWN BY:
CHECKED BY:
PROJECT NUMBER:
2011210
DRAWING NUMBER:
M2-602

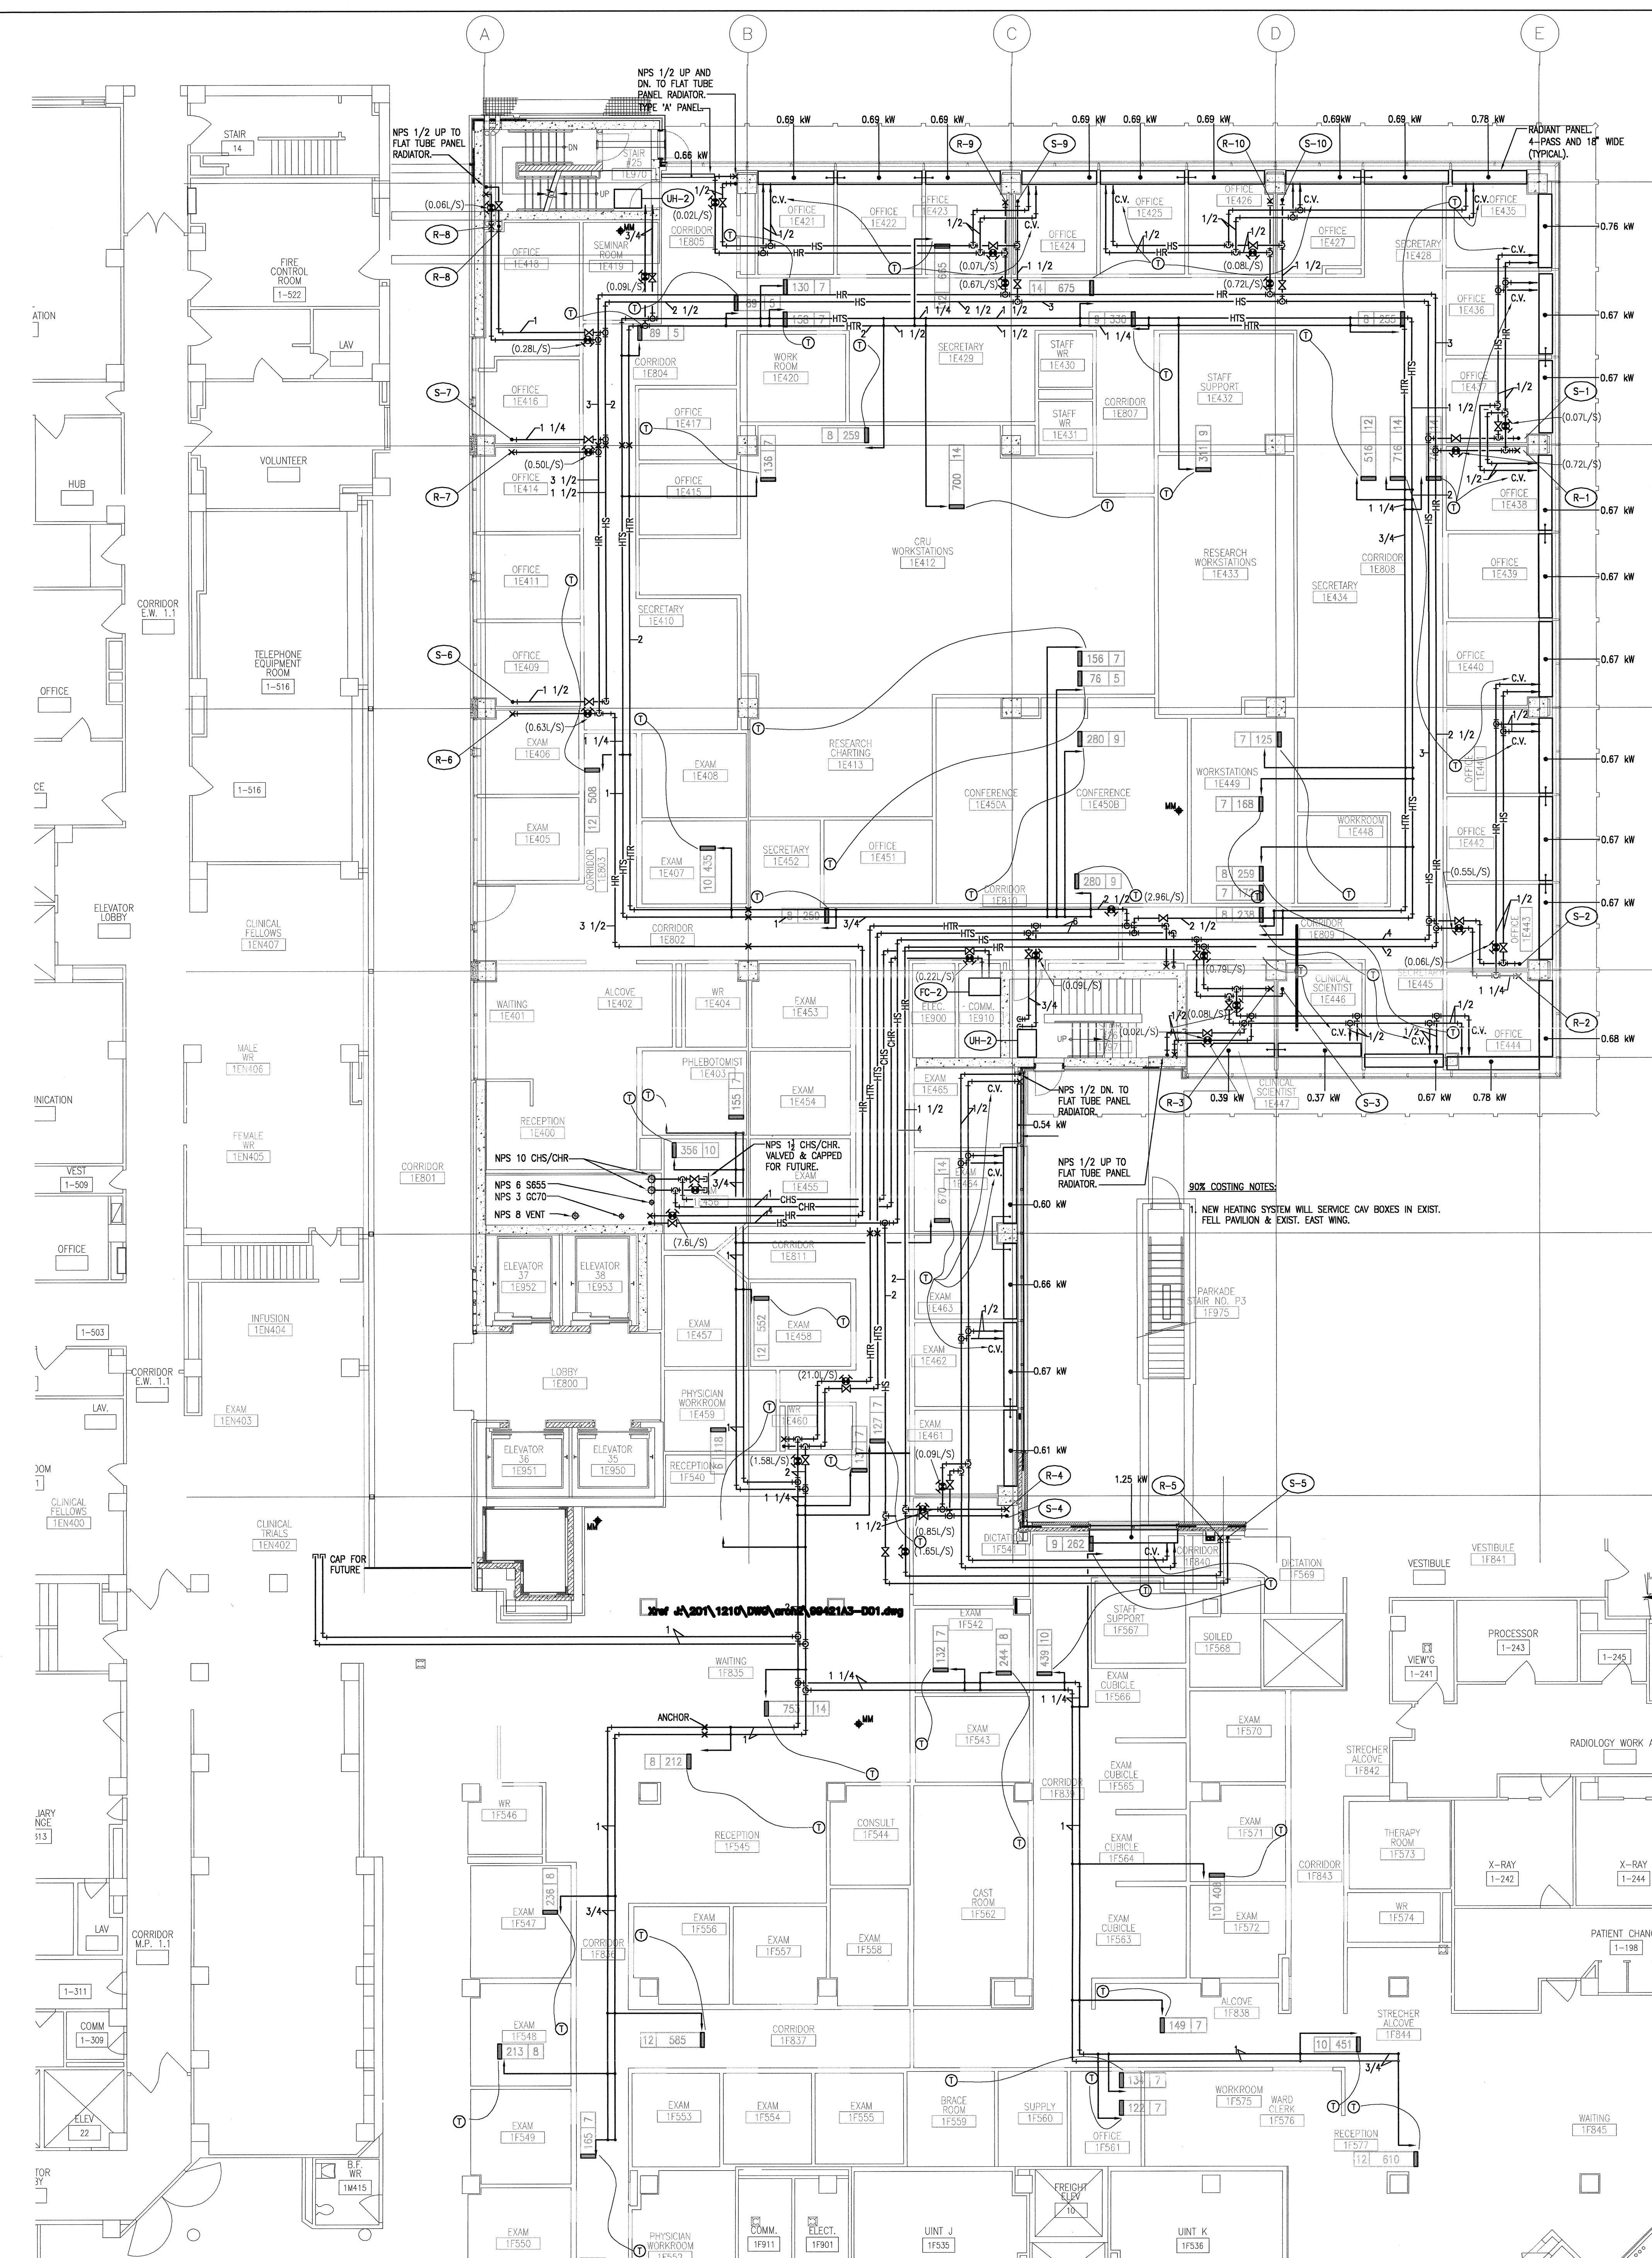

1 LEVEL ONE FLOOR PLAN
Scale: 1:100

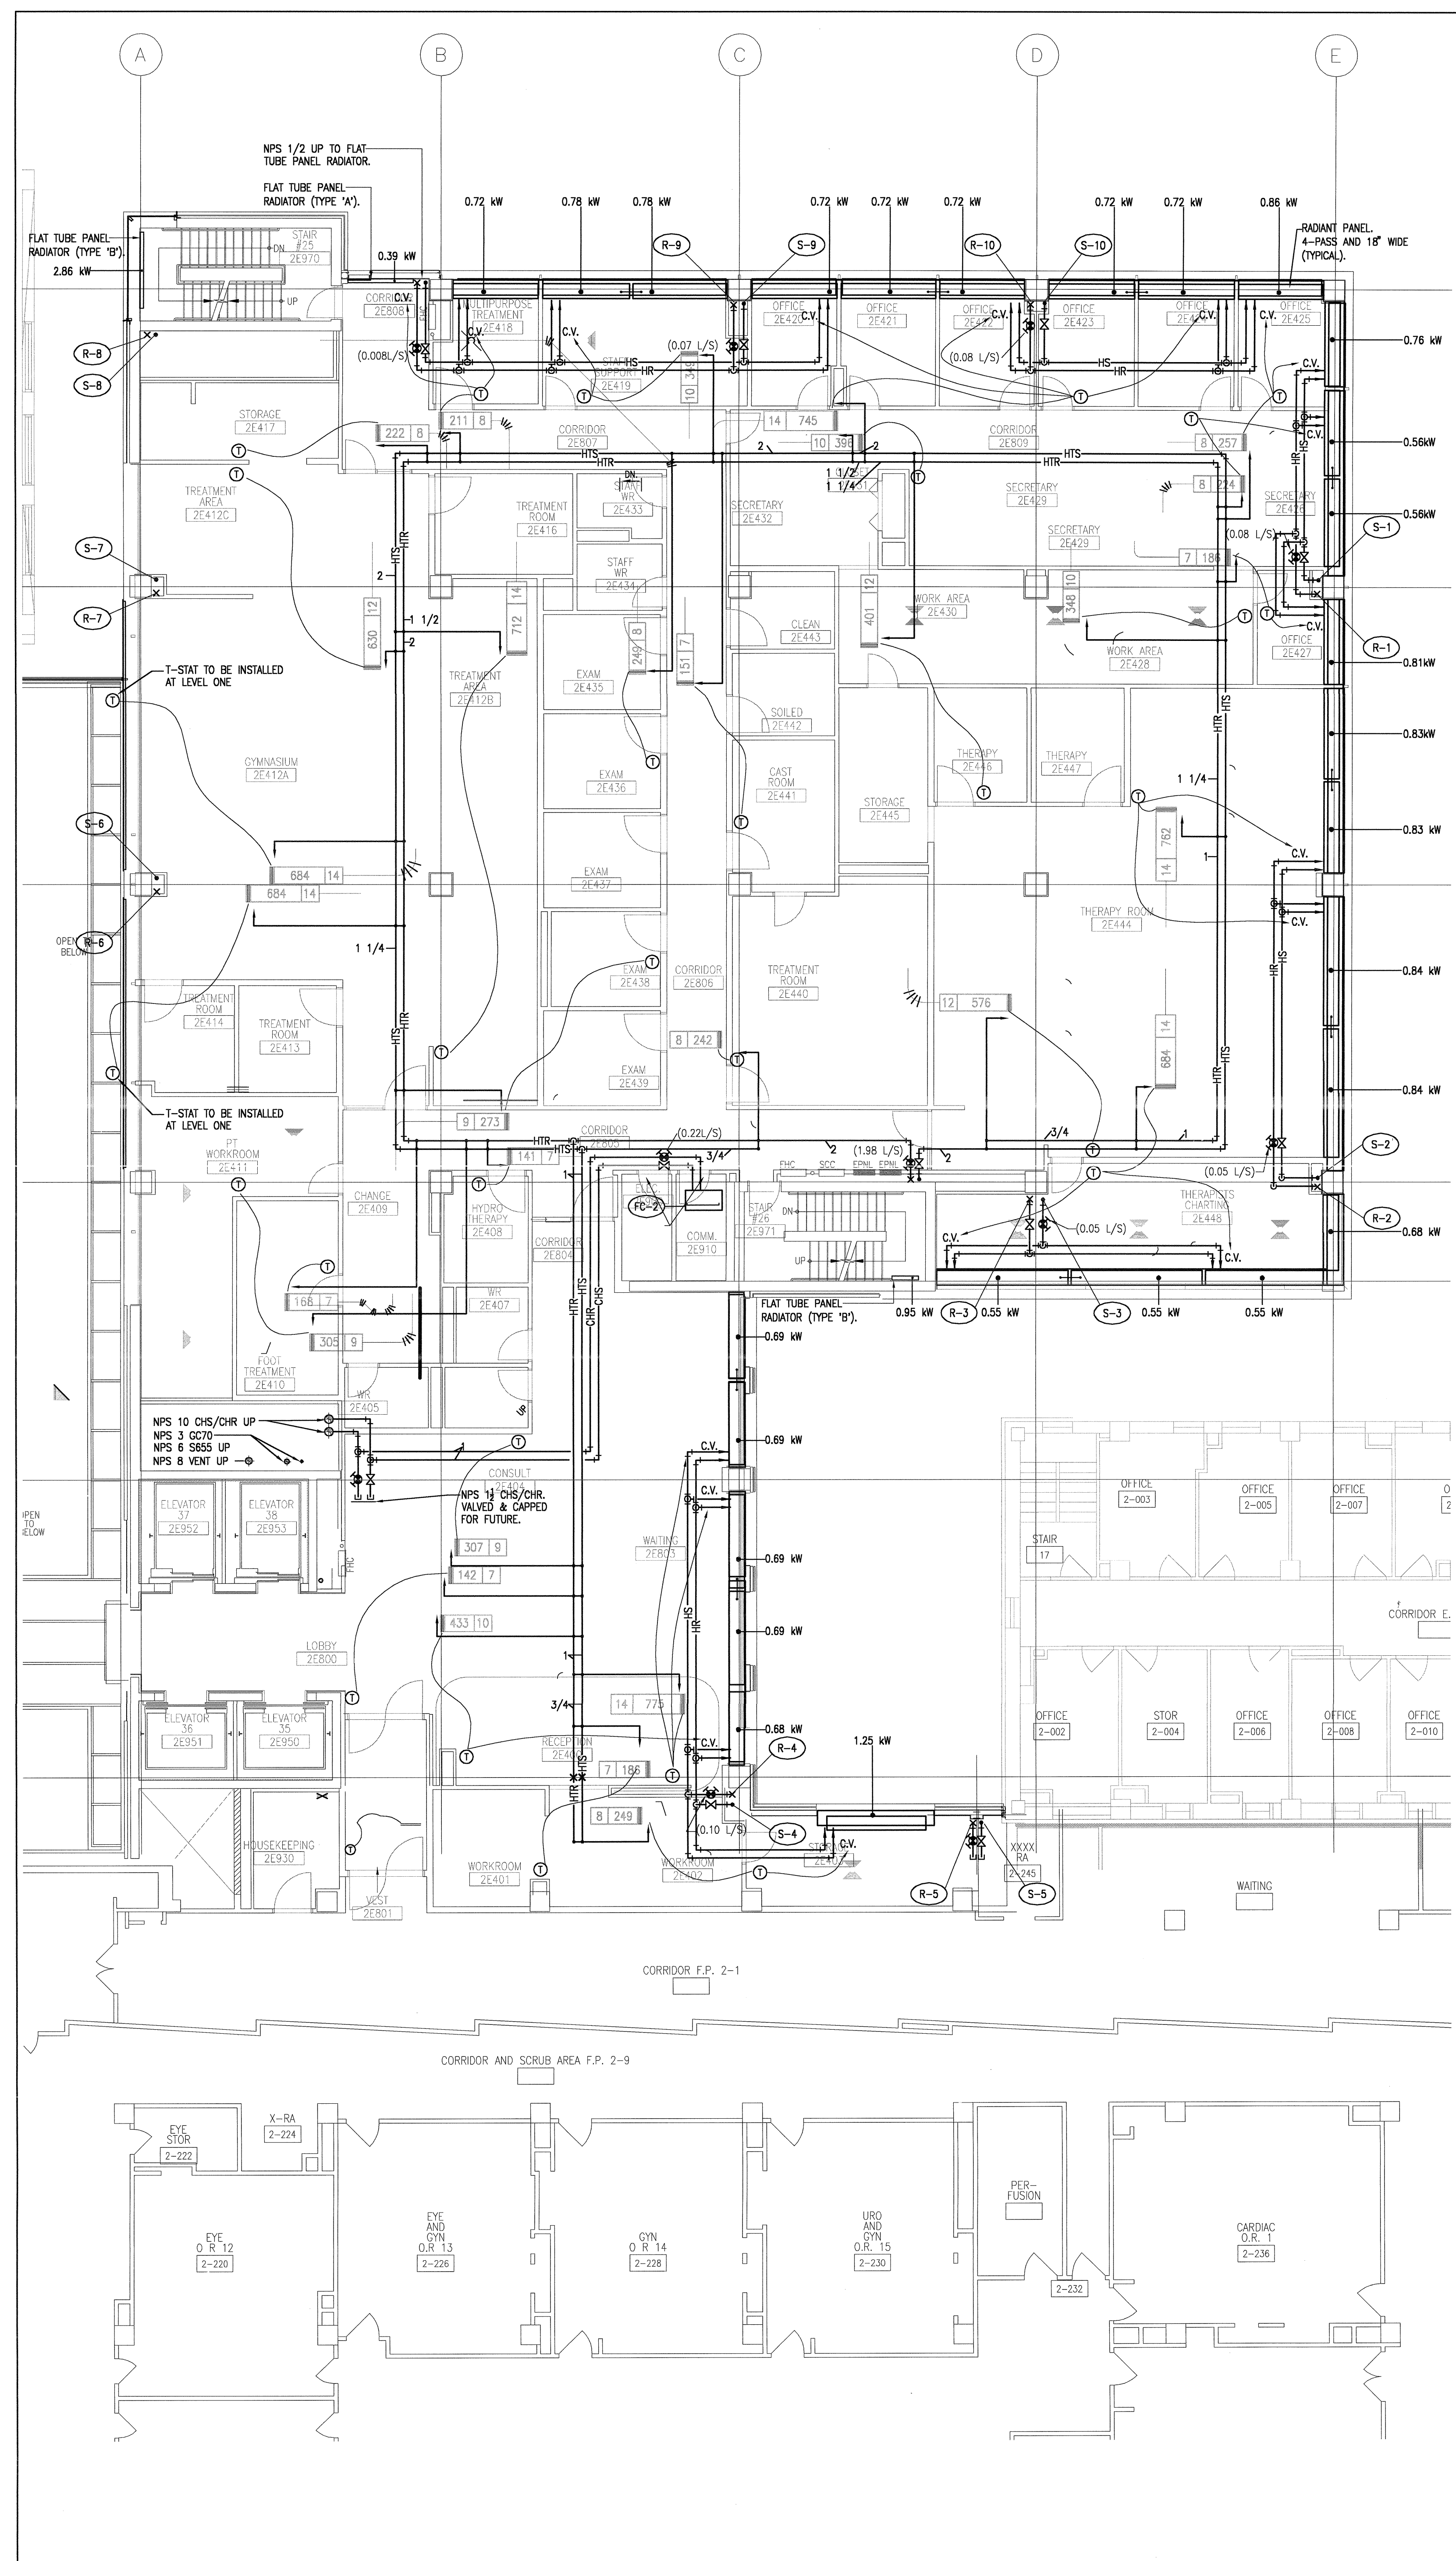


2 LEVEL TWO FLOOR PLAN
Scale: 1:100



Toronto Western Hospital


University Health Network

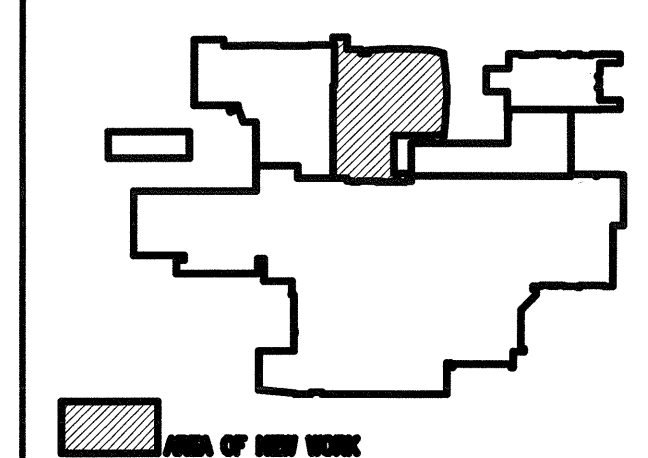

KEY PLAN (M2-603)

- 9 07/04/20 ISSUED FOR AS-BUILT DRAWINGS
 - 8 03/06/20 ISSUED FOR CONSTRUCTION
 - 7 03/04/11 REVISED FOR ADDENDUM M1
 - 6 03/03/21 ISSUED FOR BUILDING PERMIT
 - 5 03/03/18 ISSUED FOR GENERAL TENDER
 - 4 03/01/20 ISSUED FOR RISE COSTING
 - 3 02/12/19 APPLICATION FOR BUILDING PERMIT
 - 2 02/11/17 ISSUED FOR REVIEW
 - 1 02/06/16 ISSUED FOR COSTING
- REF. DATE DESCRIPTION
(M/YY/YY)

CHECK AND VERIFY ALL DIMENSIONS BEFORE PROCEEDING WITH THE WORK. DO NOT SCALE DRAWINGS.

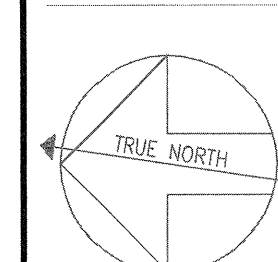


CONSTRUCTION NORTH

AS-BUILT DRAWINGS


PROJECT NAME:
TORONTO WESTERN HOSPITAL
EAST WING REDEVELOPMENT
MAIN BUILDING - STAGE TWO
TORONTO ONTARIO

DRAWING TITLE:
LEVEL 3 FLOOR PLAN
LEVEL 4 FLOOR PLAN
HEATING

SCALE:
1 : 100
DATE:
MARCH 2003
DRAWN BY:
M2-603
PROJECT NUMBER:
2011210
DRAWING NUMBER:
M2-603
CHECKED BY:

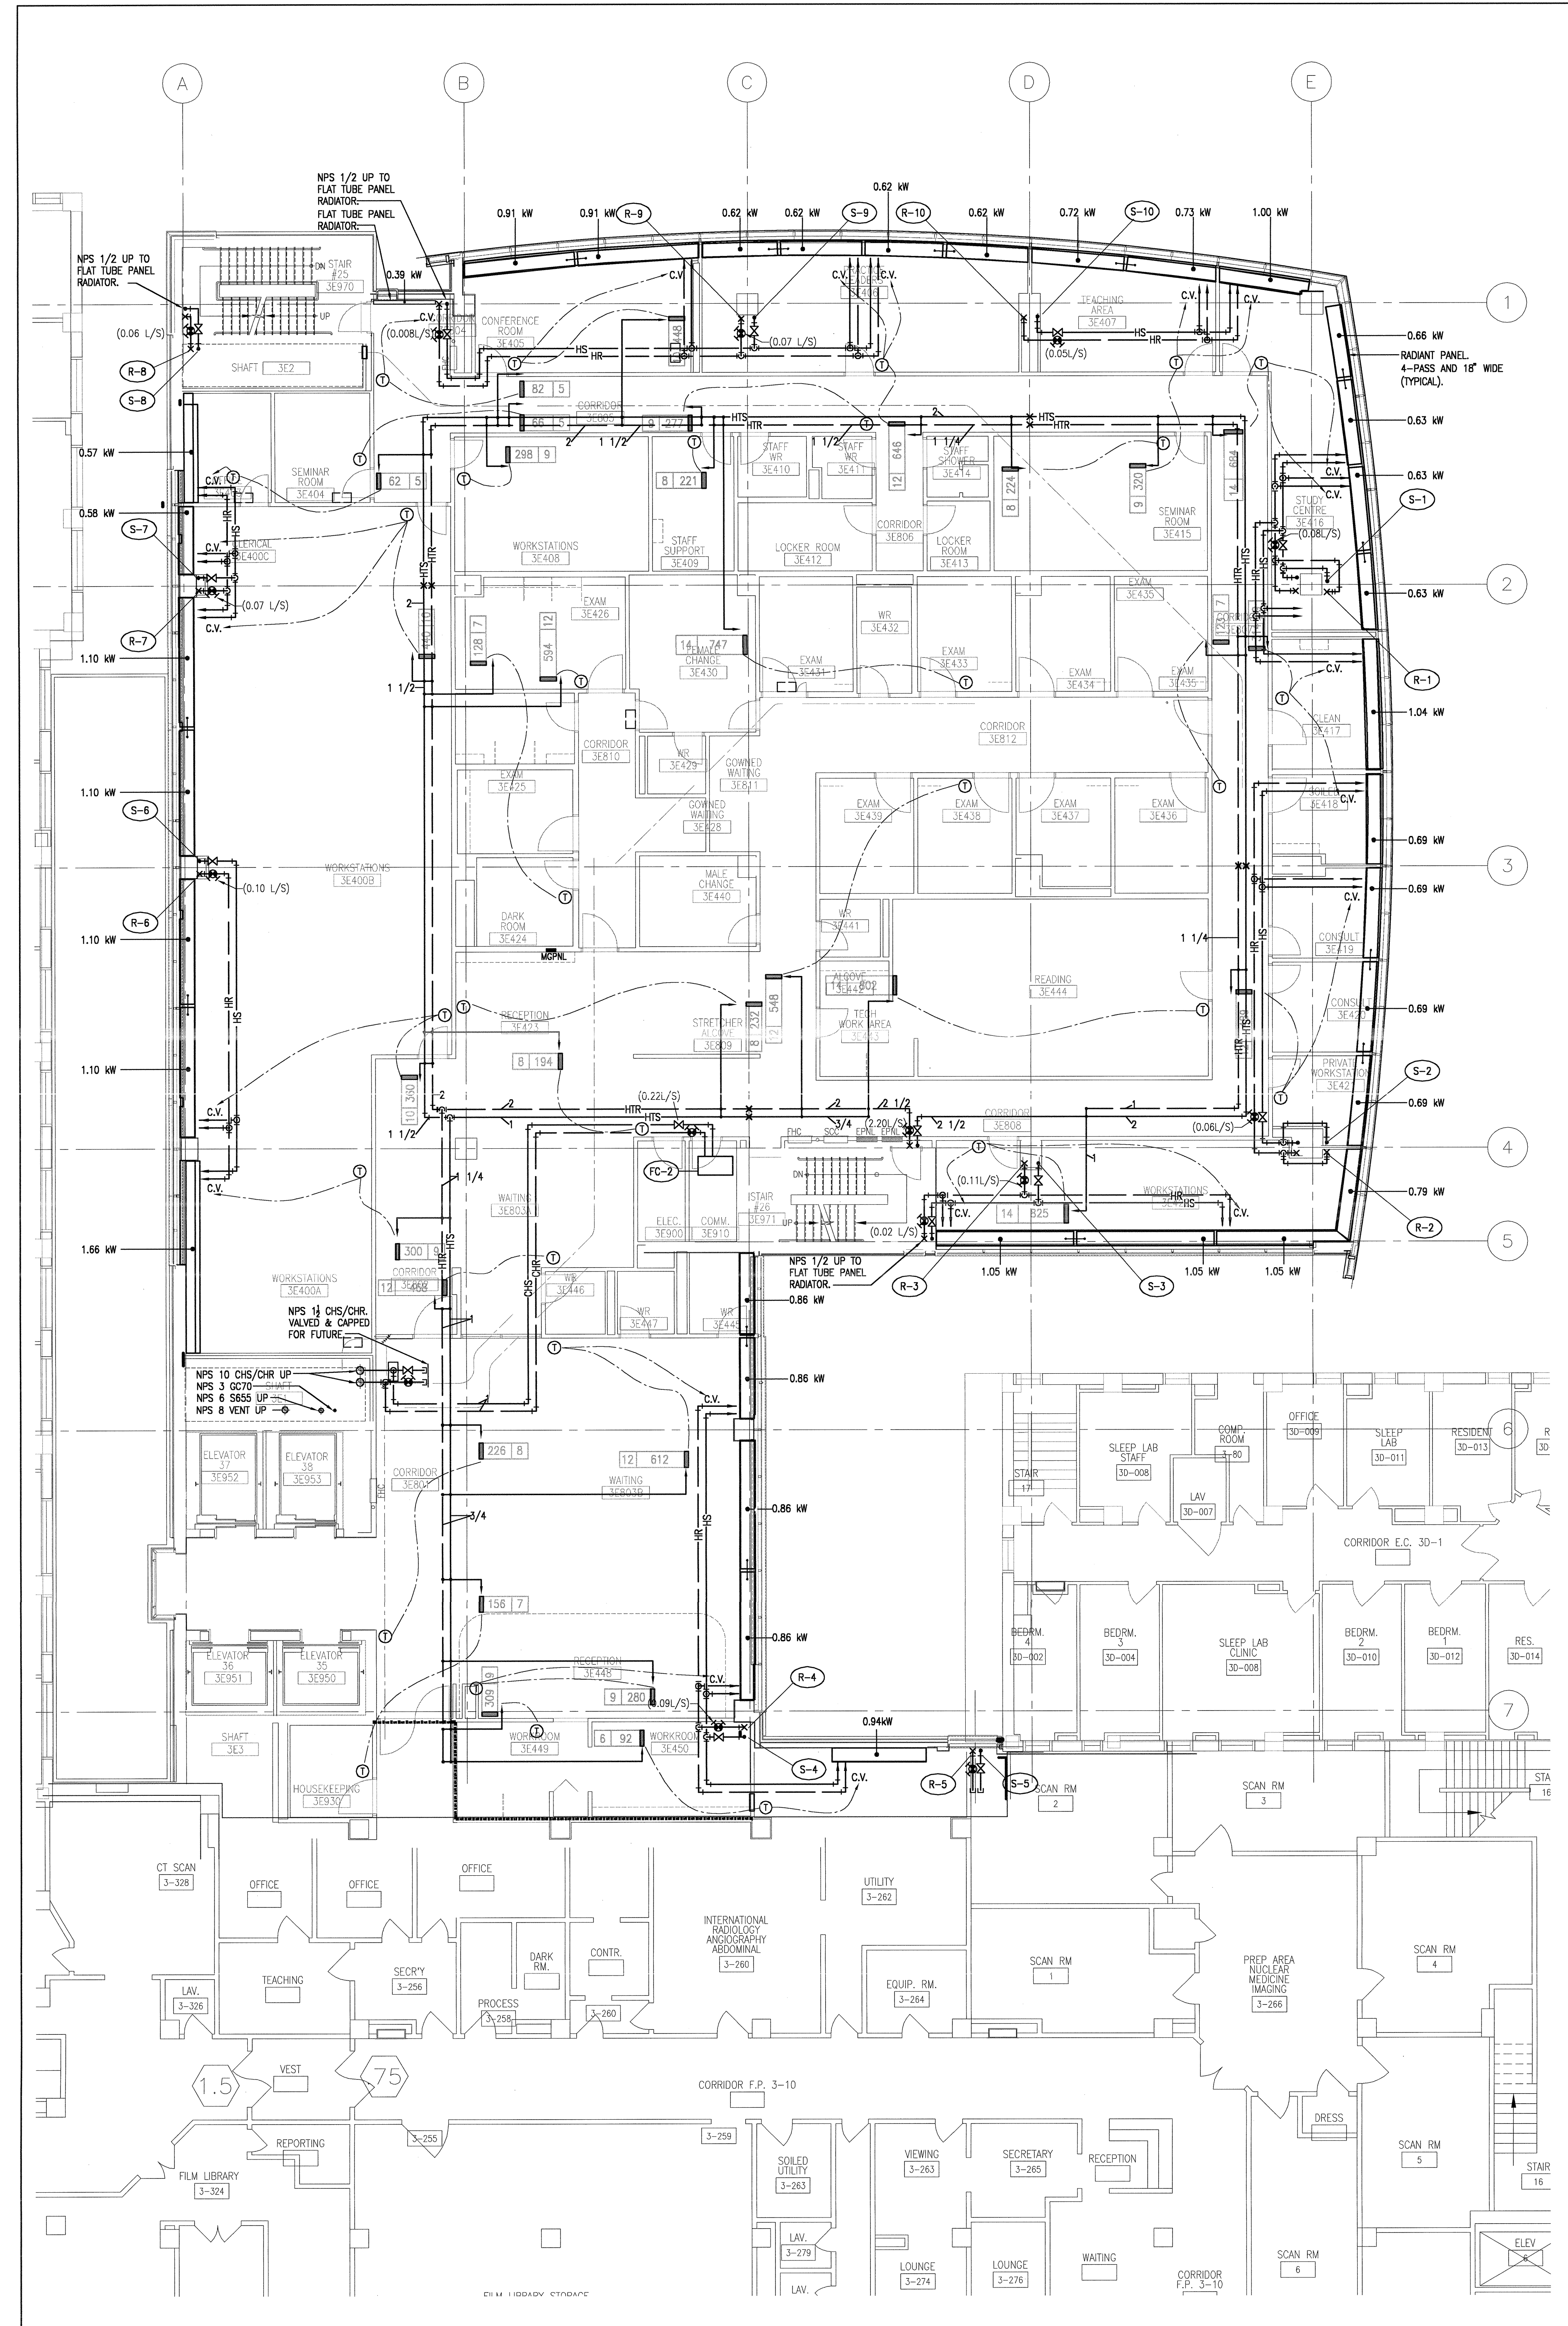

1 LEVEL THREE FLOOR PLAN
603 Scale: 1:100

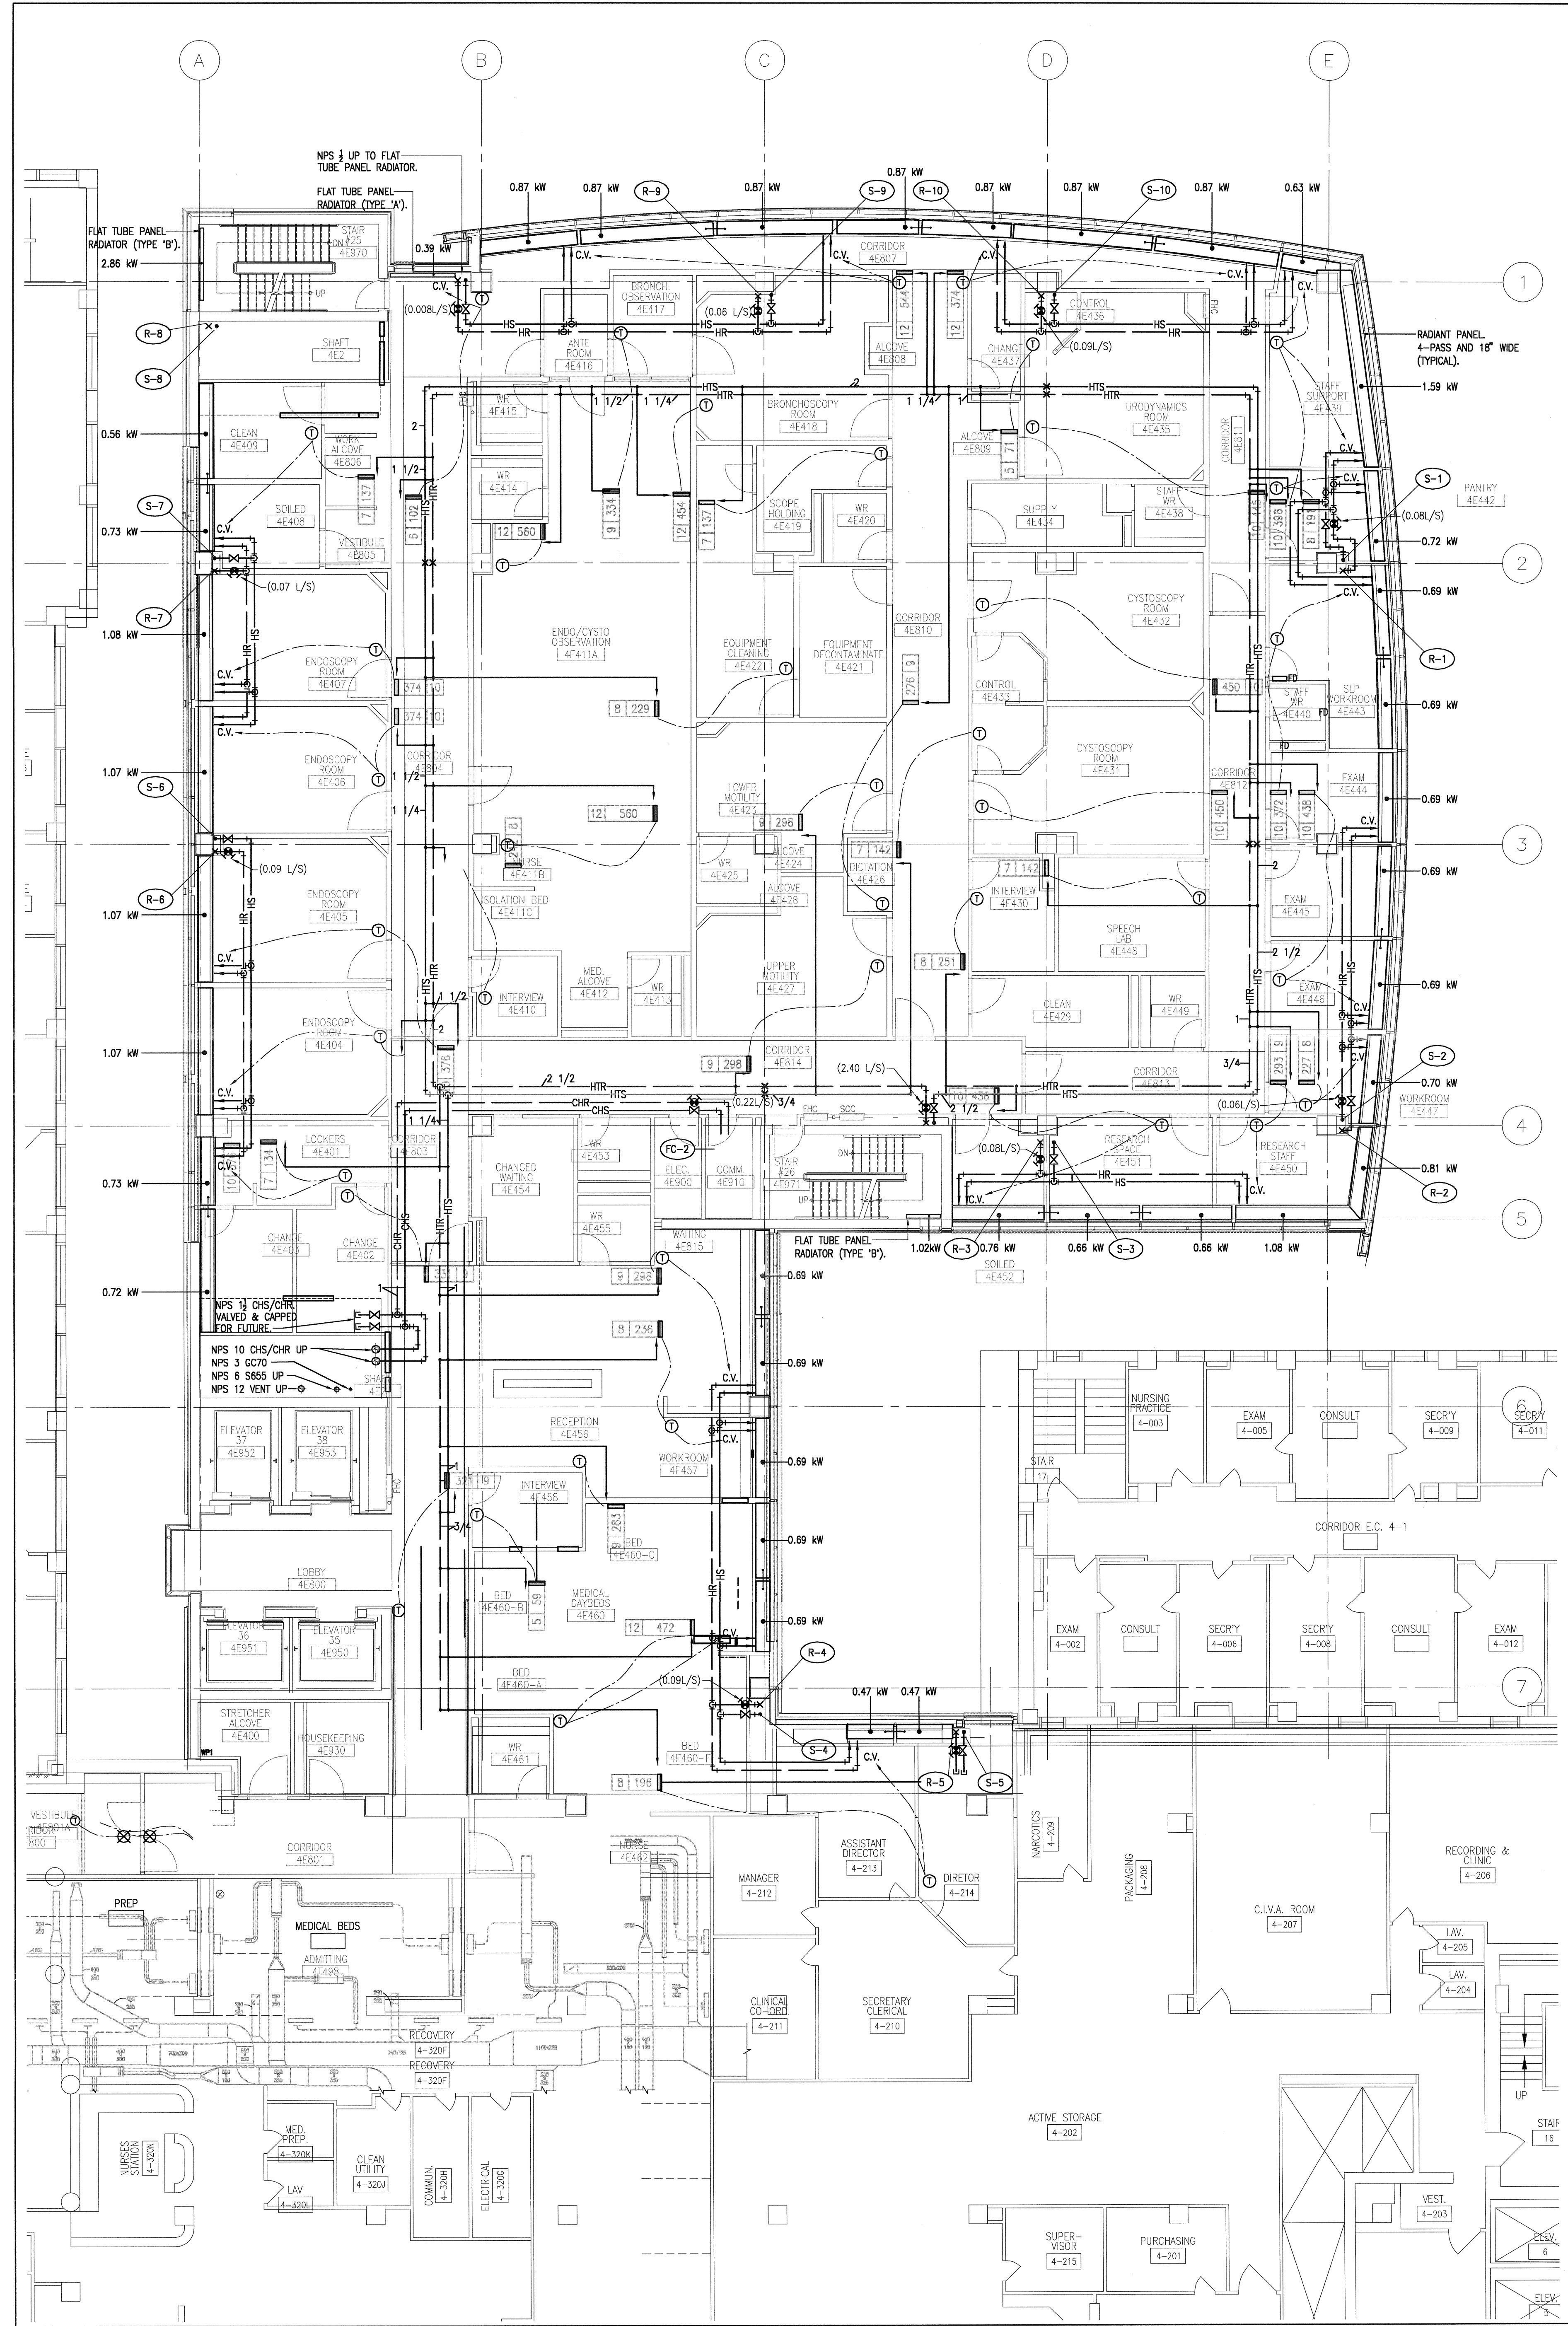


2 LEVEL FOUR FLOOR PLAN
603 Scale: 1:100



Toronto Western Hospital

University Health Network

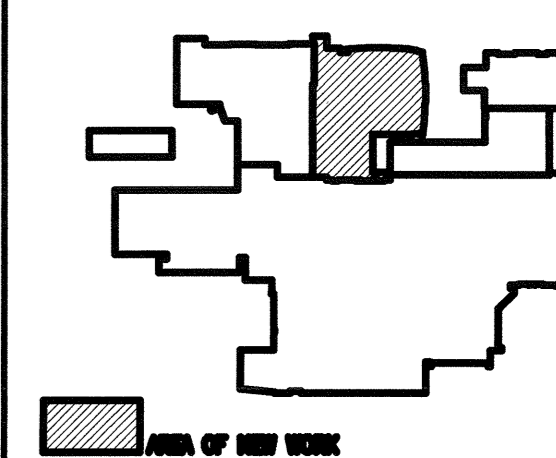


HEAT PLAN (S-2)

10	07/04/00	ISSUED FOR AS BUILT DRAWINGS
9	03/06/00	ISSUED FOR CONSTRUCTION
8	03/05/01	REVISED FOR ADDENDUM M5
7	03/04/01	REVISED FOR ADDENDUM M1
6	03/03/01	ISSUED FOR BUILDING PERMIT
5	03/03/01	ISSUED FOR GENERAL TENDER
4	03/01/01	ISSUED FOR BOM COSTING
3	02/12/01	APPLICATION FOR BUILDING PERMIT
2	02/11/01	ISSUED FOR BOM REVIEW
1	02/09/01	ISSUED FOR CONSTRUCTION

REF. DATE DESCRIPTION
(yr/mm/dd)

CHECK AND VERIFY ALL DIMENSIONS BEFORE PROCEEDING WITH THE WORK.

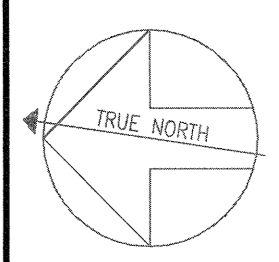


CONSTRUCTION NORTH

AS-BUILT DRAWINGS


PROJECT NAME:
TORONTO WESTERN HOSPITAL
EAST WING REDEVELOPMENT
MAIN BUILDING - STAGE TWO
TORONTO ONTARIO

DRAWING TITLE:
LEVEL 5 FLOOR PLAN
LEVEL 6 FLOOR PLAN
HEATING


SCALE:
1:100
DATE:
MARCH 2003
DRAWN BY:
CHECKED BY:
PROJECT NUMBER:
2011210
DRAWING NUMBER:
M2-604

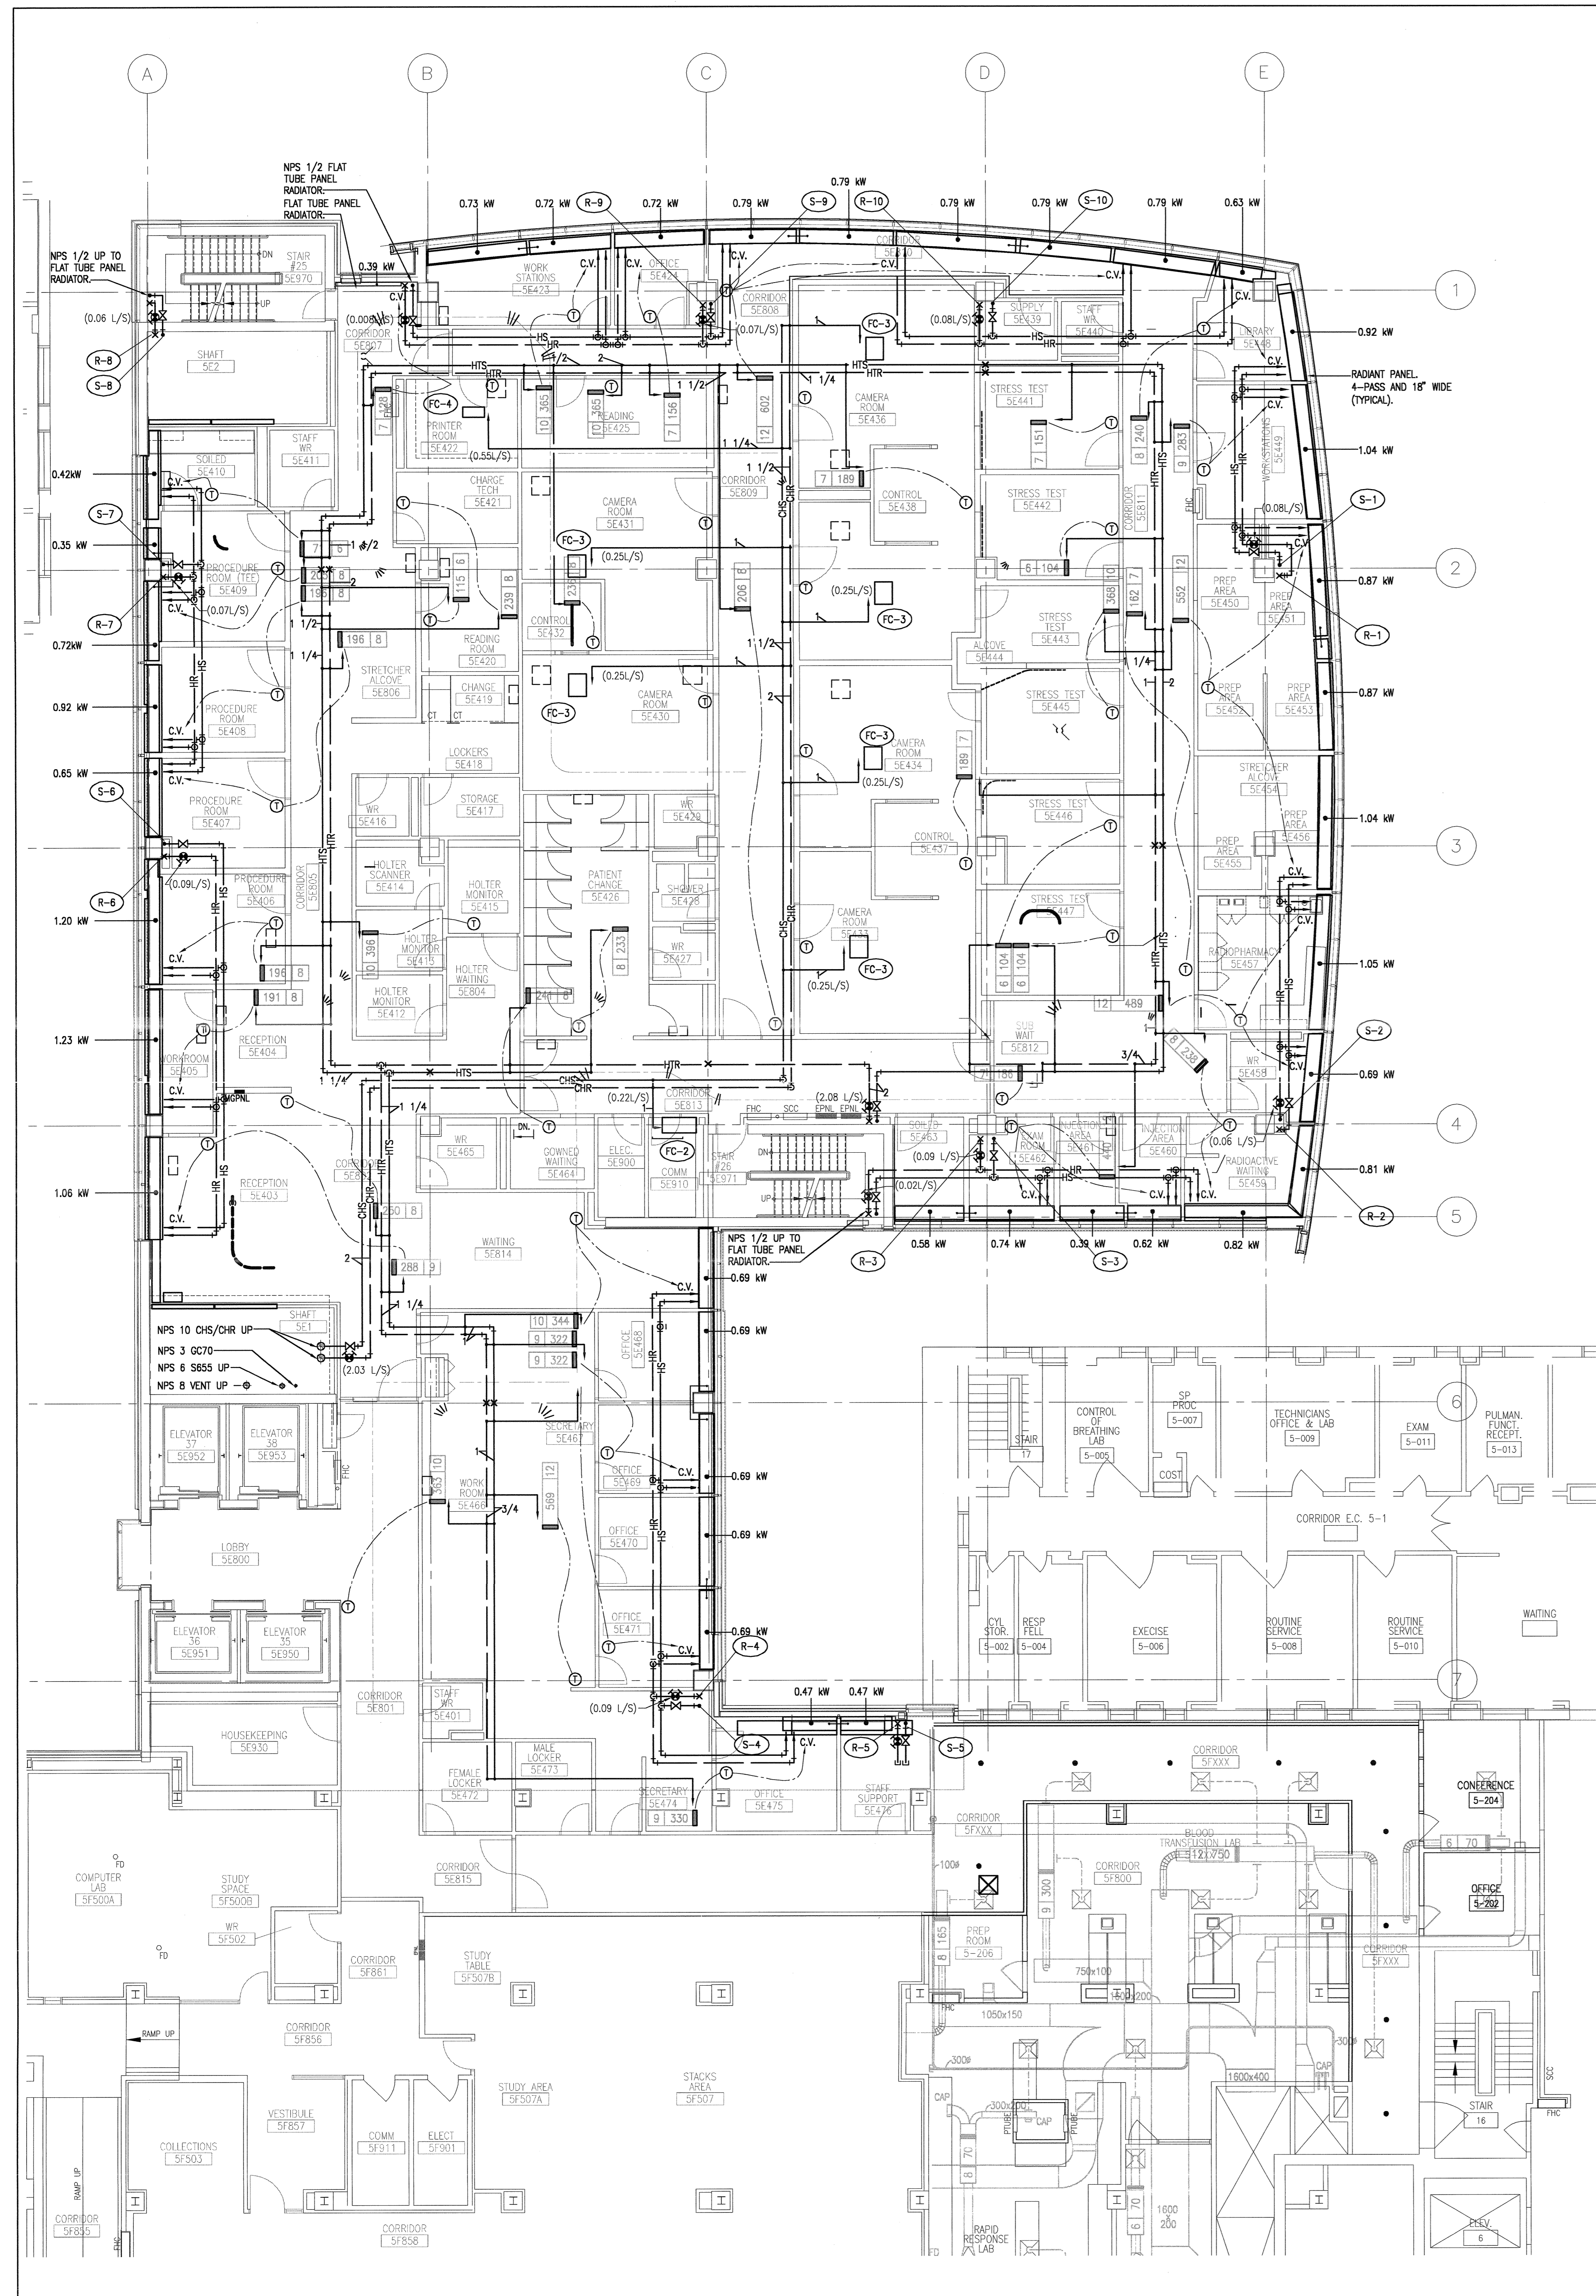

1 LEVEL FIVE FLOOR PLAN
604 Scale: 1:100

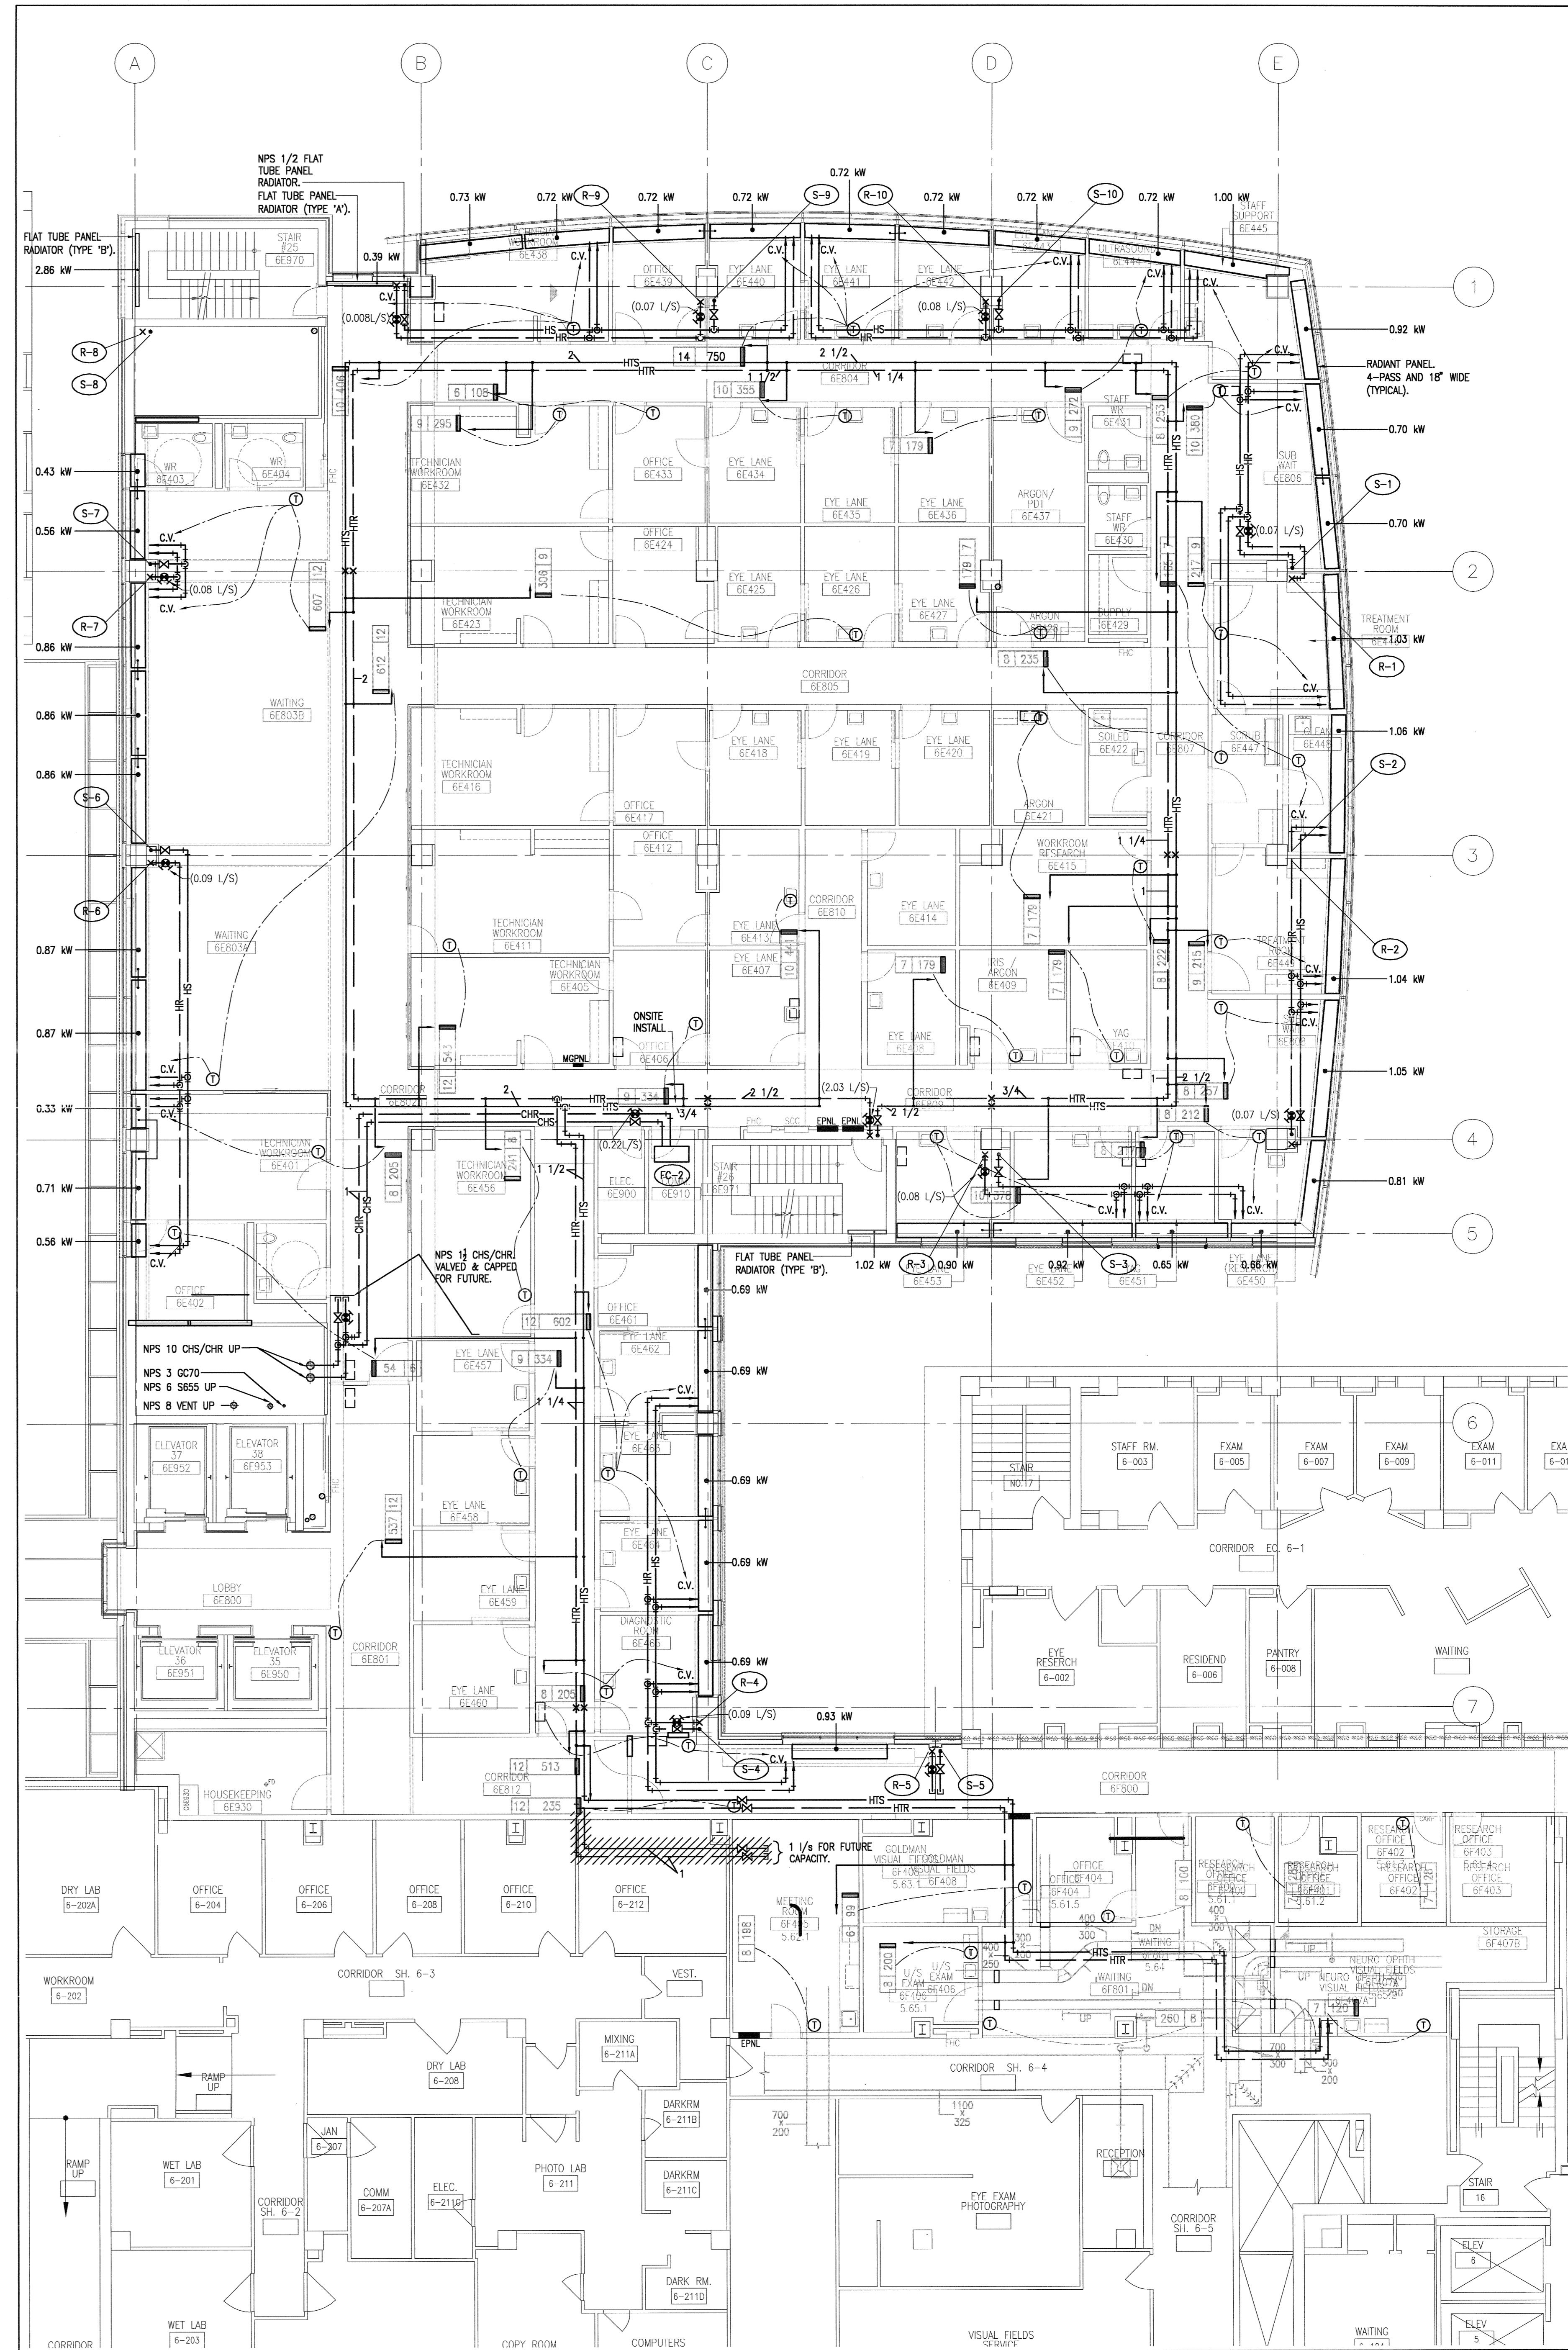


2 LEVEL SIX FLOOR PLAN
604 Scale: 1:100

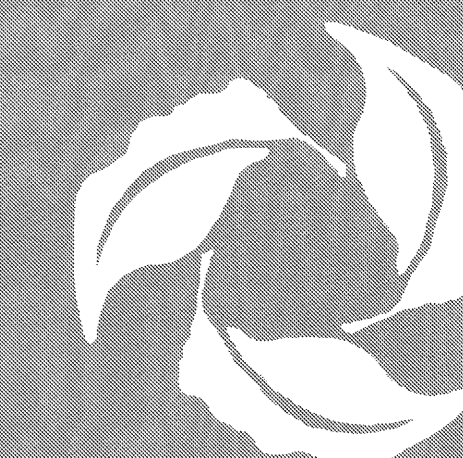

Toronto Western Hospital

University Health Network

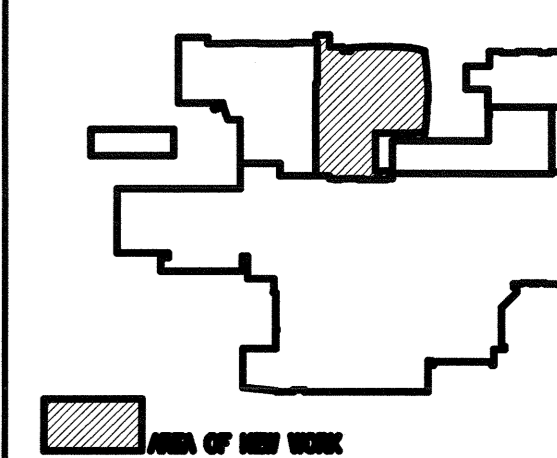


REF PLAN (202)

9	07/04/20	ISSUED FOR AS-BUILT DRAWINGS
8	03/06/20	ISSUED FOR CONSTRUCTION
7	03/04/11	REVISED FOR ADDENDUM M1
6	03/03/27	ISSUED FOR BUILDING PERMIT
5	03/03/18	ISSUED FOR GENERAL TENDER
4	03/01/29	ISSUED FOR BOX COSTING
3	02/12/19	APPLICATION FOR BUILDING PERMIT
2	02/11/17	ISSUED FOR BOX REVIEW
1	02/09/16	ISSUED FOR COSTING

REF. DATE DESCRIPTION
(yr/mm/dd)

CHECK AND VERIFY ALL DIMENSIONS BEFORE PROCEEDING WITH THE WORK.

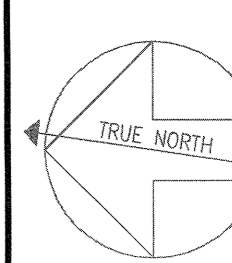


CONSTRUCTION NORTH

AS-BUILT DRAWINGS


PROJECT NAME:
TORONTO WESTERN HOSPITAL
EAST WING REDEVELOPMENT
MAIN BUILDING - STAGE TWO
TORONTO ONTARIO

DRAWING TITLE:
LEVEL 7 FLOOR PLAN
LEVEL 8 FLOOR PLAN
HEATING





SCALE:
1 : 100
DATE:
MARCH 2003
DRAWN BY:
CHECKED BY:
PROJECT NUMBER:
2011210
DRAWING NUMBER:
M2-605



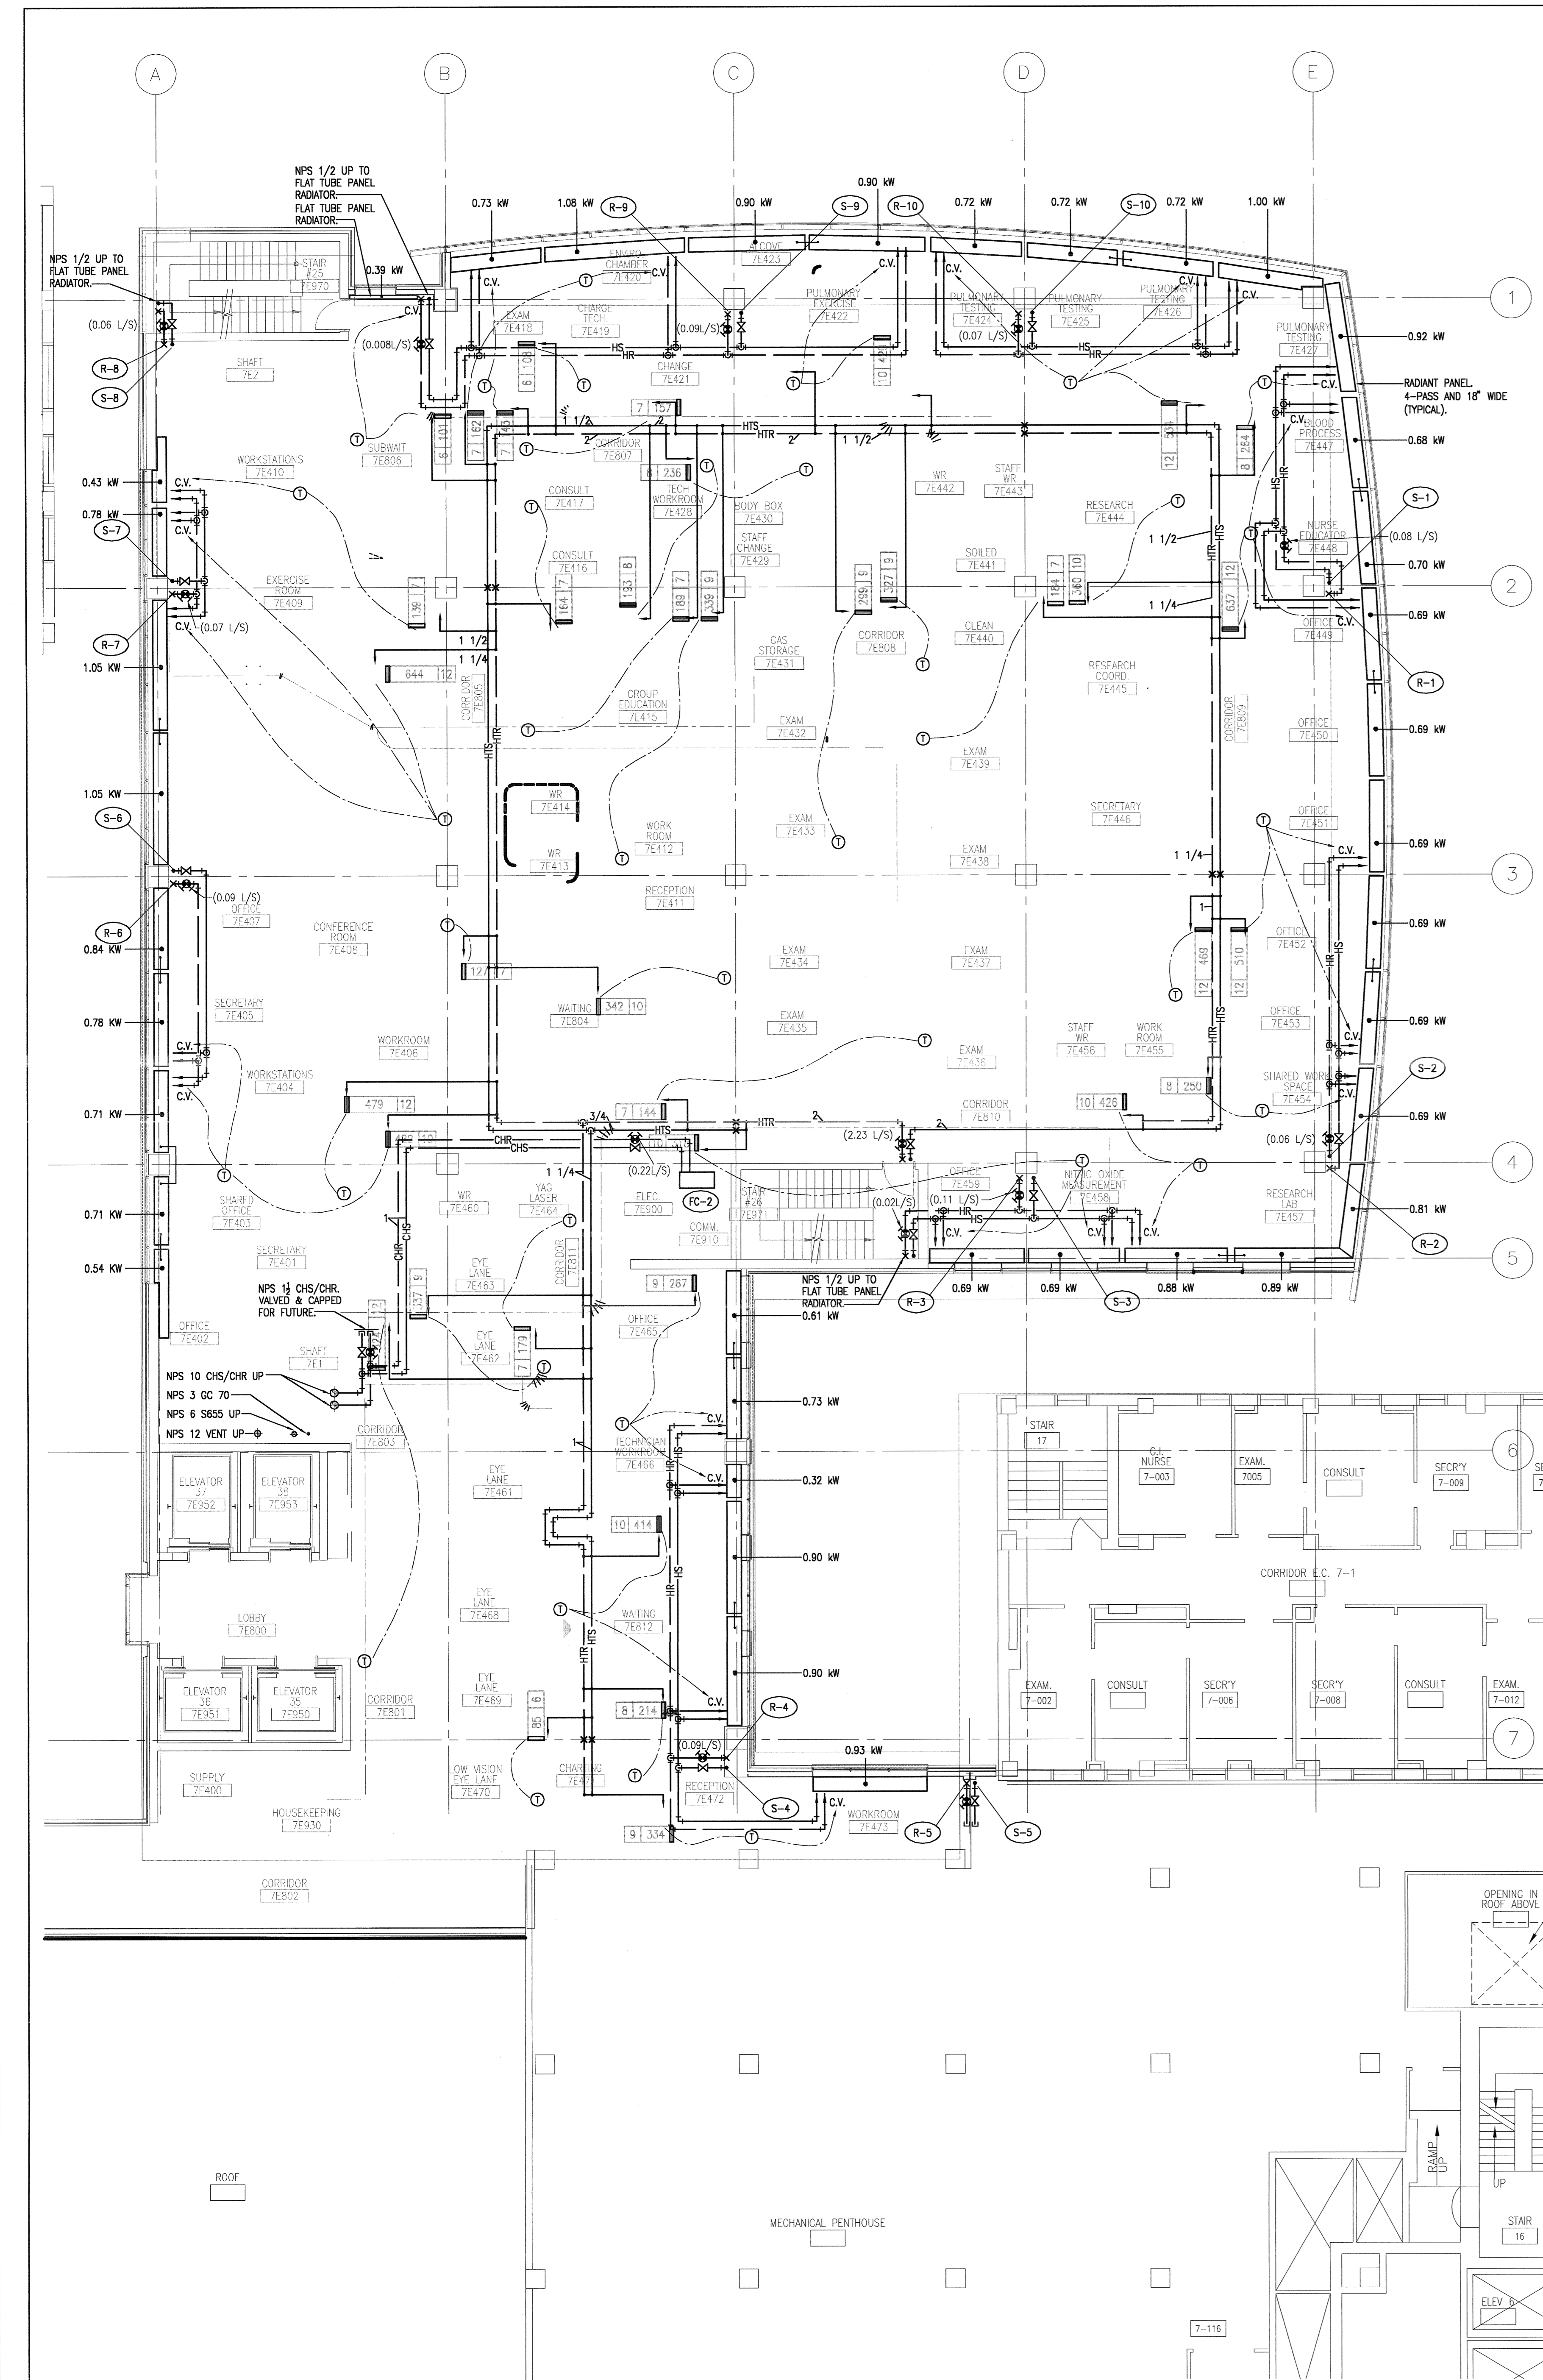



1 LEVEL SEVEN FLOOR PLAN
605 Scale: 1:100

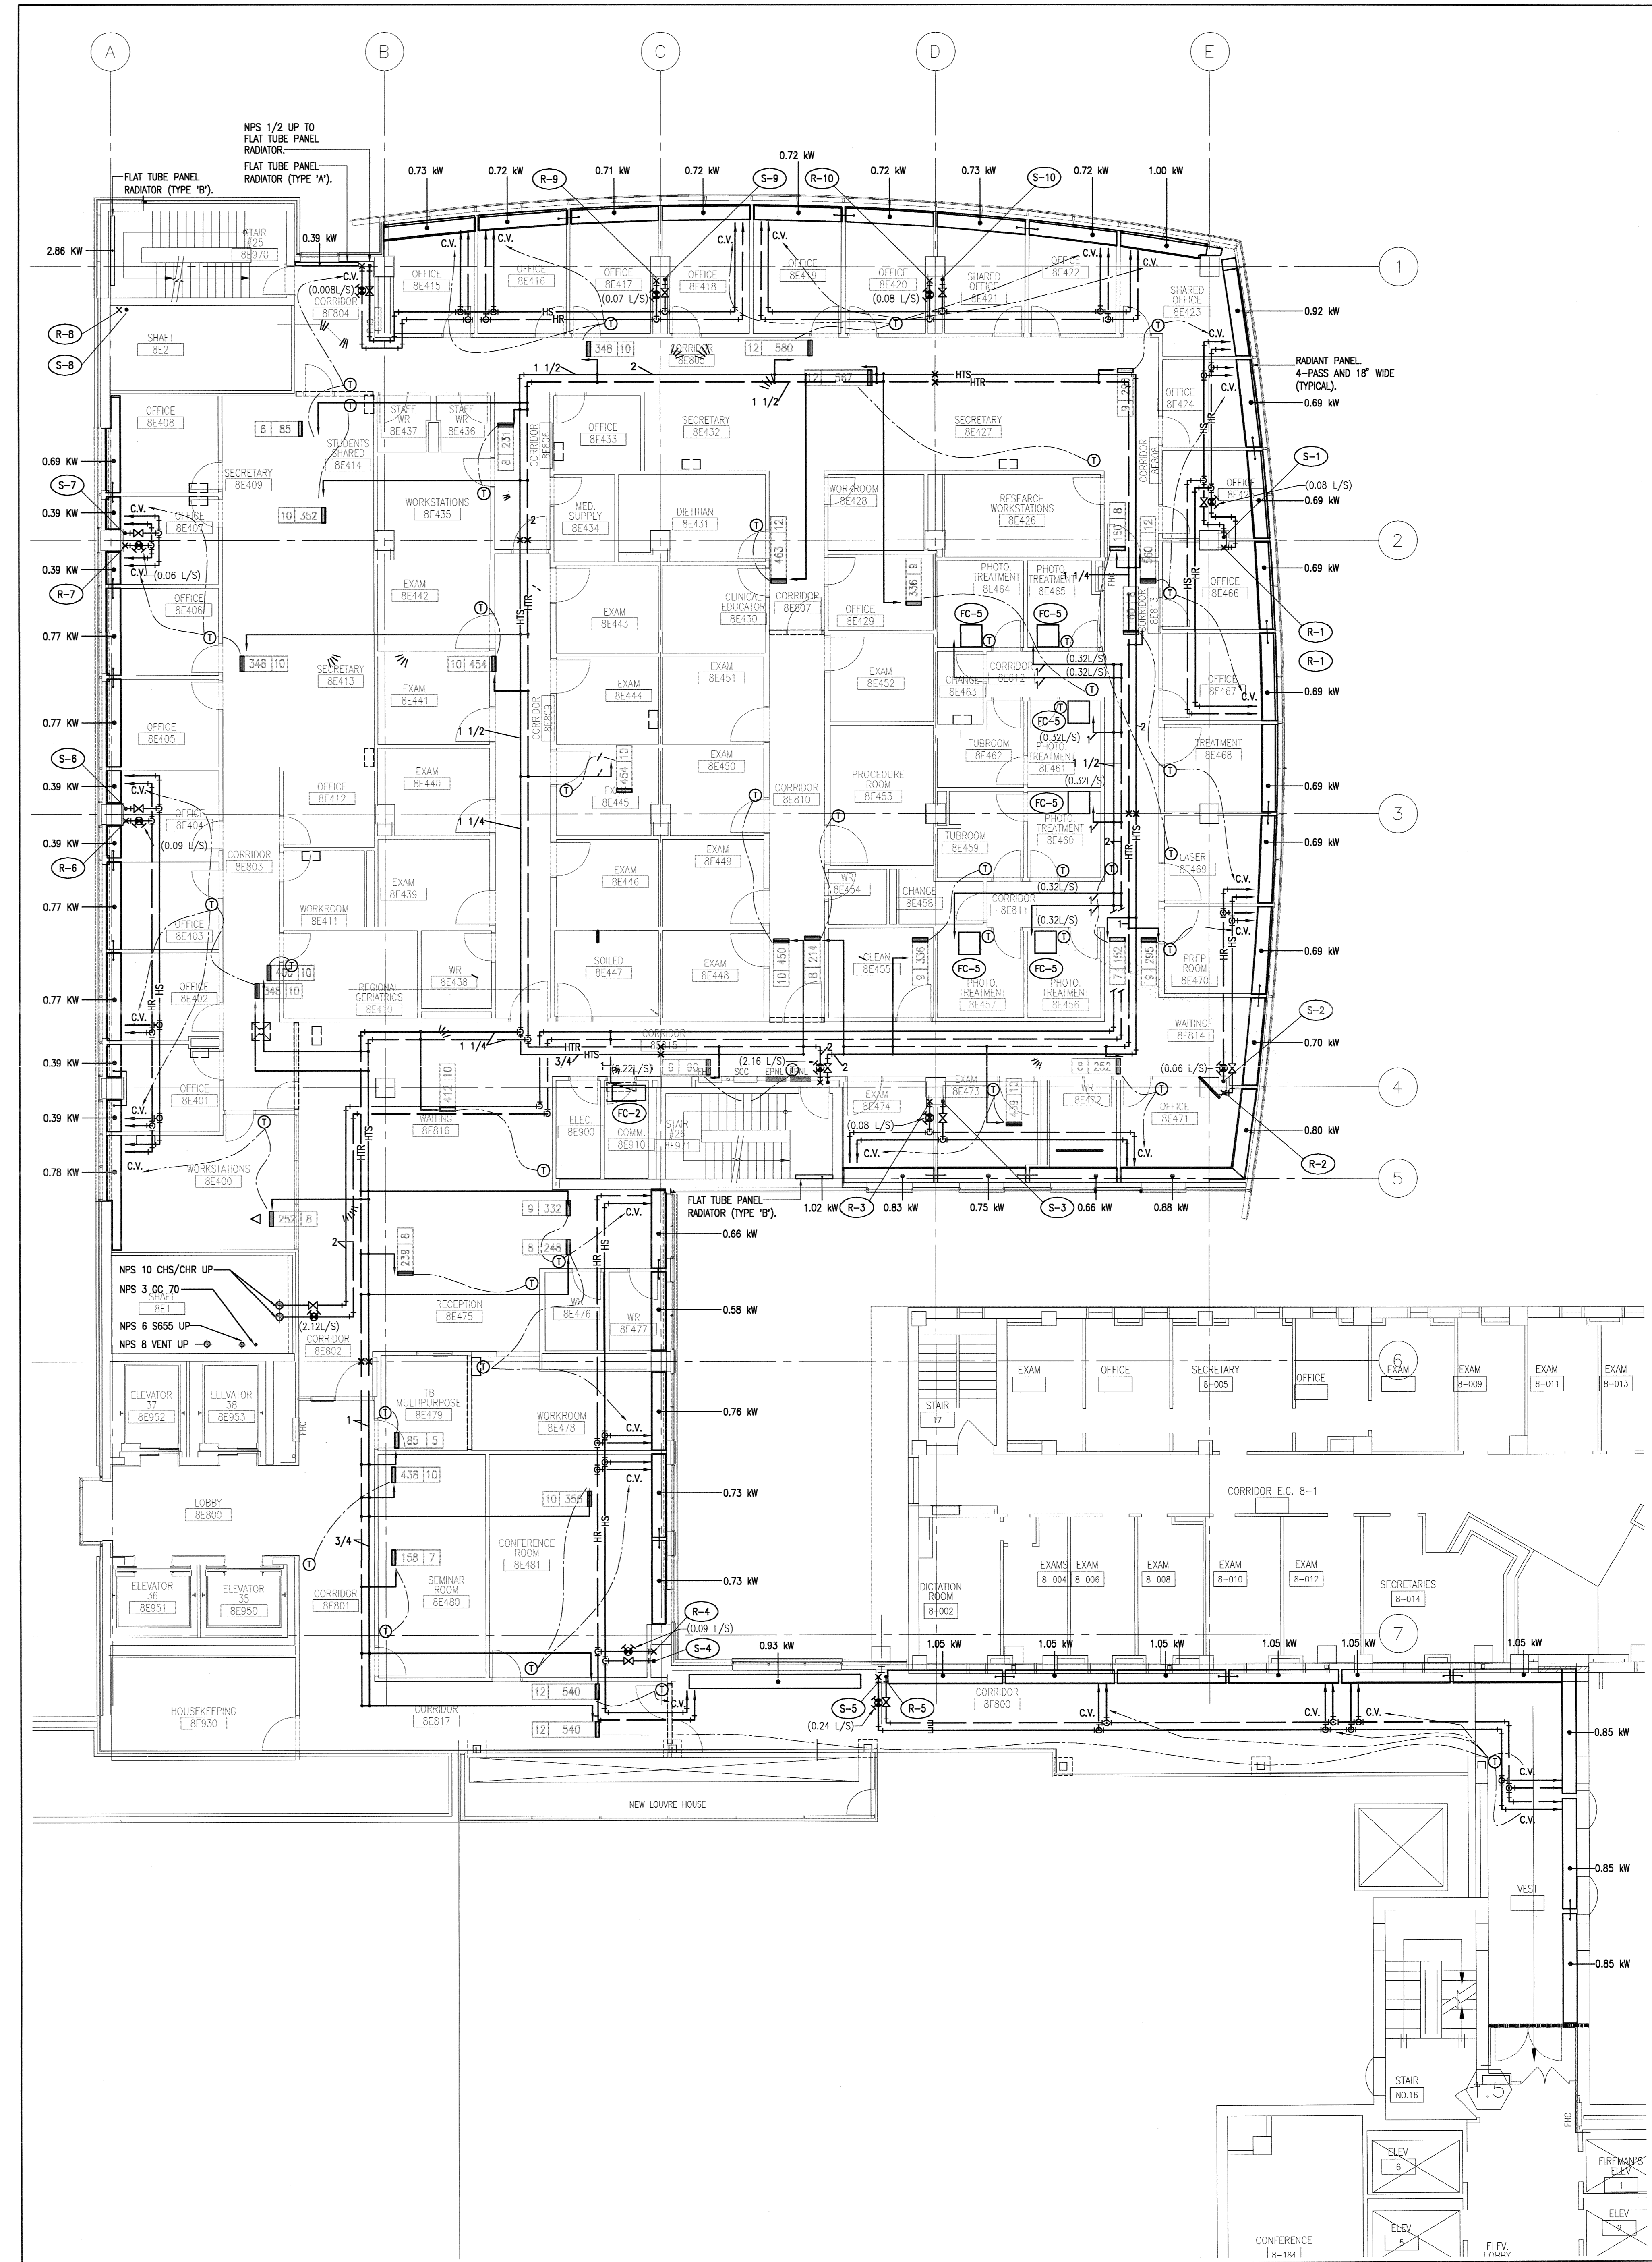

2 LEVEL EIGHT FLOOR PLAN
605 Scale: 1:100

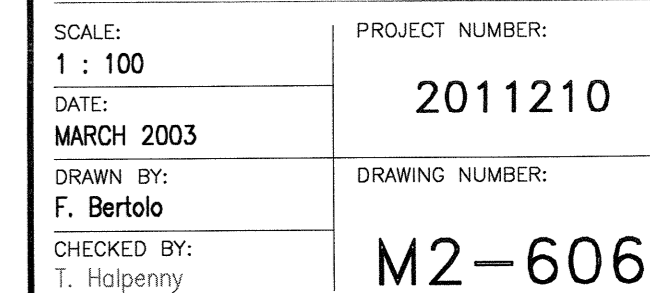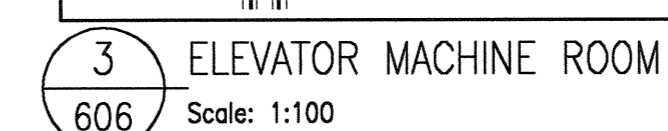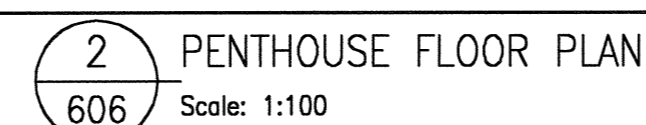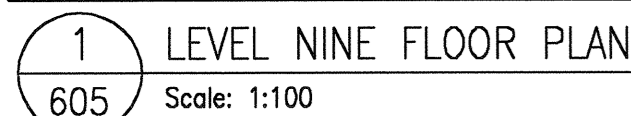


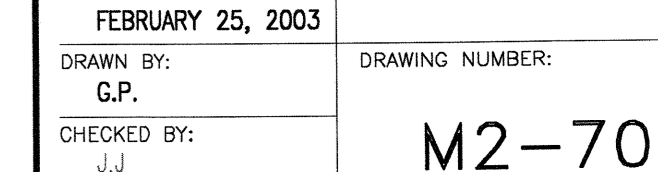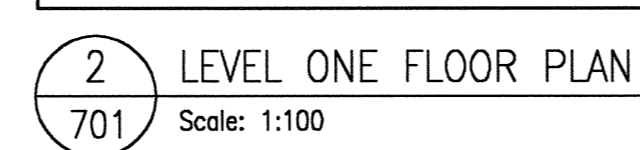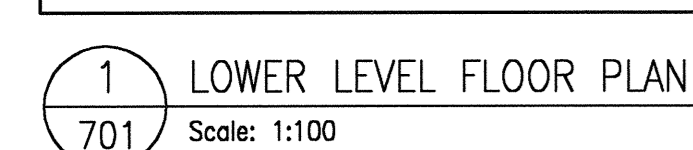

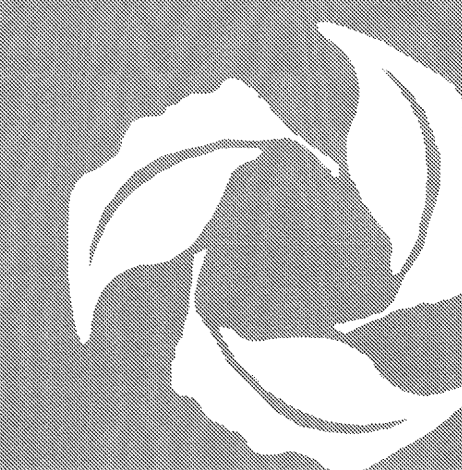

Toronto Western Hospital

University Health Network

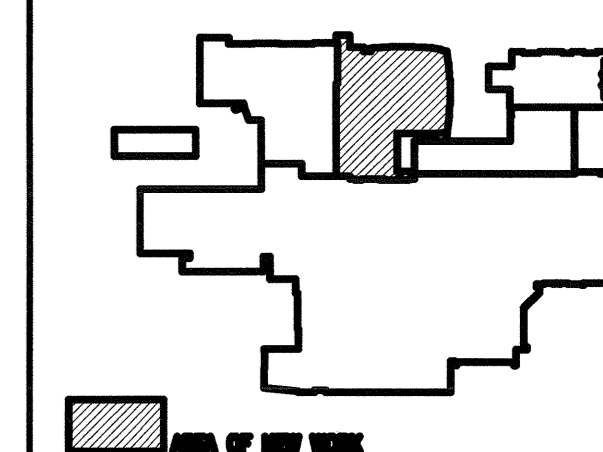


107 FLM (K1A)

9	07/04/30	ISSUED FOR AS-BUILT DRAWINGS
8	03/06/30	ISSUED FOR CONSTRUCTION
7	03/04/1	REVISED FOR ADDENDUM M1
6	03/03/27	ISSUED FOR BUILDING PERMIT
5.1	03/03/27	ISSUED FOR GENERAL TENDER
5	03/03/18	ISSUED FOR GENERAL TENDER
4	03/01/29	ISSUED FOR SITE COSTING
3	02/12/19	APPLICATION FOR BUILDING PERMIT
2	02/11/17	ISSUED FOR 80% REVIEW
1	02/09/16	ISSUED FOR COSTING

REF. DATE DESCRIPTION
(w/revs/des)

CHECK AND VERIFY ALL DIMENSIONS BEFORE PROCEEDING WITH THE WORK. DO NOT SCALE DRAWINGS.

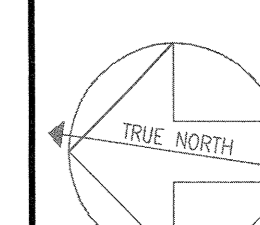

CONSTRUCTION NORTH


AS-BUILT DRAWINGS

PROJECT NAME:
TORONTO WESTERN HOSPITAL
EAST WING REDEVELOPMENT
MAIN BUILDING - STAGE TWO
TORONTO ONTARIO

DRAWING TITLE:
LEVEL 2 FLOOR PLAN
LEVEL 3 FLOOR PLAN
FIRE PROTECTION

SCALE:
1 : 100
DATE:
FEBRUARY 25, 2003
DRAWN BY:
C.P.
CHECKED BY:
J.J.

PROJECT NUMBER:
2011210
DRAWING NUMBER:
M2-702

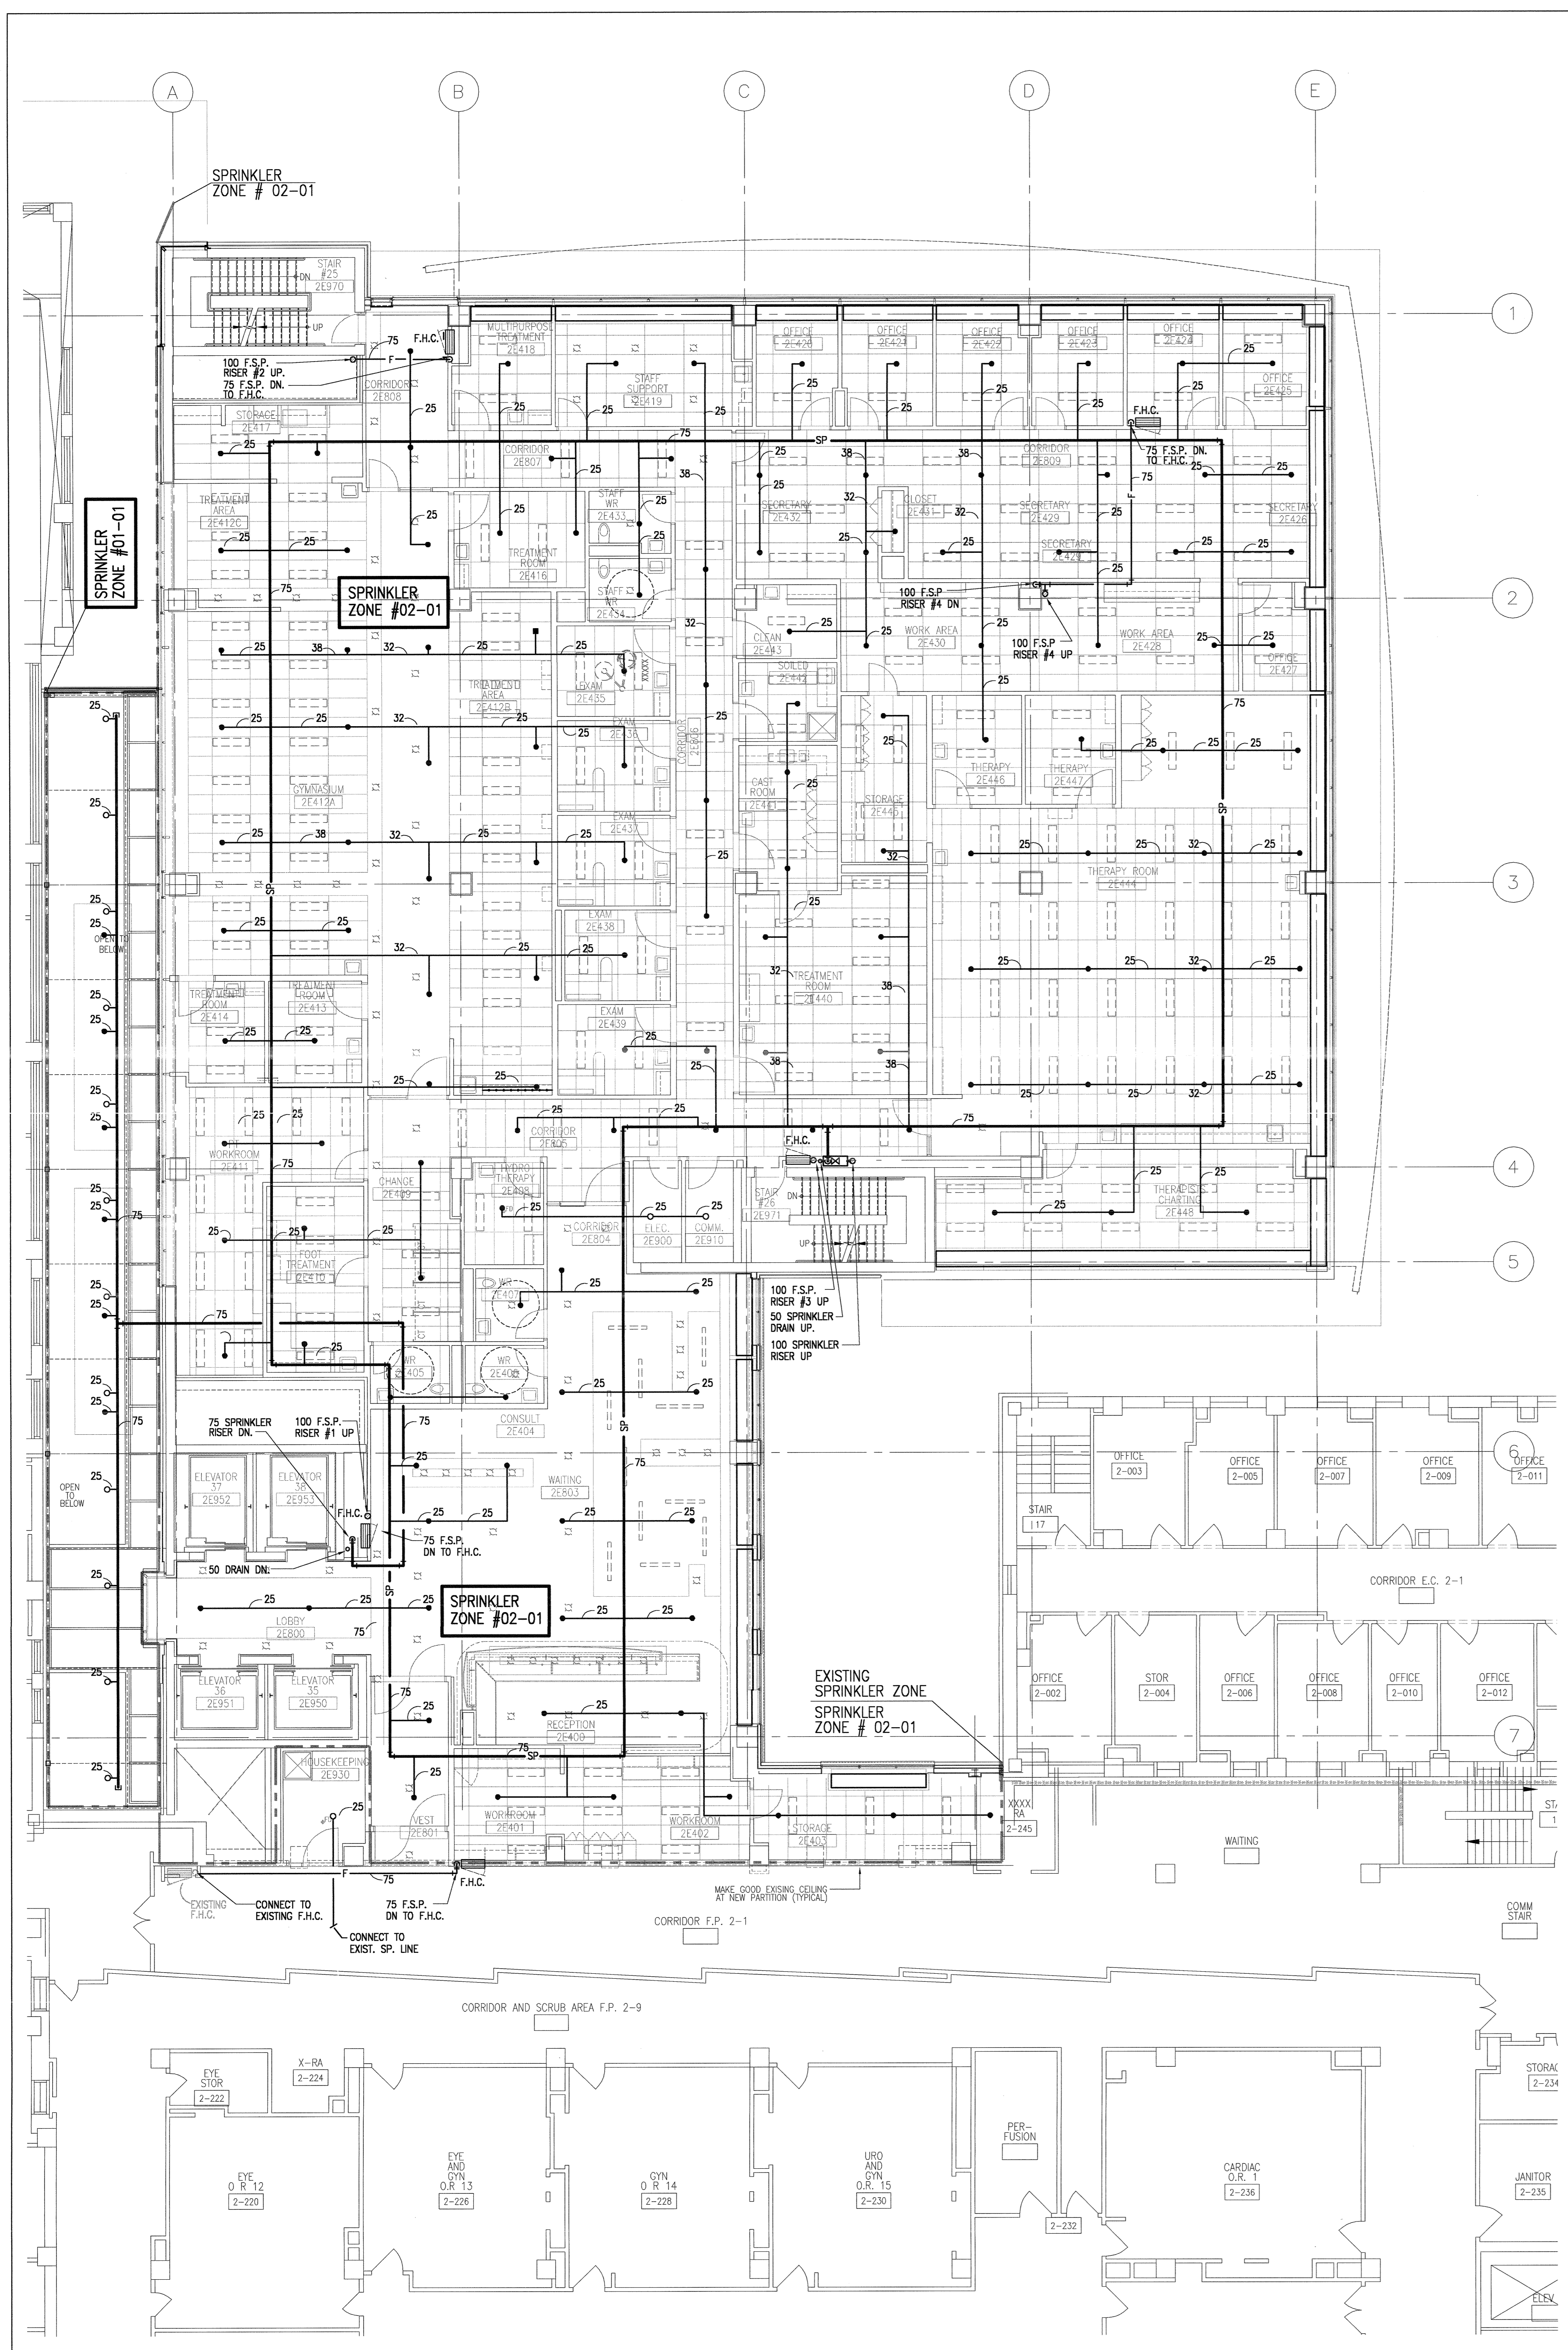

1 LEVEL TWO FLOOR PLAN
702 Scale: 1:100




2 LEVEL THREE FLOOR PLAN
702 Scale: 1:100



Toronto Western Hospital

University Health Network

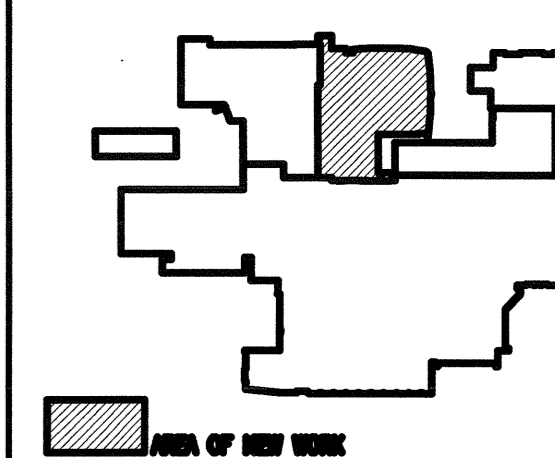


REF PLAN (2012)

9	07/04/20	ISSUED FOR AS-BUILT DRAWINGS
8	03/06/20	ISSUED FOR CONSTRUCTION
7	03/04/11	REVISED FOR ADDENDUM M1
6	03/03/27	ISSUED FOR BUILDING PERMIT
5	03/03/18	ISSUED FOR GENERAL TENDER
4	03/01/29	APPLICATION FOR BUILDING PERMIT
3	02/12/19	ISSUED FOR BOOK REVIEW
2	02/11/17	ISSUED FOR BOOK REVIEW
1	02/08/16	ISSUED FOR COSTING

REF. DATE DESCRIPTION
(y/m/dm/50)

CHECK AND VERIFY ALL DIMENSIONS BEFORE PROCEEDING WITH THE WORK. DO NOT SCALE DRAWINGS.

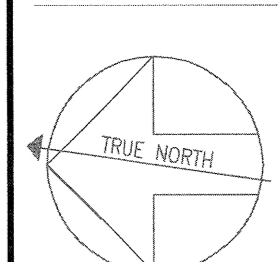

CONSTRUCTION NORTH

AS-BUILT DRAWINGS

PROJECT NAME:
TORONTO WESTERN HOSPITAL
EAST WING REDEVELOPMENT
MAIN BUILDING - STAGE TWO
TORONTO ONTARIO

DRAWING TITLE:
LEVEL 4 FLOOR PLAN
LEVEL 5 FLOOR PLAN
FIRE PROTECTION

SCALE:
1 : 100

DATE:
FEBRUARY 25, 2003


DRAWN BY:
G.P.

CHECKED BY:
J.L.


PROJECT NUMBER:
2011210

DRAWING NUMBER:
M2-703


M300

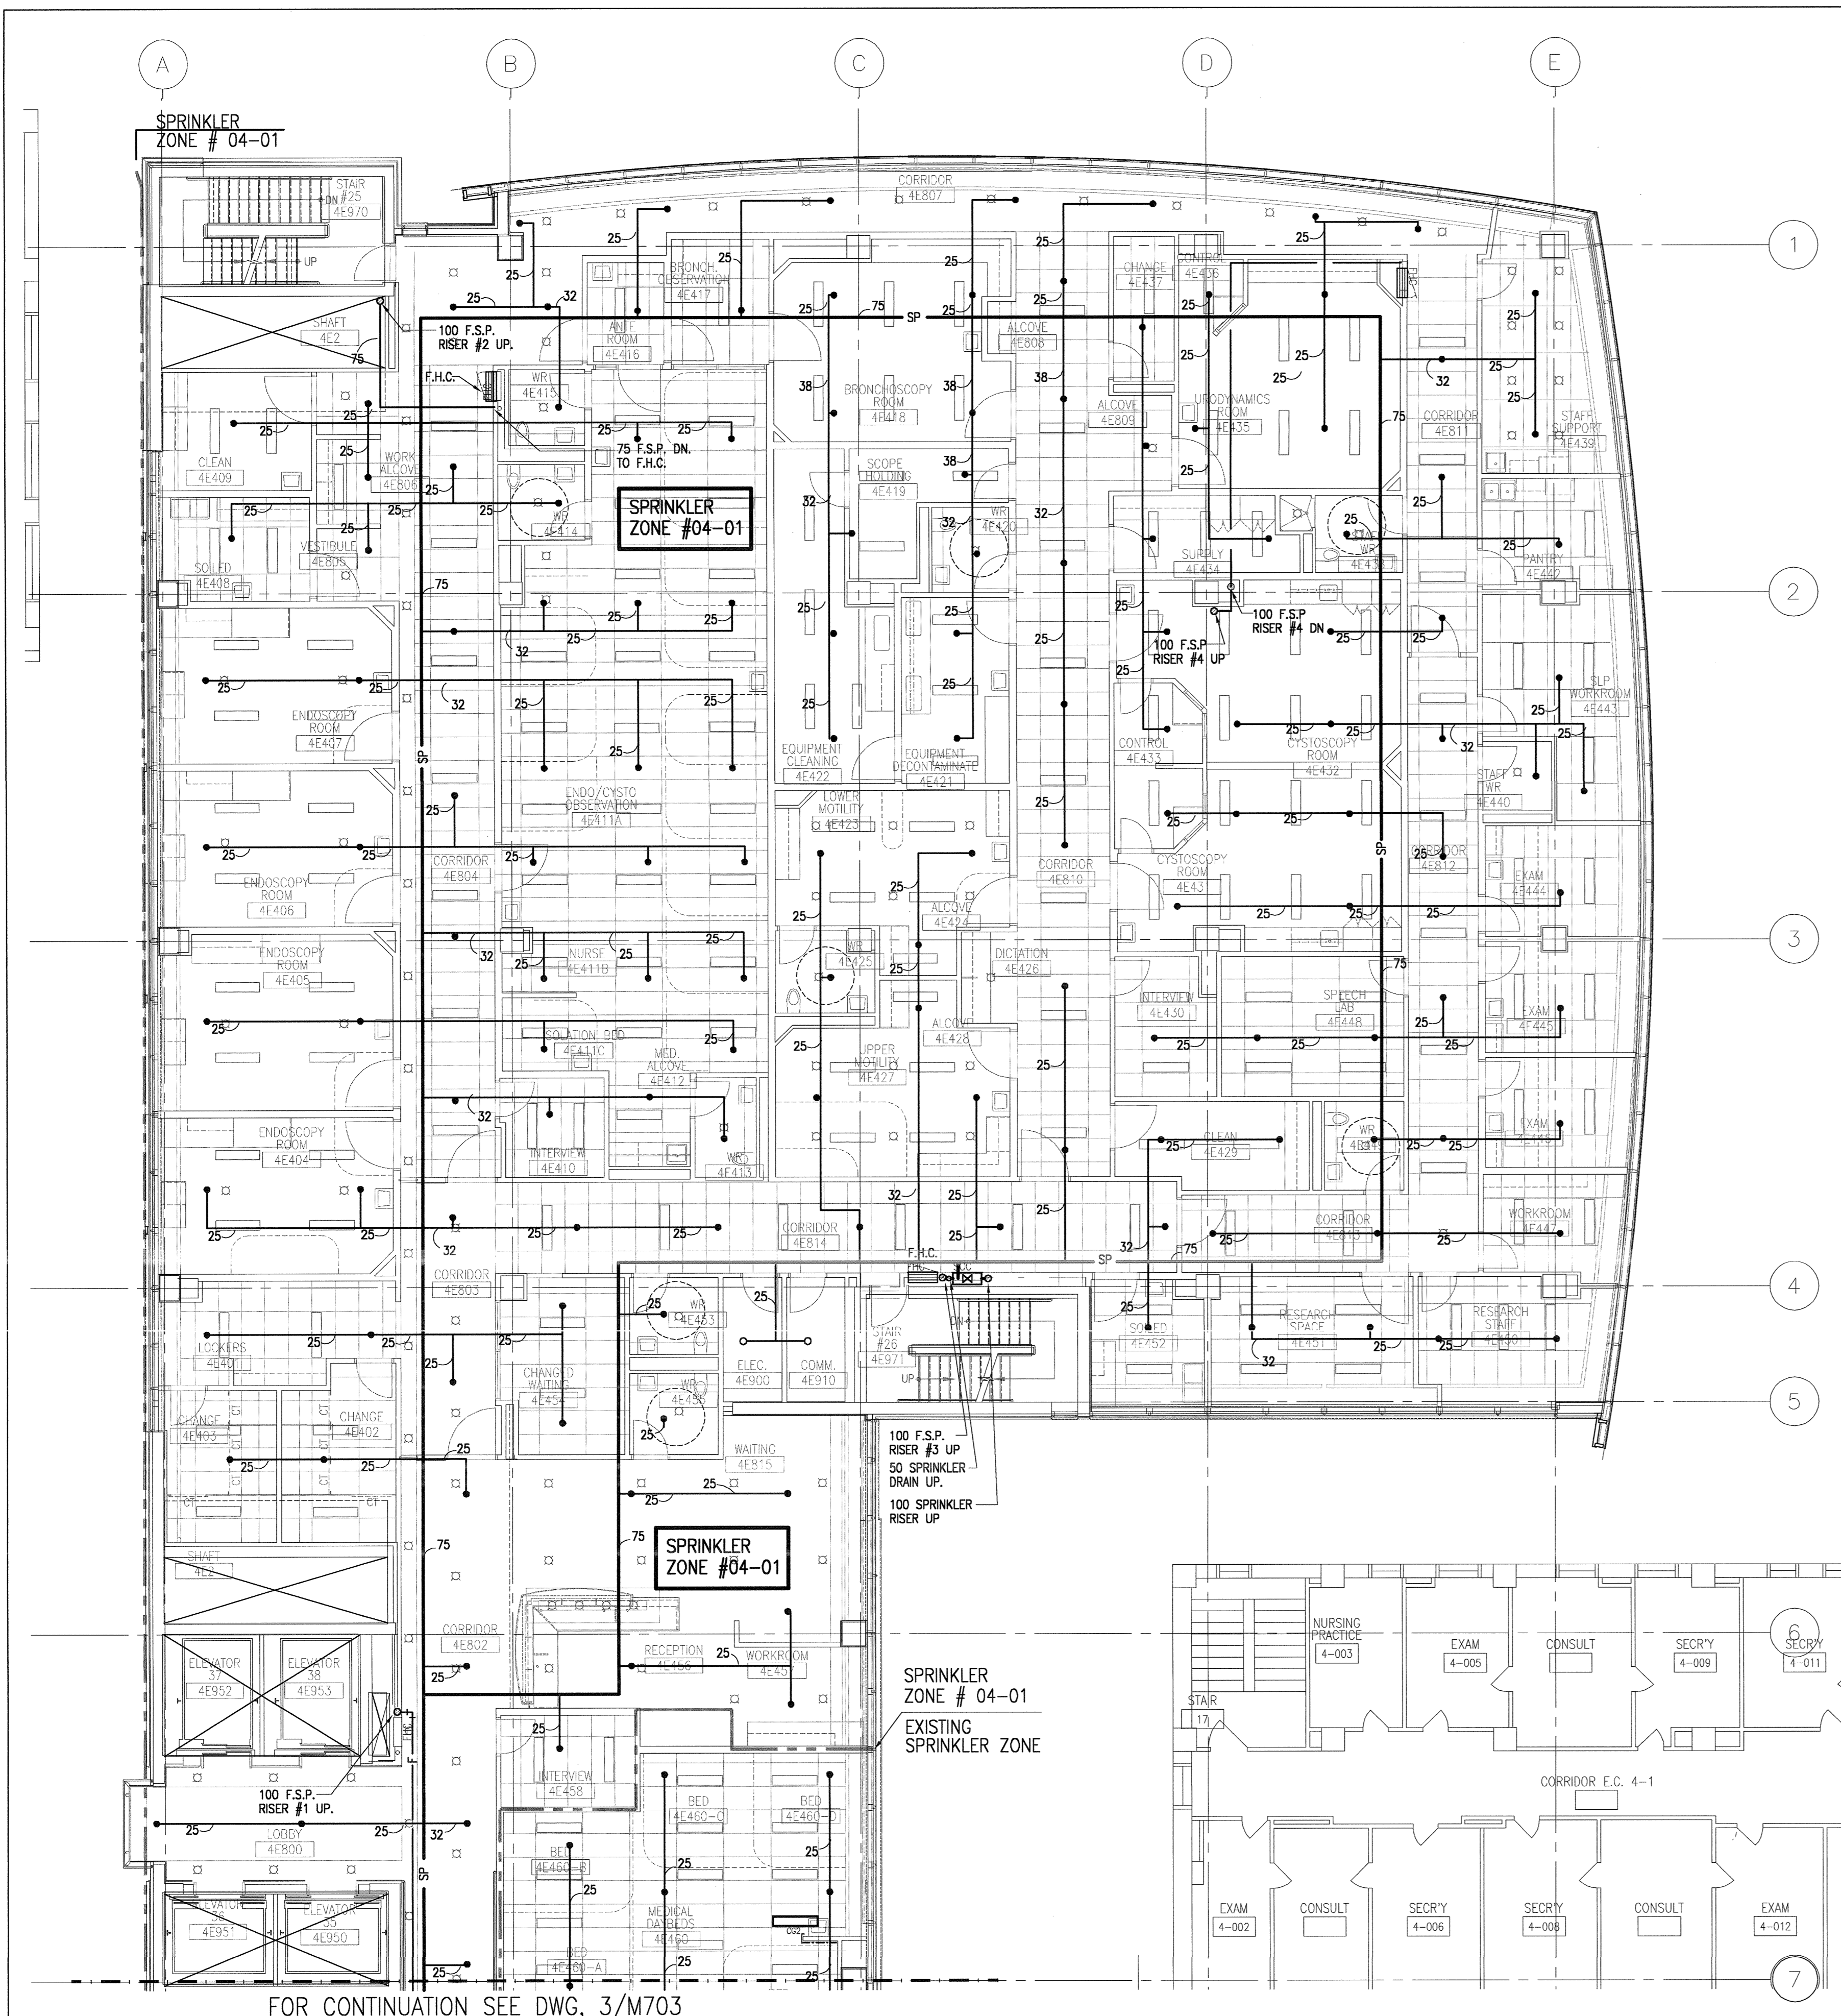


4 LEVEL FOUR FLOOR PLAN
703 Scale: 1:100

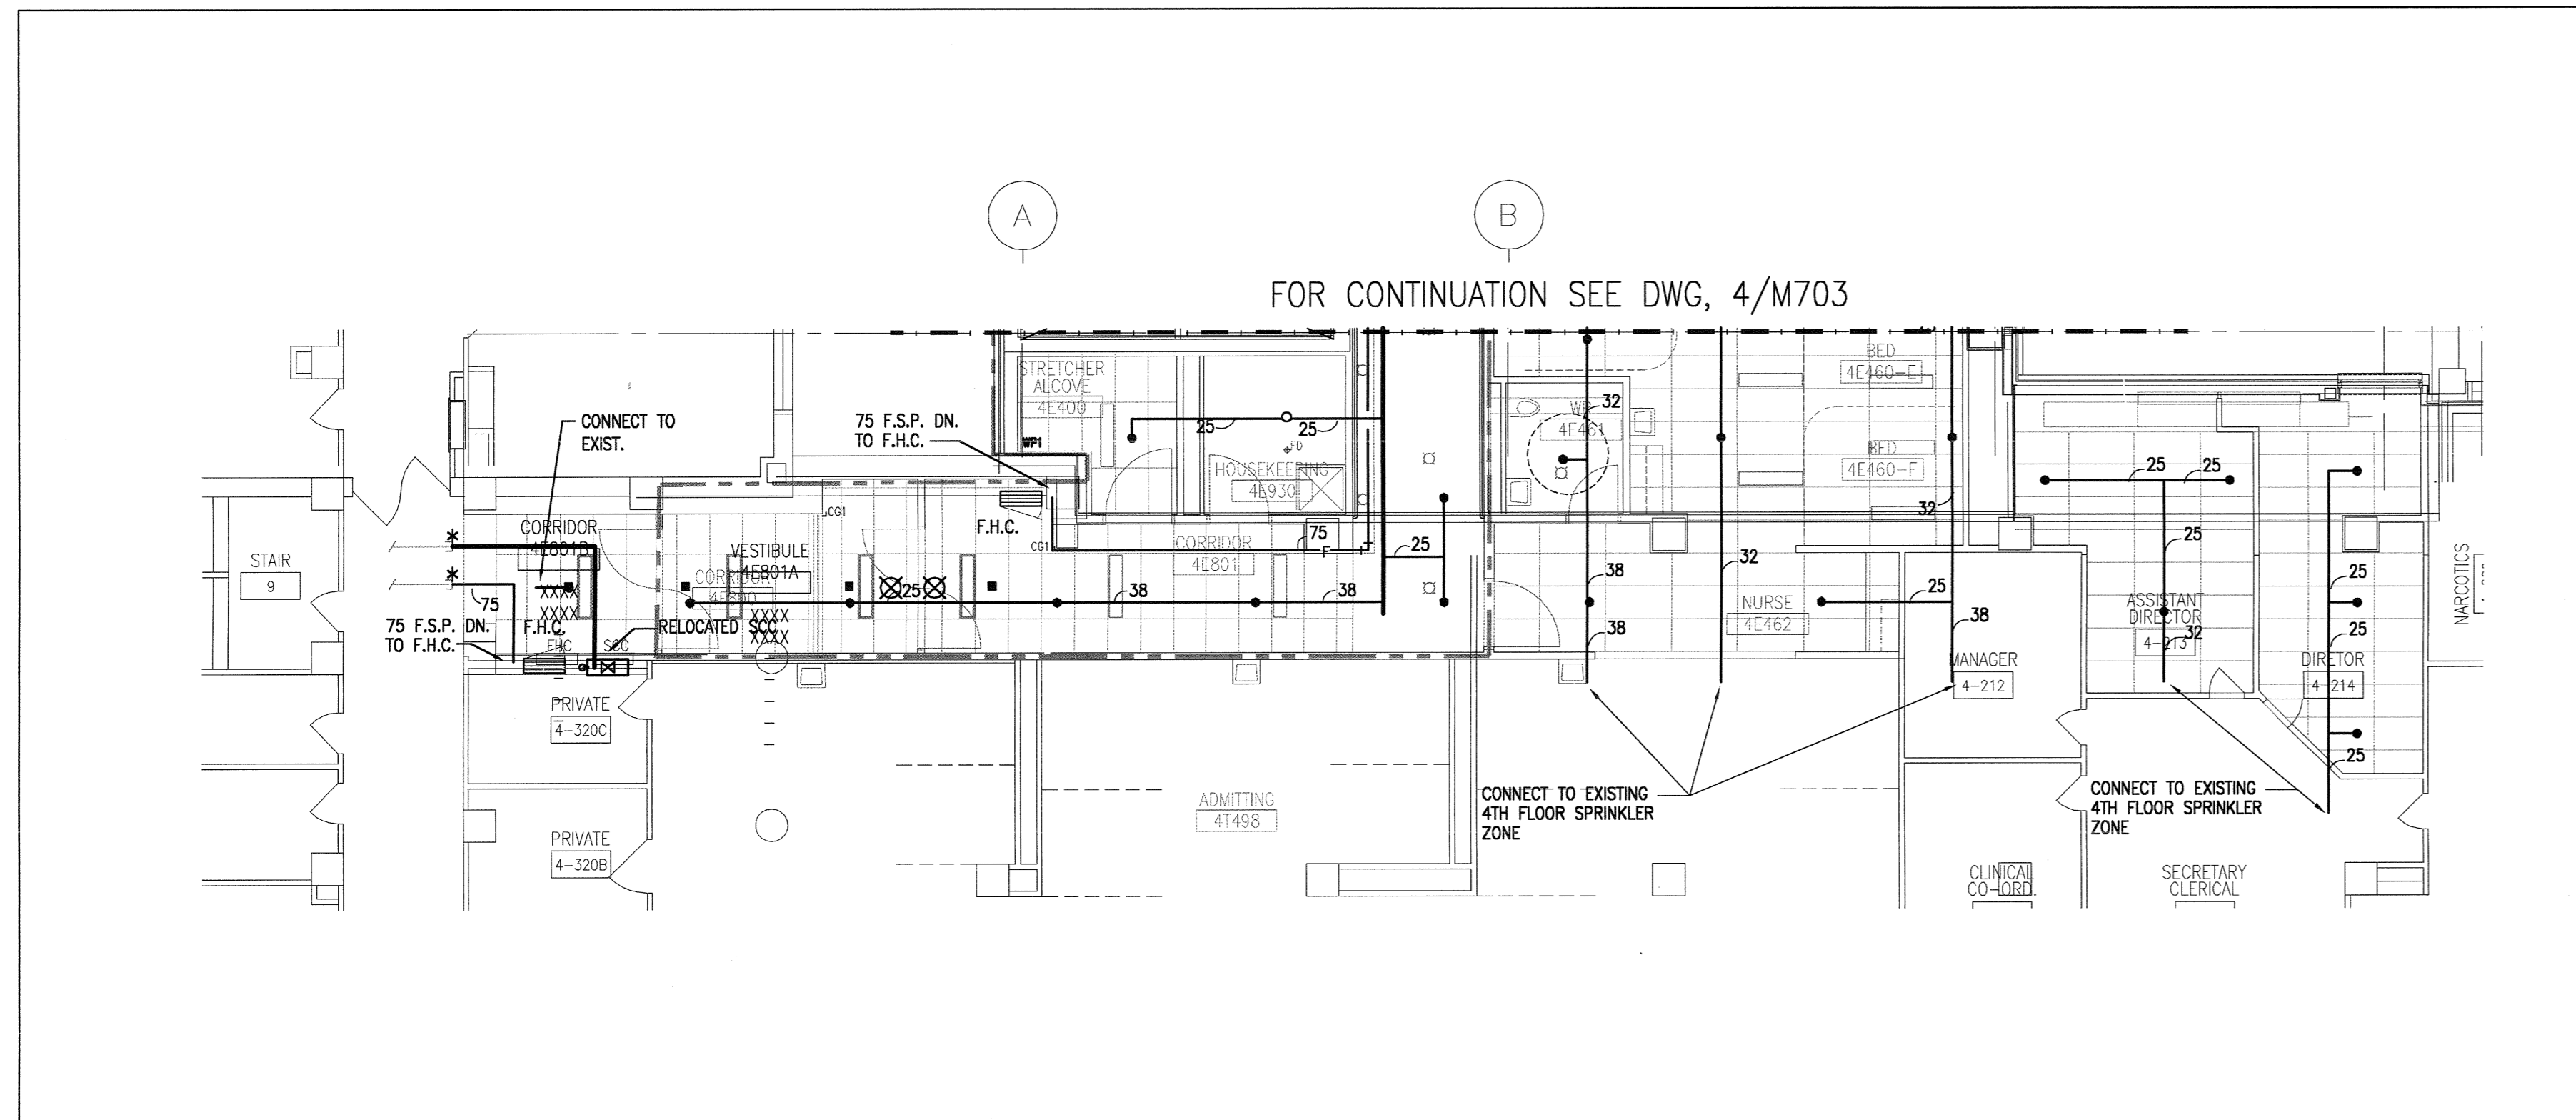

3 PARTIAL LEVEL FOUR FLOOR PLAN
703 Scale: 1:100

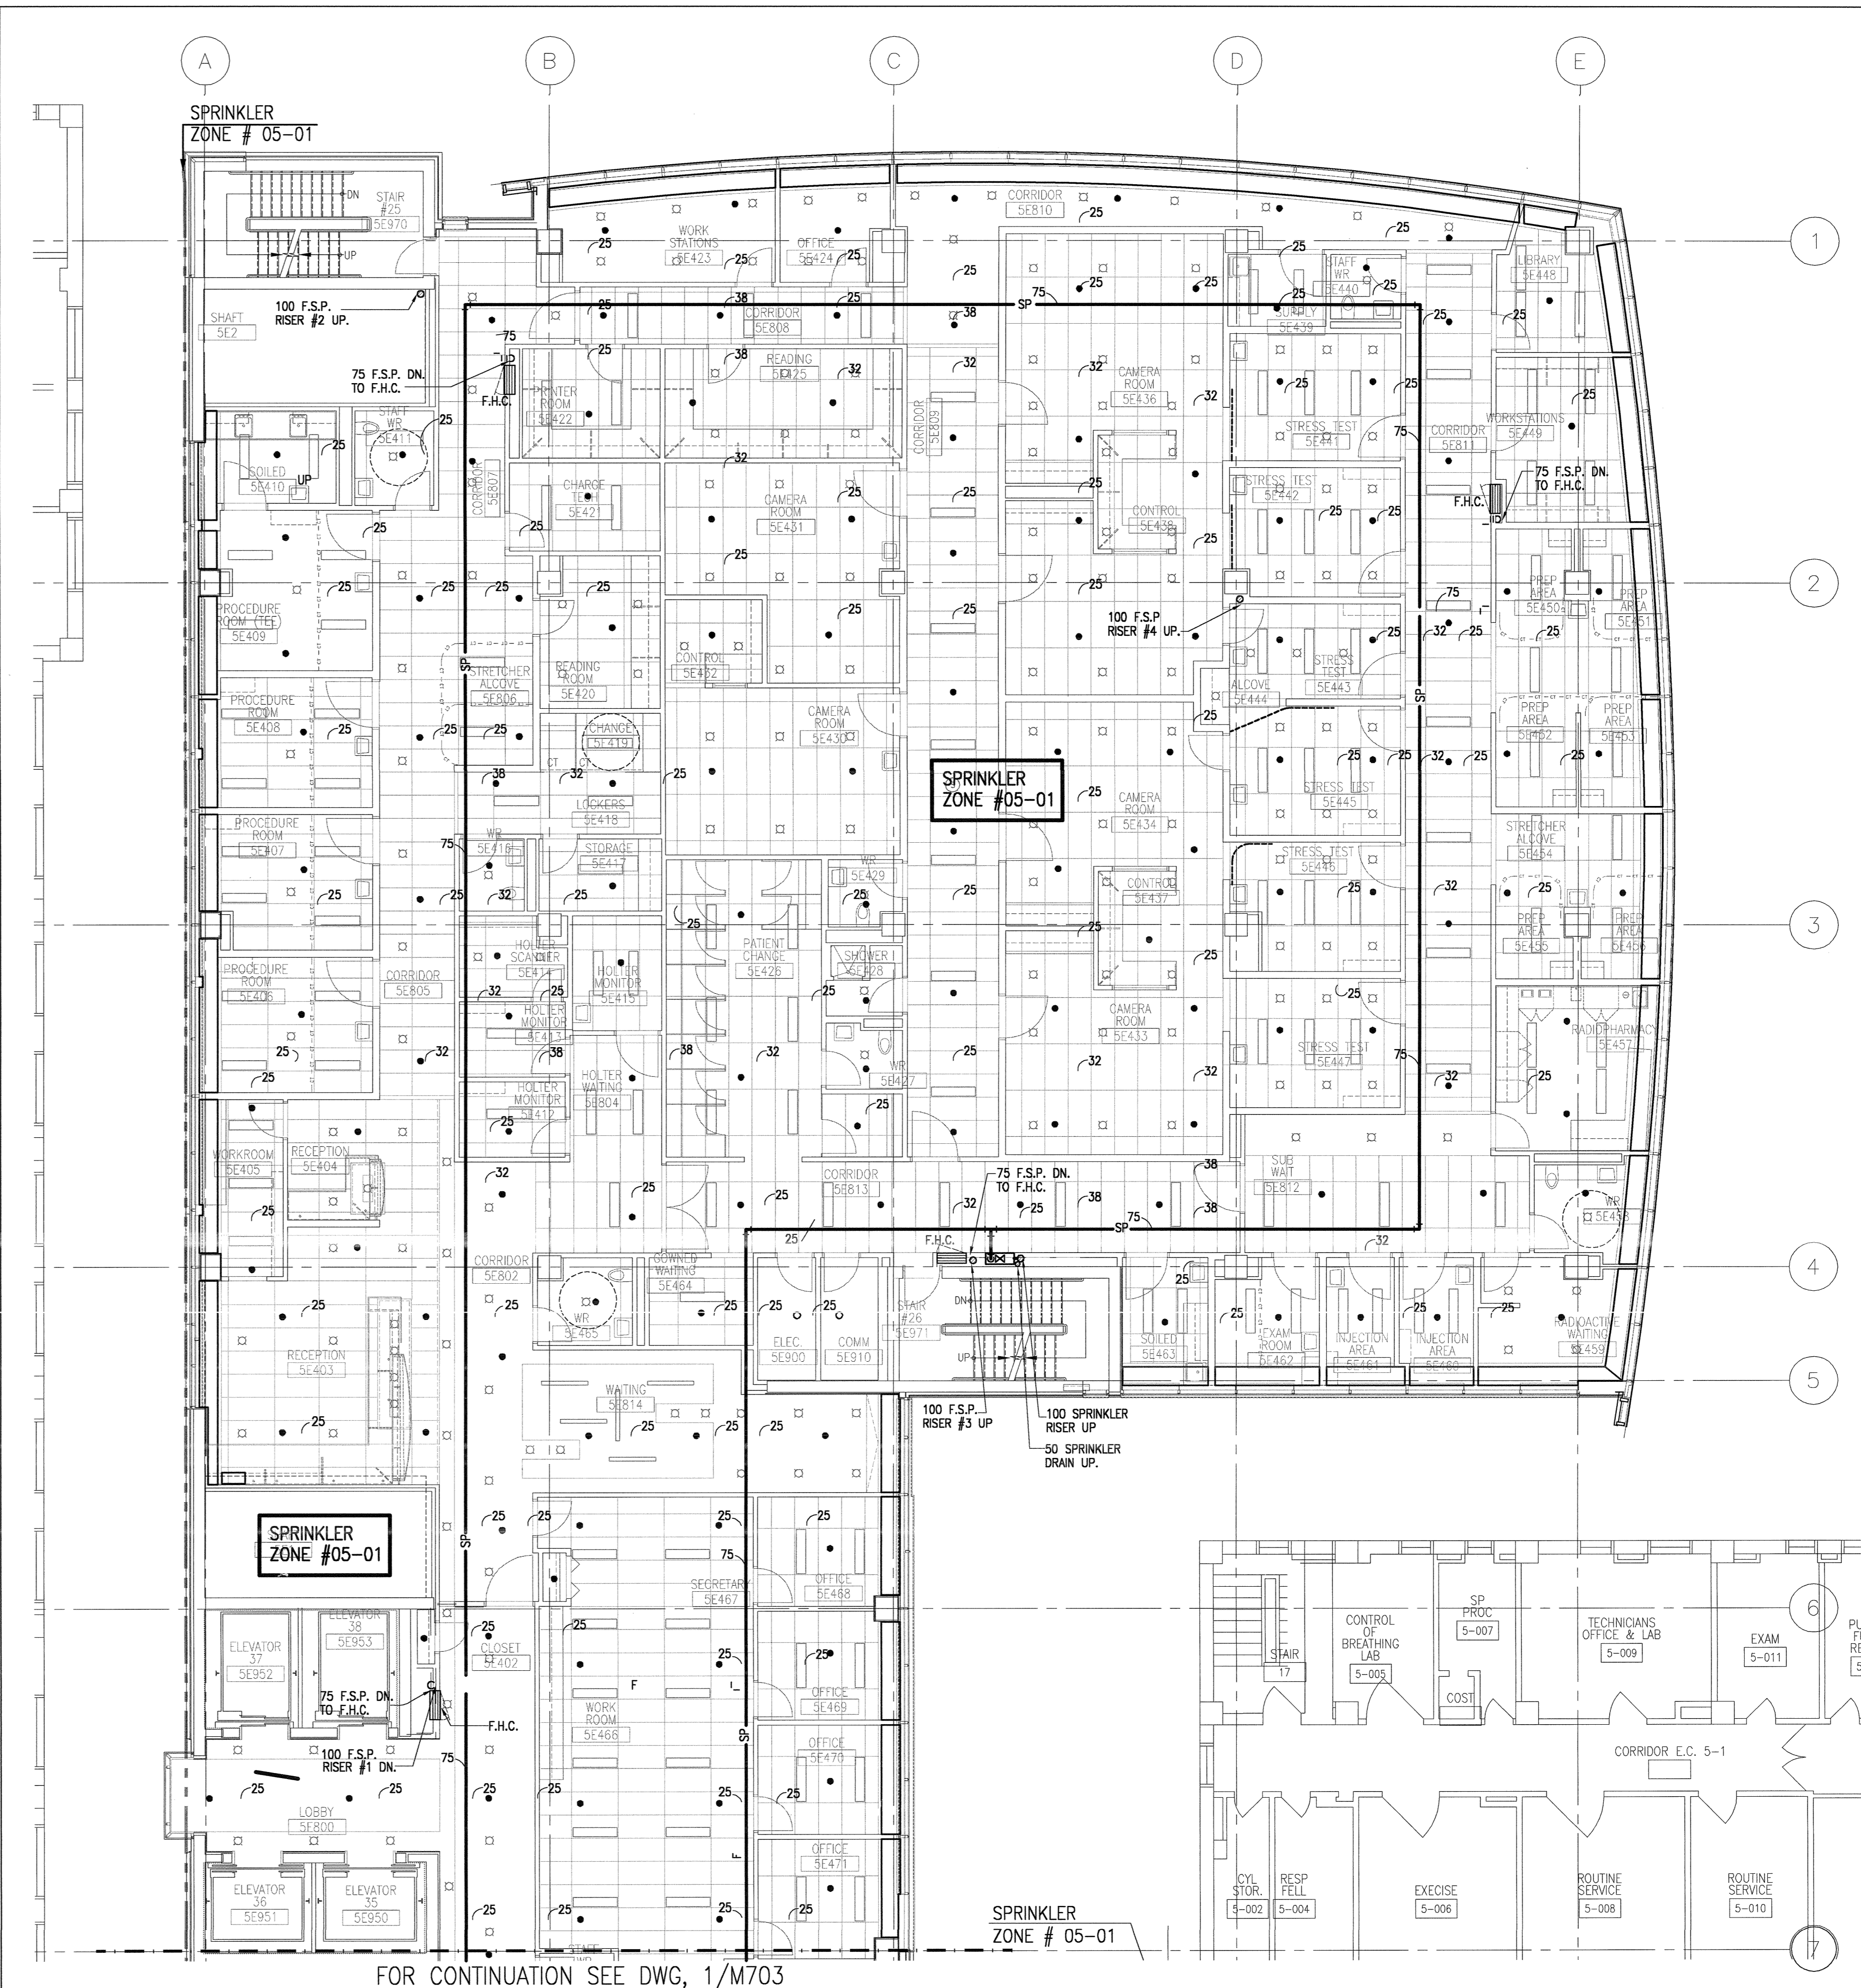

2 LEVEL FIVE FLOOR PLAN
703 Scale: 1:100

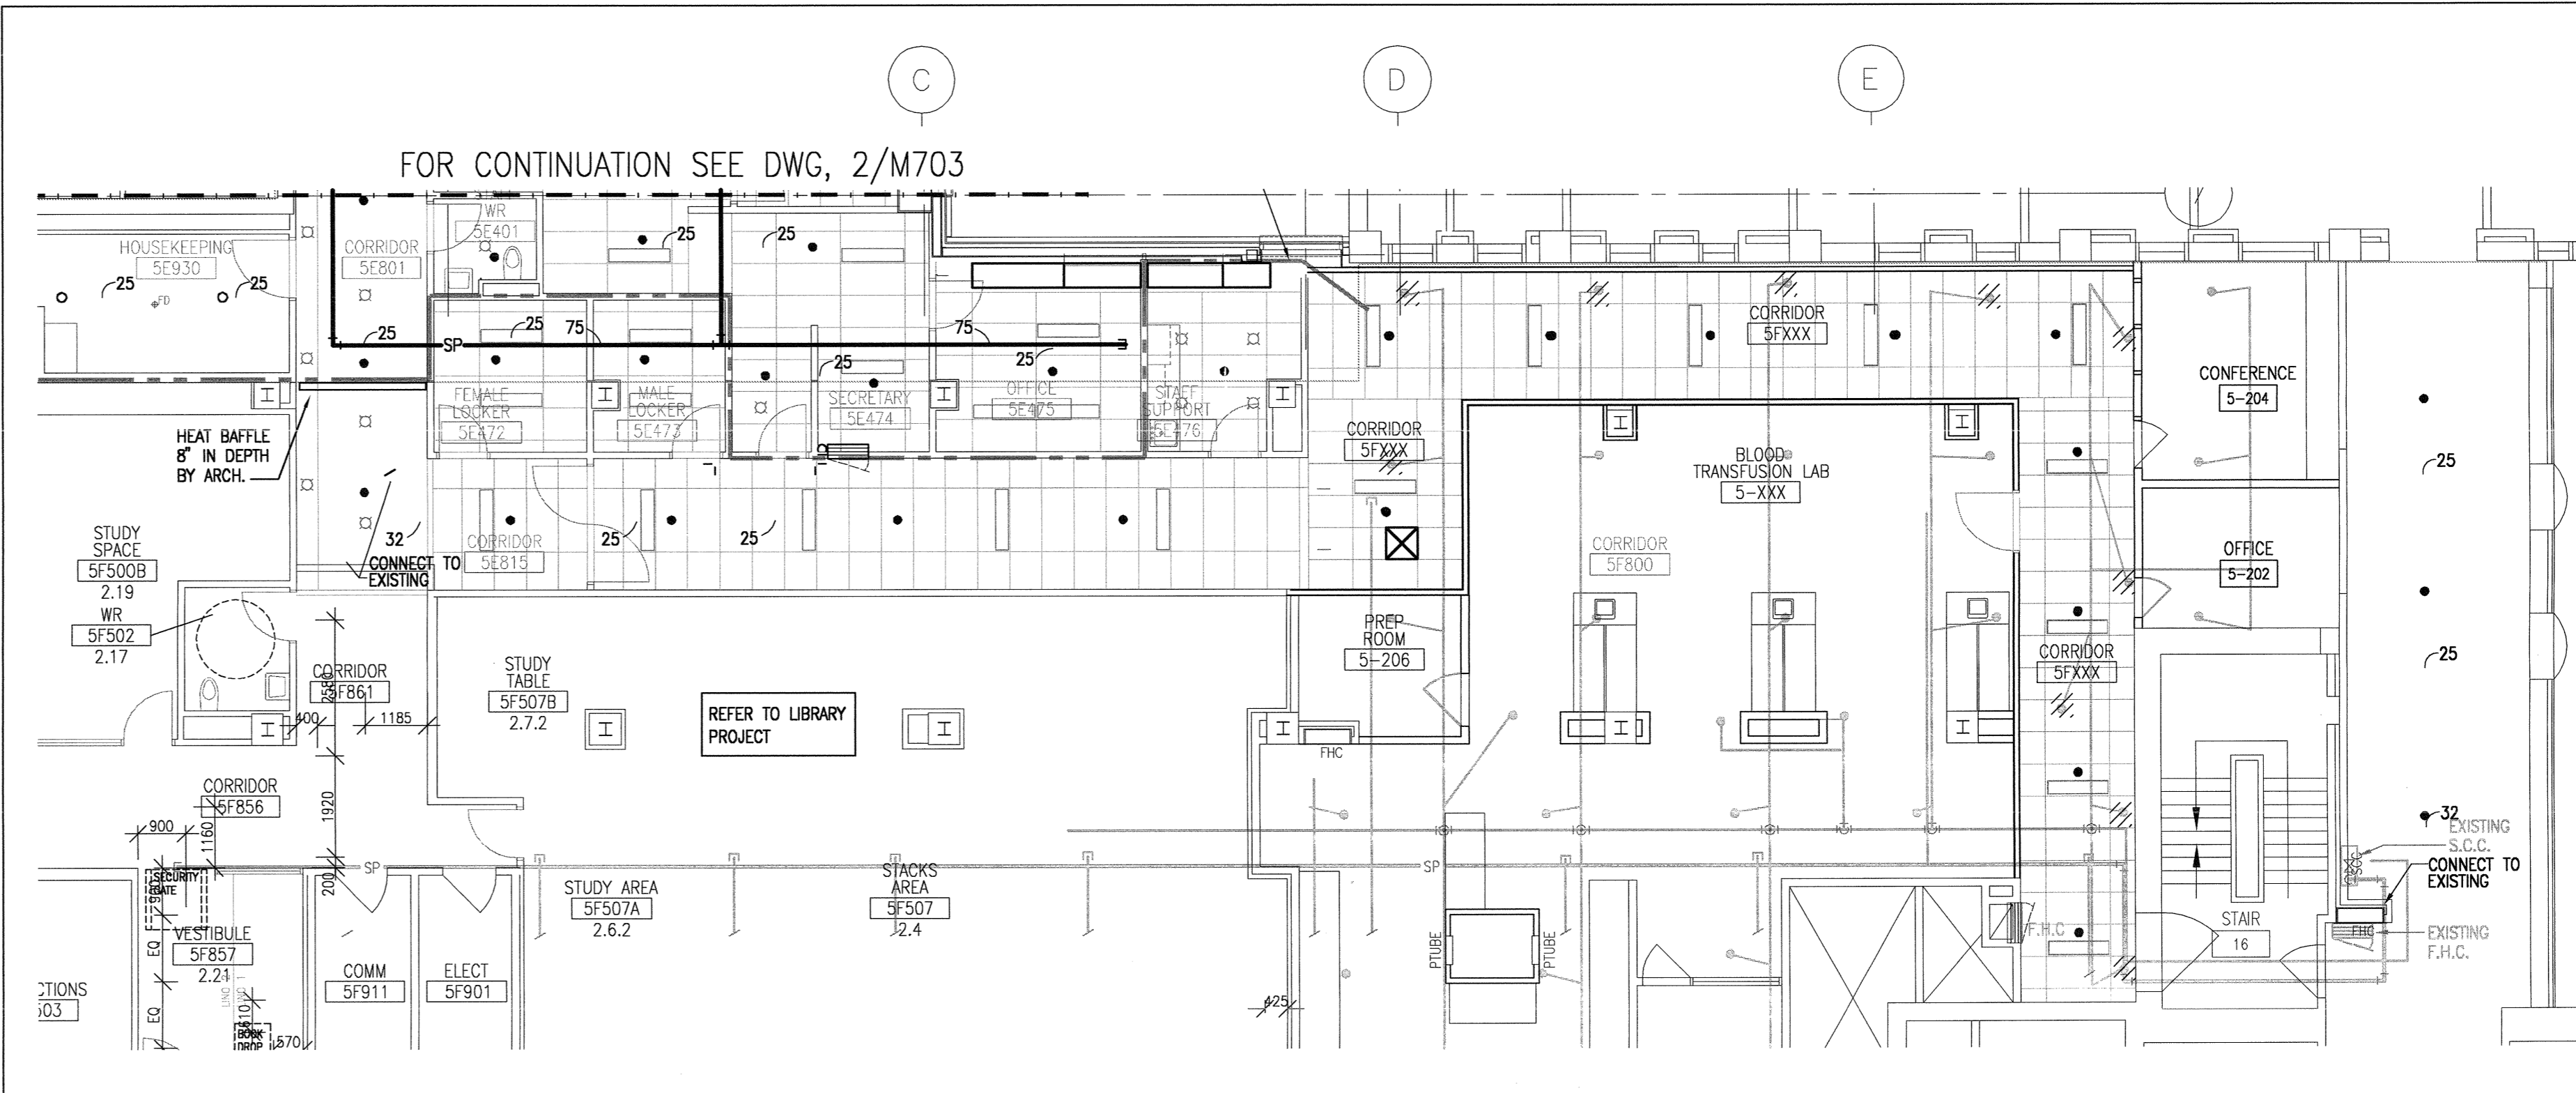


1 PARTIAL LEVEL FIVE FLOOR PLAN
703 Scale: 1:100



Toronto Western Hospital

University Health Network

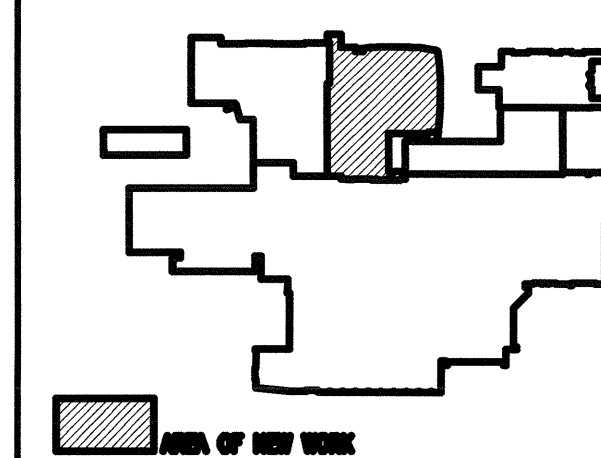


KEY PLAN (A33)

- 8 07/04/00 ISSUED FOR AS-BUILT DRAWINGS
- 7 03/06/00 ISSUED FOR CONSTRUCTION
- 6 03/03/01 ISSUED FOR BUILDING PERMIT
- 5.1 03/03/01 ISSUED FOR GENERAL TENDER
- 5 03/03/01 ISSUED FOR GENERAL TENDER
- 4 03/03/01 ISSUED FOR GENERAL TENDER
- 3 02/12/01 APPLICATION FOR BUILDING PERMIT
- 2 02/11/01 ISSUED FOR RISE REVIEW
- 1 02/08/01 ISSUED FOR COSTING

REF. DATE DESCRIPTION

07/04/00 (07/04/00)

CHECK AND VERIFY ALL DIMENSIONS BEFORE PROCEEDING WITH THE WORK.

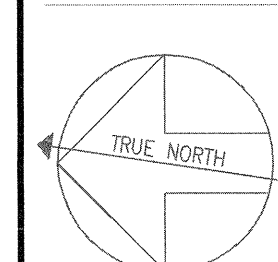

CONSTRUCTION NORTH

AS-BUILT DRAWINGS

PROJECT NAME:
TORONTO WESTERN HOSPITAL
EAST WING REDEVELOPMENT
MAIN BUILDING - STAGE TWO
TORONTO ONTARIO


DRAWING TITLE:
LEVEL 6 FLOOR PLAN
LEVEL 7 FLOOR PLAN
FIRE PROTECTION

SCALE:
1 : 100
DATE:
FEBRUARY 25, 2003
DRAWN BY:
G.P.
CHECKED BY:
J.J.


PROJECT NUMBER:
2011210
DRAWING NUMBER:
M2-704




3 LEVEL SIX FLOOR PLAN
704 Scale: 1:100

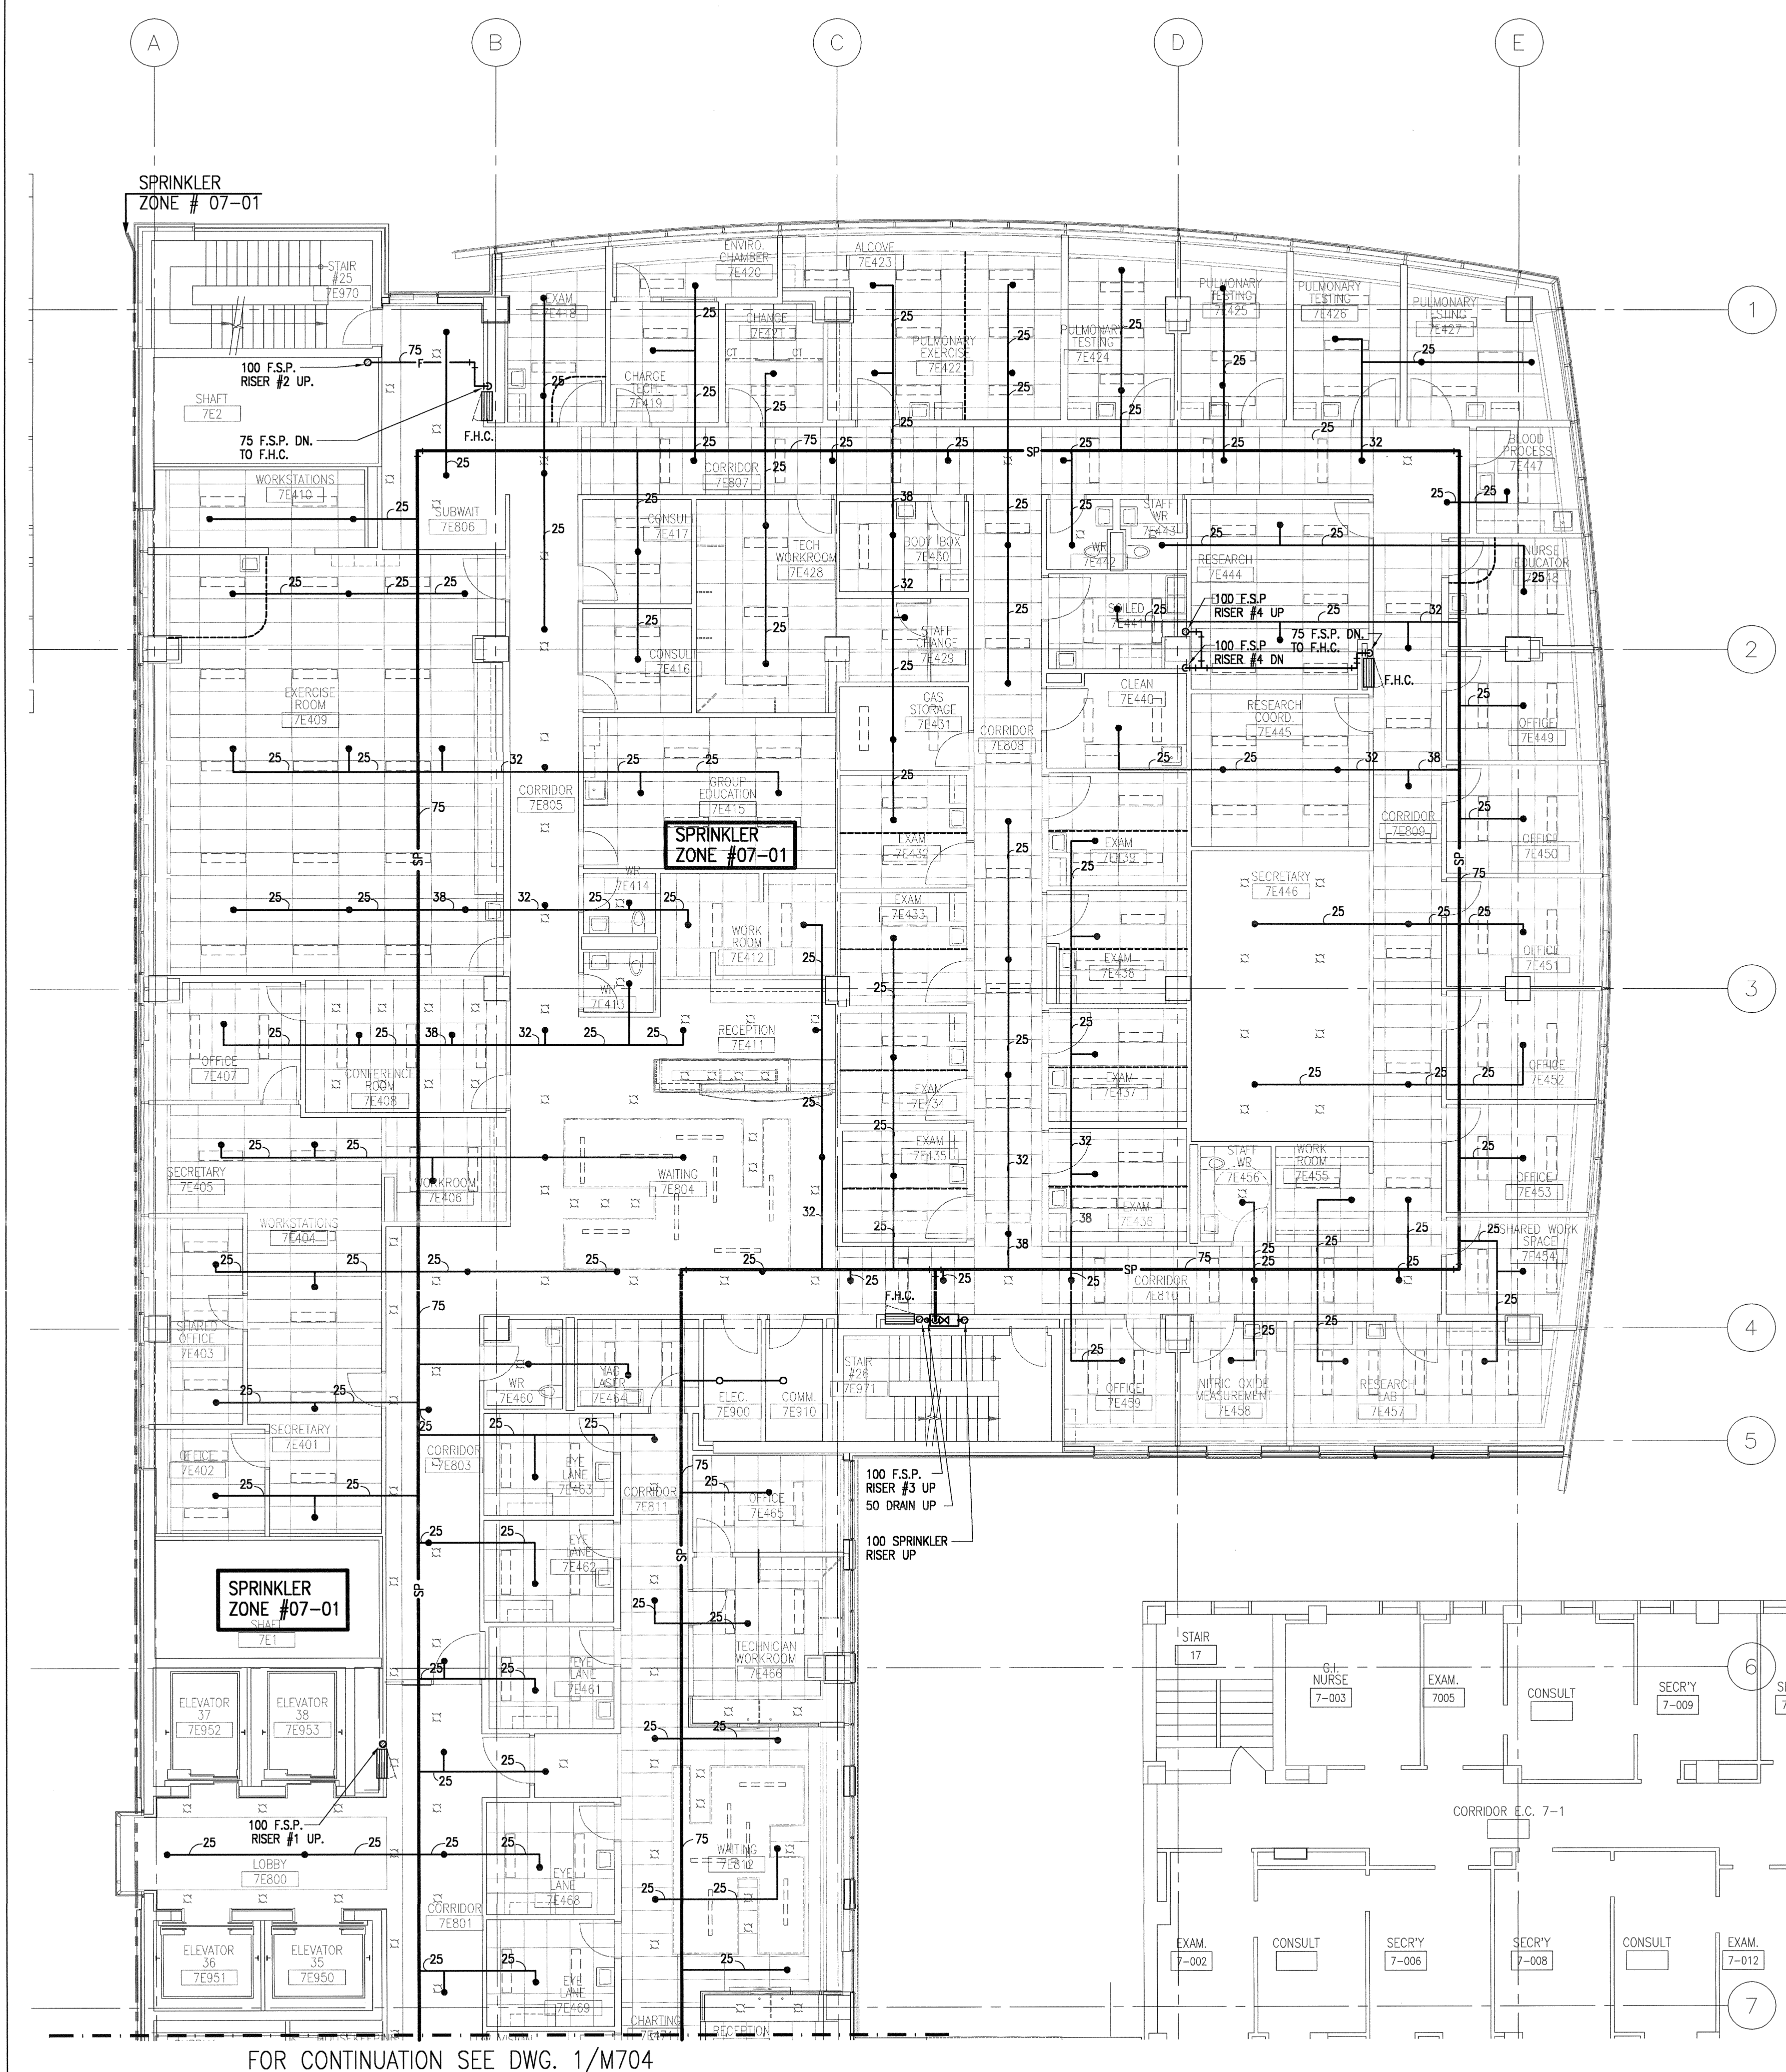

2 LEVEL SEVEN FLOOR PLAN
704 Scale: 1:100

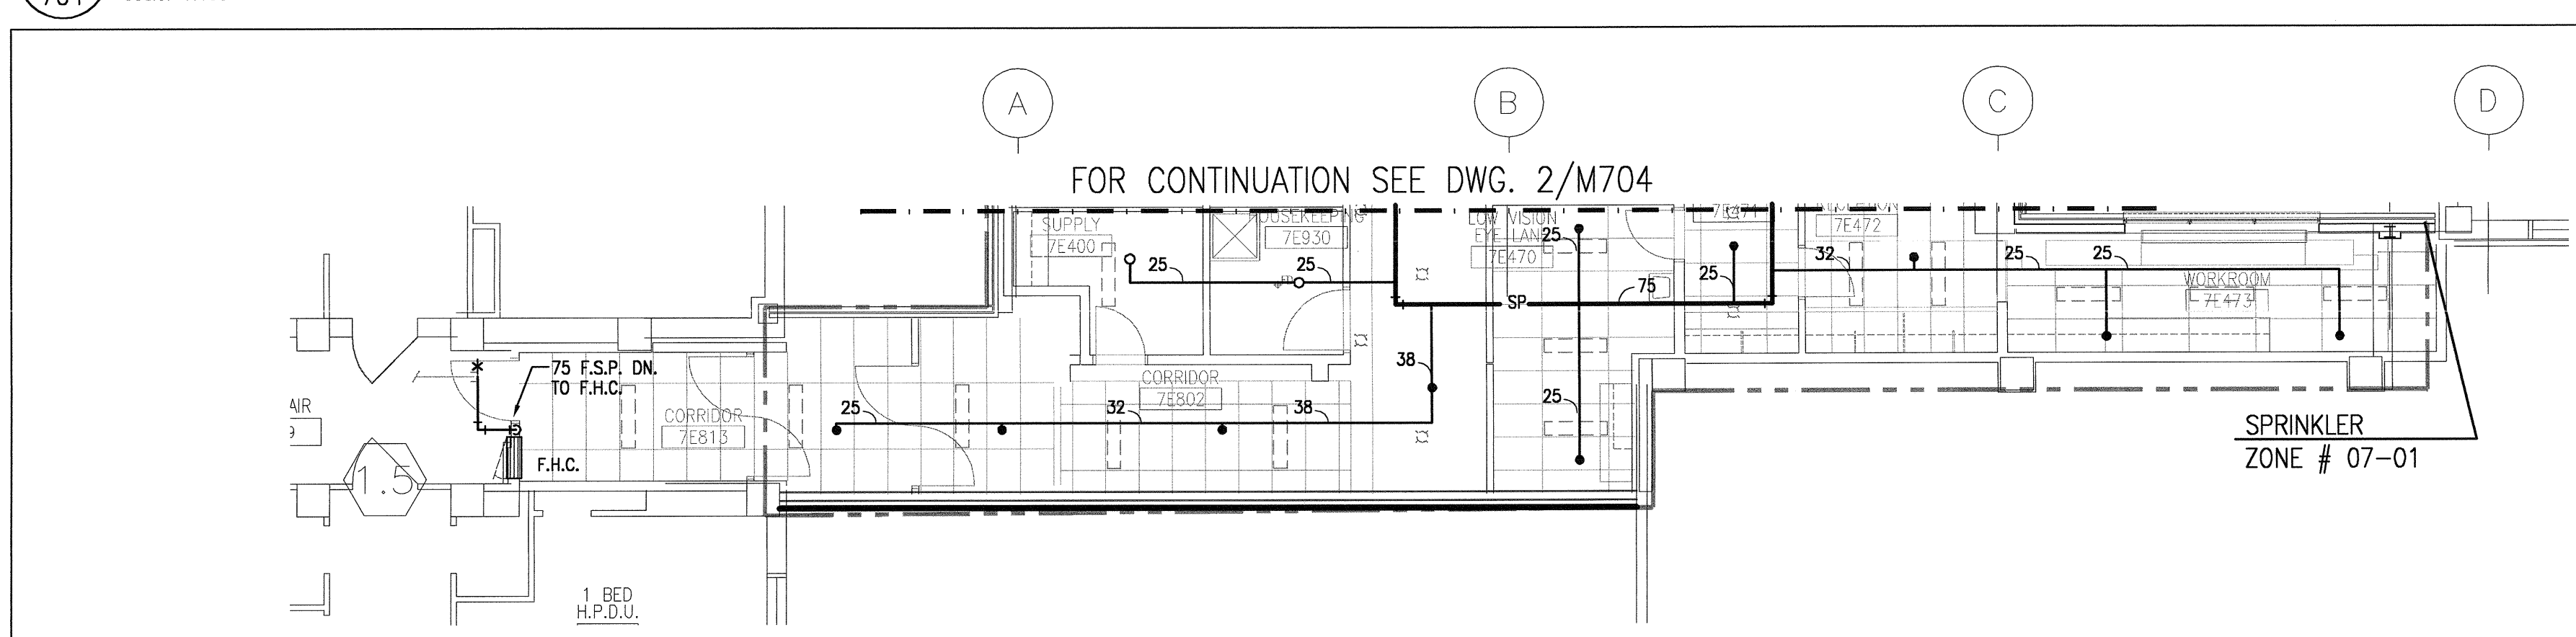


1 PARTIAL LEVEL SEVEN FLOOR PLAN
704 Scale: 1:100

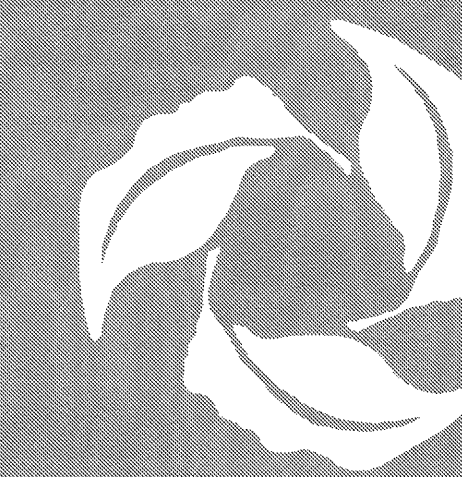

Toronto Western Hospital

University Health Network

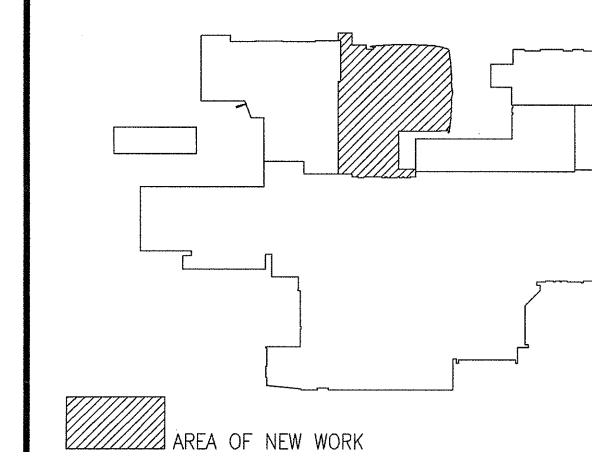


KEY PLAN (N.T.S.)

8	07/04/20	ISSUED FOR AS-BUILT DRAWINGS
7	03/06/20	ISSUED FOR CONSTRUCTION
6	03/03/20	ISSUED FOR BUILDING PERMIT
5	03/03/18	ISSUED FOR GENERAL TENDER
4	03/01/20	ISSUED FOR 90% COSTING
3	02/12/19	APPLICATION FOR BUILDING PERMIT
2	02/11/17	ISSUED FOR 60% REVIEW
1	02/08/16	ISSUED FOR COSTING

REF. DATE DESCRIPTION
(yy/mm/yy)

CHECK AND VERIFY ALL DIMENSIONS BEFORE PROCEEDING WITH THE WORK. DO NOT SCALE DRAWINGS.

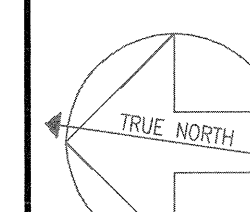

CONSTRUCTION NORTH


AS-BUILT DRAWINGS

PROJECT NAME:
TORONTO WESTERN HOSPITAL
EAST WING REDEVELOPMENT
MAIN BUILDING - STAGE TWO
TORONTO ONTARIO


DRAWING TITLE:
LEVEL 8 FLOOR PLAN
LEVEL 9 FLOOR PLAN
FIRE PROTECTION

SCALE:
1 : 100
DATE:
Feb
DRAWN BY:
G.P.
CHECKED BY:
J.J.

PROJECT NUMBER:
2011210
DRAWING NUMBER:
M2-705

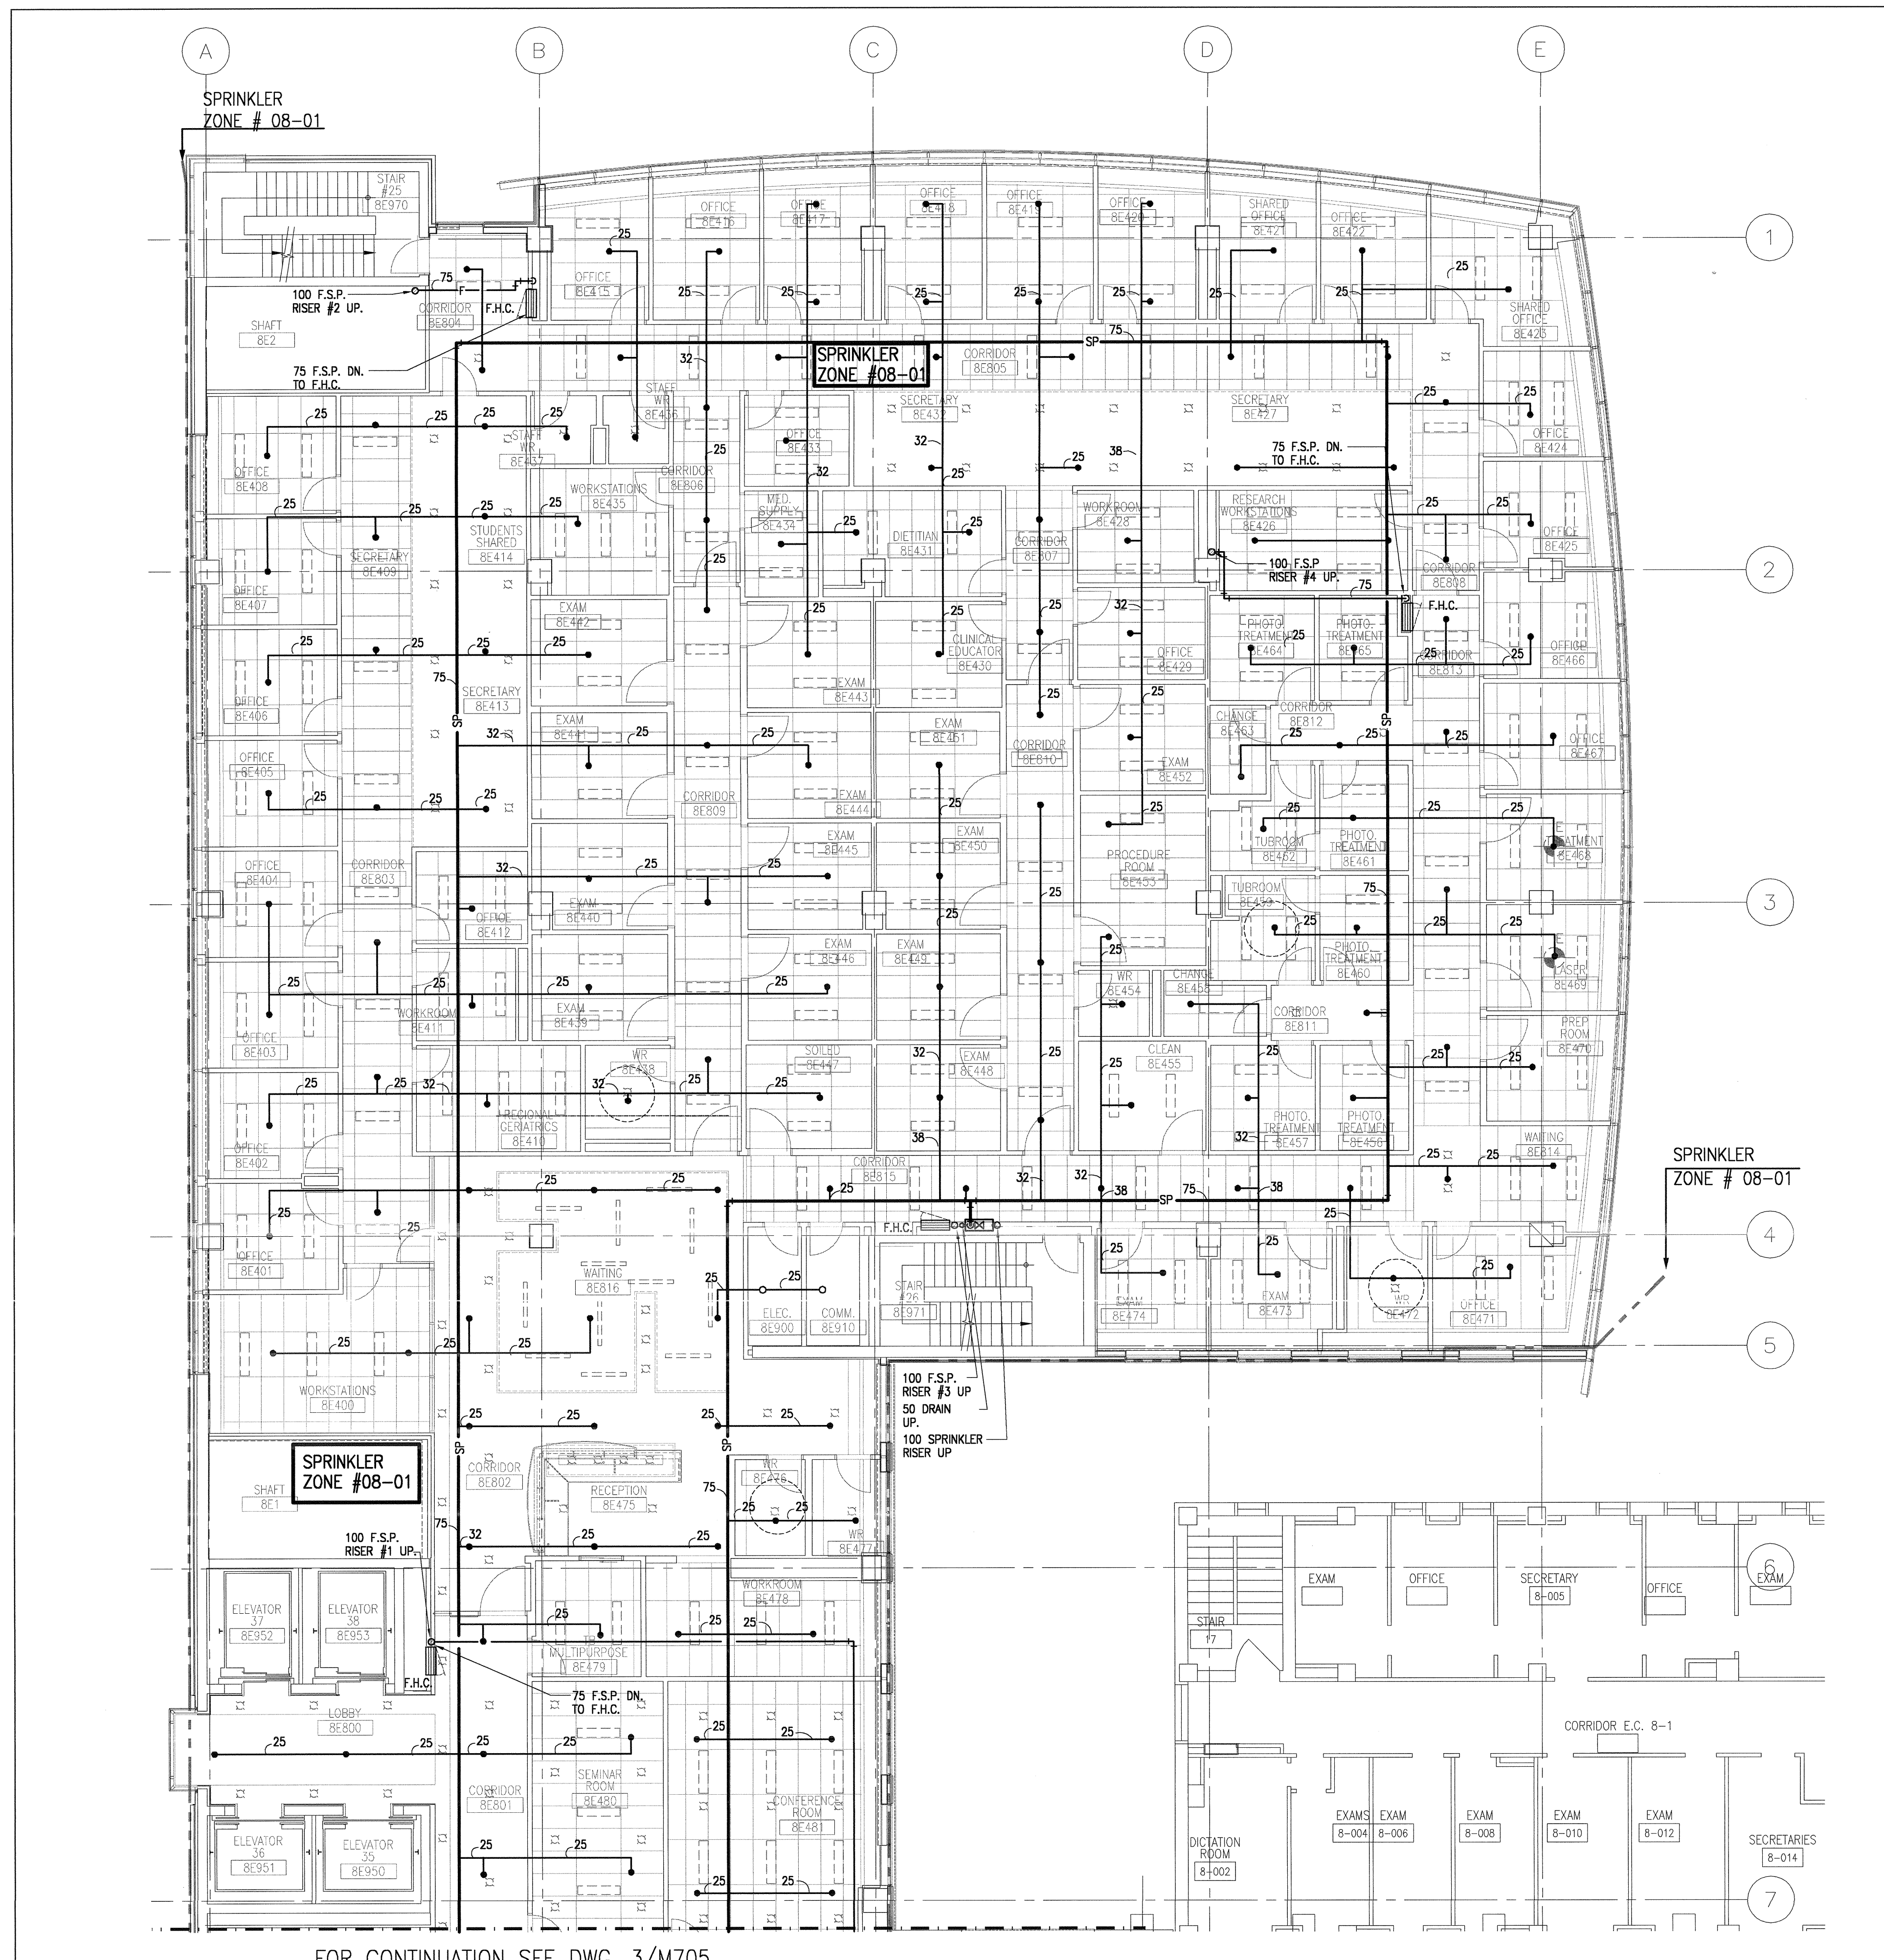


4 LEVEL EIGHT FLOOR PLAN
Scale: 1:100

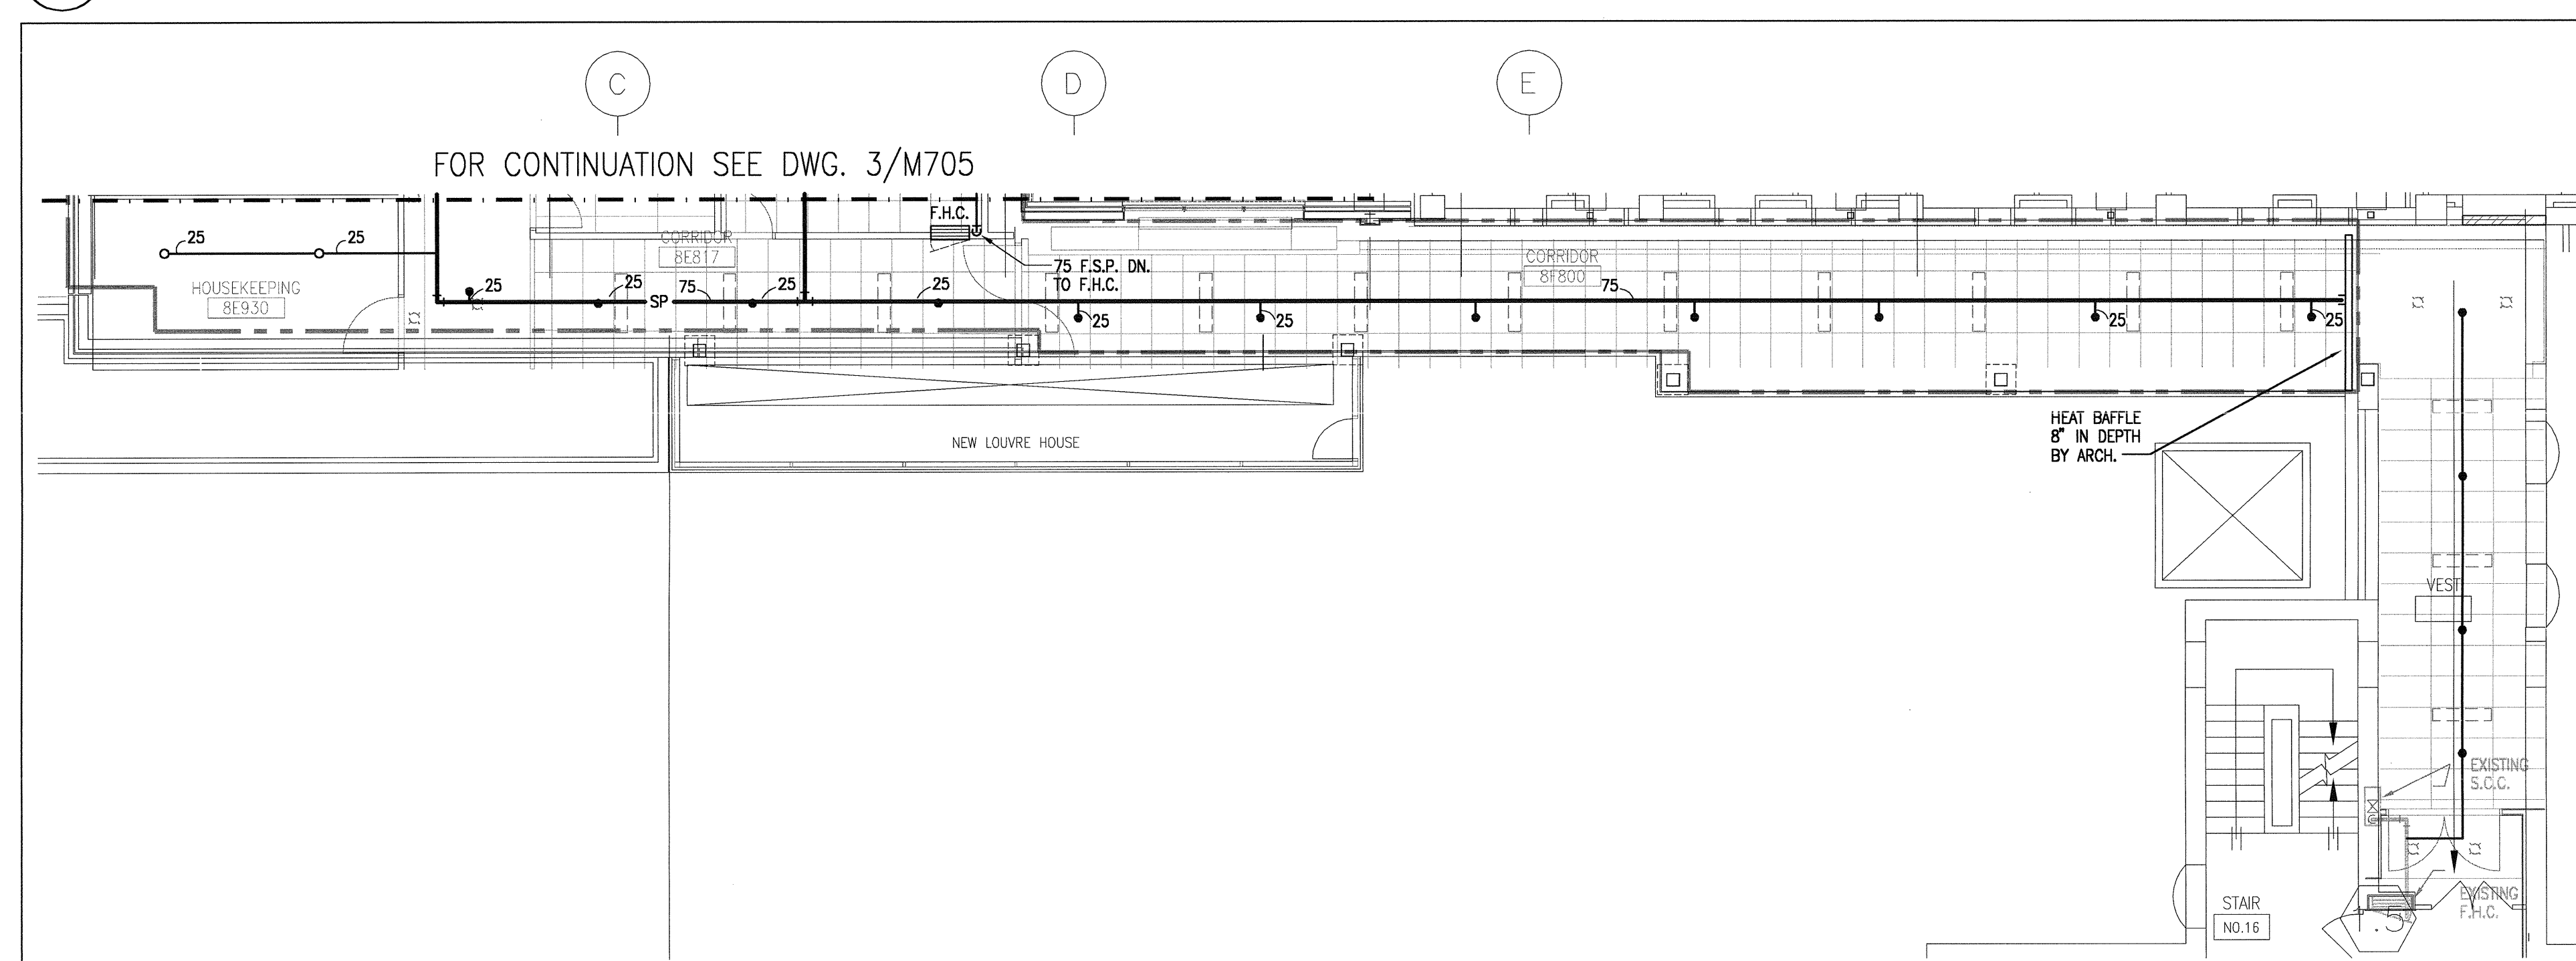


3 PARTIAL LEVEL EIGHT FLOOR PLAN
Scale: 1:100

Ref: 11


AD 841 X 1189

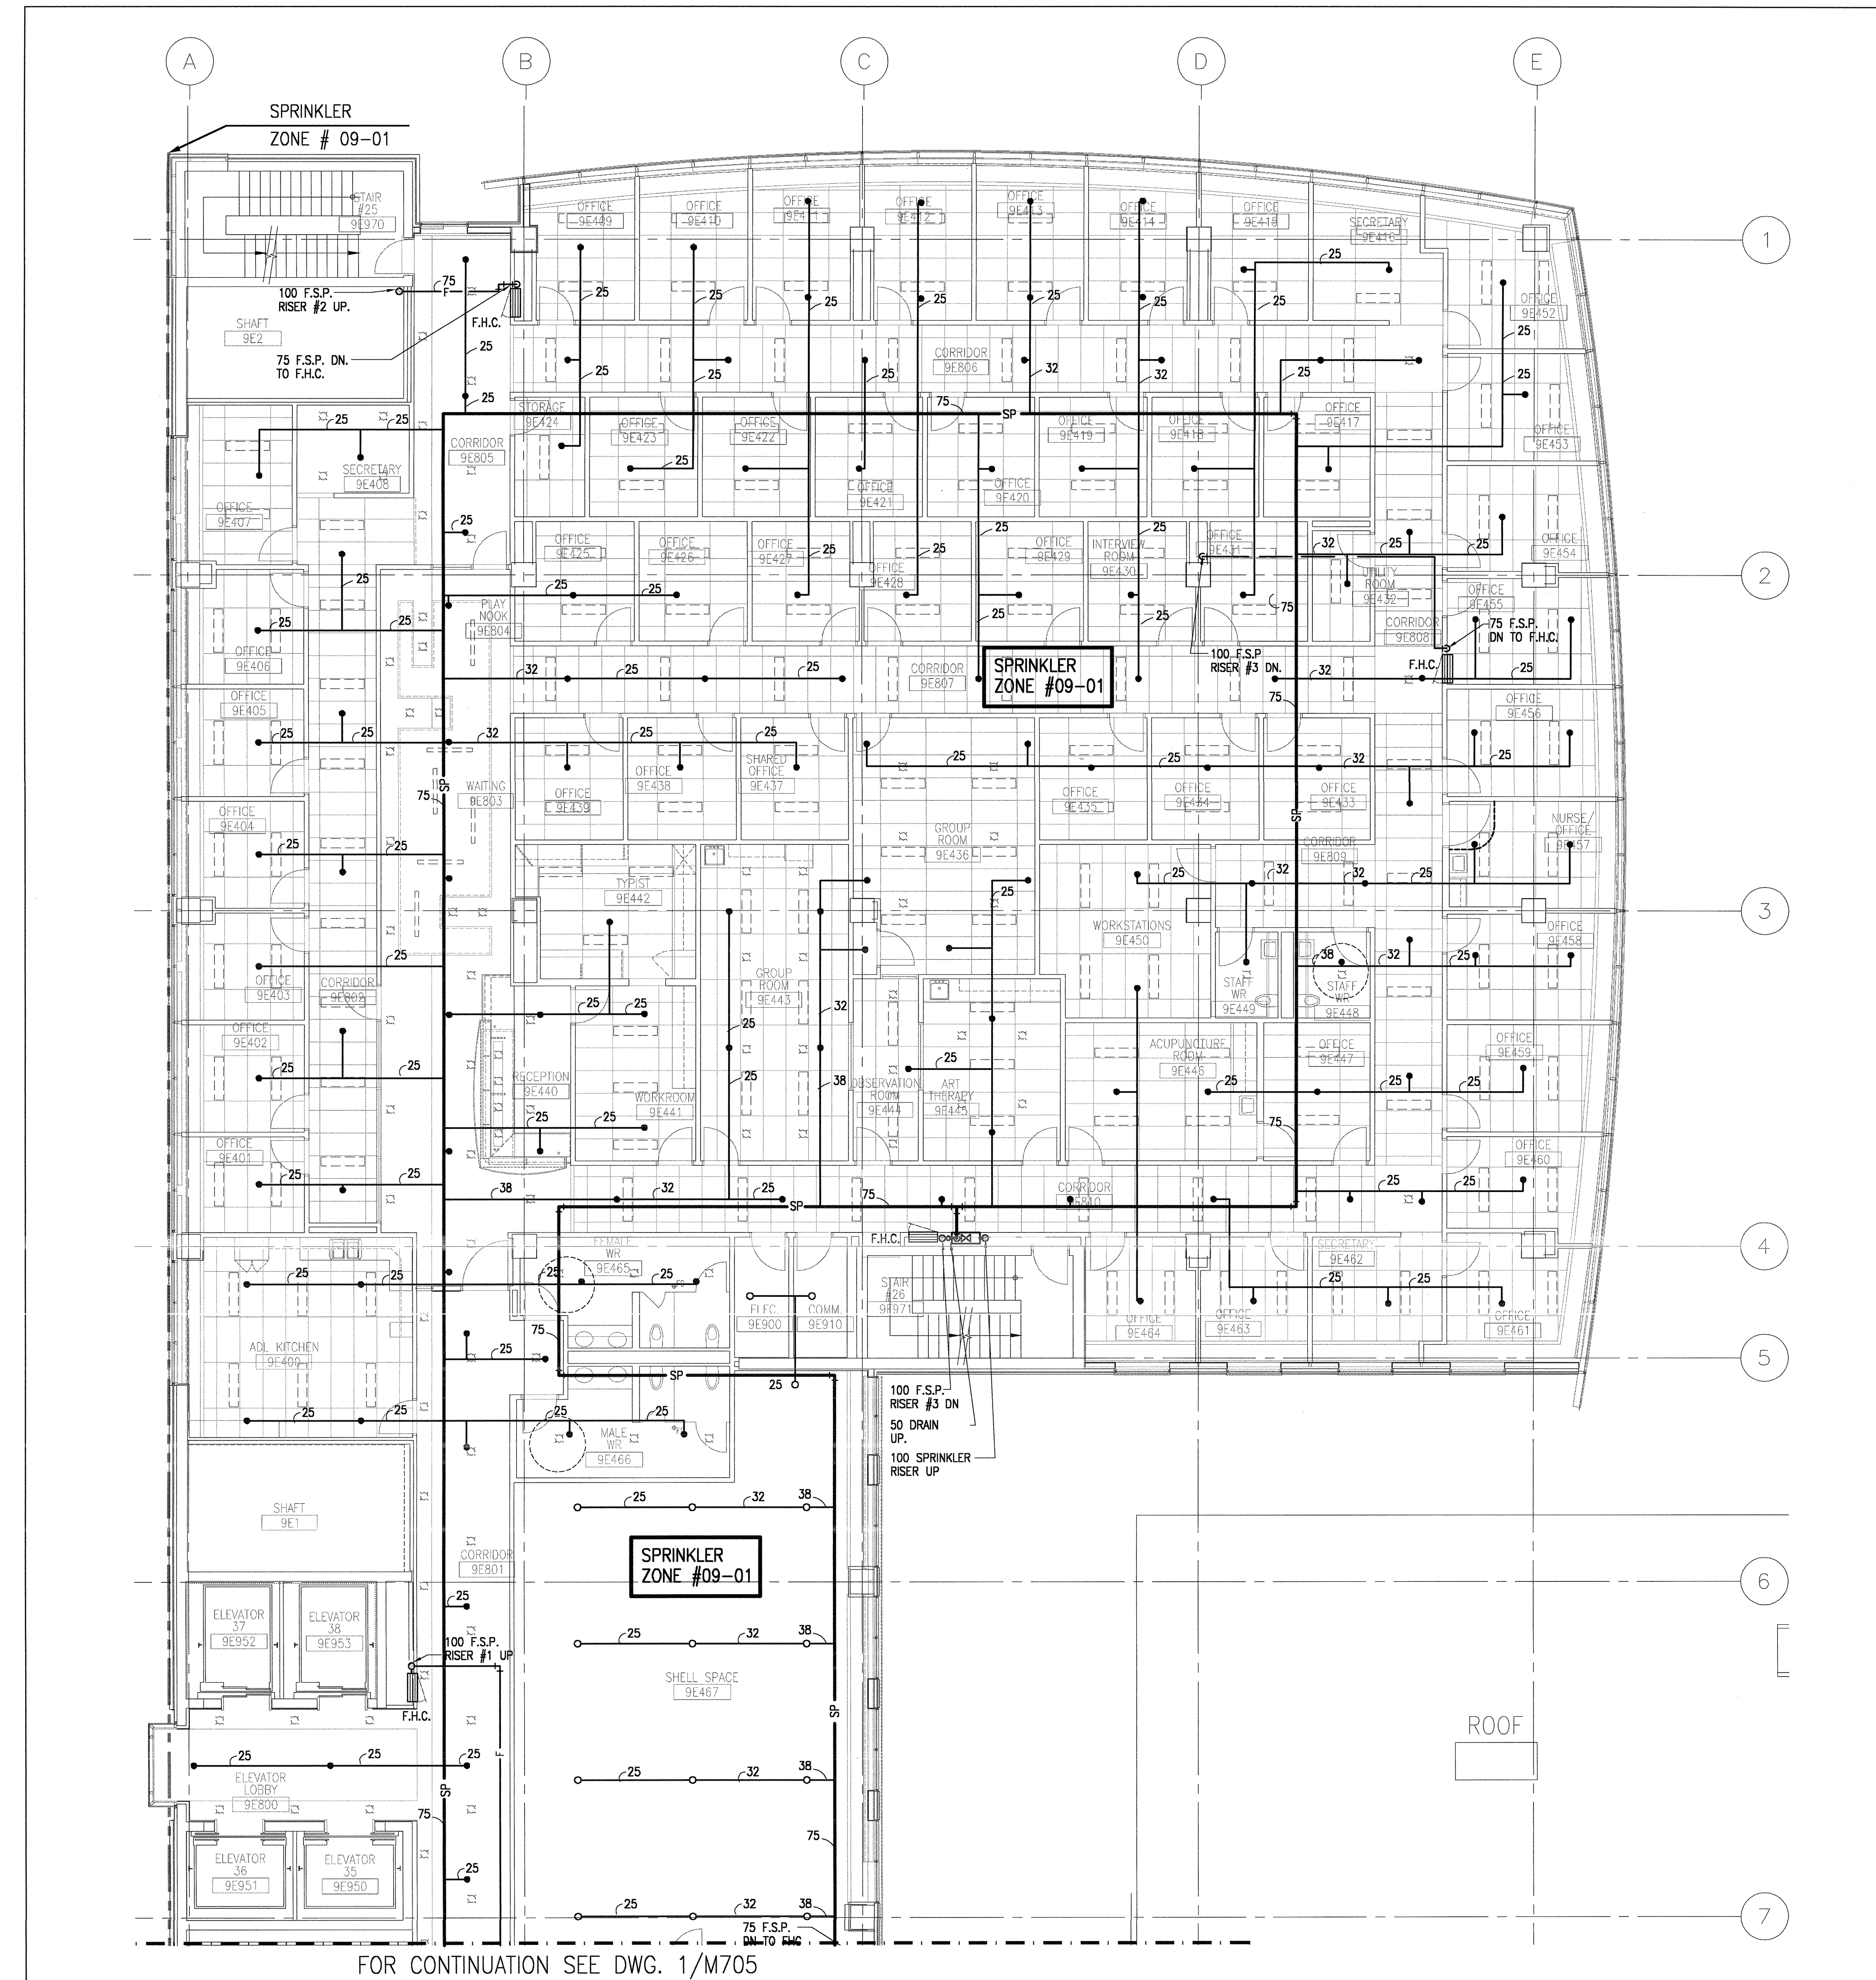


2 LEVEL NINE FLOOR PLAN
Scale: 1:100

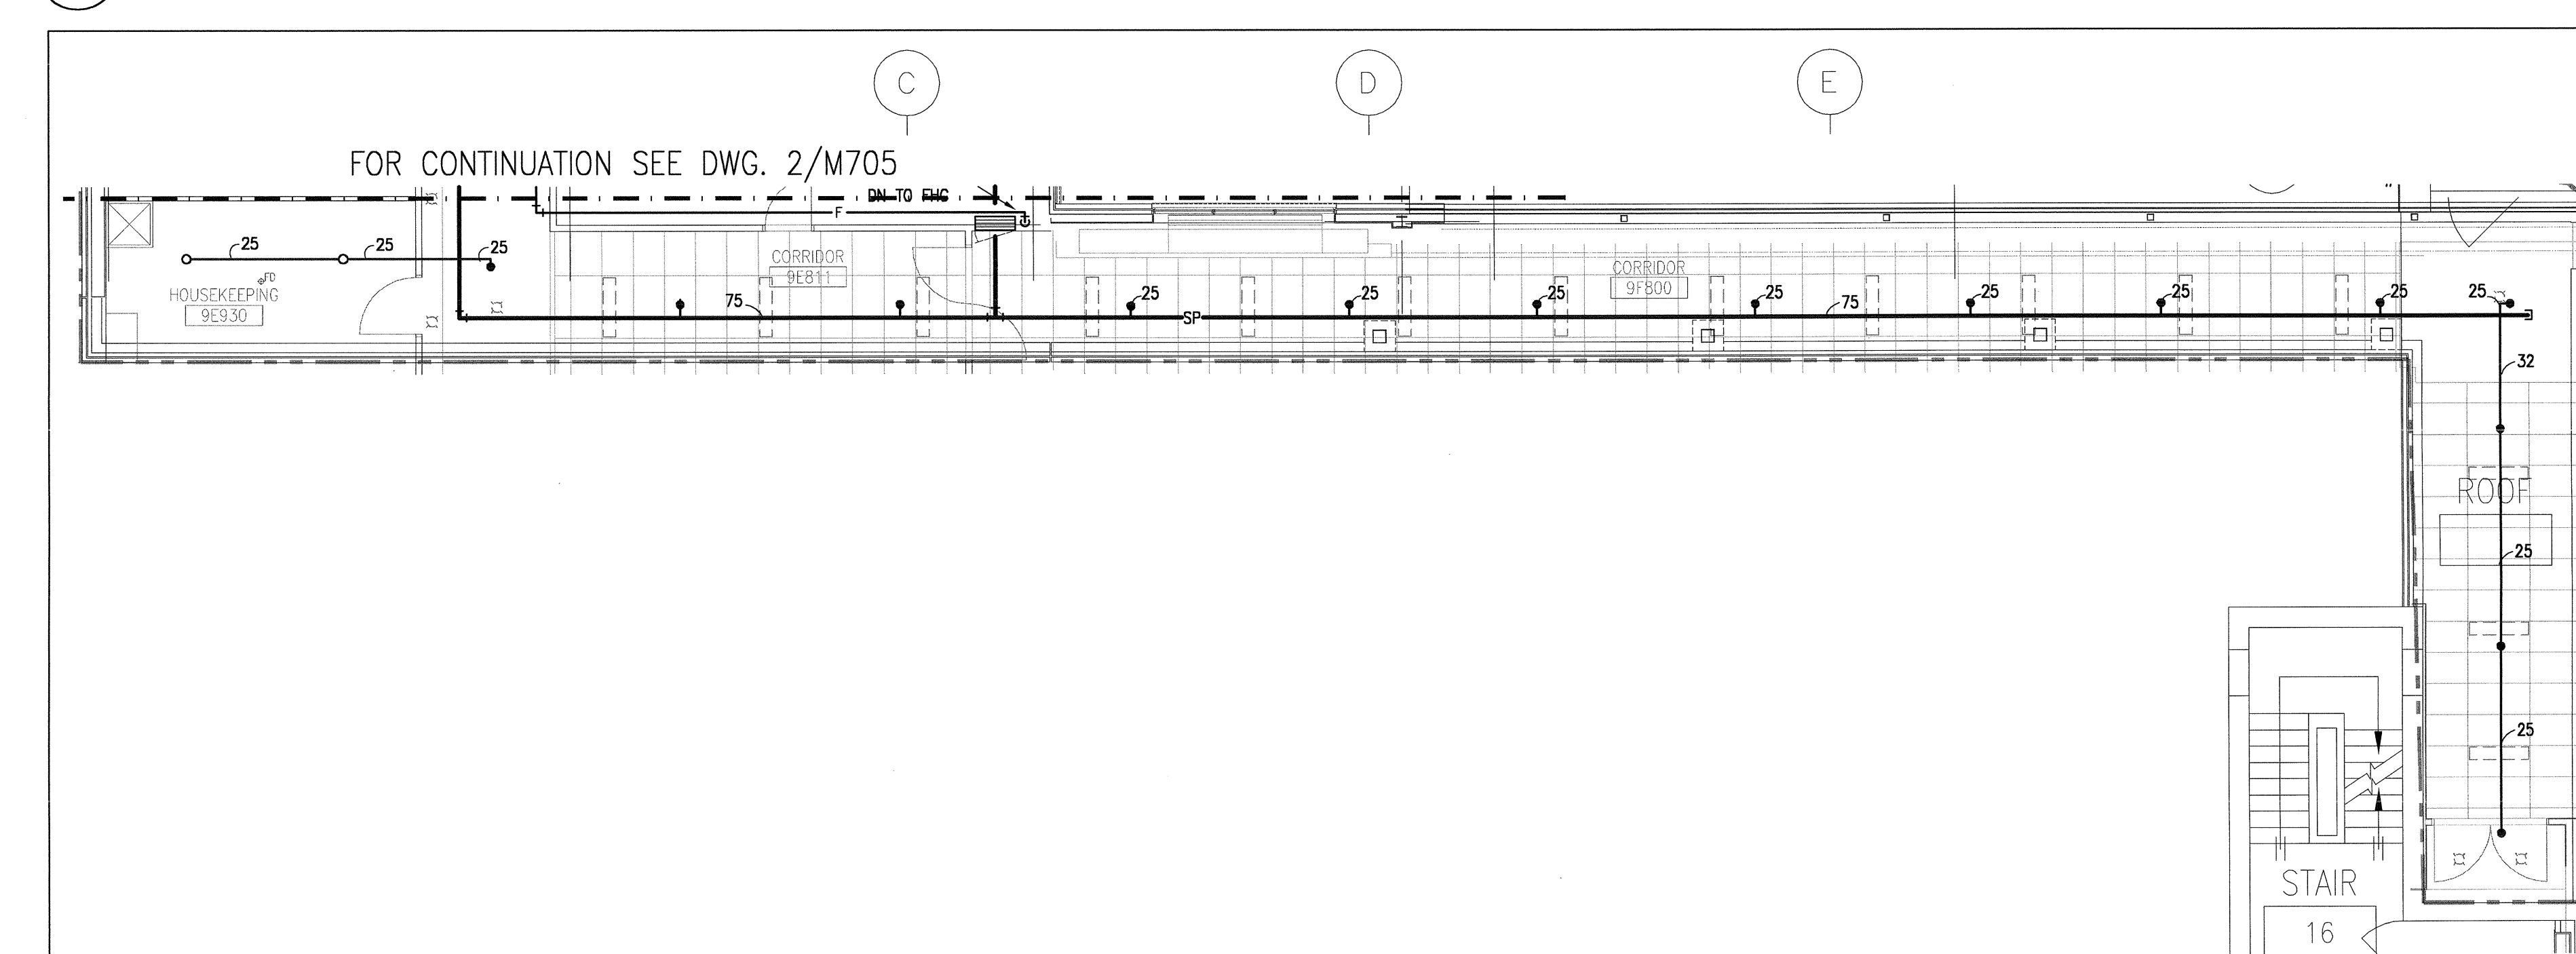

1 PARTIAL LEVEL NINE FLOOR PLAN
Scale: 1:100

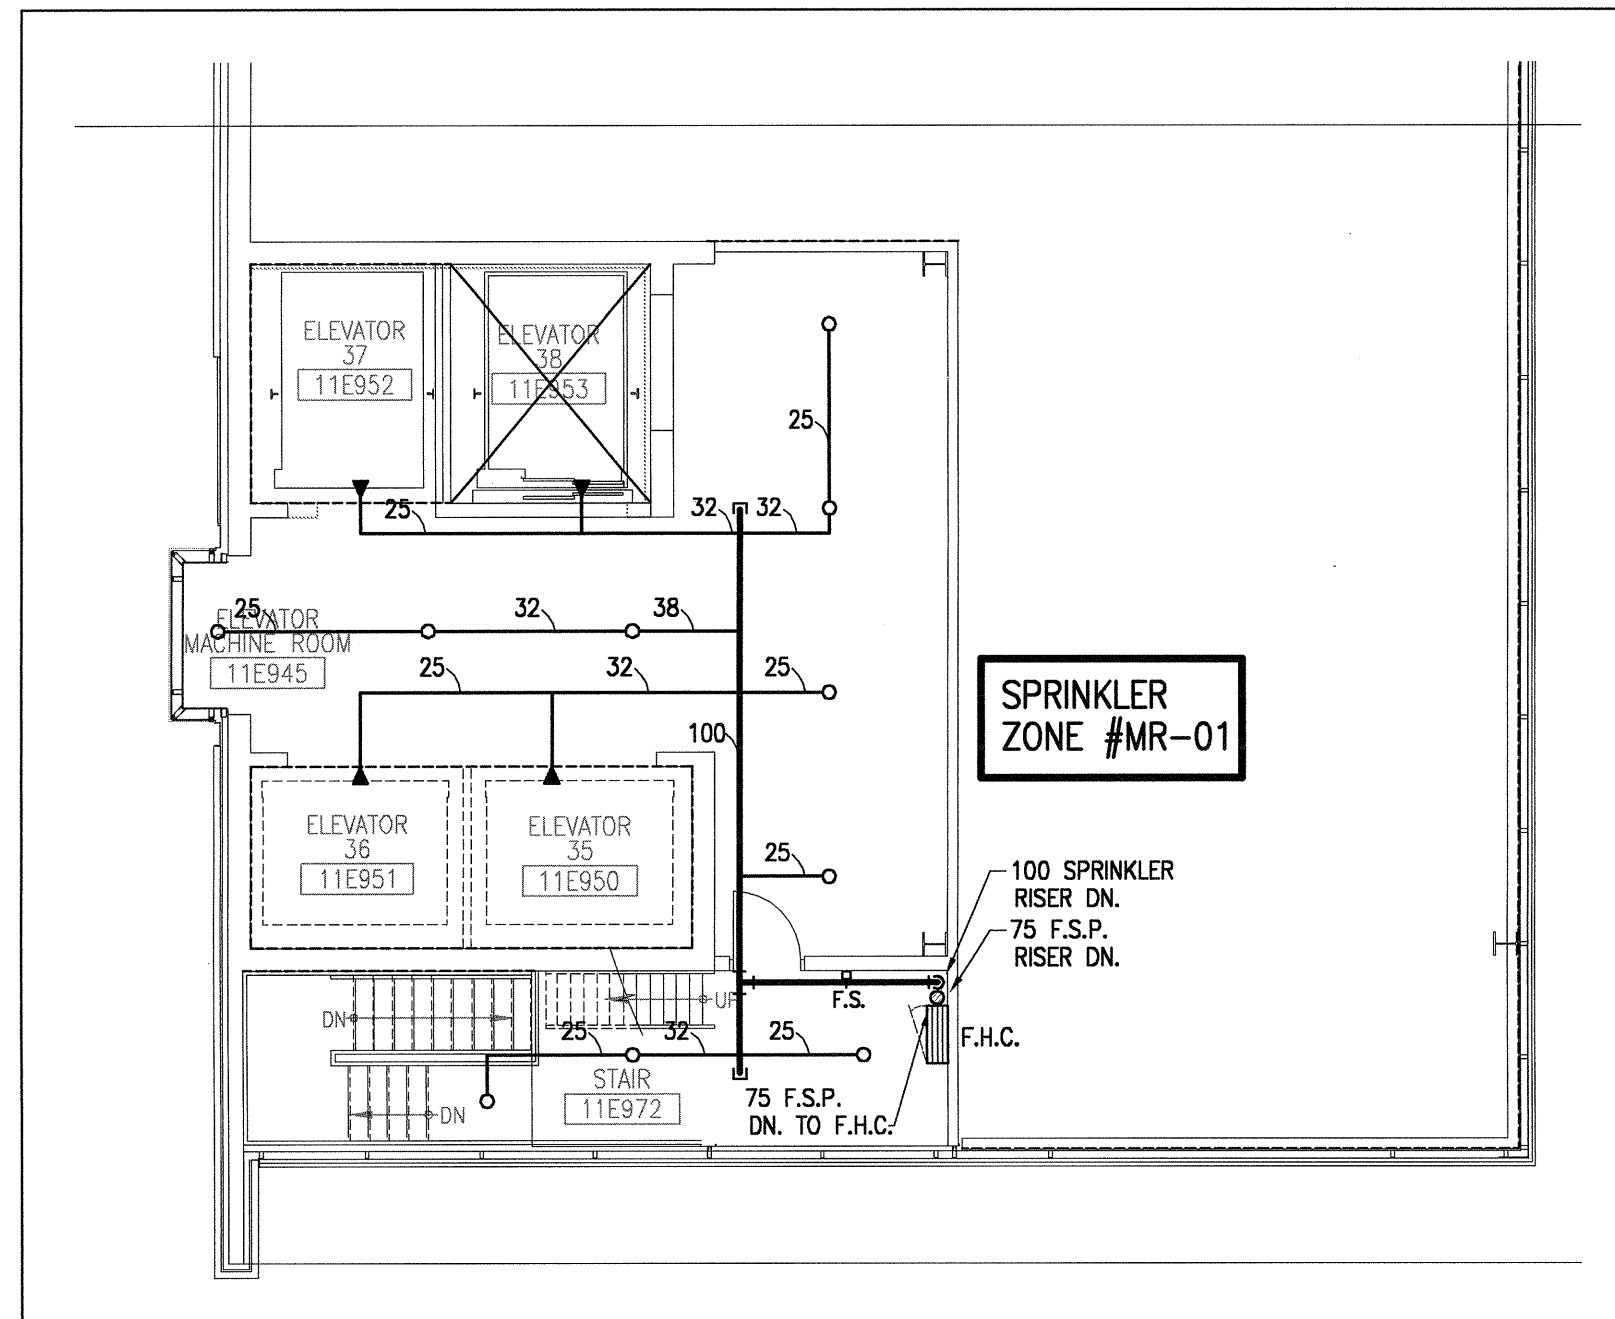

2 ELEVATOR MACHINE ROOM FLOOR PLAN
706 1:100

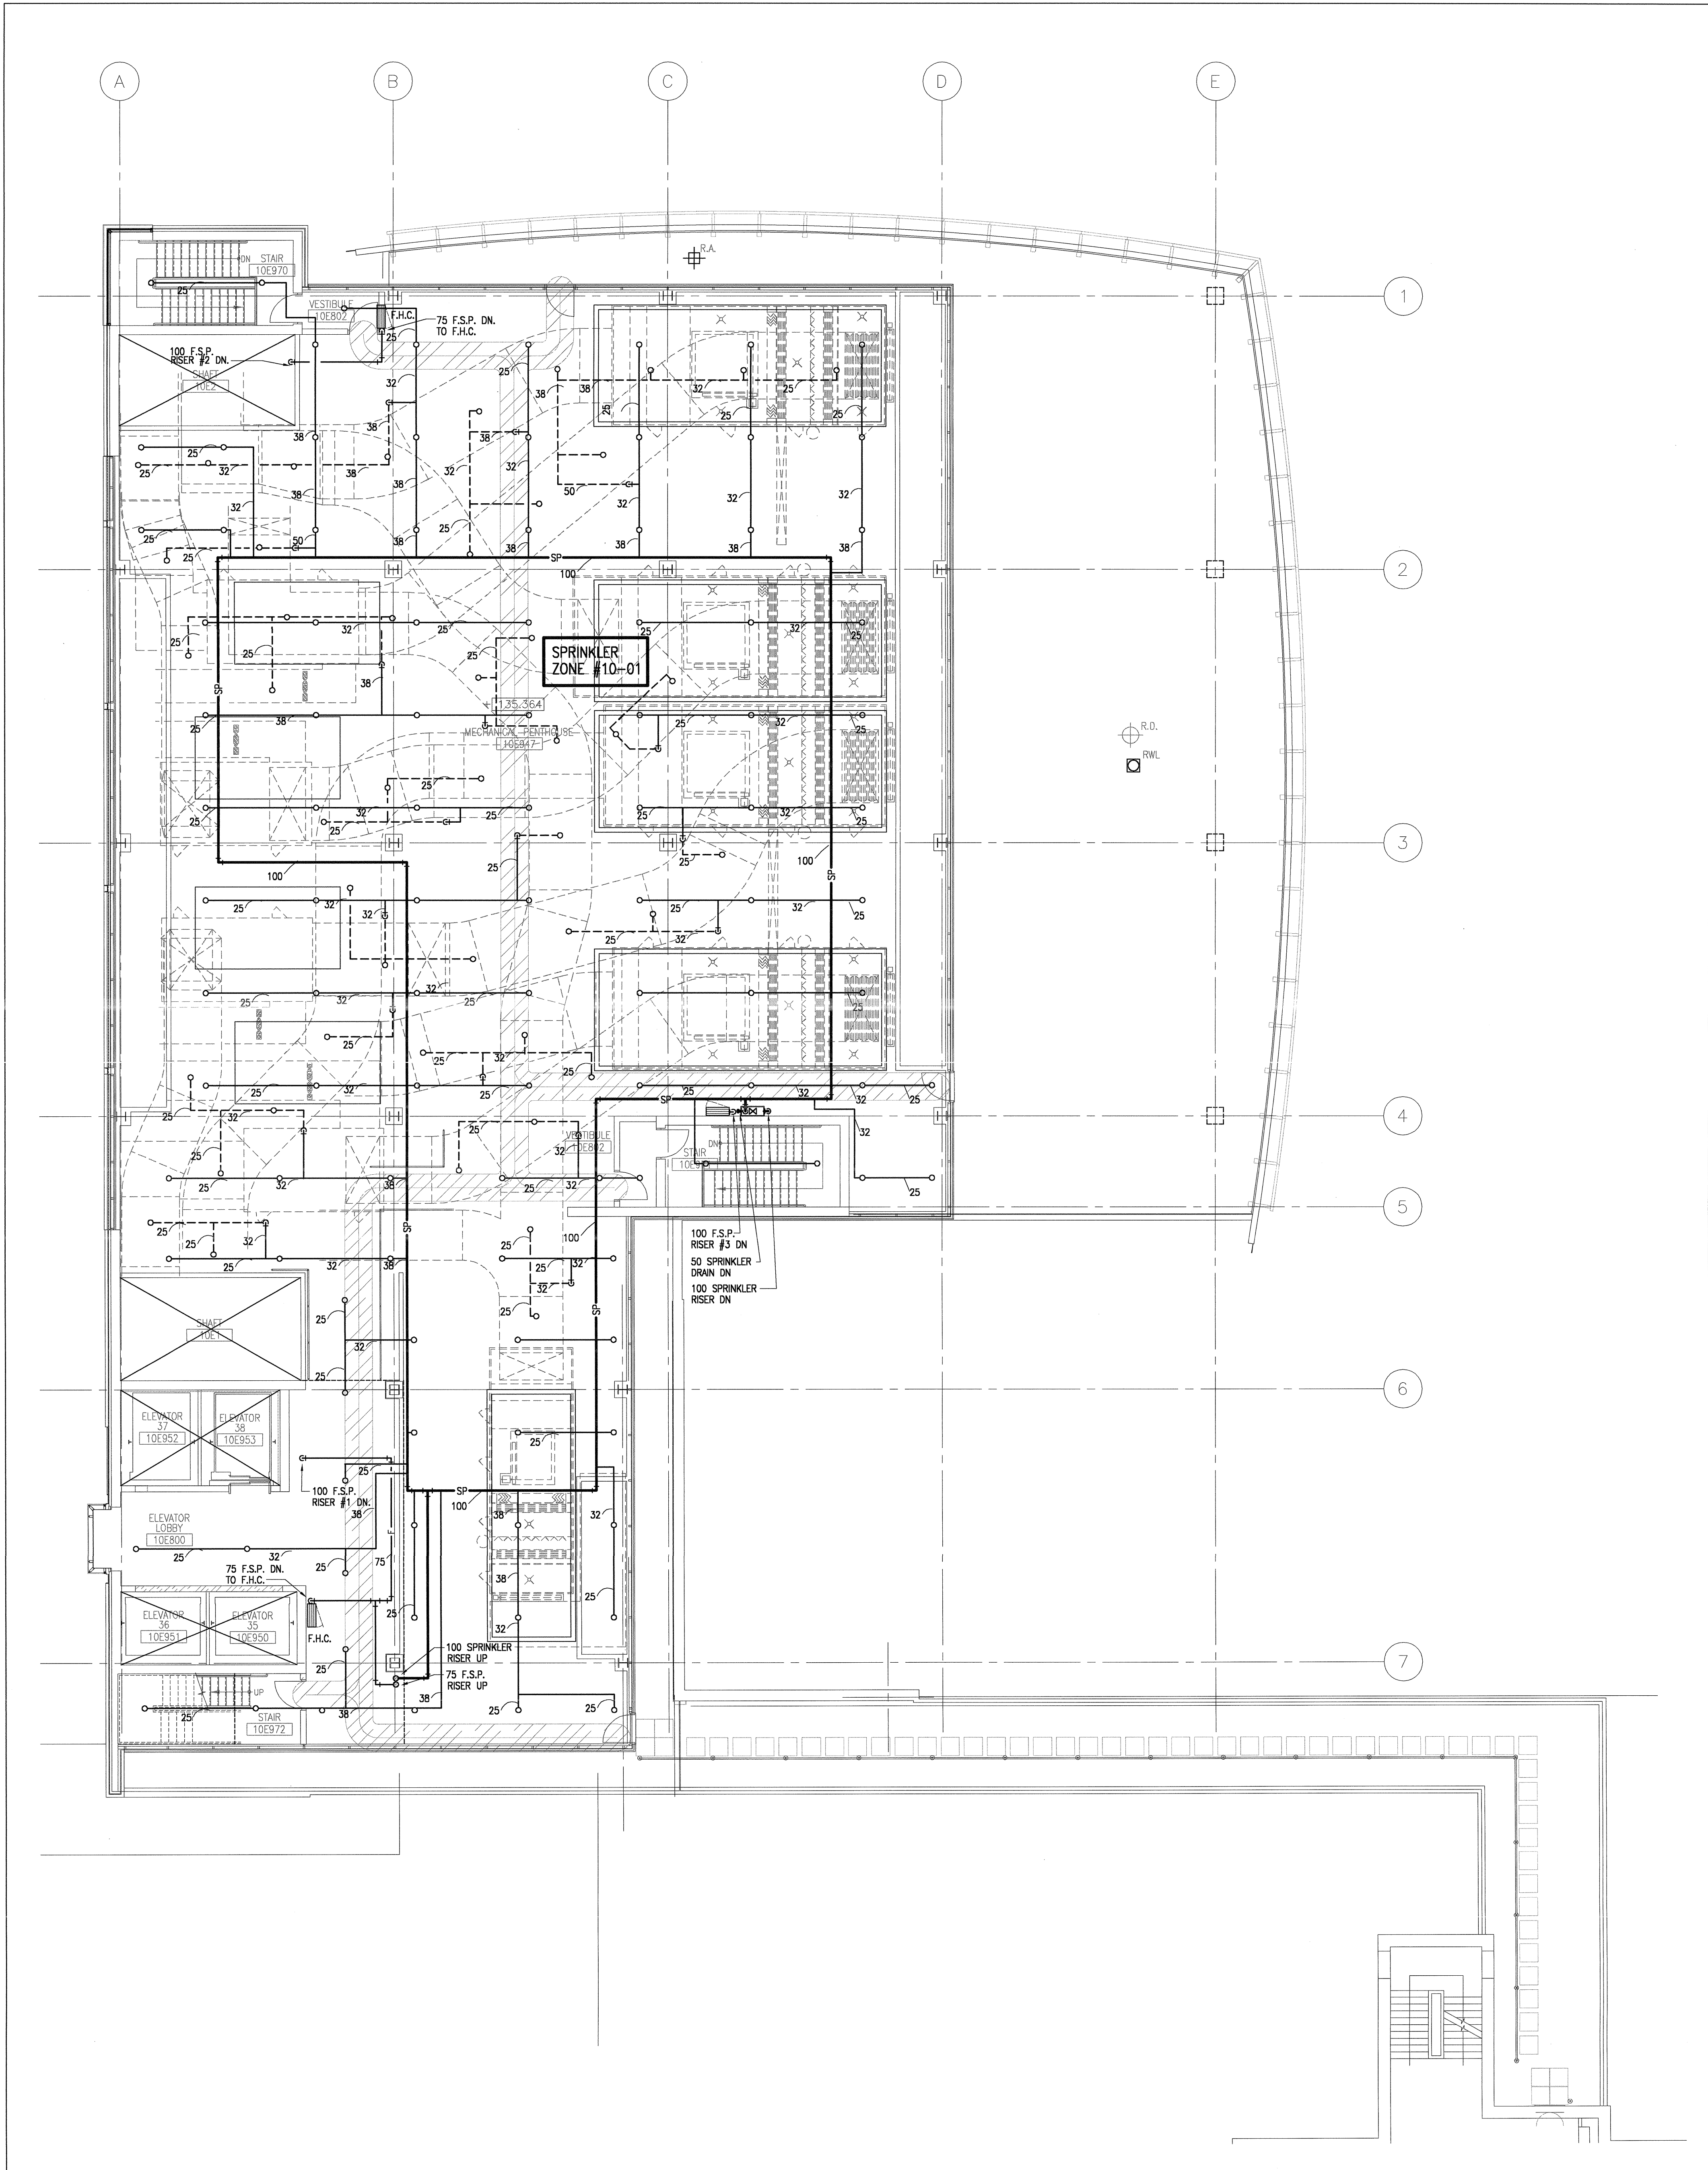


1 PENTHOUSE FLOOR PLAN
706 1:100



Toronto Western Hospital

University Health Network

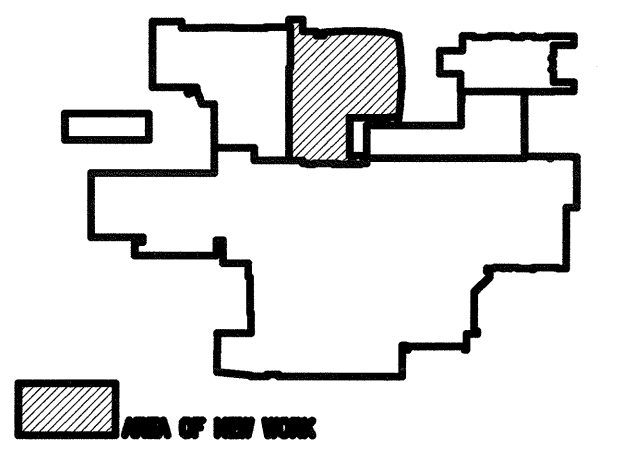


REV PLAN (R22)

9	07/04/30	ISSUED FOR AS BUILT DRAWINGS
8	03/06/20	ISSUED FOR CONSTRUCTION
7	03/04/11	REVISED FOR ADDENDUM M1
6	03/03/27	ISSUED FOR BUILDING PERMIT
5.1	03/03/27	ISSUED FOR GENERAL TENDER
5	03/03/18	ISSUED FOR GENERAL TENDER
4	03/01/28	ISSUED FOR BOM COSTING
3	02/12/19	APPLICATION FOR BUILDING PERMIT
2	02/11/17	ISSUED FOR BOM REVIEW
1	02/08/18	ISSUED FOR COSTING

REF.	DATE	DESCRIPTION
------	------	-------------

CHECK AND VERIFY ALL DIMENSIONS BEFORE PROCEEDING WITH THE WORK. DO NOT SCALE DRAWINGS.

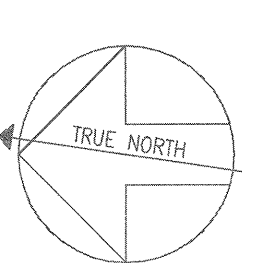


CONSTRUCTION NORTH

AS-BUILT DRAWINGS

PROJECT NAME:
TORONTO WESTERN HOSPITAL
EAST WING REDEVELOPMENT
MAIN BUILDING - STAGE TWO
TORONTO ONTARIO


DRAWING TITLE:
PENTHOUSE FLOOR PLAN
FIRE PROTECTION

SCALE: 1:100	PROJECT NUMBER: 2011210
DATE: February 25, 2003	DRAWING NUMBER: M2-706
DRAWN BY: G.P.	
CHECKED BY: J.J.	

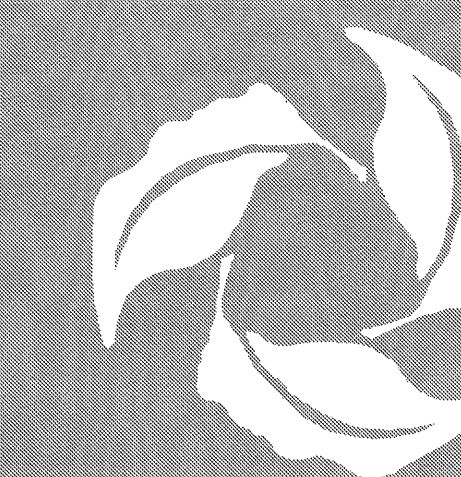

Toronto Western Hospital

University Health Network

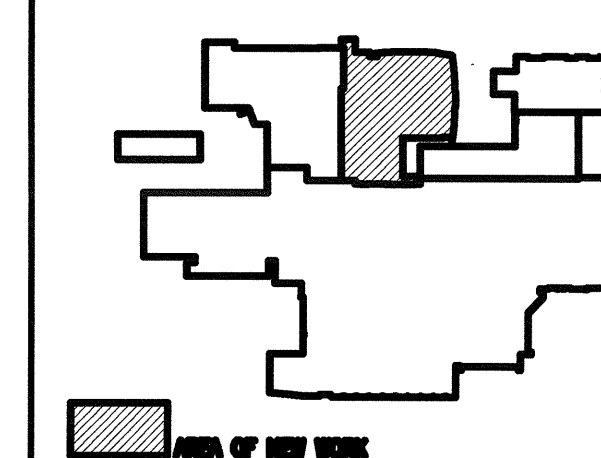


KEY PLAN (SEE)

- 8 07/04/00 ISSUED FOR AS BUILT DRAWINGS
- 7 03/06/00 ISSUED FOR CONSTRUCTION
- 6 03/03/00 ISSUED FOR BUILDING PERMIT
- 5 03/03/00 ISSUED FOR GENERAL TENDER
- 4 03/01/00 ISSUED FOR R.O.C. COSTING
- 3 02/12/00 APPLICATION FOR BUILDING PERMIT
- 2 02/11/00 ISSUED FOR R.O.C. REVIEW
- 1 02/06/00 ISSUED FOR COSTING

REF. DATE DESCRIPTION

(07/07/00)

CHECK AND VERIFY ALL DIMENSIONS BEFORE PROCEEDING WITH THE WORK. DO NOT SCALE DRAWINGS.

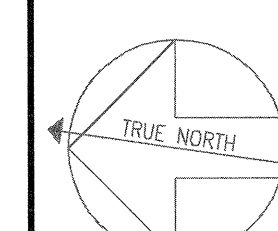

CONSTRUCTION NORTH


AS-BUILT DRAWINGS

PROJECT NAME:
TORONTO WESTERN HOSPITAL
EAST WING REDEVELOPMENT
MAIN BUILDING - STAGE TWO
TORONTO ONTARIO

DRAWING TITLE:
RISER DIAGRAM
PLUMBING

SCALE:
N.T.S.
DATE:
MARCH 2003
DRAWN BY:
DM
CHECKED BY:
LM


PROJECT NUMBER:
2011210
DRAWING NUMBER:
M2-801

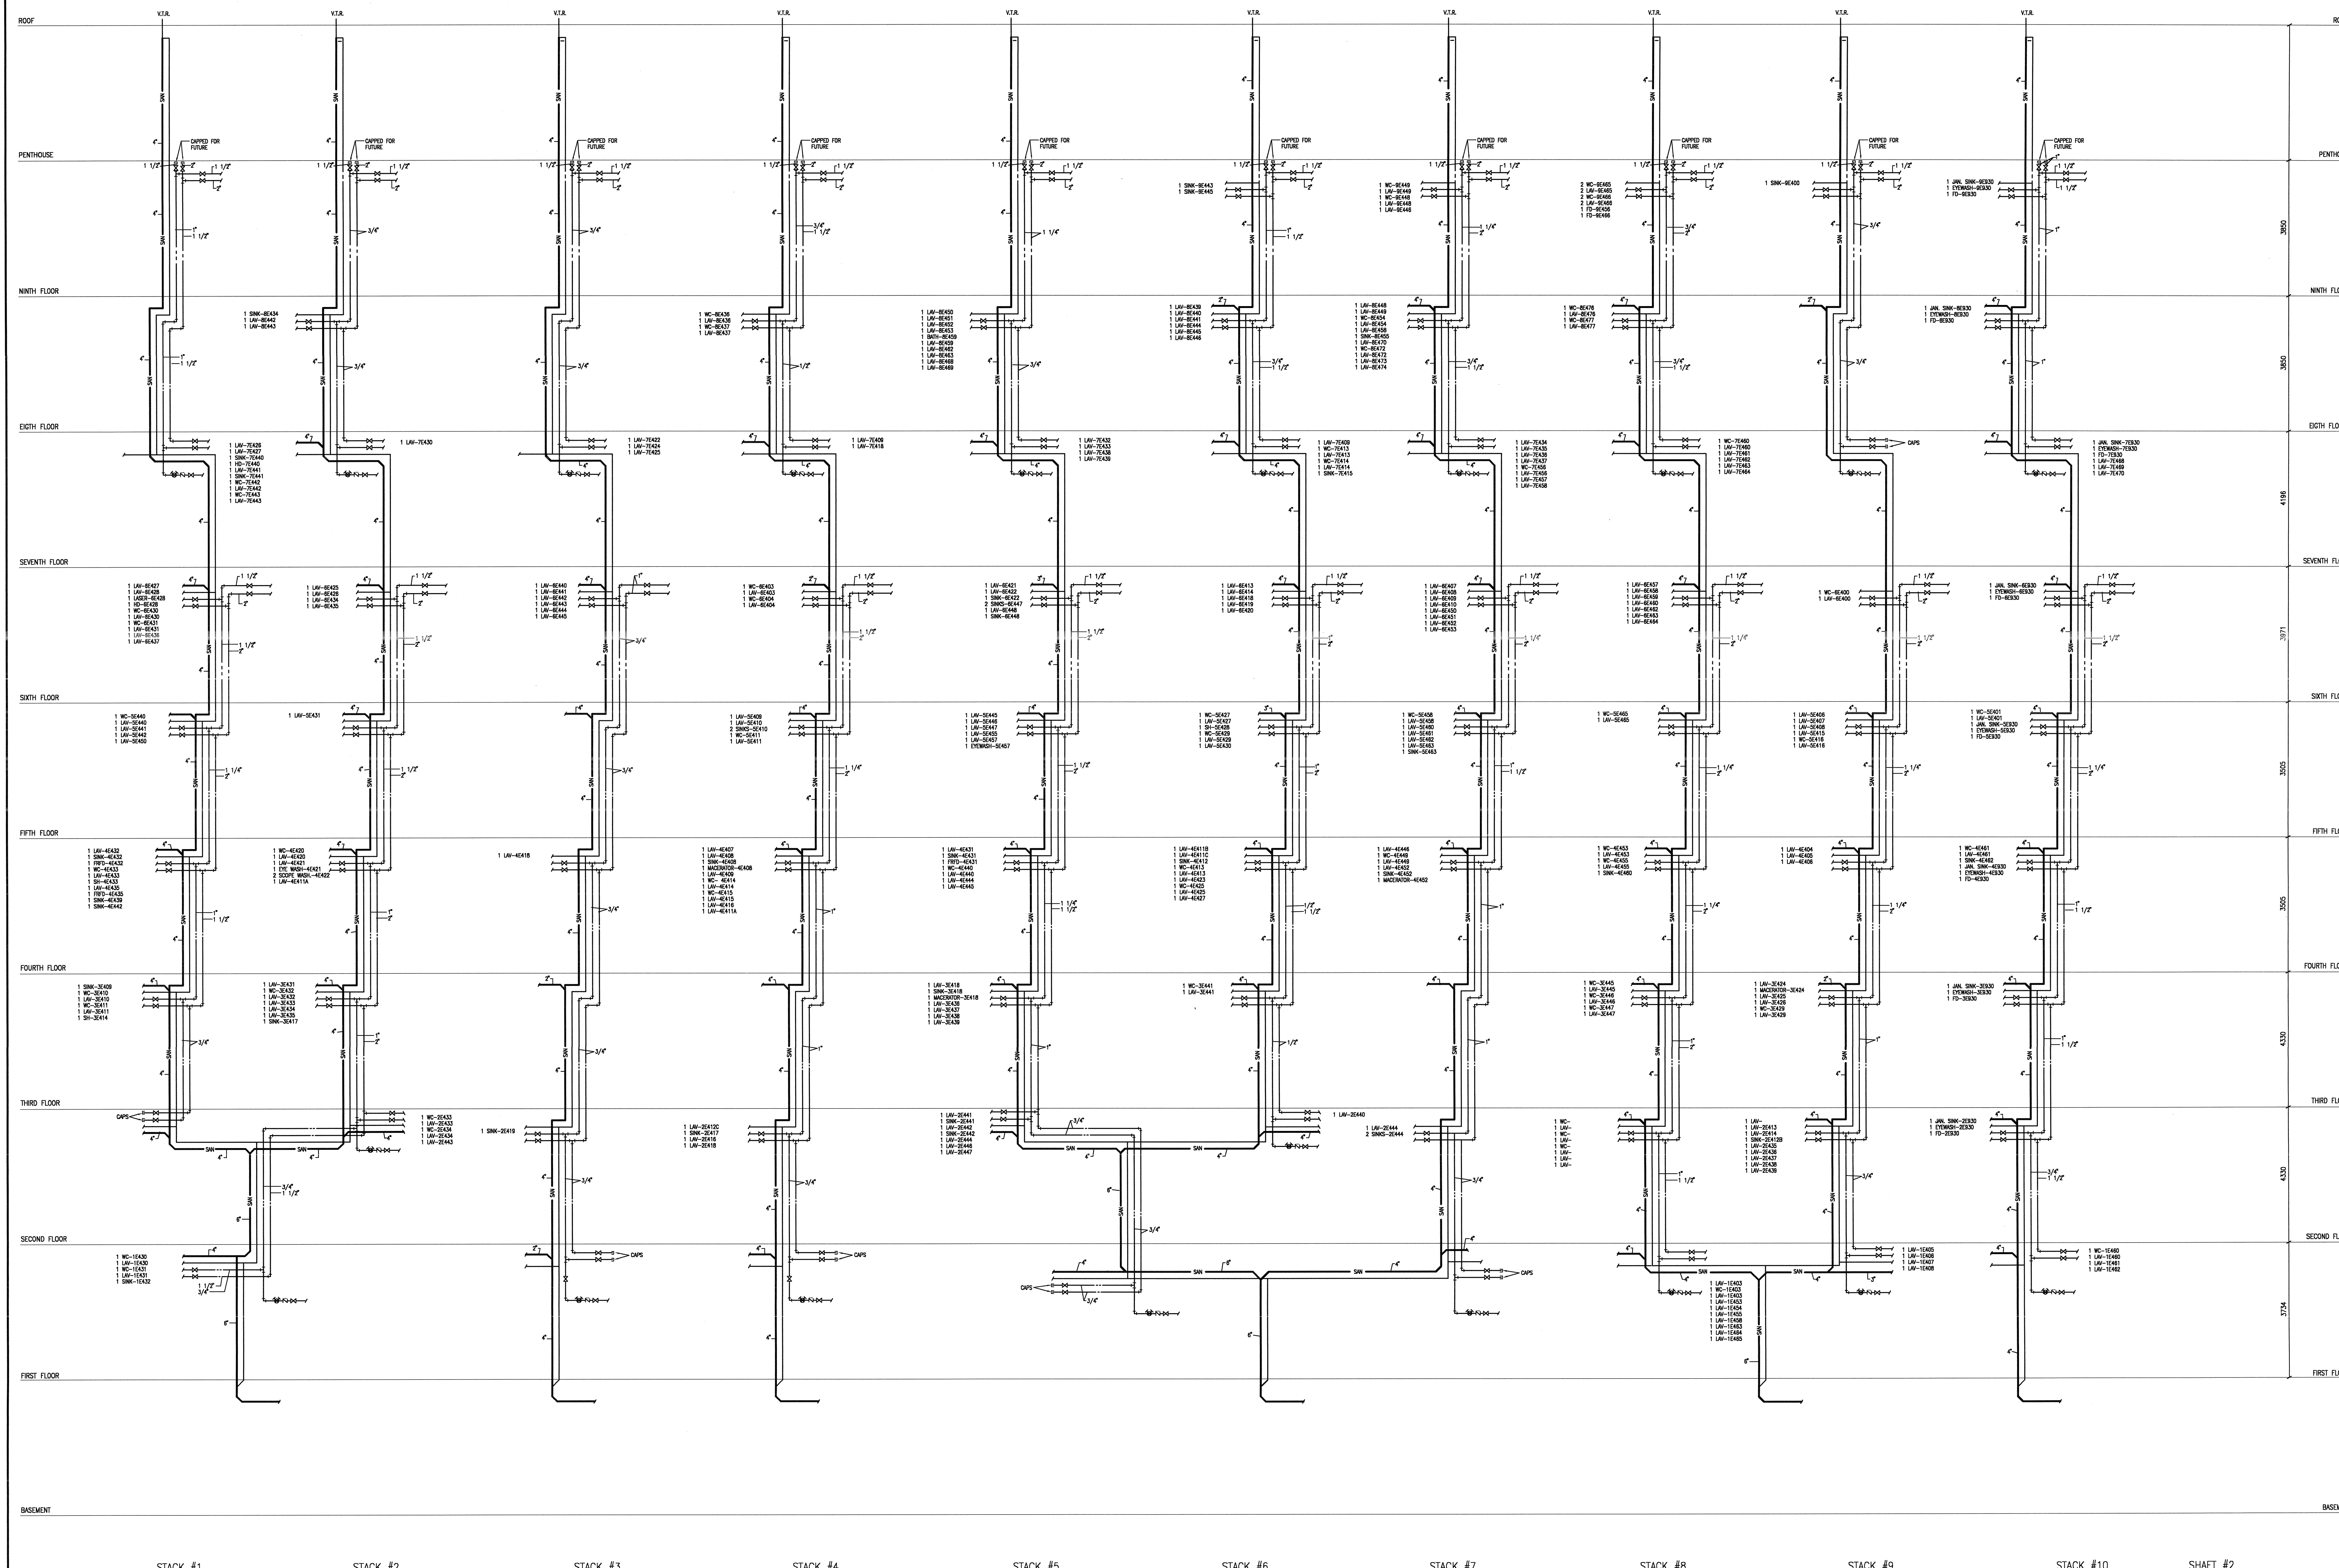



Toronto Western Hospital


University Health Network

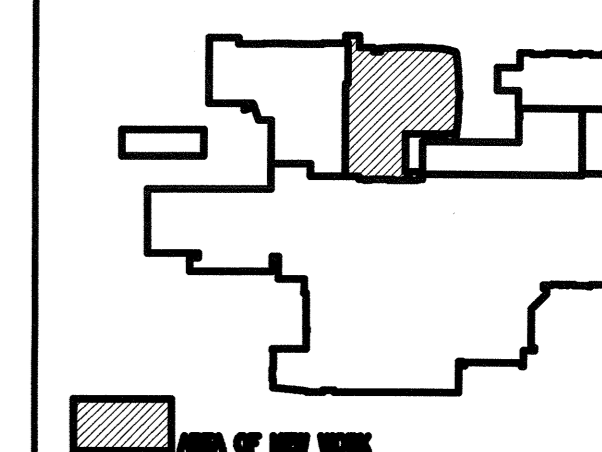

REF PLAN (S22)

REF.	DATE	DESCRIPTION
9	07/04/20	ISSUED FOR AS BUILT DRAWINGS
8	03/05/20	ISSUED FOR CONSTRUCTION
7	03/05/06	REVISED FOR ADDENDUM M6
6	03/03/27	ISSUED FOR BUILDING PERMIT
5	03/03/16	ISSUED FOR GENERAL TENDER
4	03/01/26	ISSUED FOR BOX COSTING
3	02/12/19	APPLICATION FOR BUILDING PERMIT
2	02/11/17	ISSUED FOR BOX REVIEW
1	02/08/16	ISSUED FOR COSTING

CHECK AND VERIFY ALL DIMENSIONS BEFORE PROCEEDING WITH THE WORK.

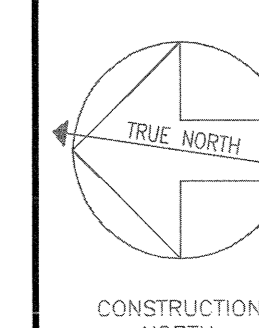

CONSTRUCTION NORTH

AS-BUILT DRAWINGS

PROJECT NAME:
TORONTO WESTERN HOSPITAL
EAST WING REDEVELOPMENT
MAIN BUILDING - STAGE TWO
TORONTO ONTARIO

DRAWING TITLE:
PERIMETER HEATING
RISER DIAGRAM

SCALE:
N.T.S.


DATE:
MARCH 2003

DRAWN BY:
M2-810


CHECKED BY:


PROJECT NUMBER:
2011210

DRAWING NUMBER:

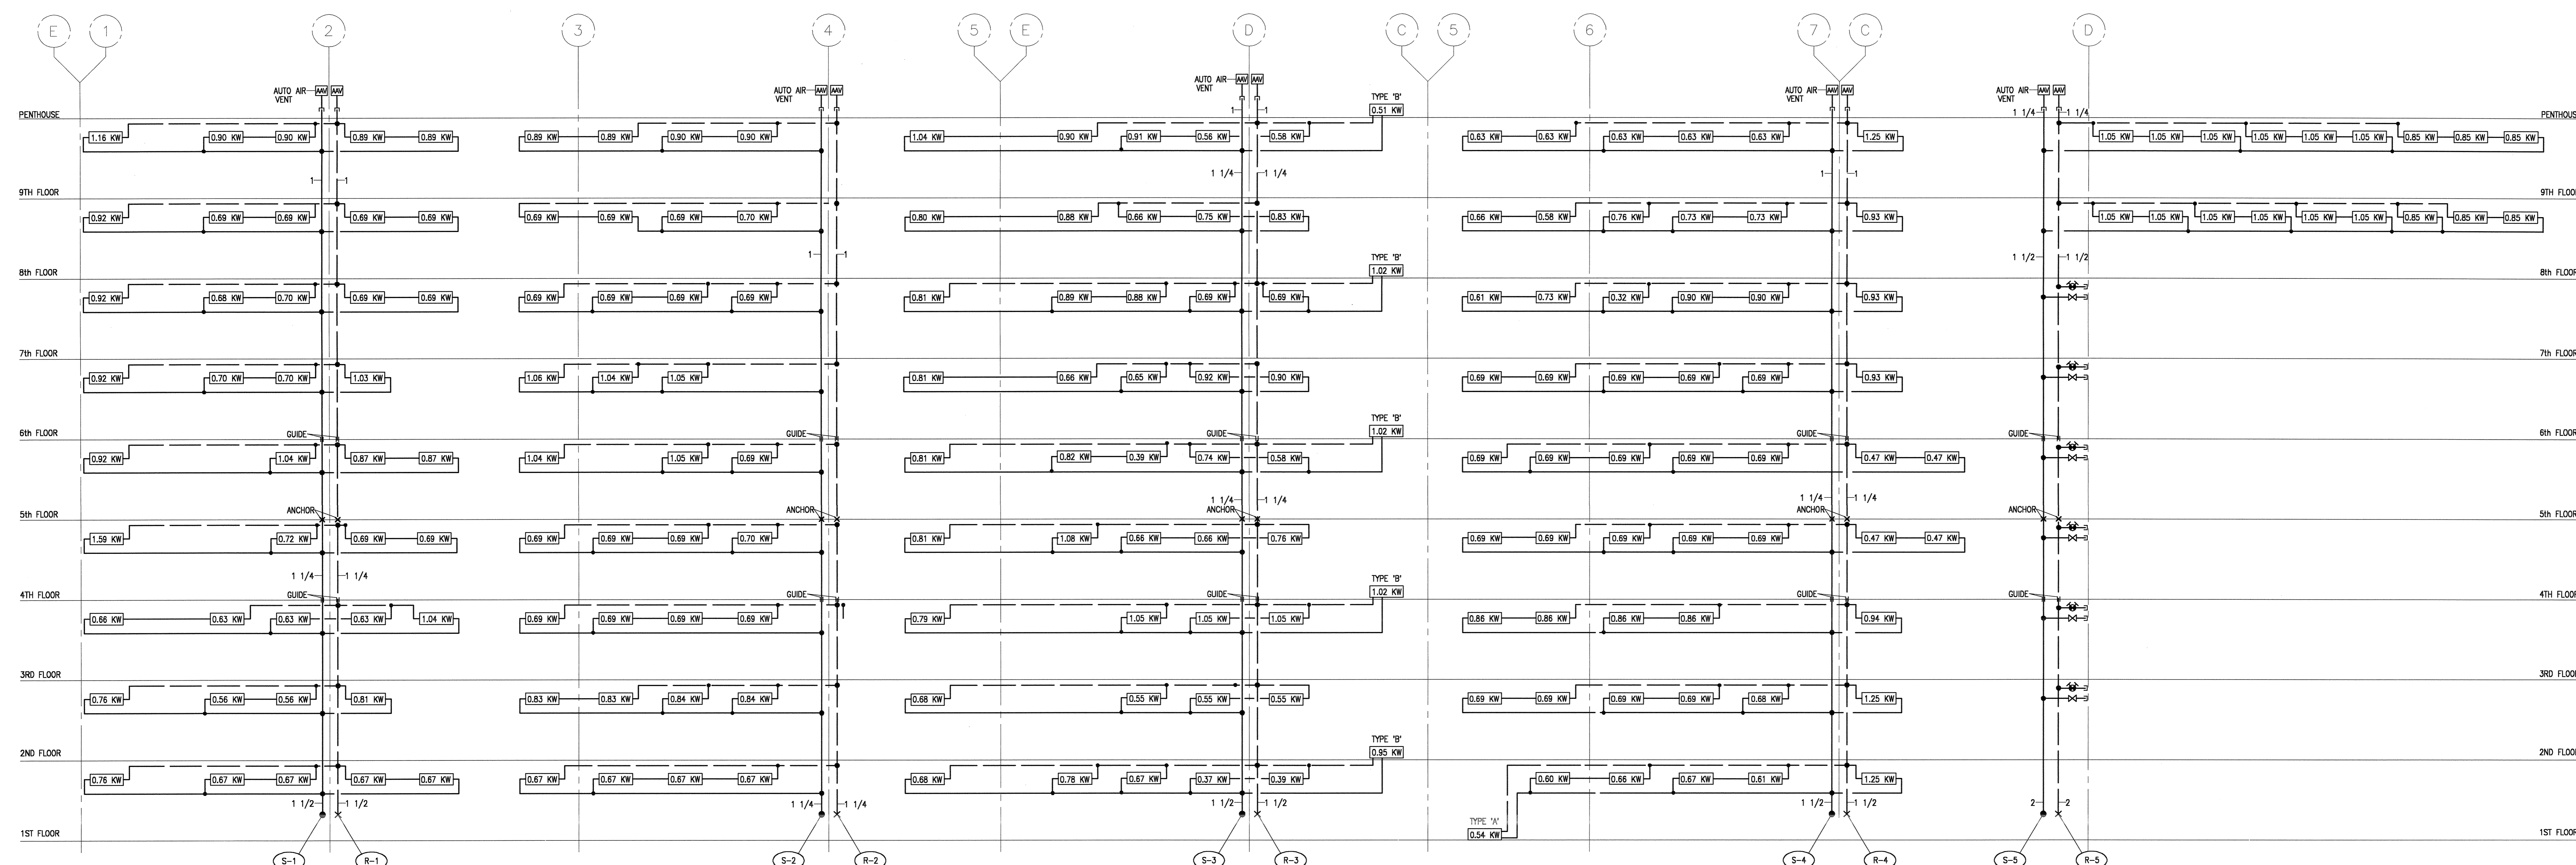


NOTES:
ALL BRANCH PIPING FROM RISERS TO BE NPS 3/4".
ALL RUNDOUT PIPING TO RADIANT PANELS TO BE NPS 1/2".
TYPE 'A' PANEL- EQUAL TO RADIANT RADIATOR 'R' MODEL WITH TYPE 'D' PIPING CONNECTION.
TYPE 'B' PANEL- EQUAL TO RADIANT RADIATOR 'R' MODEL WITH TYPE 'A' PIPING CONNECTION.

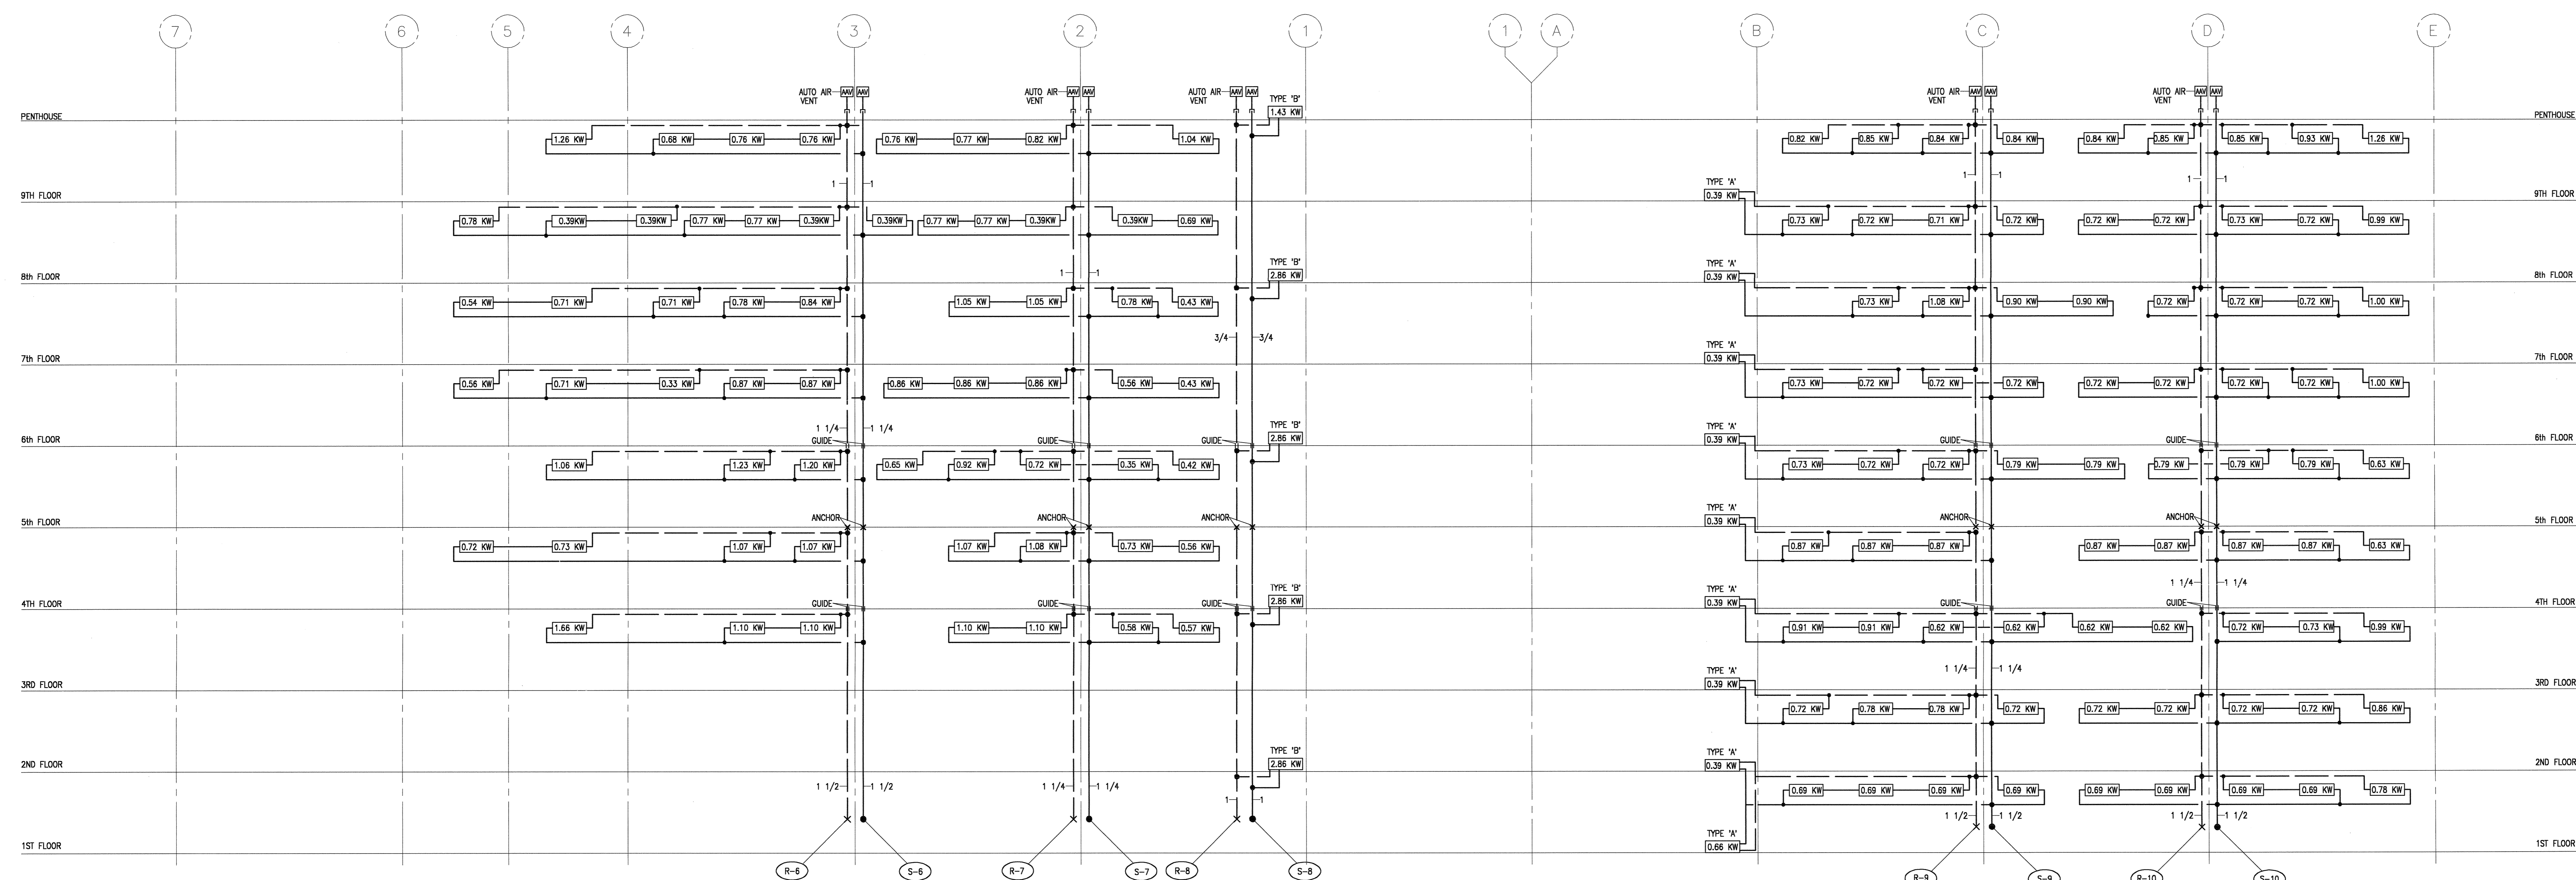


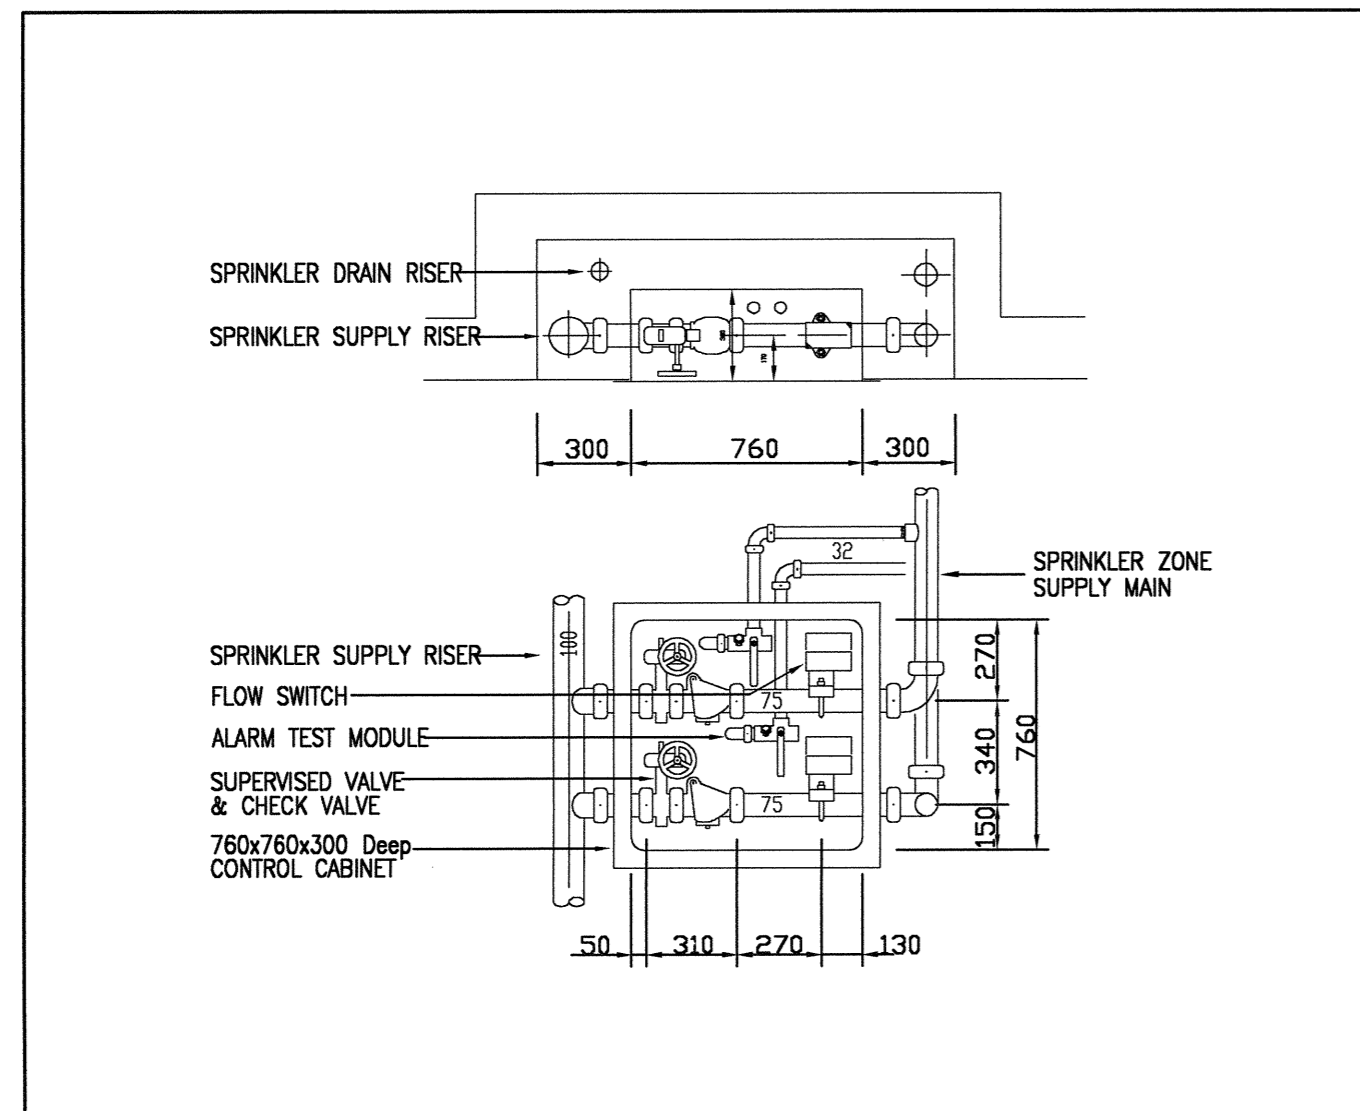


1 DOUBLE SPRINKLER CONTROL CABINET
M2-815 N.T.S.

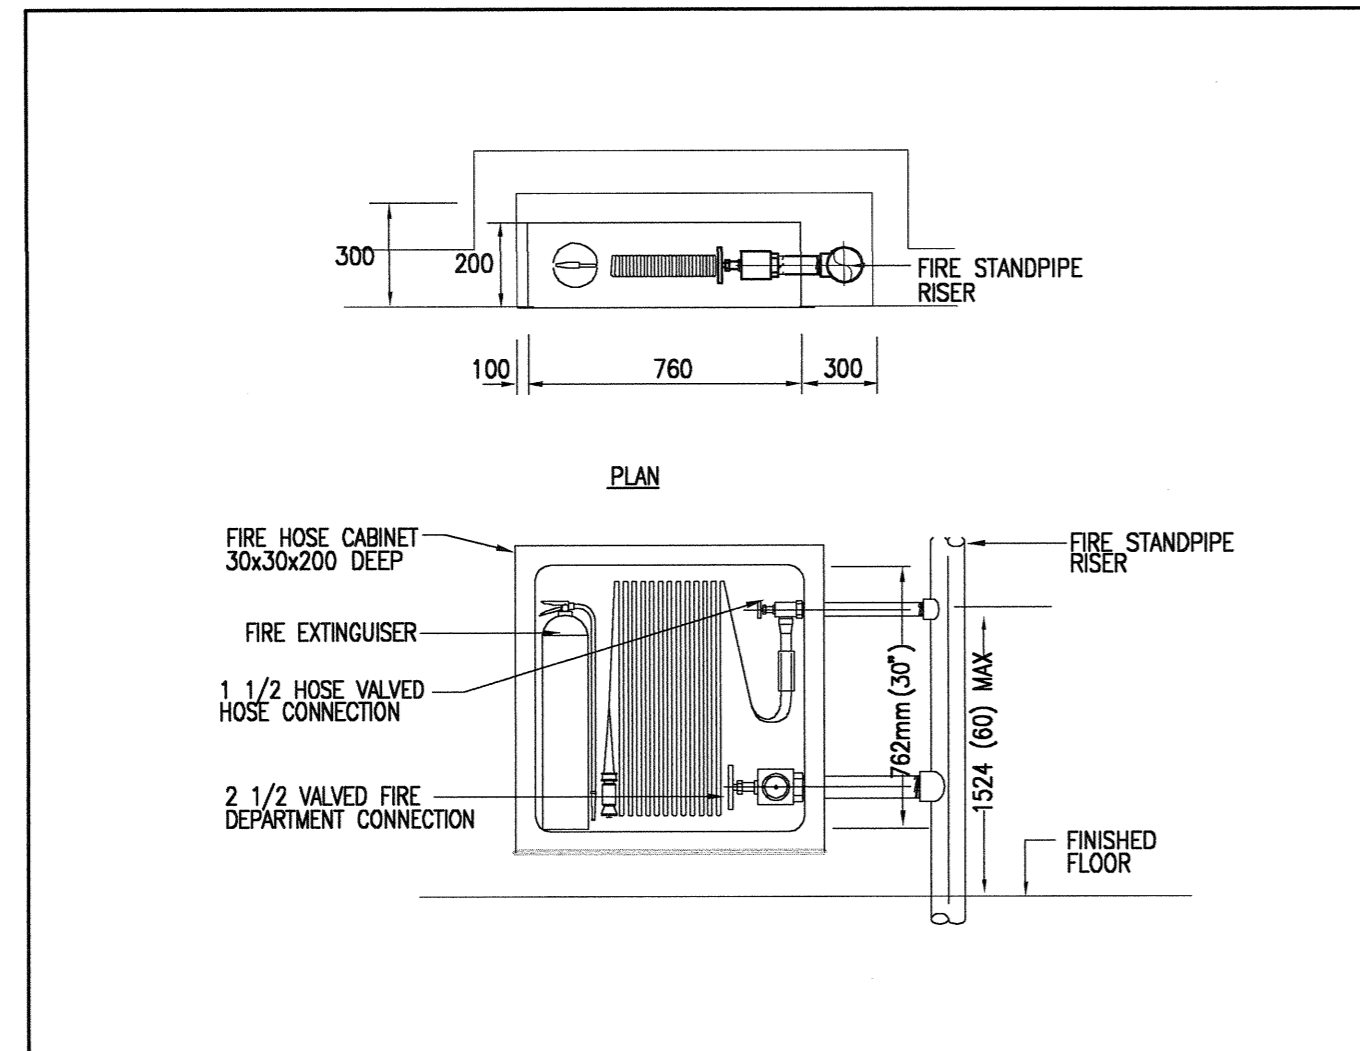


2 FIRE HOSE CABINET
M2-815 1:75

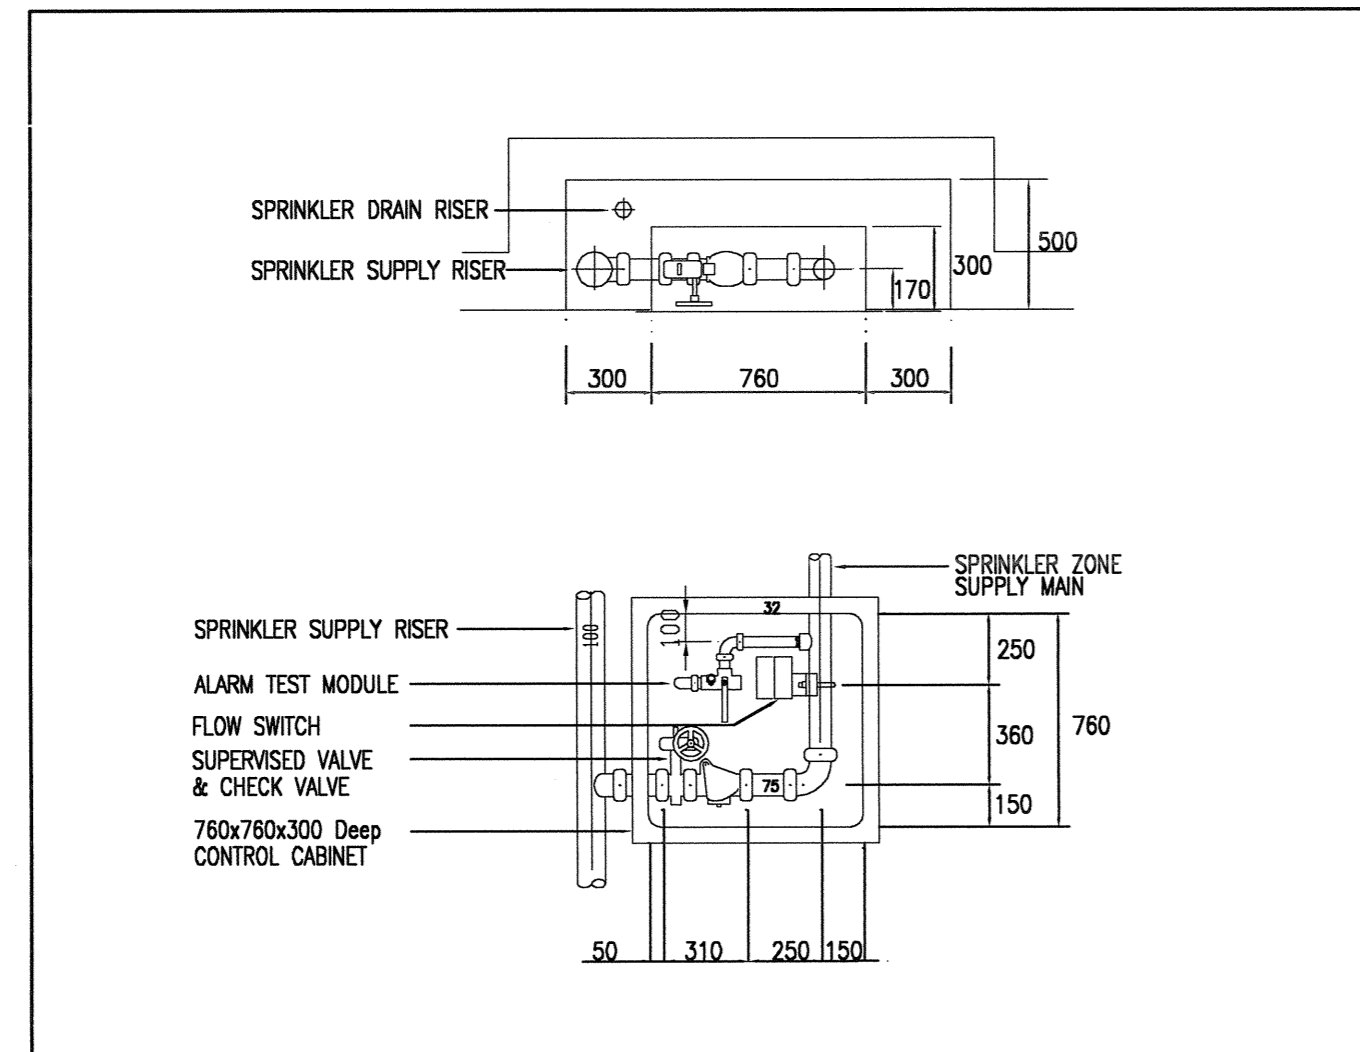


5 SPRINKLER CONTROL CABINET
M2-815 1:75

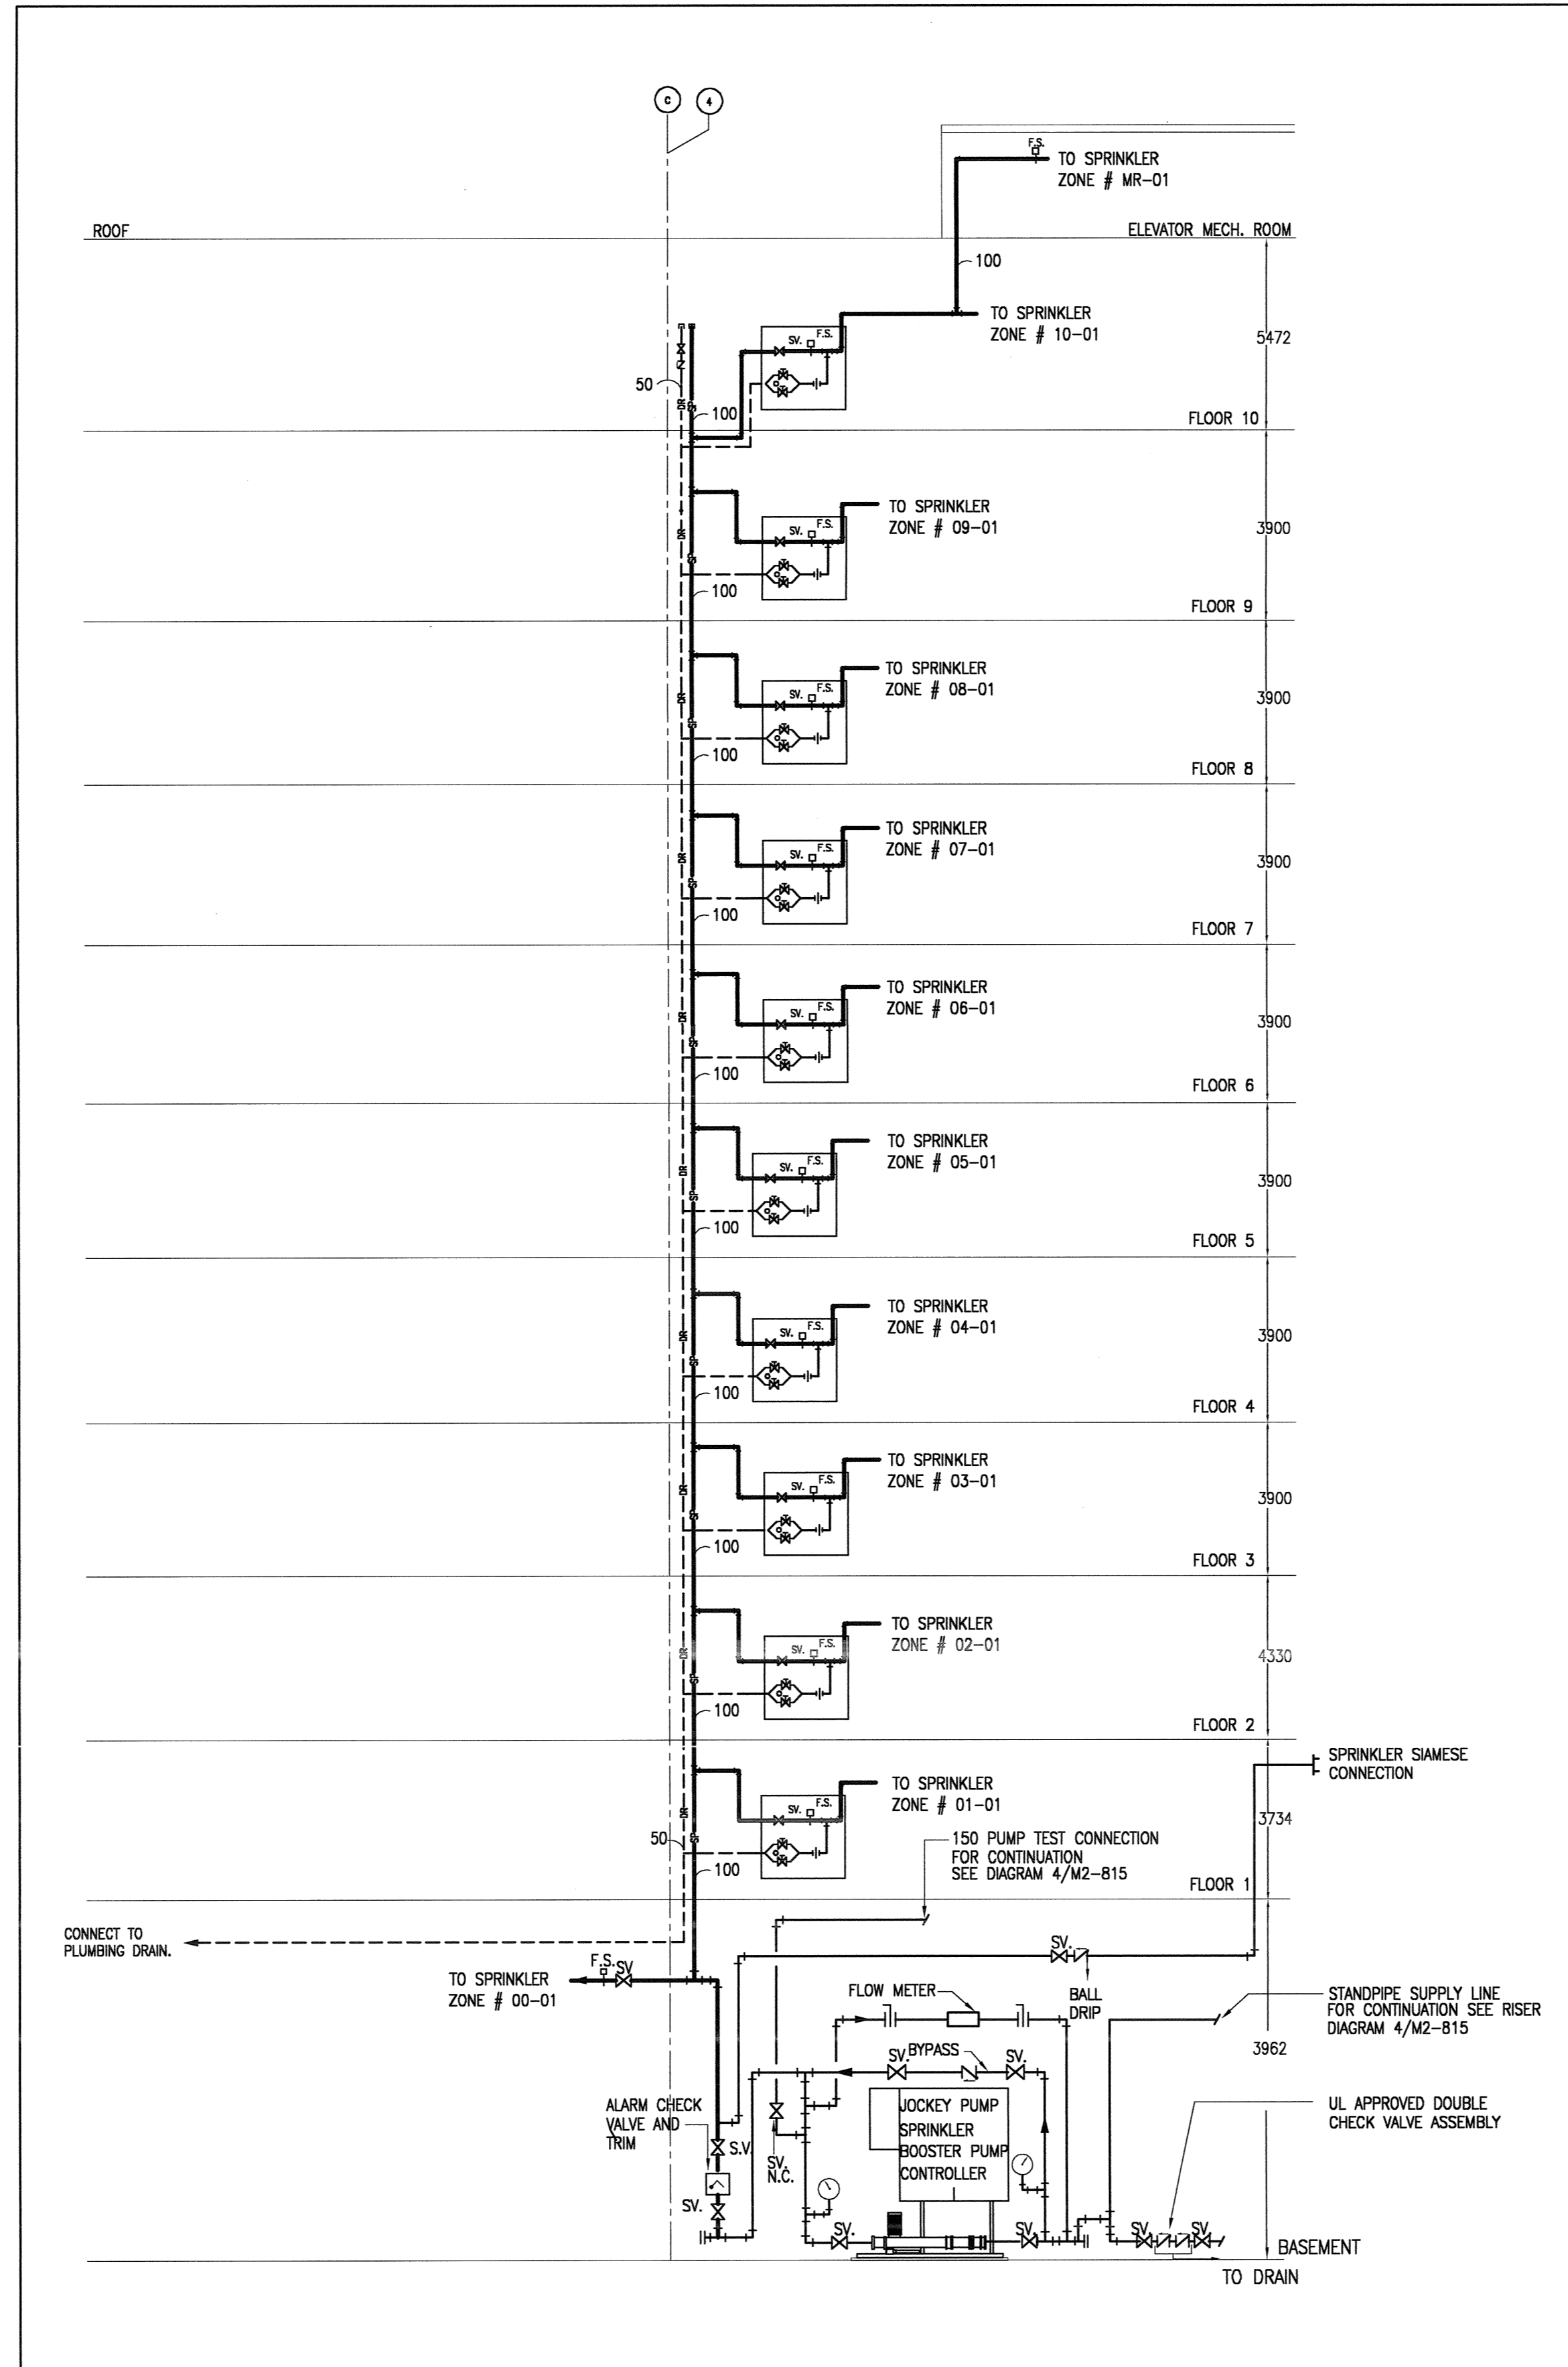

3 SPRINKLER RISER DIAGRAM
M2-815 N.T.S.

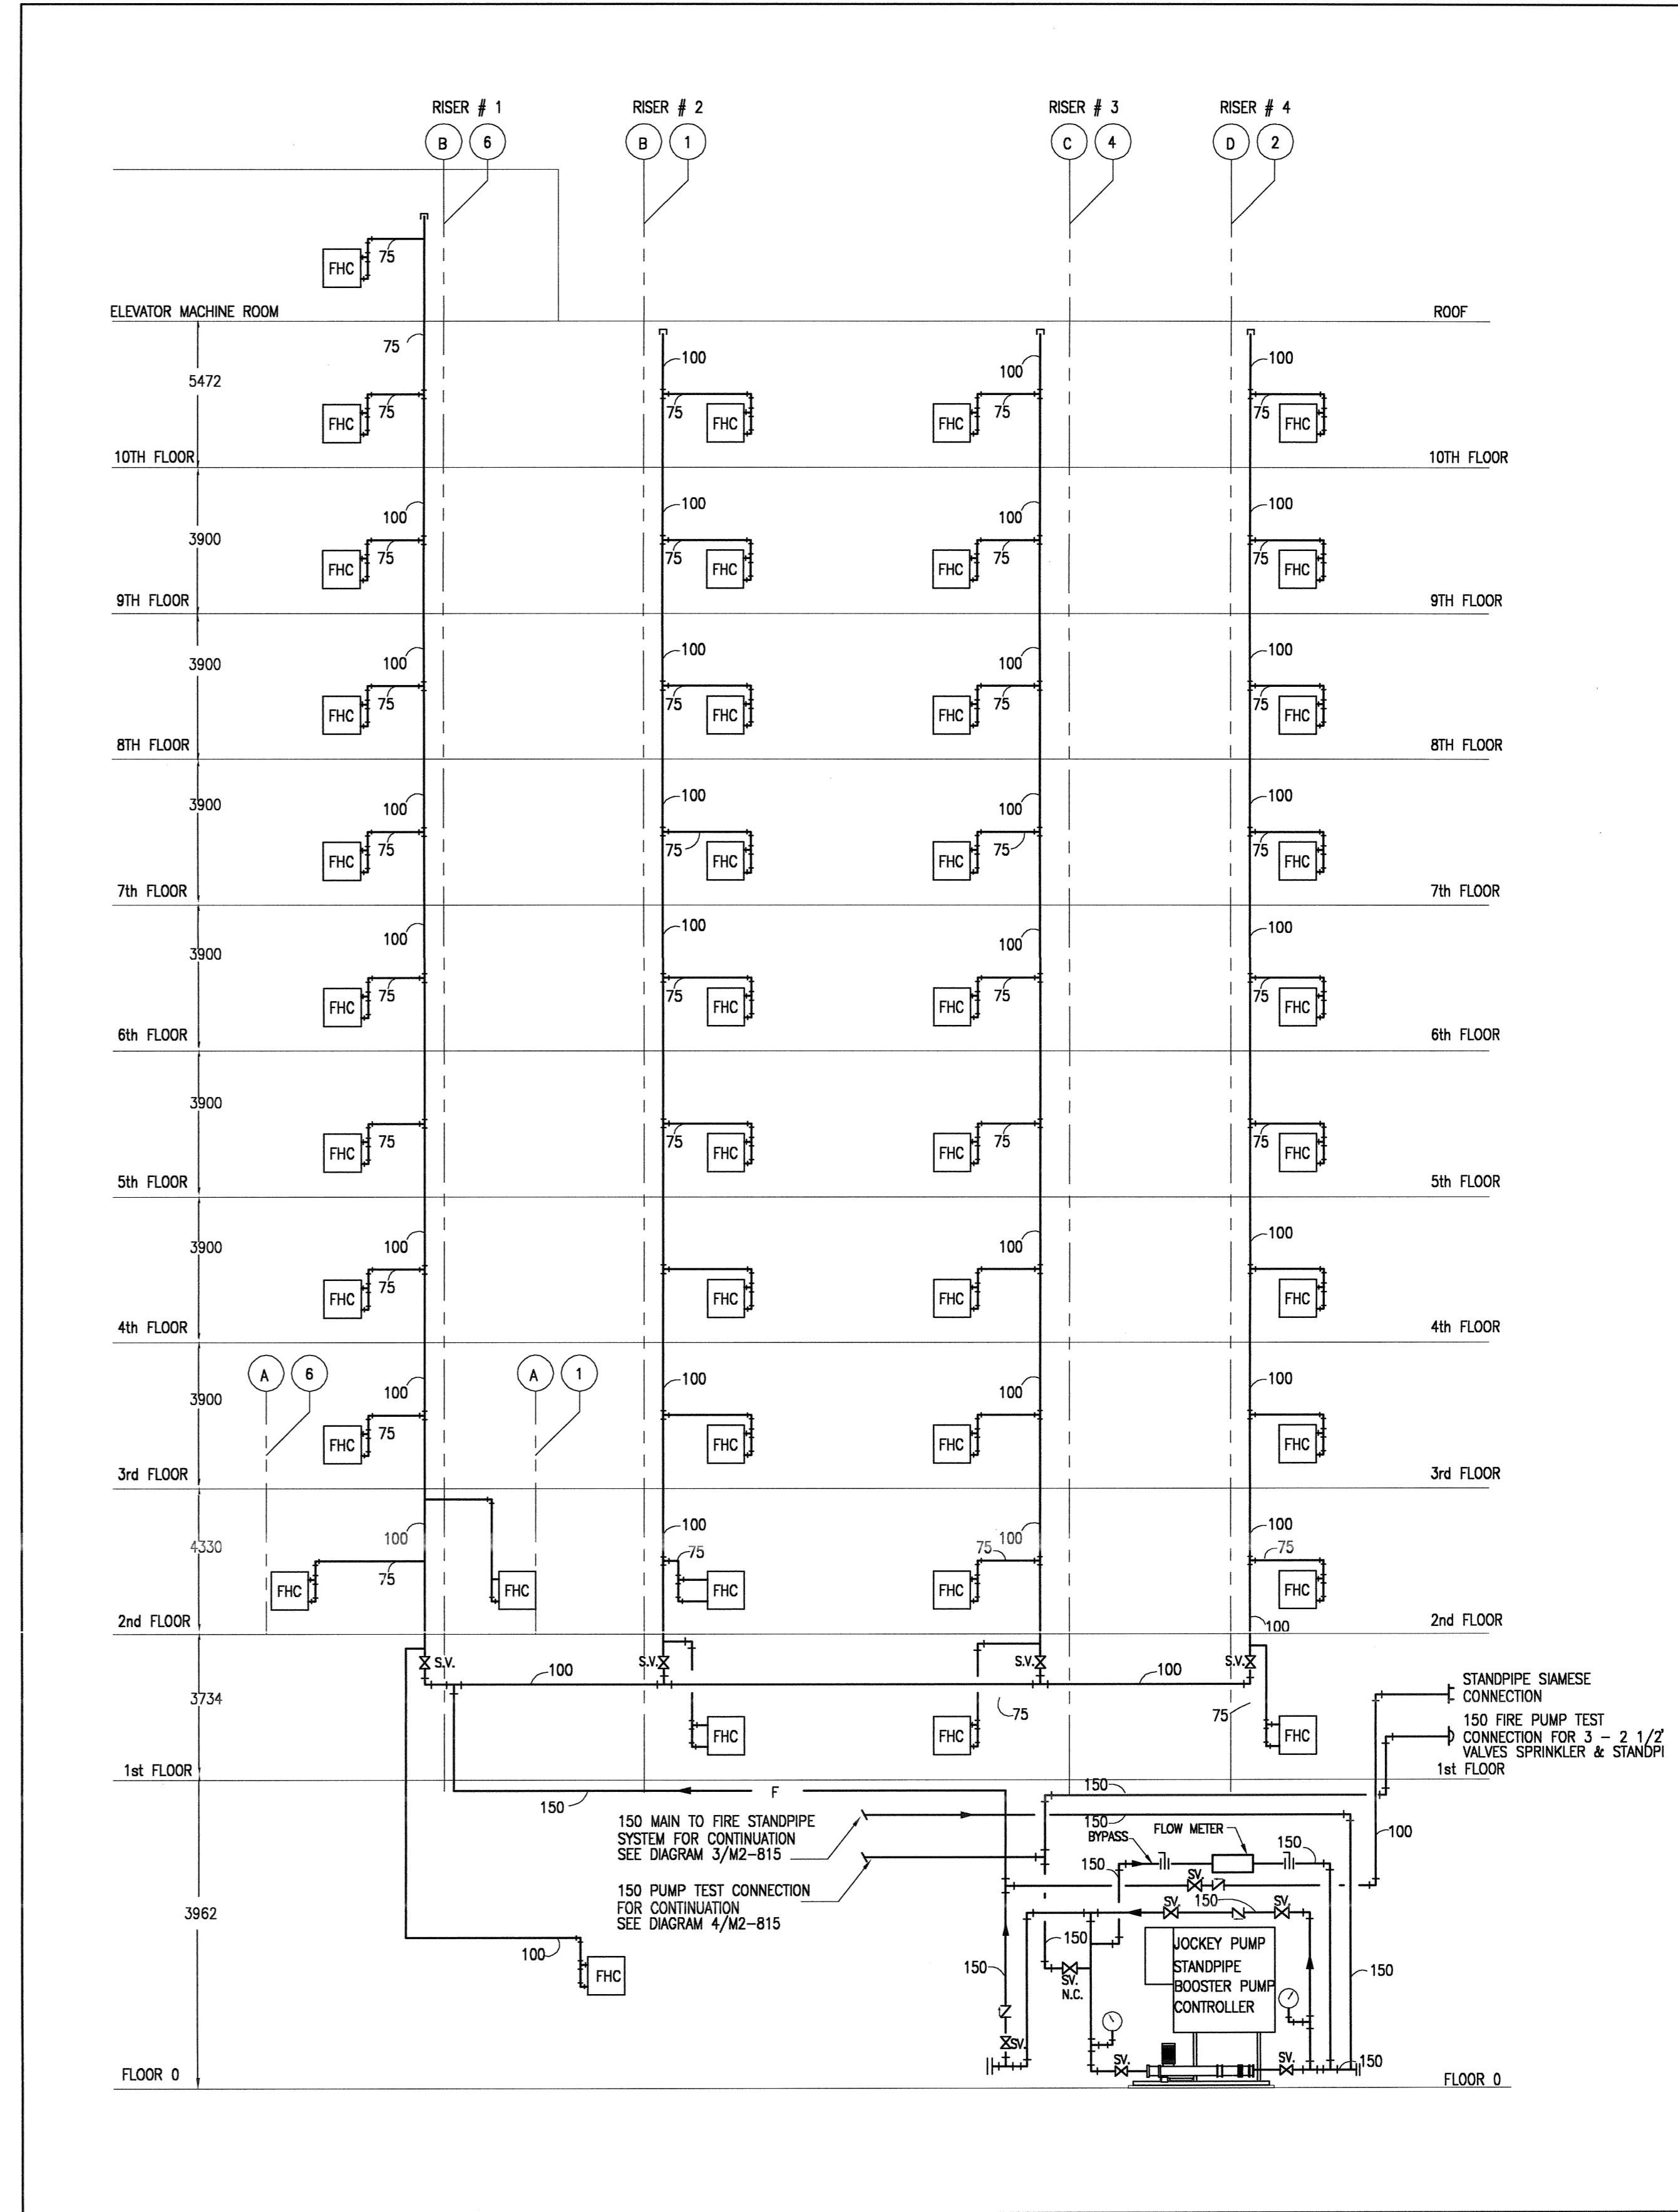

4 FIRE STANDPIPE RISER DIAGRAM
M2-815 N.T.S.

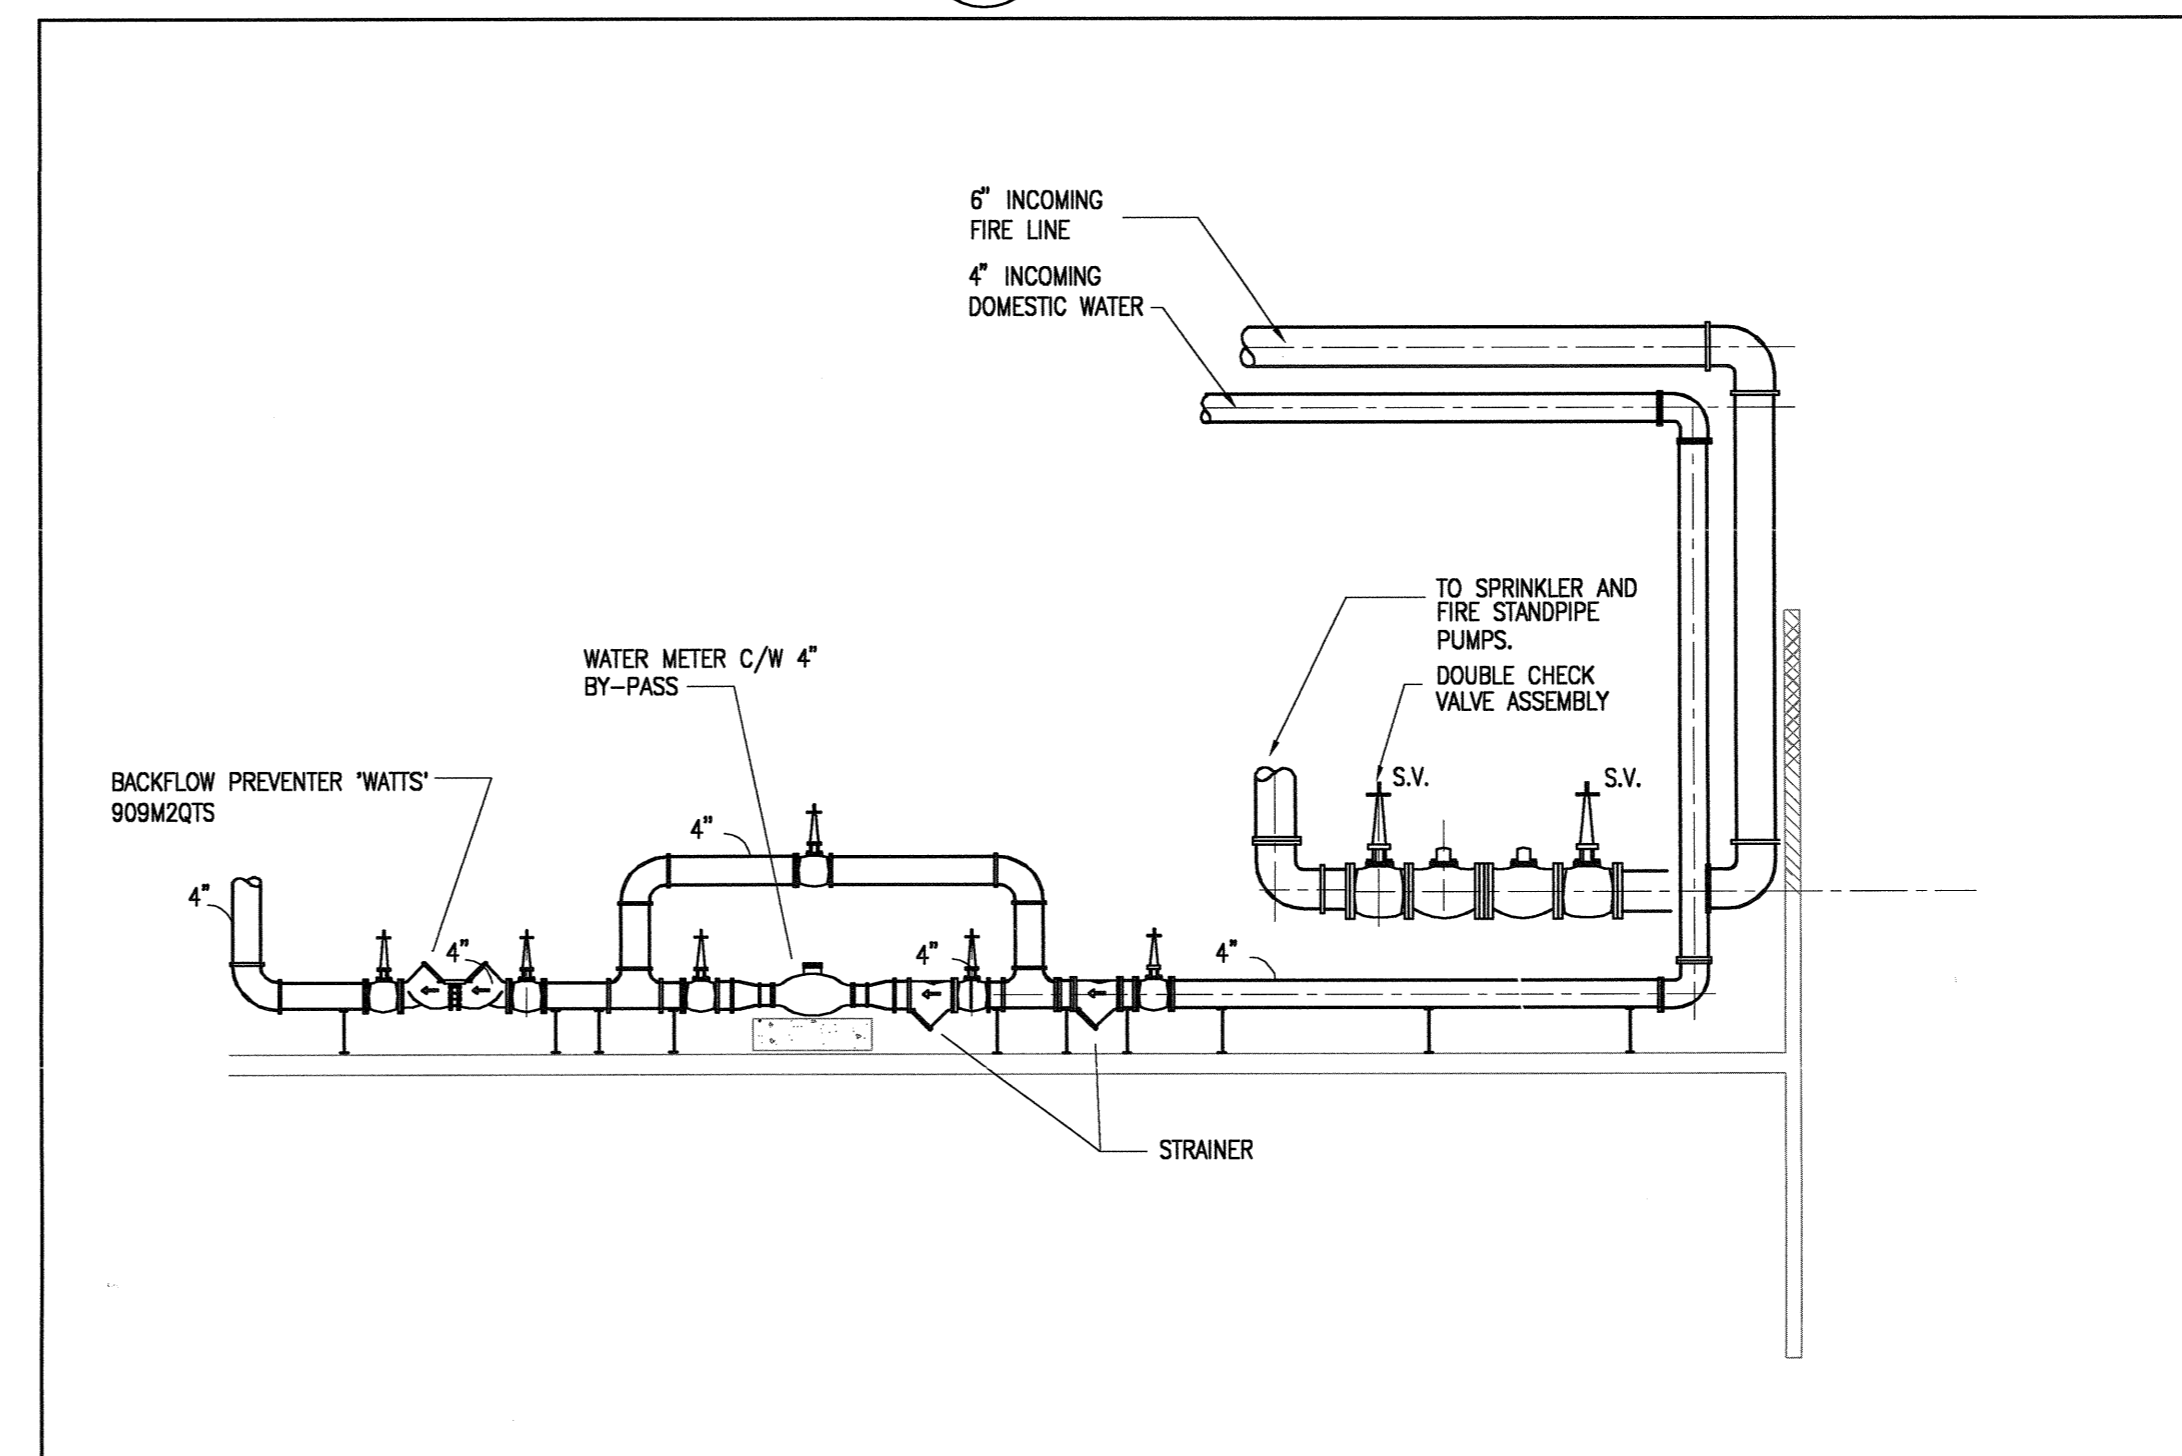


6 WATER METER ASSEMBLY DETAIL AND BACK FLOW PREVENTER
M2-815 N.T.S.

GENERAL NOTES

1. PROVIDE 1" VALVED AND CAPPED INSPECTOR'S TEST CONNECTION WITH HOSE END IN ALL SPRINKLER ZONES FOR INITIAL FLUSHING OUT OF THE SYSTEM AND REMOTE TESTING FOR ALARM DEVICES. PROVIDE ONE HOSE OF SATISFACTORY LENGTH, PROVIDE EACH SYSTEM WITH CHECK VALVE AND SHUT OFF VALVE IN CEILING SPACE TO FACILITATE DRAINING OF EACH SYSTEM.
2. PROVIDE FOR MINIMUM OF 25 SPRINKLER HEADS INCLUDING PIPING FOR SPRINKLING UNDER DUCTWORK AND UNFORESEEN OBSTRUCTIONS.
3. PROVIDE AUXILIARY DRAINS AS PER LAST ISSUE OF NFPA 13.
4. ADVISE AND ARRANGE WITH FIRE DEPARTMENT THE DATES OF TESTING ALARM DEVICES. COORDINATE THIS WORK WITH TRADES UNDER ELECTRICAL DIVISION. ENSURE ALL ALARM DEVICES ARE WORKING PRIOR TO CONTACTING FIRE DEPARTMENT.
5. EXAMINE ARCHITECTURAL REFLECTED CEILING PLAN TO COORDINATE SPRINKLER HEAD LAYOUT & LOCATIONS.
6. ALL SYSTEMS SHALL BE HYDRAULICALLY SIZED. ALL PIPES SIZING SHALL BE BASED ON CONTRACTOR'S OWN HYDRAULIC CALCULATIONS AT NO ADDITIONAL COST TO THE OWNER. PROVIDE ADDITIONAL HEADS AS REQUIRED TO MEET NFPA 13.
7. PRESSURE REDUCING VALVE: SINGLE SEATED HYDRAULICALLY OPERATED, PILOT CONTROLLED, SUPPLY SIDE, GLOBE OR ANGLE MAIN VALVE WITH EPDM, KYMAR OR ECITE INTERFACED.


SPRINKLER HEAD DISCHARGE DENSITIES

HAZARD CLASSIFICATIONS	DESIGN DENSITY (U.S. gpm/100 ft ² /sq)
LIGHT HAZARD PATIENT CARE AREAS OFFICE AREAS ASSEMBLY AREAS	0.1
ORDINARY HAZARD (GROUP 1) LABORATORY AREAS CLINICAL PHARMACY MECHANICAL SERVICE AREAS	0.15

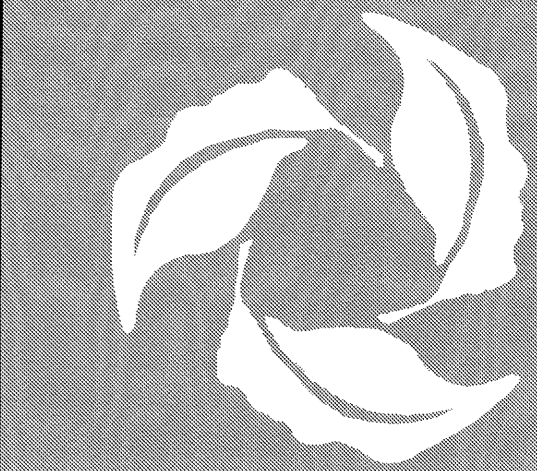

Toronto Western Hospital


University Health Network

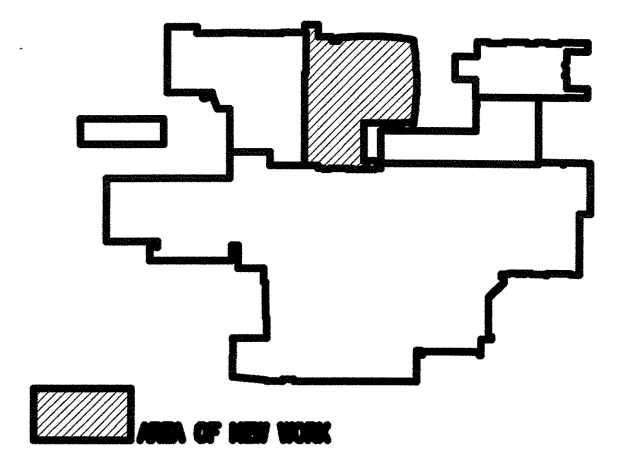

REF PLAN (S23)

DATE	DESCRIPTION
07/04/20	ISSUED FOR AS-BUILT DRAWINGS
03/06/20	ISSUED FOR CONSTRUCTION
03/05/19	REVISED FOR POST TENDER ADDENDUM M1
03/04/24	REVISED FOR ADDENDUM M3
03/04/11	REVISED FOR ADDENDUM M1
03/03/27	ISSUED FOR BUILDING PERMIT
03/03/18	ISSUED FOR GENERAL TENDER
03/03/08	ISSUED FOR BOK COSTING
03/02/29	ISSUED FOR BOK COSTING
02/12/29	ISSUED FOR BOK REVIEW
02/08/25	ISSUED FOR COSTING

CHECK AND VERIFY ALL DIMENSIONS BEFORE PROCEEDING WITH THE WORK. DO NOT SCALE DRAWINGS.

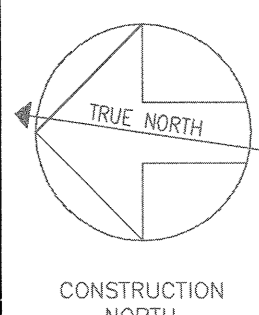

AS-BUILT DRAWINGS

PROJECT NAME:
TORONTO WESTERN HOSPITAL
EAST WING REDEVELOPMENT
MAIN BUILDING - STAGE TWO
TORONTO ONTARIO

DRAWING TITLE:
FIRE PREVENTION
RISER DIAGRAM


SCALE: N.T.S.	PROJECT NUMBER: 2011210
DATE: AUG2022	DRAWING NUMBER: M2-815
DRAWN BY: G.P.	CHECKED BY: J.J.

XREF:
2061008-45-155
2061008-4560
Level-8 Plumb
LV8-DAR
LV8-DTX
LV8-AR


DRAWING NOTES:

- ① DENOTES REMOVE EXISTING PLUMBING FIXTURES. SANITARY DRAIN FROM FIXTURES TO BE REMOVED AND CAPPED IN CEILING SPACE BELOW. C.W. H.W. AND VENT PIPING TO BE REMOVED BACK TO RISER AND CAPPED.
- ② DENOTES REMOVE EXISTING SANITARY STACK, VENT STACK, FROM 8TH FLOOR CEILING TO 7TH FLOOR CEILING.

THE EXISTING PLUMBING AND DRAINAGE LAYOUT HAS BEEN TAKEN FROM ALL AVAILABLE INFORMATION AND SHALL BE ACCURATELY CHECKED ON THE SITE AND ALL DISCREPANCIES REPORTED BEFORE WORK IS COMMENCED.

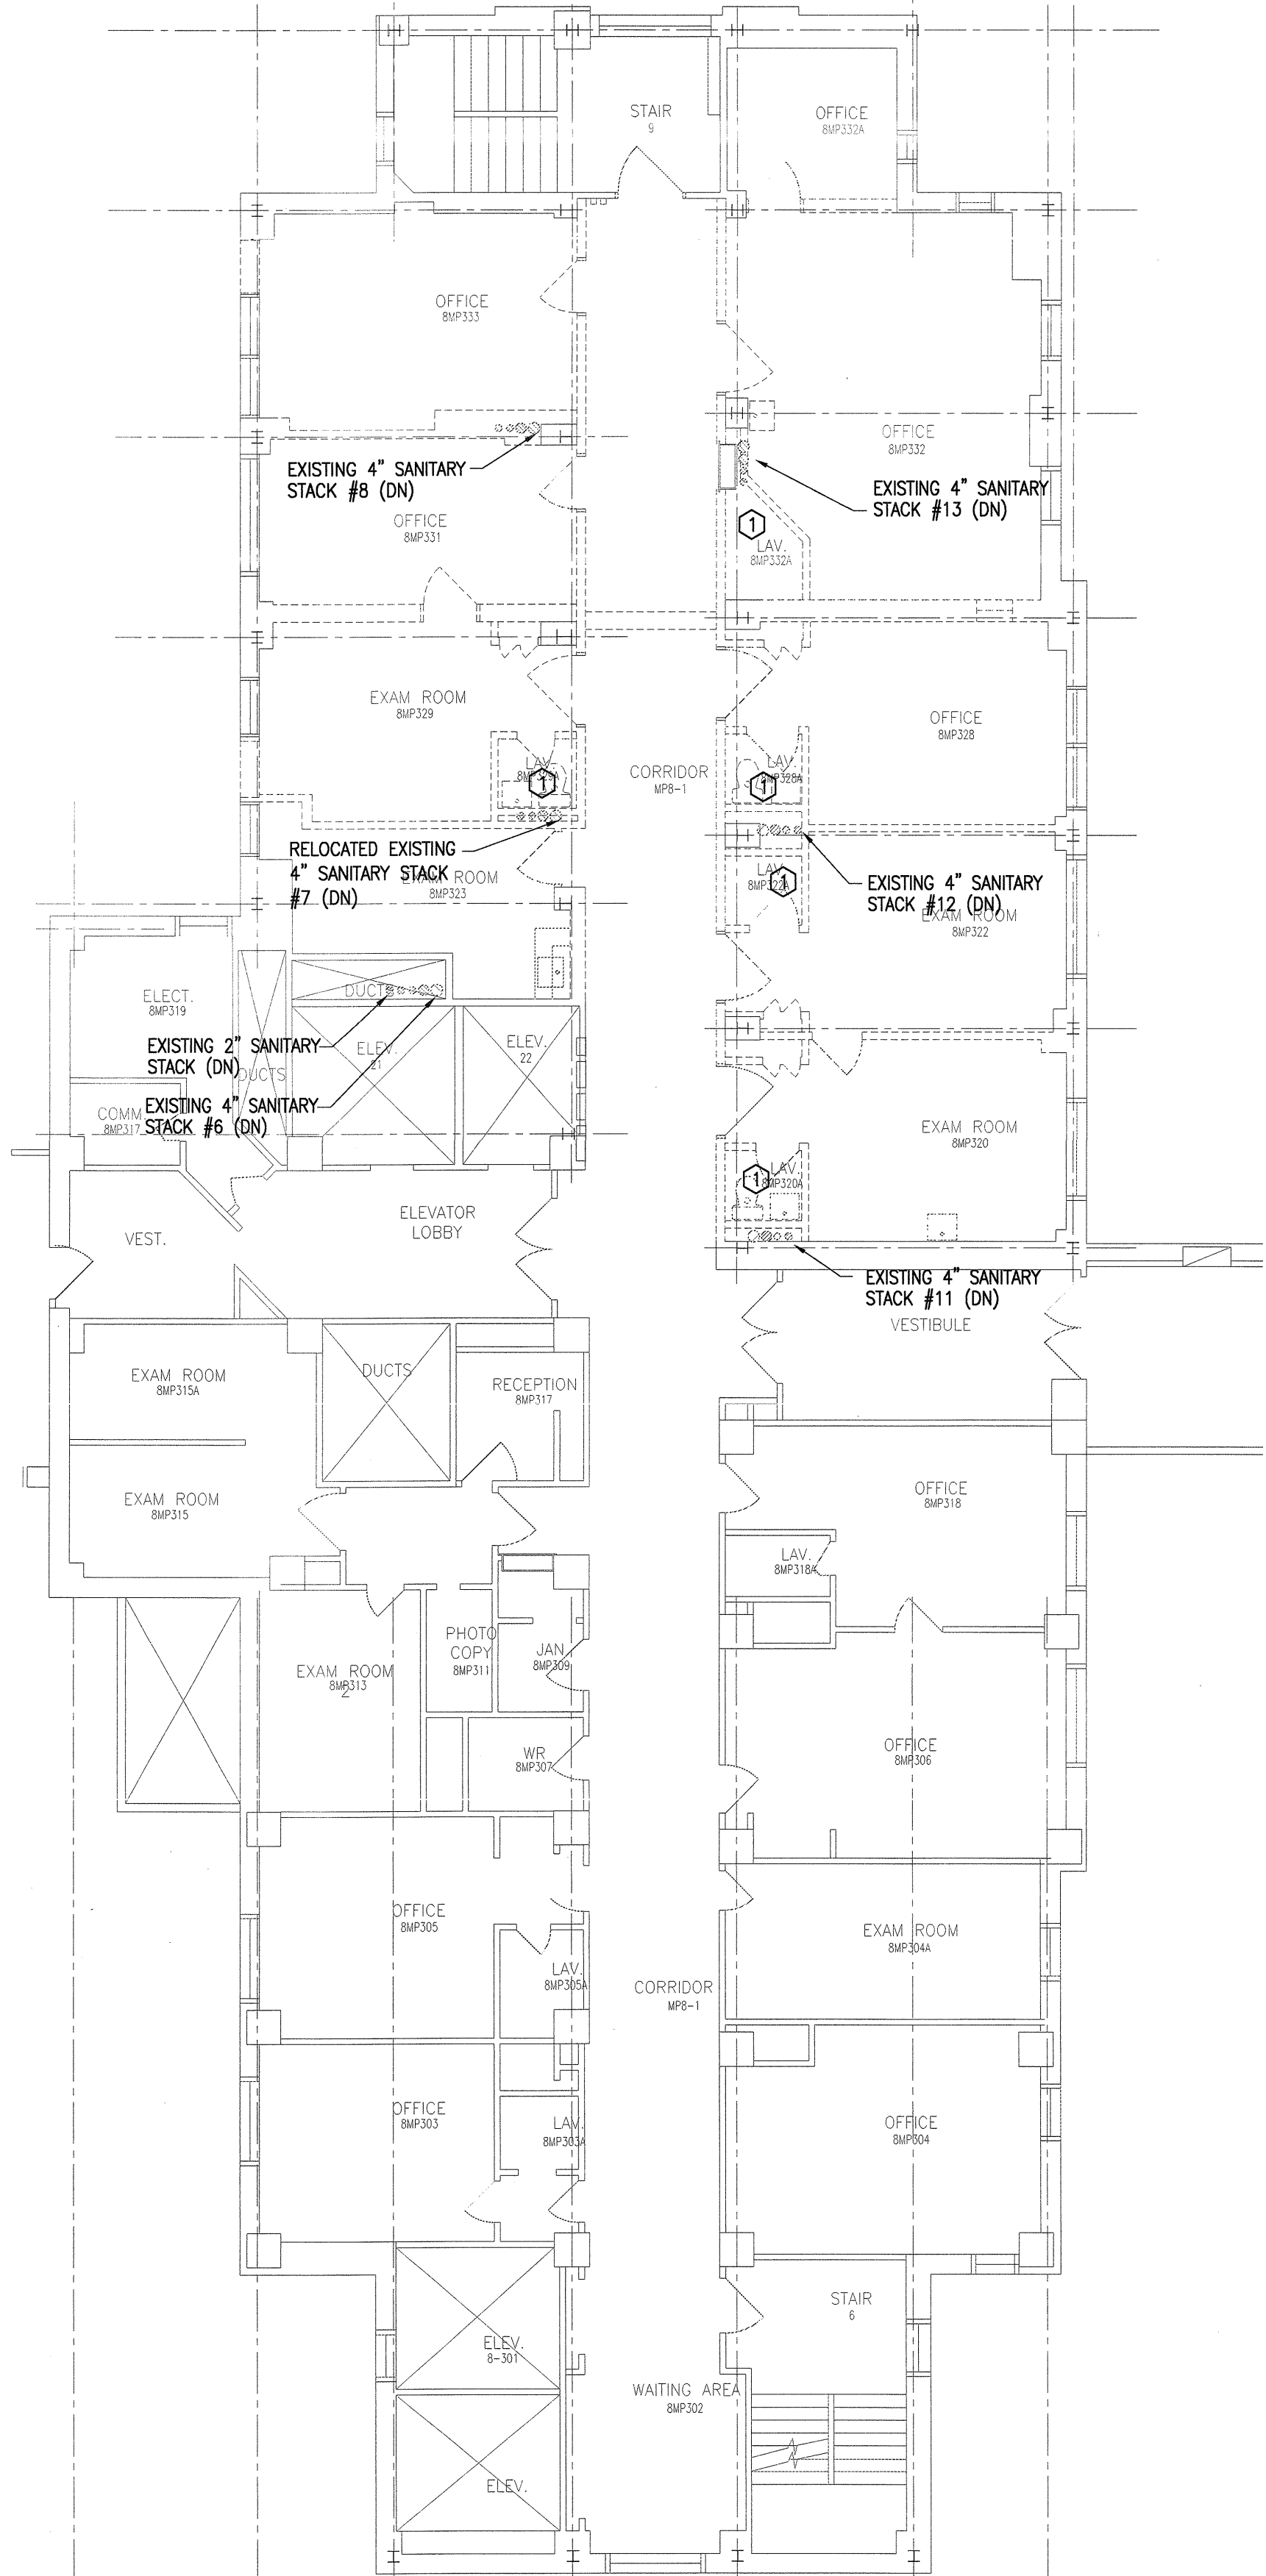

2 PART 8TH LEVEL - PLUMBING DEMO
M-2 1/8"=1'-0"

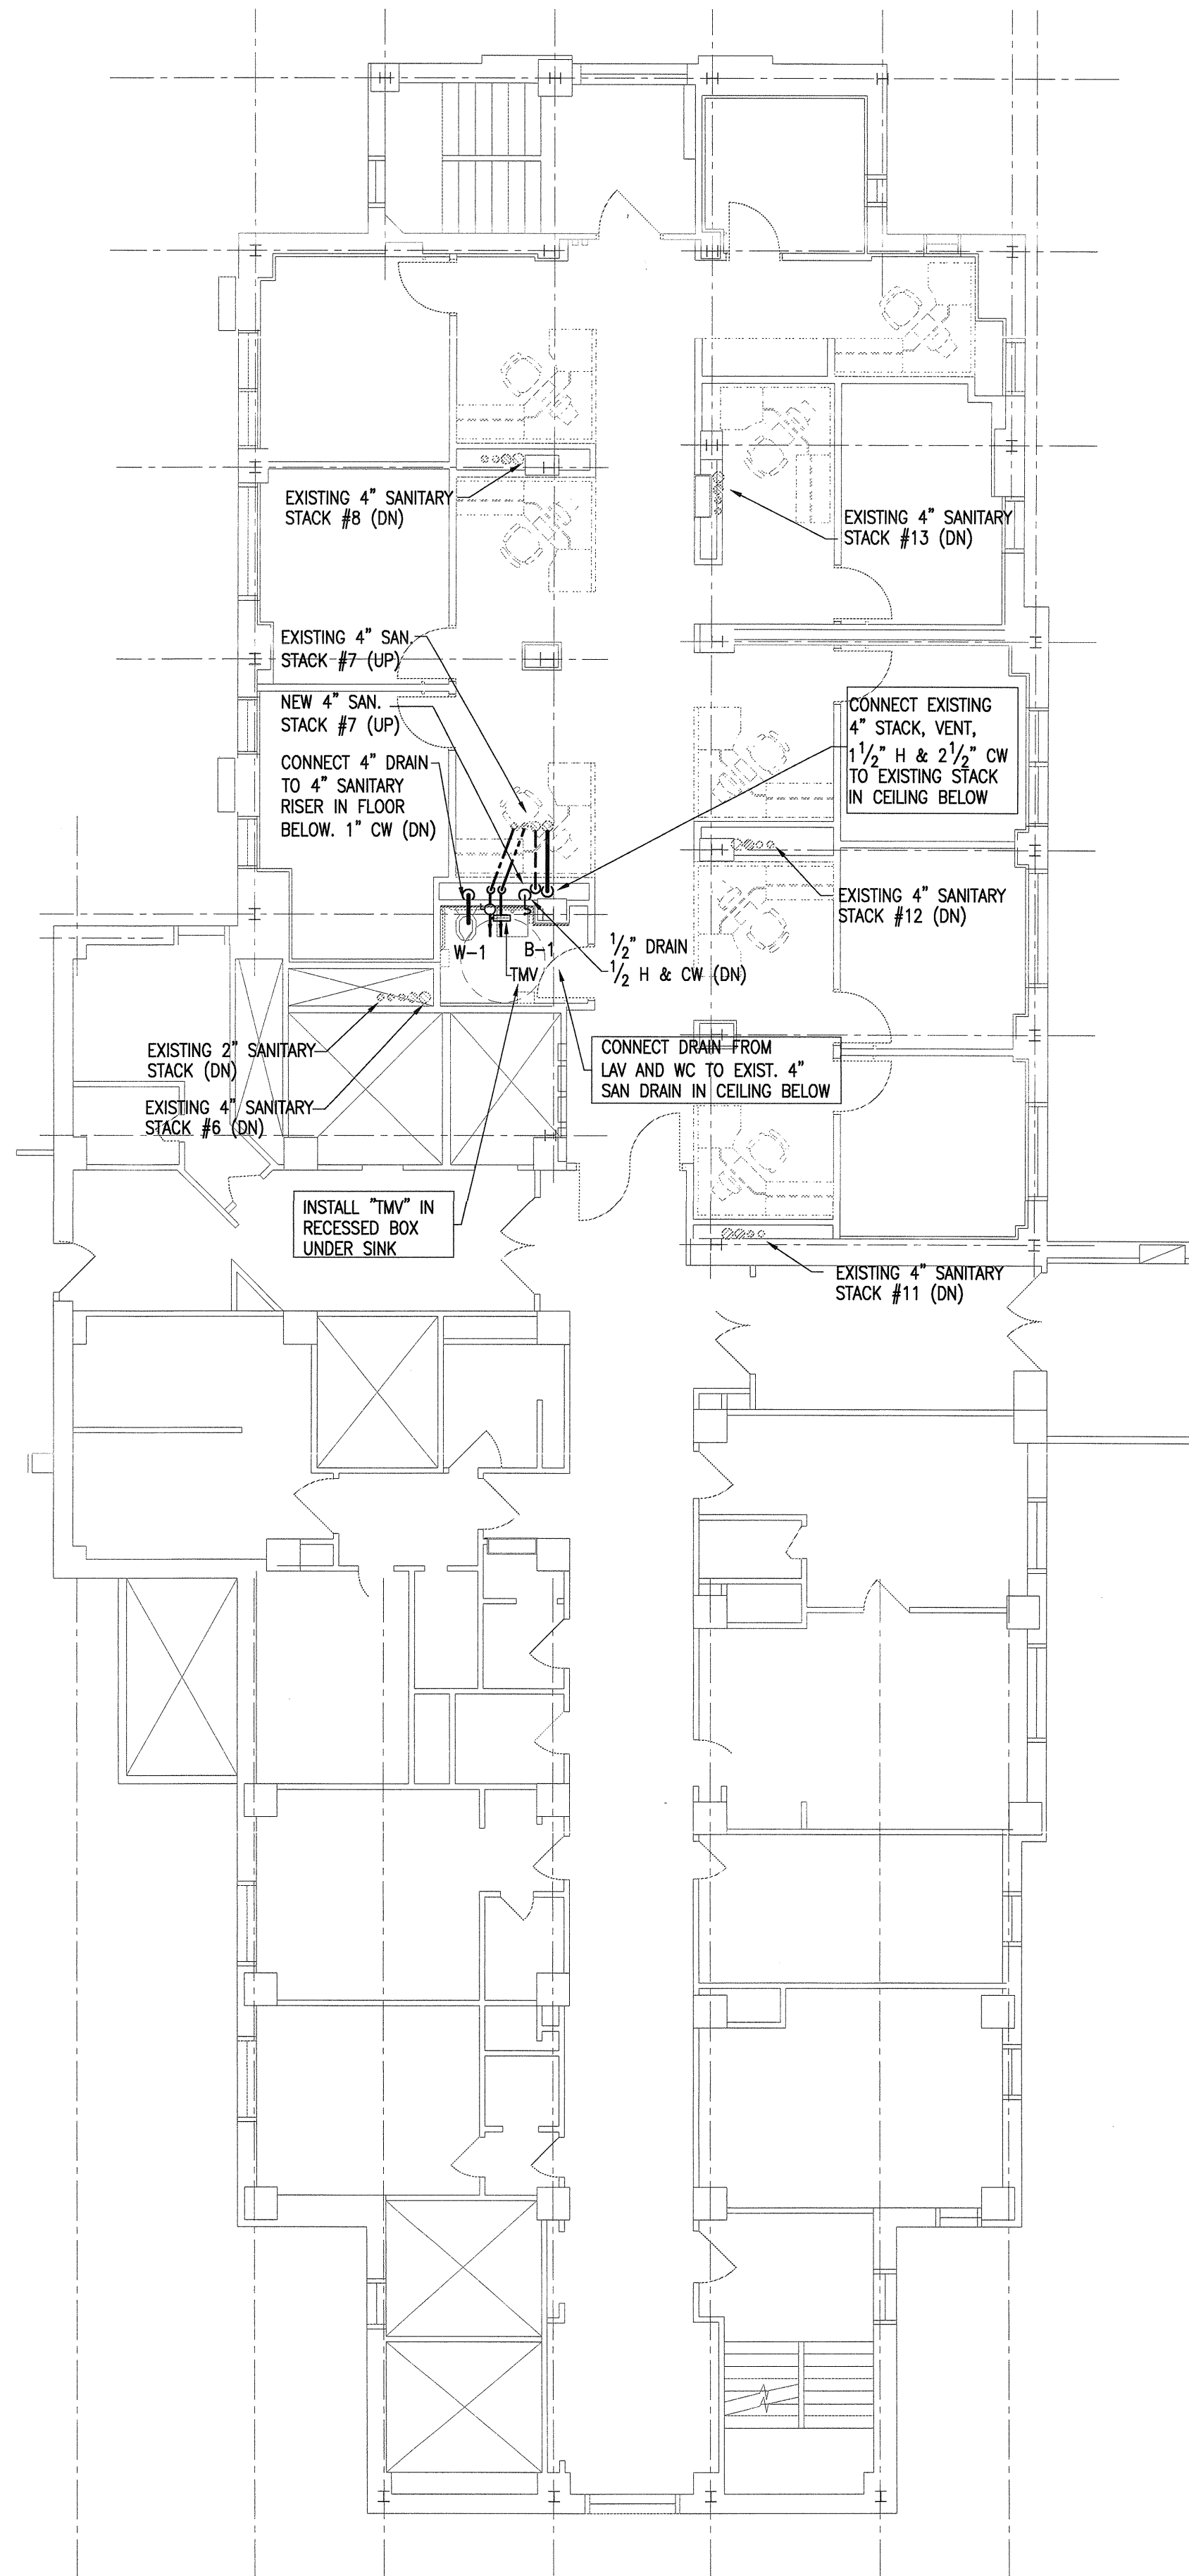

2 PART 8TH LEVEL - PLUMBING NEW
M-2 1/8"=1'-0"

GI/ GENERAL
SURGERY OFFICES



H.H. Angus & Associates Limited Consulting Engineers
1127 Leslie Street, Toronto, Ontario, M3C 2J6 Canada
T (416) 443 8200 F (416) 443 8290 www.hhangus.com

1	ISSUED FOR OWNER'S REVIEW	MAY 08/08
No.	REVISION	DATE




DRAWING TITLE:
**PART 8TH LEVEL
PLUMBING
DEMOLITION & NEW**

MECHANICAL

DATE: FEB. 11, 2008	SCALE: 1/8"=1'-0"	PROJECT NO.: 1962-07-07
DRAWN: B.S.	CHECKED: C.O.	COMP. FILE NO.:

DRAWING No.:


M-2

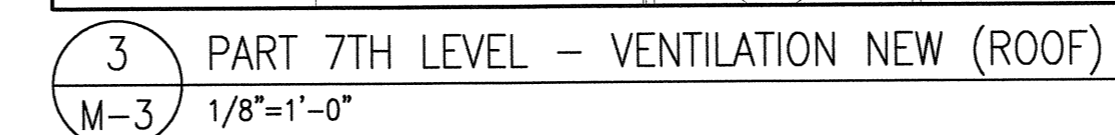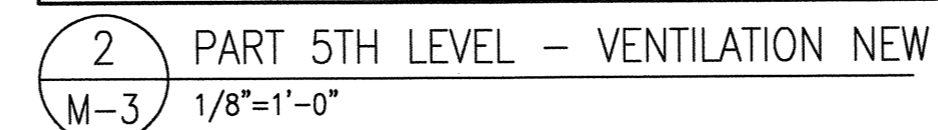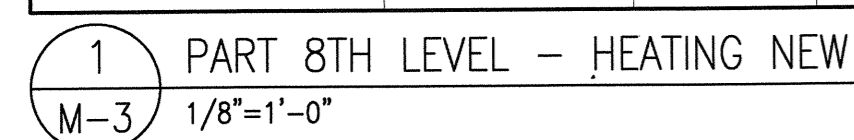


DATE: FEB. 11, 2008	SCALE: 1/8"=1'-0"	PROJECT NO: 1962-07-07
DRAWN: C.D.	CHECKED: C.O.	COMP. FILE NO.:
DRAWING No.:		

M-3

XREF:
2061008-45-ISS
2061008-45B0
Level-8 Vent
LVB-DAR
LVB-DTX
LVB-AR
LVB-TX

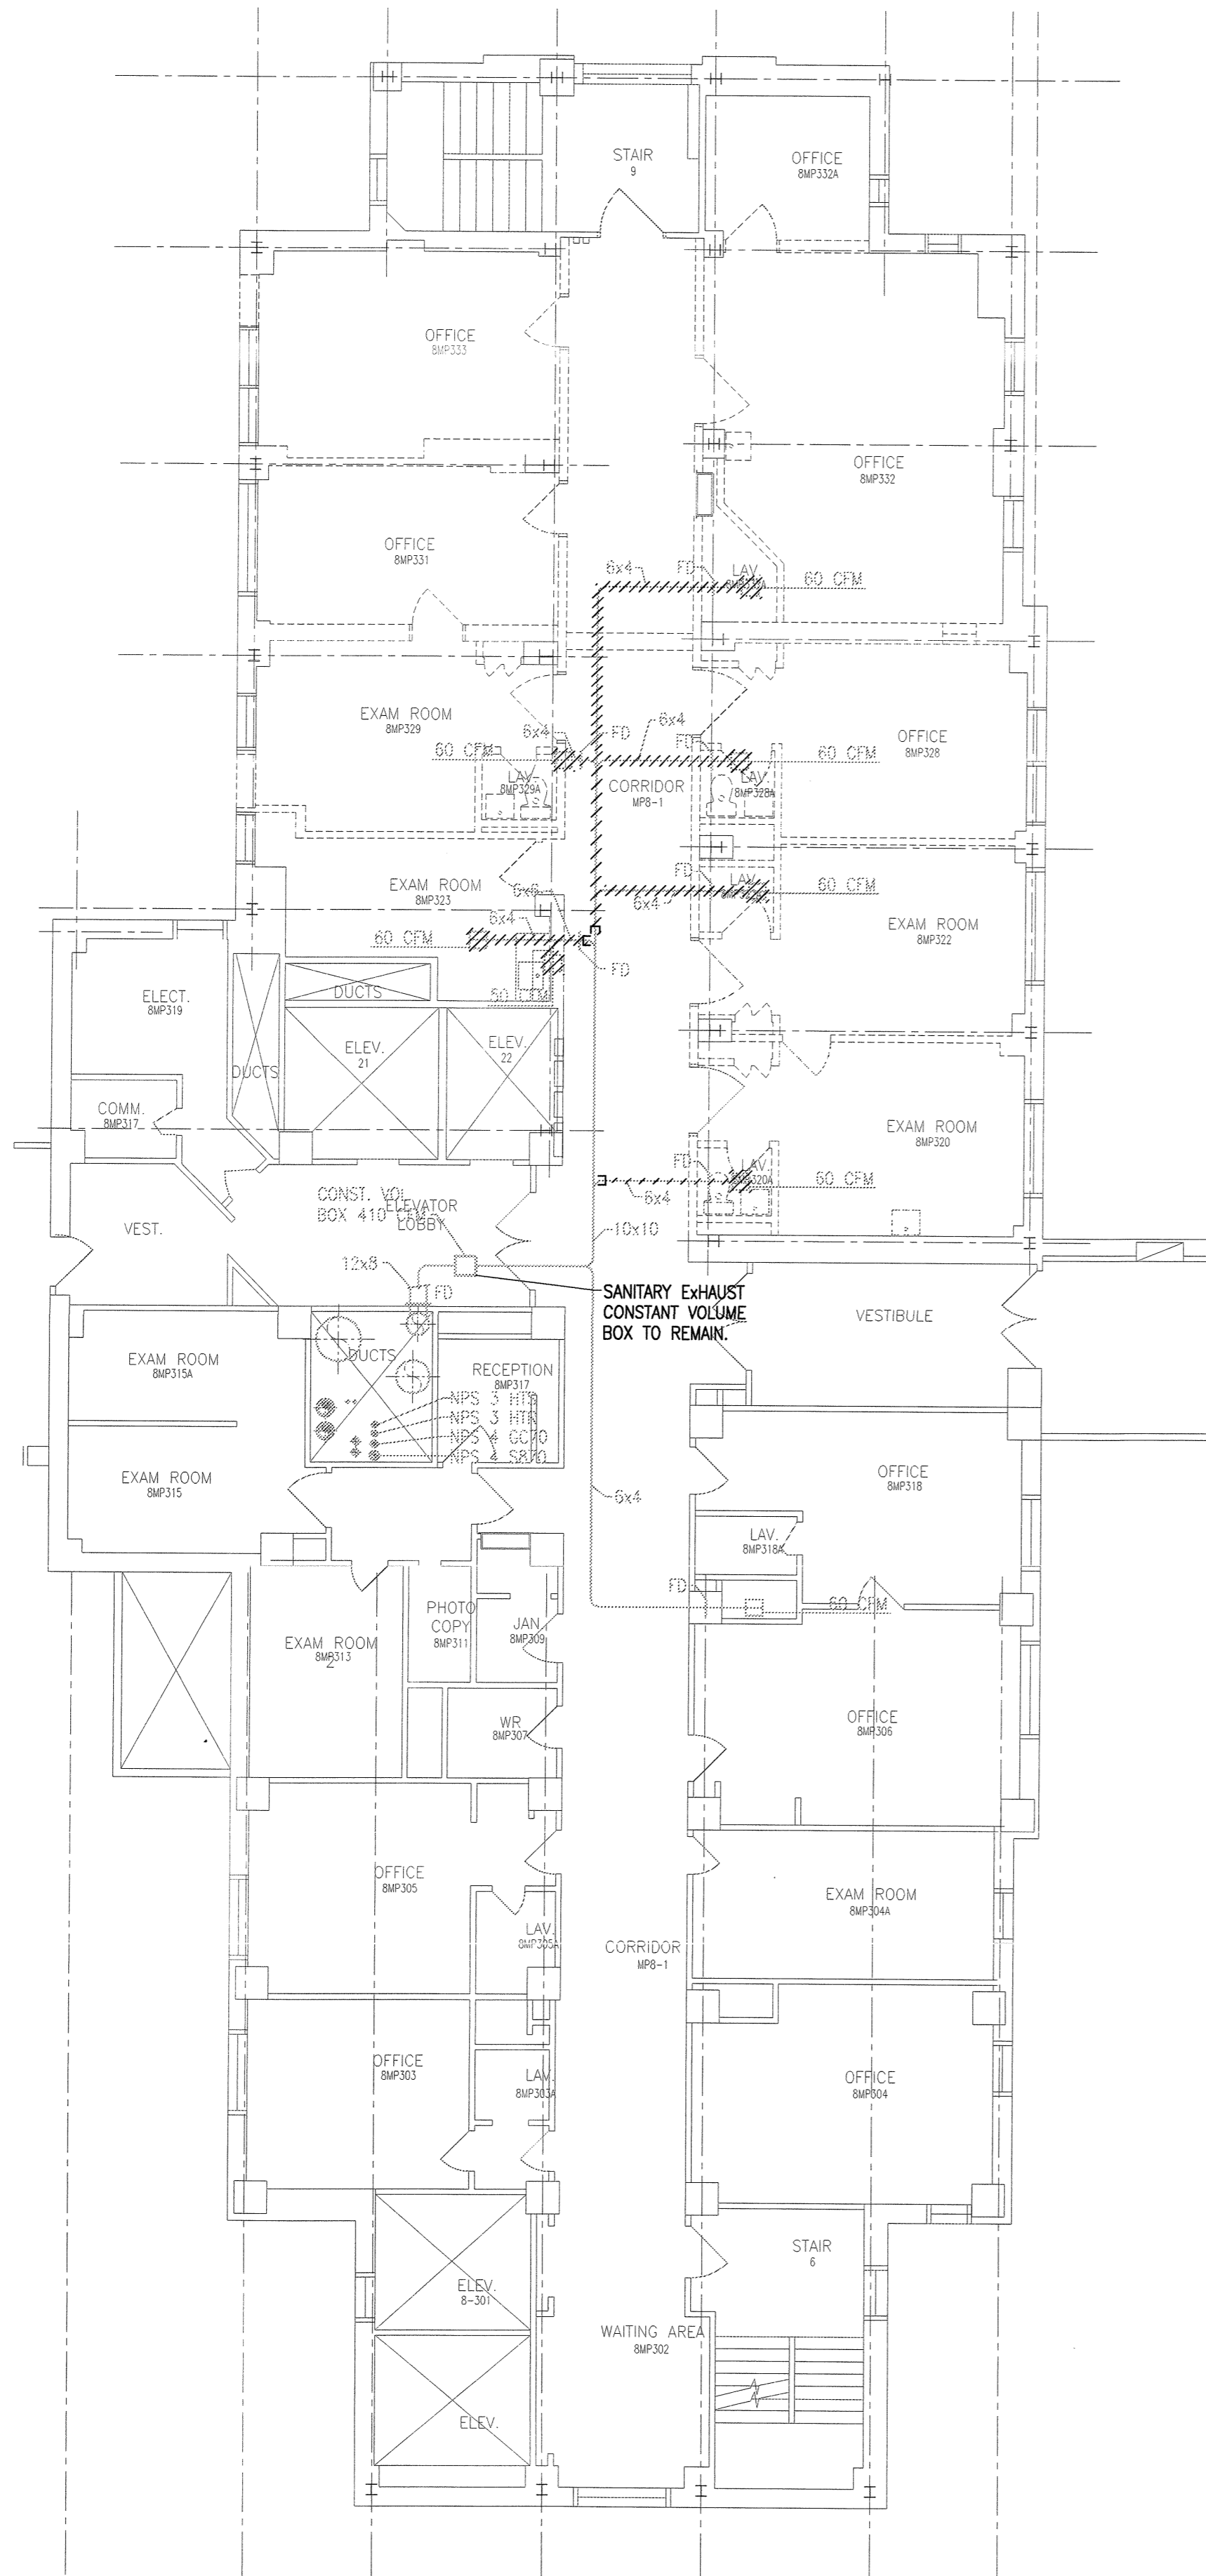

1 PART 5TH LEVEL - VENTILATION NEW
M-4 1/8"=1'-0"

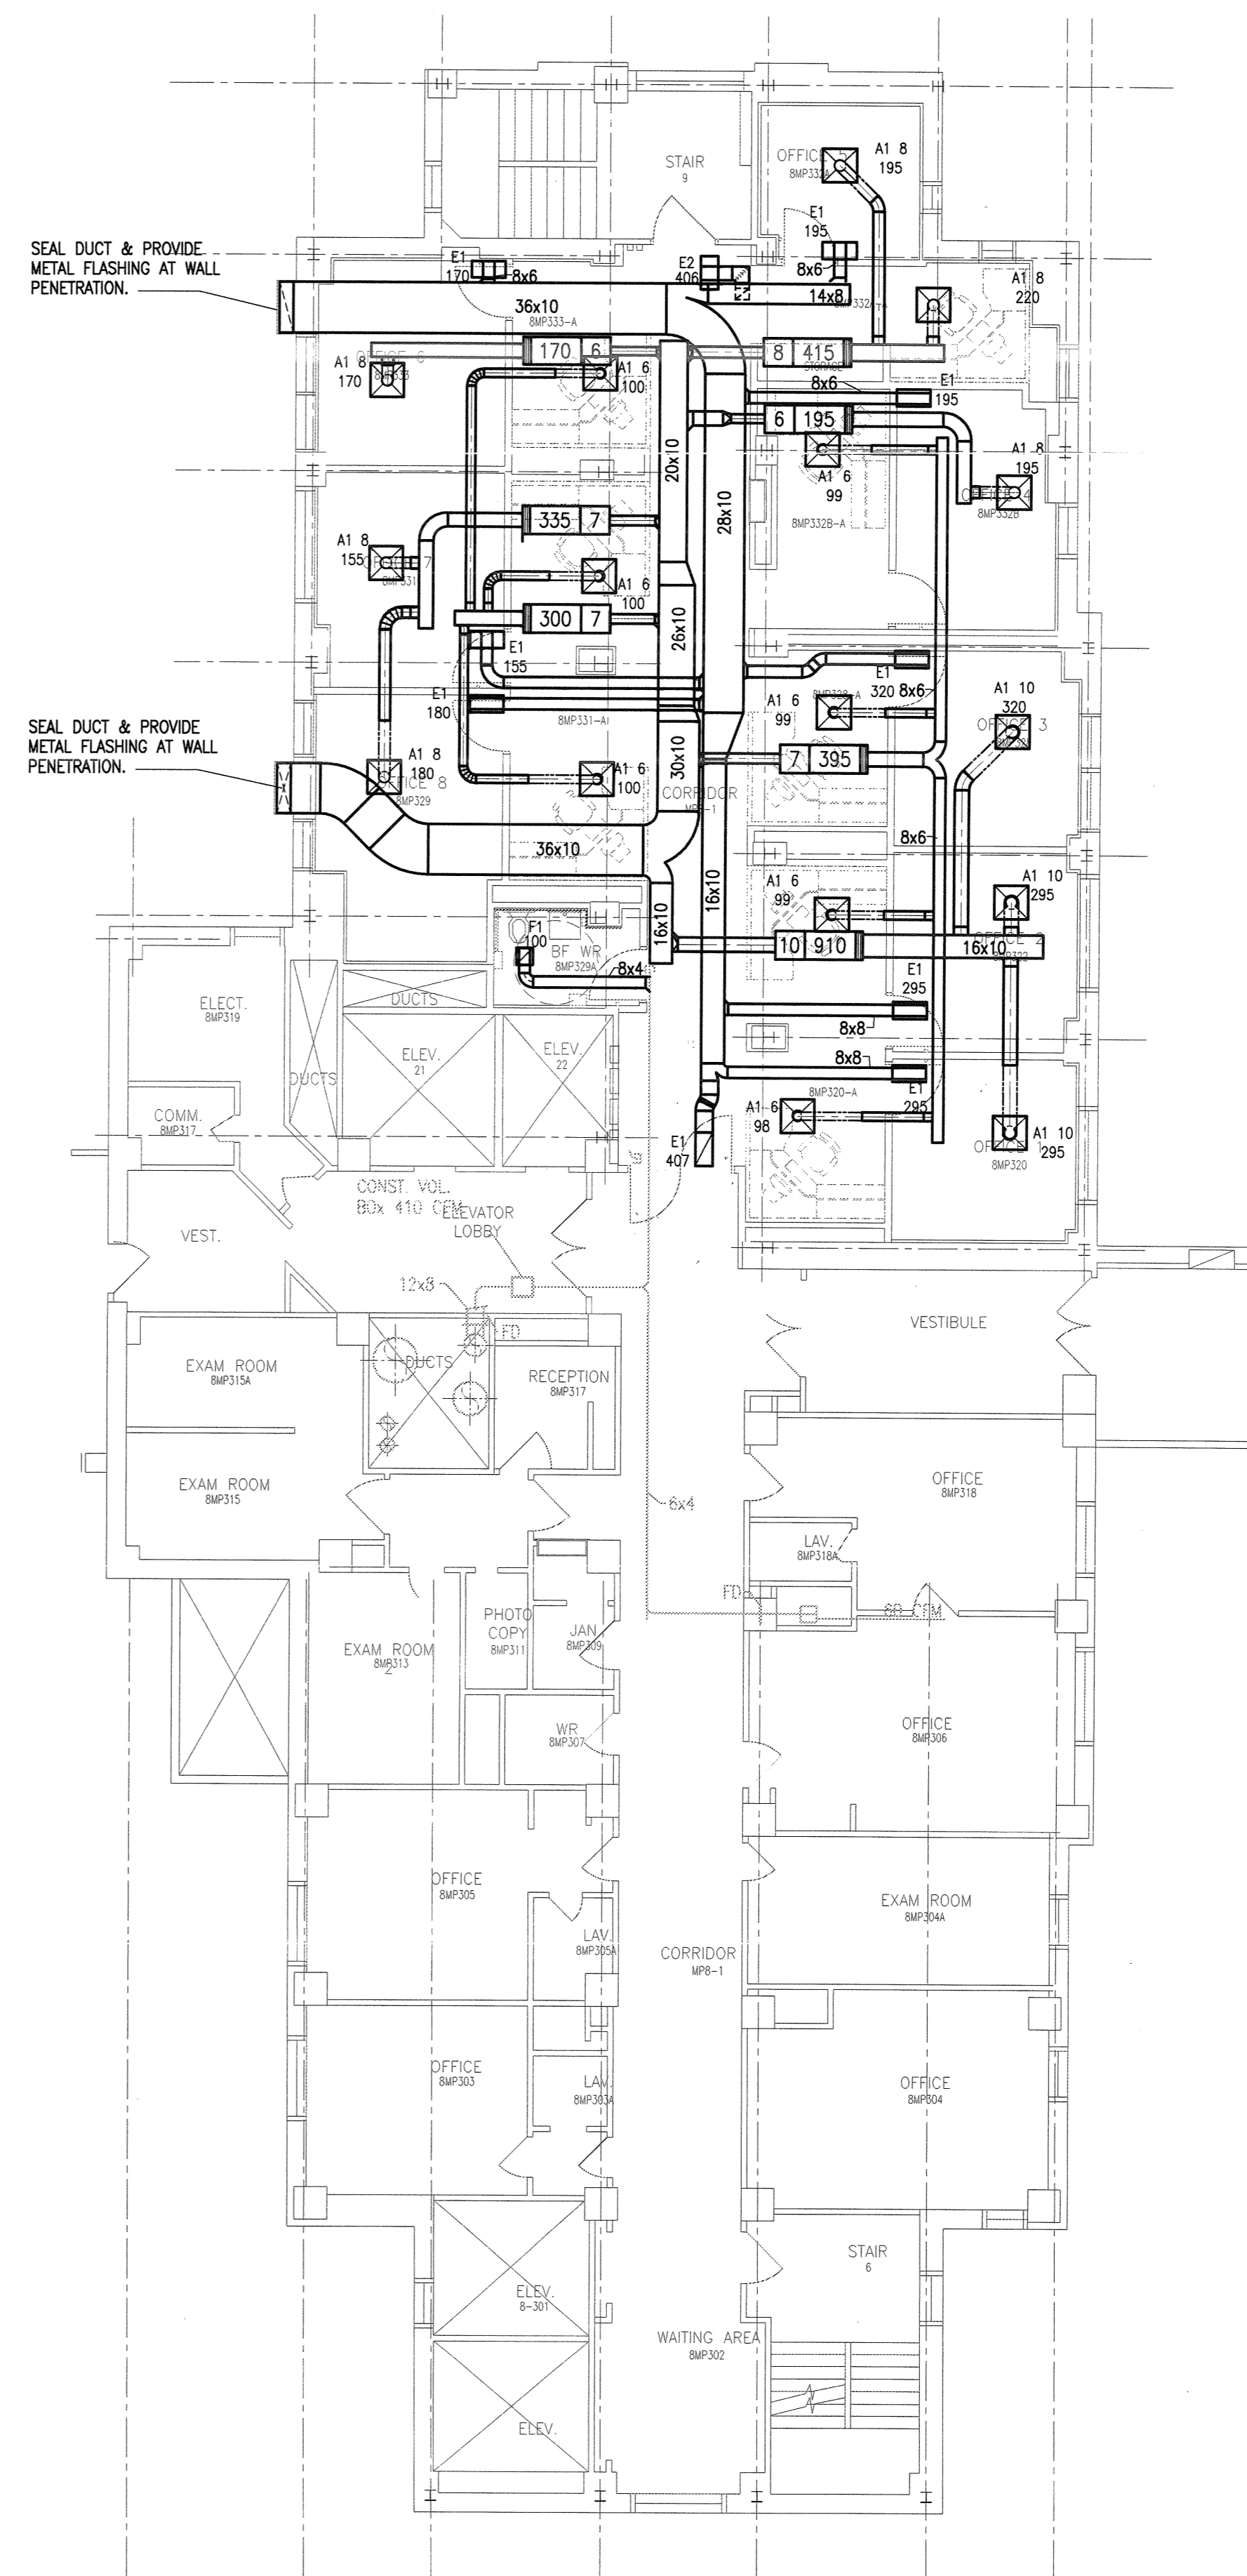


2 PART 7TH LEVEL - VENTILATION NEW
M-4 1/8"=1'-0"

GI/ GENERAL
SURGERY OFFICES


H.H. Angus & Associates Limited Consulting Engineers
1127 Leslie Street, Toronto, Ontario, M3C 3J6 Canada
T (416) 416 4433 F (416) 416 4433 www.hhangus.com

DRAWING TITLE:		
PART 8TH LEVEL VENTILATION DEMOLITION & NEW WORK		
MECHANICAL		
DATE: FEB. 11, 2008	SCALE: 1/8"=1'-0"	PROJECT NO.: 1962-07-07
DRAWN: C.D.	CHECKED: C.O.	COMP. FILE NO.:
DRAWING No.:		
M-4		

XREF:
2061008-45-ISS
2061008-45BD
Level-8 FP
LV8-AR
LV8-CL
LV8-DAR
LV8-DTX
LV8-TX

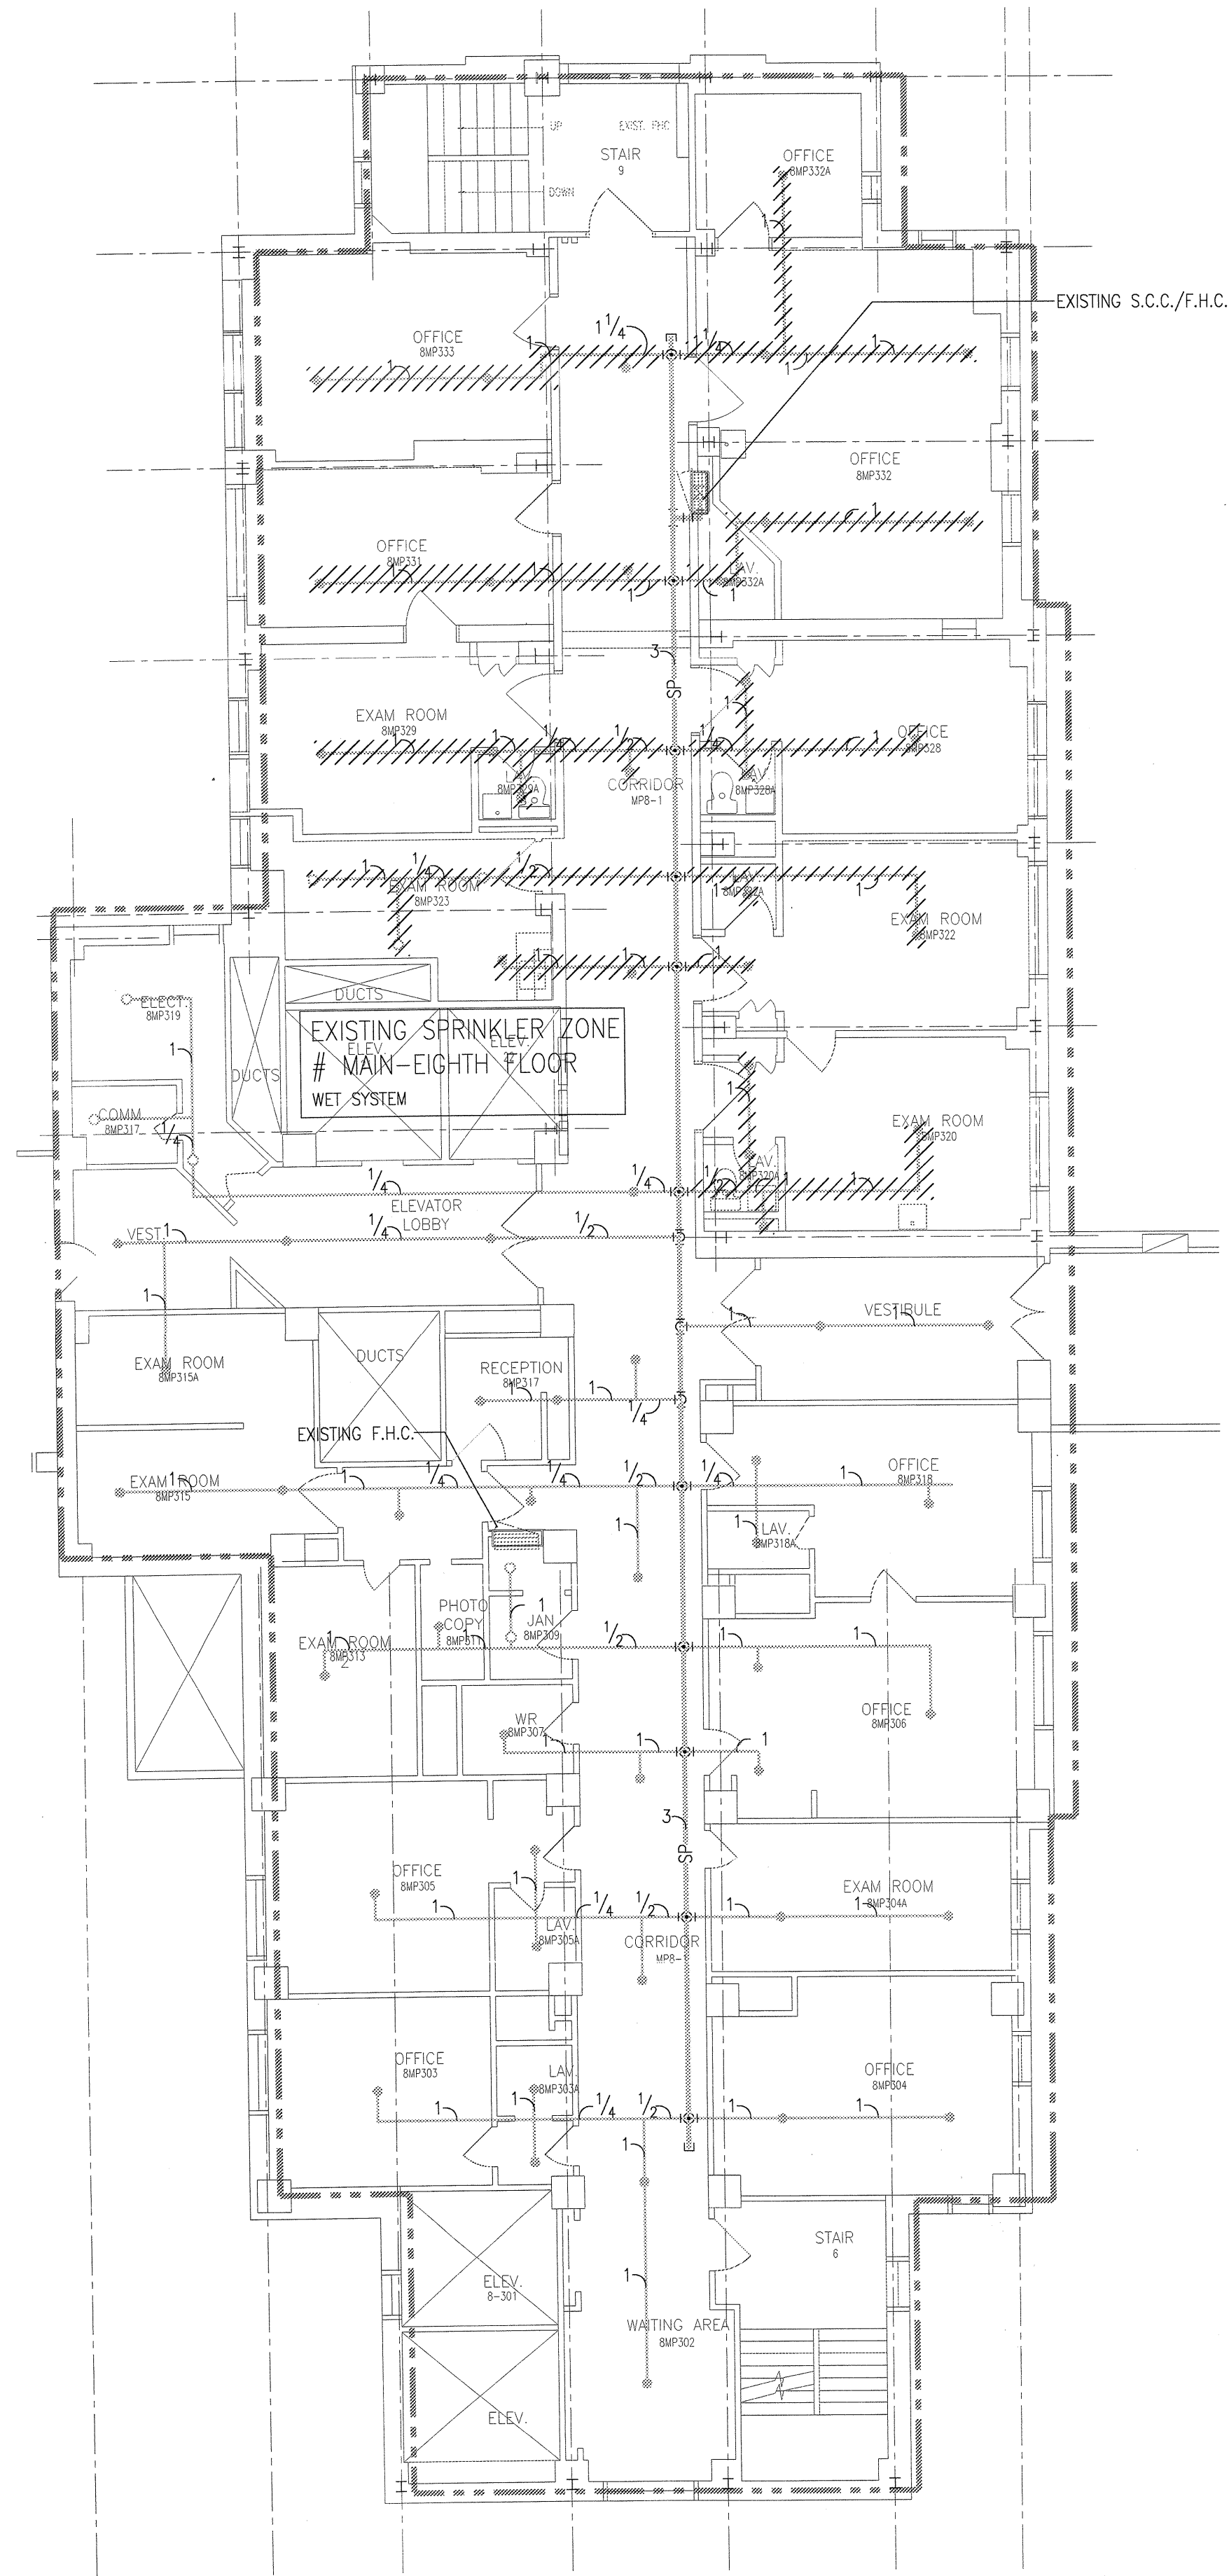

1 PART 8TH LEVEL - FIRE PROTECTION DEMO
M-5 1/8"=1'-0"

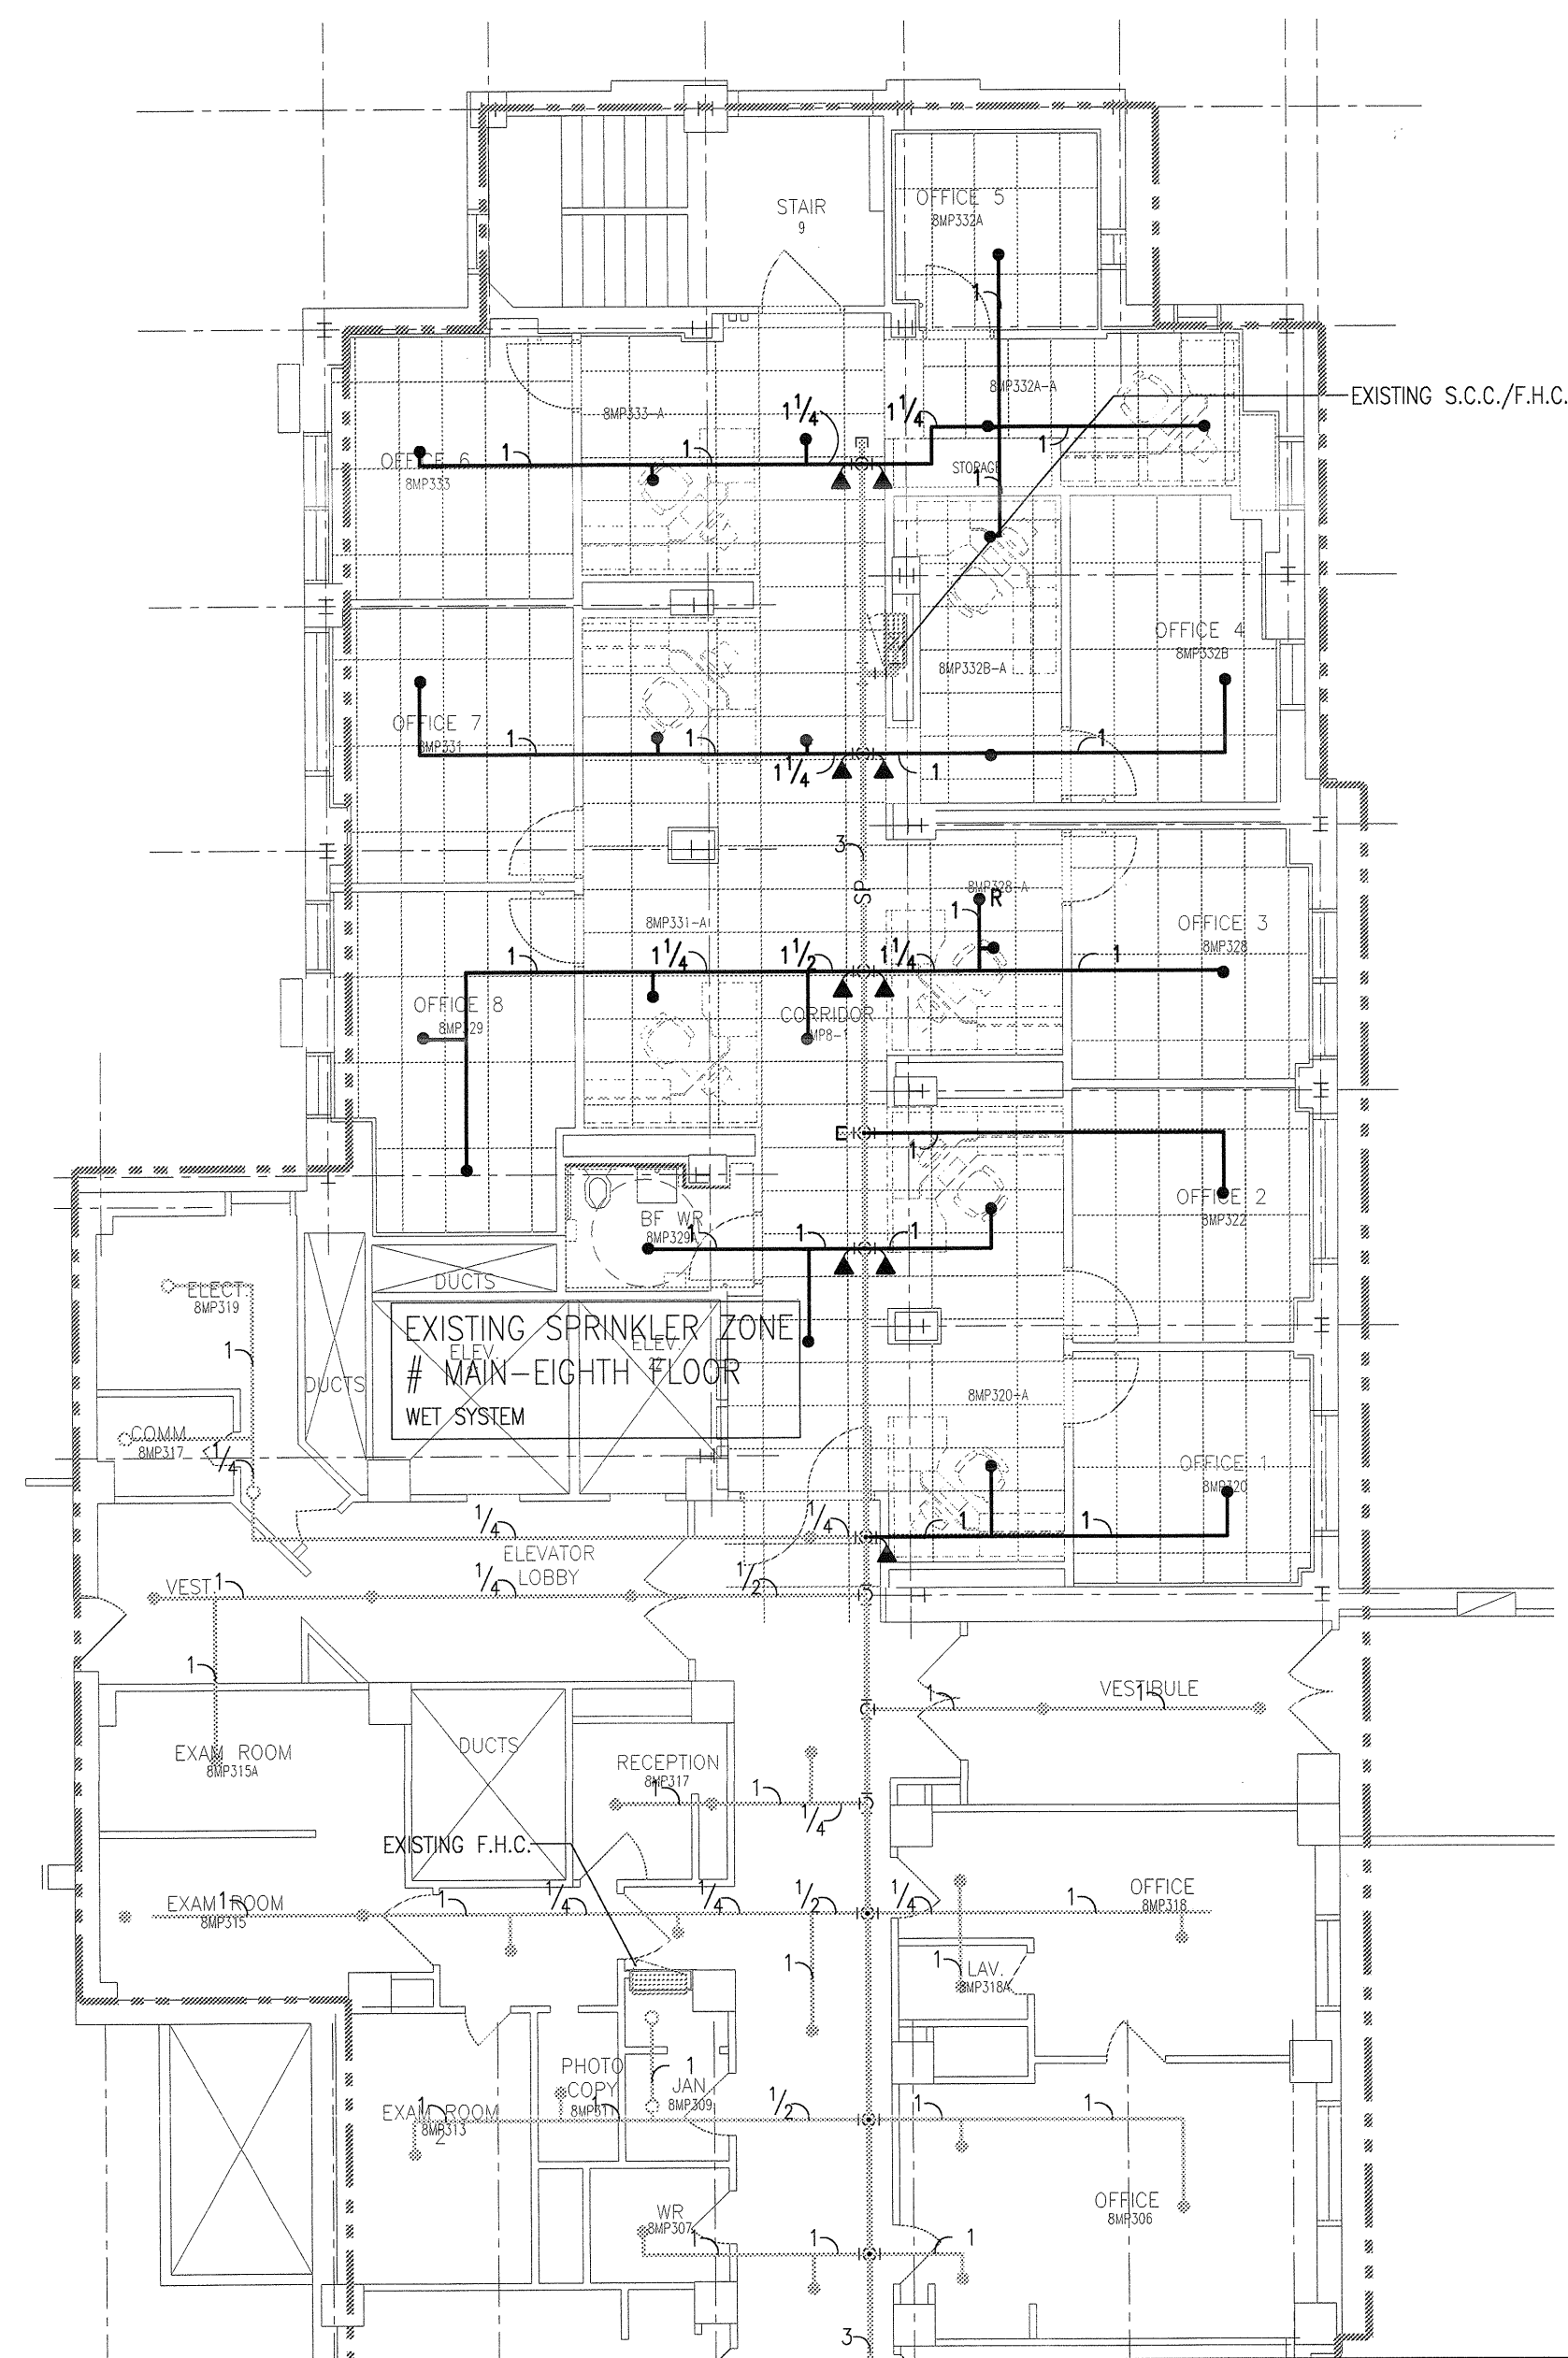

2 PART 8TH LEVEL - FIRE PROTECTION NEW
M-5 1/8"=1'-0"

GENERAL FIRE PROTECTION NOTES

- PROVIDE 1" VALVED AND CAPPED INSPECTOR'S TEST CONNECTION WITH HOSE END IN ALL SPRINKLER ZONES FOR INITIAL FLUSHING OUT OF THE SYSTEM AND REMOTE TESTING FOR ALARM DEVICES. PROVIDE ONE HOSE OF SUITABLE LENGTH. PROVIDE EACH SYSTEM WITH CHECK VALVE AND SHUT OFF VALVE IN CEILING SPACE TO FACILITATE DRAINING OF EACH SYSTEM.
- PROVIDE FOR MINIMUM OF 10 SPRINKLERS HEADS INCLUDING PIPING.
- ADVISE AND ARRANGE WITH FIRE DEPARTMENT THE DATES OF TESTING ALARM DEVICES. COORDINATE THIS WORK WITH TRADES UNDER ELECTRICAL DIVISION. ENSURE ALL ALARM DEVICES ARE WORKING PRIOR TO CONTACTING FIRE DEPARTMENT.
- EXAMINE ARCHITECTURAL REFLECTED CEILING PLAN TO COORDINATE SPRINKLER HEAD LAYOUT & LOCATIONS.
- ALL SYSTEMS SHALL BE HYDRAULICALLY SIZED. ALL PIPES SIZING SHALL BE BASED ON CONTRACTOR'S OWN HYDRAULIC CALCULATIONS AT NO ADDITIONAL COST TO THE OWNER. PROVIDE ADDITIONAL HEADS AS REQUIRED TO MEET NFPA 13.
- PRESSURE REDUCING VALVE: SINGLE SEATED HYDRAULICALLY OPERATED, PILOT CONTROLLED, DIAPHRAGM STYLE GLOBE OR ANGLE MAIN VALVE WITH EPOXY, KYNAR OR ECTFE INTERNAL COATING.
- SPRINKLER HEADS SHALL BE QUICK RESPONSE RECESSED SPRINKLER HEADS C/W ESCUTCHEON CUP. UPRIGHT SPRINKLER HEADS SHALL BE QUICK RESPONSE.

SPRINKLER HEAD DISCHARGE DENSITIES

HAZARD CLASSIFICATIONS	DESIGN DENSITY (U.S. gpm/1500 ft/sq)
LIGHT HAZARD PATIENT CARE AREAS OFFICE AREAS ASSEMBLY AREAS	0.1
ORDINARY HAZARD (GROUP 1) LABORATORY AREAS CLINICAL STORAGE ROOMS MECHANICAL SERVICE AREAS	0.15

3 FIRE PROTECTION DETAILS & NOTES
M-5 N.T.S

GI/ GENERAL SURGERY OFFICES

H.H. Angus & Associates Limited Consulting Engineers
1127 Leslie Street, Toronto, Ontario, M3C 1J6 Canada
T(416) 416 8200 F(416) 416 8290 www.hhangus.com

DRAWING TITLE:

PART 8TH LEVEL FIRE PROTECTION DEMOLITION & NEW WORK

MECHANICAL

DATE: FEB. 11, 2008	SCALE: 1/8"=1'-0"	PROJECT NO.: 1962-07-07
DRAWN: B.S.	CHECKED: C.O.	COMP. FILE NO.:
DRAWING No.:		

M-5

FILENAME: J:\2061008-45\DWG\MECH\2061008-45M07.dwg
PLOTDATE: May 08, 2008 - 5:04pm