

PART 1 - ADDENDUM

1.1. INTENT

- 1.1.1. This Addendum is issued to provide for modifications and/or clarifications during Bidding and forms part of Bid and Contract Documents for above Project.
- 1.1.2. Except as otherwise specified herein, or as shown on accompanying Drawings, work required by this Addendum shall be in accordance with Specifications dated January 31, 2025, Drawings accompanying same and previously issued Addenda.

PART 2 - SPECIFICATIONS – PROCUREMENT AND CONTRACTING REQUIREMENTS GROUP AND SPECIFICATIONS GROUP

2.1. SPECIFICATIONS REVISIONS

- 2.1.1. Specification pages listed below accompany and form part of this Addendum.
- 2.1.2. Each revised Section voids and supersedes previously issued Section of same number in its entirety. Each page is marked at bottom with a "Revised & Reissued" entry that includes date of this issue. Extent of new, revised and/or deleted text is defined by leading and trailing 1... symbol, as applicable.
- 2.1.3. Revised Sections and Pages:

<u>Section Number</u>	<u>Rev No.</u>	<u>Section Title</u>	<u>Page Numbers</u>
00 01 10	04	Table of Contents	1 thru 8
09 60 13	02	Tactile Warning Surfacing	1 thru 5


PART 3 - CLARIFICATIONS

3.1. GENERAL CLARIFICATIONS

- 3.1.1. Following are general clarification items which form part of this Addendum:
- 3.1.1.1. Question No. 59:
- 3.1.1.1.1. Question: Are we to include 5-year maintenance for Elevators in our pricing?
- 3.1.1.1.2. Answer: No. Refer to Section 14 20 00, article 1.2. Maintenance: warranty period. Maintenance to begin at Substantial Performance and end 12 months after Substantial Performance. Omit PART 2 - SEPARATE PRICES and PART 3 - ALTERNATIVE PRICES in Section 14 20 00.
- 3.1.1.2. Question No. 60:
- 3.1.1.2.1. Question: During the Site visit, the Architect noted that the new demising wall, P5, on level 3 at rooms 325B & 327, gridline 4B/4C will require some wall bracing/support from the existing walls. Please provide details showing this bracing condition.
- 3.1.1.2.2. Answer: Refer to detail 11/A802 (Addendum No. 2) and Note added to Drawing A218 (Addendum No. 2).
- 3.1.1.3. Question No. 61:
- 3.1.1.3.1. Question: Please provide location and details of expansion joints
- 3.1.1.3.2. Answer: Drawing A701 includes the locations and the descriptions for EXPANSION JOINT TYPES EJ01, EJ02, EJ03, EJ03-FR and EJ04.

3.1.1.4. Question No. 62:

3.1.1.4.1. Question: Can the architect confirm if these vertical panels are to match the countertop and extend to the wall, supplied by the millwork sub-contractor.

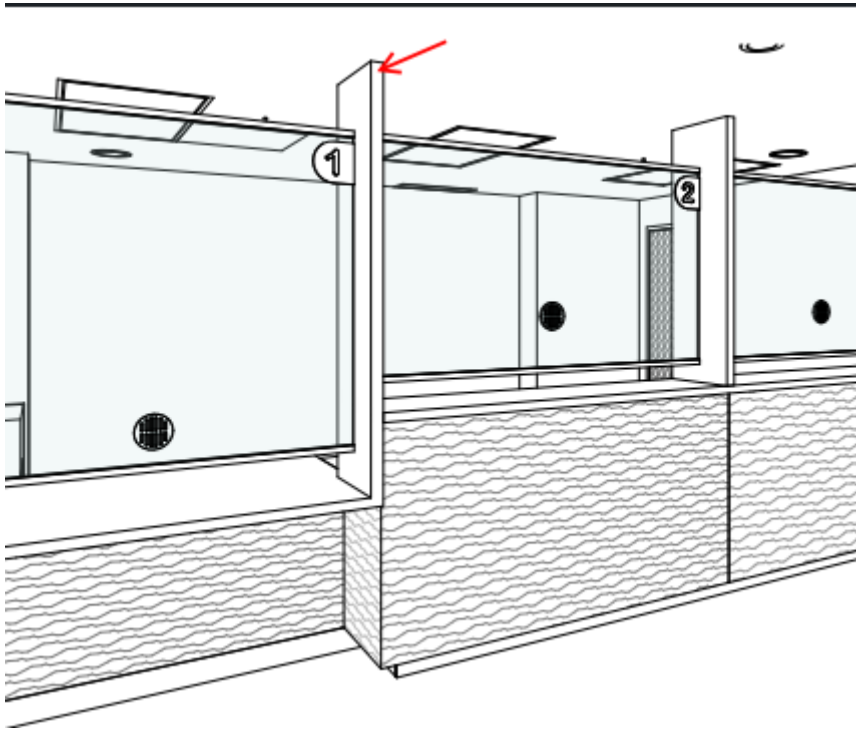

3.1.1.4.2. Answer: The materials of the vertical panels do not match the countertop finish. Refer to the WP-3 and WD-3 materials shown in detail 12/A820.

3.1.1.5. Question No. 63:

3.1.1.5.1. Question: Please clarify areas to be fireproofed with drawing number and areas marked

3.1.1.5.2. Answer: Refer to Note 9 in Drawing Nos. AD301 and AD302 and Note 18 in Drawing Nos. A310, A313, A314 and A315.

3.1.1.6. Question No. 64:

3.1.1.6.1. Question: Please clarify details of fireproofing scope and details of steel at 1st floor where the ceiling is clay.

3.1.1.6.2. Answer: New structural steel and associated connections for 1st floor ceiling (2nd level slab) shall receive cementitious spray applied fireproofing (SFRM) to achieve minimum 1-hr fire protection. Refer to Structural Drawing No. S202 for new steel beam locations and sizing.

3.1.1.7. Question No. 65:

3.1.1.7.1. Question: Please clarify scope Intumescent paint, it is listed in the specs and tender request, but we are unable to find it on drawings.

3.1.1.7.2. Answer: The 2-hr fire rated intumescent paint shall be applied to the structural 275 x 60 steel plate column supporting the floor structure of Elev. Access (106V), Elev. Access (237V), and Elev. Access (257V). Refer to details 13/A701B and 18/S701.

- 3.1.1.8. Question No. 66:
- 3.1.1.8.1. Question: Do we include firestopping on the existing firestopping and the new on life safety plans as shown on drawing A100.
- 3.1.1.8.2. Answer: Yes. Also, refer to Note 65 in Drawing Nos. A213, A214 and A216.
- 3.1.1.9. Question No. 67:
- 3.1.1.9.1. Question: What cover plates are anticipated for the interior expansion joint locations?
- 3.1.1.9.2. Answer: Refer to Product Notes in Drawing No. A701. All aluminum cover plate finishes are to visually match. All aluminum cover plate fasteners to be countersunk flush or concealed.
- 3.1.1.10. Question No. 68:
- 3.1.1.10.1. Question: Are there interior expansion Joint details?
- 3.1.1.10.2. Answer: Refer to revised Drawing Nos. A310, A313, A314 and A316 for clarification of ceiling expansion joint locations and alignment of adjacent partitions/finishes. Refer to revised Drawing No. A701 for updated expansion joint product types. Refer to revised Drawing No. A701 for clarifications of wall types and expansion joint locations. Refer to revised plan detail 3/A701B for alignment of finished expansion joint cover plates (wall, floor and ceiling).

PART 4 - DRAWINGS

4.1. DRAWING NO: A211

- 4.1.1. Drawing No. A211 attached is modified as follows:
- 4.1.1.1. "Detectable Warning Surface" note changed to "4 mm high type 316 stainless steel truncated domes 22 mm in diameter with concentric rings centre dome pattern fastened to the granite pavers".

4.2. DRAWING NO: A310

- 4.2.1. Drawing No. A310 attached is modified as follows:
- 4.2.1.1. Added ceiling expansion joint location at ELEV. ACCESS 106V

4.3. DRAWING NO: A313

- 4.3.1. Drawing No. A313 attached is modified as follows:
- 4.3.1.1. Added ceiling expansion joint location at Elevator Landing.

4.4. DRAWING NO: A314

- 4.4.1. Drawing No. A314 attached is modified as follows:
- 4.4.1.1. Added ceiling expansion joint location at Elevator Landing.

4.5. DRAWING NO: A316

- 4.5.1. Drawing No. A316 attached is modified as follows:
- 4.5.1.1. Added ceiling expansion joint location at Elevator Landing.

4.6. DRAWING NO: A701

- 4.6.1. Drawing No. A701 attached is modified as follows:
- 4.6.1.1. Expansion joint product types revised. Wall types and expansion joint locations clarified.

4.7. DRAWING NO: A701B

4.7.1. Drawing No. A701B attached is modified as follows:

4.7.1.1. Detail 3/A701B revised to show alignment of finished expansion joint cover plates (wall, floor and ceiling).

4.8. DRAWING NO: L-RP

4.8.1. Drawing No. L-RP attached is modified as follows:

4.8.1.1. Reissued for Clarity. No revisions.

4.9. DRAWING NO: L-L1

4.9.1. Drawing No. L-L1 attached is modified as follows:

4.9.1.1. Granite paver pattern changed.

4.9.1.2. Paving product changed to STO-1, 50 mm Picasso Granite - Flamed Finish.

4.9.1.3. Crushed stone product changed to STO-1, Picasso Granite - Flamed Finish.

4.9.1.4. Tactile Plate Indicator changed to Tactile Walking Surface Indicators (TWSI).

4.10. DRAWING NO: L-D1

4.10.1. Drawing No. L-D1 attached is modified as follows:

4.10.1.1. Paving product in Details 4, 8 & 9 changed to STO-1, 50 mm Picasso Granite - Flamed Finish.

4.10.1.2. Crushed stone product in Detail 6 changed to STO-1, Picasso Granite - Flamed Finish.

4.10.1.3. Tactile Plate Indicator changed to Tactile Walking Surface Indicators (TWSI).

PART 5 - MECHANICAL

5.1. MECHANICAL REQUIREMENTS

5.1.1. Mechanical Consultant has issued "Tender Addendum: M-04" which is 1 page and dated "March 25, 2025" and forms part of this Addendum.

PART 6 - ELECTRICAL

6.1. ELECTRICAL REQUIREMENTS

6.1.1. Electrical Consultant has issued "Bid Addendum No. #04" which is 4 pages and dated "March 25, 2025" and forms part of this Addendum.

PART 7 - COMMUNICATIONS

7.1. COMMUNICATIONS REQUIREMENTS

7.1.1. Communications Consultant has issued "Addendum No. ADD-D-04" which is 2 pages and dated "March 25, 2025" and forms part of this Addendum.

END OF SECTION

PROCUREMENT AND CONTRACTING REQUIREMENTS GROUP					
DIVISION 00 – PROCUREMENT AND CONTRACTING REQUIREMENTS					
INTRODUCTORY INFORMATION					
Section No.	Section Title	Rev. No.	Date	Consult.	Page No's
00 00 01	PROJECT TITLE PAGE	--	2025-01-31	EAI	1 Only
00 01 05	LIST OF CONSULTANTS	00	2025-01-31	EAI	1 and 2
00 01 10	TABLE OF CONTENTS	04	2025-03-25	EAI	1 thru 8
00 01 15	LIST OF DRAWINGS	00	2025-01-31	EAI	1 and 2
00 01 20	LIST OF SCHEDULES	01	2025-03-21	EAI	1 Only
PROCUREMENT REQUIREMENTS					
00 30 00	AVAILABLE INFORMATION	00	2025-01-31	EAI	1 and 2
CONTRACTING REQUIREMENTS					
00 65 37	MAINTENANCE MATERIAL FORM (SPECIMEN)	00	2025-01-31	EAI	1 Only
*00 70 00	"AGREEMENT BETWEEN OWNER AND CONTRACTOR", "DEFINITIONS" AND "GENERAL CONDITIONS", STANDARD CONSTRUCTION DOCUMENT CCDC 2 - 2020				Not Enclosed
00 71 00	AMENDMENTS TO DEFINITIONS	00	2025-01-31	EAI	1 and 2
00 91 01	BID ADDENDUM NO. 1		2025-03-07	EAI	1 thru 3
00 91 02	ADDENDUM NO. 2		2025-07-14	EAI	1 thru 3
00 91 03	ADDENDUM NO. 3		2025-03-21	EAI	1 thru 11
00 91 04	ADDENDUM NO. 4		2025-03-25	EAI	1 thru 4
SPECIFICATIONS GROUP					
GENERAL REQUIREMENTS SUBGROUP					
DIVISION 01 – GENERAL REQUIREMENTS					
01 33 23	INTERFERENCE DRAWINGS	00	2025-03-07	EAI	1 Only
*01 35 91	HERITAGE PROTECTIVE MEASURES	00	2025-01-31	EVOQ	1 thru 5
*01 42 16	HERITAGE DEFINITIONS	00	2025-01-31	EVOQ	1 and 2
FACILITY CONSTRUCTION SUBGROUP					
DIVISION 02 – EXISTING CONDITIONS					
02 41 00	DEMOLITION AND SALVAGE	00	2025-01-31	EAI	1 thru 6
*02 42 20	REMOVAL AND SALVAGE OF HERITAGE MATERIALS	01	2025-03-07	EVOQ	1 thru 5

<i>DIVISION 03 – CONCRETE</i>					
*03 01 37	CONCRETE RESTORATION	04	2025-01-31	EC	1 thru 14
*03 10 00	CONCRETE FORMING	04	2025-01-31	EC	1 thru 11
*03 20 00	CONCRETE REINFORCEMENT	04	2025-01-31	EC	1 thru 7
*03 30 00	CAST-IN-PLACE CONCRETE	04	2025-01-31	EC	1 thru 18
*03 30 53	MISCELLANEOUS CAST-IN-PLACE CONCRETE	00	2025-01-31	HKA	1 thru 4
03 35 13	CONCRETE FLOOR FINISHING	00	2025-01-31	EAI	1 thru 7
03 54 00	CAST CEMENT UNDERLAYMENT	00	2025-01-31	EAI	1 thru 5
<i>DIVISION 04 – MASONRY</i>					
*04 03 01	COMMON WORK RESULTS FOR HERITAGE MASONRY	00	2025-01-31	EVOQ	1 thru 7
*04 03 01.13	HERITAGE MASONRY CLEANING	00	2025-01-31	EVOQ	1 thru 9
*04 03 05.13	HERITAGE MORTARING	00	2025-01-31	EVOQ	1 thru 7
*04 03 05.21	HERITAGE REPOINTING	00	2025-01-31	EVOQ	1 thru 5
*04 03 42.13	HERITAGE STONE REPAIRING	00	2025-01-31	EVOQ	1 thru 7
*04 03 43.16	HERITAGE STONE REPLACING	00	2025-01-31	EVOQ	1 thru 3
*04 03 43.19	HERITAGE STONE DISMANTLING	00	2025-01-31	EVOQ	1 thru 5
*04 03 43.20	HERITAGE STONE REBUILDING	00	2025-01-31	EVOQ	1 thru 3
04 20 00	MASONRY UNITS	00	2025-01-31	EAI	1 thru 17
<i>DIVISION 05 – METALS</i>					
*05 12 00	STRUCTURAL STEEL	04	2025-01-31	EC	1 thru 22
*05 31 10	STEEL DECK	04	2025-01-31	EC	1 thru 8
05 41 00	STRUCTURAL METAL STUD FRAMING SYSTEM	00	2025-01-31	EAI	1 thru 11
05 50 00	METAL FABRICATIONS	00	2025-01-31	EAI	1 thru 8
05 51 00	METAL STAIRS AND BALUSTRADES	00	2025-01-31	EAI	1 thru 6
05 73 13	GLAZED DECORATIVE METAL RAILINGS	00	2025-01-31	EAI	1 thru 10
<i>DIVISION 06 – WOOD, PLASTICS AND COMPOSITES</i>					
06 10 00	ROUGH CARPENTRY	00	2025-01-31	EAI	1 thru 4
06 40 00	ARCHITECTURAL WOODWORK	00	2025-01-31	EAI	1 thru 7
06 61 16	SOLID SURFACING FABRICATIONS	00	2025-01-31	EAI	1 thru 7
06 90 00	GENERAL INSTALLATIONS	00	2025-01-31	EAI	1 thru 4
<i>DIVISION 07 – THERMAL AND MOISTURE PROTECTION</i>					
07 11 13	BITUMINOUS DAMPPROOFING	00	2025-03-21	EAI	1 thru 3
07 16 16	CRYSTALLINE WATERPROOFING	00	2025-01-31	EAI	1 thru 5
07 18 13	MECHANICAL ROOM WATERPROOFING	00	2025-01-31	EAI	1 thru 5
07 21 00	BUILDING INSULATION	00	2025-01-31	EAI	1 thru 6
07 21 19	FOAMED-IN-PLACE INSULATION	00	2025-01-31	EAI	1 thru 3
07 21 29	SPRAYED INSULATION	00	2025-01-31	EAI	1 thru 4
07 25 00	MISCELLANEOUS AIR/VAPOUR BARRIERS	00	2025-01-31	EAI	1 thru 7
07 42 44	ALUMINUM MODULAR PLATE SYSTEM	00	2025-01-31	EAI	1 thru 10

07 52 16	MODIFIED BITUMINOUS MEMBRANE ROOFING	00	2025-01-31	EAI	1 thru 16
07 62 00	SHEET METAL FLASHING AND TRIM	00	2025-01-31	EAI	1 thru 4
07 81 00	SPRAYED FIRE-RESISTIVE MATERIALS	00	2025-01-31	EAI	1 thru 6
07 81 23	INTUMESCENT FIRE RESISTIVE COATINGS	00	2025-01-31	EAI	1 thru 9
07 84 00	FIRESTOPPING AND SMOKE SEALS	00	2025-01-31	EAI	1 thru 13
07 92 00	JOINT SEALANTS	00	2025-01-31	EAI	1 thru 10
07 95 13	EXPANSION JOINT ASSEMBLIES	00	2025-01-31	EAI	1 thru 6
<i>DIVISION 08 – OPENINGS</i>					
*08 03 52.71	HERITAGE WOOD WINDOW AND DOOR REHABILITATION	00	2025-01-31	EVOQ	1 thru 6
08 06 80	GLAZING SCHEDULE	00	2025-01-31	EAI	1 thru 4
08 11 13	HOLLOW METAL DOORS AND FRAMES	00	2025-01-31	EAI	1 thru 9
08 11 16	ALUMINUM DOORS AND FRAMES	00	2025-01-31	EAI	1 thru 7
08 15 00	PLASTIC LAMINATE WOOD DOORS	00	2025-01-31	EAI	1 thru 6
08 31 13	ACCESS DOORS AND FRAMES	00	2025-01-31	EAI	1 thru 4
08 33 25	FIRE-RATED OVERHEAD COILING DOORS	00	2025-01-31	EAI	1 thru 5
08 43 14	ALUMINUM FRAMED FIRE-RATED STOREFRONTS	00	2025-01-31	EAI	1 thru 10
08 44 13	GLAZED ALUMINUM CURTAIN WALL	00	2025-01-31	EAI	1 thru 30
08 51 13	ALUMINUM WINDOWS	00	2025-01-31	EAI	1 thru 16
*08 71 00	FINISH HARDWARE	00	2025-01-31	UCSH	1 thru 9
08 71 13	AUTOMATIC DOOR OPERATORS	00	2025-01-31	EAI	1 thru 6
08 80 00	GLASS AND GLAZING	00	2025-01-31	EAI	1 thru 9
08 91 00	DELETED LOUVRES	00	2025-01-31	EAI	1 thru 7
<i>DIVISION 09 – FINISHES</i>					
*09 03 91	HERITAGE PAINTING	00	2025-01-31	EVOQ	1 thru 6
09 21 16	GYPSUM BOARD ASSEMBLIES	00	2025-01-31	EAI	1 thru 16
09 27 13	GLASS-FIBRE-REINFORCED GYPSUM FABRICATIONS	00	2025-01-31	EAI	1 thru 4
09 30 00	TILING	00	2025-01-31	EAI	1 thru 11
09 51 13	ACOUSTICAL PANEL CEILINGS	00	2025-01-31	EAI	1 thru 8
09 60 13	TACTILE WARNING SURFACING	02	2025-03-25	EAI	1 thru 5
09 62 19	LAMINATE FLOORING	00	2025-01-31	EAI	1 thru 6
09 65 13	RESILIENT BASE AND ACCESSORIES	00	2025-01-31	EAI	1 thru 3
09 65 43	LINOLEUM	00	2025-01-31	EAI	1 thru 6
09 84 13	FIXED SOUND-ABSORPTIVE PANELS	00	2025-01-31	EAI	1 thru 4
09 91 00	PAINTING	00	2025-01-31	EAI	1 thru 16
09 96 03	HIGH-PERFORMANCE INTERIOR COATINGS	00	2025-01-31	EAI	1 thru 4
<i>DIVISION 10 – SPECIALTIES</i>					
10 22 26	FOLDING PANEL OPERABLE PARTITIONS	00	2025-01-31	EAI	1 thru 4
10 28 00	WASHROOM ACCESSORIES	01	2025-03-21	EAI	1 thru 5
10 51 13	METAL LOCKERS	01	2025-03-21	EAI	1 thru 4

<i>DIVISION 12 – FURNISHINGS</i>					
12 24 13	MANUAL ROLLER WINDOW SHADES	00	2025-01-31	EAI	1 thru 6
12 24 14	MOTORIZED ROLLER WINDOW SHADES	00	2025-01-31	EAI	1 thru 7
12 48 16	ENTRANCE FLOOR GRILLES	00	2025-01-31	EAI	1 thru 3
*12 93 00	SITE FURNISHINGS	00	2025-01-31	HKA	1 Only
<i>DIVISION 14 – CONVEYING EQUIPMENT</i>					
*14 20 00	ELEVATORS: GENERAL		2025-01-31	KJA	1 thru 19
*14 21 23	MRL PASSENGER ELEVATOR		2025-01-31	KJA	1 thru 35
*14 41 00	PLATFORM LIFT		2025-01-31	KJA	1 thru 9
*14900	ELEVATORS: MAINTENANCE		2025-01-31	KJA	1 thru 21
<i>FACILITY SERVICES SUBGROUP</i>					
<i>DIVISION 20 – MECHANICAL GENERAL REQUIRMENTS</i>					
*20 05 00	GENERAL INSTRUCTIONS FOR MECHANICAL SECTIONS	00	2025-01-31	S+A	1 thru 20
*20 05 01	ABBREVIATIONS	00	2025-01-31	S+A	1 thru 6
*20 05 02	AS-BUILT DRAWINGS	00	2025-01-31	S+A	1 and 2
*20 05 03	SHOP DRAWINGS	00	2025-01-31	S+A	1 and 2
*20 05 05	SELECTIVE DEMOLITION FOR MECHANICAL SERVICES	00	2025-01-31	S+A	1 thru 4
*20 05 29	HANGERS AND SUPPORTS	00	2025-01-31	S+A	1 thru 5
*20 05 48	VIBRATION AND NOISE CONTROL	00	2025-01-31	S+A	1 thru 6
*20 05 53	PIPE AND DUCTWORK IDENTIFICATION	00	2025-01-31	S+A	1 and 2
*20 05 54	NAMEPLATES	00	2025-01-31	S+A	1 Only
*20 05 55	VALVE TAGS AND CHARTS	00	2025-01-31	S+A	1 Only
*20 05 63	ACCESS DOORS AND ACCESSIBILITY	00	2025-01-31	S+A	1 and 2
*20 05 73	EXCAVATION AND BACKFILL FOR MECHANICAL WORK	00	2025-01-31	S+A	1 and 2
*20 05 83	SLEEVES AND ESCUTCHEONS	00	2025-01-31	S+A	1 thru 3
*20 05 88	CUTTING AND PATCHING	00	2025-01-31	S+A	1 and 2
*20 07 00	INSULATION	00	2025-01-31	S+A	1 thru 15
*20 08 02	CLEANING AND PROTECTION	00	2025-01-31	S+A	1 Only
*20 08 03	OPERATING AND MAINTENANCE INSTRUCTIONS	00	2025-01-31	S+A	1 thru 3
<i>DIVISION 21 – FIRE SUPPRESSION</i>					
*21 12 00	STANDPIPE AND FIRE HOSE SYSTEM	00	2025-01-31	S+A	1 and 2
*21 12 26	FIRE HOSE CABINETS	00	2025-01-31	S+A	1 and 2
*21 13 00	SPRINKLER SYSTEMS	00	2025-01-31	S+A	1 thru 7
*21 25 00	PORTABLE FIRE EXTINGUISHERS	00	2025-01-31	S+A	1 Only
<i>DIVISION 22 – PLUMBING</i>					
*22 05 76	CLEANOUTS	00	2025-01-31	S+A	1 Only
*22 11 13	PIPES, VALVES AND FITTINGS (PLUMBING SYSTEM)	00	2025-01-31	S+A	1 thru 9

*22 11 23.29	CIRCULATORS	00	2025-01-31	S+A	1 Only
*22 13 19.13	FLOOR DRAINS	00	2025-01-31	S+A	1 and 2
*22 13 19.26	INTERCEPTORS	00	2025-01-31	S+A	1 Only
*22 42 00	FIXTURES AND TRIM	00	2025-01-31	S+A	1 thru 4
*22 42 46	FIXTURE CARRIERS	00	2025-01-31	S+A	1 and 2
*22 47 13	REFRIGERATED DRINKING FOUNTAINS AND BOTTLE FILLERS	00	2025-01-31	S+A	1 Only
<i>DIVISION 23 – HEATING, VENTILATING AND AIR CONDITIONING</i>					
*23 05 93.16	TESTING AND BALANCING PIPING SYSTEMS	00	2025-01-31	S+A	1 Only
*23 05 93.26	TESTING AND BALANCING AIR SYSTEMS	00	2025-01-31	S+A	1 and 2
*23 09 00	BUILDING AUTOMATION SYSTEM (BAS)	00	2025-01-31	S+A	1 thru 28
*23 09 23	SEQUENCE OF OPERATION FOR BAS	00	2025-01-31	S+A	1 thru 5
*23 21 13.23	PIPING, VALVES & FITTINGS (EXCEPT PLUMBING)	00	2025-01-31	S+A	1 thru 10
*23 23 01	REFRIGERANT PIPING	00	2025-01-31	S+A	1 thru 5
*23 25 26	CLEANING AND FILLING	00	2025-01-31	S+A	1 thru 3
*23 31 13	DUCTWORK AND SPECIALTIES	00	2025-01-31	S+A	1 thru 12
*23 34 53	ROOM VENTILATORS	00	2025-01-31	S+A	1 and 2
*23 36 16	VARIABLE VOLUME BOXES	00	2025-01-31	S+A	1 thru 3
*23 37 13	DIFFUSERS, GRILLES AND REGISTERS	00	2025-01-31	S+A	1 thru 3
*23 81 26	UNITARY AIR CONDITIONING UNITS	00	2025-01-31	S+A	1 and 2
*23 82 16	COILS	00	2025-01-31	S+A	1 and 2
*23 82 33	CONVECTOR RADIATORS	00	2025-01-31	S+A	1 and 2
	*HEATING COIL SCHEDULE		2025-01-31	S+A	1 Only
	*VAV SCHEDULE		2025-01-31	S+A	1 Only
	*AC UNIT SCHEDULE		2025-03-20	S+A	1 Only
	*KITCHEN ECOLOGY UNIT SCHEDULE		2025-01-31	S+A	1 Only
	*FAN SCHEDULE		2025-03-20	S+A	1 Only
<i>DIVISION 26 – ELECTRICAL</i>					
*26 01 00	OPERATING AND MAINTENANCE INSTRUCTIONS	00	2025-01-31	S+A	1 thru 3
*26 05 01	GENERAL INSTRUCTIONS FOR ELECTRICAL SECTIONS	00	2025-01-31	S+A	1 thru 25
*26 05 03	AS-BUILT DRAWINGS	00	2025-01-31	S+A	1 and 2
*26 05 04	SUBMITTALS/SHOP DRAWINGS	00	2025-01-31	S+A	1 and 2
*26 05 05	MOUNTING HEIGHTS	00	2025-01-31	S+A	1 and 2
*26 05 21	WIRES AND CABLES UNDER 2000 V	00	2025-01-31	S+A	1 thru 7
*26 05 21.01	PATIENT CARE WIRING	00	2025-01-31	S+A	1 thru 4
*26 05 26	GROUNDING + BONDING	00	2025-01-31	S+A	1 thru 4
*26 05 29	HANGERS AND SUPPORTS	00	2025-01-31	S+A	1 Only
*26 05 31	SPLITTERS, JUNCTION, PULL BOXES AND CABINETS	00	2025-01-31	S+A	1 and 2
*26 05 32	OUTLET BOXES, CONDUIT BOXES AND FITTINGS	00	2025-01-31	S+A	1 and 2
*26 05 34	CONDUITS, CONDUIT FASTENERS AND FITTINGS	00	2025-01-31	S+A	1 thru 4
*26 05 36	CABLE TRAYS	00	2025-01-31	S+A	1 thru 4
*26 05 40	POKE-THRU DEVICES	00	2025-01-31	S+A	1 and 2

*26 05 53	IDENTIFICATION	00	2025-01-31	S+A	1 thru 5
*26 05 63	ACCESS DOORS AND ACCESSIBILITY	00	2025-01-31	S+A	1 and 2
*26 05 73	ELECTRICAL POWER SYSTEM STUDIES	00	2025-01-31	S+A	1 thru 4
*26 05 83	SLEEVES	00	2025-01-31	S+A	1 and 2
*26 05 88	CUTTING AND PATCHING	00	2025-01-31	S+A	1 and 2
*26 08 01	TECHNICAL SERVICES DIVISION STARTUP SERVICE	00	2025-01-31	S+A	1 thru 12
*26 09 24	LIGHTING CONTROL EQUIPMENT - ADDRESSABLE LOW VOLTAGE	00	2025-01-31	S+A	1 thru 13
*26 12 17	DRY TYPE TRANSFORMERS - 600V PRIMARY	00	2025-01-31	S+A	1 thru 3
*26 24 13	SWITCHBOARDS	00	2025-01-31	S+A	1 thru 4
*26 24 17	PANELBOARDS - BREAKER TYPE	00	2025-01-31	S+A	1 thru 3
*26 27 02	SURGE PROTECTIVE DEVICE	00	2025-01-31	S+A	1 thru 5
*26 27 13	ELECTRONIC METERING	00	2025-01-31	S+A	1 thru 10
*26 27 19	MULTI-OUTLET ASSEMBLIES	00	2025-01-31	S+A	1 and 2
*26 27 26	WIRING DEVICES	00	2025-01-31	S+A	1 thru 4
*26 28 14	FUSES LOW VOLTAGE	00	2025-01-31	S+A	1 and 2
*26 28 21	MOULDED CASE AND INSULATED CASE CIRCUIT BREAKERS	00	2025-01-31	S+A	1 thru 4
*26 28 23	DISCONNECT SWITCHES - FUSED AND NON-FUSED	00	2025-01-31	S+A	1 and 2
*26 29 00	MOTOR STARTERS TO 600 V	00	2025-01-31	S+A	1 thru 6
*26 51 13	LIGHTING EQUIPMENT	00	2025-01-31	S+A	1 thru 8
*26 60 10	SNOW MELTING SYSTEM	00	2025-01-31	S+A	1 thru 4
*26 60 30	ROOF AND GUTTER DE-ICING SYSTEMS	00	2025-01-31	S+A	1 thru 3
DIVISION 27 – COMMUNICATIONS					
*27 00 05.10	GENERAL INSTRUCTIONS FOR TELECOMMUNICATIONS SECTIONS	00	2025-01-31	S+A	1 thru 8
*27 00 05.20	DEFINITIONS AND ABBREVIATIONS	00	2025-01-31	S+A	1 thru 9
*27 00 05.30	CODES, STANDARDS AND REGULATIONS	00	2025-01-31	S+A	1 thru 3
*27 00 05.50	CONTRACT DOCUMENTS	00	2025-01-31	S+A	1 Only
*27 00 05.60	ADMINISTRATIVE REQUIREMENTS	00	2025-01-31	S+A	1 thru 4
*27 00 05.70	PROJECT SPECIFIC REQUIREMENTS	00	2025-01-31	S+A	1 thru 3
*27 00 06	FIRE STOPPING AND WATER PROOFING	00	2025-01-31	S+A	1 thru 4
*27 05 28	PATHWAYS FOR TELECOMMUNICATIONS SYSTEMS	00	2025-01-31	S+A	1 thru 5
*27 05 53	IDENTIFICATION FOR TELECOMMUNICATIONS SYSTEMS	00	2025-01-31	S+A	1 and 2
*27 08 00	COMMISSIONING FOR TELECOMMUNICATIONS SECTIONS	00	2025-01-31	S+A	1 thru 6
*27 11 16	TELECOMMUNICATIONS CABINETS, RACKS, FRAMES AND ENCLOSURES	00	2025-01-31	S+A	1 thru 3
*27 11 19	TELECOMMUNICATIONS TERMINATION BLOCKS AND PATCH PANELS	00	2025-01-31	S+A	1 Only
*27 13 23	TELECOMMUNICATIONS OPTICAL FIBRE BACKBONE CABLING	00	2025-01-31	S+A	1 thru 4
*27 15 00.19	DATA TELECOMMUNICATIONS HORIZONTAL CABLING	00	2025-01-31	S+A	1 thru 3
*27 15 33.00	TELECOMMUNICATIONS COAXIAL HORIZONTAL CABLING	00	2025-01-31	S+A	1 and 2

*27 15 43	TELECOMMUNICATIONS FACEPLATES AND CONNECTORS	00	2025-01-31	S+A	1 thru 4
*27 16 19	TELECOMMUNICATIONS PATCH CORDS AND CROSS CONNECT WIRE	00	2025-01-31	S+A	1 and 2
	*COMMUNICATIONS INFRASTRUCTURE SPECIFICATIONS, STANDARDS AND PRACTICES		2025-01	UofT	38 pages
<i>DIVISION 28 – ELECTRONIC SAFETY AND SECURITY</i>					
*28 00 03	ADMINISTRATIVE REQUIREMENTS		2025-01-31	S+A	1 thru 3
*28 00 05.30	CODES, STANDARDS, AND REGULATIONS		2025-01-31	S+A	1 thru 3
*28 00 06	FIRE STOPPING AND WATER PROOFING		2025-01-31	S+A	1 thru 4
*28 01 00	GENERAL INSTRUCTIONS FOR ESS SECTIONS		2025-01-31	S+A	1 thru 6
*28 01 01	OPERATION AND MAINTENANCE OF ELECTRONIC SAFETY AND SECURITY		2025-01-31	S+A	1 Only
*28 05 00	RACEWAYS FOR SECURITY SYSTEM	00	2025-01-31	S+A	1 Only
*28 05 00	COMMON WORK RESULTS FOR ELECTRONIC SAFETY AND SECURITY		2025-01-31	S+A	1 and 2
*28 05 03	RECORD DRAWINGS		2025-01-31	S+A	1 thru 3
*28 05 04	SUBMITTALS - SHOP DRAWINGS		2025-01-31	S+A	1 and 2
*28 05 05.20	DEFINITIONS AND ABBREVIATIONS		2025-01-31	S+A	1 thru 6
*28 05 13	CONDUCTORS AND CABLES FOR ELECTRONIC SAFETY AND SECURITY		2025-01-31	S+A	1 thru 4
*28 05 26	GROUNDING AND BONDING FOR ELECTRONIC SAFETY AND SECURITY		2025-01-31	S+A	1 and 2
*28 05 28	PATHWAYS FOR ELECTRONIC SAFETY AND SECURITY		2025-01-31	S+A	1 thru 3
*28 05 53	IDNETIFICATION FOR ELECTRONIC SAFETY AND SECURITY		2025-01-31	S+A	1 and 2
*28 08 00	COMMISSIONING OF ELECTRONIC SAFETY AND SECURITY		2025-01-31	S+A	1 thru 3
*28 31 02	MULTIPLEX FIRE ALARM SYSTEM	00	2025-01-31	S+A	1 thru 18
<i>SITE AND INFRASTRUCTURE SUBGROUP</i>					
<i>DIVISION 32 – EXTERIOR IMPROVEMENTS</i>					
*32 13 13	CONCRETE PAVING	00	2025-01-31	HKA	1 thru 5
*32 14 13	UNIT PAVING	00	2025-01-31	HKA	1 and 2
*32 93 00	PLANTING	00	2025-01-31	HKA	1 thru 6

LEGEND

* - Specifications prepared by Consultants other than ENFORM Architects Inc. have been prefixed with an asterisk. These Specifications are not included under, nor governed by ENFORM Architects Inc.'s seal.

Consultant's Abbreviations:

UofT University of Toronto
EAI ENFORM Architects Inc.
EC Entuitive Corporation
EVOQ EVOQ Architecture
UCSH Upper Canada Specialty Hardware Limited

Owner
Architectural (A)
Structural Consultant (S)
Heritage Consultant
Hardware Consultant

S+A *Smith + Andersen*
S+A *Smith + Andersen*
KJA *KJA Consultants Inc.*
MBII *Mulvey & Banani International Inc.*
HKA *Henry Kortekaas and Associates Inc.*

Mechanical Consultant (M)
Electrical Consultant (E)
Vertical Transportation Consultant
Security Consultant
Landscape Consultant (L)

END OF SECTION

PART 1 - GENERAL

1.1. GENERAL INSTRUCTIONS

- 1.1.1. Read and conform to:
 - 1.1.1.1. CCDC 2 - 2020, Stipulated Price Contract as amended in the Contract Documents.
 - 1.1.1.2. Division 1 requirements and documents referred to therein.

1.2. SUMMARY

- 1.2.1. Section Includes: Provide tactile warning surfacing including but not limited to following:
 - 1.2.1.1. cast-in-place tactile warning surfacing.
 - 1.2.1.2. surface applied tactile warning surfacing.
- 1.2.2. Related Sections: Following description of work is included for reference only and shall not be presumed complete:
 - 1.2.2.1. Filling and sealing of sawcut joints in concrete slab: Section 03 35 13, Concrete Floor Finishing.
 - 1.2.2.2. Provision of laminate flooring: Section 09 62 19, Laminate Flooring.
 - 1.2.2.3. Provision of linoleum sheet flooring: Section 09 65 43, Linoleum.

1.3. REFERENCES

- 1.3.1. Abbreviations and Acronyms:
 - 1.3.1.1. SDS: Safety Data Sheet.

1

- 1.3.2. Reference Standards:
 - 1.3.2.1. ASTM A48/A48M-22 - Standard Specification for Gray Iron Castings 1

1.4. ADMINISTRATIVE REQUIREMENTS

- 1.4.1. Preinstallation Meetings: Arrange preinstallation meeting 1 week before commencing work with all parties associated with trade as designated in Contract Documents or as requested by Consultant. Presided over by Contractor, include Consultant who may attend, Subcontractor performing work of this trade, Owner's representative, testing company's representative and consultants of applicable discipline. Review Contract Documents for work included under this trade and determine complete understanding of requirements and responsibilities relative to work included, storage and handling of materials, materials to be used, installation of materials, sequence and quality control, Project staffing, restrictions on areas of work and other matters affecting construction, to permit compliance with intent of work of this Section.

1.5. SUBMITTALS

- 1.5.1. Product Data: Submit Product data on tactile warning surfacing; clearly indicate specific items proposed for use if manufacturer's catalogues are submitted.
- 1.5.2. Samples: Submit samples in accordance with Section 01 30 00. Submit following samples in sizes indicated:
 - 1.5.2.1. cast-in-place tactile surfacing 300 mm (12") square.
 - 1.5.2.2. surface applied tactile surfacing 300 mm (12") square.

1.6. CLOSEOUT SUBMITTALS

- 1.6.1. Operational and Maintenance Data: Submit 3 copies of Product maintenance manual to Consultant prior to completion of the Work. Ensure manual contains specific maintenance recommendations and gives specific warning of any maintenance practice or materials which may damage or disfigure tactile warning surfacing.

1.7. MAINTENANCE MATERIAL SUBMITTALS

- 1.7.1. Extra Stock Materials: Leave 2 extra tiles of each type of tactile warning surfacing specified for Owner's future maintenance use. Supply tactile warning surfacing from same production run as installed. Execute Section 00 65 37.

1.8. QUALITY ASSURANCE

- 1.8.1. Qualifications:
- 1.8.1.1. Installers: Provide work of this Section executed by competent installers with minimum 5 years' experience in the application of Products, systems and assemblies specified and with approval and training of the Product manufacturers.
- 1.8.2. Mock-Ups: Construct minimum 10 m² (100 sq ft) mock-up sample at Project location designated by Consultant for review. Once reviewed with no objection recorded, sample remains part of finished work and used as a quality reference standard for balance of Project.

1.9. DELIVERY, STORAGE AND HANDLING

- 1.9.1. Delivery and Acceptance Requirements:
- 1.9.1.1. Deliver materials in good condition to site in manufacturer's original unopened containers that bears name and brand of manufacturer, Project identification, shipping and handling instructions.
- 1.9.1.2. Deliver flooring material in a manner to avoid deterioration, staining or any other damage.
- 1.9.1.3. Deliver packaged floor preparation and adhesive materials in their original bags or containers clearly identified; keep containers sealed and labels intact until time of use. Prevent damage or contamination to materials by water, moisture, freezing, excessive heat, foreign matter or other causes.
- 1.9.1.4. Deliver materials on site at least 24 hours before work begins.
- 1.9.2. Storage and Handling Requirements:
- 1.9.2.1. Store and handle flooring material in a manner to avoid deterioration, staining or any other damage.
- 1.9.2.2. Store packaged floor preparation and adhesive materials in their original bags or containers clearly identified; keep containers sealed and labels intact until time of use. Prevent damage or contamination to materials by water, moisture, freezing, excessive heat, foreign matter or other causes. If materials are frozen, do not stir any such liquids or adhesives until they are completely thawed.
- 1.9.2.3. Provide secure heated and dry storage facilities on site. Maintain temperature in storage area between 18 deg C (65 deg F) and 38 deg C (100 deg F).
- 1.9.2.4. Store materials on site at least 24 hours before work begins.

1.10. SITE CONDITIONS

- 1.10.1. Ambient Conditions:
- 1.10.1.1. Maintain appropriate environmental conditions and protect work during and after installation. Comply with trade standards and manufacturer's Product instructions. Follow Product SDS and label instructions concerning safety, health and other related precautionary and environmental protection. Comply with applicable federal, provincial, local and statutory regulations.

- 1.10.1.2. Close doors and windows. Turn off radiant floor heating systems and protect work area from direct draft, sun and heat exposure during installation and for at least 72 hours after completion.
- 1.10.1.3. When necessary, build a temporary shelter and use indirect auxiliary heaters to maintain an adequate temperature level in work environment.
- 1.10.1.4. Exhaust temporary heaters to building exterior to prevent health hazards and damage to work from toxic fumes and emanations.
- 1.10.1.5. Maintain temperature of floor covering areas at not less than 18 deg C (65 deg F) or more than 38 deg C (100 deg F) 48 hours before, during installation and for 48 hours after application unless otherwise required in Product instructions.

1.11. WARRANTY

- 1.11.1. Manufacturer Warranty: Warrant work of this Section for period of 5 years against defects and/or deficiencies in accordance with General Conditions of the Contract. Promptly correct any defects or deficiencies which become apparent within warranty period, to satisfaction of Consultant and at no expense to Owner. Defects include but are not limited to; buckling, opening of seams, bond failure and extensive colour fading.

PART 2 - PRODUCTS

2.1. MANUFACTURERS

- 2.1.1. Manufacturer List: Products of following manufacturers are permitted subject to conformance to requirements of Drawings, Schedules and Specifications:
 - 2.1.1.1. AccessTile; www.accesstile.com
 - 2.1.1.2. Engineered Plastics Inc.; www.armor-tile.com
 - 2.1.1.3. Kinesik Engineered Products Incorporated; www.kinesik.ca
- 2.1.2. Substitution Limitations: Comparable Products from other manufacturers not listed herein may be reviewed provided they meet requirements of this Specification.

2.2. MATERIALS

- 2.2.1. Cast-in-Place Tactile Warning Surfacing: Provide 1 of following:
 - 2.2.1.1. Ceramic Tile Type: Provide 10 mm thick porcelain tactile walking surface indicator with 4 mm high truncated domes in colour indicated in "Material and Finish Schedule" appended to Section 00 01 20. Permitted Product: "Elan® Tile" by Kinesik Engineering Products Incorporated.
 - 2.2.1.2. Polymer Type:
 - 2.2.1.2.1. Provide 3 mm thick polymer based tactile walking surface indicator with 5 mm high truncated domes in colour indicated in "Material and Finish Schedule" appended to Section 00 01 20. Permitted Products: "Eon® Tile" by Kinesik Engineering Products Incorporated or "Intelligent Design™ Cast In Place Replacement" by AccessTile.
 - 2.2.1.2.2. Provide vitrified polymer composite based tactile walking surface indicator with raised truncated domes in colour indicated in "Material and Finish Schedule" appended to Section 00 01 20. Permitted Product: "Armor-Tile™ Cast in Place" by Engineered Plastics Inc.
 - 2.2.1.2.3. Provide fire resistant vitrified polymer composite based tactile walking surface indicator with raised truncated domes in colour selected later by Consultant. Permitted Product: "Access Tile® FR Cast in Place" by Kinesik Engineered Products Incorporated.

1

- 2.2.1.3. **2...2** Cast Iron Cast-in-Place Tactile Warning Surfacing: Provide 6 mm thick cast iron tactile walking surface indicator with 4 mm high truncated domes 22 mm in diameter with concentric rings in middle in accordance with ASTM A48/A48M. Permitted Products: "Advantage® Cast Iron Tactile Walking Surface Indicator [TWSI], **Product Code: ADV-D-1281-N**" by Kinesik Engineering Products Incorporated or "Detectable Warning Plates" by Reliance Foundry Co Ltd.

1...2

- 2.2.2. Surface Applied Tactile Warning Surfacing: Provide 1 of following:
- 2.2.2.1. Domes: Provide 4 mm high 316L, marine grade stainless steel truncated domes 22 mm in diameter with concentric rings in middle; "Advantage® One Tactile Walking Surface Indicators (TWSI) Dome, Product Code: ADV-D-1281-N" by Kinesik Engineered Products Incorporated.
- 2.2.2.2. Provide vitrified polymer composite based tactile walking surface indicator with raised truncated domes in colour indicated in "Material and Finish Schedule" appended to Section 00 01 20. Permitted Products: "Armor-Tile™ Surface Applied" by Engineered Plastics Inc. or "Intelligent Design™ Surface Applied" by AccessTile.
- 2.2.2.3. Provide fire resistant vitrified polymer composite based tactile walking surface indicator with raised truncated domes in colour indicated in "Material and Finish Schedule" appended to Section 00 01 20. Permitted Product: "Access Tile® FR Surface Applied" by Kinesik Engineered Products Incorporated.

PART 3 - EXECUTION

3.1. EXAMINATION

- 3.1.1. Verification of Conditions: Verify actual site dimensions and location of adjacent materials prior to commencing work. Notify Consultant in writing of any conditions which would be detrimental to the installation.
- 3.1.2. Evaluation and Assessment: Commencement of work implies acceptance of previously completed work.

3.2. INSTALLATION

- 3.2.1. Install tactile warning surfacing according to manufacturer's written instructions unless otherwise indicated.
- 3.2.2. Place tactile warning surfacing units in dimensions and orientation indicated on Drawings.

3.3. SITE QUALITY CONTROL

- 3.3.1. Non-Conforming Work: Replace damaged work which cannot be satisfactorily repaired, restored or cleaned, to satisfaction of Consultant at no cost to Owner.

3.4. CLEANING


- 3.4.1. Remove protective plastic sheeting from detectable warning tiles within 24 hours of installation.
- 3.4.2. Clean tiles not more than 4 Days prior to date scheduled for inspection intended to establish Date of Substantial Performance in each area of the Project.

3.5. PROTECTION


- 3.5.1. Protect detectable warning tiles against damage during construction period to comply with tile manufacturer's specifications.

- 3.5.2. During and after detectable warning tile's installation and concrete curing stage, it is imperative no walking, leaning, or external forces are placed on tile to rock tile, causing a void between underside of tile and concrete substrate.

END OF SECTION

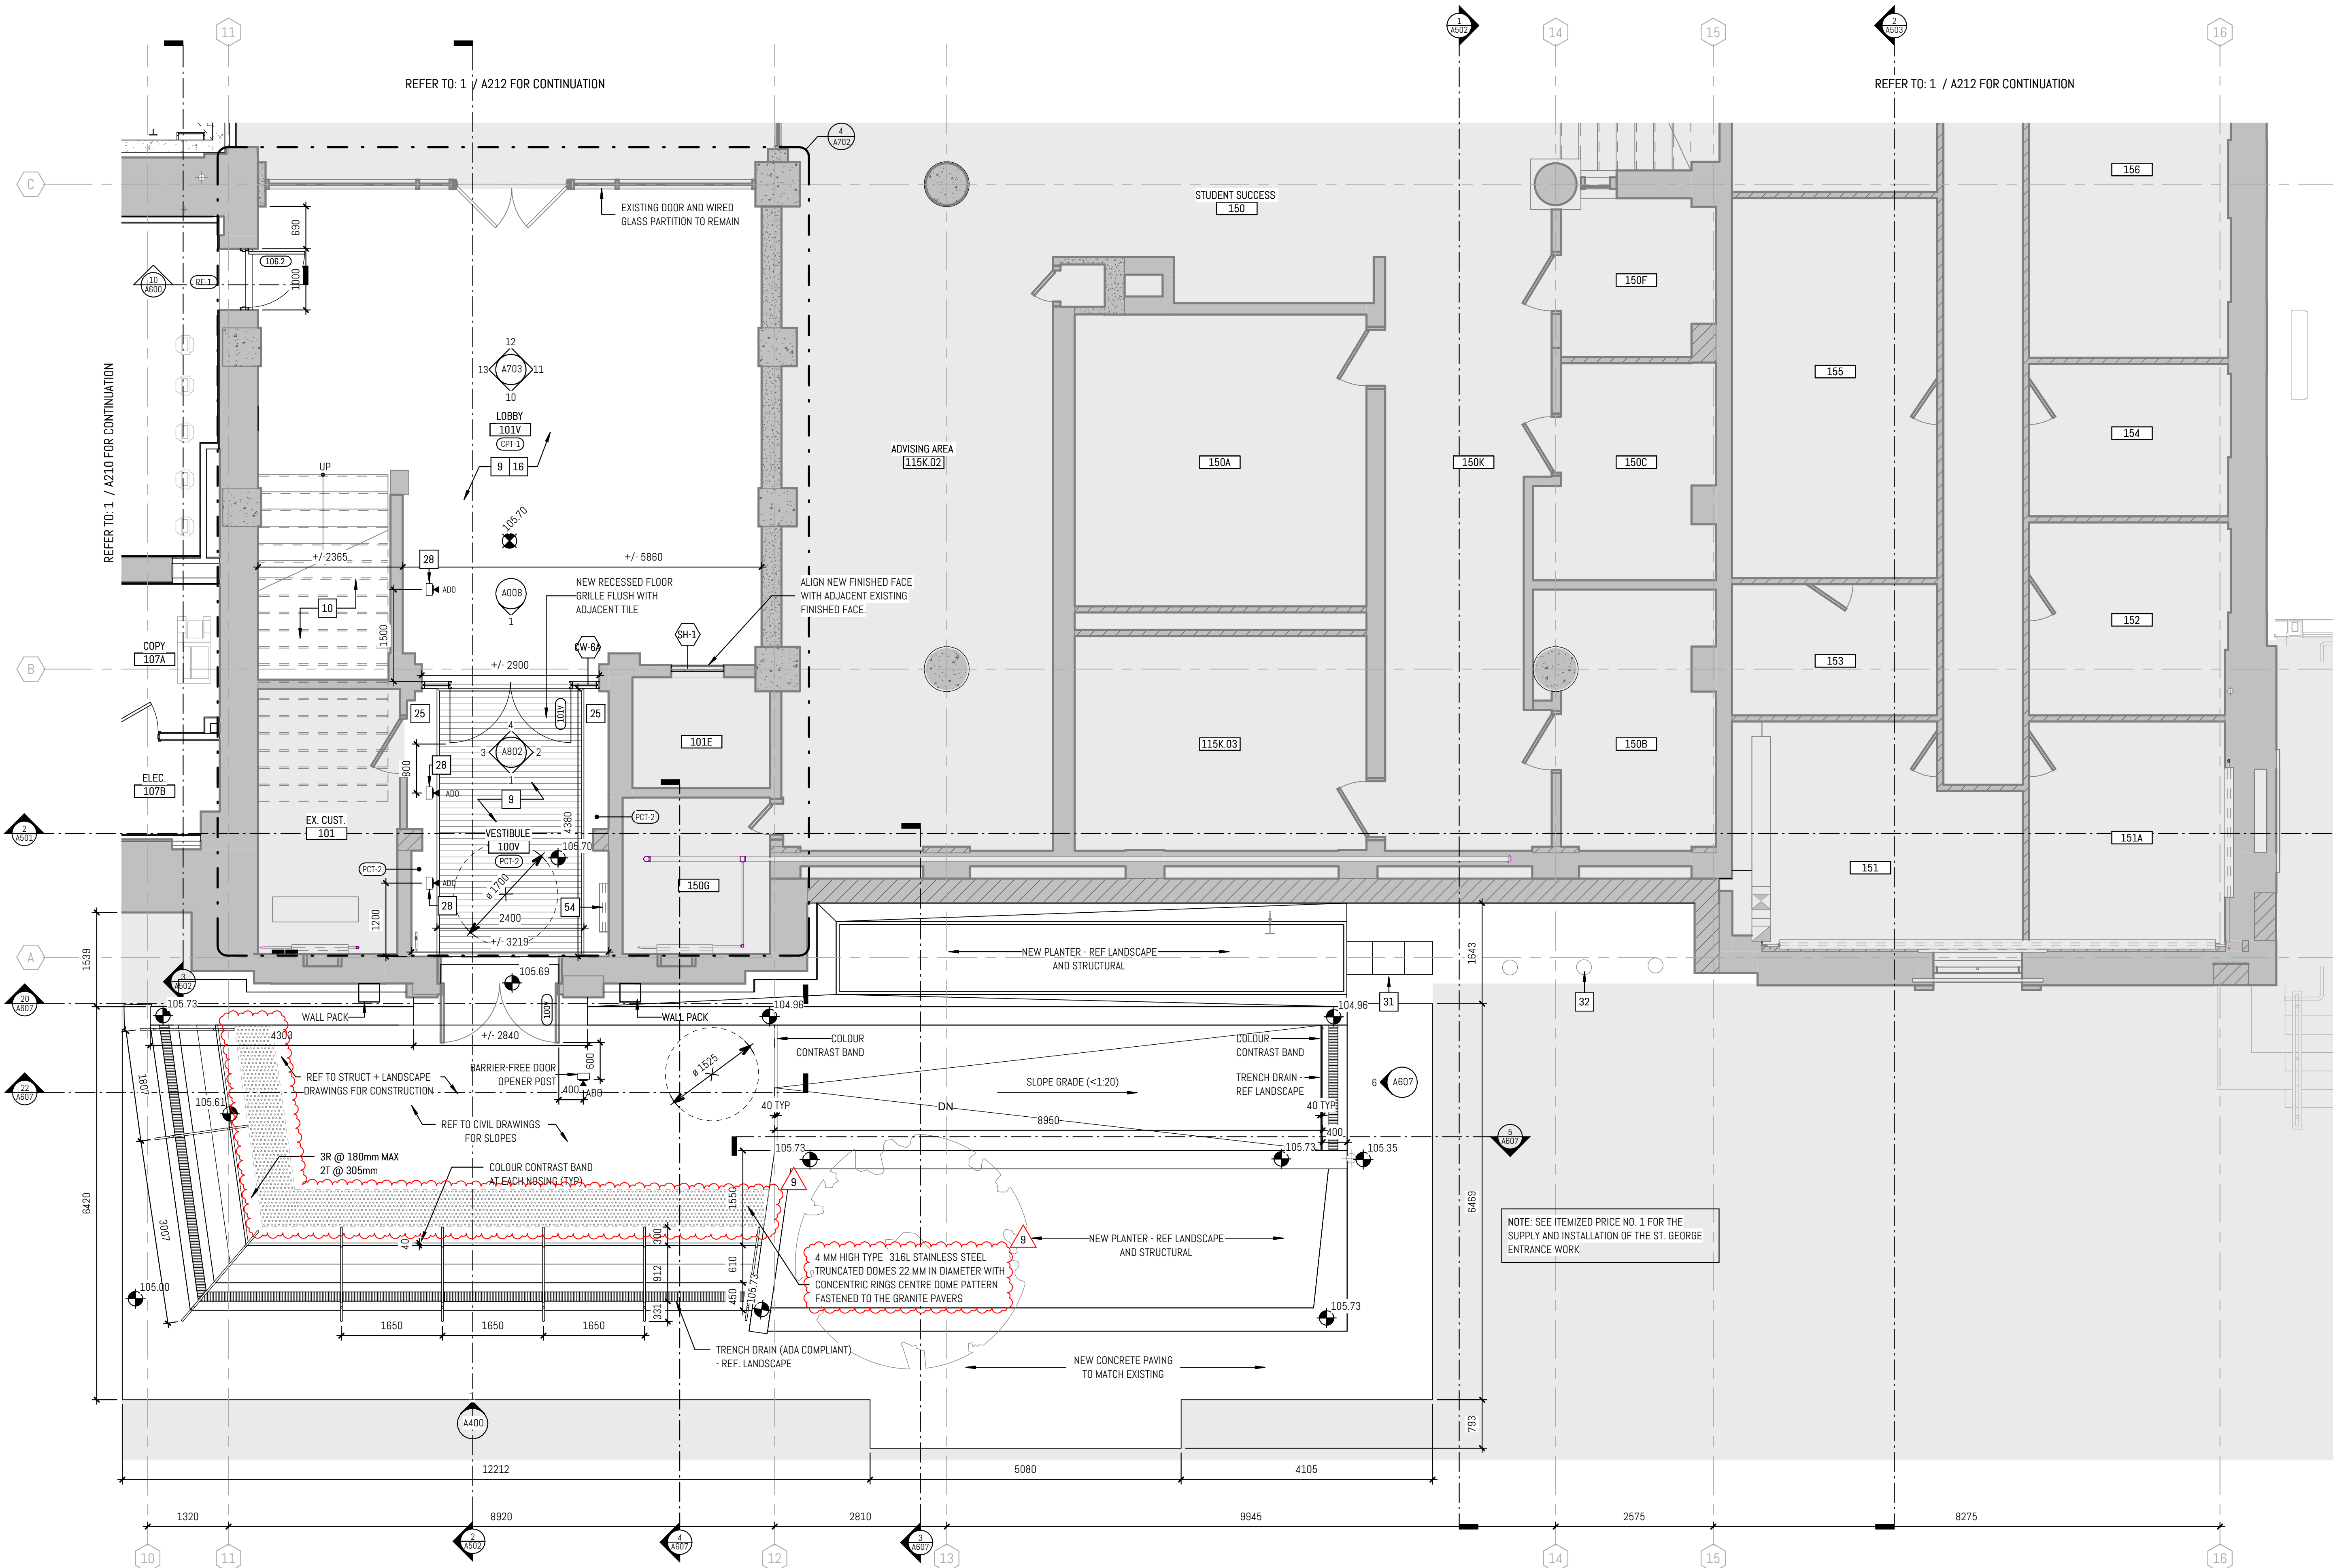

1
A211
LEVEL 01 - NORTHEAST - ENLARGED PLAN
1:50

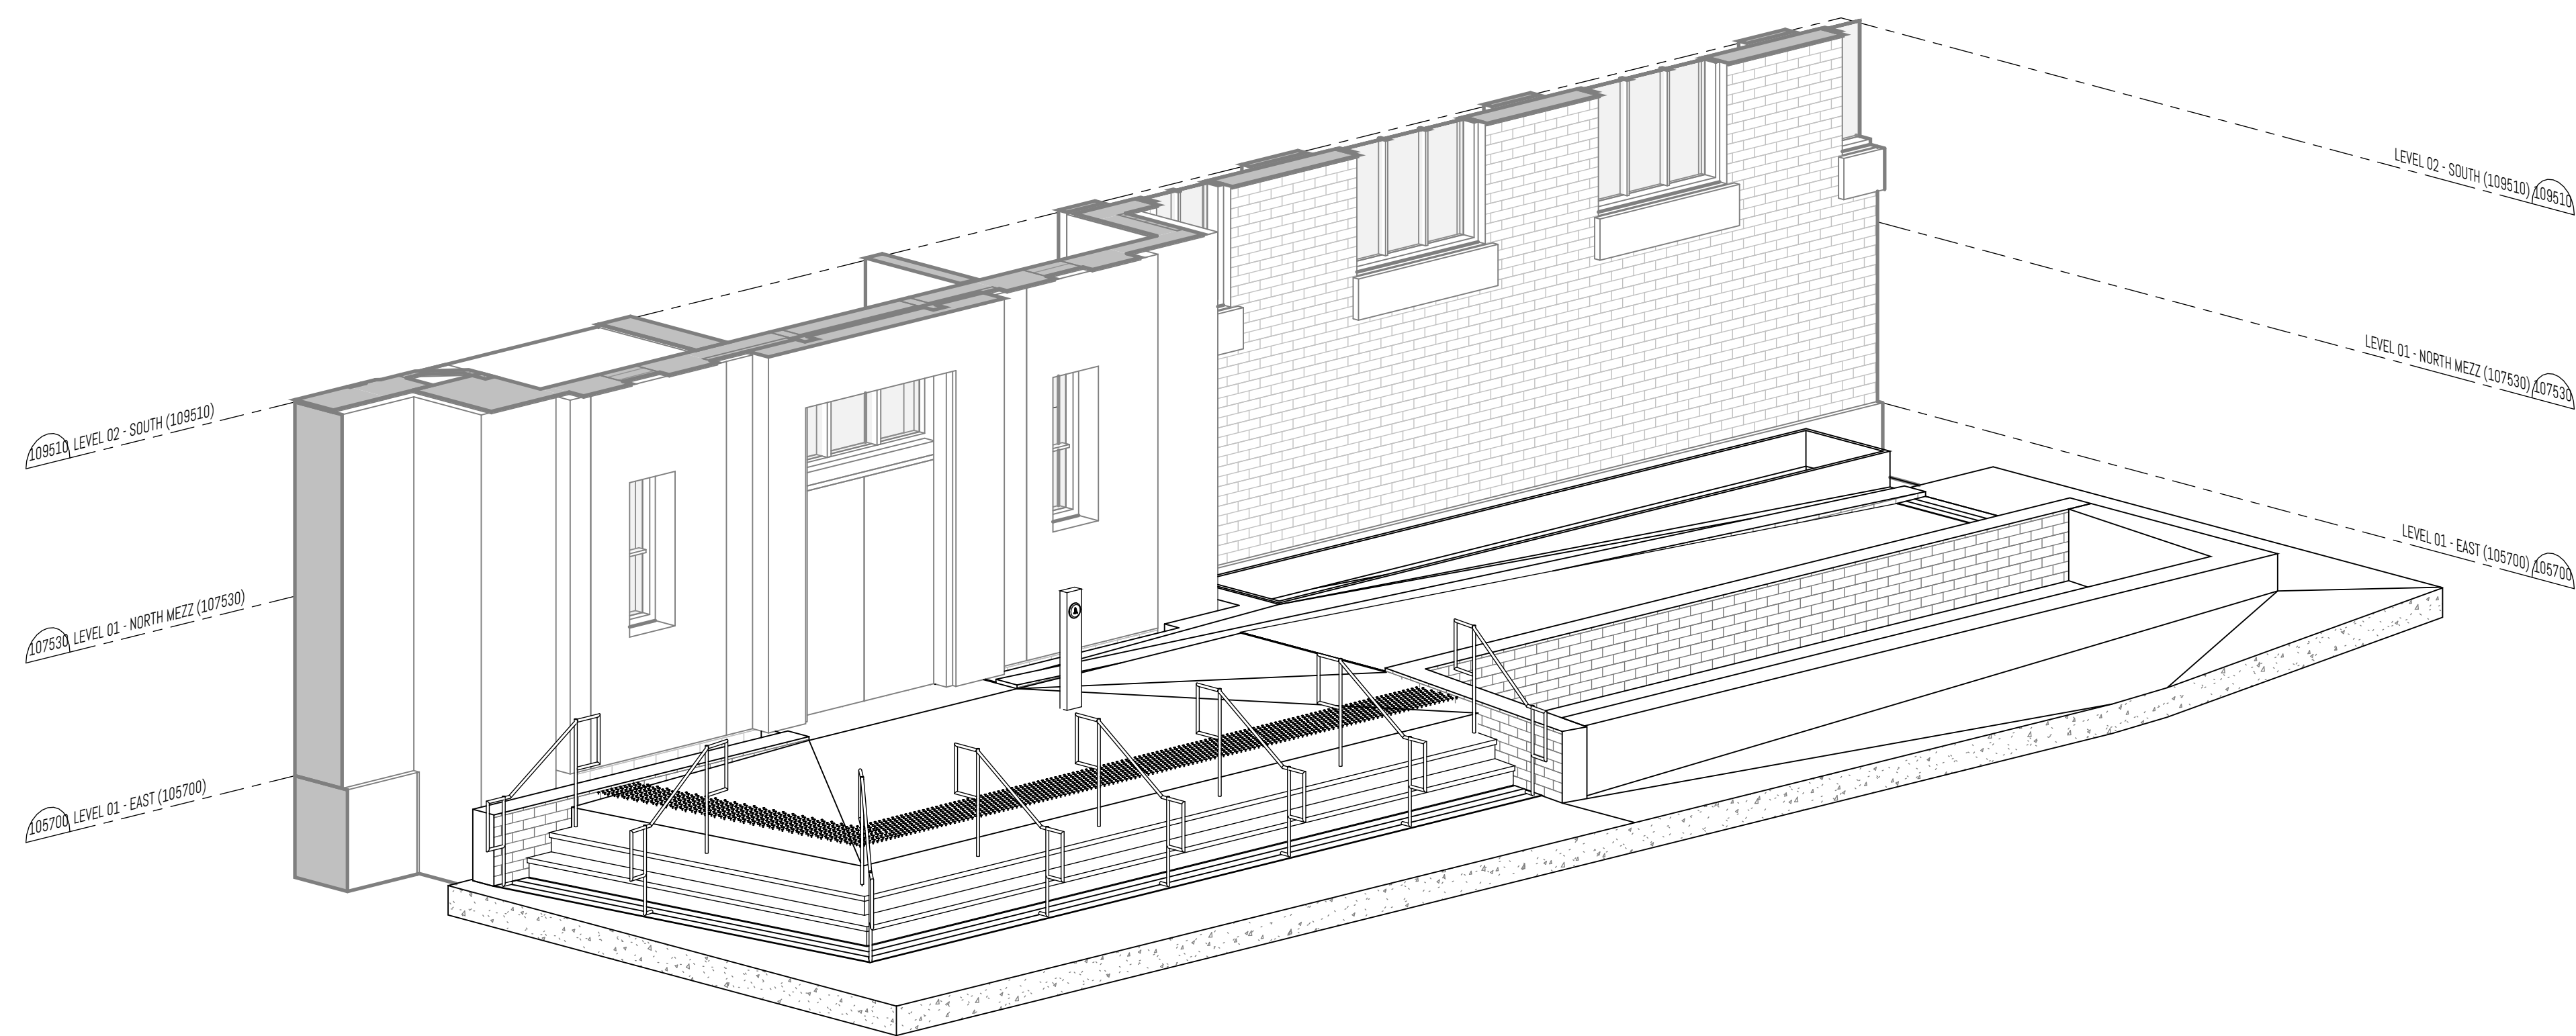


2
A211
LEVEL 01 - FRONT ENTRANCE ISOMETRIC

NEW WORK - ENLARGED PLAN NOTES	
NOTE	DESCRIPTION
1	PROVIDE NEW FLOORING AND BASE THROUGHOUT ROOM OR TO EXTEND SHOWN ON PLAN TO MATCH EXISTING
2	WHEELCHAIR AND MOBILITY SCOOTER WAITING SPACES DESIGNATED CLEAR SPACE TO BE NO LESS THAN 760mm (30") BY 1370mm (54")
3	REMOVE ALL EXISTING FILM, REPAINT EXISTING WOOD DOOR AND WINDOW FRAMES, SILLS AND CASING
4	NEW SUB INFILL, REFER TO STRUCTURAL
5	2-HR FIRE RATED ACCESS DOOR FOR MECH, COORDINATE LOCATION WITH MECH ON SITE. SEE INT. ELEVATIONS, SEE MECH.
6	305MM x 305MM RECESSED ACCESS DOOR TO RECEIVE WP-1, COORDINATE LOCATION WITH MECH ON SITE. SEE INT. ELEVATIONS FOR LOCATION. SEE MECH.
7	DRINKING FOUNTAIN, SEE MECH.
8	NEW RADIATOR COVER ON EXISTING RADIANT FIN TUBE, COMPLETE WITH COVERS AND TRIMS TO ENCLOSE ALL PIPING AND EXTEND WALL TO WALL (WHERE APPLICABLE)
9	PAINT EXISTING GYM WALLS, CEILING & BULKHEAD THROUGHOUT ROOM OR TO EXTEND SHOWN ON PLAN. PROTECT AND MAINTAIN EXISTING GOLD CAPITALS.
10	EXISTING TRAVERTINE LANDING & STAIRS TO BE CLEANED & SEALED, REPLACE NON SLIP STRIPS, PAINT EXISTING METAL GUARDRAILS & HANDRAILS, REFINISH EXISTING WOOD HANDRAILS AS PER SPECIFICATIONS
11	PROVIDE NEW WALL BASE TO MATCH EXISTING ON NEW WALLS FOR FULL LENGTH OF WALL OR WHERE DAMAGED BY DEMOLITION WORK
12	INSTALL NEW WINDOW IN EXISTING WINDOW OPENING, REFER TO DEMO PLANS FOR REMOVAL OF EXISTING INFILL.
13	INSTALL NEW WINDOW IN EXISTING DOOR OPENING, PROVIDE NEW STONE SILL TO MATCH EXISTING SILLS, INFILL WITH 1800MM CMU AND RECLAIMED BRICK MASONRY ABOVE AND BELOW WINDOW TO MATCH EXISTING DEPTH, INCLUDING THE RECESSED PANEL PATTERN.
14	NEW RADIATOR WITH INTEGRATED COVER, COMPLETE WITH COVERS AND TRIMS TO ENCLOSE ALL PIPING AND EXTEND WALL TO WALL (WHERE APPLICABLE) REFER TO 7/A802
15	INSTALL NEW WINDOW IN EXISTING MASONRY WALL, WINDOW SIZE SHOWN FOR INTENT ONLY - SIZE AND LOCATE WINDOW TO SUIT EXISTING BRICK/TILE EXTERIOR WALL FINISH PATTERN AS INDICATED ON EXTERIOR ELEVATIONS, REFER TO STRUCTURAL FOR UNTEL DETAILS.
16	REPLACE CARPET TO MATCH EXISTING.
17	REPAIRS
18	PATCH AND REPAIR OPENING IN BRICK MASONRY AROUND NEW BEAM ANCHORS, SEE STRUCT. RE-USE EXISTING BRICKS.
20	INTEGRATE NEW INTERIOR FINISHES WITH EXIST. COLUMN FINISHES PATCH AND MAKE GOOD AS REQ'D (TYP)
21	BRICK IN EXISTING WINDOW OPENINGS WITH COLOUR-MATCHING SALVAGED BRICK FROM DEMO PHASE.
22	EXISTING WINDOW OPENING TO BE INFILLED WITH MASONRY, EXISTING GLAZING TO BE COVERED WITH OPAQUE FILM (SPEC. AND COLOUR T80)
24	2HR FRR GLAZING SYSTEM
25	NEW PCT FLOOR FINISH, REFER TO ROOM FINISH SCHEDULE
26	PROVIDE NEW WALL BASE TO MATCH EXISTING PERIMETER WALL BASE TRIM
27	NEW STAINLESS STEEL HANDRAIL, 38 DIA.
28	SS BOLLARD SEE DETAIL 1/A807
31	NEW DAMAGED ON LOCATION
32	EXISTING THREE BICYCLE RINGS TO REMAIN.
34	REINSTATE FLOOR FINISH TO MATCH EXISTING.
35	SUPPLY AND INSTALL VINYL GRAPHIC, OWNER TO PROVIDE DIGITAL FILE.
36	ACCESSIBLE COUNTER.
37	SUPPLY AND INSTALL FLOOR MOUNTED MOP SINK WITH WALL MOUNTED MOP HOLDERS AND SHELVING.
38	AV RACK, REFER TO ELEC. AND AV DOCUMENTATION.
39	ELEC. PANELS, REFER TO ELEC. DOCUMENTATION.
41	SUPPLY AND INSTALL PLYWOOD SUBSTRATE.
42	SUPPLY AND INSTALL 2-HR FIRE RATED ROLLER SHUTTER, SHUTTER CASSETTE TO BE CONCEALED IN CEILING WITH RECESSED ACCESS DOORS AS REQUIRED.
43	NEW HANDRAIL.
44	NEW GUARD TO BE ENGINEERED BY CONTRACTOR.
45	EXISTING SPRINKLER PROTECTED GLAZING.
46	MAKE GOOD EXISTING ROOF SYSTEM.
47	EXISTING RADIATORS ABOVE, REFER TO MECHANICAL DOCUMENTATION FOR PIPING WORKS.
48	SUPPLY AND INSTALL 1 LAYER OF 18mm FIRE RETARDANT FLYWOOD (FRFW) FASTENED TO THE TOP FLANGE OF THE C-JOISTS.
51	NEW STEEL STAIR GUARD + HANDRAIL - ENGINEERED BY CONTRACTOR
52	TYPICAL COMMENT (GROUND FLOOR): SUPPLY AND INSTALL 18MM GWB PATCHING (INFILL) TO ALL PERIMETER WALL SURFACES WHERE EXISTING OPENINGS (HOLES) ARE OBSERVED LOCATED SOUTH OF GRID 11 UP TO THE 300MM AFT TO ACCOMMODATE A NEW PAINT FINISH.
53	CLEAN EXISTING MASONRY COLUMN, REPAIR, REPOINT AND SUPPLY AND APPLY SEALER - TYPICAL FOR MASONRY COLUMNS
54	PREPARE (SAND AND PRIME) AND REPAINT EXISTING RADIATOR COVER.
55	SUPPLY AND INSTALL MANUAL ROLLER SHADE (INSIDE MOUNT) WITH PRE-FINISHED ALUMINUM FASCIA (COLOUR: WHITE) AND STAINLESS STEEL BALL CHAIN AND KEEPER - CONTRACTOR TO SITE MEASURE EXISTING WINDOW OPENING.
56	SUPPLY AND INSTALL 18MM GWB AT THE BASE OF THE EXISTING WALL TO CLOSE GAP, AND TO ACCOMMODATE NEW PAINT FINISH AND WALL BASE.
57	SUPPLY AND INSTALL MOTORIZED BLACKOUT ROLLER SHADES WITH PRE-FINISHED ALUMINUM FASCIA (COLOUR: WHITE), CONTRACTOR TO SITE MEASURE EXISTING WINDOW OPENING, INTEGRATE BLIND CONTROLS WITH AV SYSTEMS.
58	TYPICAL NOTE FOR 2ND & 3RD LEVELS: MAKE GOOD ALL PERIMETER WALL SURFACES NORTH OF GRID 11 UP TO 2750MM A.F.F. TO ACCOMMODATE A NEW PAINT FINISH. THE SCOPE INCLUDING PATCHING (INFILL GWB) IF REQUIRED.
59	TYPICAL NOTE FOR 2ND & 3RD LEVELS: MAKE GOOD ALL PERIMETER WALL SURFACES SOUTH OF GRID 11 UP TO THE UNDERSIDE OF THE EXISTING CEILING TO ACCOMMODATE A NEW PAINT FINISH. THE SCOPE INCLUDING PATCHING (INFILL GWB) IF REQUIRED.
60	ALIGN INSIDE SURFACE OF NEW INFILL WALL ASSEMBLY WITH EXISTING WALL ASSEMBLY ABOVE. CONTRACTOR TO VERIFY DIMENSIONS OF INFILL ASSEMBLY AT SITE FOLLOWING ABATEMENT WORKS BY OTHERS.
61	EXISTING ROOF LADDER WITH SAFETY CAGE
63	NEW 4X12' FLOATING GLASS WHITEBOARD
64	NEW RADIATOR FIN TUBE CONCEALED BEHIND FINISHES.
65	ALONG GRID 11 AT LEVELS 2 AND 3, CONTRACTOR TO REPAIR EXISTING 1HR FIRE RATED ASSEMBLY (REF. BUILDING SECTION 1/A501) AND APPLY FIRESTOPPING MATERIAL AT LOCATIONS WHERE EXISTING PIPING SERVICES PENETRATE. REPAIR OPENINGS WITH WALL TYPE B2A OR SH-1.
66	SEPARATE PRICE NO. 1: TO SUPPLY AND INSTALL A WATER BASED AIR/LIQUID MOISTURE BARRIER TO THE INSIDE FACE OF THE EXISTING LEVEL 3 EXTERIOR WALL ALONG GRID 14 BETWEEN BRICK CANY & C&B SHIELD LIFT BY W. R. MEADOWS OF CANADA.
67	ALTERNATIVE PRICE NO. 1: IN LIEU OF THE REMOVAL OF DECOMMISSIONED ELEVATOR AND ASSOCIATED WORKS AS INDICATED IN THE DRAWINGS AND SPECIFIED HEREIN, PROVIDE ONLY DECOMMISSIONING OF THE ELEVATOR (CUT HOIST ROPS) & PUT CAB INTO THE PIT, SEAL DOORS, HAVE TSSA DECOMMISSION AS SPECIFIED HEREIN, INCLUDING ANY ASSOCIATED WORK SHALL BE INCLUDED.
68	APPLY FIRESTOPPING TO EXISTING PENETRATIONS TO ENSURE COMPLIANT FIRE SEPARATION.

EQUIPMENT TYPE SCHEDULE		TYPE COMMENT		Supply	Install
EQ-01	PATIENT EXAM BED			U/L	CONTRACTOR
EQ-02	WALL MOUNTED INTEGRATED EQUIPMENT	SYSTEM INCLUDES: OPHTHALMOSCOPE, OTOSCOPIES, THERMOMETRY, BLOOD PRESSURE, WALL ANEROID & KLEINSPEC DISPENSER		U/L	CONTRACTOR
EQ-03	EXAM LIGHTS			U/L	CONTRACTOR
EQ-04	SPECIMEN FRIDGE			U/L	CONTRACTOR
EQ-05	PRINTER			U/L	CONTRACTOR
EQ-06	KIOSK FLOOR STAND FOR IPAD			U/L	CONTRACTOR
EQ-07	STAINLESS STEEL SPECIMEN PASS-THRU CABINET - 12x12			CONTRACTOR	CONTRACTOR

GENERAL NOTES, NEW WORK
A. MAKE GOOD ALL EXISTING WALL SURFACES DAMAGED DURING REMOVALS AND CONSTRUCTION.
B. NEW FLOOR FINISHES, REFER TO FINISH SCHEDULE.
C. NEW DOOR & DOOR FRAME, REFER TO DOOR SCHEDULES.
D. PAINT ALL EXISTING DOORS AND DOOR FRAMES.
E. PROVIDE FIRESTOPPING TO ALL NEW FLOOR SERVICE PENETRATIONS, REFER TO MECH AND ELEC DWGS FOR LOCATIONS OF PENETRATIONS.
F. PROTECT ALL EXISTING FINISHES, LANDINGS, STAIRS, HANDRAILS & GUARDRAILS DURING CONSTRUCTION.
G. CLEAN AND PAINT EXISTING PIPE & MECH. DUCTS AS REQUIRED.
H. THIS DRAWING IS TO BE READ IN CONJUNCTION WITH THE MECHANICAL & ELECTRICAL DRAWINGS.
I. WHERE DISSIMILAR COMPONENTS SUCH AS PUSH BUTTON AND KEY SWITCH ARE INTO FIRE RATED ASSEMBLIES, ENSURE CONTINUITY OF FIRE SEPARATIONS BY BOXING IN ELEMENTS WITH GYPSUM BOARD AND FRAMING TO SUIT AUTHORITIES JURISDICTION.
J. CONTRACTOR TO PATCH, REPAIR AND MAKE GOOD ALL AREAS DISTURBED BY THE OPERATION OF THE WORK AND DISTURBED BY THE WORK OF OTHER TRADES (MECH, ELEC, AV, ETC.). MATERIALS AND FINISHES TO MATCH EXISTING UNLESS NOTED OTHERWISE.
K. FILL NEW FLOOR OPENINGS WITH NON SHRINK GROUT. REFER TO MECH AND ELEC DWGS.
L. NEW BRYK WALL PARTITIONS AND EXISTING PARTITIONS WITHIN PROJECT C/W NEW BASE, NEW BASE TO BE ONE PRICE ON EACH SEGMENT OF WALL BOTH SIDES OF THE WALL. WALL TO SIT DIRECTLY ON FLOOR. REFER TO FINISH SCHEDULE.
M. PAINT WALLS & BULKHEADS IN AND CORRIDORS WITHIN PROJECT SCOPE. REFER TO FINISH SCHEDULE.

FLOOR PLAN LEGEND & SYMBOLS	
	GLAZING TYPE TAG
	WALL TYPE TAG
	WALL TYPE TAG (TO BE USED BY CONTRACTOR)
	SPOT ELEVATION (PROPOSED FLOOR ELEVATION DATUM)
	SPOT ELEVATION (EXISTING FLOOR ELEVATION DATUM)
	EXISTING WALL TO REMAIN
	NEW OR EXISTING RATED WALL TO BE MAINTAINED
	NEW NOTE REFERENCE TAG
	NCD PRIMARY SCOPE OF WORK
	SCOPE OF WORK
	SHELL SPACE - FIT OUT BY OTHERS
	MAKE GOOD EXISTING FLOOR
	EXIST. UNEXCAVATED SPACE
	DOOR TAG
	SPECIALTY EQUIPMENT TAG
	REPAIR SCOPE TAG (REFER TO A212A)

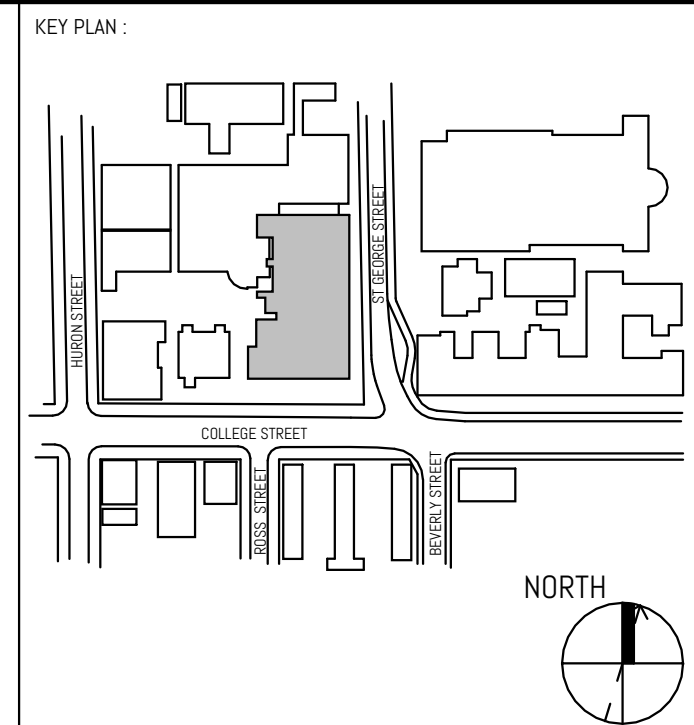

REVISION		
NO.	DATE	DESCRIPTION
1	10/20/2024	CLIENT REVIEW
2	10/20/2024	COSTING SET
3	10/20/2024	CLIENT REVIEW
4	11/01/2024	PROPOSED ISSUANCE
5	11/10/2024	BUILDING PERMIT
6	12/10/2024	PER REVIEW
7	01/20/2025	PER REVIEW
8	01/21/2025	ISSUED FOR BID
9	03/26/2025	BID ADDENDUM #4

ENFORM
architects
ENFORM Architects Inc.
1334 Brimley Road, Suite 3010
Toronto, Ontario, Canada M6R 2B7
Tel: 416-467-7523
www.enformarchitects.com



PROJECT:
UNIVERSITY OF TORONTO
HEALTH & WELLNESS CENTRE
AT KOFFLER RENOVATION

214 College Street, Toronto,
ON M5T 3A2.


SHEET CONTENTS:
ENLARGED GROUND FLOOR PLAN

PROJECT NUMBER:
23-011 (P143-19-100)

DRAWING SCALE:
1:50

DRAWN BY: NE
CHECKED BY: AF
DATE: 2025-03-31

SHEET NO:
A211

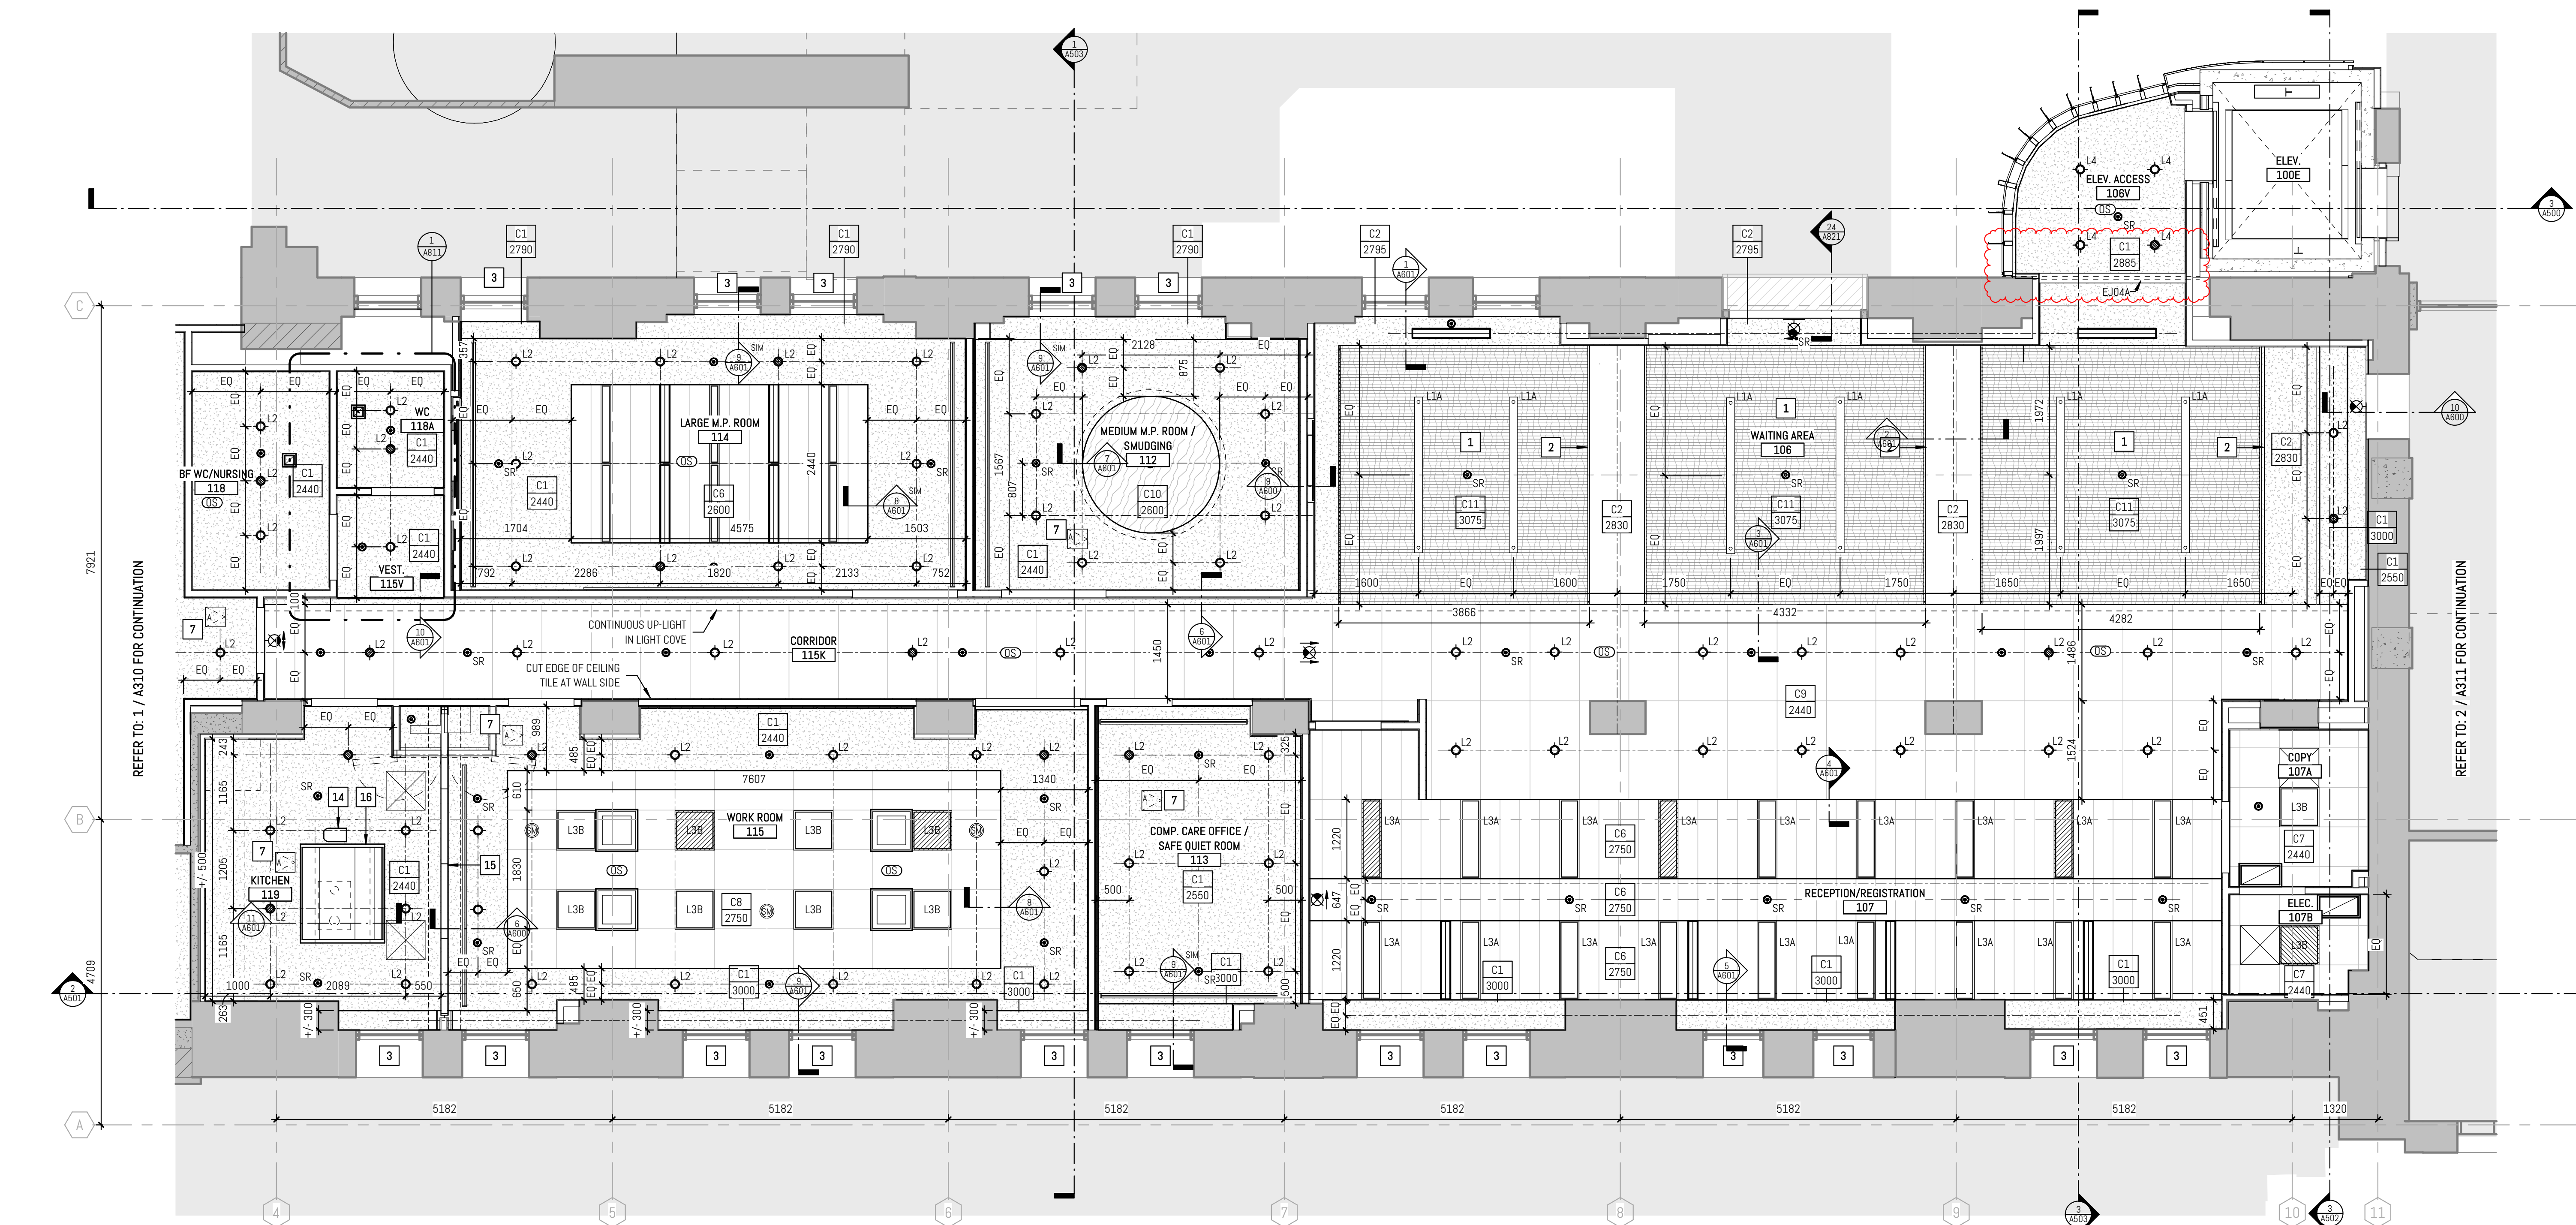

2 GROUND FLOOR ENLARGED REFLECTED CEILING PLAN - EAST
1:50 Ref: 21 A009



1 GROUND FLOOR ENLARGED REFLECTED CEILING PLAN - SOUTHEAST
1:50 Ref: 21 A009




9 EXISTING STAFF ROOM CEILING
1:1

NEW WORK - ENLARGED RCP NOTES	
NOTE	DESCRIPTION
1	ACOUSTIC WOOD PANEL CEILING - REFER TO DETAILS.
2	PATCH AND REPAIR EXISTING PLASTER BEAM AND MOULDING - PAINT TO MATCH EXISTING.
3	PROVIDE NEW MANUAL ROLLER SHADES.
4	PROVIDE NEW MOTORIZED ROLLER SHADES - REFER TO ELECTRICAL.
5	50A 305mm x 305mm, 80-457mm x 457mm ACCESS DOOR COORDINATE LOCATION WITH MECHANICAL ON SITE.
6	70A 305mm x 305mm, 70-457mm x 457mm RECESSED ACCESS DOOR TO RECEIVE GWB COORDINATE LOCATION WITH MECHANICAL ON SITE.
7	485mm x 485mm FIRE RATED ACCESS DOOR COORDINATE LOCATION WITH MECHANICAL ON SITE.
8	GENERAL NOTE (ALL FLOORS): EXISTING GWB AND PLASTER CEILINGS, BULKHEADS AND PLASTER FINISHED BEAMS TO RECEIVE NEW PAINT FINISH. REFER TO FINISHES SCHEDULE.
9	GENERAL NOTE (3RD FLOOR): APPLY NEW PAINT FINISH TO ALL EXPOSED ROOF STRUCTURE. REFER TO FINISHES SCHEDULE.
10	SEE NOTE 9 EXCEPT FINISHES TO MATCH EXISTING.
11	PATCH, REPAIR AND MAKE GOOD ALL AREAS DISTURBED BY THE OPERATION OF THE WORK TO RECEIVE PAINT TO MATCH EXISTING.
12	CAMERA OVER ISLAND, CEILING MOUNTED, ALIGN WITH BOTTOM OF RANGE HOOD. REFER TO ELECTRICAL AND AV.
13	TRACK: TEMPERED ALUMINUM OR STEEL TRACK SUPPORTED BY THREADED RODS, TO BE ENGINEERED BY CONTRACTOR.
14	TYPE 1 REDCIRCULATING HOOD COMPLETE WITH INTEGRAL FIRE SUPPRESSION SYSTEM. ALIGN EAST SIDE OF EXHAUST TO EDGE OF MILLWORK. REFER TO MECHANICAL DRAWINGS.
15	REINSTATE GWB CEILING FINISH AND ASSOCIATED FIXTURES TO MATCH EXISTING UPON COMPLETION OF STRUCTURAL WORK. REFER TO STRUCTURAL.
16	GENERAL NOTE FOR GROUND FLOOR AND 2ND LEVEL RCP: SUPPLY AND INSTALL NEW FIRE SPRAY SYSTEM TO THE UNDERSIDE OF EXISTING SLAB AND SUPPORTING STRUCTURE - CEILING TYPE EX-F1 (SOUTH OF GRID 11) AND CEILING TYPE EX-F2 (NORTH OF GRID 11).
17	GENERAL NOTE FOR THE THIRD LEVEL RCP (NORTH OF GRID 12): SUPPLY AND INSTALL NEW PAINT FINISH TO THE STEEL ROOF STRUCTURE AND GYPSUM SHEATHING BOARD.
18	SUPPLY AND INSTALL FIRE RATED ROLLER SHUTTER. REFER TO STRUCTURE AND ELECTRICAL.
19	EXISTING SKYLIGHT.
20	MAKE GOOD EXISTING GWB CEILING AND APPLY NEW PAINT FINISH.
21	STUDENT SUCCESS (RM 150) GENERAL NOTE: CORNICE AND CEILING AREAS UNDER REPAIR TO RECEIVE NEW PAINT FINISH TO MATCH EXISTING.
22	STAIR 11 GENERAL NOTE: EXISTING CEILINGS, UNDERSIDE OF STAIR LANDINGS AND STEP RUNS, BULKHEADS AND CORNICES TO RECEIVE NEW PAINT FINISH. REFER TO FINISHES SCHEDULE.

GENERAL NOTES - NEW WORK	
A	MAKE GOOD ALL EXISTING WALL SURFACES DAMAGED DURING REMOVALS AND CONSTRUCTION.
B	NEW FLOOR FINISHES: REFER TO FINISH SCHEDULE.
C	NEW DOOR & DOOR FRAME: REFER TO DOOR SCHEDULES.
D	PANT ALL EXISTING DOORS AND DOOR FRAMES.
E	PROVIDE FIRESTOPPING TO ALL NEW FLOOR SERVICE PENETRATIONS. REFER TO MECH AND ELEC DWGS FOR LOCATIONS OF PENETRATIONS.
F	PROTECT ALL EXISTING FINISHES, LANDINGS, STAIRS, HANDRAILS & GUARDRAILS DURING CONSTRUCTION.
G	CLEAN AND PAINT EXISTING PIPE & MECH. DUCTS AS REQUIRED.
H	THIS DRAWING IS TO BE READ IN CONJUNCTION WITH THE MECHANICAL & ELECTRICAL DRAWINGS.
I	WHERE DISSIMILAR COMPONENTS SUCH AS PUSH BUTTON AND KEY SWITCH ARE INTO FIRE RATED ASSEMBLIES, ENSURE CONTINUITY OF FIRE SEPARATIONS BY BONDING ELEMENTS WITH GYPSUM BOARD AND FRAMING TO SUIT AUTHORITIES JURISDICTION.
J	CONTRACTOR TO PATCH, REPAIR AND MAKE GOOD ALL AREAS DISTURBED BY THE OPERATION OF THE WORK AND DISTURBED BY THE WORK OF OTHER TRADES (MECH, ELEC, AV, & ETC.) MATERIALS AND FINISHES TO MATCH EXISTING UNLESS NOTED OTHERWISE.
K	FILL NEW FLOOR OPENINGS WITH NON SHRINK GROUT. REFER TO MECH AND ELEC DWGS.
L	NEW DRYWALL PARTITIONS AND EXISTING PARTITIONS WITHIN PROJECT C/W NEW BASE. NEW BASE TO BE ONE PIECE ON EACH SEGMENT OF WALL, BOTH SIDES OF THE WALL. WALL TO SIT DIRECTLY ON FLOOR. REFER TO FINISH SCHEDULE.
M	PANT WALLS AND BULKHEADS IN AND CORRIDORS WITHIN PROJECT SCOPE. REFER TO FINISH SCHEDULE.

RCP LEGEND & SYMBOLS

	CEILING MATERIAL TYPE		DIFFUSERS. SEE MECH. DWGS.
	CEILING HEIGHT		GRILLES. SEE MECH. DWGS.
	NEW ACT GRID		OCCUPANCY SENSOR. SEE ELEC. DWGS.
	NEW GWB CEILING		RECESSED LOUDSPEAKERS. SEE ELEC. & AV.
	SPRINKLER HEAD. SEE MECH. DWGS.		RECESSED SOUND MASKING SPEAKER. SEE ELEC. & AV.
	POTLIGHT FIXTURES. SEE ELEC. DWGS.		N/C PRIMARY SCOPE OF WORK
	PENDANT LIGHT FIXTURES. SEE ELEC. DWGS.		SCOPE OF WORK
	LINEAR LIGHT FIXTURES. SEE ELEC. DWGS.		EMERGENCY
	WALL-MOUNTED EXIT SIGN		1MR RATED BULKHEAD
	CEILING-MOUNTED EXIT SIGN		ACCESS PANEL

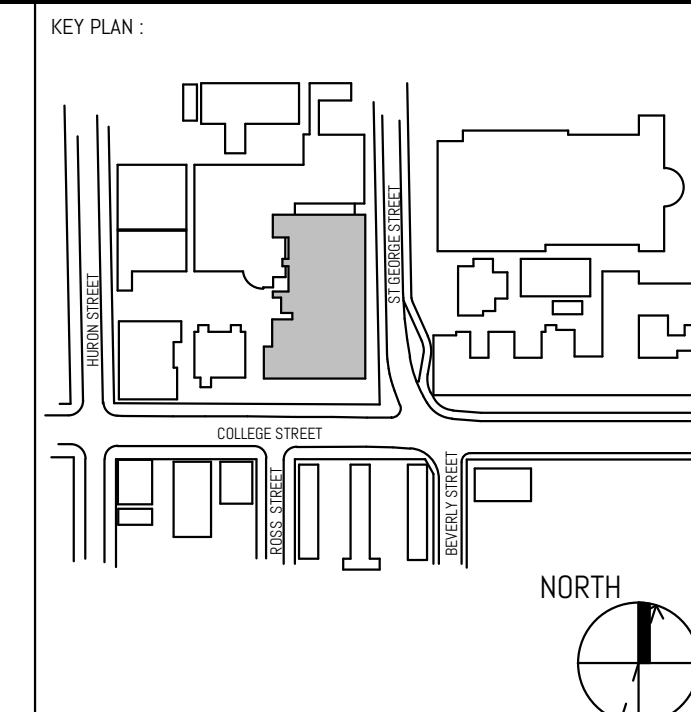

REVISION		
NO.	DATE	DESCRIPTION
1	08/20/2024	CLIENT REVIEW
2	09/20/2024	CUSTOMER SET
3	10/04/2024	CLIENT REVIEW
4	11/01/2024	PROPOSED ISSUES
5	11/15/2024	BUILDING PERMIT
6	12/10/2024	PBS REVIEW
7	01/26/2025	PEER REVIEW
8	01/31/2025	ISSUED FOR BID
9	02/26/2025	BID ADDENDUM #4

ENFORM
architects

ENFORM Architects Inc.
130A Bloor Street East, Suite 3000
Toronto, Ontario, Canada M4W 2B7
Tel: 416-597-7523
www.enformarchitects.com

SEAL



PROJECT:
**UNIVERSITY OF TORONTO
HEALTH & WELLNESS CENTRE
AT KOFFLER RENOVATION**

214 College Street, Toronto,
ON M5T 3A2

SHEET CONTENTS:
ENLARGED RCP - LEVEL 01

PROJECT NUMBER:
23-011 (P143-19-100)

DRAWING SCALE:
1:50


DRAWN BY:
NE

CHECKED BY:
AF


DATE:
2025-01-31

SHEET NO:
A310


9

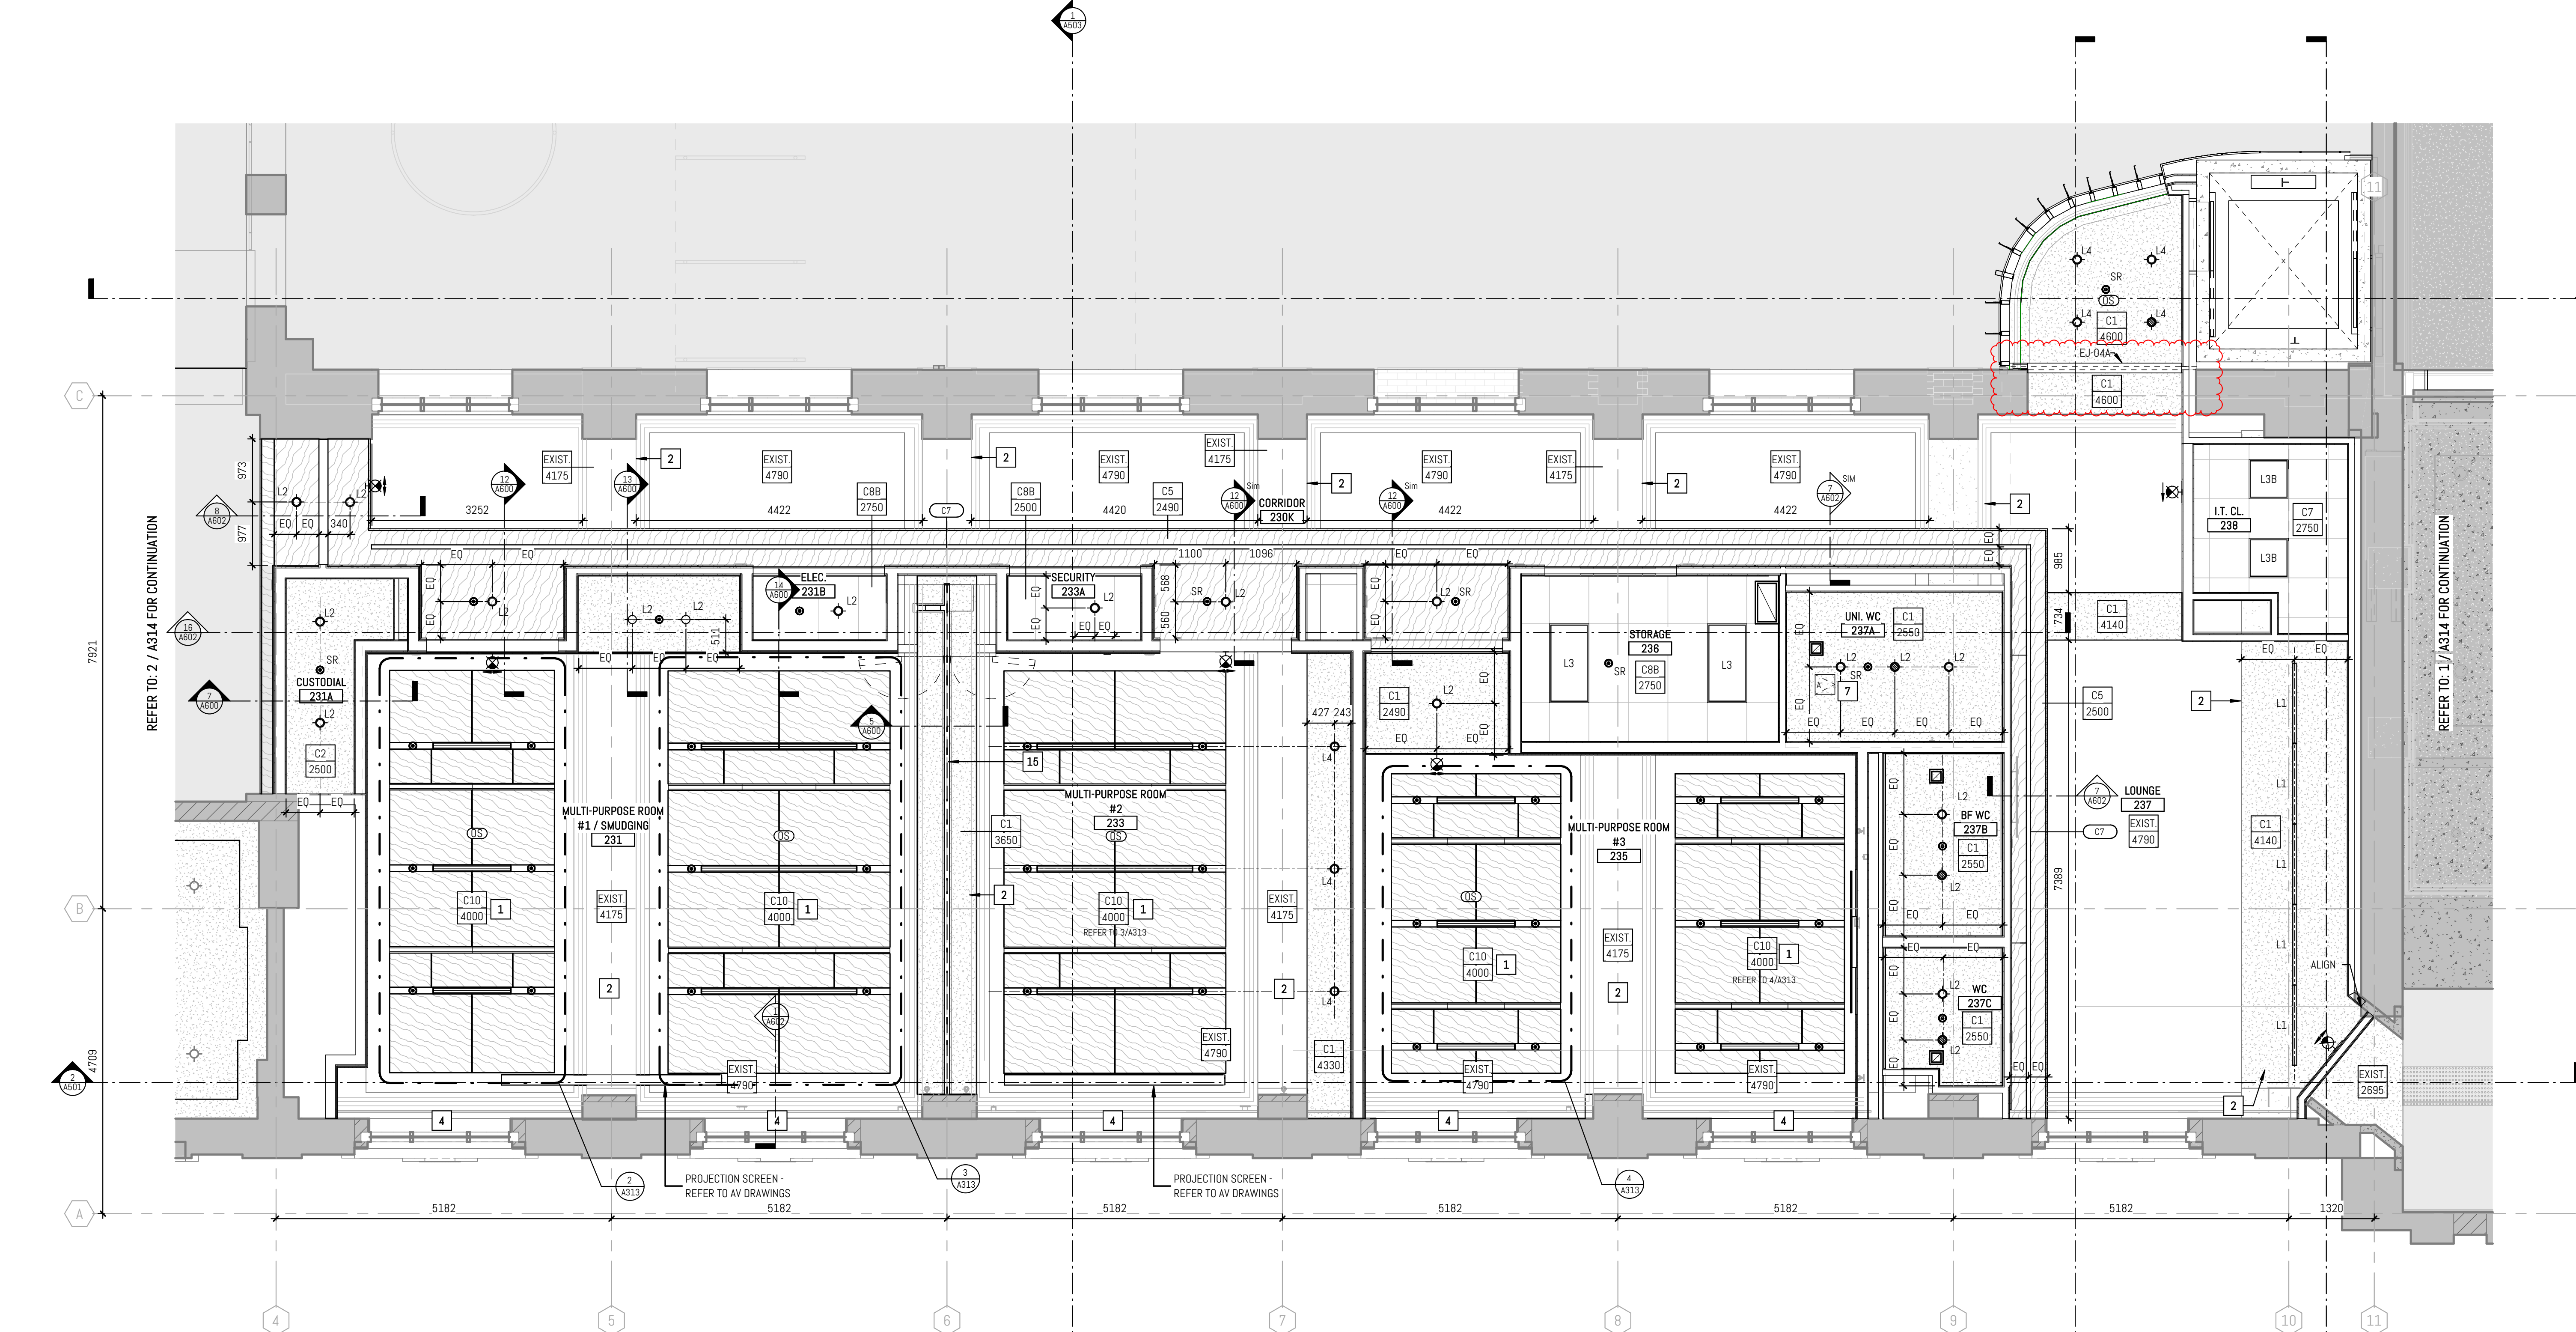


1 2ND FLOOR ENLARGED REFLECTED CEILING PLAN - EAST
A313 1:50
Rev. 1/1/2025

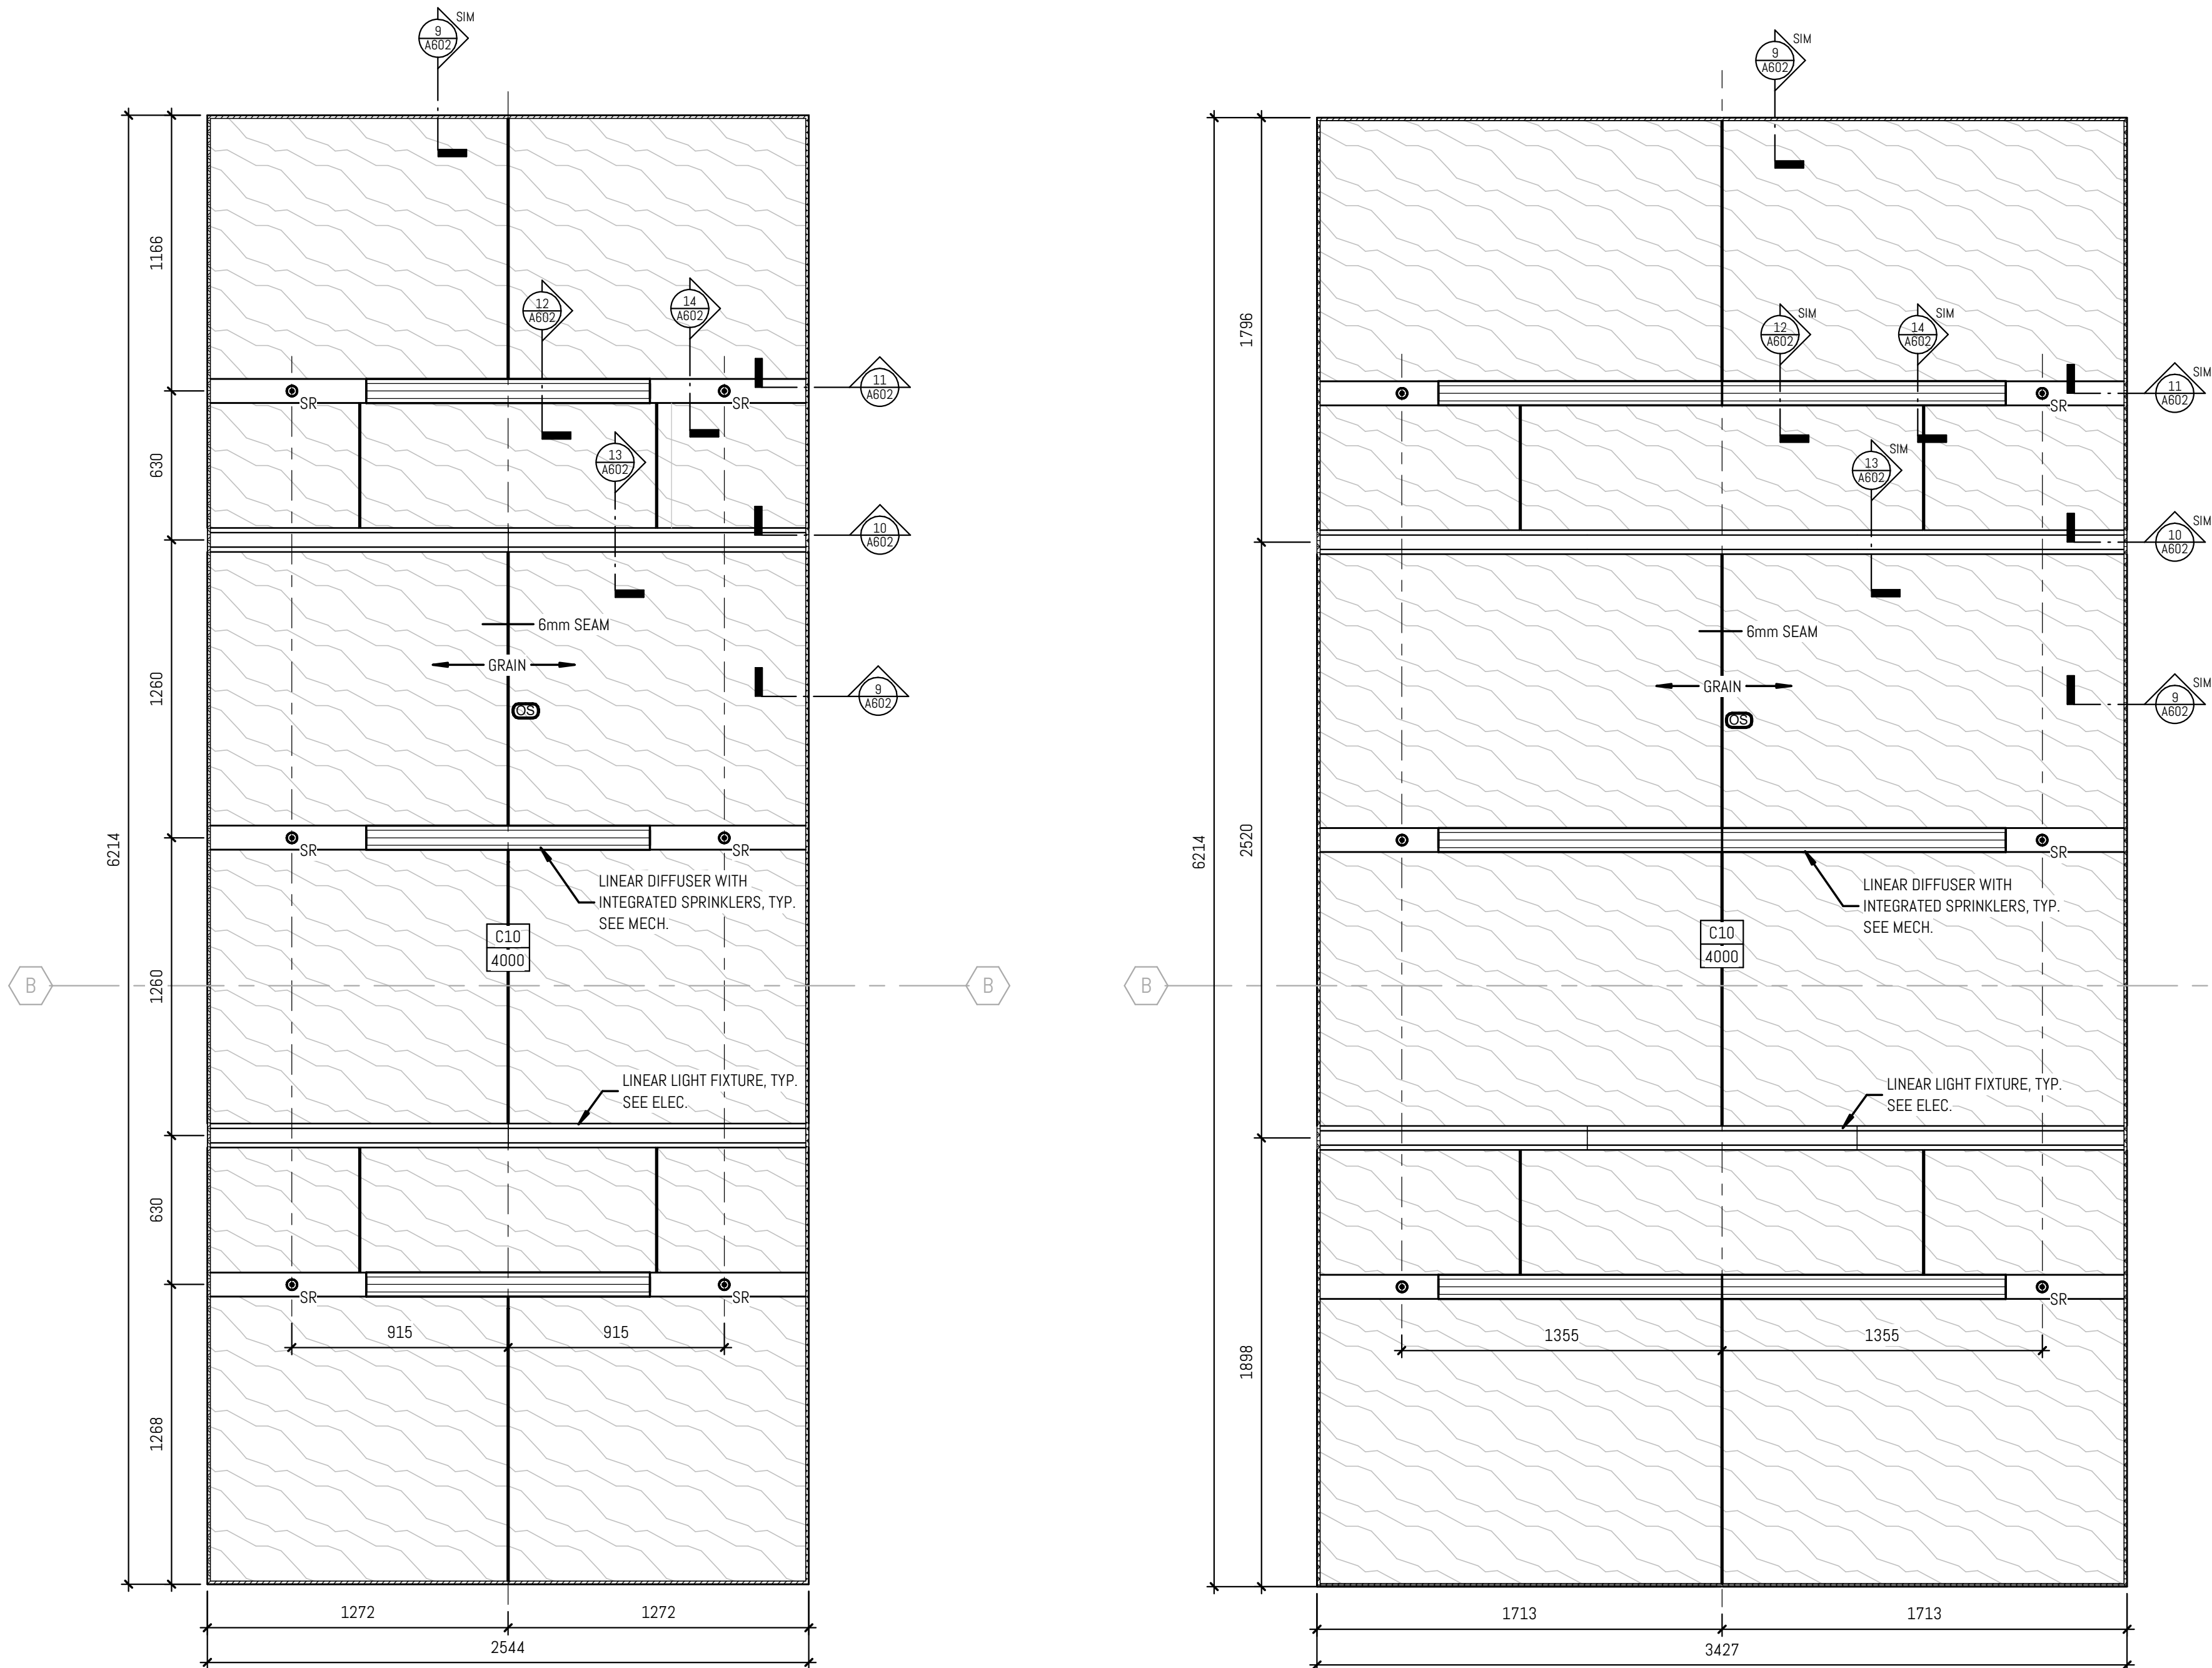

2 MULTI-PURPOSE ROOM #1 / SMUDGING - ENLARGED RCP
A313 1:20
Rev. 1/1/2025

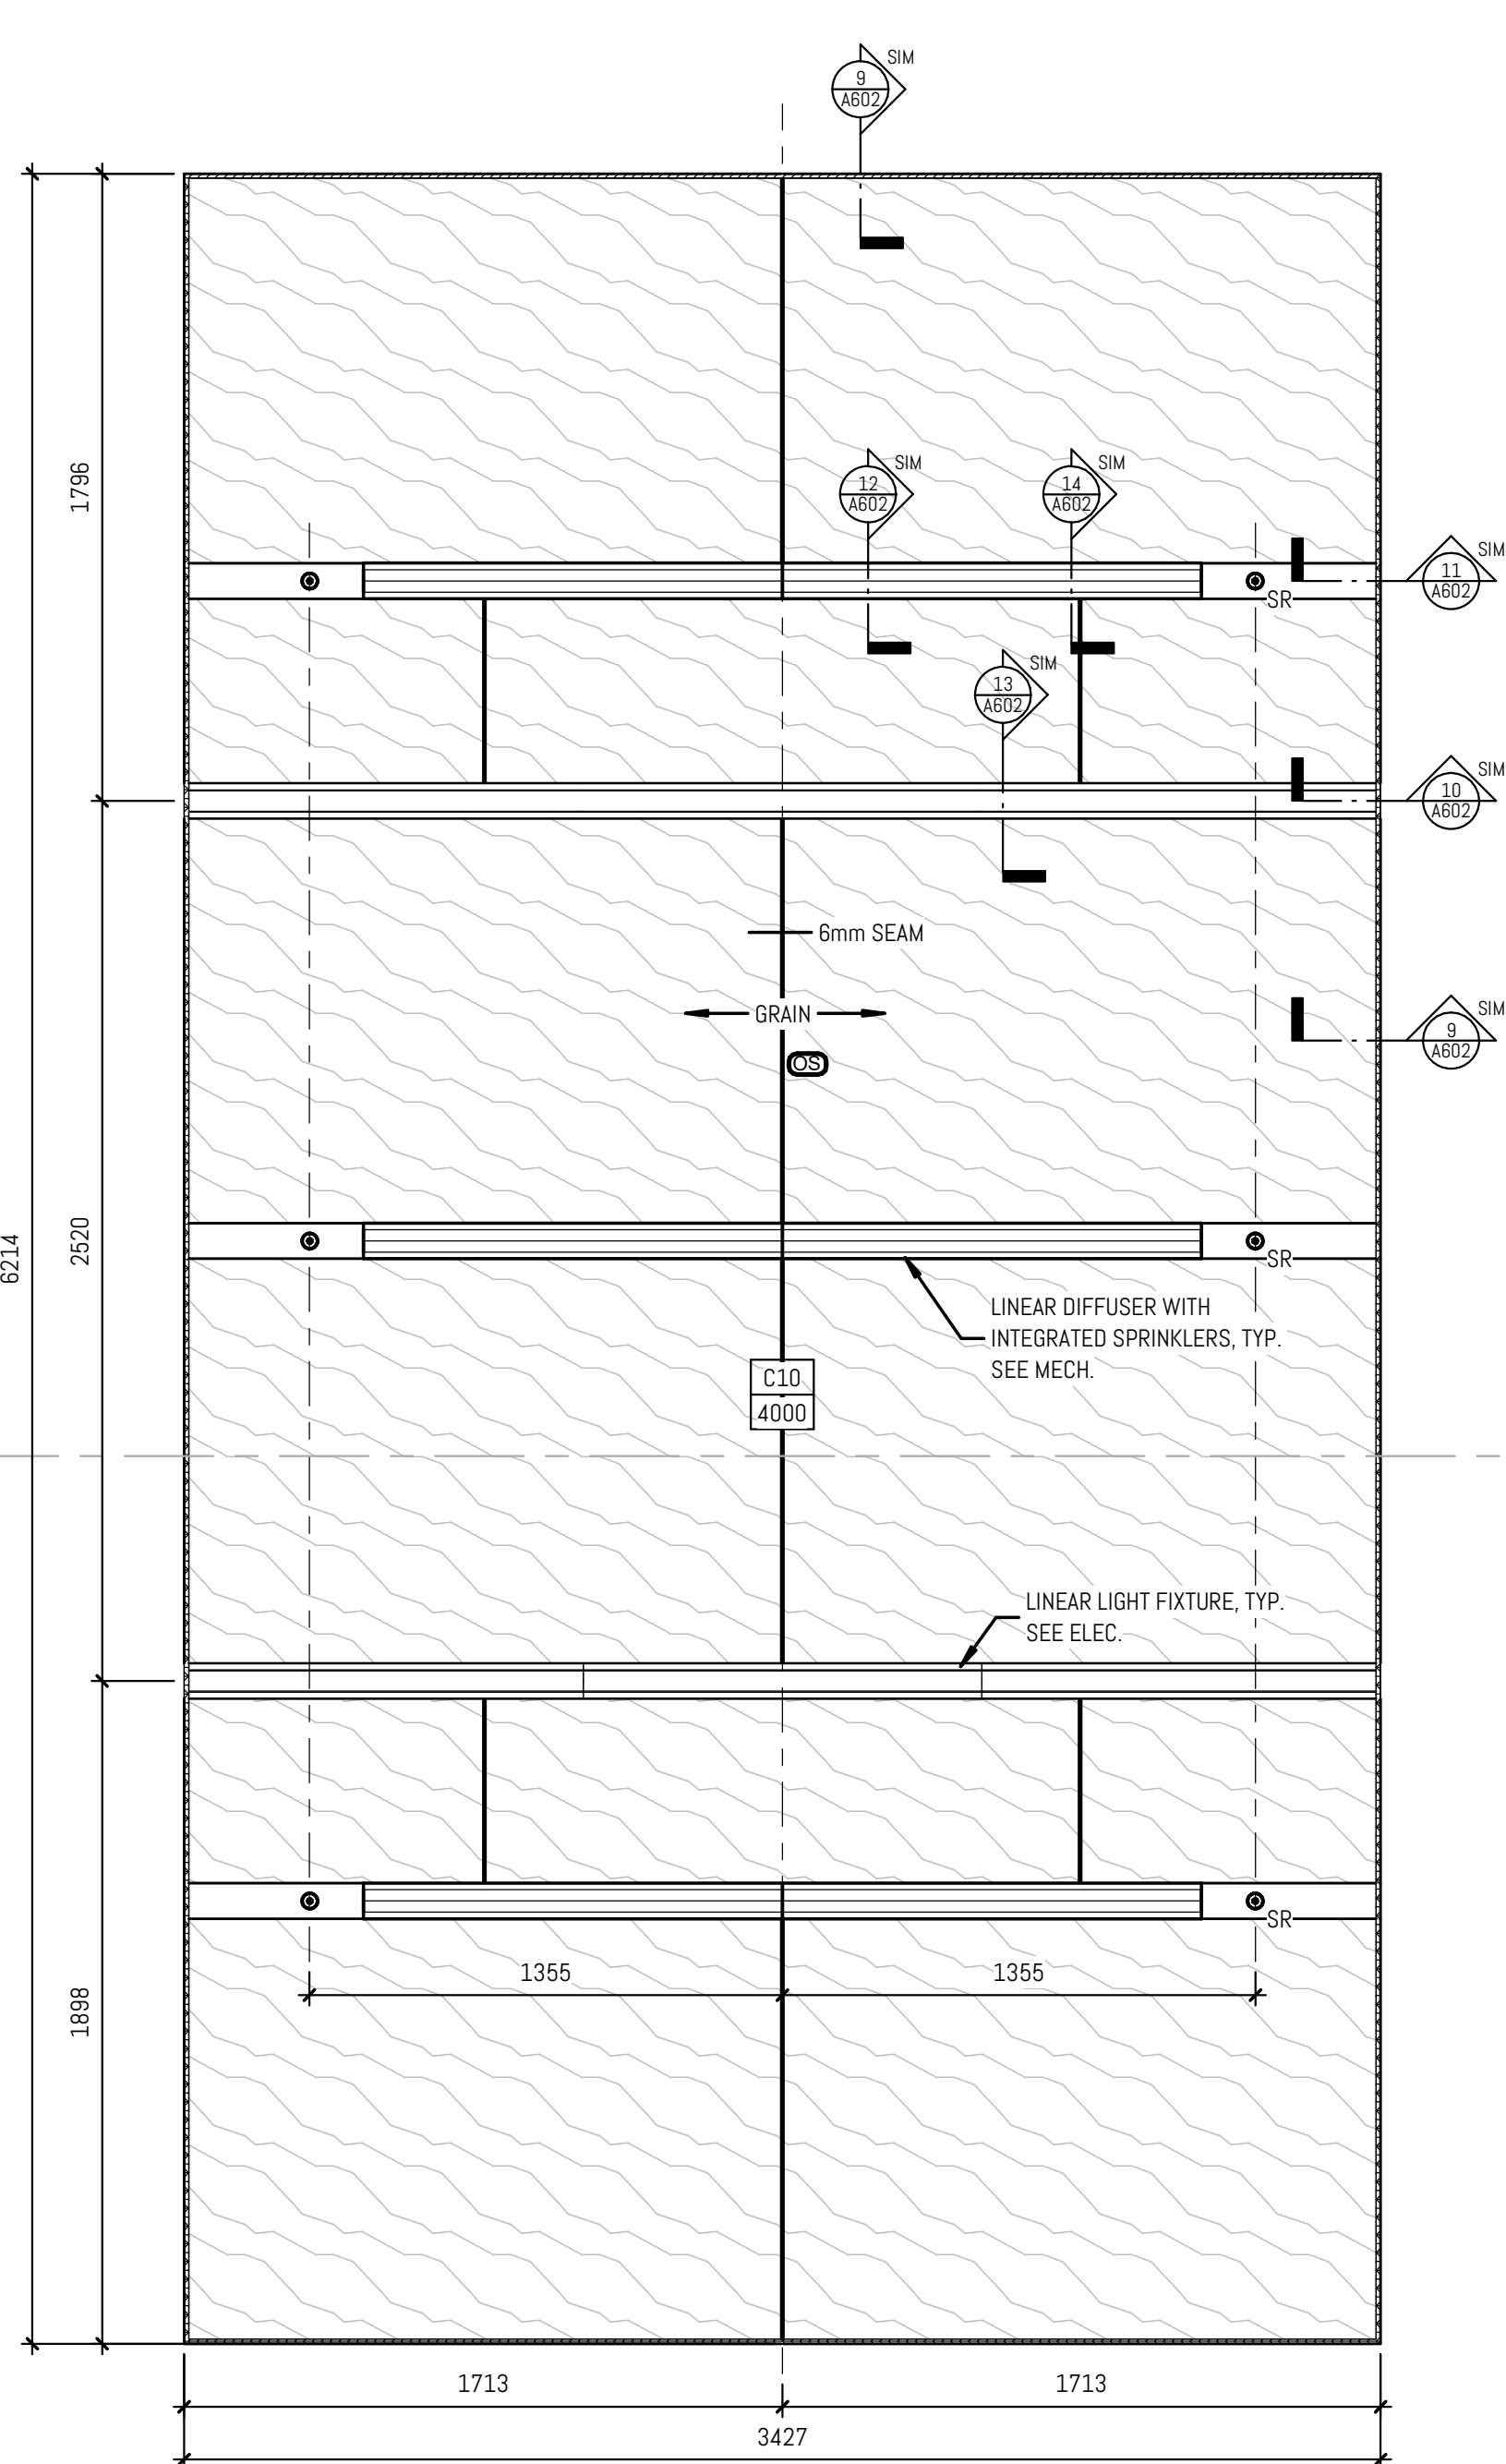

3 MULTI-PURPOSE ROOM #1/2 - ENLARGED RCP
A313 1:20
Rev. 1/1/2025

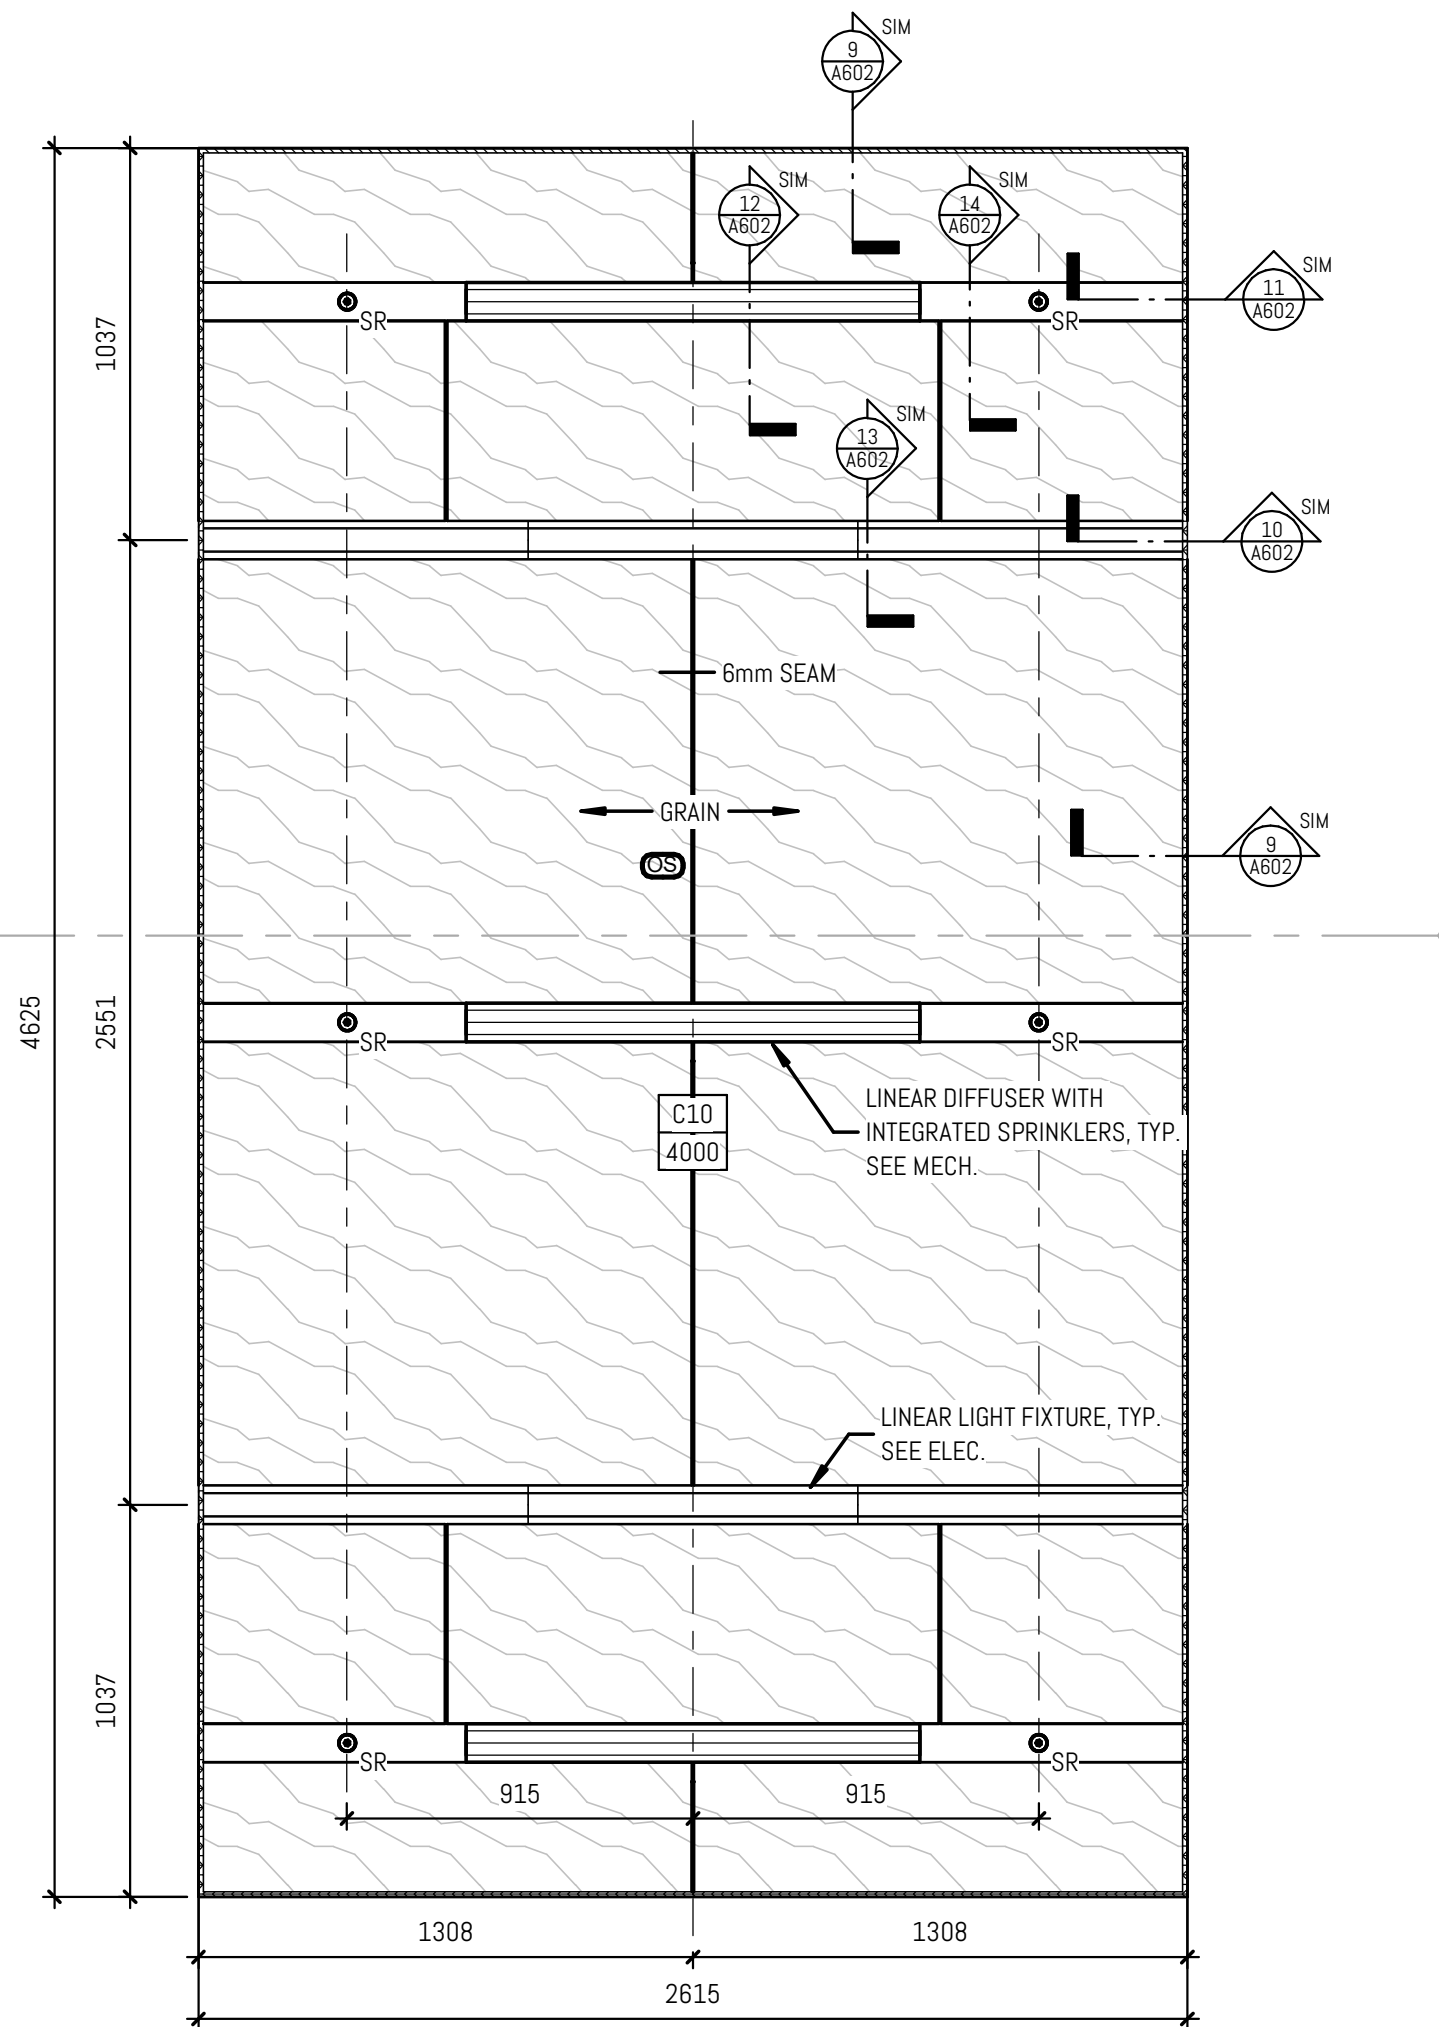


4 2ND FLOOR ENLARGED REFLECTED CEILING PLAN - EAST - ENLARGED RCP
A313 1:20
Rev. 1/1/2025

NEW WORK - ENLARGED RCP NOTES	
NOTE	DESCRIPTION
1	ACOUSTIC WOOD PANEL CEILING - REFER TO DETAILS.
2	PATCH AND REPAIR EXISTING PLASTER BEAM AND MOULDING. PAINT TO MATCH EXISTING.
3	PROVIDE NEW MANUAL ROLLER SHADES.
4	PROVIDE NEW MOTORIZED ROLLER SHADES. REFER TO ELECTRICAL.
6	7A-305mm x 305mm, 7B-457mm x 457mm ACCESS DOOR. COORDINATE LOCATION WITH MECHANICAL ON SITE.
7	7A-305mm x 305mm, 7B-457mm x 457mm RECESSED ACCESS DOOR TO RECEIVE GWB. COORDINATE LOCATION WITH MECHANICAL ON SITE.
8	480mm x 480mm FIRE RATED ACCESS DOOR. COORDINATE LOCATION WITH MECHANICAL ON SITE.
9	GENERAL NOTE (ALL FLOORS): EXISTING GWB AND PLASTER CEILINGS, BULKHEADS AND PLASTER FINISHED BEAMS TO RECEIVE NEW PAINT FINISH. REFER TO FINISHES SCHEDULE.
10	GENERAL NOTE (3RD FLOOR): APPLY NEW PAINT FINISH TO ALL EXPOSED ROOF STRUCTURE. REFER TO FINISHES SCHEDULE.
11	SEE NOTE 8 EXCEPT FINISHES TO MATCH EXISTING.
12	PATCH, REPAIR AND MAKE GOOD ALL AREAS DISTURBED BY THE OPERATION OF THE WORK TO RECEIVE PAINT TO MATCH EXISTING.
14	CAMERA OVER ISLAND, CEILING MOUNTED, ALIGN WITH BOTTOM OF RANGE WOOD. REFER TO ELECTRICAL AND AV.
15	TRACK, TEMPERED ALUMINUM OR STEEL TRACK SUPPORTED BY THREADED RODS. TO BE ENGINEERED BY CONTRACTOR.
16	TYPE 1 RECIRCULATING HOOD COMPLETE WITH INTEGRAL FIRE SUPPRESSION SYSTEM. ALIGN EAST SIDE OF EXHAUST TO EDGE OF MILLWORK. REFER TO MECHANICAL DRAWINGS.
17	REINSTATE GWB CEILING FINISH AND ASSOCIATED FIXTURES TO MATCH EXISTING UPON COMPLETION OF STRUCTURAL WORK. REFER TO STRUCTURAL.
18	GENERAL NOTE FOR GROUND FLOOR AND 2ND LEVEL RCP: SUPPLY AND INSTALL NEW FIRE SPRAY SYSTEM TO THE UNDERSIDE OF EXISTING SLAB AND SUPPORTING STRUCTURE - CEILING TYPE EX-F1 (SOUTH OF GRID 11) AND CEILING TYPE EX-F2 (NORTH OF GRID 11).
19	GENERAL NOTE FOR THE THIRD LEVEL RCP (NORTH OF GRID 12): SUPPLY AND INSTALL NEW PAINT FINISH TO THE STEEL ROOF STRUCTURE AND GYPSUM SHEATHING BOARD.
20	SUPPLY AND INSTALL FIRE RATED ROLLER SHUTTER. REFER TO STRUCTURE AND ELECTRICAL.
21	EXISTING SKYLIGHT.
23	MAKE GOOD EXISTING GWB CEILING AND APPLY NEW PAINT FINISH.
25	STUDENT SUCCESS (RM. 150) GENERAL NOTE: CORNICE AND CEILING AREAS UNDER REPAIR TO RECEIVE NEW PAINT FINISH TO MATCH EXISTING.
26	STAIR 13 GENERAL NOTE: EXISTING CEILINGS, UNDERSIDE OF STAIR LANDINGS AND STEP RUNS, BULKHEADS AND CORNICES TO RECEIVE NEW PAINT FINISH. REFER TO FINISHES SCHEDULE.


GENERAL NOTES - NEW WORK	
A	MAKE GOOD ALL EXISTING WALL SURFACES DAMAGED DURING REMOVALS AND CONSTRUCTION.
B	NEW FLOOR FINISHES. REFER TO FINISH SCHEDULE.
C	NEW DOOR & DOOR FRAME. REFER TO DOOR SCHEDULES.
D	PANT ALL EXISTING DOORS AND DOOR FRAMES.
E	PROVIDE FIRESTOPPING TO ALL NEW FLOOR SERVICE PENETRATIONS. REFER TO MECH AND ELEC DWGS FOR LOCATIONS OF PENETRATIONS.
F	PROTECT ALL EXISTING FINISHES, LANDINGS, STAIRS, HANDRAILS & GUARDRAILS DURING CONSTRUCTION.
G	CLEAN AND PAINT EXISTING PIPE & MECH. DUCTS AS REQUIRED.
H	THIS DRAWING IS TO BE READ IN CONJUNCTION WITH THE MECHANICAL & ELECTRICAL DRAWINGS.
I	WHERE DISSIMILAR COMPONENTS SUCH AS PUSH BUTTON AND KEY SWITCH ARE INTO FIRE RATED ASSEMBLIES, ENSURE CONTINUITY OF FIRE SEPARATIONS BY BONDING ELEMENTS WITH GYPSUM BOARD AND FRAMING TO SUIT AUTHORITIES JURISDICTION.
J	CONTRACTOR TO PATCH, REPAIR AND MAKE GOOD ALL AREAS DISTURBED BY THE OPERATION OF THE WORK AND DISTURBED BY THE WORK OF OTHER TRADES (MECH, ELEC, AV, & ETC.) MATERIALS AND FINISHES TO MATCH EXISTING UNLESS NOTED OTHERWISE.
K	FILL NEW FLOOR OPENINGS WITH NON SHRINK GROUT. REFER TO MECH AND ELEC DWGS.
L	NEW DRYWALL PARTITIONS AND EXISTING PARTITIONS WITHIN PROJECT C/W NEW BASE. NEW BASE TO BE ONE PIECE ON EACH SEGMENT OF WALL, BOTH SIDES OF THE WALL. WALL TO SIT DIRECTLY ON FLOOR. REFER TO FINISH SCHEDULE.
M	PANT WALLS AND BULKHEADS IN AND CORRIDORS WITHIN PROJECT SCOPE. REFER TO FINISH SCHEDULE.

RCP LEGEND & SYMBOLS

	CEILING MATERIAL TYPE		DIFFUSERS. SEE MECH. DWGS.
	CEILING HEIGHT		GRILLES. SEE MECH. DWGS.
	NEW ACT GRID		OCCUPANCY SENSOR. SEE ELEC. DWGS.
	NEW GWB CEILING		RECESSED LOUDSPEAKERS. SEE ELEC. & AV.
	SPRINKLER HEAD. SEE MECH. DWGS.		RECESSED SOUND MASKING SPEAKER. SEE ELEC. & AV.
	POTLIGHT FIXTURES. SEE ELEC. DWGS.		N.I.C. PRIMARY SCOPE OF WORK.
	PENDANT LIGHT FIXTURES. SEE ELEC. DWGS.		SCOPE OF WORK.
	LINEAR LIGHT FIXTURES. SEE ELEC. DWGS.		EMERGENCY.
	WALL MOUNTED EXIT SIGN		1HR RATED BULKHEAD.
	CEILING MOUNTED EXIT SIGN		ACCESS PANEL.

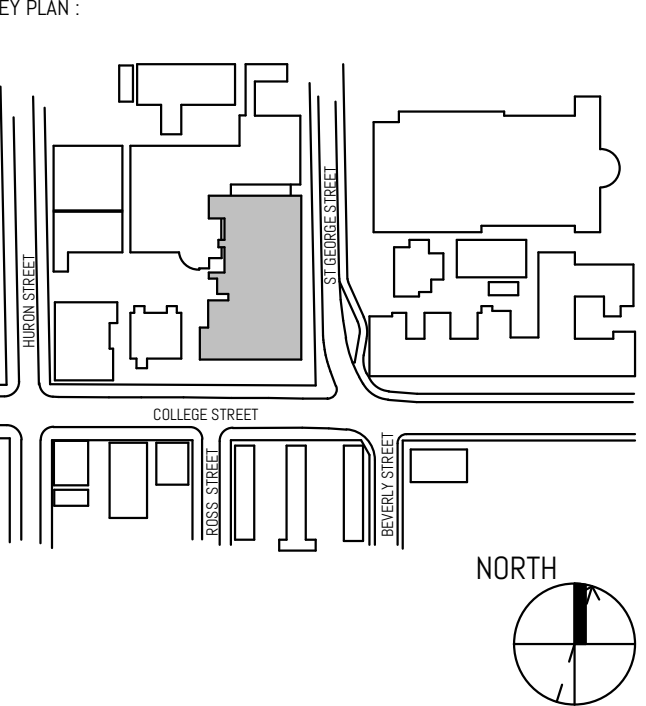

REVISION		
NO.	DATE	DESCRIPTION
1	08/20/2024	CLIENT REVIEW
2	09/20/2024	CUSTOMER SET
3	10/04/2024	CLIENT REVIEW
4	11/01/2024	PROPOSED ISSUES
5	11/15/2024	BUILDING PERMIT
6	12/10/2024	PBS REVIEW
7	01/20/2025	PBS REVIEW
8	01/11/2025	ISSUED FOR BID
9	02/20/2025	BID ADDENDUM #3
10	02/20/2025	BID ADDENDUM #4

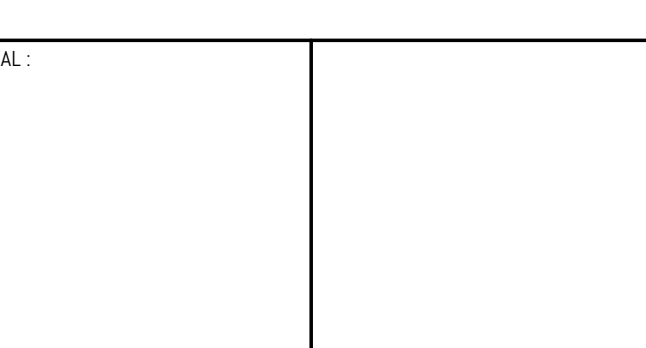

PROJECT: UNIVERSITY OF TORONTO HEALTH & WELLNESS CENTRE AT KOFFLER RENOVATION

214 College Street, Toronto, ON M5T 3A2


SHEET CONTENTS: ENLARGED RCP - LEVEL 02

PROJECT NUMBER: 23-011 (P143-19-100)

DRAWING SCALE: 1:50

DRAWN BY: NE CHECKED BY: AF DATE: 2025-01-31

SHEET NO: A313


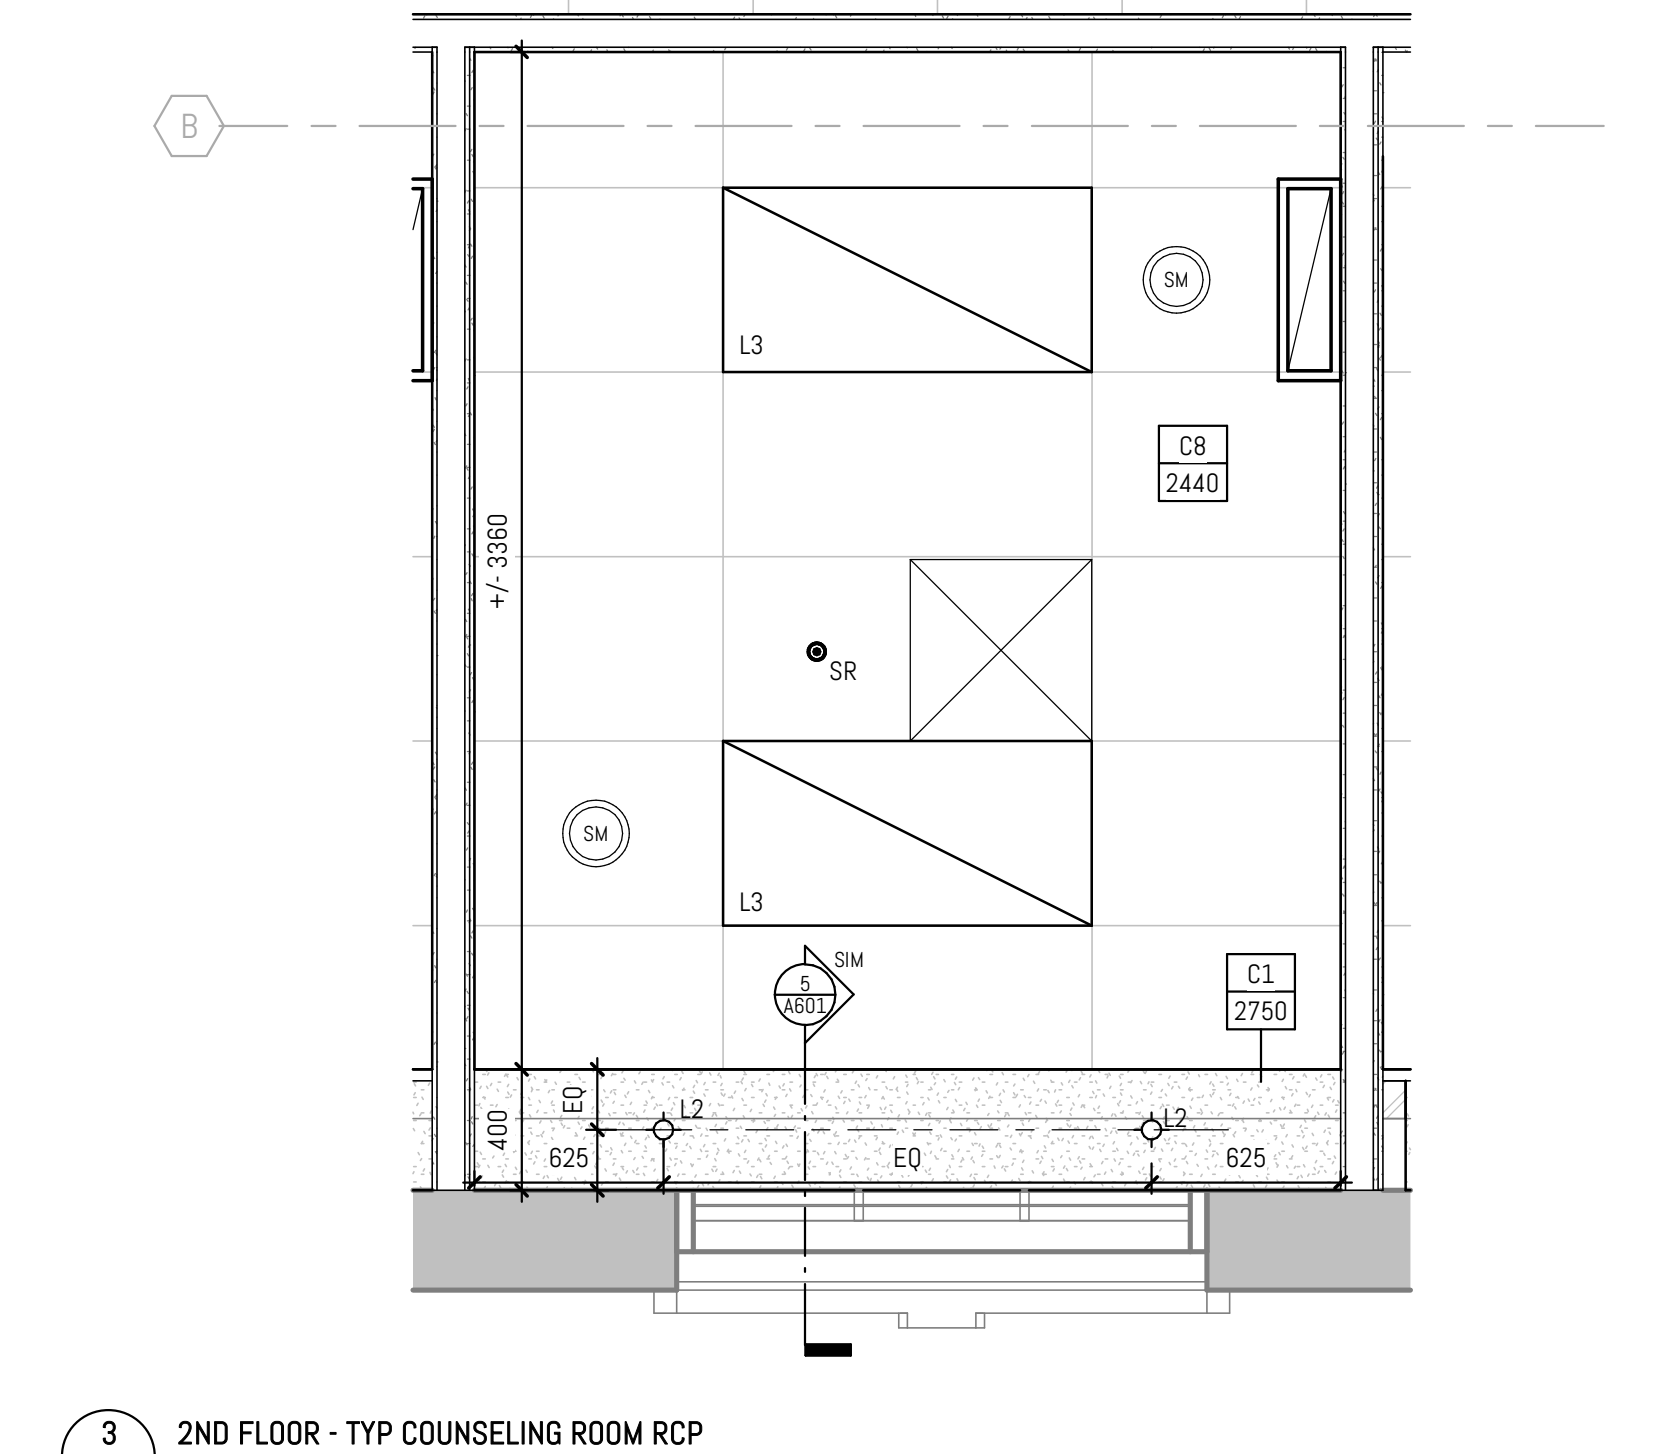

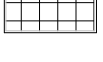
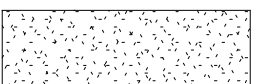










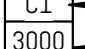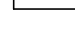


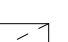



NEW WORK - ENLARGED RCP NOTES	
NOTE	DESCRIPTION
1	ACQUISITW DOWD PANEL CEILING - REFER TO DETAILS
2	PATCH AND REPAIR EXISTING PLASTER BOARD AND MOULDING. PATCH TO MATCH EXISTING.
3	PROVIDE NEW MANUAL ROLLER SHADES.
4	PROVIDE NEW MOTORIZED ROLLER SHADES. REFER TO ELECTRICAL.
5	64-305mm x 305mm, 76-457mm x 457mm ACCESS DOOR. COORDINATE LOCATION WITH MECHANICAL ON SITE.
6	76-305mm x 305mm, 76-457mm x 457mm RECESS ACCESS DOOR TO RECEIVE GWS. COORDINATE LOCATION WITH MECHANICAL ON SITE.
7	ACQUISITW 450mm FIRE RATED ACCESS DOOR. COORDINATE LOCATION WITH MECHANICAL ON SITE.
8	GENERAL NOTE: (ALL FLOORS) EXISTING GWS AND PLASTER CEILING, BULKHEADS AND PLASTER FINISHES ARE TO BE RECEIVED NEW PANT FINISH. REFER TO FINISHES SCHEDULE.
9	GENERAL NOTE (3RD FLOOR): APPLY NEW PANT FINISH TO ALL EXPOSED ROOF STRUCTURE. REFER TO FINISHES SCHEDULE.
10	GENERAL NOTE 9 EXCEPT FINISHES TO MATCH EXISTING.
11	PATCH, REPAIR AND MAKE GOOD ALL AREAS DISTURBED BY THE OPERATION OF THE WORK TO RECEIVE PATCH TO MATCH EXISTING.
12	CARPORT OVER ISLAND, CEILING MOUNTED, ALIGN WITH BOTTOM OF RANGE HOOD. REFER TO ELECTRICAL AND AIA.
13	TRUCK, TEMPERED ALUMINUM OR STEEL, TRUCK SUPPORTED BY THREADED RODS. TO BE ENGINEERED BY CONTRACTOR.
14	TYPE 1 RECYCLATING HOOD COMPLETE WITH INTEGRAL FIRE SUPPRESSION SYSTEM, ALIGN EAST SIDE OF EXHAUST TO EDGE OF MILLWORK. REFER TO MECHANICAL DRAWINGS.
15	REMOVE EXISTING FINISHES AND ASSOCIATED FIXTURES TO MATCH EXISTING UPON COMPLETION OF STRUCTURAL WORK. REFER TO STRUCTURAL.
16	GENERAL NOTE: FOR GROUND FLOOR AND 2ND LEVEL RCP: SUPPLY AND INSTALL NEW FIRE SPRAY SYSTEM TO THE UNDERSIDE OF EXISTING SLAB AND SUPPORTING STRUCTURE - CEILING TYPE EX-F1 (SOUTH OF GRID 11) AND CEILING TYPE EX-F2 (NORTH OF GRID 11).
17	GENERAL NOTE: FOR THE THIRD LEVEL RCP (NORTH OF GRID 12) SUPPLY AND INSTALL NEW PANT FINISH TO THE STEEL ROOF STRUCTURE AND GYPSSUM SHEATHING BOARD.
18	SUPPLY AND INSTALL FIRE RATED ROLLER SHUTTER. REFER TO STRUCTURAL AND ELECTRICAL.
19	EXISTING SKYLIGHT
20	MAKE GOOD EXISTING GWS CEILING AND APPLY NEW PANT FINISH.
21	STUDENT SUCCESS (Rm. 150) GENERAL NOTE: CORNICE AND CEILING AREAS UNDER PANT TO RECEIVE NEW PANT TO MATCH EXISTING.
22	STAIR 1 GENERAL NOTE: EXISTING CEILING, UNDERSIDE OF STAIR LANDINGS AND STAIR RUNS, BULKHEADS AND CORNICES TO RECEIVE NEW PANT FINISH. REFER TO FINISHES SCHEDULE.

GENERAL NOTES: NEW WORK


- A. MAKE GOOD ALL EXISTING WALL STRUCTURES DAMAGED DURING REMOVALS AND CONSTRUCTION
- B. NEW FLOOR FINISHES: REFER TO FINISH SCHEDULE
- C. NEW DOOR & DOOR FRAME: REFER TO DOOR SCHEDULES
- D. PAINT ALL EXISTING SURFACES TO SPECIFICATIONS
- E. PROVIDE FIRSTINGS TO ALLOW NEW FLOOR FINISH PENETRATIONS, REFER TO FINISH SCHEDULES FOR LOCATIONS OF PENETRATIONS
- F. PAINT ALL EXISTING FINISHES: LAMINOS, STAIN, HANDRAILS & GUARDRAILS DURING CONSTRUCTION
- G. CLEAN AND PAINT EXISTING PIPE & MISC. OUTLETS AS REQUIRED
- H. THE DRAWING SET IS TO BE IN CONJUNCTION WITH THE MECHANICAL & ELECTRICAL DRAWINGS
- I. WHERE DISJUNCTAR COMPONENTS SUCH AS PUSH-BUTTONS AND KEY SWITCH ARE NOT SHOWN ON THE DRAWING SET, THE CONTRACTOR SHALL BE RESPONSIBLE FOR THE BUYING IN COMPLIANCE WITH CYPRIAN BOARD AND FRAMING TO SUSTAIN AUTHORITIES JURISDICTION
- J. CONTRACTOR TO PATCH, REPAIR AND MAKE GOOD ALL AREAS DISTURBED BY THE OPERATION OF THE WORK AND DISTURBED BY THE WORK OF OTHER TRADES (MISC. ELECT. W/ & G) MATERIALS AND FINISHES TO MATCH EXISTING
- K. CONTRACTOR TO PATCH, REPAIR AND MAKE GOOD ALL AREAS DISTURBED BY THE FILL NEW FLOOR OPENINGS WITH NON SHRINK GROUT. REFER TO MECHANICAL AND ELEC DWGS
- L. NEW WALL PARTITIONS AND EXISTING PARTITIONS WITH PROJECT W/ALC NEW BASE- LINE SHALL BE TO BE ONE PCE ON EACH SEGMENT OF WALL, BOTH SIDES OF THE WALL. WALL TO SET TO DIRECTLY ON FLOOR TO REFER TO FINISH SCHEDULE
- M. PAINT WALLS AND BULKHEADS IN AREAS AND CORRIDORS WITH PROJECT SPEC. REFER TO FINISH SCHEDULE

RCP LEGEND & SYMBOLS


	CEILING MATERIAL TYPE CEILING HEIGHT		DIFFUSERS. SEE MECH. DWGS.
	NEW ACT GRID		GRILLES. SEE MECH. DWGS.
	NEW GWB CEILING		OCCUPANCY SENSOR. SEE ELEC. DWGS.
	SPRINKLER HEAD. SEE MECH. DWGS.		RECESSED LOUDSPEAKERS. SEE ELEC. & AV
	POTLIGHT FIXTURES. SEE ELEC. DWGS.		RECESSED SOUND MASKING SPEAKER SEE ELEC. & AV.
	PENDANT LIGHT FIXTURES. SEE ELEC. DWGS.		N.I.C. PRIMARY SCOPE OF WORK
	LINEAR LIGHT FIXTURES. SEE ELEC. DWGS.		SCOPE OF WORK
	WALL MOUNTED EXIT SIGN		EMERGENCY
	CEILING MOUNTED EXIT SIGN		1HR RATED BULKHEAD
			ACCESS PANEL

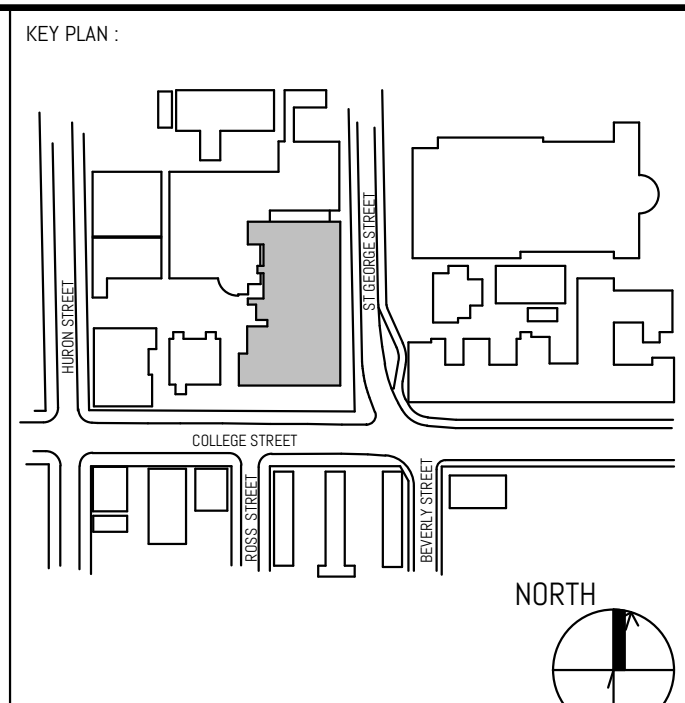

REVISION		
NO.	DATE	DESCRIPTION
1	08/20/2024	CLIENT REVIEW
2	08/30/2024	COSTING SET
3	10/04/2024	CLIENT REVIEW
4	11/01/2024	PROGRESS ISSUANCE
5	11/19/2024	BUILDING PERMIT
6	12/13/2024	FBS REVIEW
7	01/25/2025	PEER REVIEW
8	01/31/2025	ISSUED FOR BID
9	03/25/2025	BID ADDENDUM #4

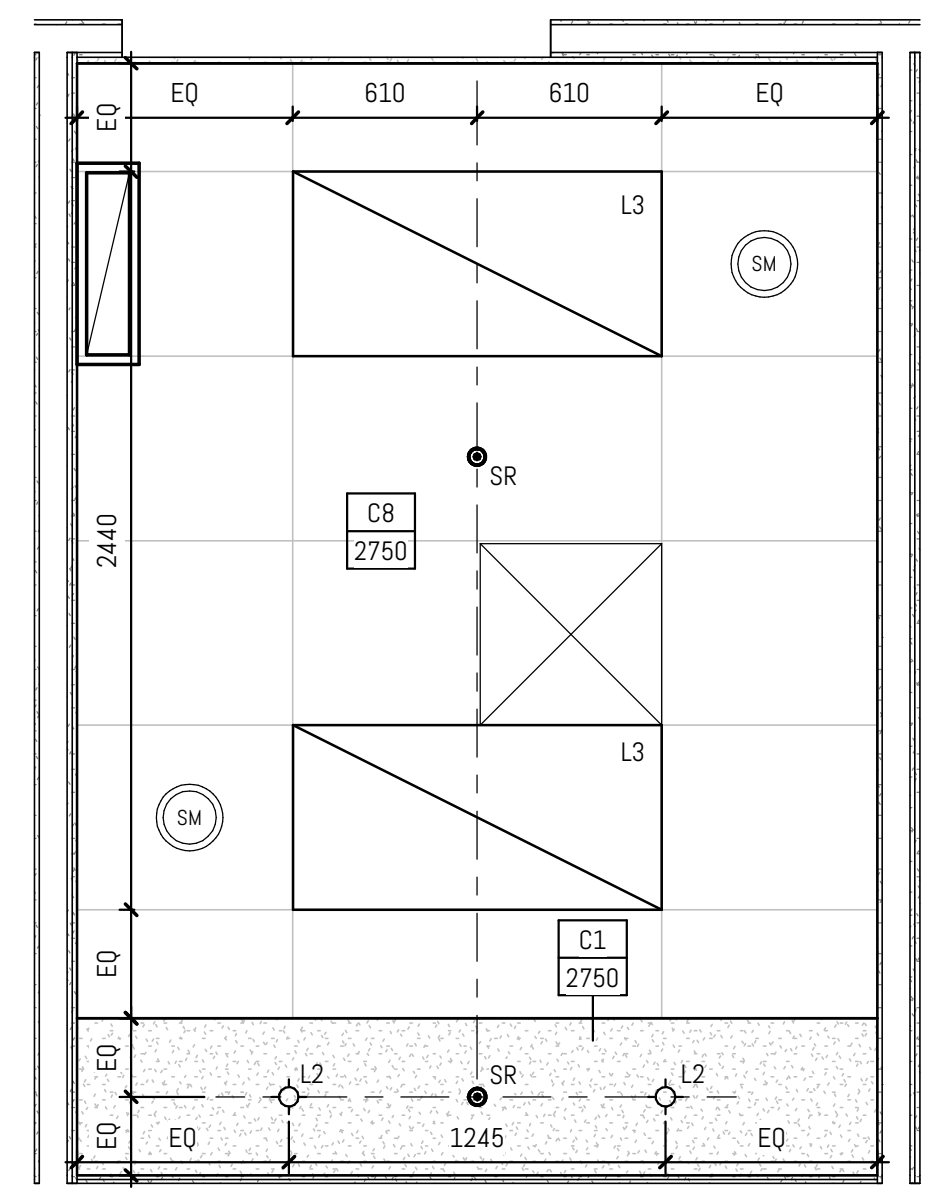



3 LEVEL 03 - TYPICAL COUNS. F
A316 1:25 Ref. 1/ A316

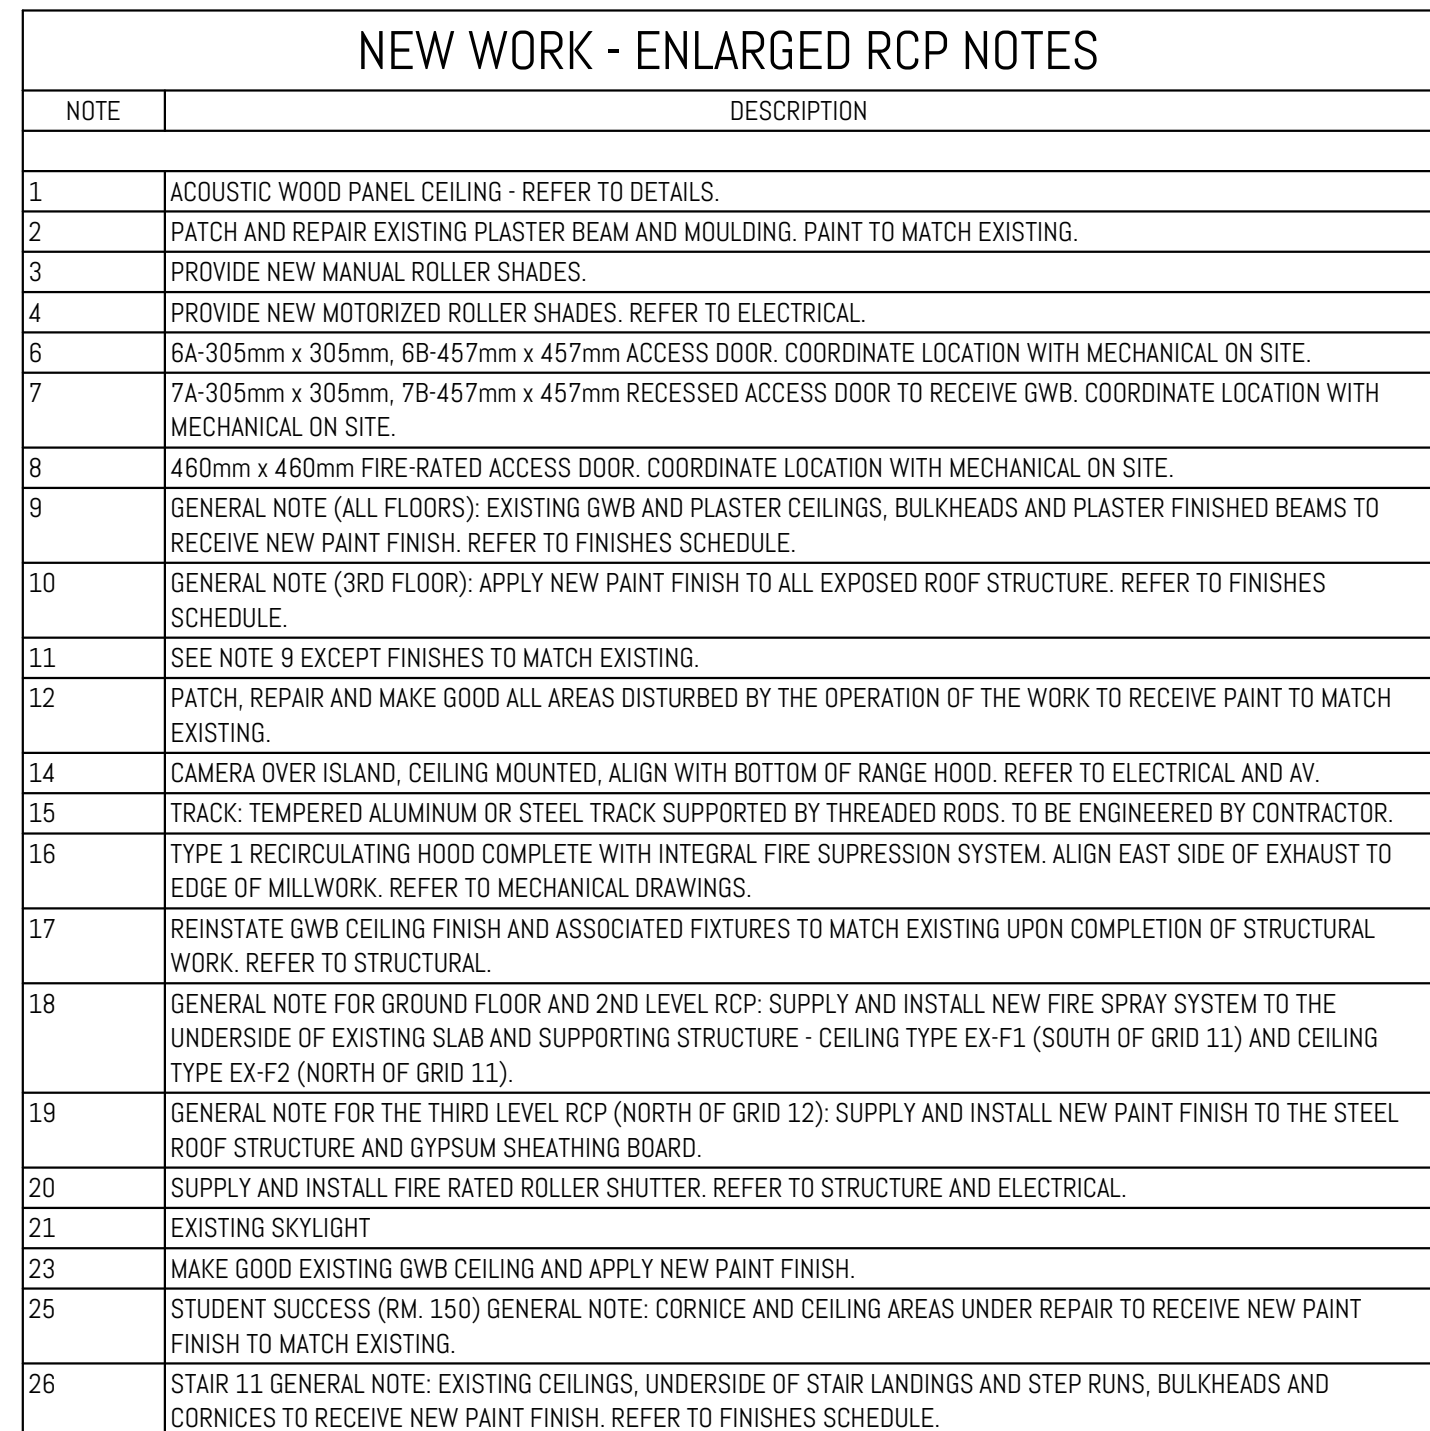


GENERAL NOTES: NEW WORK

- A. MAKE GOOD ALL EXISTING WALL SURFACES DAMAGED DURING REMOVALS AND CONSTRUCTION
- B. NEW FLOOR FINISHES. REFER TO FINISH SCHEDULE
- C. NEW DOOR & DOOR FRAME. REFER TO DOOR SCHEDULES
- D. PAINT ALL EXISTING DOORS AND DOOR FRAMES
- E. PROVIDE FINISHES TO ALL WALLS AND CEILING SURFACES PENETRATIONS. REFER TO MECH AND ELEC DGS FOR LOCATIONS OF PENETRATIONS
- F. PROTECT ALL EXISTING FINISHES, LANDINGS, STAIRS, HANDRAILS & S GUARDRAILS
- G. ELECTRICAL
- H. CLEAN AND PAINT EXISTING PIPE & MISC. DUCTS AS REQUIRED
- I. THIS DRAWING IS TO BE READ IN CONJUNCTION WITH THE MECHANICAL & ELECTRICAL SCHEDULES
- J. WHERE DIMENSIONAL COMPROMISES SUCH AS PUSH BUTTON AND KEY SWITCH ARE USED TO FREE PRELATEREASSEMBLIES, ENSURE CONTINUITY OF FIRE SEPARATIONS BY PROVIDING FINISHES WITH OPTIMUM GRADES AND FRAMING TO SATISFY AUTHORITIES JURISDICTION
- K. CONSTRUCTION TO PATCH, REPAIR AND MAKE GOOD ALL FINISHES DESTROYED BY THE WORK OF THIS WORK AND DISTURBED BY THE WORK OF OTHER TRADES (MECH, ELEC, A/C, ETC.) MATERIALS AND FINISHES TO MATCH EXISTING UNLESS NOTED OTHERWISE
- L. NEW DOOR OPERATORS TO BE PROVIDED WHEN SHOWN SHROUD. REFER TO MECH AND ELEC DGS
- M. NEW DRYWALL PARTITIONS AND EXISTING PARTITIONS WITH PROJECT CURTAIN WALLS TO BE ONE PLY OR ONE PLY WITH ONE SEGMENT OF WALL WITH BOTH SIDES OF THE WALL WALL TO SET DIRECTLY ON FLOOR. REFER TO FINISH SCHEDULE
- N. PROJECT WALLS AND BALKEHEADS IN LO CORRIDORS WITH PROJECT SCHEDULE
- O. REFER TO FINISH SCHEDULE


RCP LEGEND & SYMBOLS

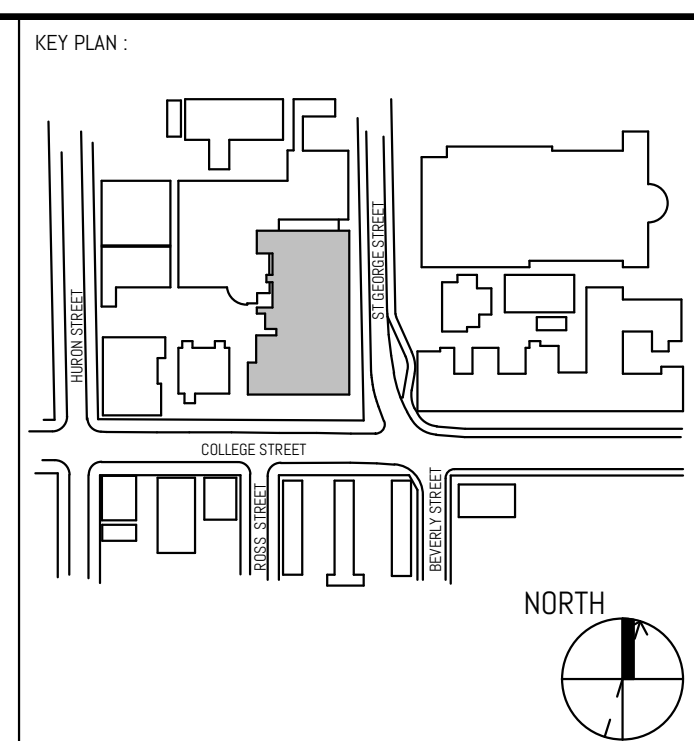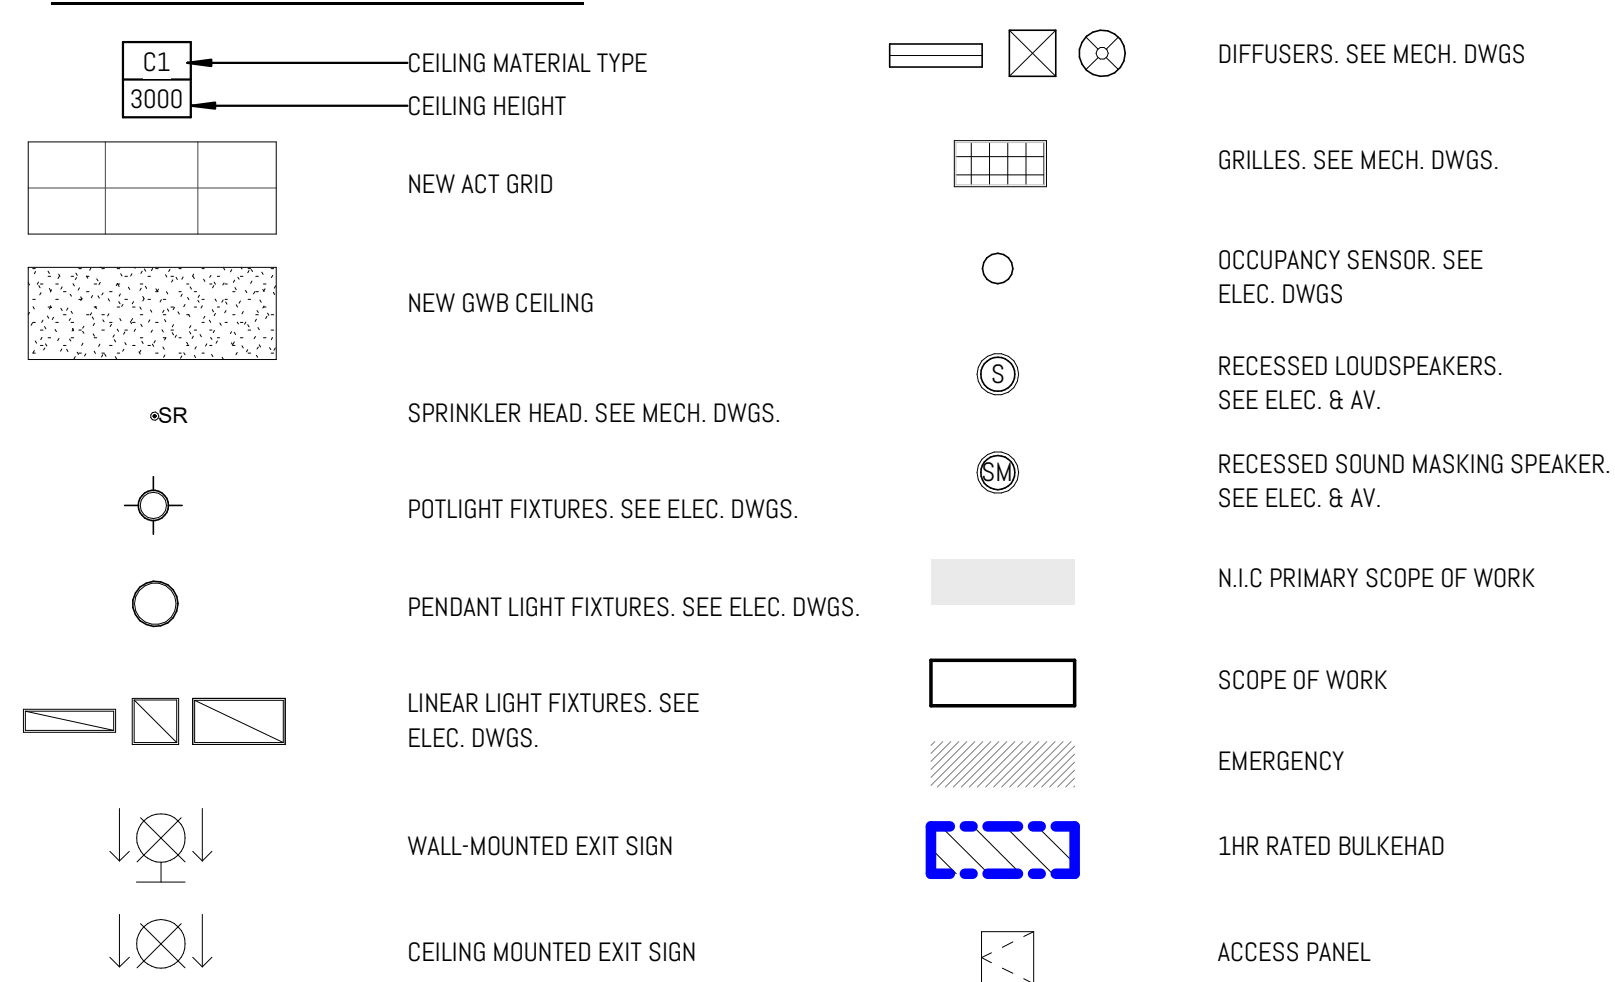


REVISION		
NO.	DATE	DESCRIPTION
1	08/20/2024	CLIENT REVIEW
2	08/20/2024	COSTING SET
3	10/04/2024	CLIENT SET
4	11/01/2024	PROGRESS ISSUANCE
5	11/15/2024	BUILDING PERMIT
6	12/13/2024	FBS REVIEW
7	01/25/2025	PEER REVIEW
8	01/31/2025	ISSUED FOR BID
9	03/20/2025	BID ADDENDUM #3
10	03/25/2025	BID ADDENDUM #4

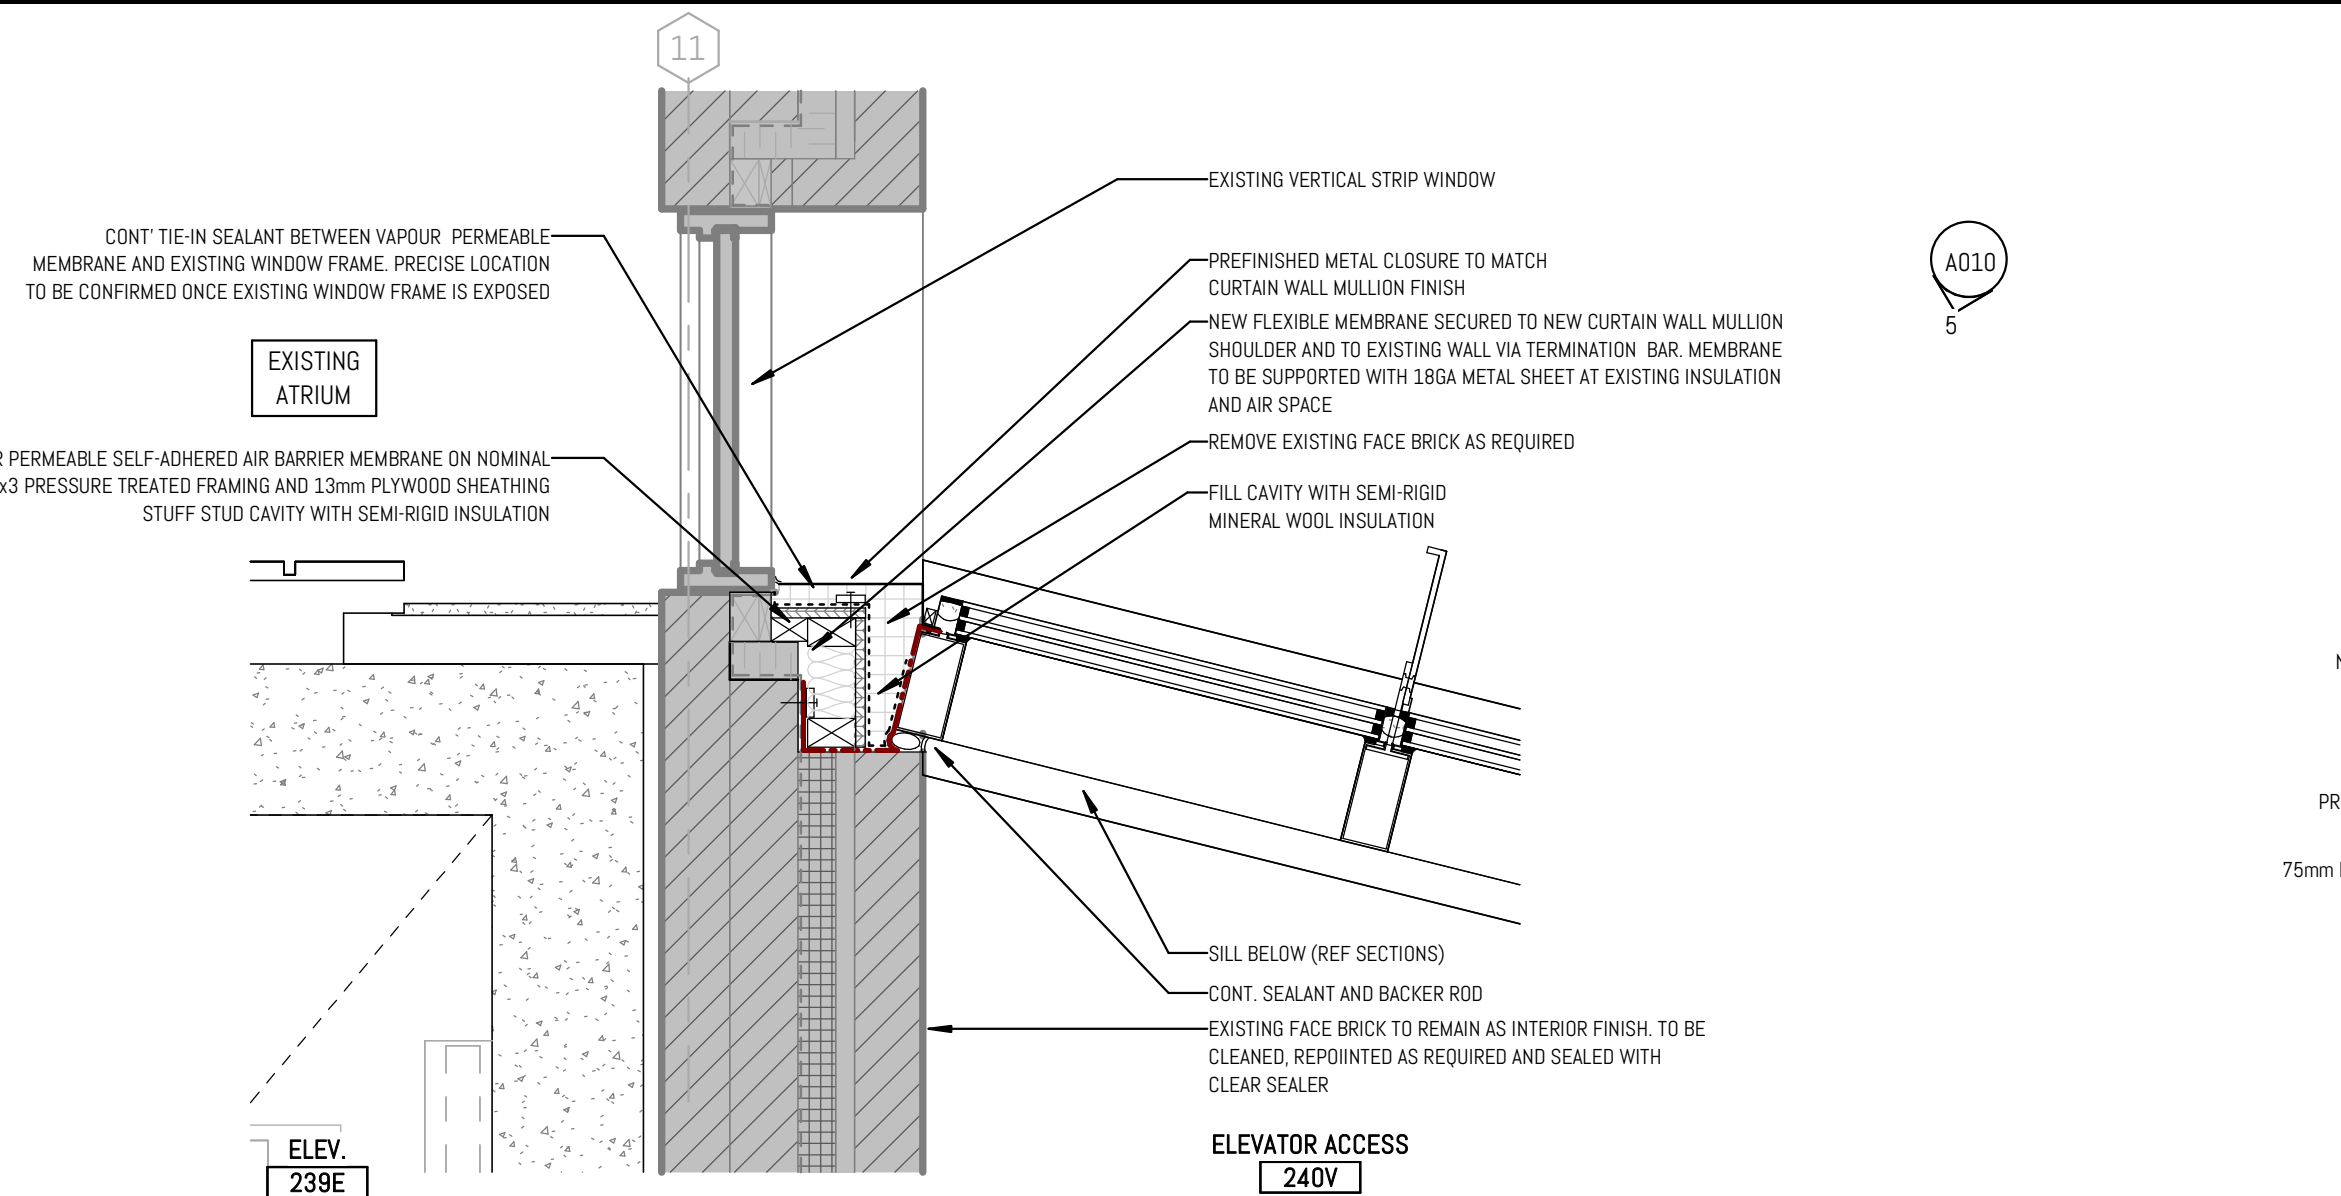


1 PLAN DETAIL - ELEVATOR CURTAIN WALL AT MASONRY CAVITY WALL
1:10 Ref: 3/1 A701

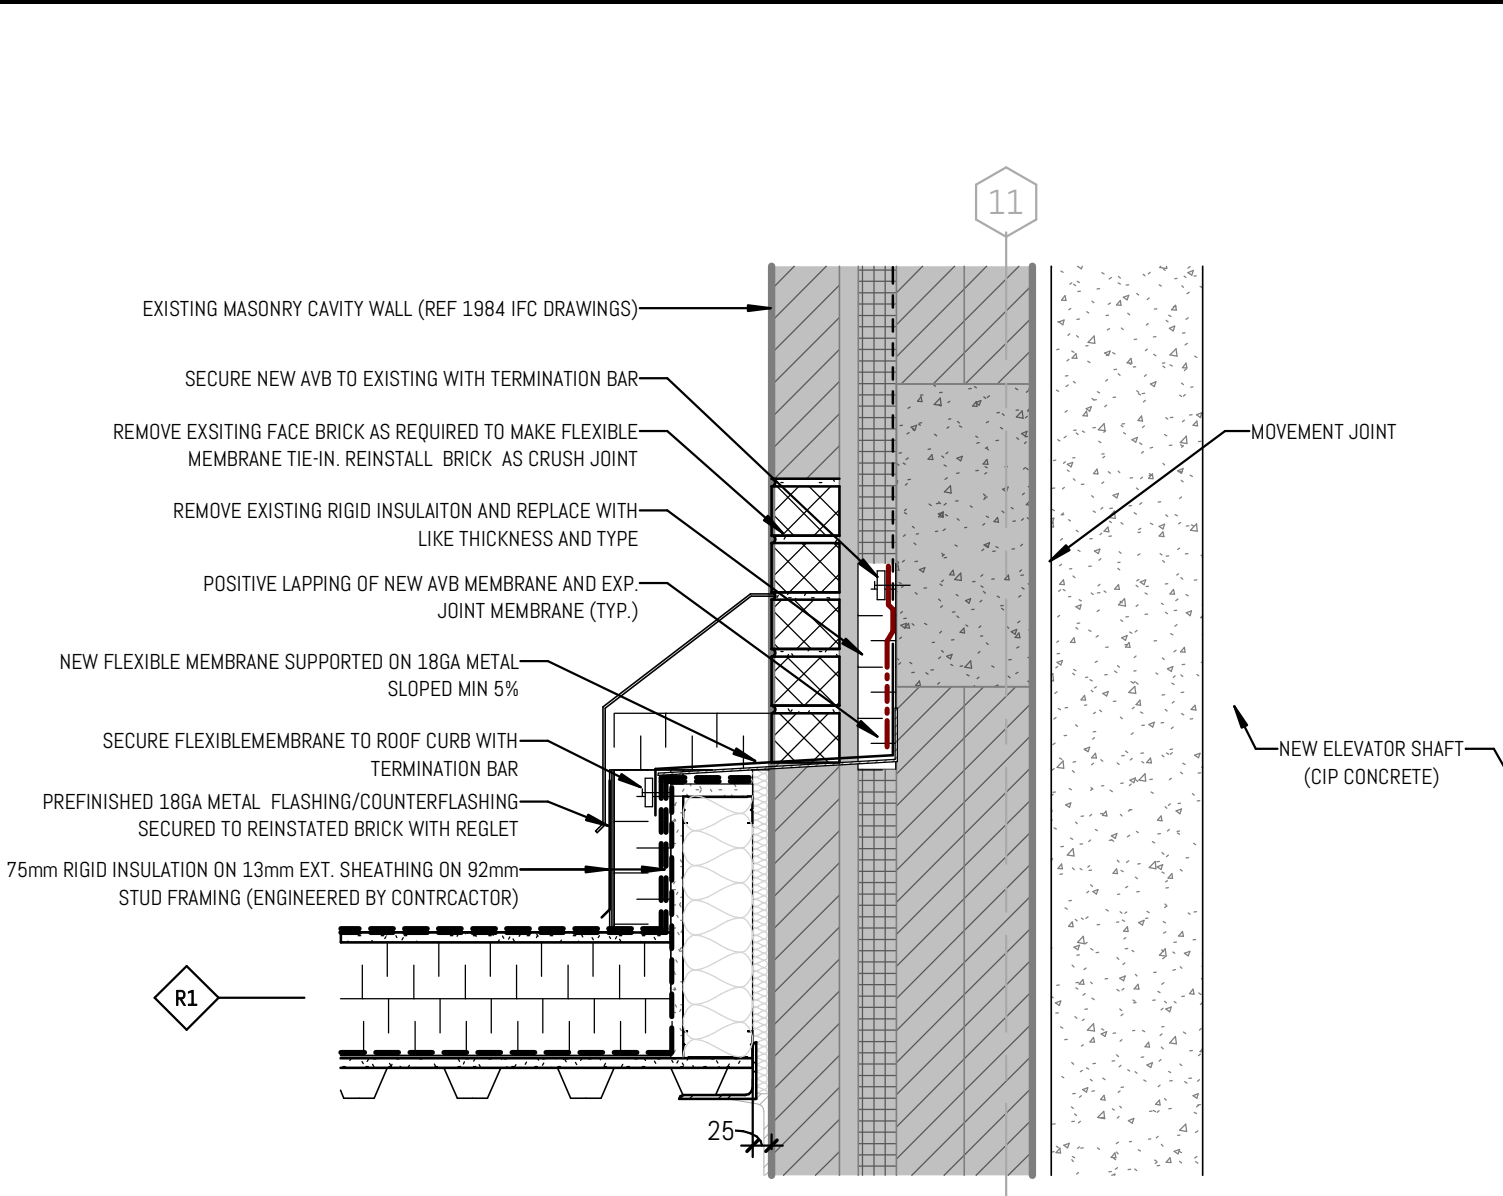


11 SECTION DETAIL - ROOF JOINT AT ATRIUM NORTH WALL
1:10 Ref: 12/1 A701

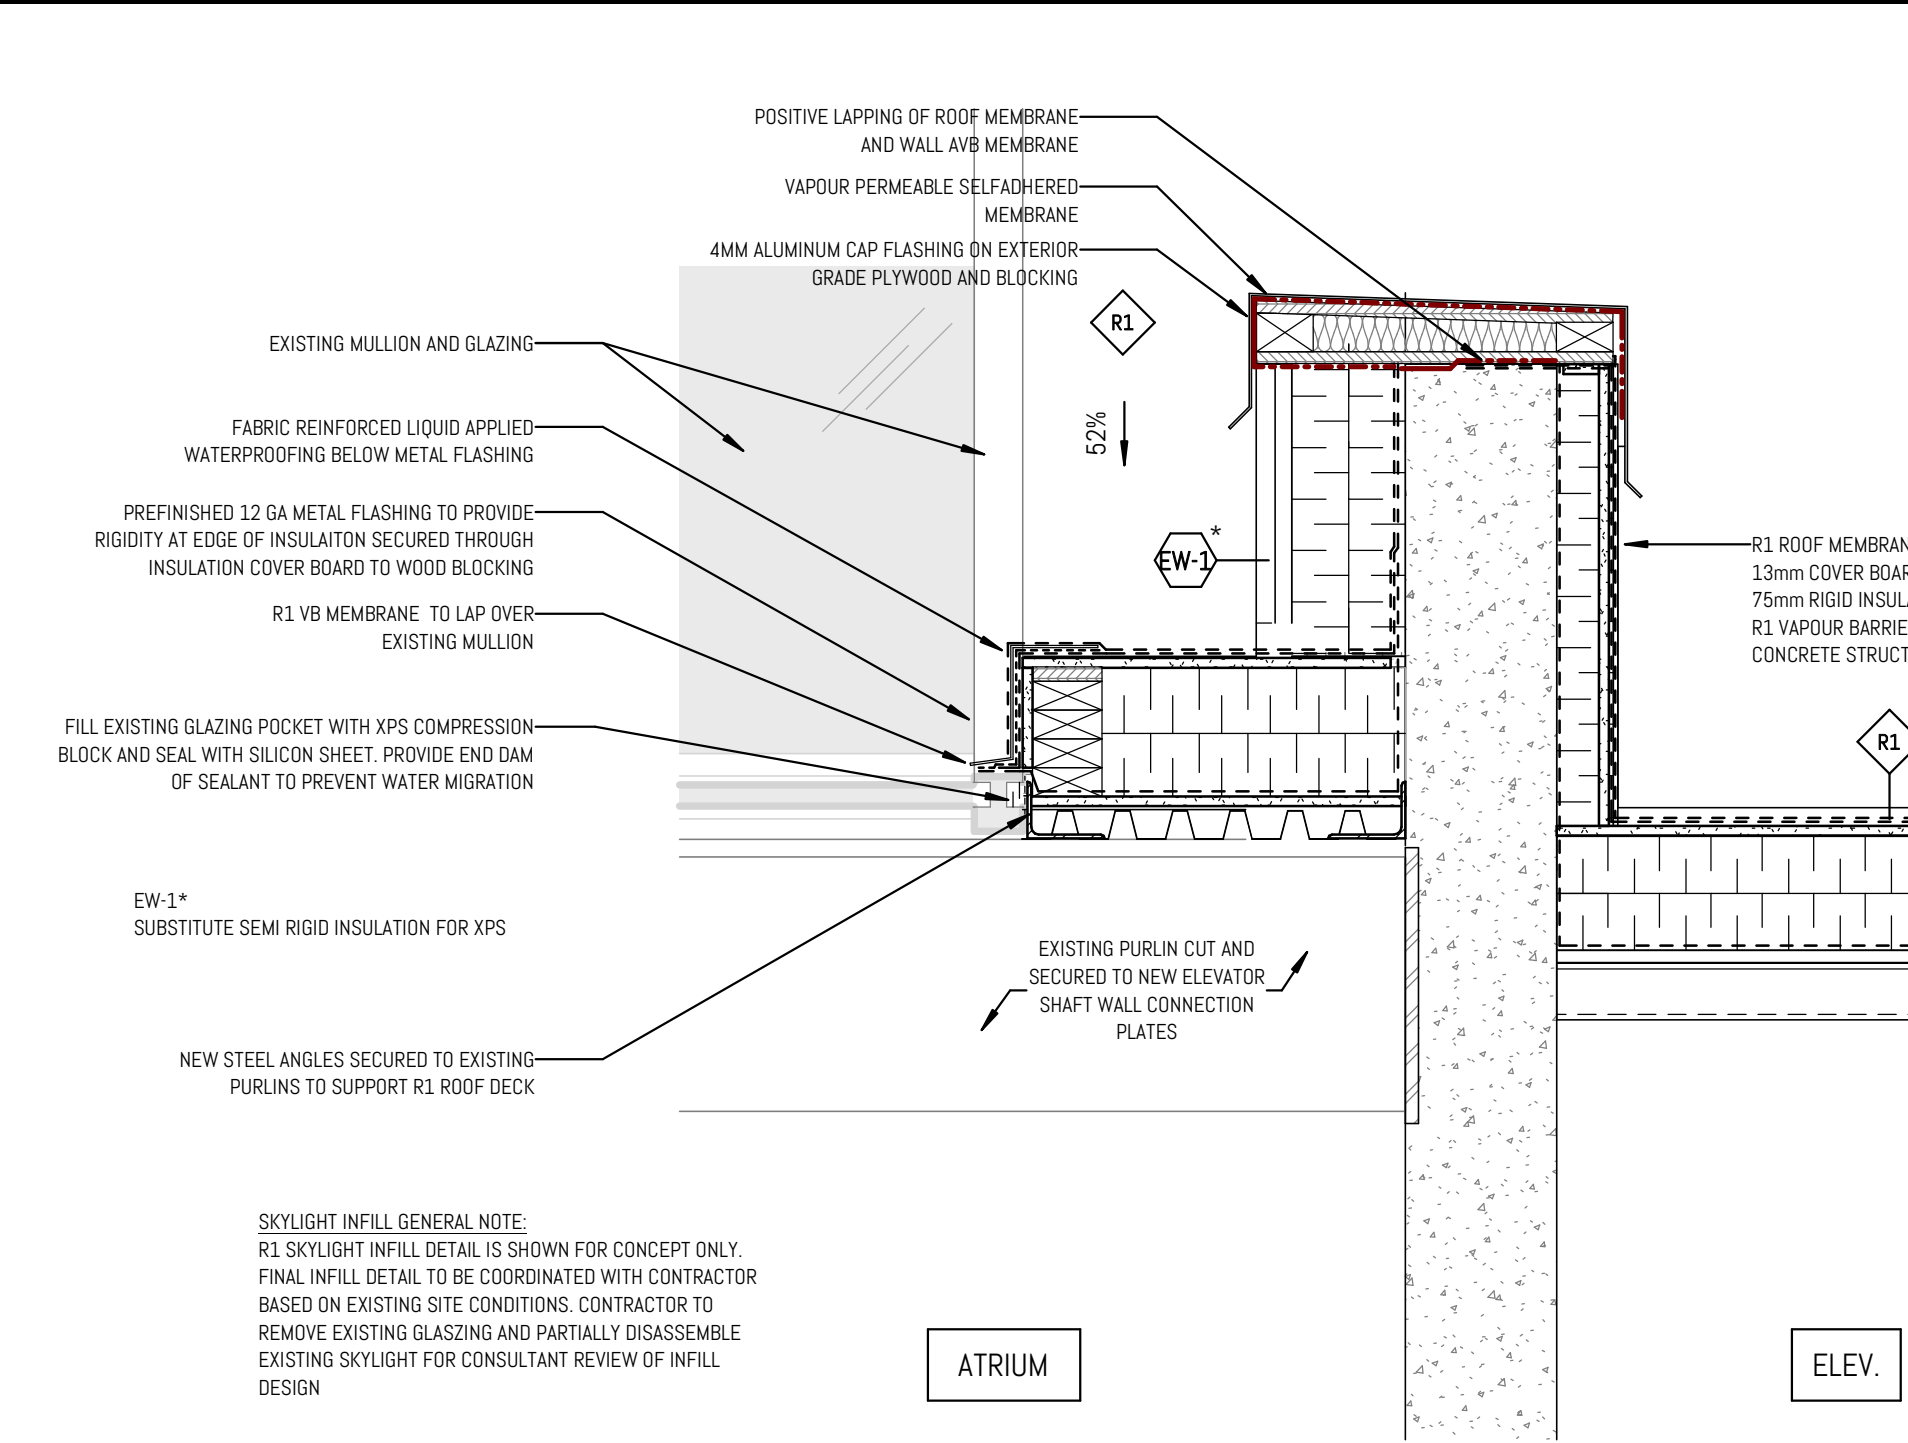


4 SECTION DETAIL - ATRIUM ROOF INFILL AT SKYLIGHT + ELEVATOR OVERRUN
1:10 Ref: 10/1 A701

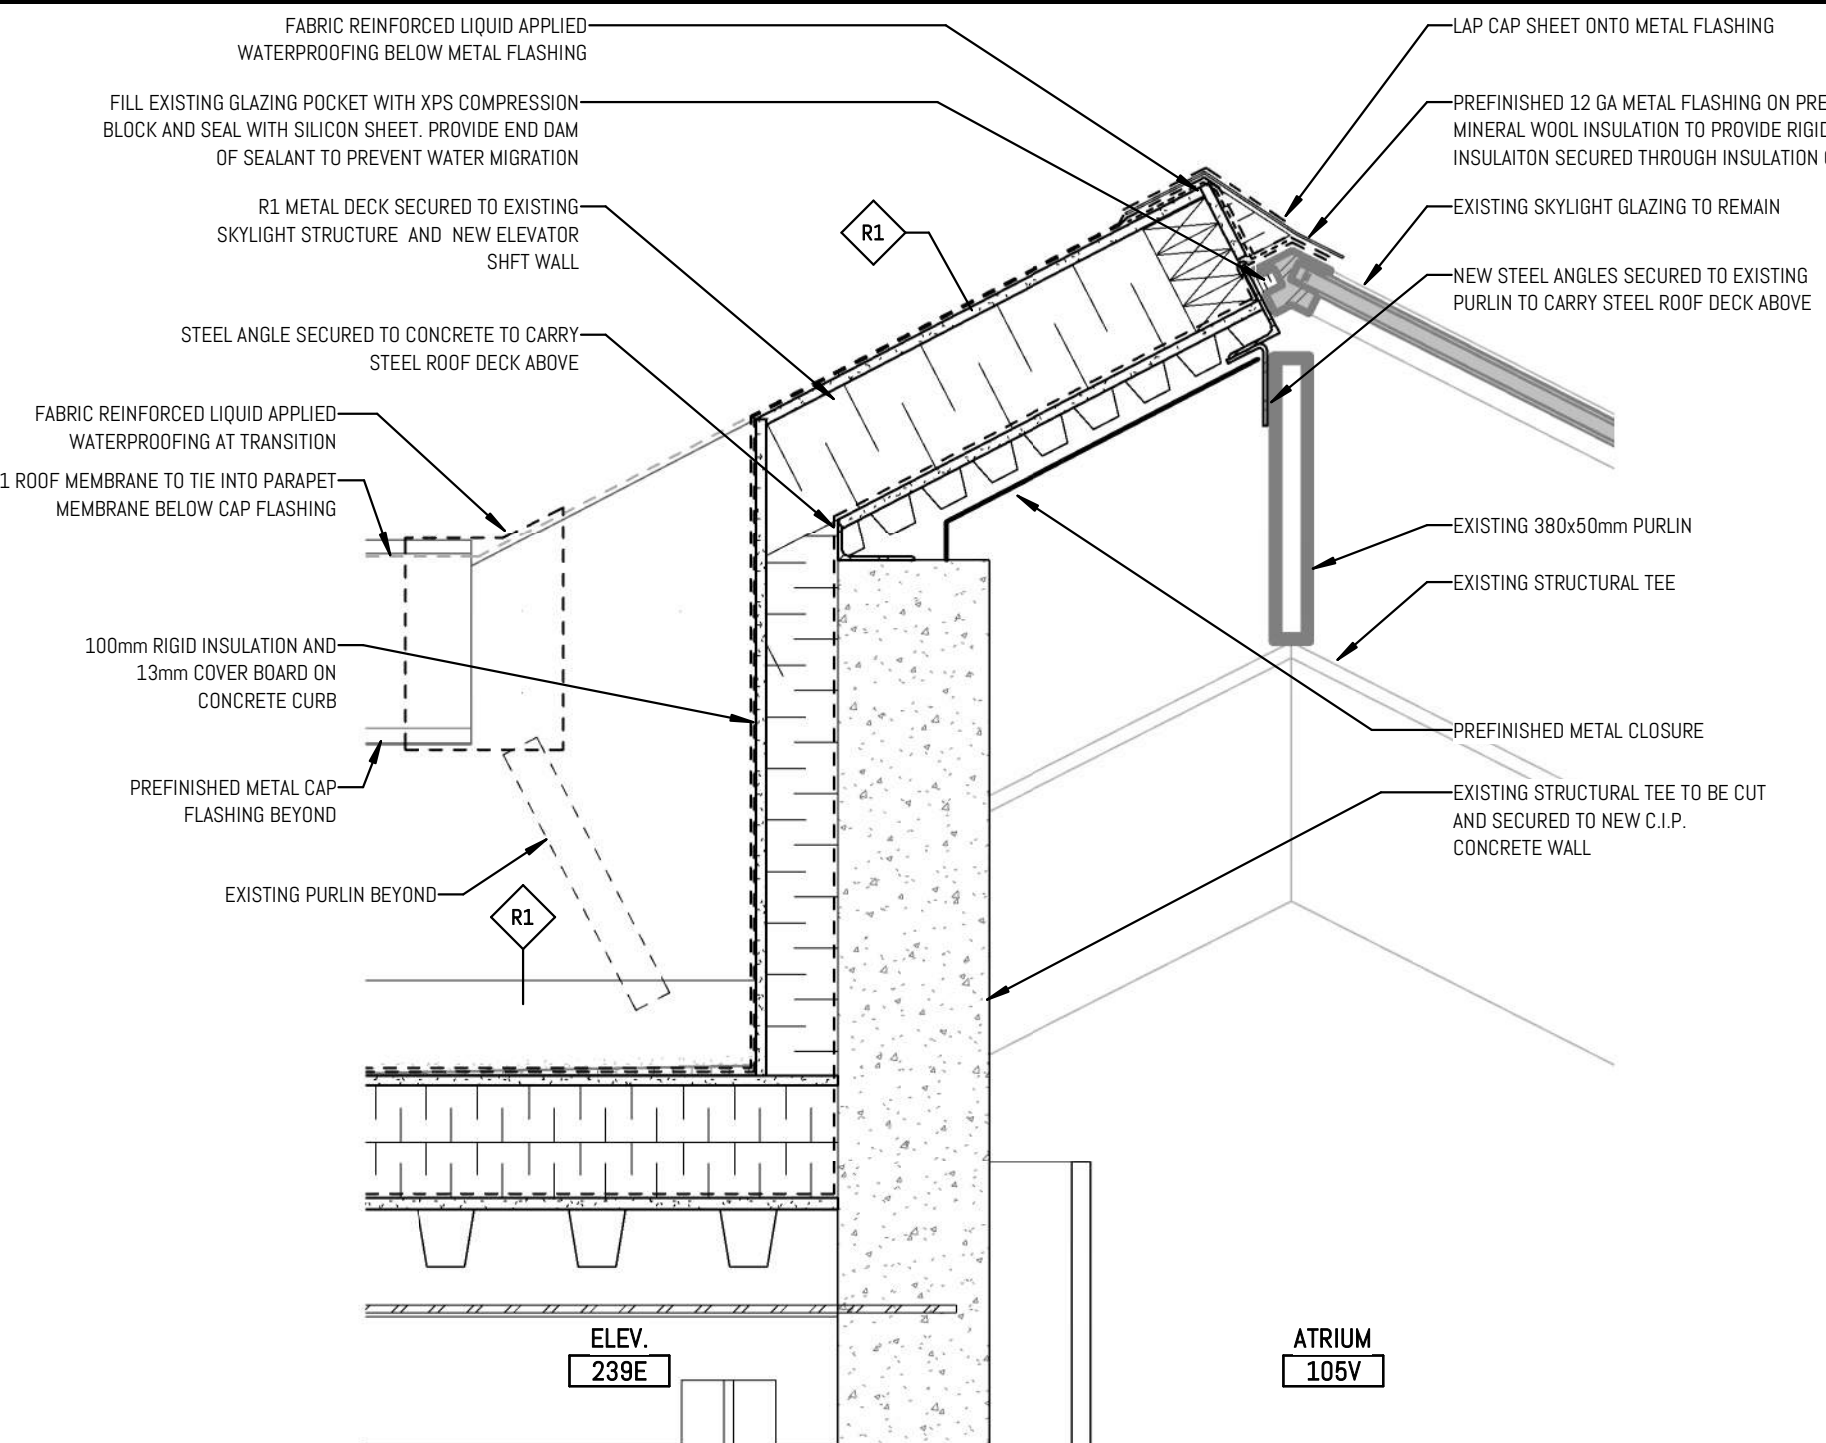


2 SECTION DETAIL - ATRIUM ROOF INFILL AT RIDGE/ELEVATOR OVERRUN
1:10 Ref: 12/1 A701

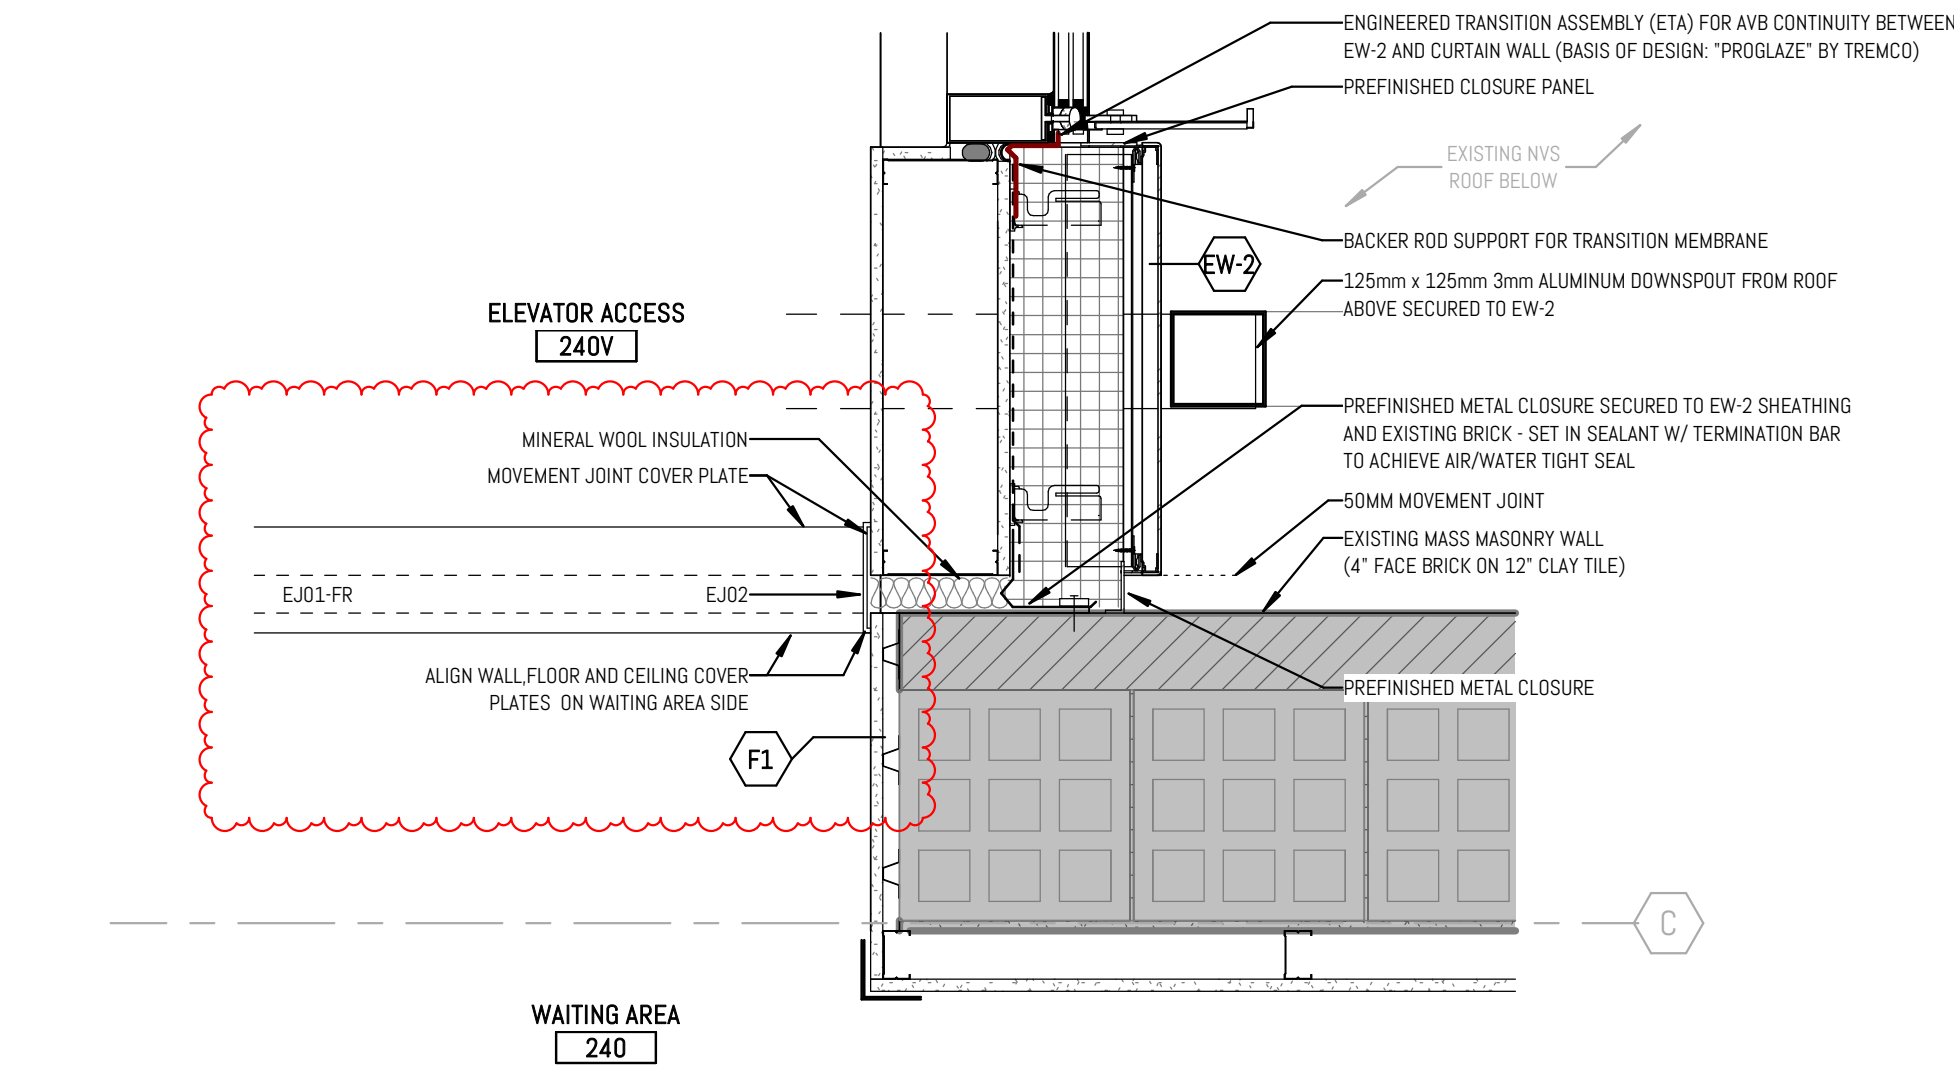


3 PLAN DETAIL - ELEVATOR CURTAIN WALL AT MASS MASONRY - LEVEL 02
1:10 Ref: 3/1 A701

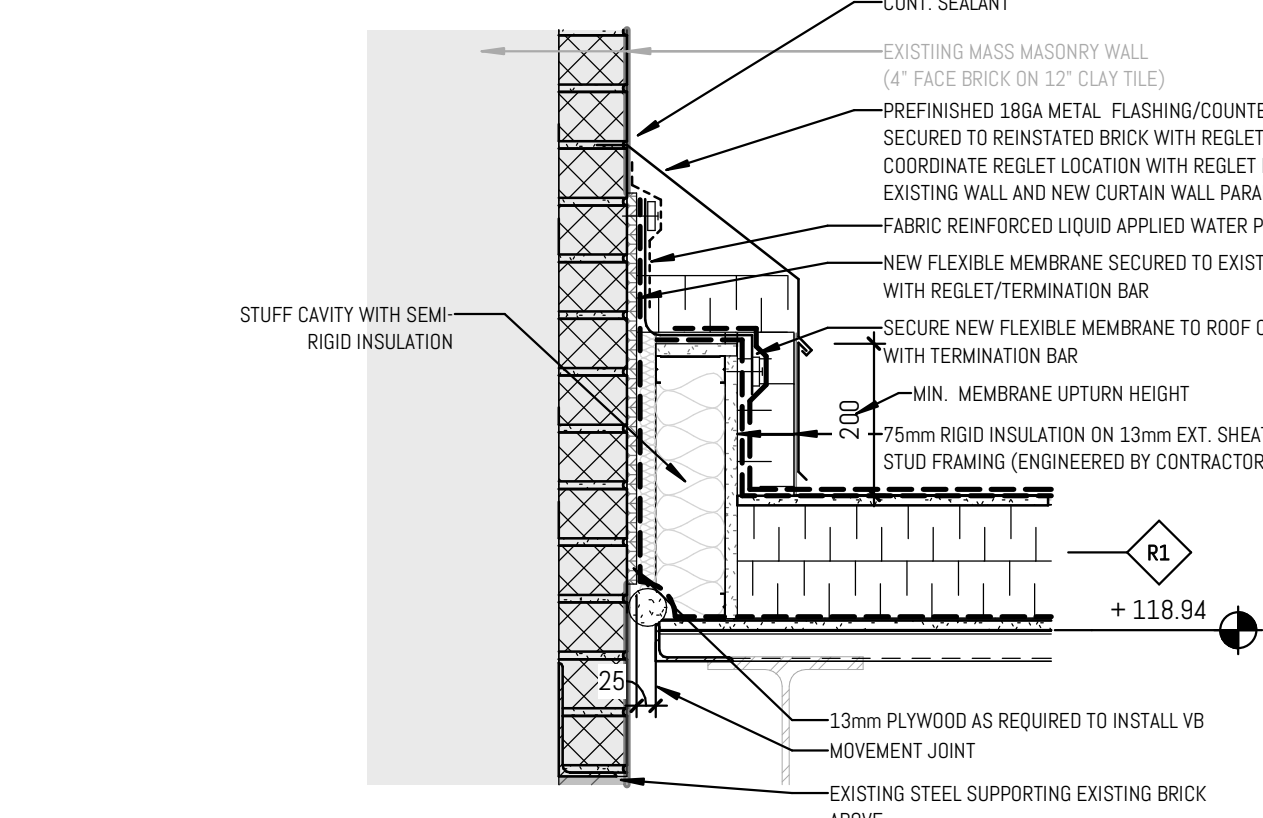


12 SECTION DETAIL - ROOF EXPANSION JOINT AT MASS MASONRY WALL
1:10 Ref: 12/1 A701

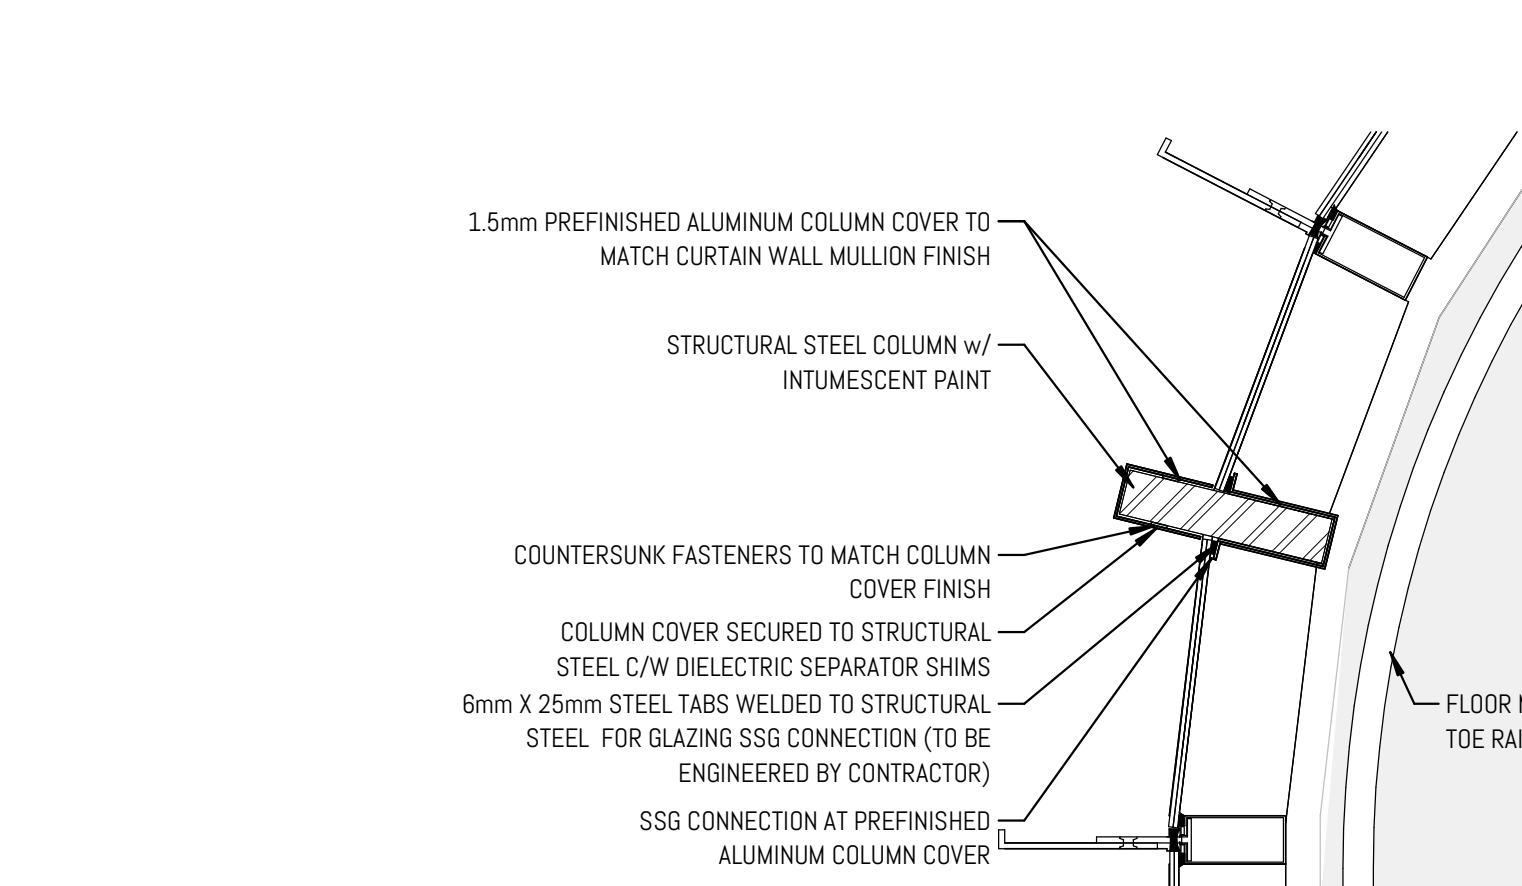


13 PLAN DETAIL - COLUMN COVER AT ELEVATOR SOUTH LOBBY
1:10 Ref: 3/1 A701

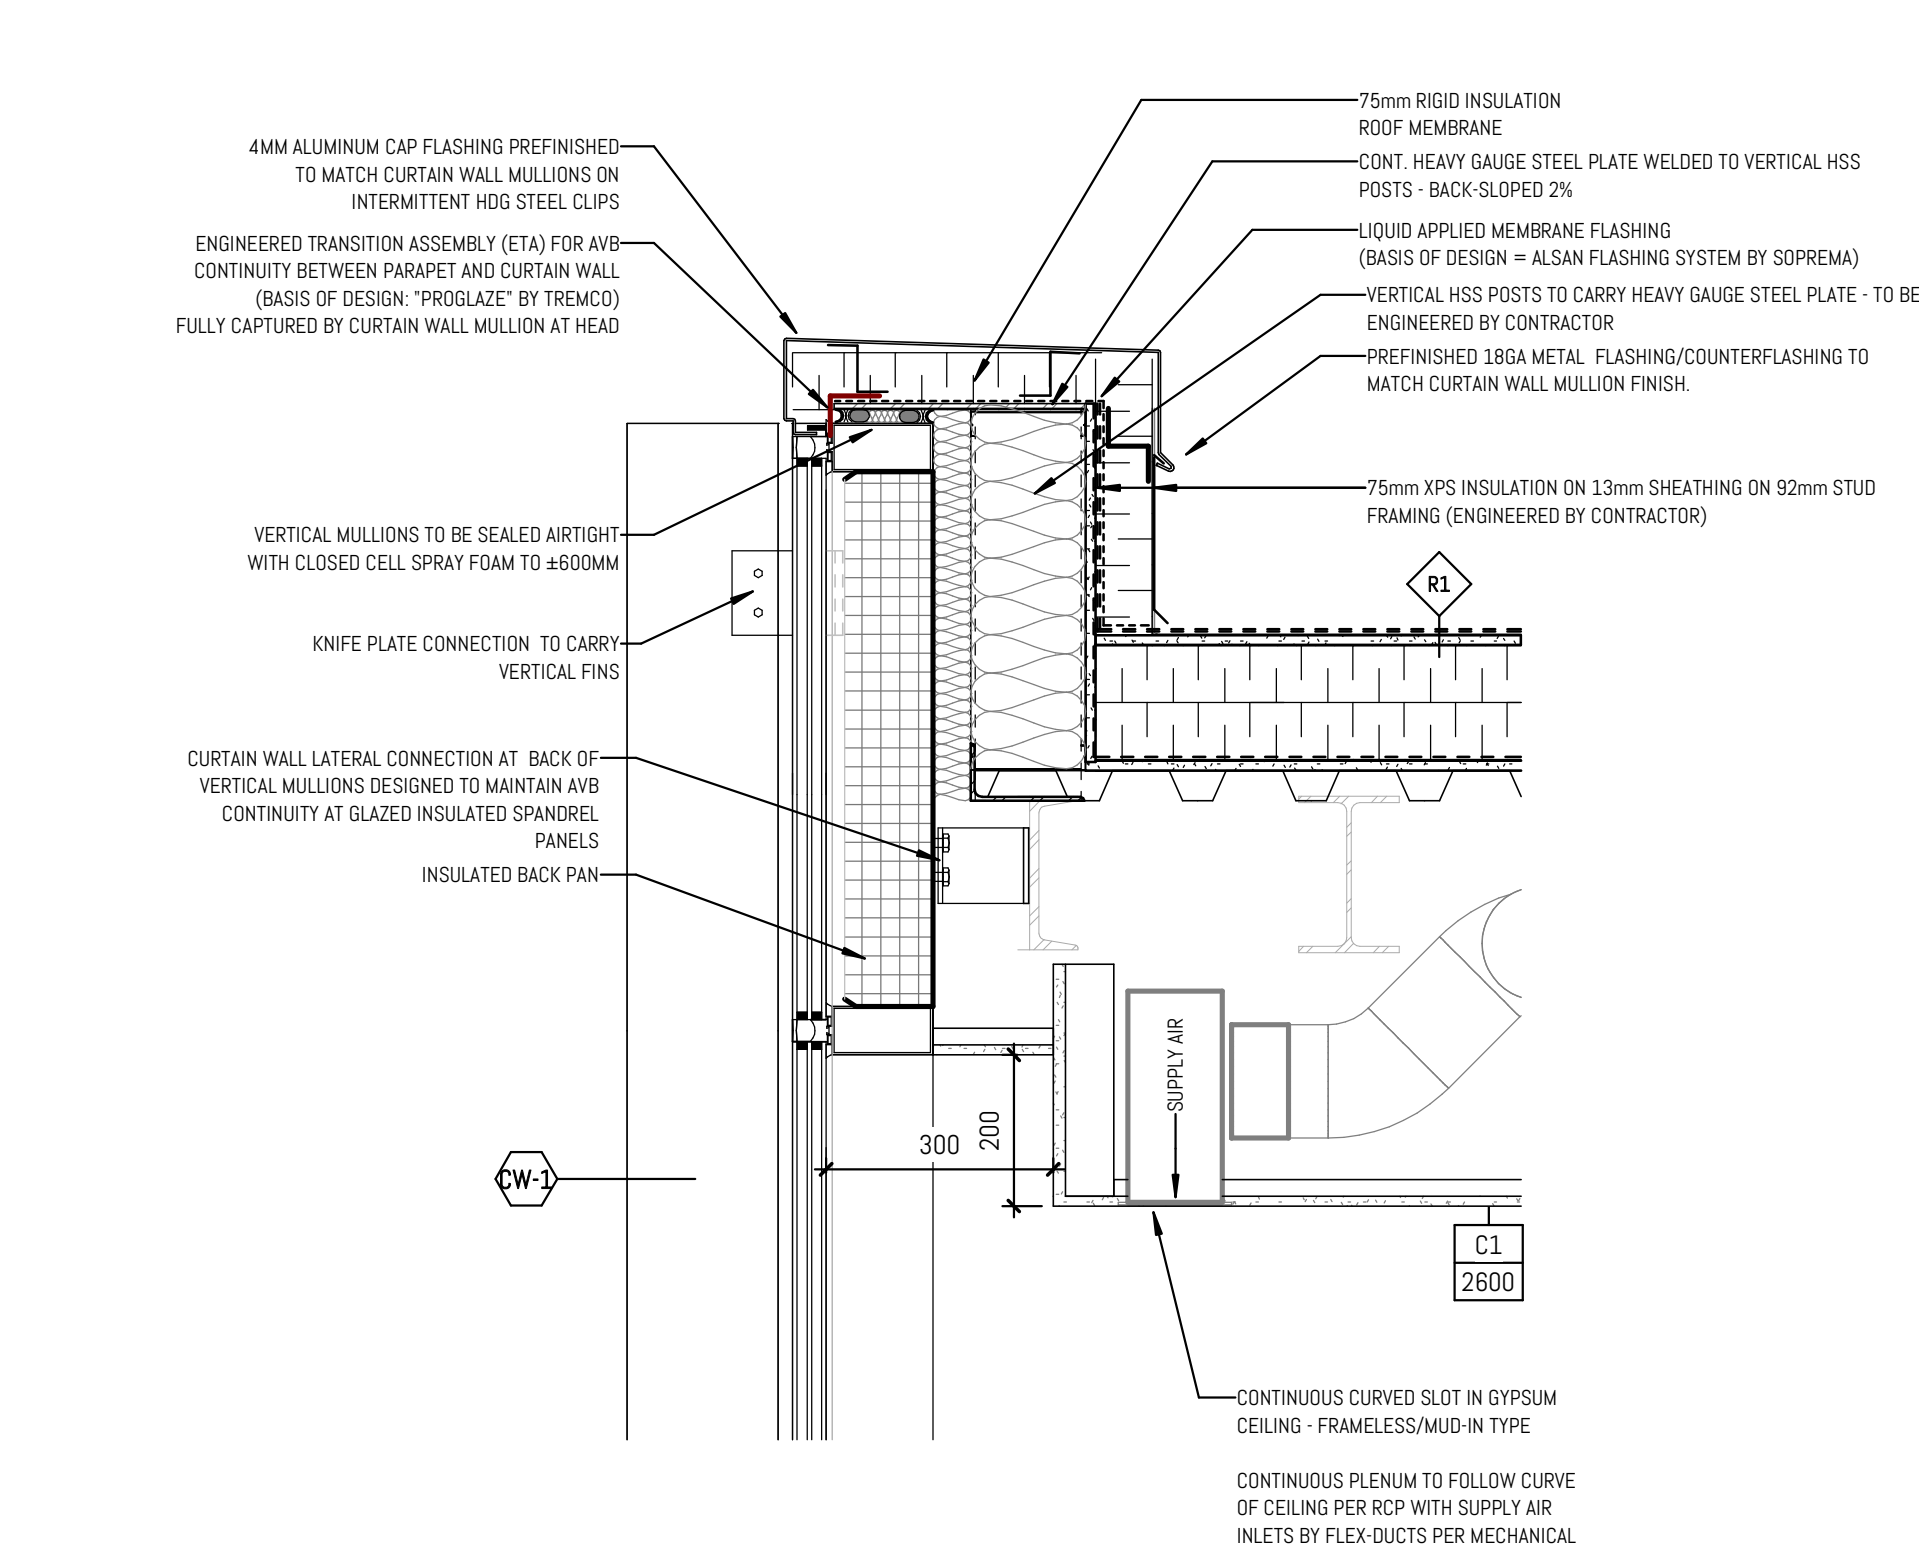



6 SECTION DETAIL - ELEVATOR NORTH LOBBY PARAPET
1:10 Ref: 12/1 A701

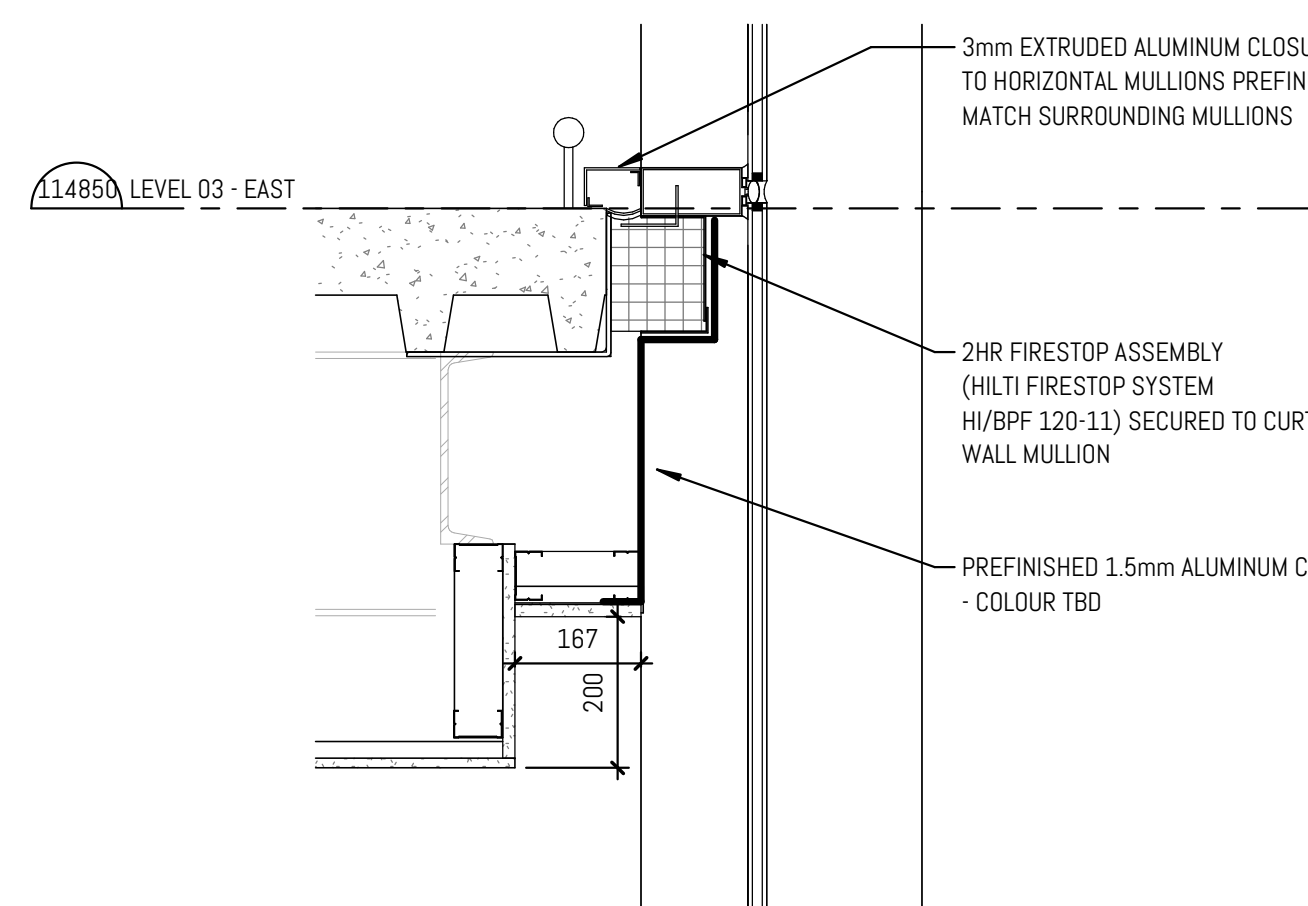



14 SECTION DETAIL - ELEVATOR SOUTH LOBBY INTERMEDIATE FLOOR
1:10 Ref: 12/1 A701

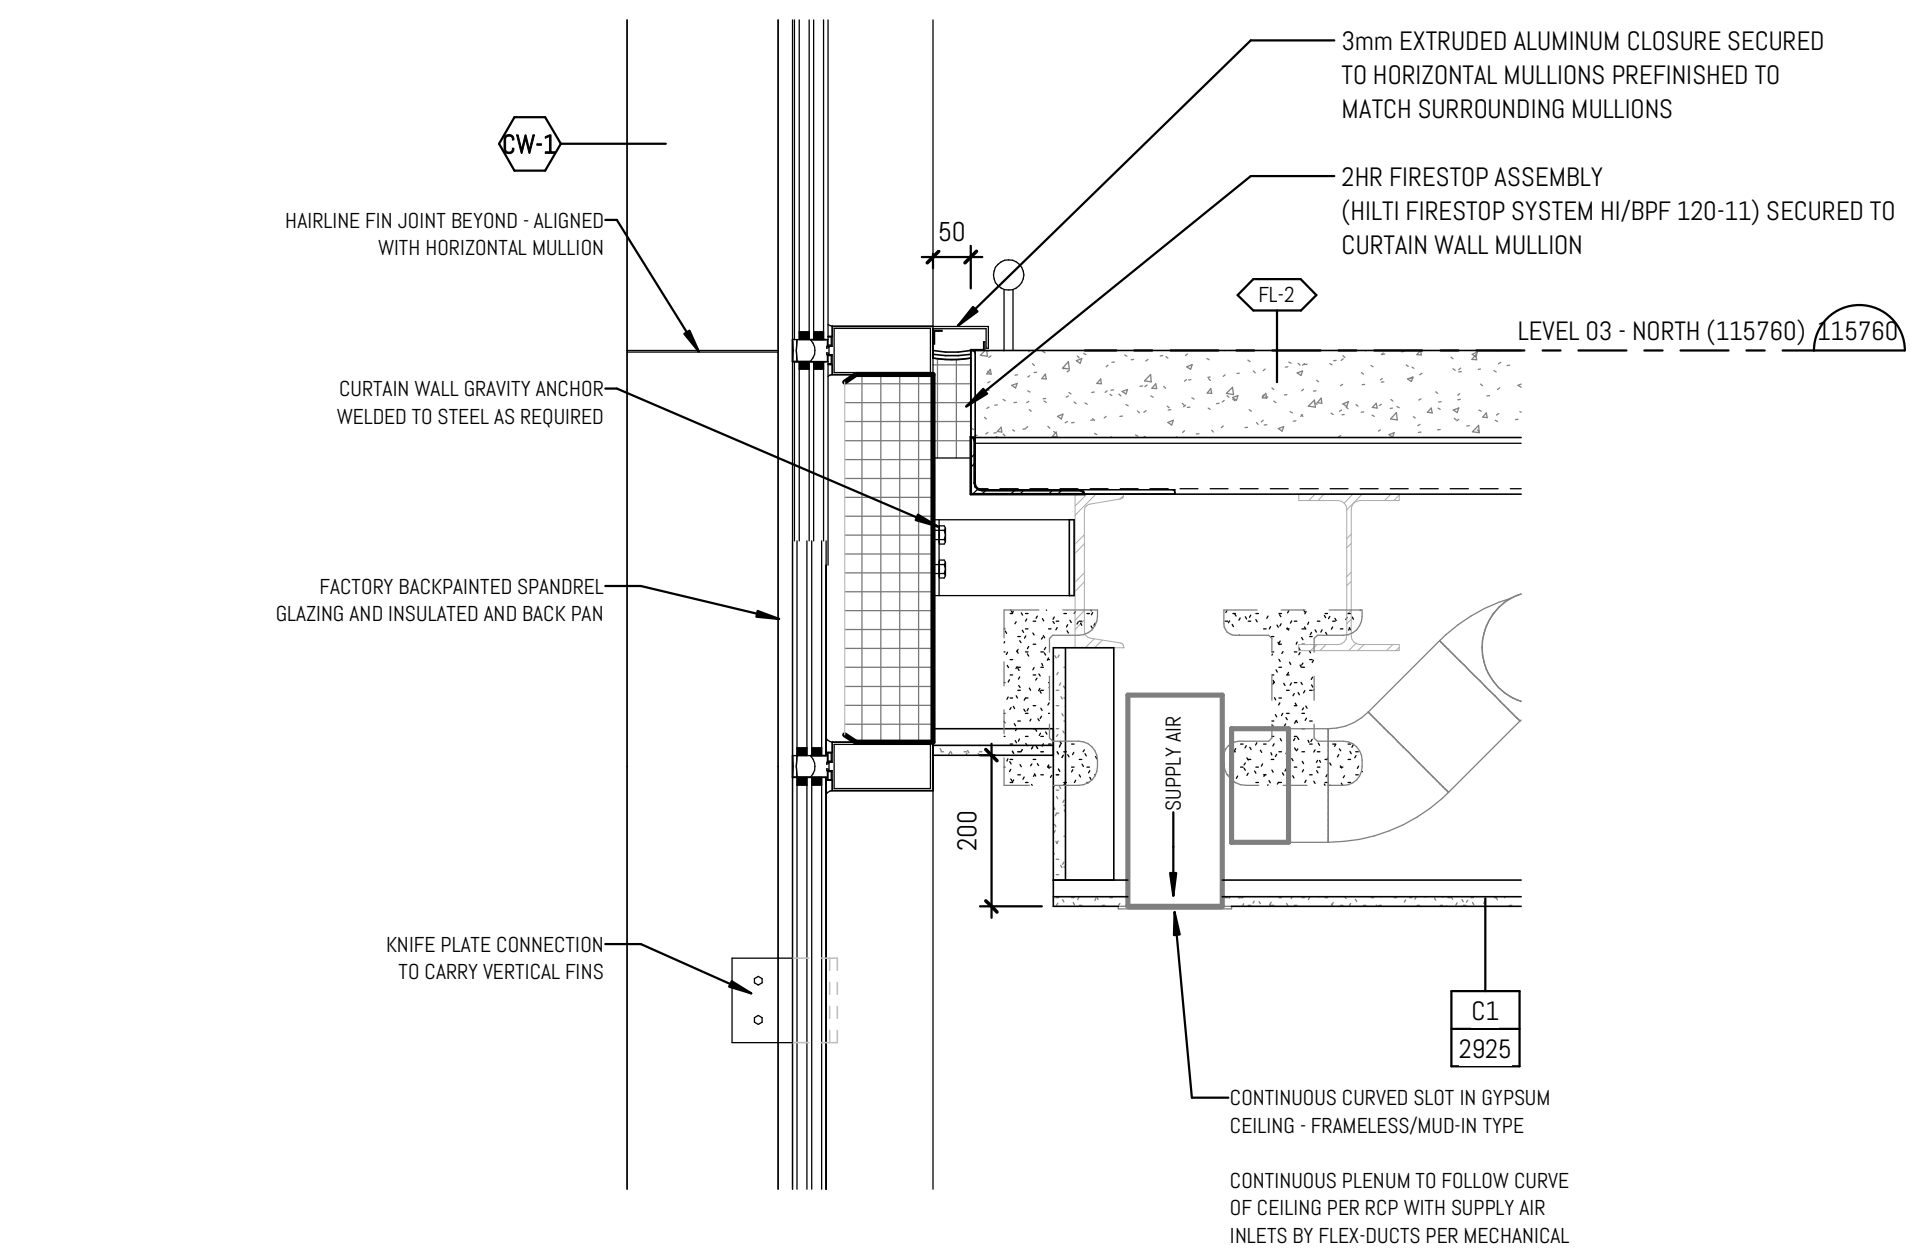


7 SECTION DETAIL - ELEVATOR NORTH LOBBY INTERMEDIATE FLOOR
1:10 Ref: 12/1 A701

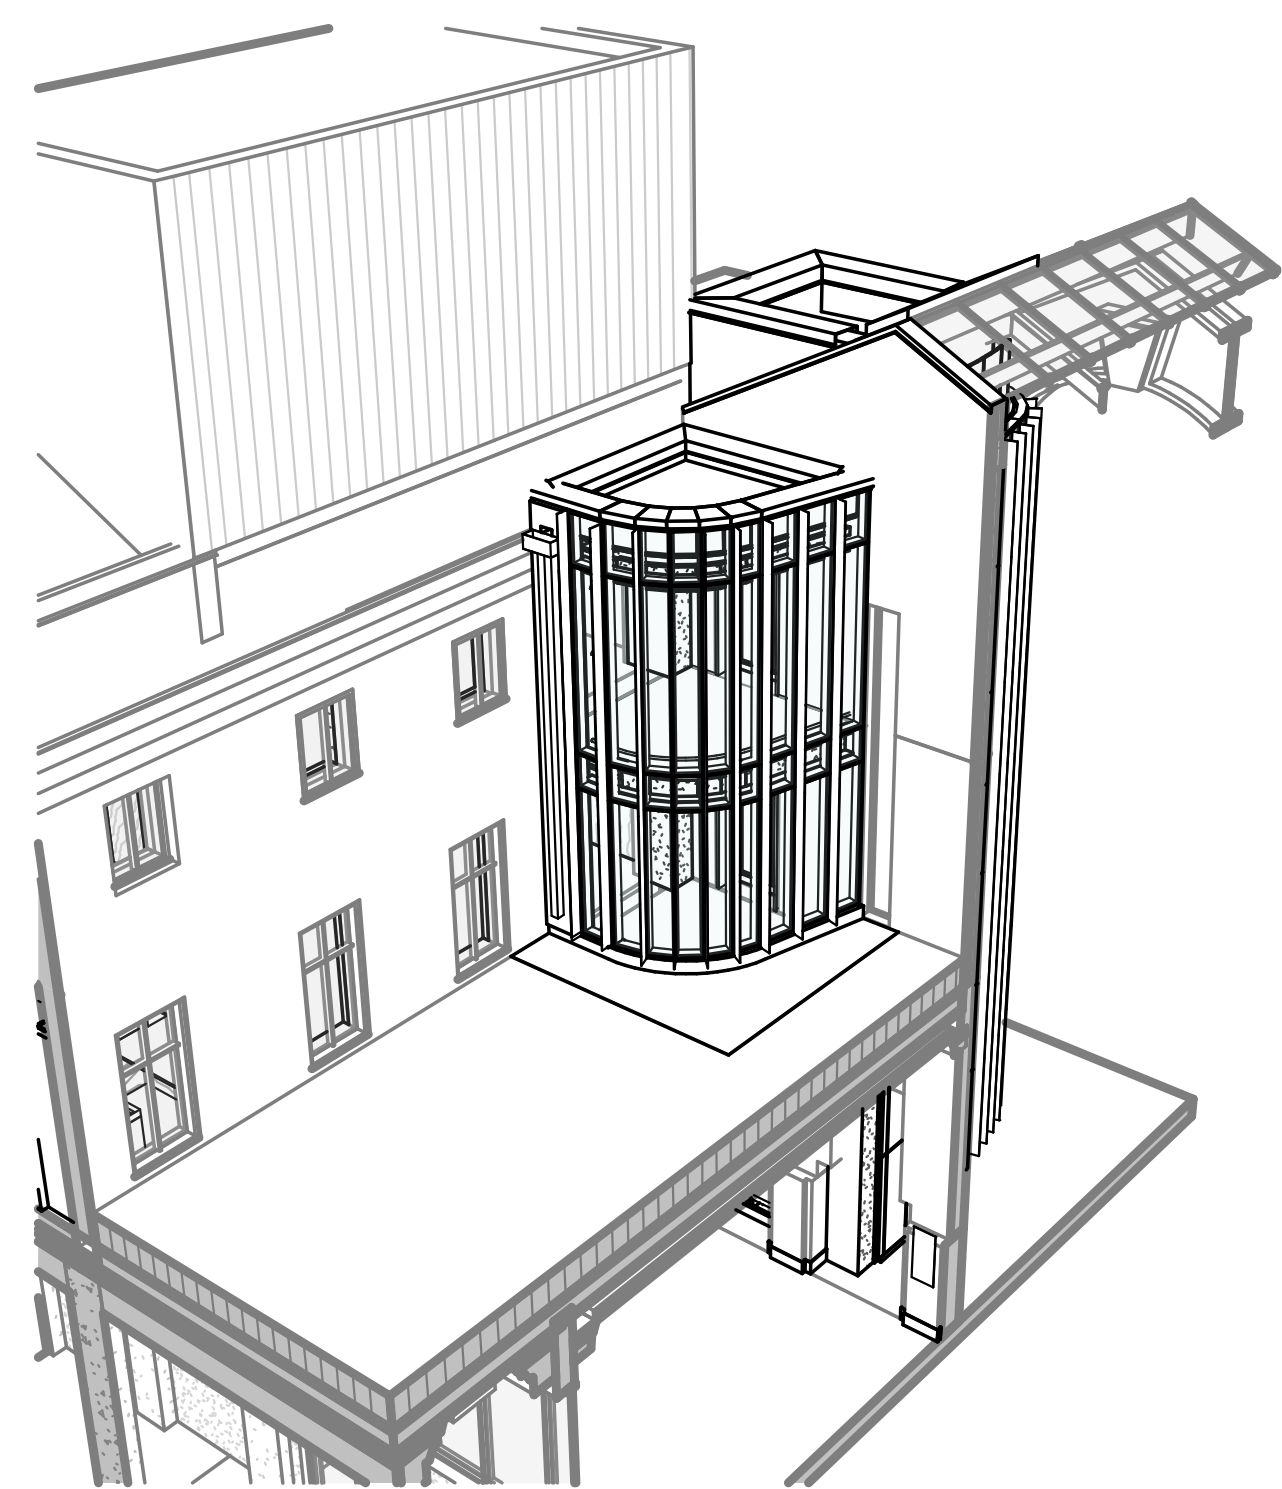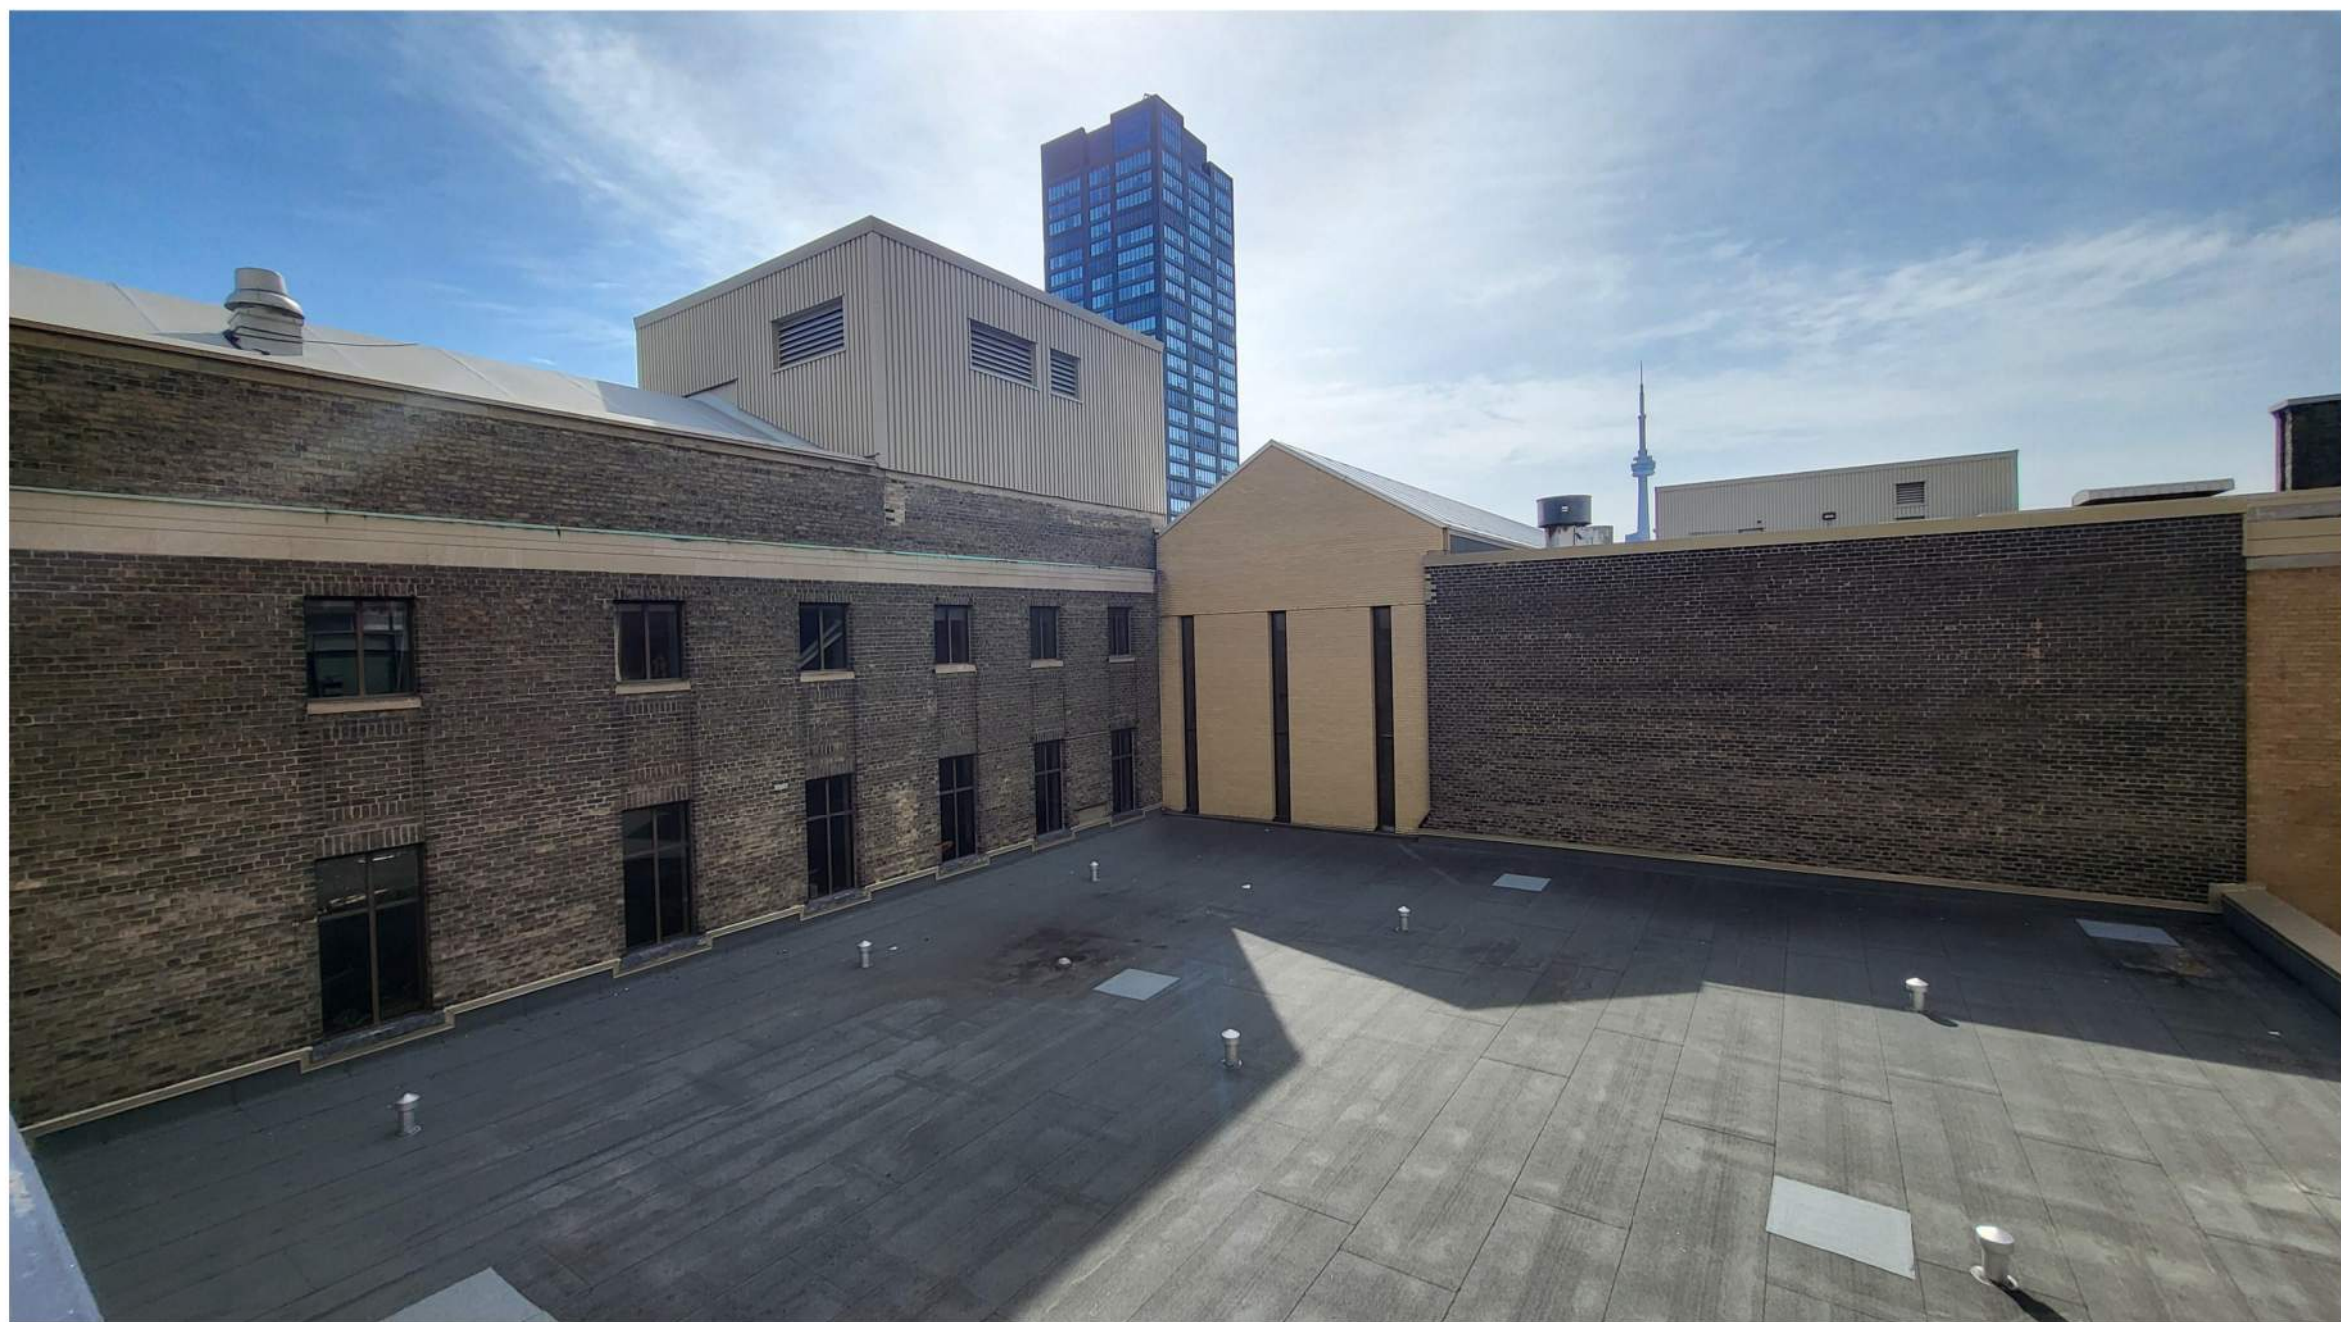


5 3D - EXTERIOR LOBBY PERSPECTIVE
1:10 Ref: 12/1 A701

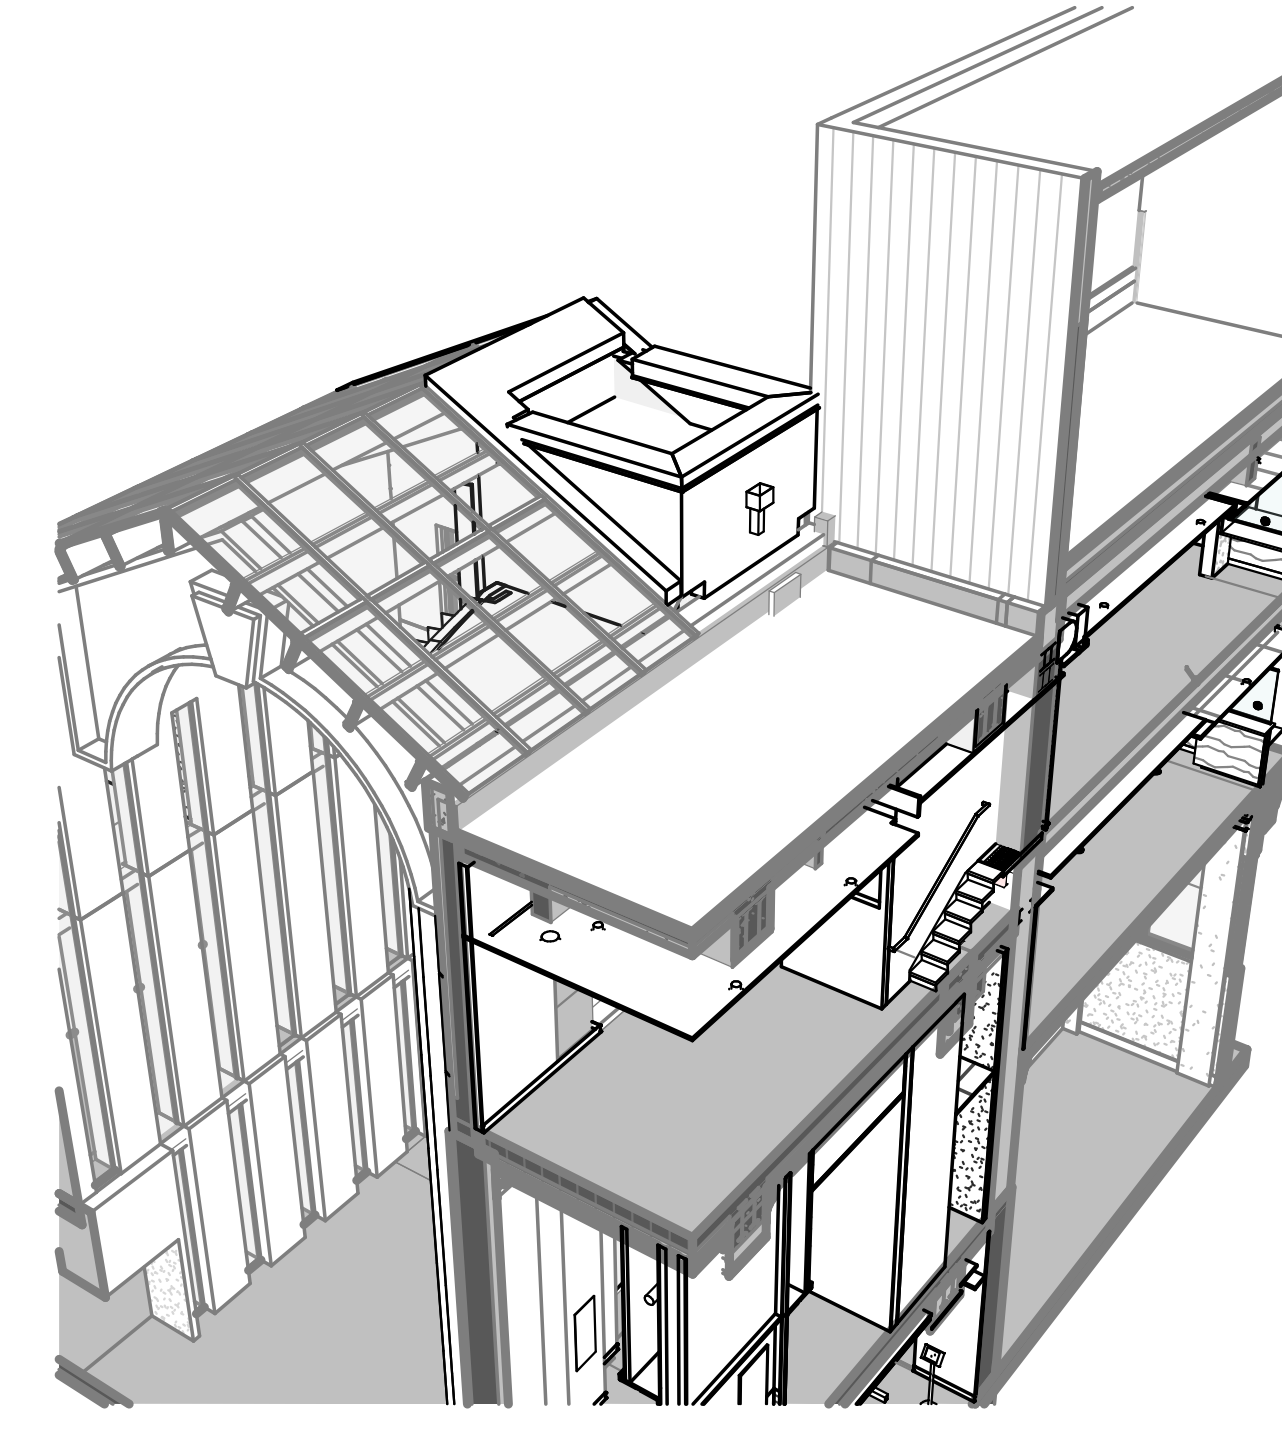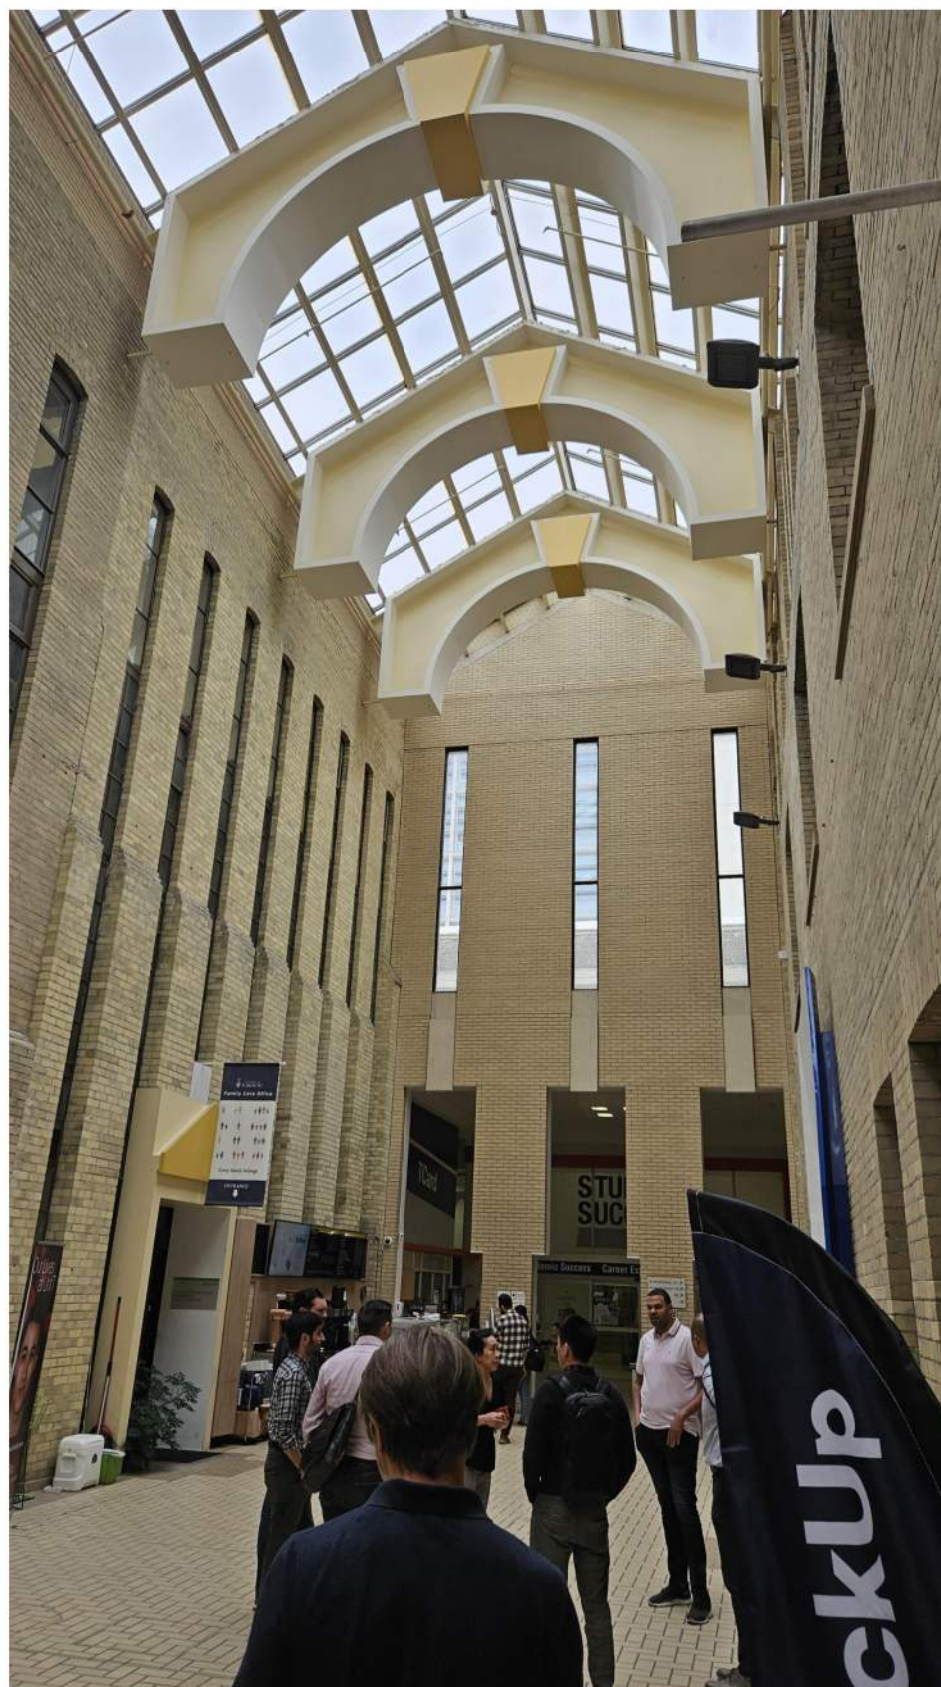


6 3D - EXTERIOR SKYLIGHT PERSPECTIVE
1:10 Ref: 12/1 A701

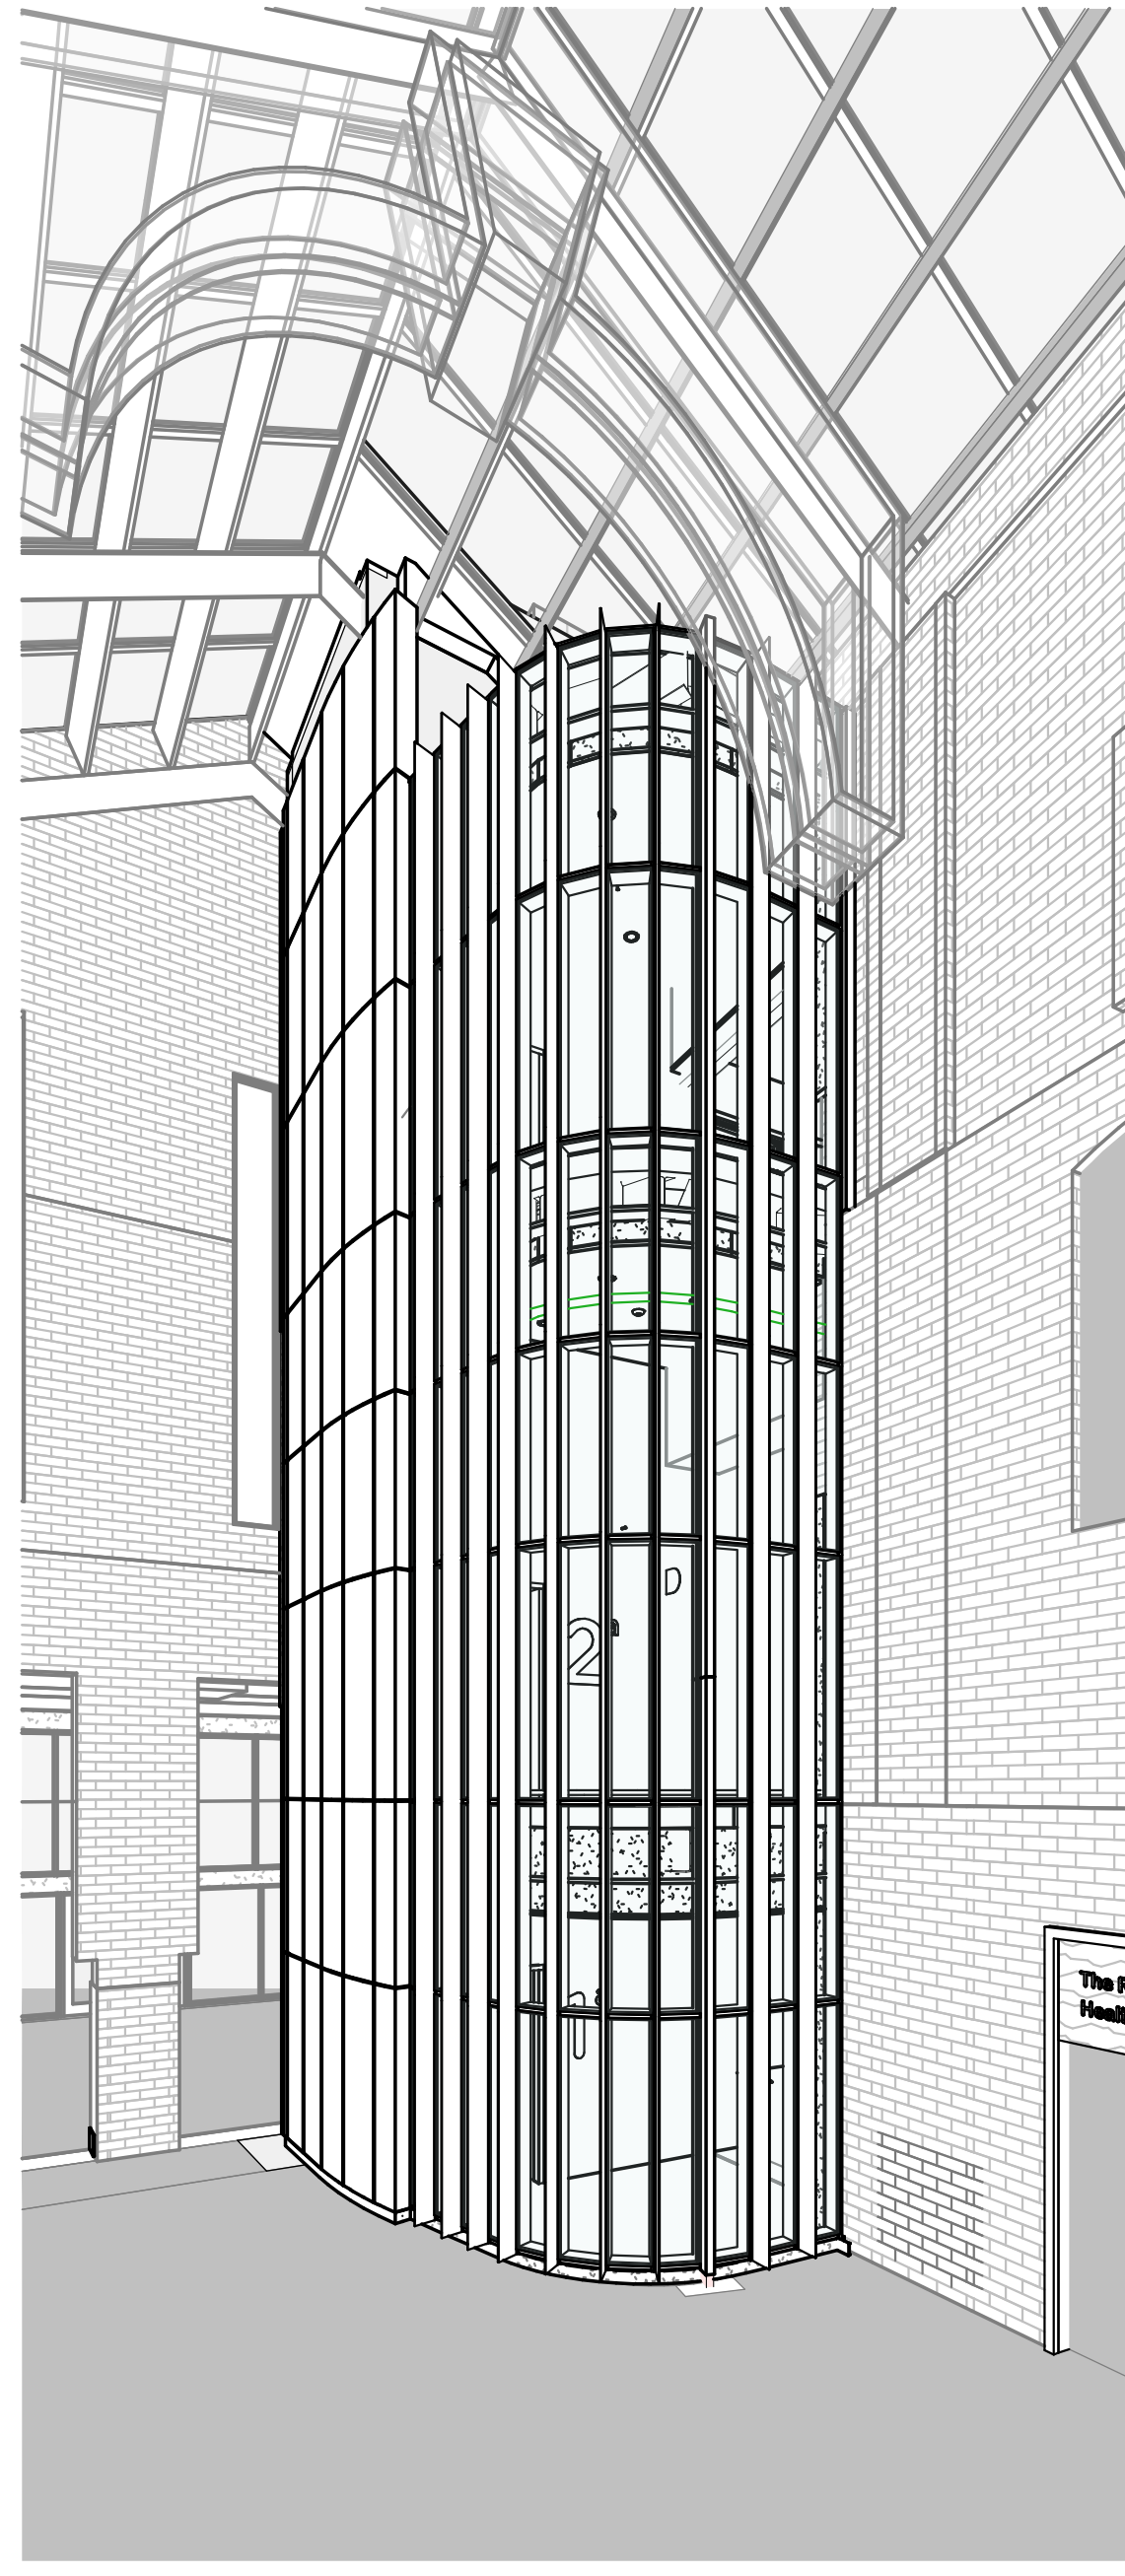


10 3D - INTERIOR PERSPECTIVE
1:10 Ref: 12/1 A701

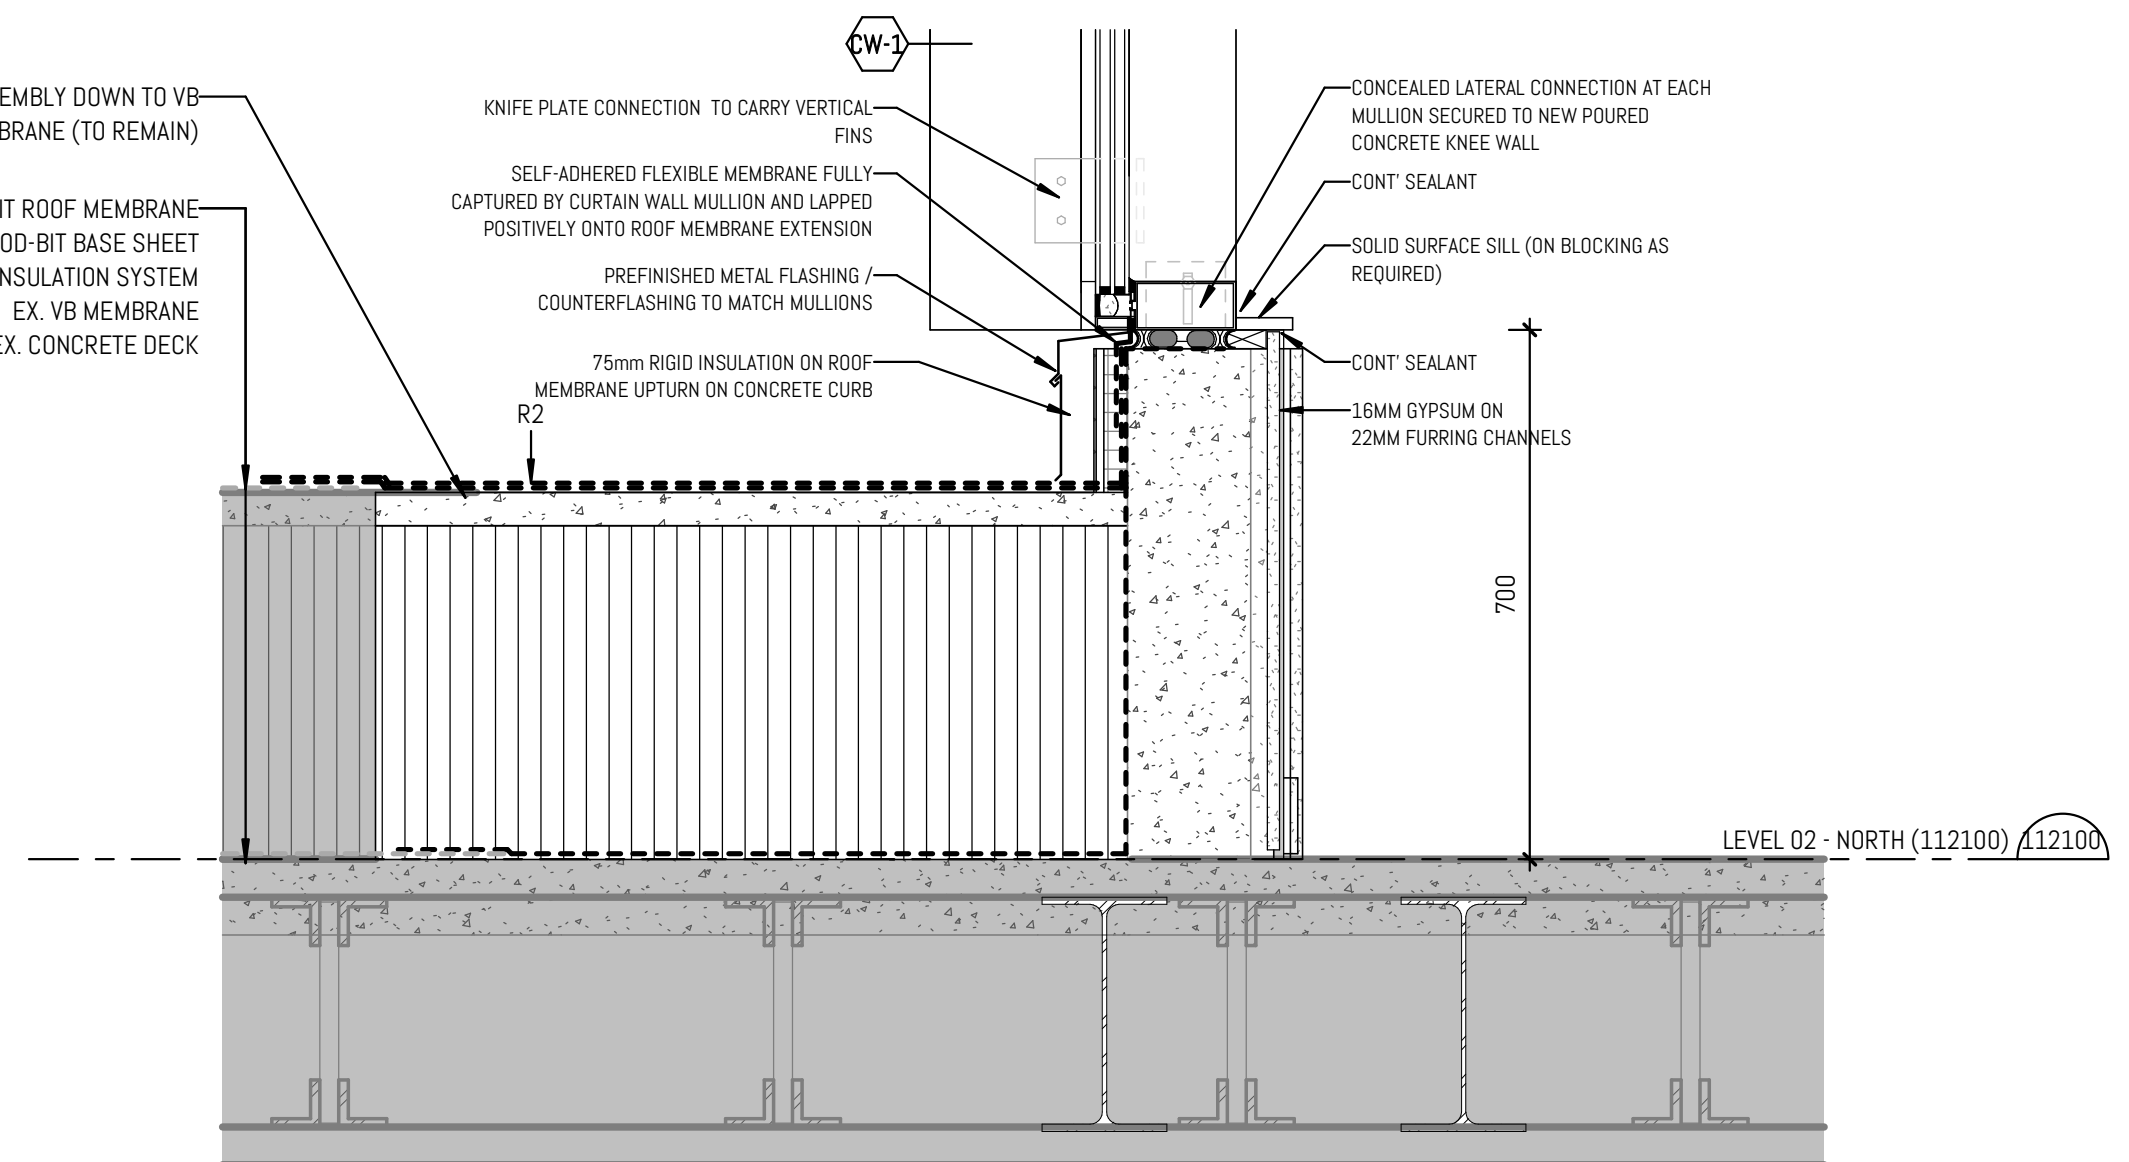

8 SECTION DETAIL - ELEVATOR NORTH LOBBY ROOF/SILL INTERFACE
1:10 Ref: 12/1 A701

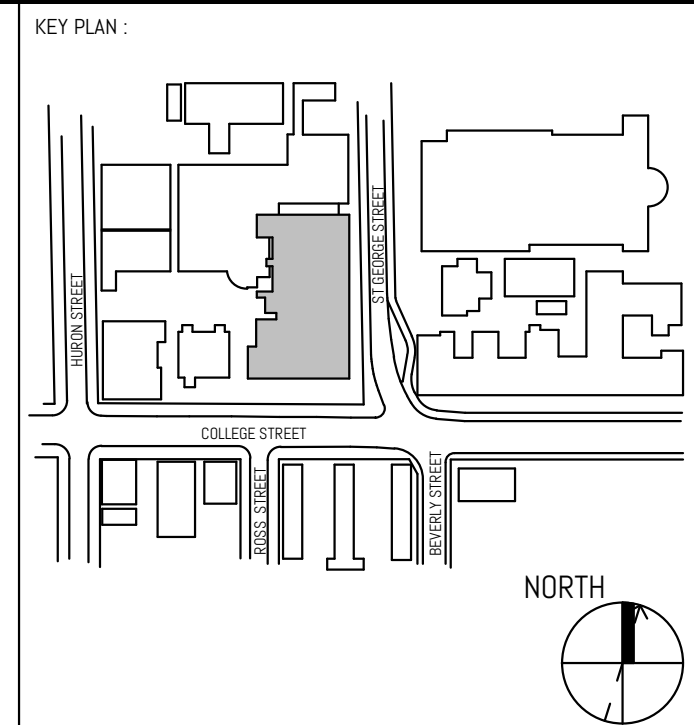

REVISION		
NO.	DATE	DESCRIPTION
1	10/20/2024	ISSUED SET
2	10/20/2024	CLIENT REVIEW
3	11/01/2024	PROGRESS ISSUANCE
4	11/20/2024	BUILDING PERMIT
5	12/13/2024	FWS REVIEW
6	01/28/2025	MEIN REVIEW
7	02/11/2025	ISSUED FOR BID
8	03/25/2025	BID ADDENDUM #4

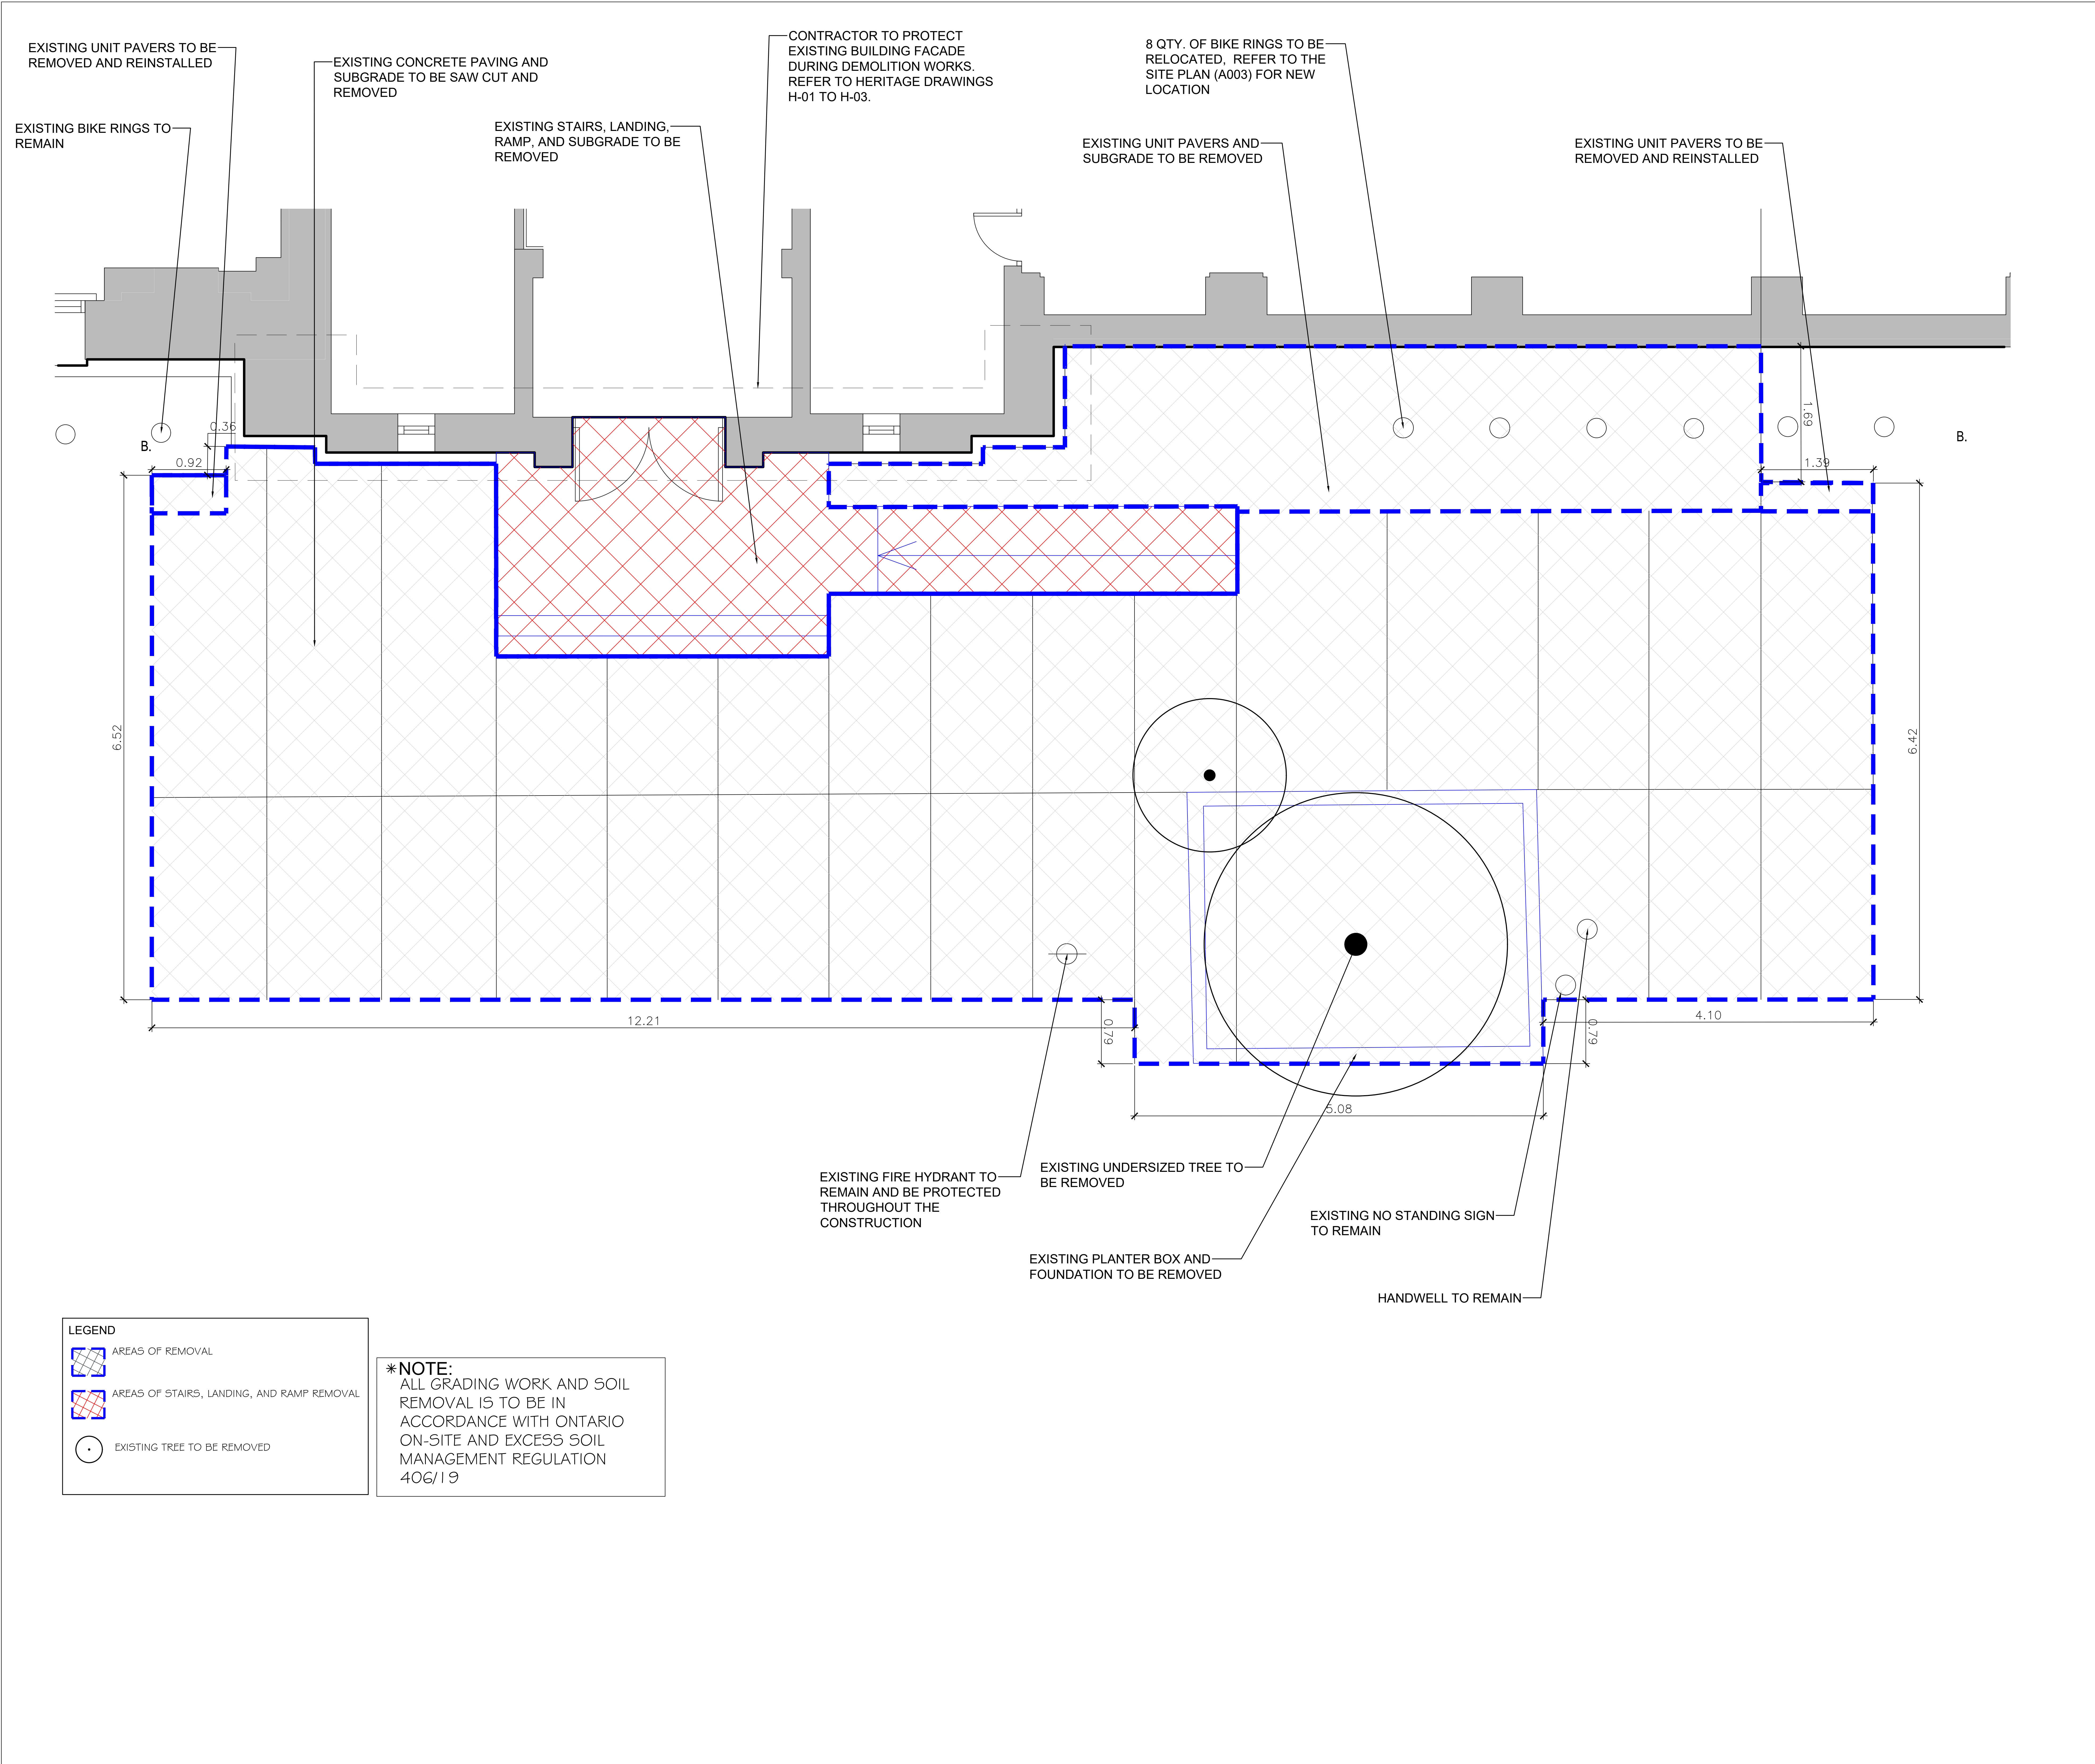

LOCATION MAP

GENERAL NOTES

THE LOCATION OF PROPERTY LINES, ELEVATIONS AND FACILITIES ON THIS PLAN WERE DRAWN ON THE BASIS OF A DIGITAL SITE PLAN OR SURVEY DATA PROVIDED BY OTHER CONSULTANTS.

IT IS THE RESPONSIBILITY OF THE CLIENT AND HIS CONTRACTORS TO CONFIRM THE ACCURACY OF THE SETBACKS, LOCATIONS AND GRADES ETC. ANY VARIATIONS BETWEEN EXISTING CONDITIONS AND THIS PLAN SHOULD BE ADJUSTED ON SITE AND REPORTED TO THE CONSULTING LANDSCAPE ARCHITECT TO DETERMINE THE IMPACT OF THE VARIATIONS ON THE SUITABILITY OF THE PROPOSED DEVELOPMENT.

CONSTRUCTION MUST CONFORM TO ALL CODES AND REQUIREMENTS OF AUTHORITIES HAVING JURISDICTION.

REVISIONS

NO.	DATE	NOTES
01	2024-02-16	BUILDING PERMIT
02	2024-11-01	PROGRESS ISSUANCE
03	2024-11-15	BUILDING PERMIT
04	2025-01-31	ISSUED FOR BID
05	2025-03-25	ADDENDUM # 4



THESE DRAWINGS ARE INSTRUMENTS OF SERVICE AND THE LANDSCAPE ARCHITECT RETAINS OWNERSHIP OF THESE DRAWINGS. THEY ARE FOR SITE PLAN APPROVAL ONLY AND MAY REQUIRE FURTHER CONSTRUCTION DETAILING AND COORDINATION WITH OTHER ASSOCIATED PROFESSIONAL DESIGN SERVICES BEFORE ACTUAL TENDER AND CONSTRUCTION COMMENCES. DIMENSIONS ARE TO BE VERIFIED PRIOR TO CONSTRUCTION. DRAWINGS ARE NOT TO BE SCALED. IT IS ADVISED THAT CONTRACTORS CONTACT THE LANDSCAPE ARCHITECT PRIOR TO CONSTRUCTION TO ENSURE THE USE OF THE LATEST REVISED DRAWINGS. THE LANDSCAPE ARCHITECT IS NOT LIABLE FOR ERRORS OR OMISSIONS ARISING FROM UTILIZATION OF THESE PLANS BEFORE THE SAID DRAWINGS ARE SEALED, SIGNED AND DATED. AND THE LANDSCAPE ARCHITECT IS CONTRACTED TO PROVIDE CONSTRUCTION ADMINISTRATION AND CERTIFICATION SERVICES BY THE OWNER. ALL APPARENT DISCREPANCIES ARE TO BE REPORTED IN WRITING TO THE LANDSCAPE ARCHITECT BEFORE CONSTRUCTION COMMENCES.

KEY PLAN (NTS)

SEAL



PROJECT TITLE

UNIVERSITY OF TORONTO
**HEALTH & WELLNESS
CENTRE AT KOFFLER
RENOVATION**


214 College Street

DRAWING SHEET TITLE

REMOVALS PLAN

DRAWN BY: FL SCALE: 1:25
REVIEWED BY: KF DATE CREATED: 31-OCTOBER-2023

UNIVERSITY PROJECT NUMBER
P143-19-100

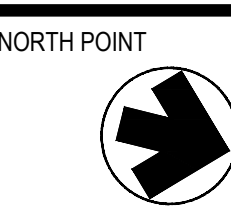

DRAWING NUMBER
L-RP

REV. NUMBER
1



Smith + Andersen

1100 – 100 Sheppard Ave. East, Toronto ON, M2N 6N5

416 487 8151 f 416 487 9104 smithandandersen.com

TENDER ADDENDUM

PROJECT NAME: HEALTH & WELLNESS CENTER RENOVATION AT KOFFLER

COMPANY: ENFORM

ATTENTION: Alan Fraser

PROJECT NO.: 21590.003.M.001

DATE: 2025-03-25

TENDER ADDENDUM: M-04

ISSUED BY: Ali Safi

The following amendments are hereby made as part of the Contract Documents. The following revisions and/or additions shall be made to contract documents and the cost shall be included in the Tender Price.

1.0 MECHANICAL RFI RESPONSES

1.1.1 Please provide a complete equipment schedule. The one provided in the specification document is incomplete.

.1 **Refer to Bid Addendum #3 for updated schedules.**

1.1.2 Some ventilation equipment (AHS-3, 4, 7), RAD zone CV and stats will remain as is. Is the expectation to bring all existing equipment on to new BAS?

.1 **Existing equipment is not to be tied into BAS.**

1.1.3 There is some contradiction in this paragraph. Please confirm if a new riser is required or not.

.1 **New BAS network riser is required.**

1.1.4 Please confirm the scope for the Snow Melt system on BAS.

.1 **Refer to Mechanical Specifications Section 23 09 23 Sequence of Operation for BAS.**

.2 **Monitor/Control points to tie into BAS: override on/off, supply, heat, snow, alert.**

.3 **Refer to Electrical Drawing E600 for snow melt system controller location.**

1.1.5 Please provide HP and details for Domestic Recirculation Pump "P-DHWE-B.1".

.1 **Refer to Mechanical Specifications Section 22 11 23.29 Circulators.**

.2 **0.1 HP, 120V/1Ph/60Hz.**

END OF MECHANICAL TENDER ADDENDUM M-04

POINT LEGEND	
	POINT TYPE
POINT TYPE	DESCRIPTION
AI	ANALOG INPUT
AO	ANALOG OUTPUT
BI	BINARY INPUT
BO	BINARY OUTPUT
PI	PULSE INPUT
	POINT ABBREVIATION
POINT ABBREVIATION	DESCRIPTION
AF	AIR FLOW
AFS	AIR FLOW STATION
BYPD	BYPASS DAMPER
CCV	COOLING COIL VALVE
CDAF	COLD DECK AIR FLOW
CDASP	COLD DECK AIR STATIC PRESSURE
CDAT	COLD DECK AIR TEMPERATURE
CDD	COLD DECK DAMPER
CHWDP	CHILLED WATER DIFFERENTIAL PRESSURE
CHXAMP	CHILLER XX AMPS
CHXXCHWT	CHILLER XX CHILLED WATER ENTERING TEMPERATURE
CHXXCHWF	CHILLER XX CHILLED WATER FLOW
CHXXCHWLT	CHILLER XX WATER LEAVING TEMPERATURE
CHXXCHWSTSP	CHILLER XX CHILLED WATER SUPPLY TEMPERATURE SET POINT
CHXXCHWV	CHILLER XX CHILLED WATER VALVE
CHXXCMV	CHILLER XX CONDENSER WATER VALVE
CHXXCMCV	CHILLER XX CONDENSER WATER CONTROL VALVE
CHXXCWET	CHILLER XX CONDENSER WATER ENTERING TEMPERATURE
CHXXCWL	CHILLER XX CONDENSER WATER LEAVING TEMPERATURE
CHXXCWV	CHILLER XX CONDENSER WATER VALVE
CHXKEN	CHILLER XX ENABLE
CHXXHWSOV	CHILLER XX HEATING WATER ISOLATION VALVE
CHXXLHWRT	CHILLER XX LOW HEATING WATER RETURN TEMPERATURE
CHXXLHWST	CHILLER XX LOW HEATING WATER SUPPLY TEMPERATURE
COMP	COMPRESSOR
CDWVT	DECOUPLER CHILLED WATER TEMPERATURE
EAD	EXHAUST AIR DAMPER
EADES	EXHAUST AIR DAMPER END SWITCH
EAT	ENTERING AIR TEMPERATURE
EFSS	EXHAUST FAN START/STOP
EFST	EXHAUST FAN STATUS
F	FIRESTAT
FFPD	FINAL FILTER PRESSURE DIFFERENTIAL
FZ	FREEZE/STAT
GAL	GENERAL ALARM
GLR	GLYCOL RETURN
QLS	GLYCOL SUPPLY
GLYPX	GLYCOL PUMP
HCV	HEATING COIL VALVE
HDAF	HOT DECK AIR FLOW
HDD	HOT DECK DAMPER
HDGAH	HOT DECK SUPPLY AIR HUMIDIFIER
HP	HIGH PRESSURE SWITCH


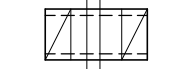
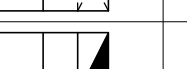



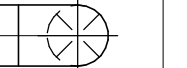
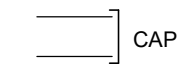



 

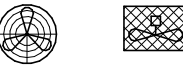
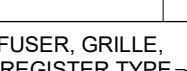
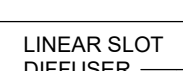
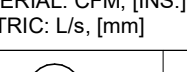
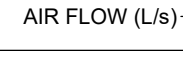

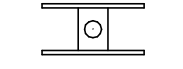
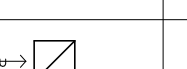
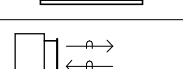

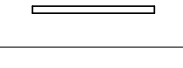





 




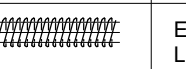
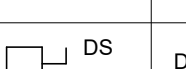
10. POINT LEGEND
(TM4.1)

--

12. NOT USED
(TM4.1)




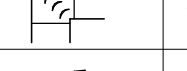


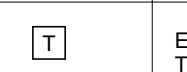
	POINT ABBREVIATION
POINT ABBREVIATION	DESCRIPTION
HTWE	HEAT WHEEL ENABLE
HTWLAT	HEAT WHEEL LEAVING AIR TEMPERATURE
LAT	HEAT WHEEL VARIABLE SPEED DRIVE
HUME	HUMIDIFIER ENABLE
HUMV	HUMIDIFIER VALVE
HWP	HOT WATER PUMP
HWR	HOT WATER RETURN
HWRT	HOT WATER RETURN TEMPERATURE
HWRV	HOT WATER RETURN VALVE
HWS	HOT WATER SUPPLY
HWST	HOT WATER SUPPLY TEMPERATURE
HWSTSP	HOT WATER SUPPLY TEMPERATURE SET POINT
LAT	LEAVING AIR TEMPERATURE
LTHWDP	LOW TEMPERATURE HEATING WATER DIFFERENTIAL PRESSURE
LTHWPXKEN	LOW TEMPERATURE HEATING PUMP XX
LTHWPXFB	LOW TEMPERATURE HEATING PUMP XX FEED BACK
LTHWPXVFD	LOW TEMPERATURE HEATING PUMP XX VARIABLE FREQUENCY DRIVE
OAD	OUTSIDE AIR DAMPER
OADES	ROUND RETURN OR EXHAUST END SWITCH
POHWST	PRIMARY CHILLED WATER SUPPLY TEMPERATURE
PPFD	PRE-FILTER PRESSURE DIFFERENTIAL
PHCV	PRE-HEAT COIL VALVE
PP	PRIMARY PUMP
PPXKEN	PRIMARY PUMP XX ENABLE
PPXFB	PRIMARY PUMP XX FEED BACK
PPXVFD	PRIMARY PUMP XX VARIABLE FREQUENCY DRIVE
RADV	RADIANT VALVE
RAF	RETURN AIR FLOW
RAH	RETURN AIR HUMIDITY
RAT	RETURN AIR TEMPERATURE
RHV	REHEAT VALVE
RVLV	REVERSING VALVE
SAT	SUPPLY AIR TEMPERATURE
SAH	SUPPLY AIR HUMIDITY
SCHWF	SECONDARY CHILLED WATER FLOW
SCHWRT	SECONDARY CHILLED WATER RETURN TEMPERATURE
SCHWST	SECONDARY CHILLED WATER SUPPLY TEMPERATURE
SF	SERIES FAN
SFSS	SUPPLY FAN START/STOP
SFST	SUPPLY FAN STATUS
SP	SECONDARY PUMP
SPCT	SPACE TEMPERATURE
SPXKEN	SECONDARY PUMP XX ENABLE
SPXFB	SECONDARY PUMP XX FEED BACK
SPXVFD	SECONDARY PUMP XX VARIABLE FREQUENCY DRIVE
VAVD	VAV DAMPER
ZD	ZONE DAMPER

11. NOT USED
(TM4.1)

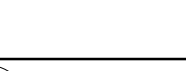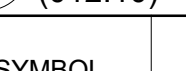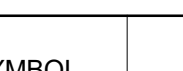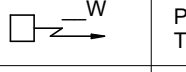SYMBOL	DESCRIPTION	SYMBOL	DESCRIPTION
	SUPPLY DUCT UP OR FROM ABOVE		ACOUSTICALLY LINED TRANSFER AIR DUCT
	SUPPLY DUCT DOWN OR FROM BELOW		SILENCER
	RETURN OR EXHAUST DUCT UP OR FROM ABOVE		CROSSTALK SILENCER
	RETURN OR EXHAUST DUCT DOWN OR FROM BELOW		DUCT WITH MINIMUM CLEARANCE FIRE RATED ENCLOSURE
	ROUND DUCT UP OR FROM ABOVE		DUCT WITH SLEEVE, INSULATION, AND DAMPER
	ROUND DUCT DOWN OR FROM BELOW		CAPPED CONNECTION
	ACOUSTIC LINED DUCT		RISE IN DUCT
	FLEXIBLE CONNECTION		DROP IN DUCT
	SQUARE ELBOW DUCT WITH TURNING VANES		SOUND Baffle
	RADIUS ELBOW WITH TURNING VANES		PROPELLER FAN WITH PROTECTIVE SCREEN
	AXIAL FAN / INLINE FAN MIXED FLOW OR CENTRIFUGAL		LINEAR SLOT DIFFUSER
	DIFFUSER, GRILLE, OR REGISTER TYPE		IMPERIAL CFM (INCH) METRIC L/S (MM)
	ROUND SUPPLY DIFFUSER		SUPPLY AIR DIFFUSER CW FLEXIBLE DUCT
	DUCTED RETURN OR EXHAUST REGISTER OR GRILLE		LIGHT TROFFER DIFFUSER TOP INLET CW FLEXIBLE DUCT
	SQUARE OR RECTANGULAR DIFFUSER		LIGHT TROFFER DIFFUSER SIDE INLET CW FLEXIBLE DUCT
	RETURN OR EXHAUST GRILLE		DUCT MOUNTED SUPPLY OR RETURN GRILLE
	ROUND RETURN OR EXHAUST GRILLE		LINEAR SUPPLY OR RETURN GRILLE
	SQUARE DIFFUSER		
	DIFFUSER WITH BLANK-OFF PORTION (QTY SHOWN)		

NOTE: NOT ALL SYMBOLS APPLY. REFER TO FLOOR PLANS AND DRAWINGS

7. AIR HANDLING SYMBOLS AND ABBREVIATIONS
(TM4.1) (012.10)

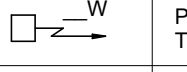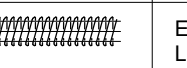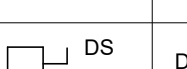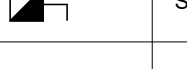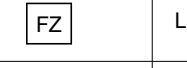
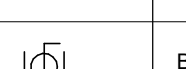
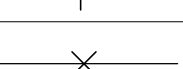
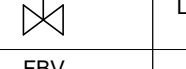
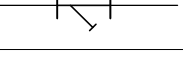

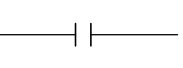







 
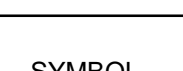
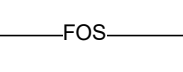

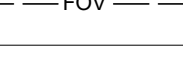
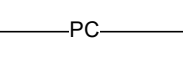
SYMBOL	DESCRIPTION	SYMBOL	DESCRIPTION
	POWER REQUIREMENT FOR ELECTRIC TRACING	PE	PNEUMATIC-ELECTRIC
	ELECTRIC PIPE TRACING FOR SINGLE LINE PIPES	C	CONTROLLER
	ELECTRIC PIPE TRACING FOR DOUBLE LINE PIPES	TS	TEMPERATURE SENSOR
	MOTOR CONTROL CENTRE	HS	HUMIDITY SENSOR
	DISCONNECT SWITCH		AIR FLOW MONITORING STATION
	SWITCH (MANUAL STARTER)	BP	STATIC
HOA	HAND-OFF AUTO	VFD	VARIABLE FREQUENCY DRIVE
FZ	LOW TEMPERATURE THERMOSTAT	CO	CARBON MONOXIDE SENSOR
FS	HIGH TEMPERATURE THERMOSTAT	RS	REFRIGERANT SENSOR
T	ELECTRIC LOW VOLTAGE THERMOSTAT/SENSOR	CO2	CARBON DIOXIDE SENSOR
PT	PNEUMATIC THERMOSTAT	NO2	NITROGEN DIOXIDE SENSOR
F	FLOW SWITCH	AFS	AIR FLOW STATION
S	SPEED SWITCH	PS	PRESSURE SENSOR
T	THERMOSTAT WITH LOCKABLE TAMPER GUARD	BTU	BTU METER

NOTE: NOT ALL SYMBOLS APPLY. REFER TO FLOOR PLANS AND DRAWINGS

8. ELECTRICAL AND CONTROLS SYMBOLS AND ABBREVIATIONS
(TM4.1) (012.11)

--

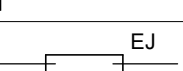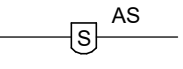9. NOT USED
(TM4.1)

SYMBOL	DESCRIPTION	SYMBOL	DESCRIPTION
	ISOLATION VALVE (REFER TO SPECIFICATION FOR SPECIFIC TYPE AS REQUIRED)		PIPE GUIDE (REFER TO SPECIFICATIONS)
	GLOBE VALVE		PIPE SLEEVE
	BALL VALVE		ANCHOR
	LOCKSHIELD VALVE		STRAINER
FBV	FLOW BALANCING VALVE		UNION
PIEBV	PRESSURE INDEPENDENT FLOW BALANCING VALVE		FLANGE FITTING
PRV	NATURAL PRESSURE REDUCING VALVE ASSEMBLY		ECCENTRIC FITTING
CHECK VALVE	CHECK VALVE		CENTRIC FITTING
SOLENOID VALVE	SOLENOID VALVE		PRESSURE GAUGE
SAFETY RELIEF VALVE	SAFETY RELIEF VALVE		THERMOMETER
FLOW METERING STATION	FLOW METERING STATION		PRESSURE GAUGE COCK ASSEMBLY
BACKFLOW PREVENTOR	BACKFLOW PREVENTOR		THERMOMETER WELL
ANGLE VALVE	ANGLE VALVE		EXPANSION JOINT
BUTTERFLY VALVE	BUTTERFLY VALVE		MANUAL AIR VENT
2-WAY BUTTERFLY VALVE	2-WAY BUTTERFLY VALVE		AUTOMATIC AIR VENT
TEMPERED MIXING VALVE	TEMPERED MIXING VALVE		AIR SEPARATOR
FLEXIBLE JOINT	FLEXIBLE JOINT		SIGHT GLASS
VACUUM BREAKER	VACUUM BREAKER		PUMP
BACK WATER VALVE	BACK WATER VALVE		DOMESTIC WATER PIV STATION
			WATER HAMMER ARRESTOR


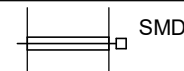

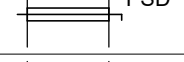
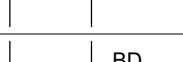

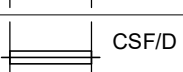
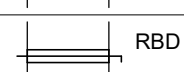
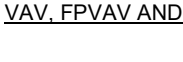

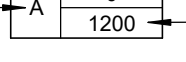

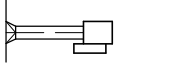
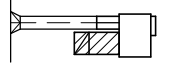
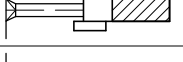
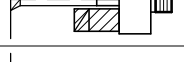



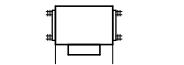

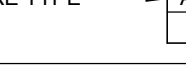
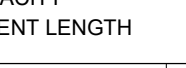
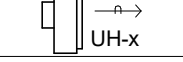

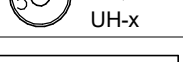
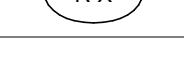
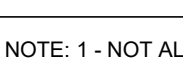

NOTE: NOT ALL SYMBOLS APPLY. REFER TO FLOOR PLANS AND DRAWINGS

4. VALVE AND COMPONENT SYMBOLS AND ABBREVIATIONS
(TM4.1) (012.06)

SYMBOL	DESCRIPTION	SYMBOL	DESCRIPTION
HWS	HEATING WATER SUPPLY	FOS	FUEL OIL SUPPLY
HWR	HEATING WATER RETURN	FOR	FUEL OIL RETURN
CHS	CHILLED WATER SUPPLY	EFOV	EMERGENCY FUEL OIL VENT
CHR	CHILLED WATER RETURN	FOV	FUEL OIL VENT
GLS	GLYCOL SUPPLY	FOF	FUEL OIL FILL
GLR	GLYCOL RETURN	PC	PUMPED STEAM CONDENSATE
QLHS	GLYCOL HEATING SUPPLY	RS	REFRIGERATION SUCTION
QLHR	GLYCOL HEATING RETURN	RL	REFRIGERATION LIQUID
QLCS	GLYCOL COOLING SUPPLY	RHG	REFRIGERATION HOT GAS
QLCR	GLYCOL COOLING RETURN	DTS	DUAL TEMPERATURE SUPPLY
CDS	CONDENSER WATER SUPPLY	DTR	DUAL TEMPERATURE RETURN
CDR	CONDENSER WATER RETURN	BT	BUCKET TYPE STEAM TRAP
LPS	LOW PRESSURE STEAM	FT	FLOAT AND THERMOSTAT TYPE STEAM TRAP
MPS	MEDIUM PRESSURE STEAM	SVB	STEAM VACUUM BREAKER
HPS	HIGH PRESSURE STEAM	TEV	REFRIGERATION THERMAL EXPANSION VALVE
LPC	LOW PRESSURE CONDENSATE	SLV	REFRIGERATION SOLENOID LIQUID VALVE
MPC	MEDIUM PRESSURE CONDENSATE	RFD	REFRIGERATION FILTER DRYER
HPC	HIGH PRESSURE CONDENSATE	6 WAY CONTROL VALVE ELECTRIC	
PICV	PRESSURE INDEPENDENT CONTROL VALVE	6 WAY CONTROL VALVE	
2 WAY CONTROL VALVE		CONTROL VALVE (WHERE SYMBOL NOT SHOWN)	
3 WAY CONTROL VALVE			














NOTE: NOT ALL SYMBOLS APPLY. REFER TO FLOOR PLANS AND DRAWINGS

5. MECHANICAL PIPING SYMBOLS AND ABBREVIATIONS
(TM4.1) (012.08)

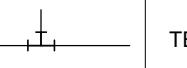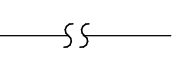





SYMBOL	DESCRIPTION	SYMBOL	DESCRIPTION
	FIRE DAMPER		SMOKE DAMPER
	MOTOR OPERATED DAMPER		POSITIVE SEAL DAMPER
	MANUAL DAMPER		GRAVITY OR BACKDRAFT DAMPER
	BALANCING DAMPER		VOLUME EXTRACTOR
	COMBINATION SMOKE AND FIRE DAMPER		REMOTE OPERATED BALANCING DAMPER
VAV, CPVAV AND AFS TAG			
VAV BOX TYPE		VAV BOX TYPE	
MIN. PRIMARY FLOW FAN POWERED VAV BOX TYPE	0 1200 MIN. FLOW (L/s) MAX. FLOW (L/s)	0 1200(600) MIN. FLOW (L/s) MAX. FLOW (L/s) COOLING/HEATING MAX. FLOW (L/s) COOLING/HEATING	
	120/1000 1100 MAX. PRIMARY FLOW (L/s) SECONDARY FLOW (L/s) REHEAT COIL CAPACITY (KW)		REHEAT COIL CAPACITY (KW)
		IMPERIAL CFM (IN.) METRIC L/s (MM)	
	VAV BOX (VARIABLE AIR VOLUME)		FAN POWERED BOX CW RETURN AIR SILENCER OR ACOUSTICALLY LINED RETURN AIR
	VAV BOX WITH ATTENUATOR		FAN POWERED BOX CW RETURN AIR SILENCER OR ACOUSTICALLY LINED RETURN AIR WITH REHEAT COIL
	VAV BOX WITH REHEAT COIL		INDUCTION VAV BOX
	VAV BOX WITH REHEAT COIL AND ATTENUATOR		PRESSURE INDEPENDENT AIR VALVE (IAB)
			TERMINAL UNIT (SEE NOTE 2)
HEATING ELEMENT TAG			
ENCLOSURE TYPE		ENCLOSURE TYPE	
			
0 1200W HEATING CAPACITY ACTIVE ELEMENT LENGTH		0 1200W HEATING CAPACITY ACTIVE ELEMENT LENGTH	
	HORIZONTAL UNIT HEATER		DUCT COIL
	DOWN BLAST UNIT HEATER		RADIATION HEATING RISER NUMBERS (S-SUPPLY AND R-RETURN)
	RADIANT HEATING PANEL		WALL FIN ELEMENT IN CONTINUOUS ENCLOSURE
NOTE 1: NOT ALL SYMBOLS APPLY. REFER TO FLOOR PLANS AND DRAWINGS. NOTE 2: SYMBOLS ARE DIAGRAMMATIC IN NATURE. REFER TO SPECIFICATIONS/SCHEDULES FOR EXACT DIMENSIONS/CLEARANCES			

  NOTE: 1 - NOT ALL SYMBOLS APPLY. REFER TO FLOOR PLANS AND DRAWINGS
NOTE: 2 - SYMBOLS ARE DIAGRAMMATIC IN NATURE. REFER TO SPECIFICATIONS/SCHEDULES FOR EXACT DIMENSIONS/CLEARANCES


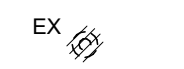




6. AIR HANDLING SYMBOLS AND ABBREVIATIONS
(TM4.1) (012.09)

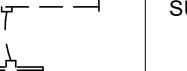SYMBOL	DESCRIPTION	SYMBOL	DESCRIPTION
	DETAIL NUMBER		DRAWING NUMBER
	REVISION NUMBER		REVISION BUBBLE
	ELBOWS		PIPING SERVICE CONTINUES
	TEE		REFER TO STANDARD DETAIL DRAWINGS FOR ADDITIONAL REQUIREMENTS OF EQUIPMENT NOTED
	BRANCH OFF BOTTOM OF MAIN		VENT PIPE REDUCER
	BRANCH OFF TOP OF MAIN		AIR QUANTITY CFM (L/s)
	DIRECTION OF FLOW		

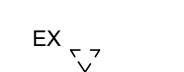NOTE: EXISTING EQUIPMENT, PIPING, VALVES, DUCTWORK SHOWN LIGHT TO REMAIN.




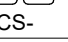
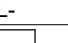


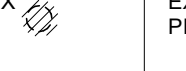
	EXISTING DUCT, FLEX DUCT, AND AIR SUPPLY TO BE REMOVED		EXISTING CONCEALED SPRINKLER HEAD & PIPING TO REMAIN
	EXISTING ELECTROPHILUMETIC THERMOSTAT/TEMPERATURE SENSOR AND SPEED CONTROL SWITCH TO REMAIN		EXISTING PENDANT SPRINKLER HEAD & PIPING TO REMAIN
	EXISTING UPRIGHT SPRINKLER HEAD & PIPING TO REMAIN		EXISTING SIDEWALL OR WINDOW SPRINKLER HEAD & PIPING TO REMAIN

NOTE: EXISTING EQUIPMENT, PIPING, VALVES, DUCTWORK SHOWN HATCHED TO BE REMOVED AND/OR RELOCATED.


	EXISTING DUCT, FLEX DUCT, AND AIR SUPPLY TO BE REMOVED		EXISTING CONCEALED SPRINKLER HEAD & PIPING TO BE REMOVED/RELOCATED
	EXISTING ELECTROPHILUMETIC THERMOSTAT/TEMPERATURE SENSOR AND SPEED CONTROL SWITCH TO BE REMOVED/RELOCATED		EXISTING PENDANT SPRINKLER HEAD & PIPING TO BE REMOVED/RELOCATED
	EXISTING UPRIGHT SPRINKLER HEAD & PIPING TO BE REMOVED/RELOCATED		EXISTING SIDEWALL OR WINDOW SPRINKLER HEAD & PIPING TO BE REMOVED/RELOCATED

NOTE: NOT ALL SYMBOLS APPLY. REFER TO FLOOR PLANS AND DRAWINGS


1. GENERAL SYMBOLS AND ABBREVIATIONS
(TM4.1) (012.13)

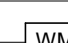SYMBOL	DESCRIPTION	SYMBOL	DESCRIPTION
	FLOOR DRAIN, SIZE AS NOTED, REFER TO SPECIFICATION FOR TYPES		DOMESTIC COLD WATER (DOM. COLD WATER) (DCW)
	FUNNEL FLOOR DRAIN, SIZE AS NOTED, REFER TO SPECIFICATION FOR TYPES		DOMESTIC HOT WATER (DOM. HOT WATER) (DHW)
	UPTURNED CLEANOUT		DOMESTIC HOT WATER RECIRCULATION (DOM. HOT WATER RECIRC.) (DHWRC)
	HORIZONTAL CLEANOUT		TEMPERED WATER
	FLOOR DRAIN FROM ABOVE WITH TRAP		NATURAL GAS
	FUNNEL FLOOR DRAIN FROM ABOVE WITH TRAP		NATURAL GAS VENT
	WATER CLOSET AS NOTED, REFER TO SPECIFICATION FOR TYPES		VENT
	URINAL		SANITARY ABOVE GRADE OR FLOOR
	SINGLE COMPARTMENT KITCHEN SINK		SANITARY BELOW GRADE OR FLOOR
	DOUBLE COMPARTMENT SINK		GATE OR ISOLATION VALVE (REFER TO SPECIFICATION)
	WALL HUNG LAVATORY		GLOBE VALVE
	MOP SINK		BALL VALVE
	DRINKING FOUNTAIN		PENDANT SPRINKLER HEAD
	WET SPRINKLER LINE		DRY PENDANT SPRINKLER HEAD
	DRY SPRINKLER LINE		UPRIGHT SPRINKLER HEAD
	FIRE HOSE CABINET AND TYPE		CONCEALED SPRINKLER HEAD
	SPRINKLER SHUT-OFF VALVE CABINET AND TYPE		NON-FREEZE SPRINKLER HEAD
	FIRE EXTINGUISHER AND TYPE		HIGH TEMPERATURE SPRINKLER HEAD
	FIRE EXTINGUISHER CABINET AND TYPE		CHEMICAL SPRINKLER HEAD
	FIRE REEL AND TYPE		SIDEWALL SPRINKLER HEAD
	WATER METER		WINDOW SPRINKLER HEAD
	BACK FLOW PREVENTOR		


NOTE: NOT ALL SYMBOLS APPLY, REFER TO FLOOR PLANS AND DRAWINGS

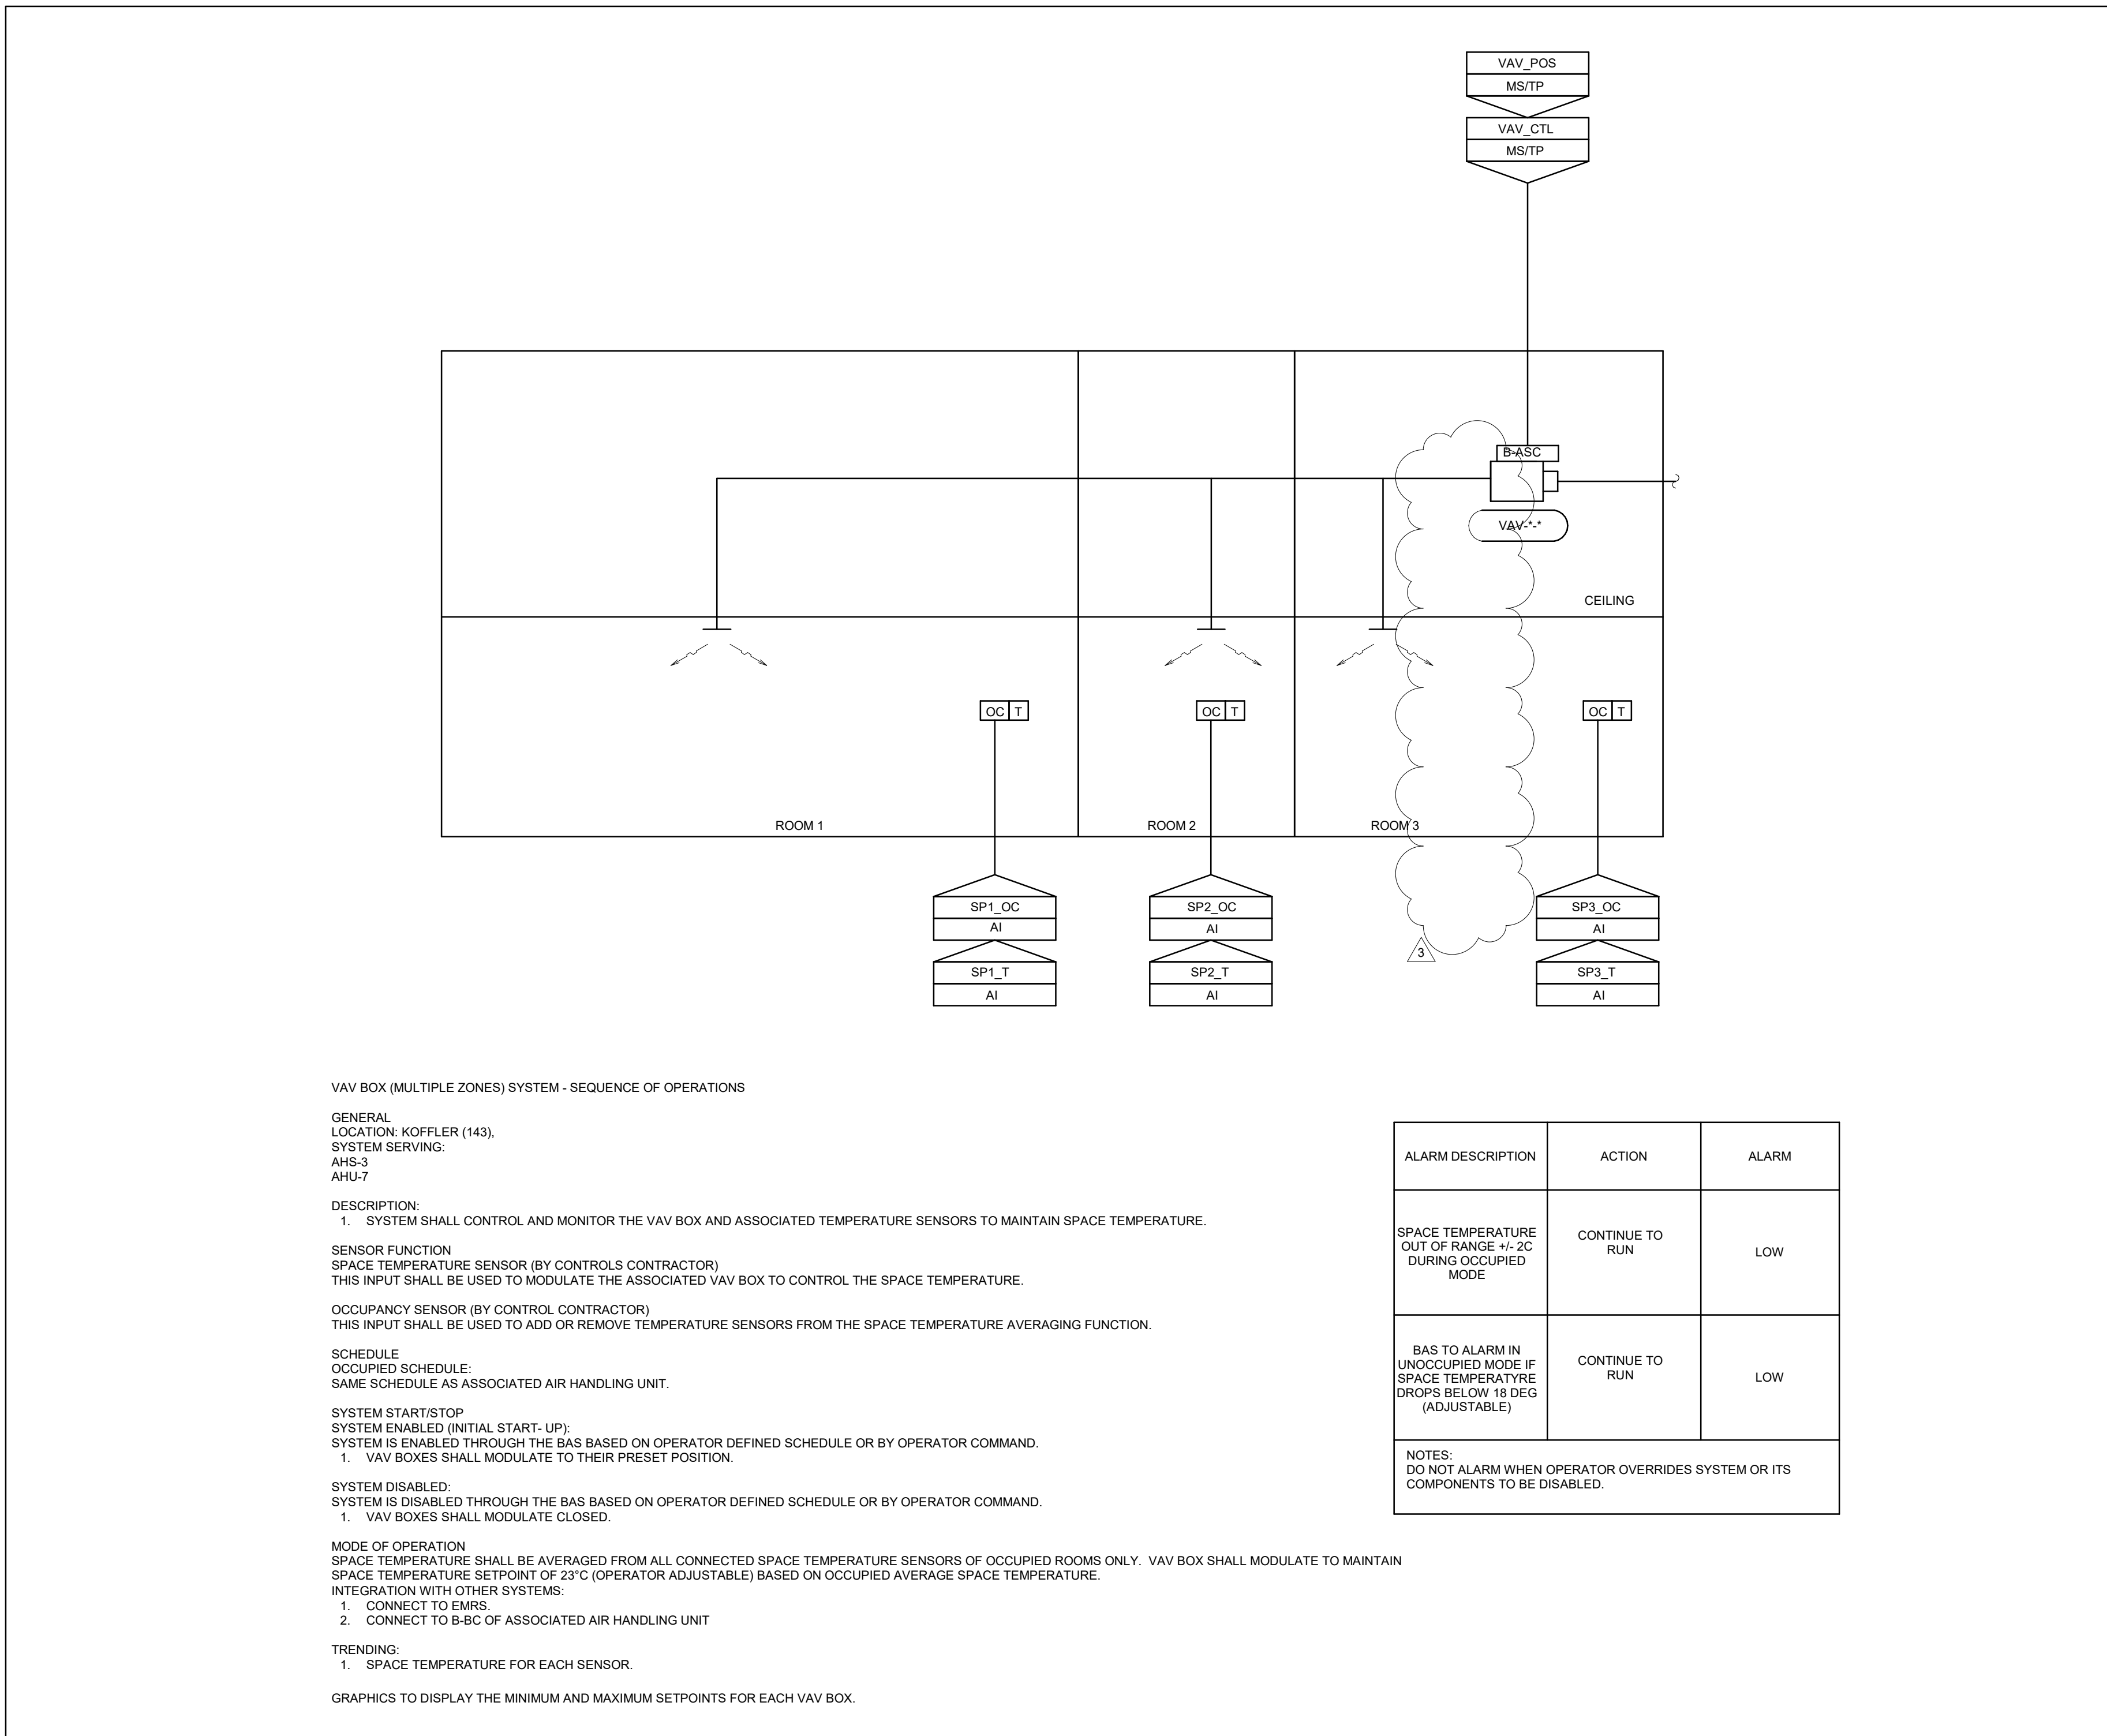


3 MULTI-ZONE BOXES CONTROL DIAGRAM AND SEQUENCE

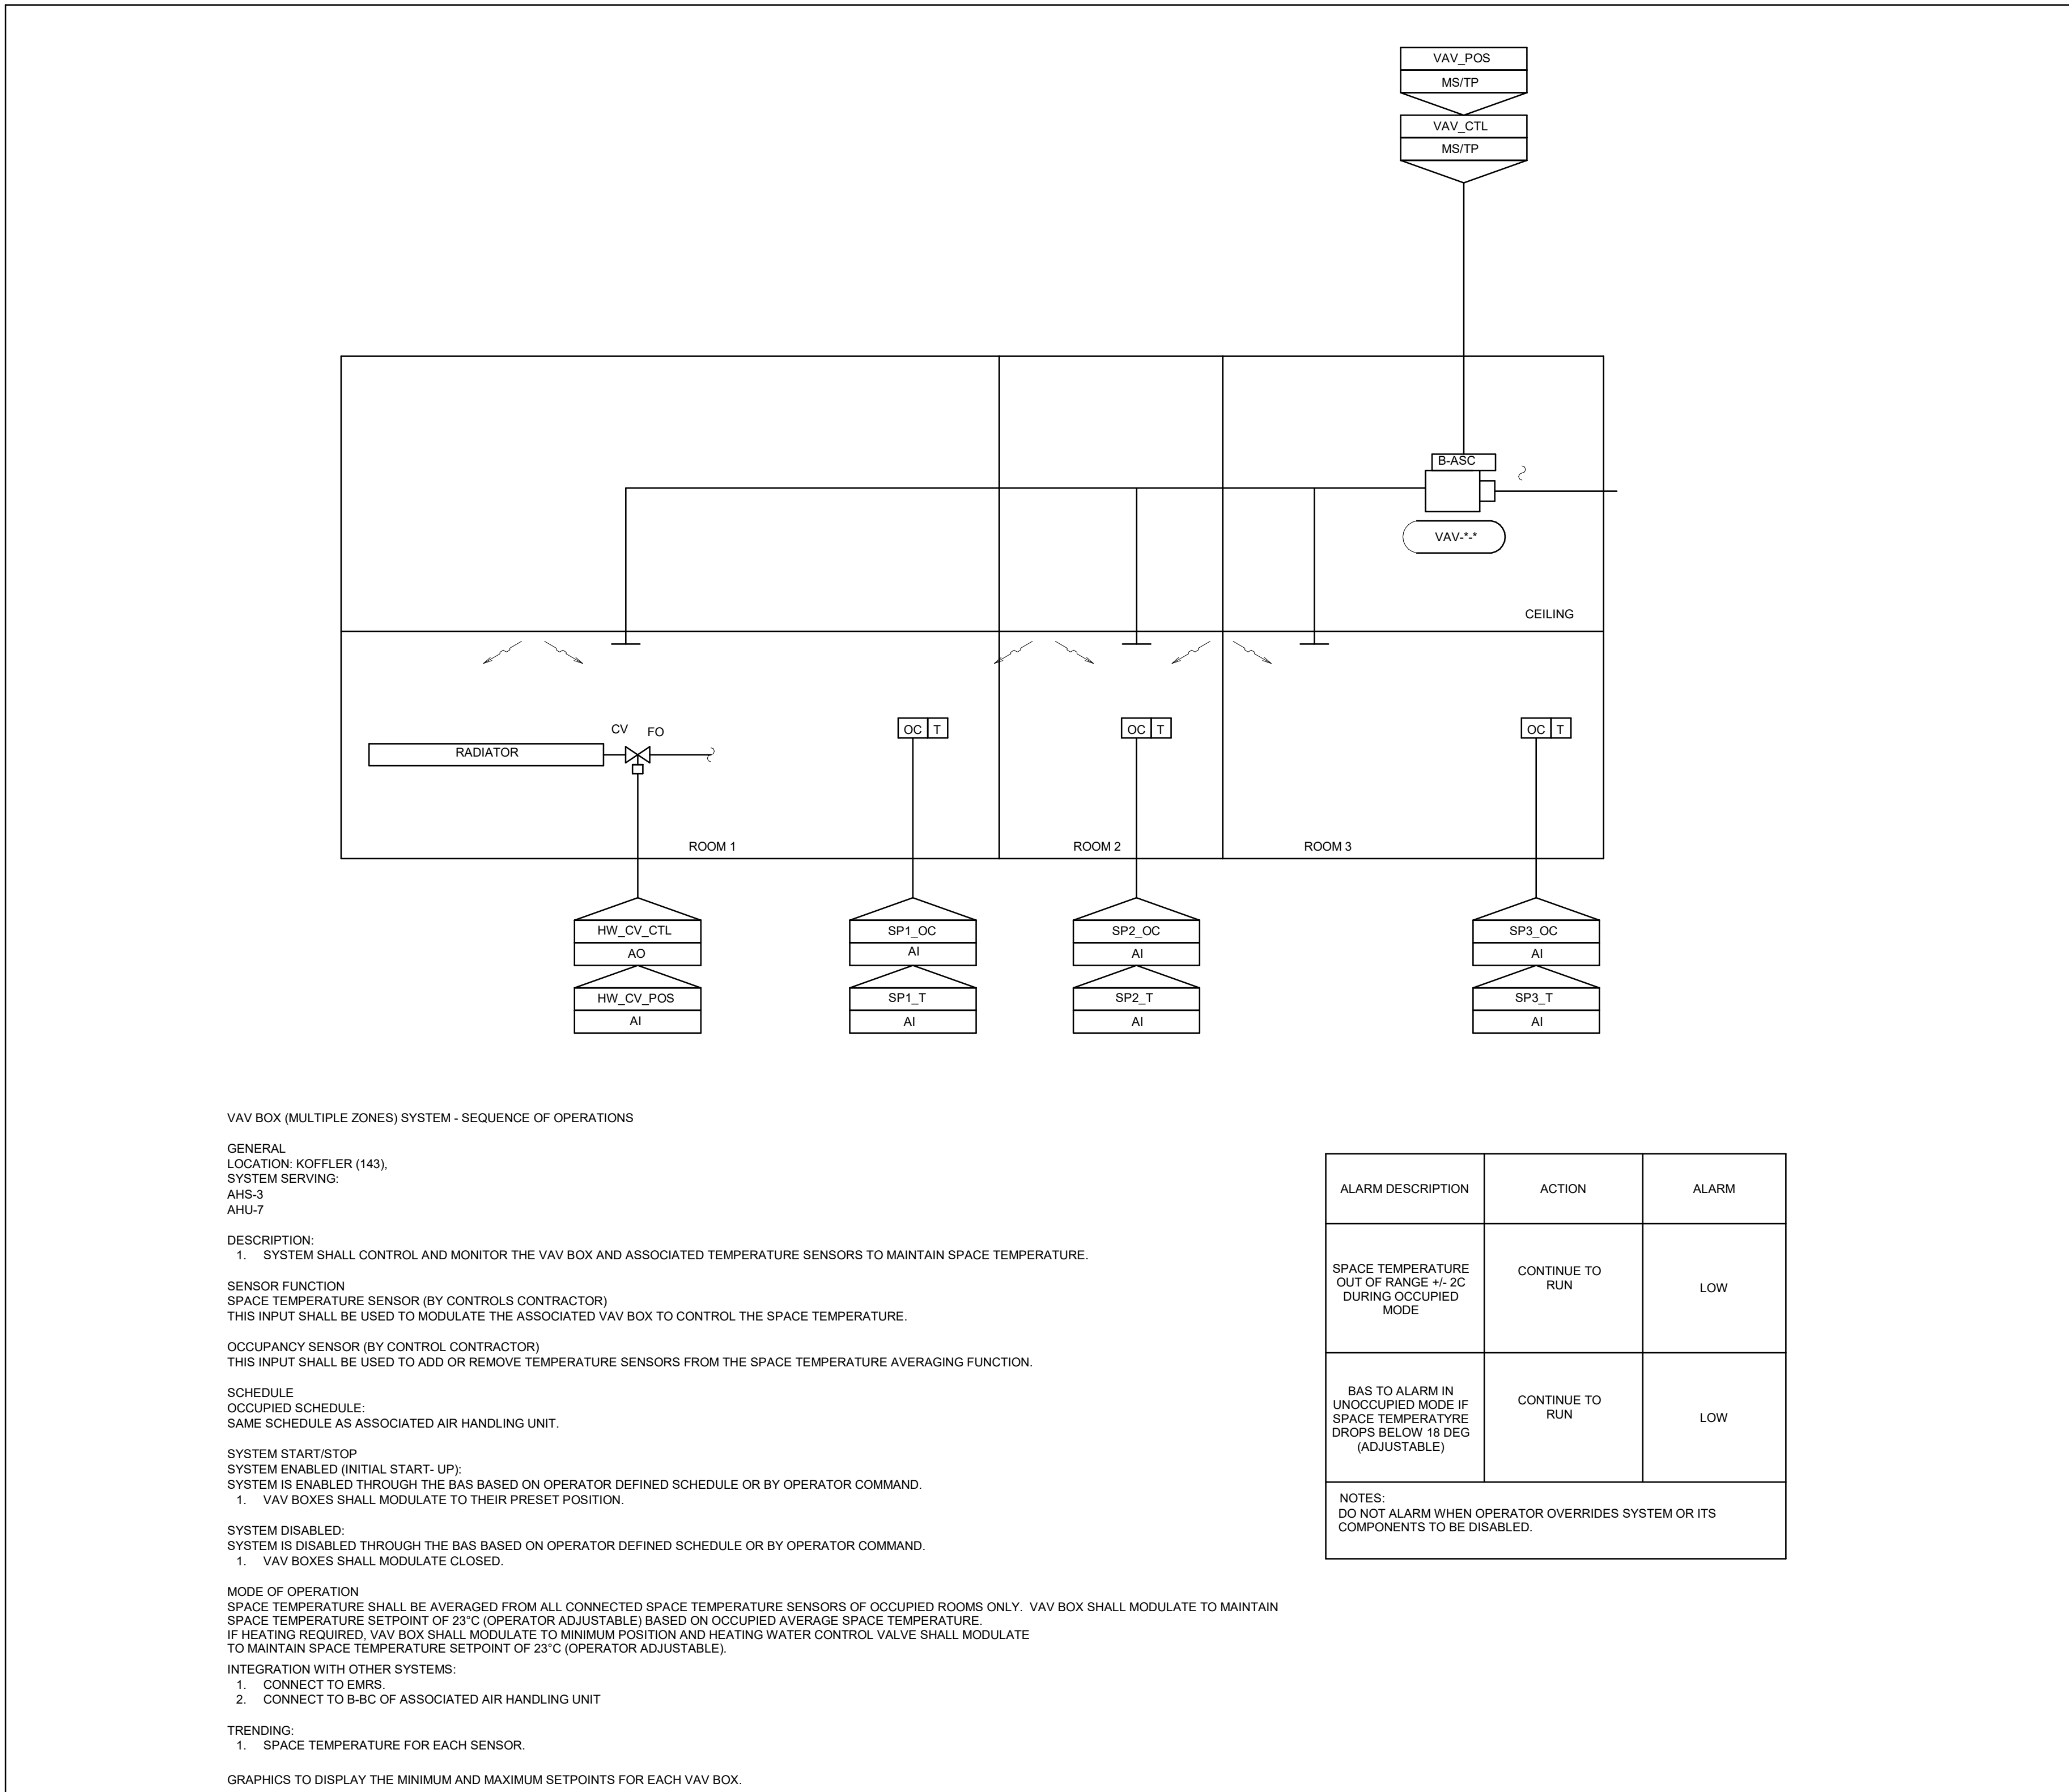

4 MULTI-ZONE BOXES WITH RADIATORS CONTROL DIAGRAM AND SEQUENCE

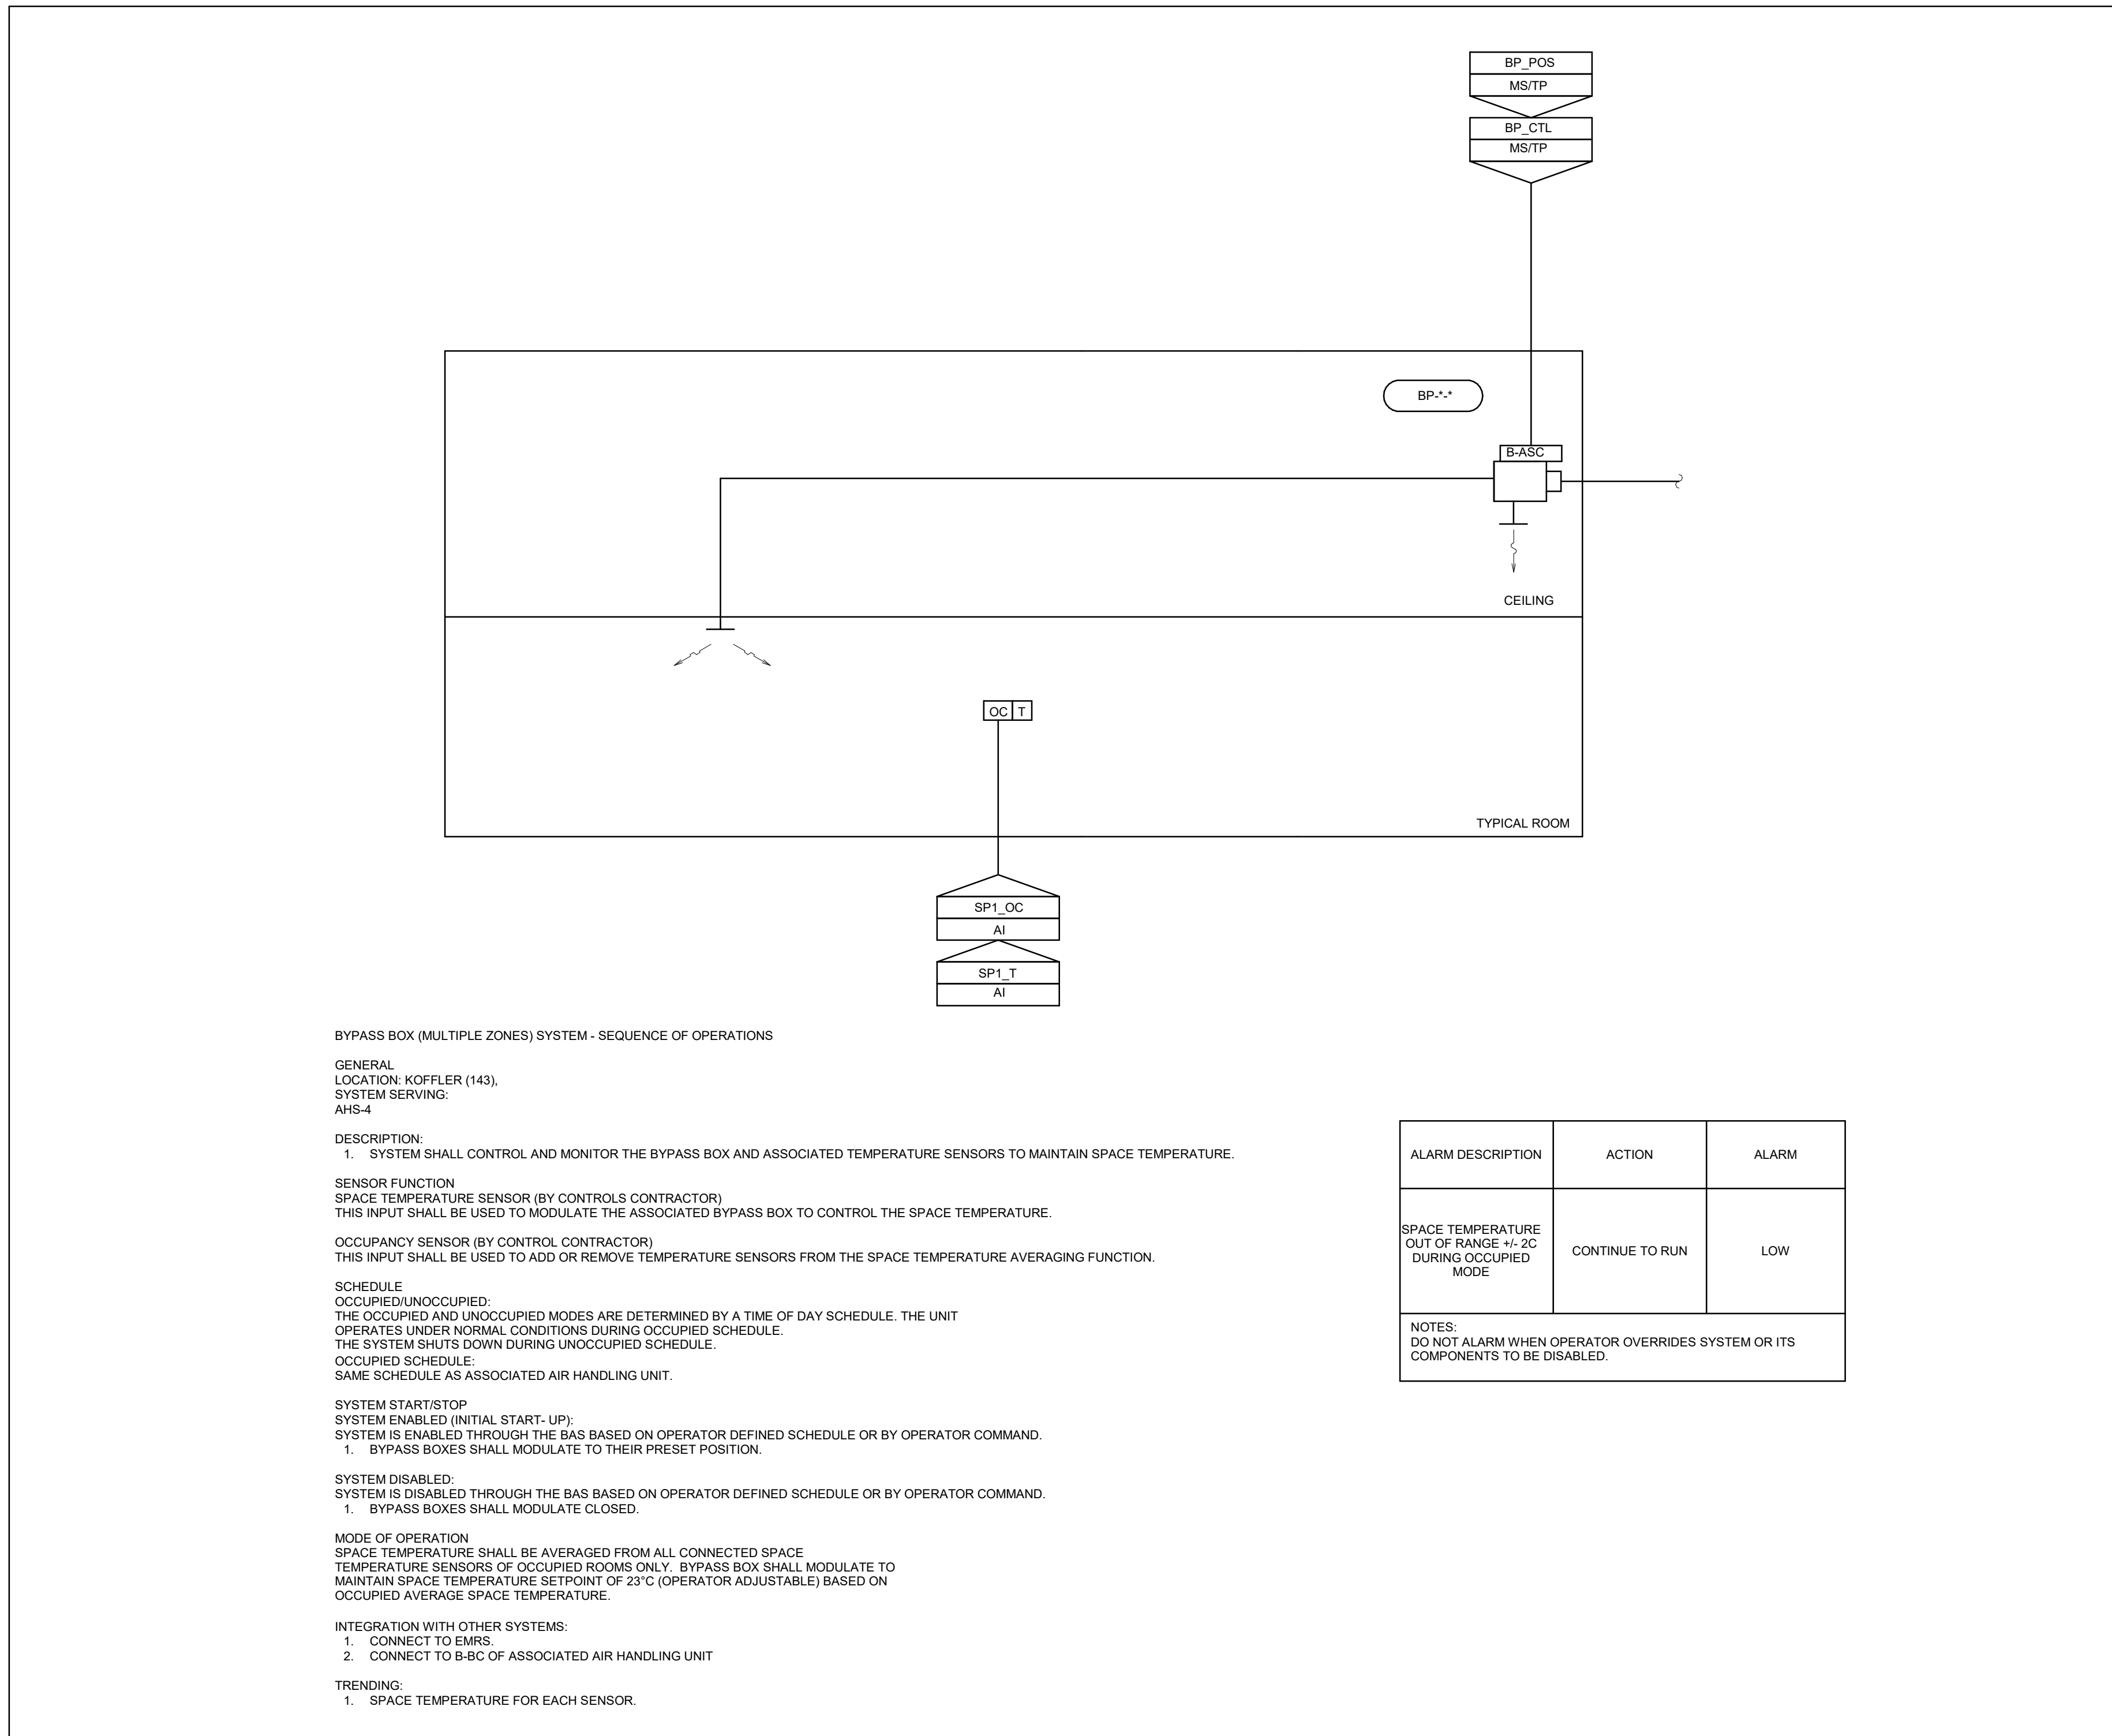


1 BY PASS BOX CONTROL DIAGRAM AND SEQUENCE

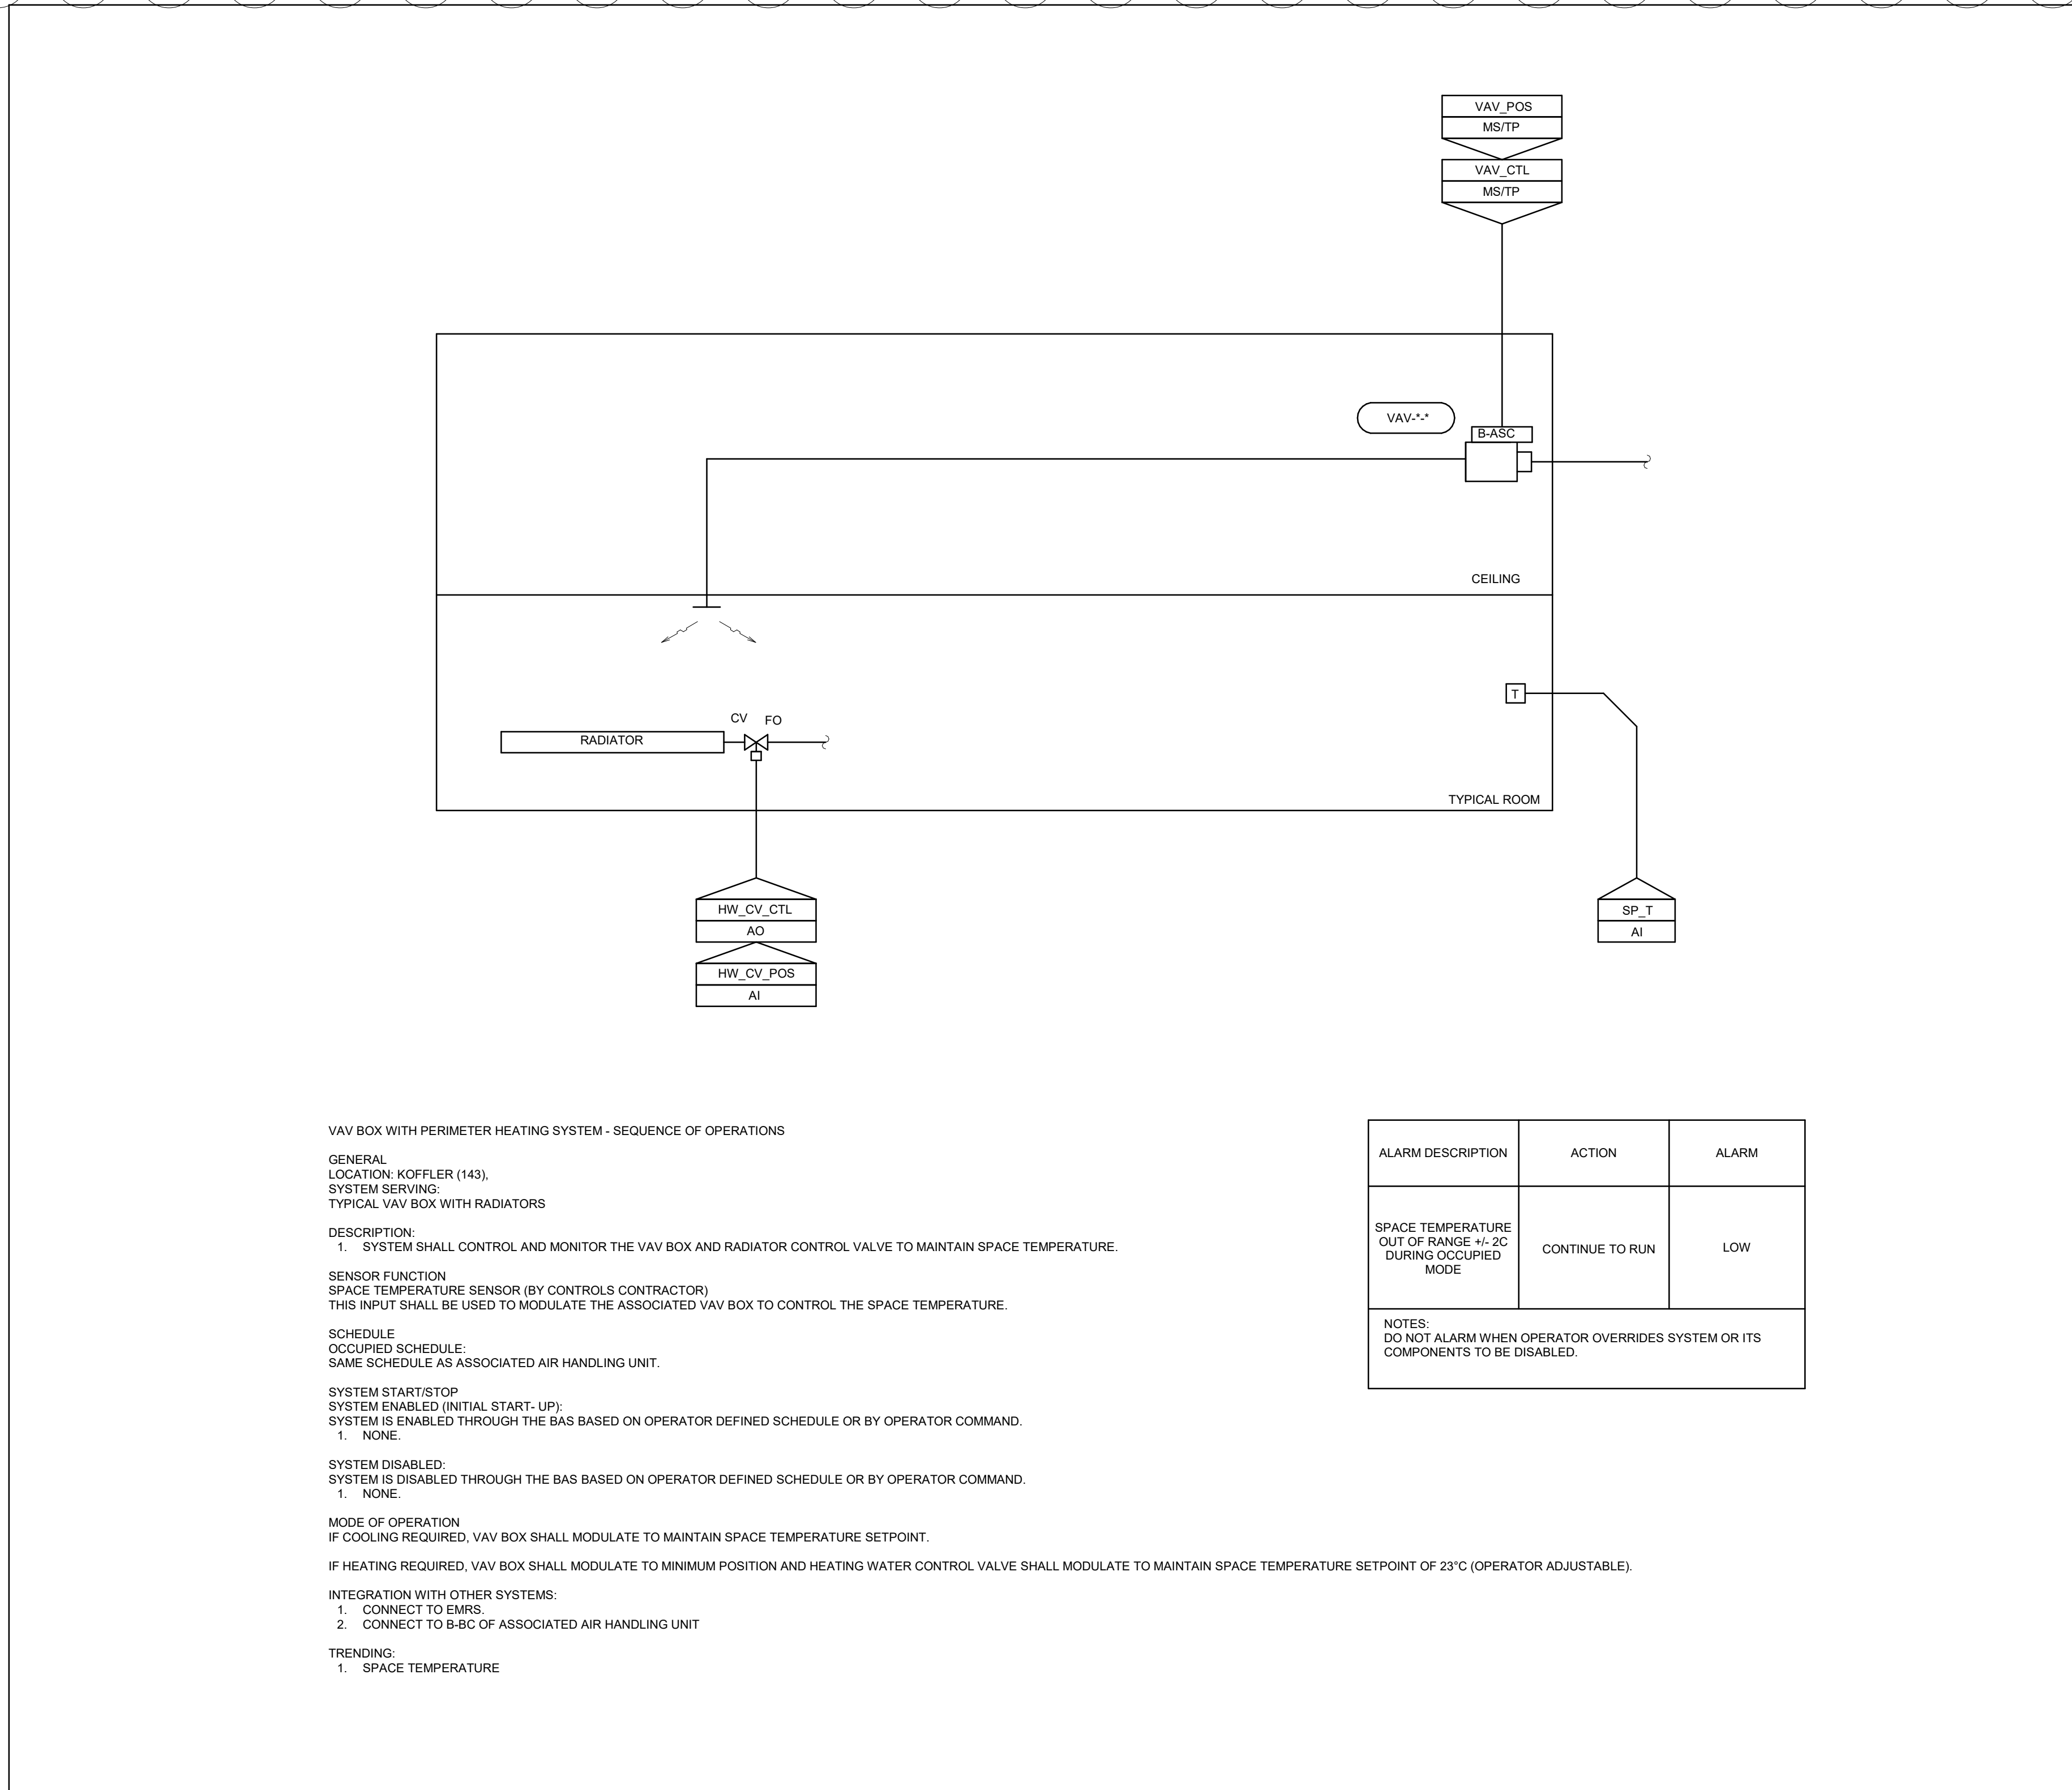

2 VAV BOXES WITH RADIATORS CONTROL DIAGRAM AND SEQUENCE

KEY PLAN:

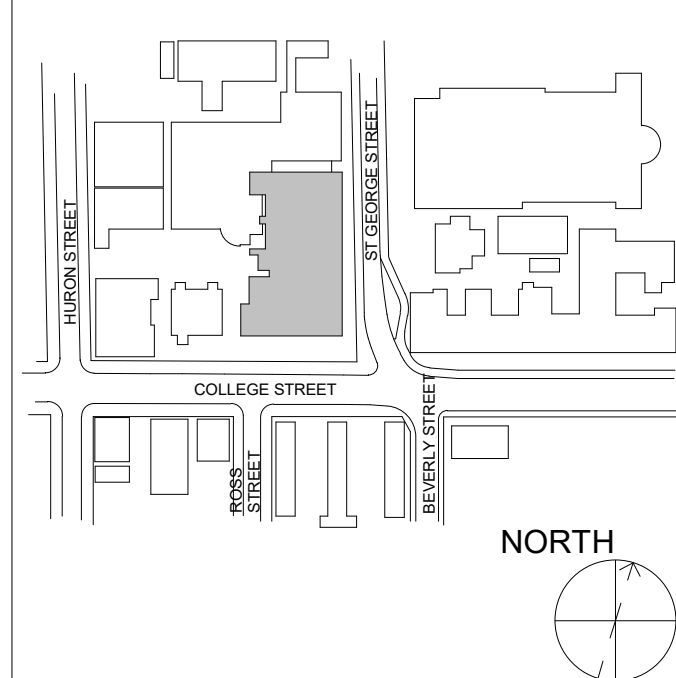

CONSTRUCTOR SHALL CHECK ALL DIMENSIONS ON THE WORK AND REPORT ANY DISCREPANCY TO THE CONSULTANT BEFORE PROCEEDING. THIS DRAWING IS NOT TO BE USED FOR CONSTRUCTION UNTIL AUTHORIZED IN WRITING BY CONSULTANT.

REVISION		
NO.	DATE	DESCRIPTION
1	2025-01-11	ISSUED FOR BID
2	2025-03-07	Bid Addendum #01
3	2025-03-24	Bid Addendum #04



SEAL:




PROJECT:
HEALTH AND WELLNESS CENTRE RENOVATION AT KOFFLER


214 COLLEGE ST.
TORONTO, ON M5T 3A1

SHEET CONTENTS:
CONTROLS DIAGRAM AND SEQUENCES


PROJECT NUMBER:
21590.003
DRAWING SCALE:
N.T.S.
DRAWN BY:
AS
CHECKED BY:
RC/DC
DATE:
2024-02-08
SHEET NO.:
TM-0.8
REV:
3

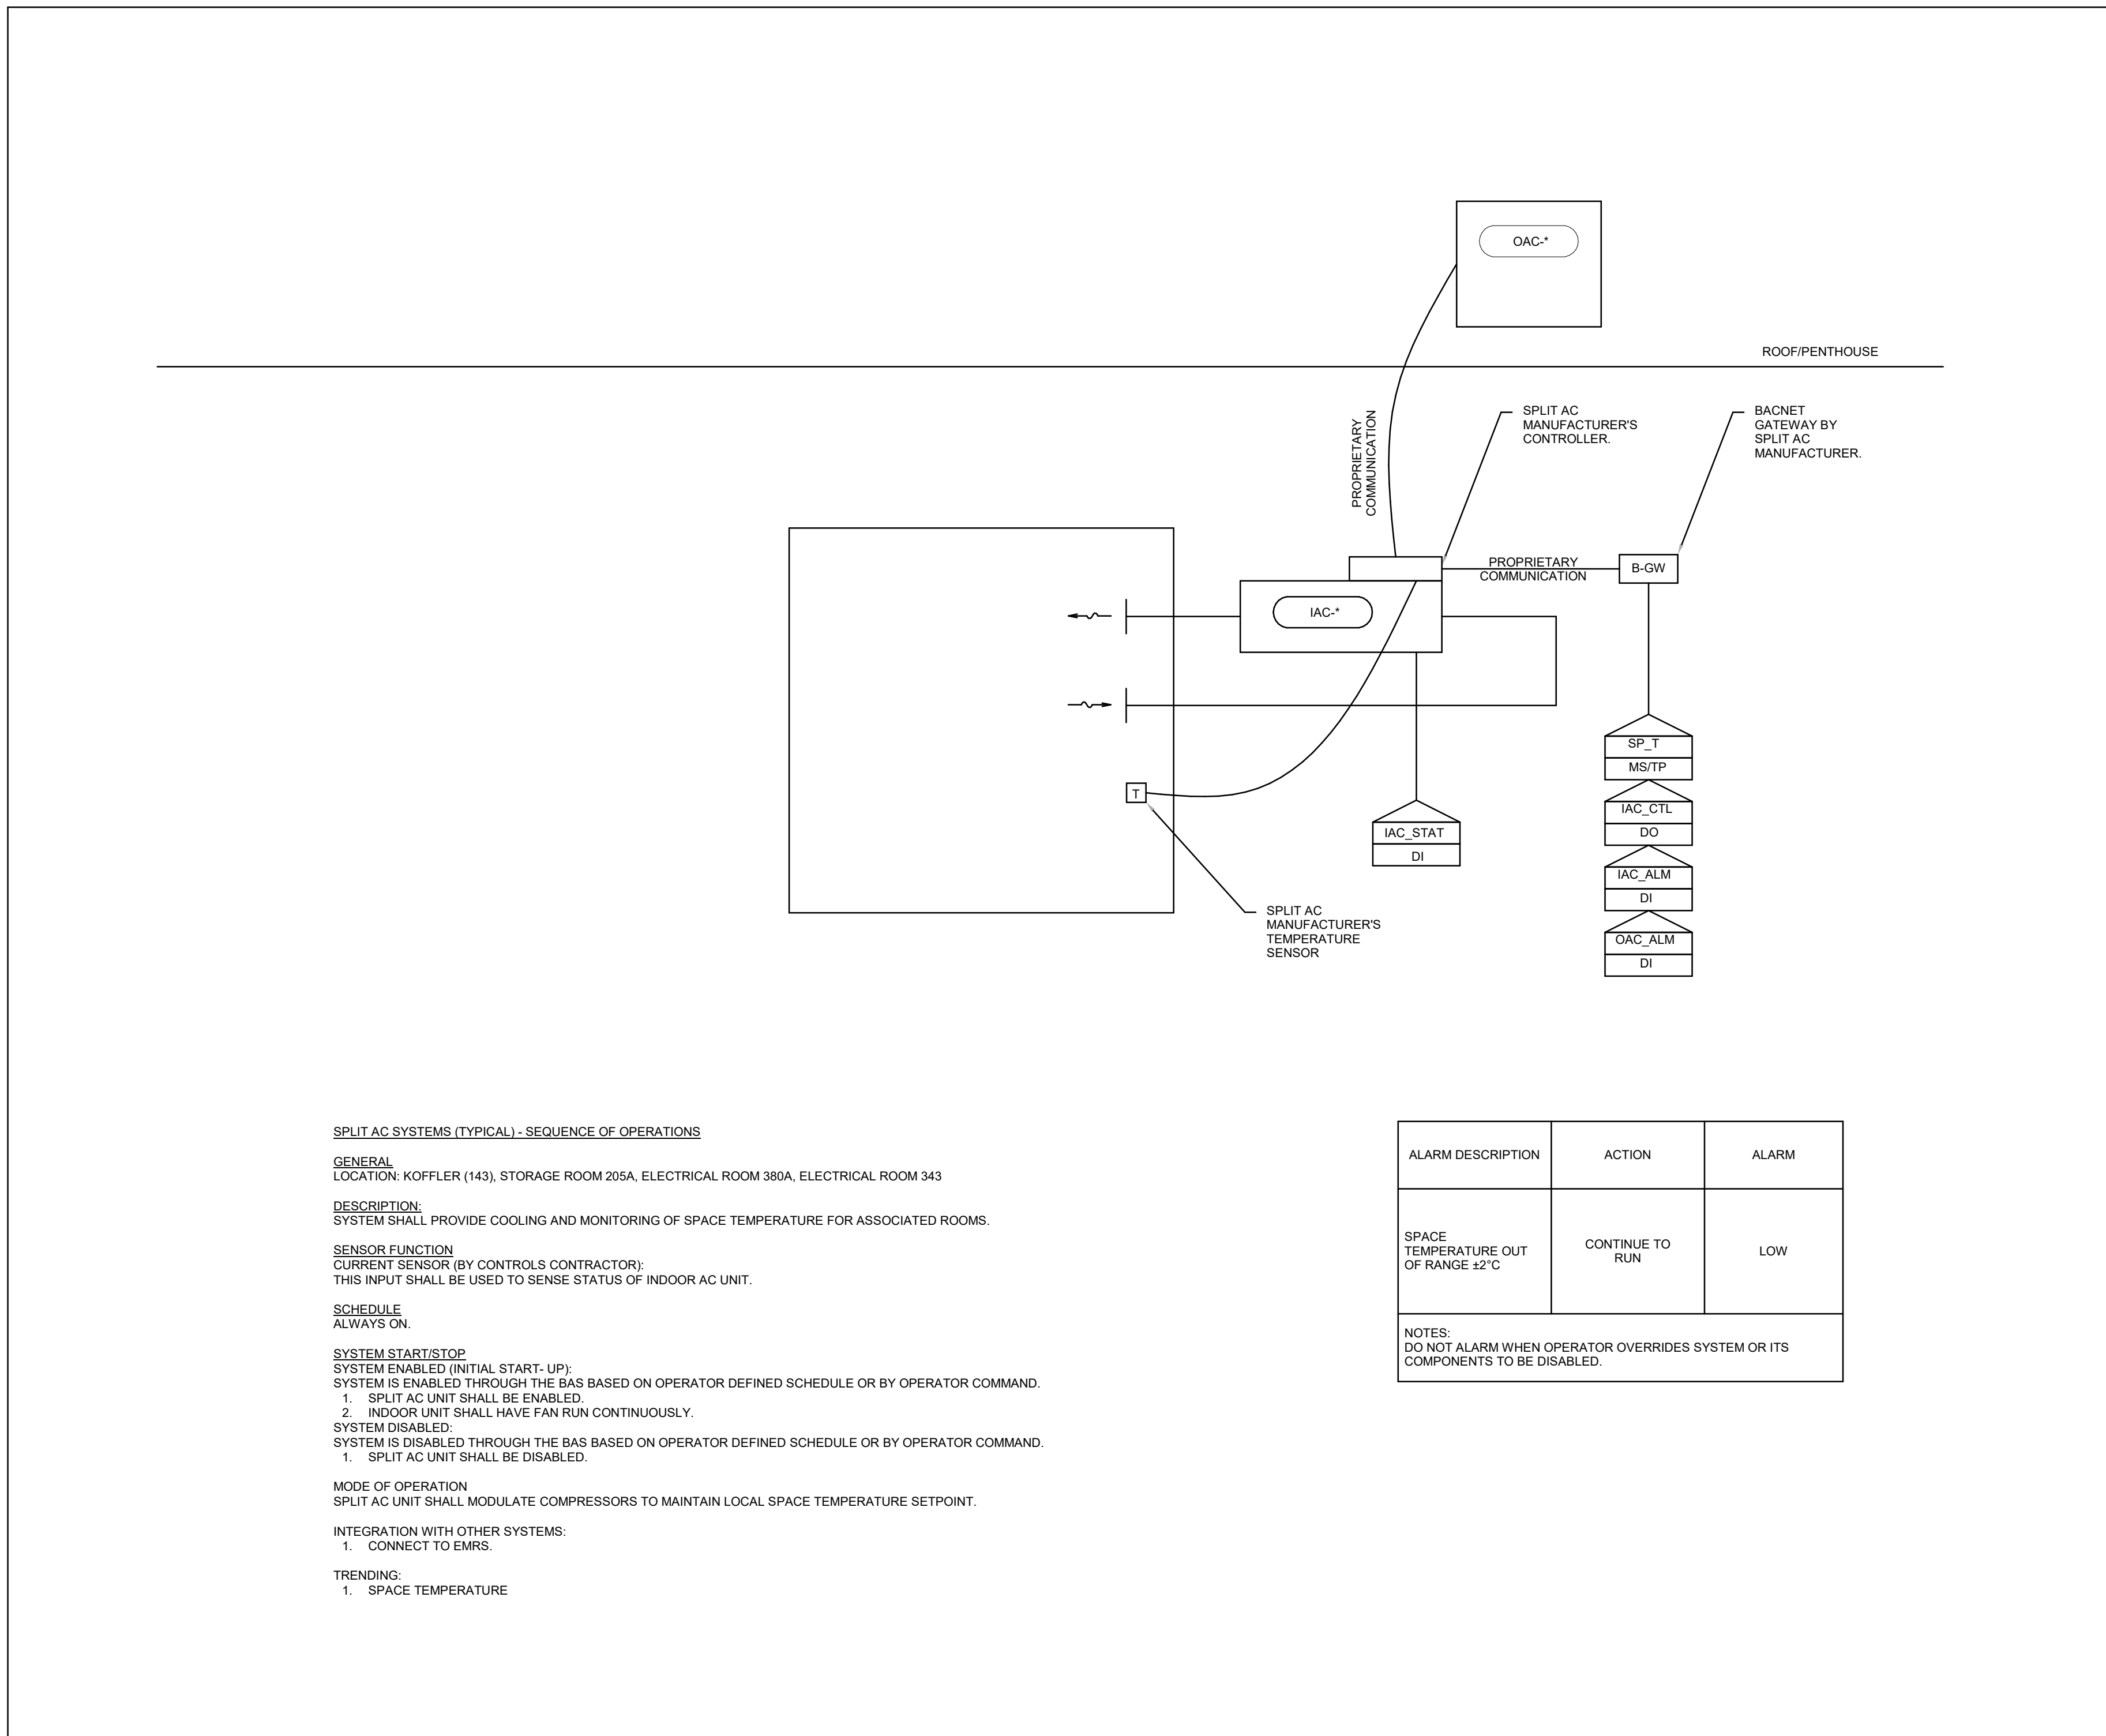

2 SPLIT AC CONTROLS DIAGRAM

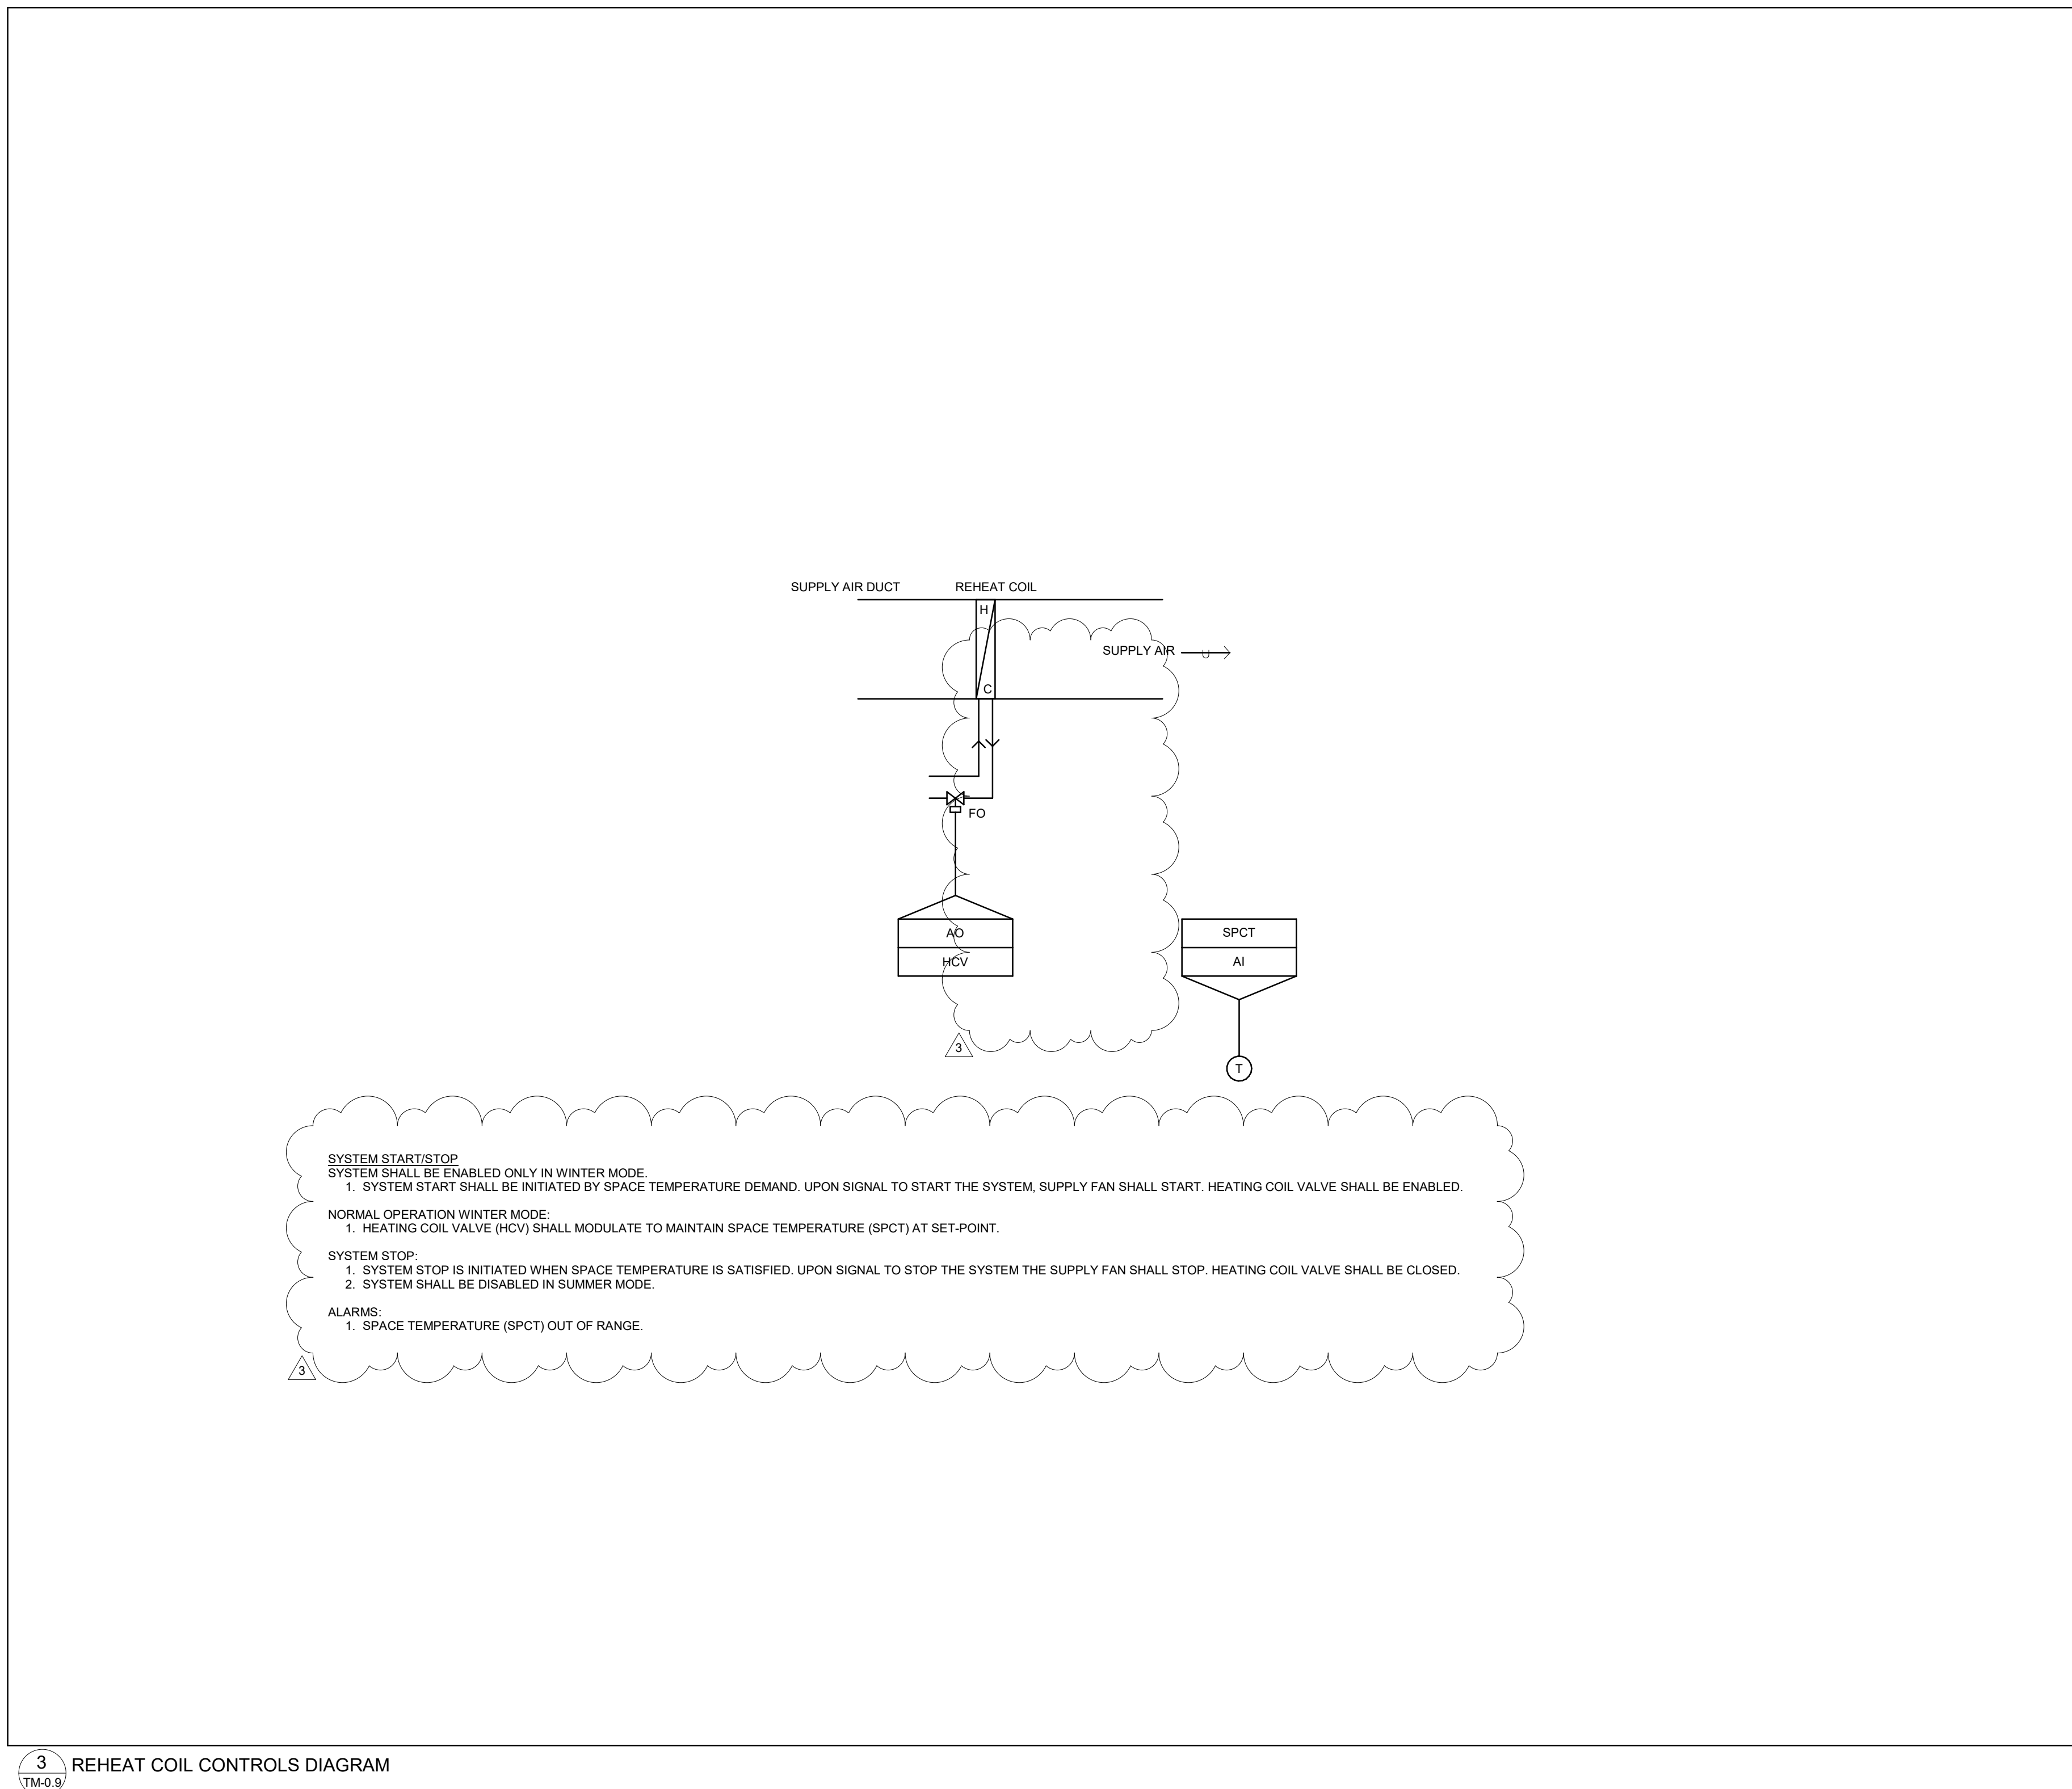


3 REHEAT COIL CONTROLS DIAGRAM

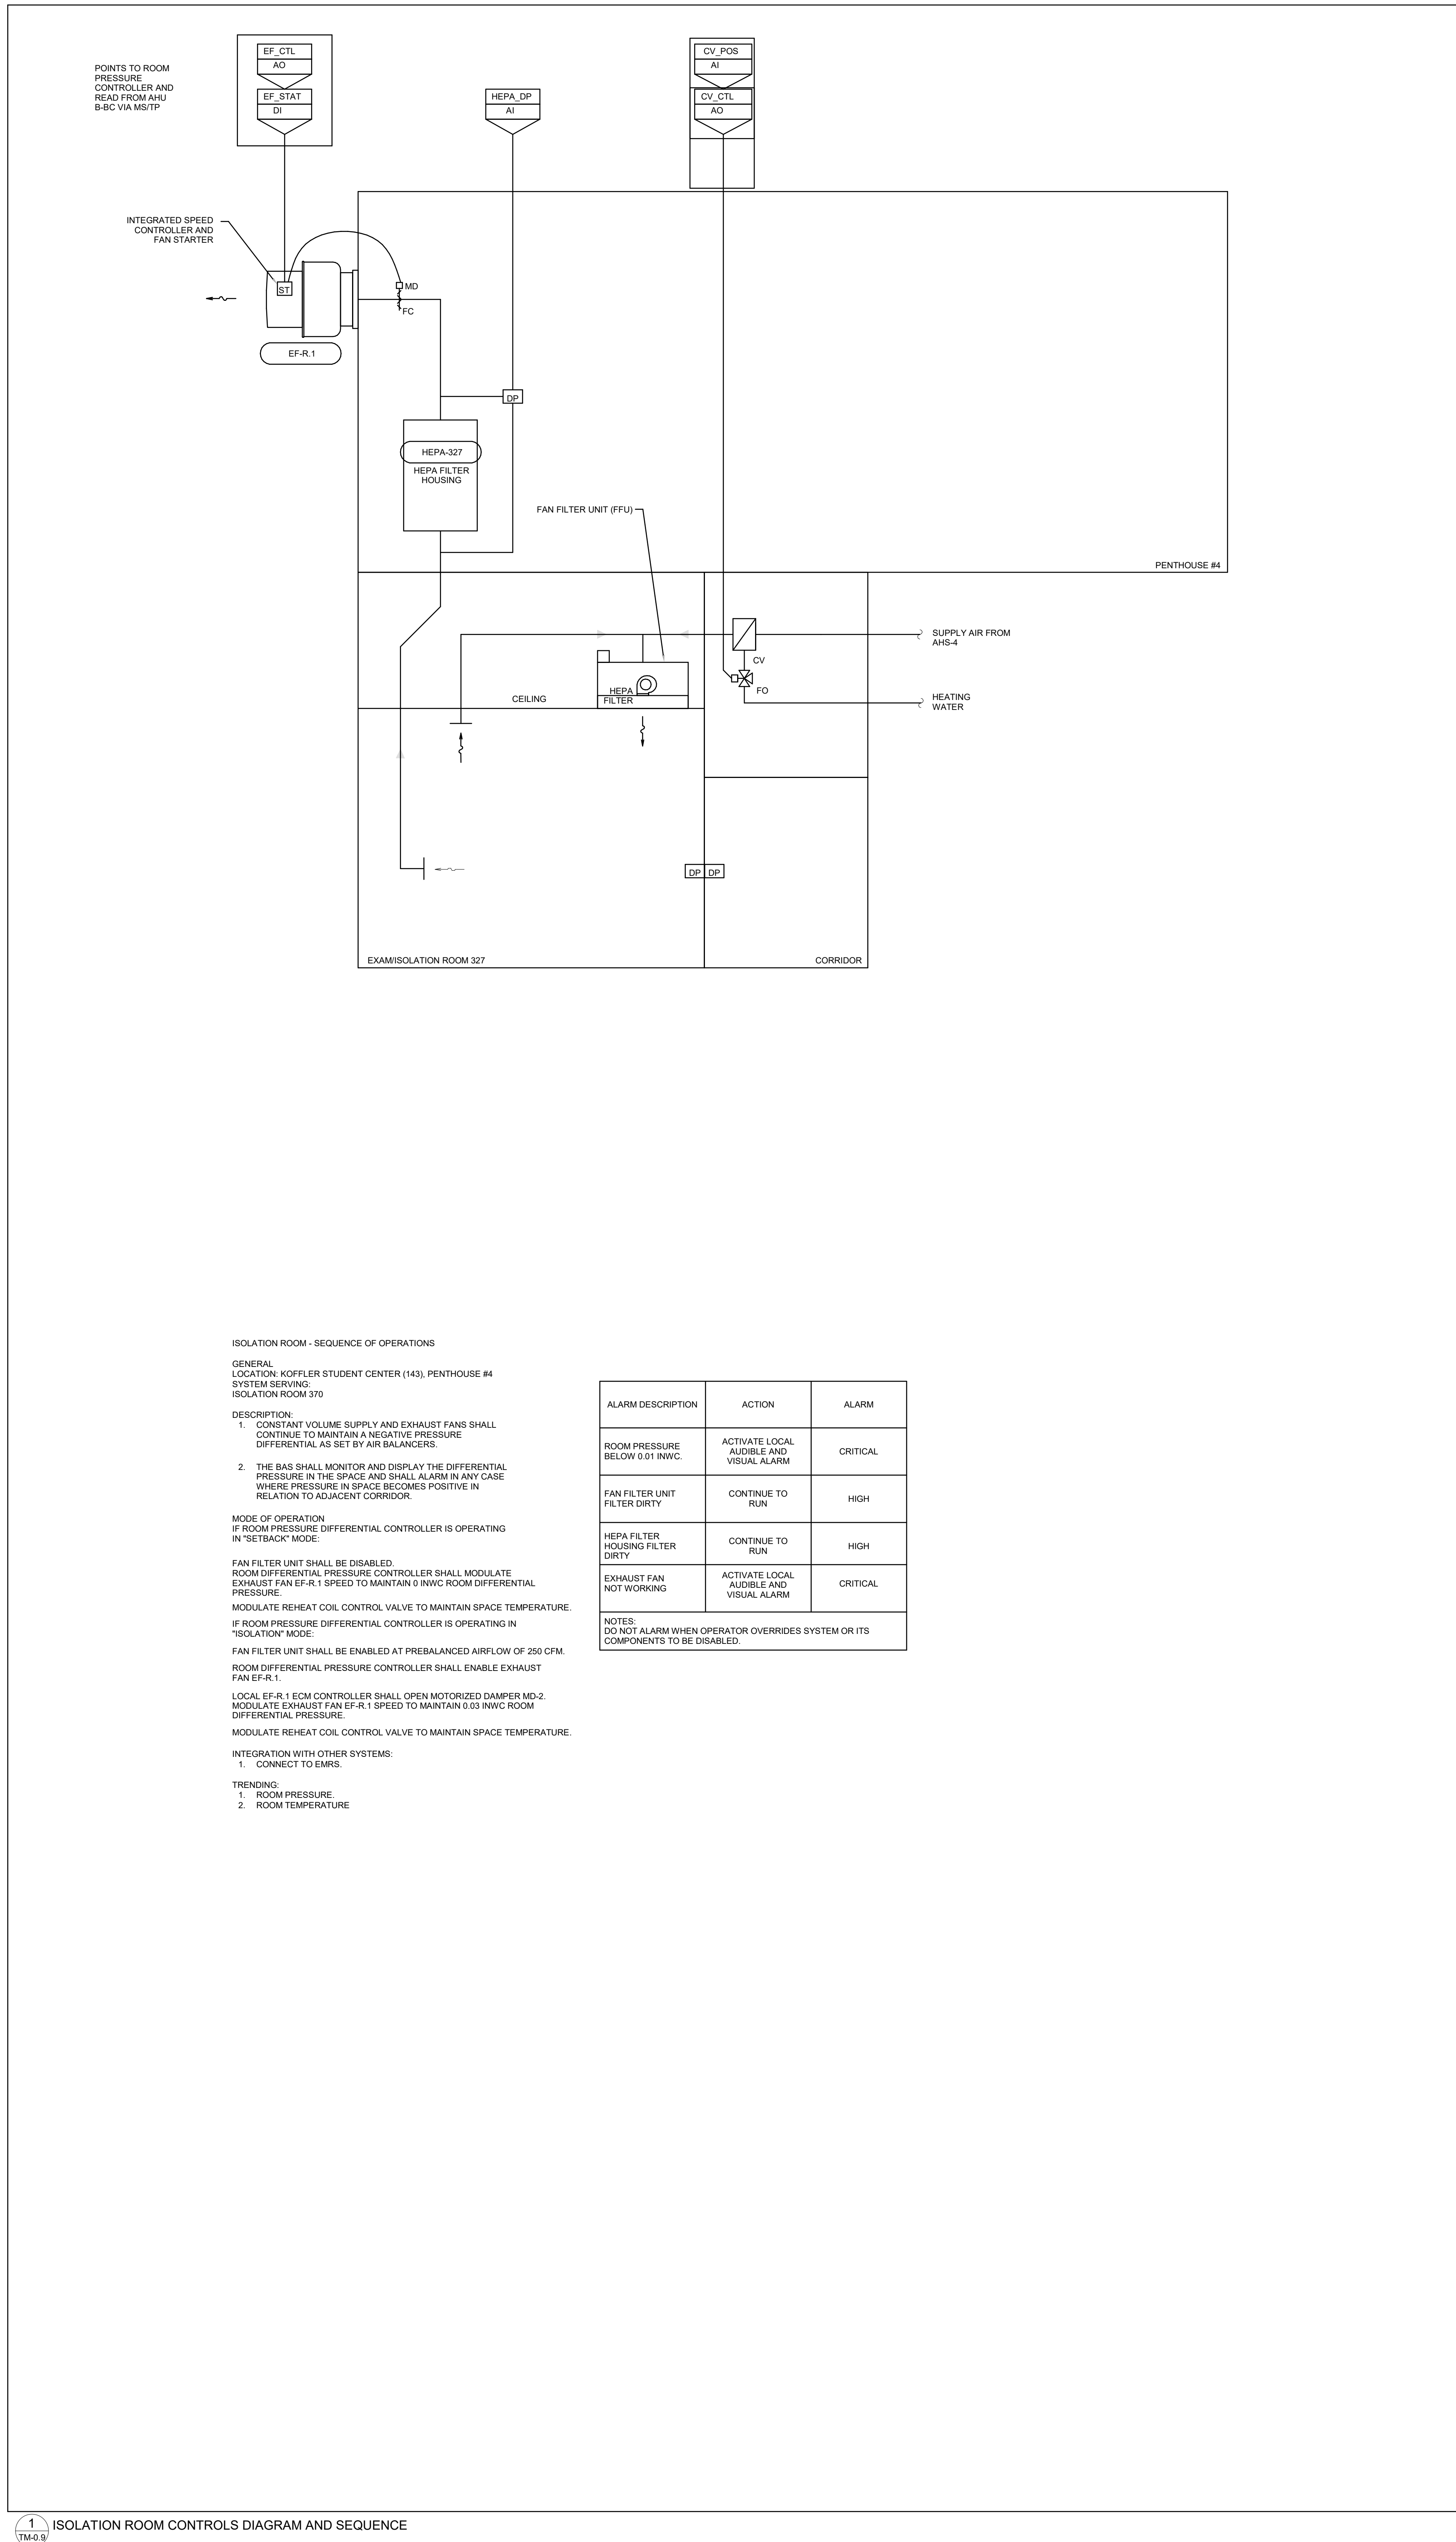

1 ISOLATION ROOM CONTROLS DIAGRAM AND SEQUENCE

KEY PLAN:

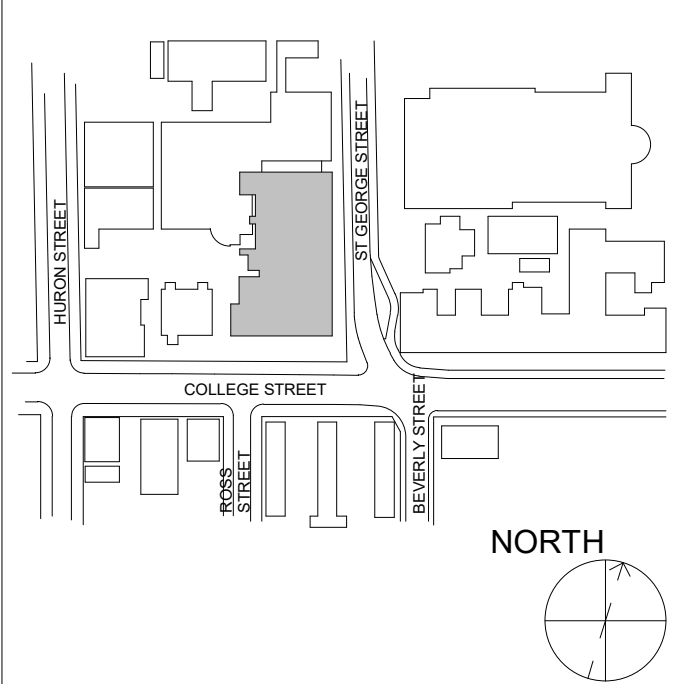

CONSTRUCTOR SHALL CHECK ALL DIMENSIONS ON THE WORK AND REPORT ANY DISCREPANCY TO THE CONSULTANT BEFORE PROCEEDING. THIS DRAWING IS NOT TO BE USED FOR CONSTRUCTION UNTIL AUTHORIZED IN WRITING BY CONSULTANT.

REVISION	
NO.	DESCRIPTION
1	ISSUED FOR BID
2	Bid Addendum #01
3	Bid Addendum #04

REVISION	
NO.	DESCRIPTION
1	ISSUED FOR BID
2	Bid Addendum #01
3	Bid Addendum #04

Grease Interceptor Calculation

Floor	Item Description	length (inches)	width (inches)	depth (inches)	volume (cu in)	Factor to convert volume to gallons	Item Gallons - Item Fixture Units or Calculated Gallons	120 ^{*4} and ^{*3}
1	Sink Compartment 1	14	13	9	1456	231	23	0.5
1	Sink Compartment 2	14	13	8	1456	231	23	0.5
Conversion								1.1
								0.1
								16.9

Notes:

- *1 : Total floor drains (i.e., 3 floor drain * 2.31 to convert to gallons)
*2 : Enter unit gallon in column H if/when volumes do not apply
*3 : Drainage Load - 75% of Maximum Discharge (Dishes Displace 25% of the water in sink)
*4 : Drain Down Time 120 (seconds) = (0.75/(2*3.785)/120) where 3.785 convert gallons to litres and 120 is the drain down time
*5 : Drain Down Time 60 (seconds) = (0.75/(2*3.785)/60) where 3.785 convert gallons to litres and 60 is the drain down time


Code Reference: OBC 7.4.4.3 Interceptors

GENERAL NOTES:


- DO NOT SCALE DRAWINGS. THE LOCATIONS OF ALL ITEMS SHOWN ON THE DRAWINGS OR SPECIFIED THAT ARE NOT EXPLICITLY FIXED BY DIMENSIONS ARE APPROXIMATE. DETERMINE THE EXACT LOCATIONS NECESSARY TO REQUIRE THE BEST CONDITIONS AND RESULTS BASED ON SITE CONDITIONS. REVIEW ALL REVISIONS WITH THE CONSULTANT.
- READ FLOOR PLANS IN CONJUNCTION WITH SCHEMATICS. ASSUME INFORMATION SHOWN ON FLOOR PLANS TO BE APPLICABLE TO THE RELATED SYSTEM SCHEMATIC AND VICE-VERSA TO PROVIDE A COMPLETE AND OPERATIONAL SYSTEM.
- VERIFY STRUCTURAL INTEGRITY OF ALL TEMPORARY AND PERMANENT OPENINGS. PROVIDE ADDITIONAL FRAMING TO ENSURE STRUCTURAL INTEGRITY AS REQUIRED.
- REFER TO THE STANDARD DETAILS AND DETAIL SHEETS FOR ADDITIONAL INFORMATION.

DRAWING NOTES:

- CONNECT NEW 1000 SANITARY DRAINAGE PIPE TO EXISTING 1000 SANITARY PIPE RISER AND EXTEND AS INDICATED.
- 120 DOMESTIC HOT AND COLD WATER PIPES DOWN TO SINK, 320 VENT LINE UP FROM SINK, AND 380 SANITARY DRAIN DOWN TO BELOW COUNTER GREASE INTERCEPTOR AND DOWN TO CEILING SPACE OF BASEMENT FLOOR BELOW. RUGH-IN AND FINAL CONNECTION FOR TWO AT 132 (110) ONE VALVED AND CAPPED DOMESTIC HOT WATER CONNECTION FOR DISHWASHER AND ONE VALVED AND CAPPED DOMESTIC COLD WATER CONNECTION FOR FUTURE CLIENT SUPPLIED APPLIANCE. PROVIDE NEW GREASE INTERCEPTER UNDER SINK.
- 120 DOMESTIC HOT AND COLD WATER PIPES DOWN TO MOP SINK, 320 VENT LINE UP FROM MOP SINK, AND 380 SANITARY DRAIN DOWN FROM MOP SINK TO CEILING SPACE OF (BASEMENT) FLOOR BELOW.
- 120 DOMESTIC HOT AND COLD WATER PIPES DOWN TO LAVATORY, 320 VENT LINE UP FROM LAVATORY, AND 320 SANITARY DRAIN DOWN FROM LAVATORY TO NEW 750 SANITARY PIPING AS INDICATED.
- 120 DOMESTIC HOT AND COLD WATER PIPES DOWN TO LAVATORY, 320 VENT LINE UP FROM LAVATORY, AND 320 SANITARY DRAIN DOWN FROM LAVATORY TO CEILING SPACE OF (BASEMENT) FLOOR BELOW.
- 250 DOMESTIC COLD WATER PIPE DOWN TO WATERCLOSET, 500 VENT LINE UP FROM WATERCLOSET, AND 750 SANITARY DRAIN DOWN FROM WATERCLOSET TO NEW 750 SANITARY PIPING AS INDICATED.
- 250 DOMESTIC COLD WATER PIPE DOWN TO WATERCLOSET, 500 VENT LINE UP FROM WATERCLOSET, AND 750 SANITARY DRAIN DOWN FROM WATERCLOSET TO CEILING SPACE OF (BASEMENT) FLOOR BELOW.
- PROVIDE AND INSTALL NEW WALL MOUNTED DUCTLESS SPLIT A/C COMPLETE WITH REFRIGERANT LINES AND CONDENSATE PUMP. NEW 250 CONDENSATE DRAIN FROM SPLIT A/C TO TERMINATE INDIRECTLY OVER MOP SINK AS INDICATED.
- PROVIDE NEW 1000 STORM DRAIN FROM NEW TRENCH DRAIN AND DISCHARGE OPEN ENDED TO DRY BASIN BELOW PLANTER FOR IRRIGATION. REFER TO ARCHITECTURAL DRAWING FOR ELEVATION.
- PROVIDE NEW TRENCH DRAIN. TRENCH DRAIN SHALL BE J.R. SMITH #9600, 150MM WIDE STAINLESS STEEL CONTINUOUS TRENCH DRAIN SYSTEM. SNOWMELT SYSTEM FOR TRENCH DRAIN BY ELECTRICAL CONTRACTOR.
- CONNECT NEW 120 DOMESTIC HOT AND COLD WATER PIPES TO EXISTING 120 DOMESTIC HOT AND COLD WATER PIPES IN THE CEILING SPACE OF THIS FLOOR AND EXTEND AS INDICATED.
- 120 DOMESTIC HOT AND COLD WATER PIPES UP TO SINK ON FLOOR ABOVE AND 380 SANITARY DRAIN DOWN FROM SINK ON FLOOR ABOVE DOWN TO CEILING OF THIS FLOOR.
- 250 DOMESTIC COLD WATER PIPE UP TO WATER CLOSET ON FLOOR ABOVE AND 750 SANITARY DRAIN DOWN FROM WATER CLOSET ON FLOOR ABOVE DOWN TO CEILING OF THIS FLOOR.
- 120 DOMESTIC COLD WATER PIPE UP TO DRINKING FOUNTAIN ON FLOOR ABOVE AND 380 SANITARY DRAIN DOWN FROM DRINKING FOUNTAIN ON FLOOR ABOVE DOWN TO CEILING OF THIS FLOOR.
- ALLOW FOR 3 HOURS OF INVESTIGATION OF EXISTING PLUMBING SUB-OUTS TO TRACE PIPING BACK TO MAIN SOURCE, REMOVE AND CAP EXISTING PLUMBING PIPING AS CLOSE TO SOURCE AS POSSIBLE. ALLOW FOR REMOVAL OF 30" OF PIPING OF EACH PLUMBING SERVICE.
- 120 DOMESTIC HOT AND COLD WATER PIPES DOWN TO SINK, 380 VENT LINE UP FROM SINK, AND 380 SANITARY DRAIN DOWN FROM SINK TO CEILING SPACE OF (BASEMENT) FLOOR BELOW.
- PROVIDE NEW 190 WALL MOUNTED HOSE BIB FOR FUTURE IRRIGATION CONNECTION. HOSE BIB SHALL BE 1/2" A LOCKABLE BOX AND RECESSED INTO THE NEW PLANTER. EXACT LOCATION TO BE COORDINATED ON SITE.
- 250 DOMESTIC COLD WATER PIPE CAPPED CONNECTION COMPLETE WITH SHUT-OFF VALVE AND WATER CHECK VALVE FOR FUTURE TENANT.
- 500 VENT PIPE CAPPED CONNECTION FOR FUTURE TENANT.
- PROVIDE AND INSTALL NEW UNDER COUNTER GREASE INTERCEPTOR COMPLETE WITH COUPLING ON SIDE AND THREADED CONNECTION FOR GREASE PUMP CONNECTION. GREASE INTERCEPTOR SHALL BE RATED FOR 34 GPM AND 7.0 LB GREASE HOLDING CAPACITY.
- PROVIDE 190 CAPPED DOMESTIC HOT AND COLD WATER LINES FOR FUTURE CLIENT SUPPLIED WASHER.
- ALLOW FOR 3 HOURS OF INVESTIGATION AND TO REMOVE AND RE-ROUTE EXISTING PIPE.
- 120 DOMESTIC HOT AND COLD WATER PIPES UP TO MOP SINK ON FLOOR ABOVE AND 750 SANITARY DRAIN DOWN FROM MOP SINK ON FLOOR ABOVE DOWN TO CEILING OF THIS FLOOR.
- PROVIDE NEW ELECTRONIC TRAP SEAL PRIMER. COORDINATE POWER REQUIREMENTS WITH ELECTRICAL DIVISION.

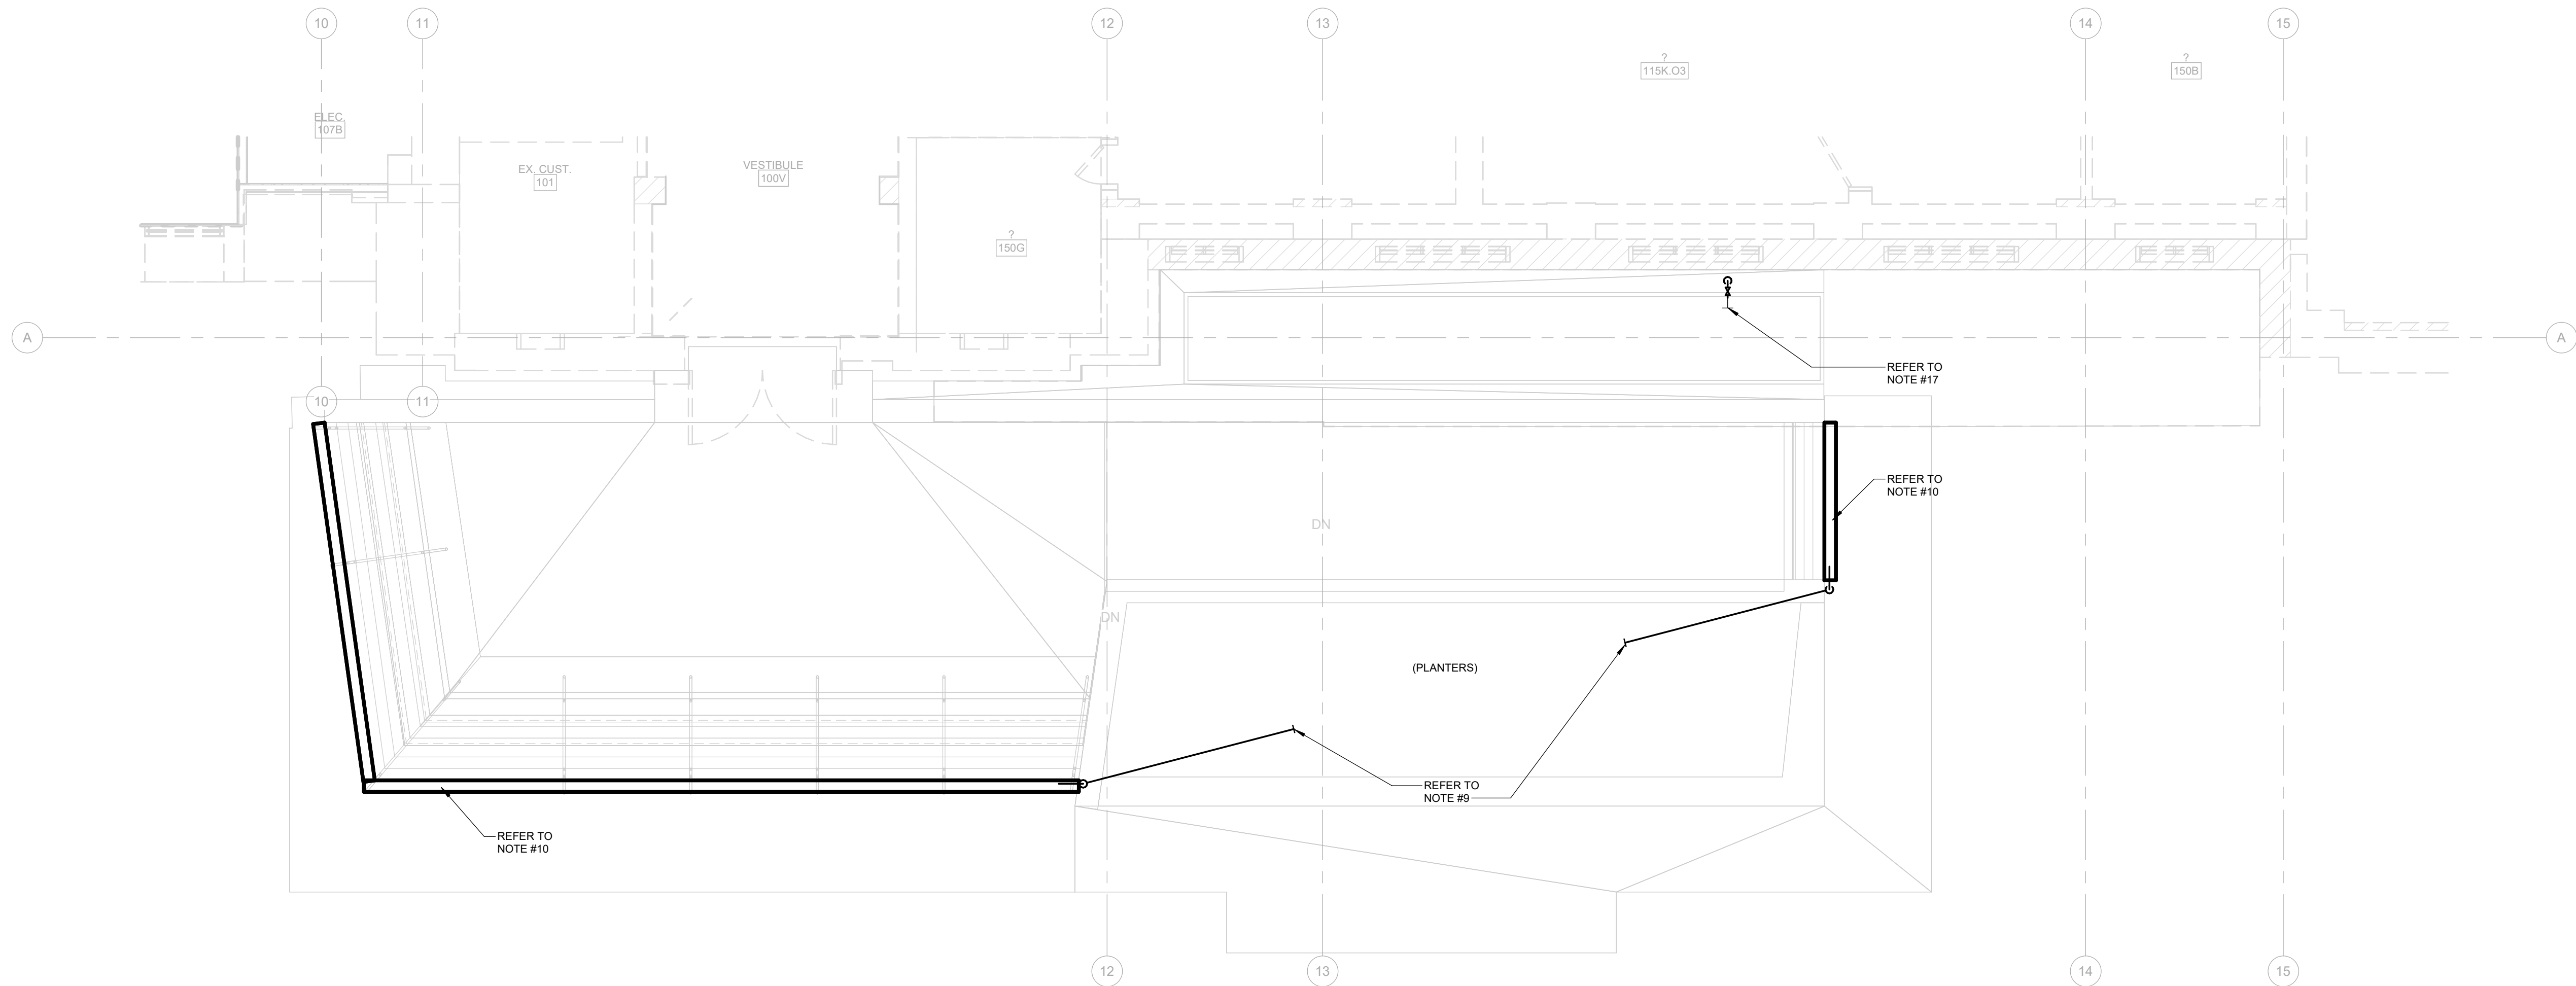


2 ENLARGED BUILDING EXTERIOR PLUMBING PLAN
TM-1.2 1:50

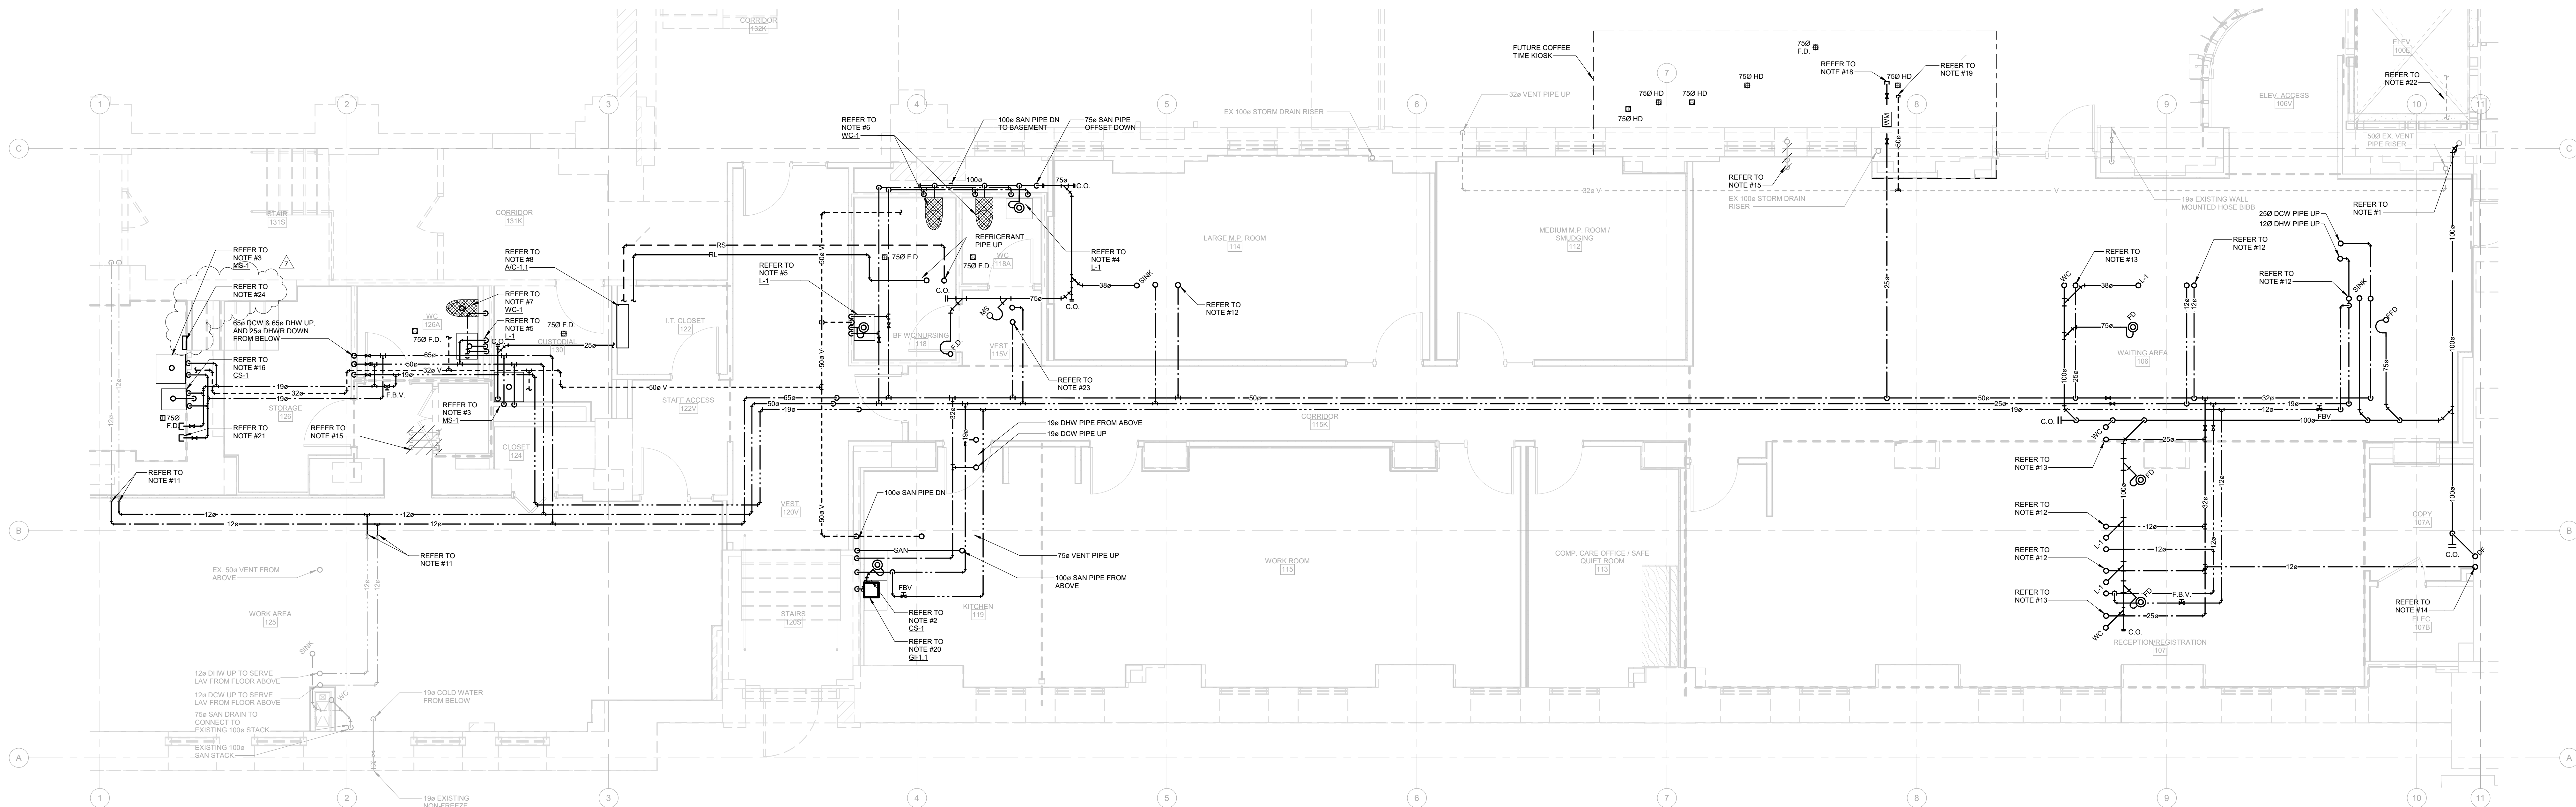

1 GROUND FLOOR PLAN
TM-1.2 1:50

KEY PLAN:

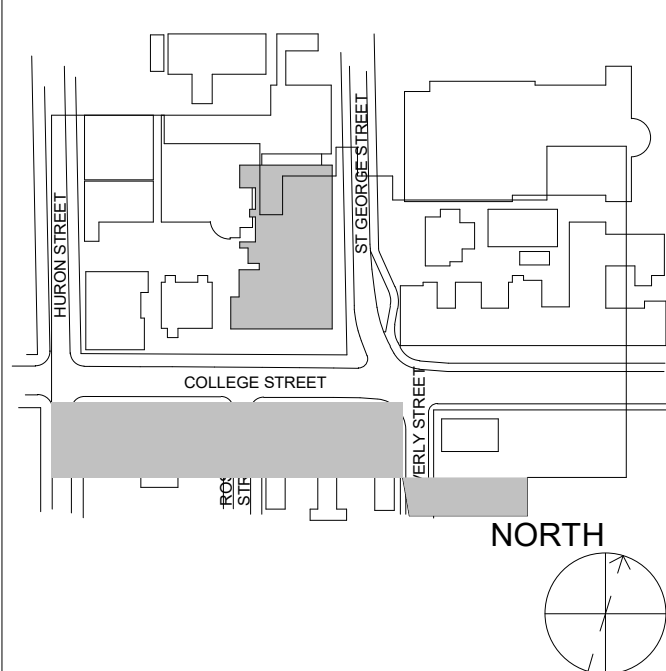

CONSTRUCTOR SHALL CHECK ALL DIMENSIONS ON THE WORK AND REPORT ANY DISCREPANCY TO THE CONSULTANT BEFORE PROCEEDING. THIS DRAWING IS NOT TO BE USED FOR CONSTRUCTION UNTIL AUTHORIZED IN WRITING BY CONSULTANT.

REVISION		
NO.	DATE	DESCRIPTION
1	2024-10-04	ISSUED FOR 50% REVIEW
2	2024-11-01	PROGRESS ISSUANCE
3	2024-11-14	ISSUED FOR PERMIT
4	2024-12-04	ISSUED FOR F&S REVIEW
5	2025-01-24	ISSUED FOR PEER REVIEW
6	2025-01-31	ISSUED FOR BID
7	2025-03-24	Bid Addendum #04



SEAL:



PROJECT: HEALTH AND WELLNESS CENTRE RENOVATION AT KOFFLER


214 COLLEGE ST.
TORONTO, ON M5T 3A1
SHEET CONTENTS:
GROUND FLOOR - PLUMBING AND PIPING LAYOUT

PROJECT NUMBER: 21590.003	CHECKED BY: RC/DC	DATE: 2024-02-08
DRAWN BY: AS	SHEET NO: TM-1.2	REV: 7

1. DO NOT SCALE DRAWINGS. THE LOCATIONS OF ALL ITEMS SHOWN ON THE DRAWINGS OR SPECIFIED THAT ARE NOT DEFINITELY FIXED BY DIMENSIONS ARE APPROXIMATE. DETERMINE THE EXACT LOCATIONS NECESSARY TO SECURE THE BEST CONDITIONS AND RESULTS BASED ON SITE CONDITIONS. REVIEW ALL REVISIONS WITH THE CONSULTANT.
2. READ FLOOR PLANS IN CONJUNCTION WITH SCHEMATICS. ASSUME INFORMATION SHOWN ON FLOOR PLAN TO BE APPLICABLE TO THE RELATED SYSTEM SCHEMATIC AND VICE-VERSA TO PROVIDE A COMPLETE AND OPERATIONAL SYSTEM.
3. VERIFY STRUCTURAL INTEGRITY OF ALL TEMPORARY AND PERMANENT OPENINGS. PROVIDE ADDITIONAL FRAMING TO ENSURE STRUCTURAL INTEGRITY AS REQUIRED.
4. REFER TO THE STANDARD DETAILS AND DETAIL SHEETS FOR ADDITIONAL INFORMATION.

1. CONNECT NEW DOMESTIC COLD WATER PIPING TO EXISTING DOMESTIC COLD WATER PIPING AND EXTEND AS INDICATED. REFER TO DRAWING FOR PIPE SIZES.
2. CONNECT NEW WASTEWATER PIPING TO EXISTING DOMESTIC COLD WATER PIPING AND EXTEND AS INDICATED. REFER TO DRAWING FOR PIPE SIZES.
3. CONNECT NEW 580 VENT PIPE TO EXISTING 750 VENT PIPE AND EXTEND AS INDICATED.
4. CONNECT NEW 1000 SANITARY DRAINAGE PIPE TO EXISTING 1000 SANITARY PIPE RISER AND EXTEND AS INDICATED.
5. 320 DOMESTIC HOT AND COLD WATER PIPES UP FROM SINK, 320 VENT LINE UP FROM SINK, AND 380 SANITARY DRAIN DOWN FROM SINK TO CEILING SLAB OF (GROUND) FLOOR BELOW.
6. 320 DOMESTIC HOT AND COLD WATER PIPES UP FROM FLOOR BELOW TO SINK, 320 VENT LINE UP FROM SINK, AND 380 SANITARY DRAIN DOWN FROM SINK TO CEILING SLAB OF (GROUND) FLOOR BELOW.
7. 320 DOMESTIC HOT AND COLD WATER PIPES DOWN FROM LAVATORY, 320 VENT LINE UP FROM LAVATORY, AND 380 SANITARY DRAIN DOWN FROM LAVATORY TO CEILING SLAB OF (GROUND) FLOOR BELOW.
8. 320 DOMESTIC HOT AND COLD WATER PIPES UP FROM FLOOR BELOW TO LAVATORY, 320 VENT LINE UP FROM LAVATORY, AND 320 SANITARY DRAIN DOWN FROM LAVATORY TO CEILING SLAB OF (GROUND) FLOOR BELOW.
9. 260 DOMESTIC COLD WATER PIPE DOWN FROM WATERCLOSET, 50 VENT LINE UP FROM WATERCLOSET, AND 750 SANITARY DRAIN DOWN FROM WATERCLOSET TO CEILING SLAB OF (GROUND) FLOOR BELOW.
10. 260 DOMESTIC COLD WATER PIPE UP FROM FLOOR BELOW TO WATERCLOSET, 50 VENT LINE UP FROM WATERCLOSET, AND 750 SANITARY DRAIN DOWN FROM WATERCLOSET TO CEILING SLAB OF (GROUND) FLOOR BELOW.

12. PROVIDE 120 CM DEIST HOT WATER PIPE UP FROM FLOOR BELOW TO DRINKING FOUNTAIN, 320 VENT AND 320 SANSITARY DRAIN DOWN FROM FLOOR ABOVE TO SINK (TYPICAL) ON FLOOR ABOVE.
13. PROVIDE 120 CM DEIST HOT WATER PIPE UP TO LAUNDRY ON FLOOR ABOVE, 320 SANSITARY DRAIN DOWN FROM DRINKING FOUNTAIN ON FLOOR ABOVE.
14. PROVIDE 120 CM DEIST HOT AND COLD WATER PIPES UP TO SINK ON FLOOR ABOVE, 360 SANSITARY DRAIN DOWN FROM SINK ON FLOOR ABOVE. (TYPICAL)
15. PROVIDE NEW FLOOR DRAINS COMPLETE WITH TRAPS AND TRAP ARRESTORS.
15.1 PROVIDE NEW DRAINAGE PIPES TO EXISTING SINKS AT ALL COMPLETE WITH DIFFERENTIALS, WATERSHEDS AND CONDENSATE PANS. NEW 2" CONDENSATE DRAIN FROM GRAVITY ACTS TO EXTEND AS REQUIRED AND NOT TO EXCEED 10' VERTICAL RISE. PROVIDE 1/2" AIR GAP AT EACH SINK AND 1/2" AIR GAP AT EACH DRAIN.
16. PROVIDE NEW WATER TRIP DRAIN PANS UNDER EXISTING PLUMBING SECTIONS. COMPLETE WITH MOLDURE SENSITIVE TRIP TO ADJUSTABLE ALARM WITH CEILING SPEAKER FOR MONITORING. 2" DRAIN PANS NOT TO EXCEED 10' VERTICAL RISE. PROVIDE 1/2" AIR GAP AT EACH SINK AND 1/2" AIR GAP AT EACH DRAIN.
17. CONNECT NEW HEATING WATER SUPPLY PIPES TO EXISTING PIPING ON FLOOR AND EXTEND AS REQUIRED TO EXISTING FLOOR. PROVIDE NEW RETURN PIPING TO EXISTING PIPING ON FLOOR AND EXTEND AS REQUIRED INDICATED FOR PIPE FREEZING TO FACILITATE NEW CONNECTION WITHOUT DISTURBANCE TO EXISTING WORK.
18. PROVIDE NEW HEATING WATER RETURN PIPES TO EXISTING PIPING ON THIS FLOOR AND EXTEND AS REQUIRED TO EXISTING FLOOR. PROVIDE NEW RETURN PIPING TO EXISTING PIPING ON FLOOR AND EXTEND AS REQUIRED INDICATED FOR PIPE FREEZING TO FACILITATE NEW CONNECTION WITHOUT DISTURBANCE TO EXISTING WORK. SIZE AS REQUIRED.
19. PROVIDE HOT AND COLD WATER PIPES DOWN TO COUNTER SIN, 320 VENT LINE UP FROM SINK, 360 SANSITARY DRAIN DOWN FROM SINK TO CEILING SPEAKER OF FLOOR BELOW AND TO CONNECT TO EXISTING PIPE OF LOCAL OR LARGER SIZE.
20. PROVIDE HOT AND COLD WATER PIPES TO EXISTING SINKS ON FLOOR ABOVE AND TO EXISTING BATH TO EXISTING BATH. (TYPICAL)
21. PROVIDE HOT AND COLD WATER PIPES TO EXISTING SINKS ON FLOOR ABOVE AND TO EXISTING BATH TO EXISTING BATH. (TYPICAL)
22. ALLOW FOR THE REWORK OF EXISTING HEATING WATER SUPPLY PIPES AND INITIAL NEW PIPING. MAINTAIN WORKING SPACE FOR THE REWORK OF EXISTING HEATING WATER SUPPLY PIPES AND INITIAL NEW PIPING. COORDINATE WORK ON SITE. WORK SHALL BE PERFORMED BY X.Y. (TYPICAL)
23. CONNECT NEW 7/8" SANSITARY DRAINAGE PIPE TO EXISTING 1000 SANSITARY PIPE RISE AND EXTEND AS REQUIRED TO EXISTING BATH. (TYPICAL)
24. COORDINATE CEILING DEMOLITION AND REINSTATEMENT WITH THE ARCHITECT.

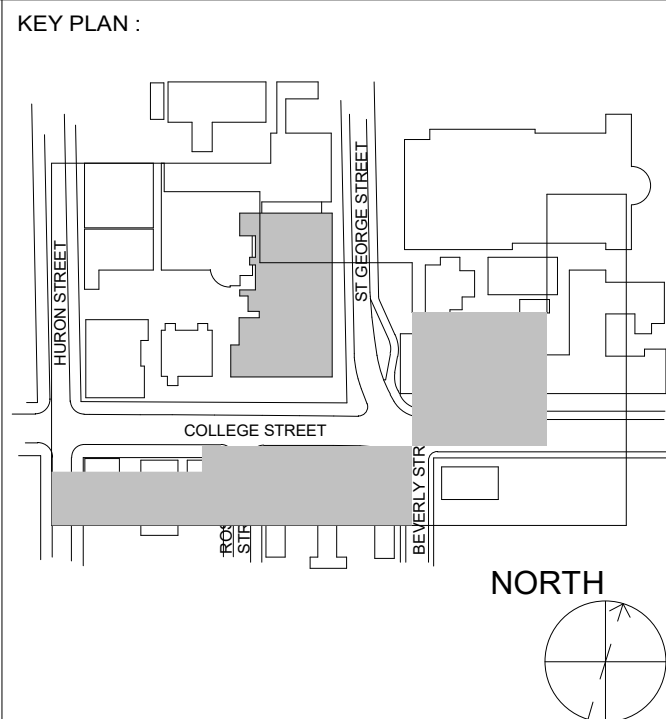

REVISION		
NO.	DATE	DESCRIPTION
1	2024-10-04	ISSUED FOR 50% REVIEW
2	2024-11-01	PROGRESS ISSUANCE
3	2024-11-14	ISSUED FOR PERMIT
4	2024-12-04	ISSUED FOR F&S REVIEW
5	2025-01-24	ISSUED FOR PEER REVIEW
6	2025-01-31	ISSUED FOR BID
7	2025-03-24	Bid Addendum #04



ENFORM
architects

ENFORM Architects Inc.
128A Sterling Road, Suite 302B
Toronto, Ontario, Canada M6R 2B7
t: 647-948-7523
www.enformarchitects.com

SEAL




PROJECT :
HEALTH AND WELLNESS
CENTRE RENOVATION AT
KOFFLER

214 COLLEGE ST,
TORONTO, ON M5T 3A1

SHEET CONTENTS :

**SECOND FLOOR - PLUMBING
AND PIPING LAYOUT**

PROJECT NUMBER :		21590.003	
DRAWING SCALE :		1:100	
DRAWN BY :	CHECKED BY :	DATE:	
AS	RC/DC	2024-02-08	
SHEET NO :			REV :
TM-2.2			7

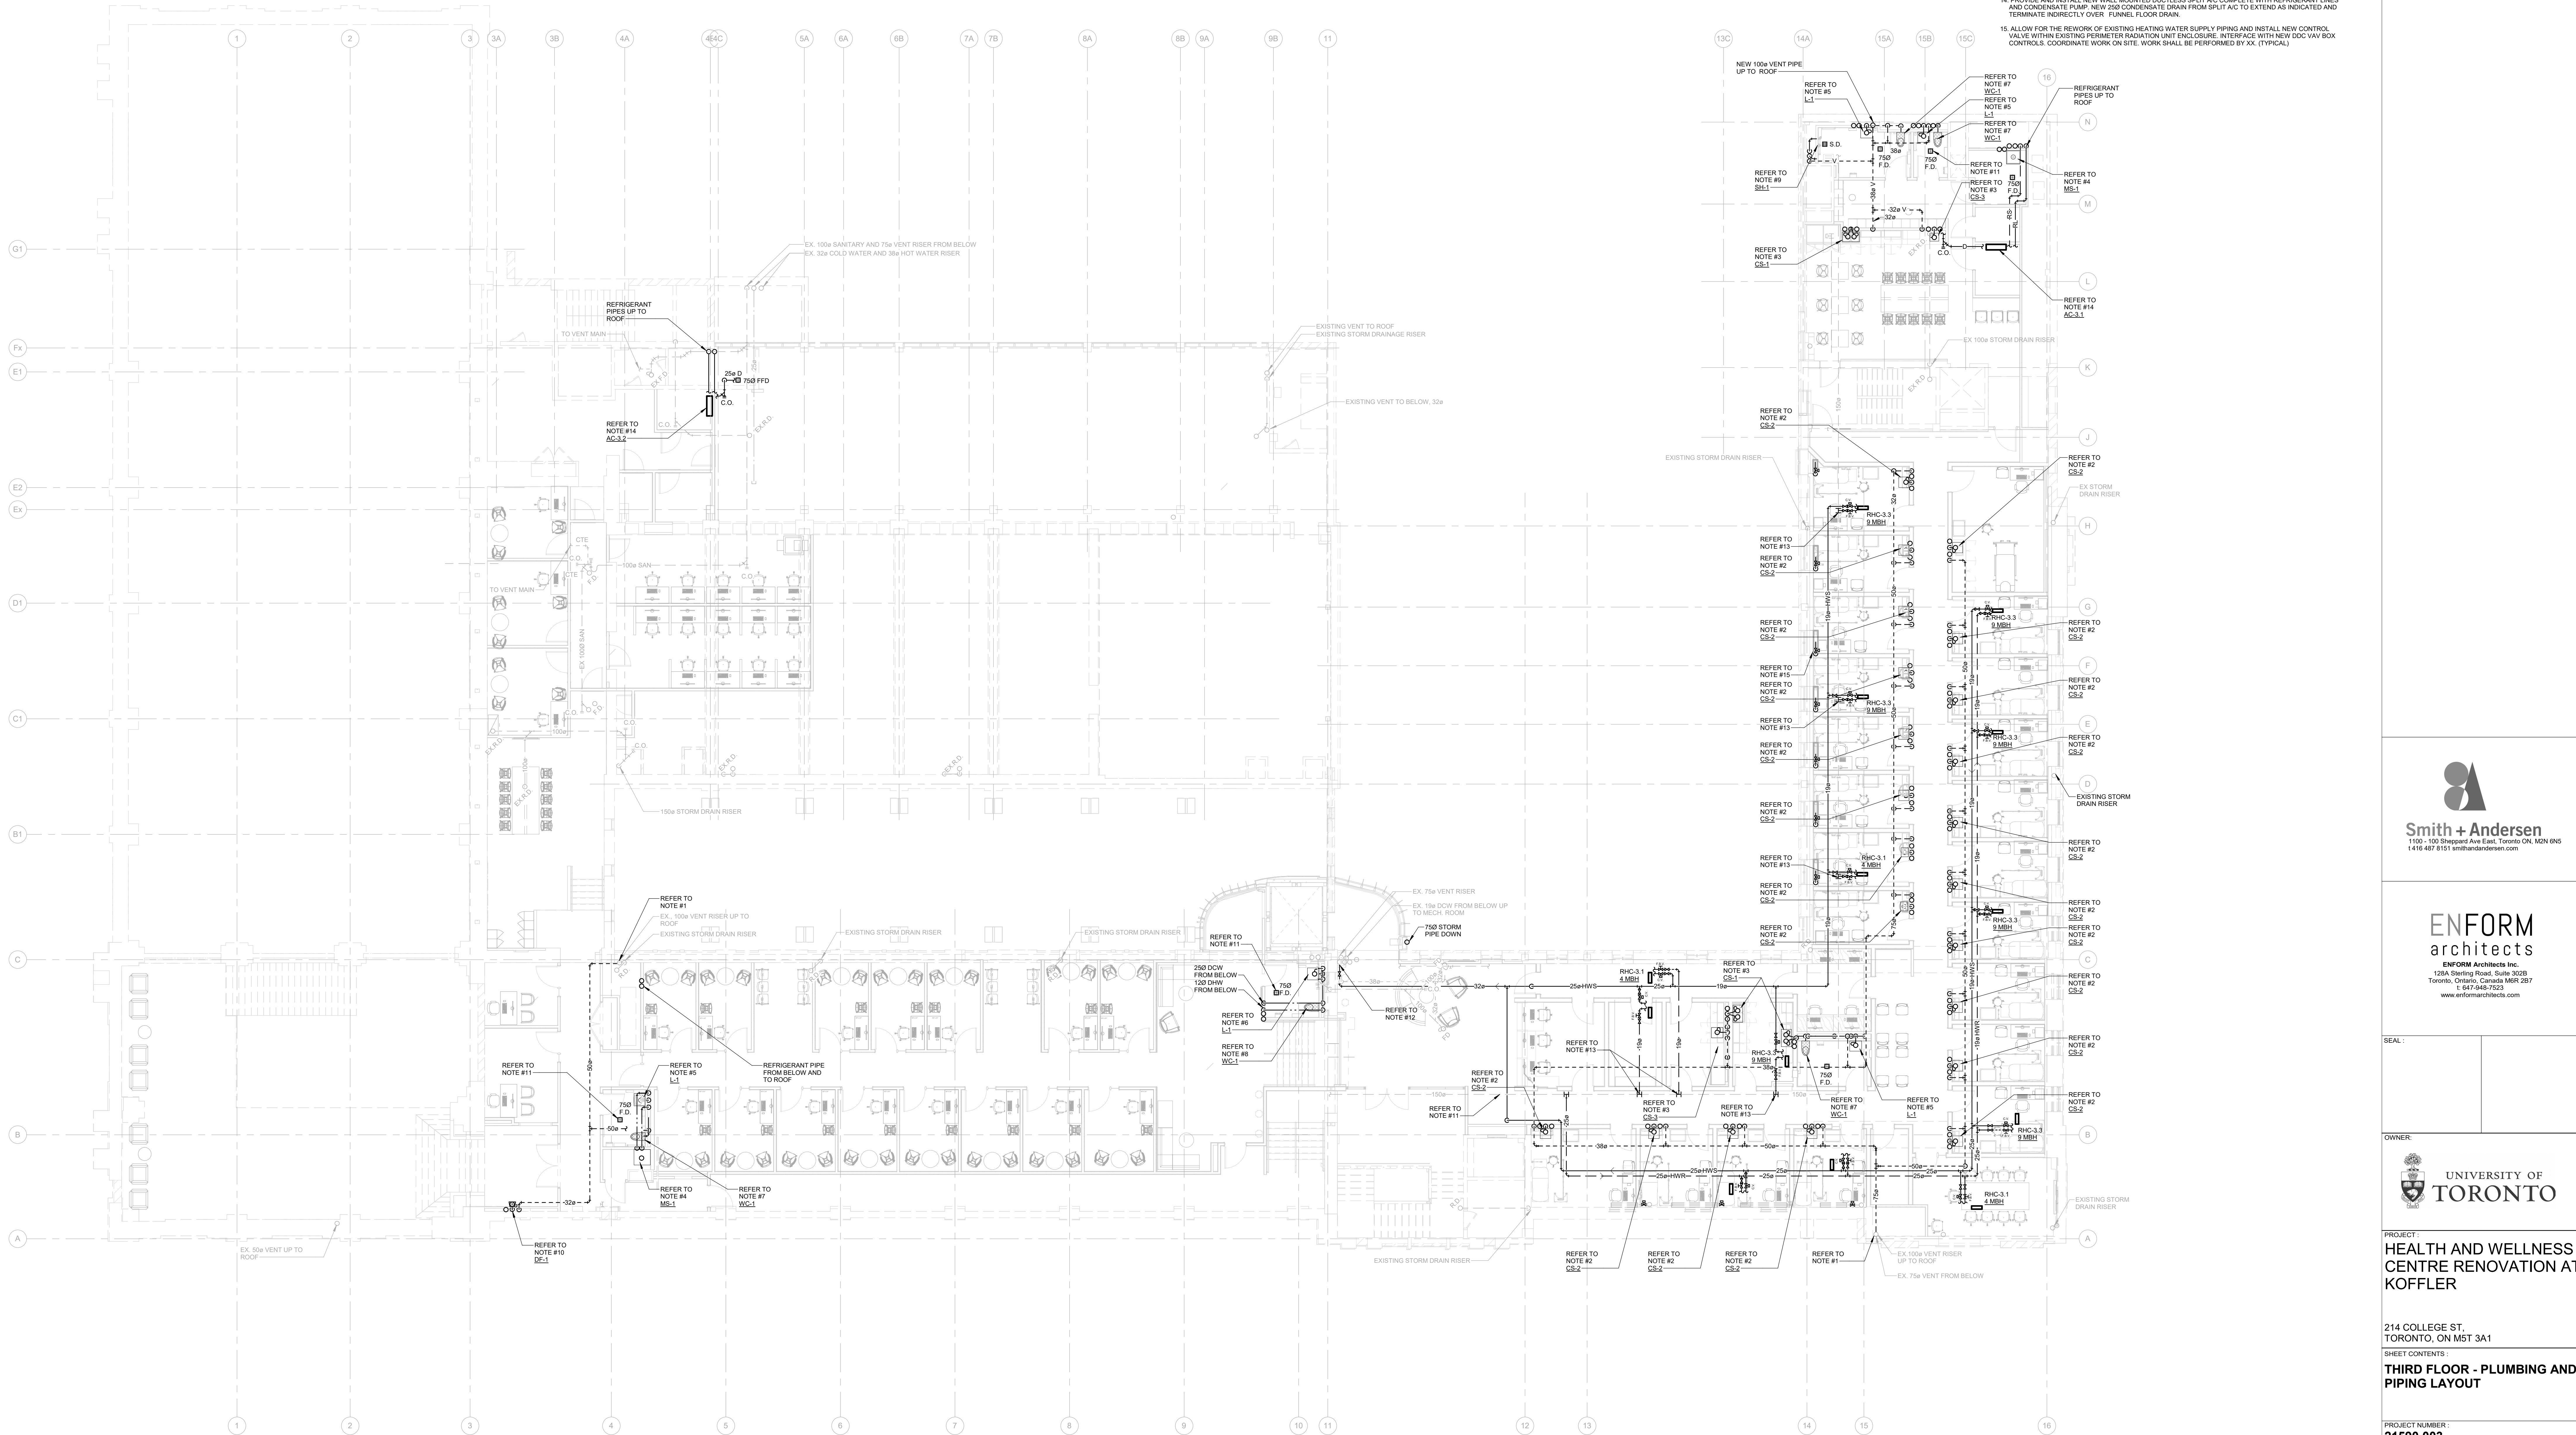


GENERAL NOTES:

- DO NOT SCALE DRAWINGS. THE LOCATIONS OF ALL ITEMS SHOWN ON THE DRAWINGS OR SPECIFIED THAT ARE NOT DEFINITELY FIXED BY DIMENSIONS ARE APPROXIMATE. DETERMINE THE EXACT LOCATIONS NECESSARY TO SECURE THE BEST CONDITIONS AND RESULTS BASED ON SITE CONDITIONS. REVIEW ALL REVISIONS WITH THE CONSULTANT.
- READ FLOOR PLANS IN CONJUNCTION WITH SCHEMATICS. ASSUME INFORMATION SHOWN ON FLOOR PLANS TO BE APPLICABLE TO THE RELATED SYSTEM SCHEMATIC AND VICE-VERSA TO PROVIDE A COMPLETE AND OPERATIONAL SYSTEM.
- VERIFY STRUCTURAL INTEGRITY OF ALL TEMPORARY AND PERMANENT OPENINGS. PROVIDE ADDITIONAL FRAMING TO ENSURE STRUCTURAL INTEGRITY AS REQUIRED.
- REFER TO THE STANDARD DETAILS AND DETAIL SHEETS FOR ADDITIONAL INFORMATION.

DRAWING NOTES:

- CONNECT NEW 750 VENT PIPE TO EXISTING 1000 VENT PIPE AND EXTEND AS INDICATED.
- 120 DOMESTIC HOT AND COLD WATER PIPES UP FROM FLOOR BELOW TO SINK, 320 VENT LINE UP FROM SINK, AND 380 SANITARY DRAIN DOWN FROM SINK TO CEILING SPACE OF (2ND) FLOOR BELOW. OFFSET NEW SANITARY DRAIN IN WALL TO AVOID INTERFERENCE WITH EXISTING BEAM BELOW. COORDINATE WITH STRUCTURAL.
- 120 DOMESTIC HOT AND COLD WATER PIPES UP FROM FLOOR BELOW TO SINK, 320 VENT LINE UP FROM SINK, AND 380 SANITARY DRAIN DOWN FROM SINK TO CEILING SPACE OF (2ND) FLOOR BELOW. ROUNDOFF AND FINAL CONNECTION FOR TWO AT 120 ONE VALVED AND CAPPED DOMESTIC HOT WATER CONNECTION FOR DISHWASHER AND ONE VALVED AND CAPPED DOMESTIC COLD WATER CONNECTION FOR FUTURE CLIENT SUPPLIED APPLIANCE. OFFSET NEW SANITARY DRAIN IN WALL TO AVOID INTERFERENCE WITH EXISTING BEAM BELOW. COORDINATE WITH STRUCTURAL.
- 120 DOMESTIC HOT AND COLD WATER PIPES DOWN TO MOP SINK, 320 VENT LINE UP FROM MOP SINK, AND 380 SANITARY DRAIN DOWN FROM MOP SINK TO CEILING SPACE OF (2ND) FLOOR BELOW.
- 120 DOMESTIC HOT AND COLD WATER PIPES UP FROM FLOOR BELOW TO LAVATORY, 320 VENT LINE UP FROM LAVATORY, AND 320 SANITARY DRAIN DOWN FROM LAVATORY TO CEILING SPACE OF (2ND) FLOOR BELOW.
- 120 DOMESTIC HOT AND COLD WATER PIPES DOWN TO LAVATORY, 320 VENT LINE UP FROM LAVATORY, AND 320 SANITARY DRAIN DOWN FROM LAVATORY TO CEILING SPACE OF (2ND) FLOOR BELOW.
- 250 DOMESTIC COLD WATER PIPE DOWN TO WATERCLOSET, 500 VENT LINE UP FROM WATERCLOSET, AND 750 SANITARY DRAIN DOWN FROM WATERCLOSET TO CEILING SPACE OF (2ND) FLOOR BELOW.
- 250 DOMESTIC COLD WATER PIPE UP FROM FLOOR BELOW TO WATERCLOSET, 500 VENT LINE UP FROM WATERCLOSET, AND 750 SANITARY DRAIN DOWN FROM WATERCLOSET TO CEILING SPACE OF (2ND) FLOOR BELOW.
- 120 DOMESTIC HOT AND COLD WATER PIPES UP FROM FLOOR BELOW TO SHOWER MIXING ASSEMBLY, 180 VENT LINE UP FROM SHOWER, AND 500 SANITARY DRAIN DOWN FROM SHOWER TO CEILING SPACE OF (2ND) FLOOR BELOW.
- 120 DOMESTIC COLD WATER PIPE UP FROM FLOOR BELOW TO DRINKING FOUNTAIN AND 300 SANITARY DRAIN DOWN FROM DRINKING FOUNTAIN TO CEILING SPACE OF (GROUND) FLOOR BELOW.
- PROVIDE NEW FLOOR DRAINS COMPLETE WITH TRAPS AND TRAP PRIMERS. (TYPICAL).
- CONNECT NEW HEATING WATER SUPPLY PIPES TO EXISTING PIPING ON THIS FLOOR AND EXTEND AS INDICATED. INCLUDE FOR PIPE FREEZING TO FACILITATE NEW CONNECTION WITHOUT DISTURBANCE TO EXISTING SERVICES. SIZE AS INDICATED ON DRAWING.
- CONNECT NEW HEATING WATER RETURN PIPES TO EXISTING PIPING ON THIS FLOOR AND EXTEND AS INDICATED. SYSTEM SHALL FOLLOW A REVERSE RETURN PIPING CONFIGURATION. INCLUDE FOR PIPE FREEZING TO FACILITATE NEW CONNECTION WITHOUT DISTURBANCE TO EXISTING SERVICES. SIZE AS INDICATED ON DRAWING.
- PROVIDE AND INSTALL NEW WALL MOUNTED DUCTLESS SPLIT A/C COMPLETE WITH REFRIGERANT LINES AND CONDENSATE PUMP. NEW 250 CONDENSATE DRAIN FROM SPLIT A/C TO EXTEND AS INDICATED AND TERMINATE INDIRECTLY OVER FUNNEL FLOOR DRAIN.
- ALLOW FOR THE REWORK OF EXISTING HEATING WATER SUPPLY PIPING AND INSTALL NEW CONTROL VALVE WITHIN EXISTING PERIMETER RADIATION UNIT ENCLOSURE. INTERFACE WITH NEW BOC VAN BOX CONTROLS. COORDINATE WORK ON SITE. WORK SHALL BE PERFORMED BY XX. (TYPICAL).

KEY PLAN:

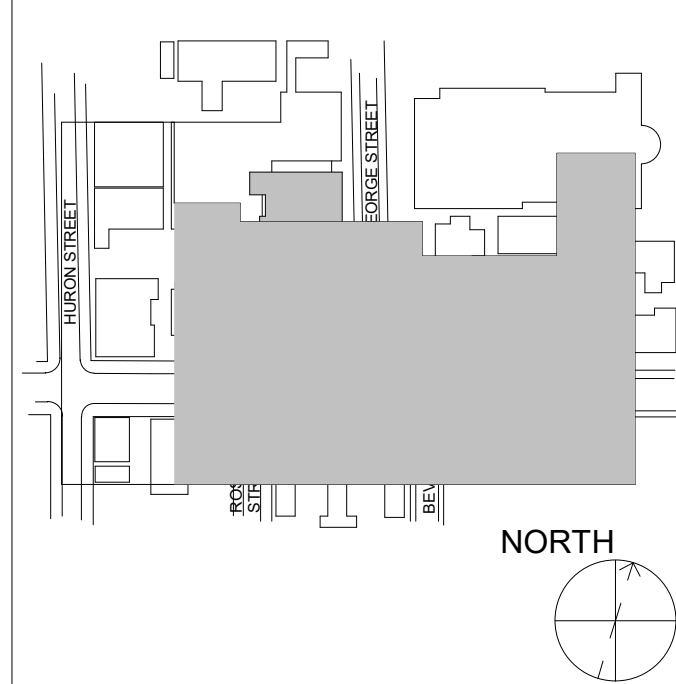

CONSTRUCTOR SHALL CHECK ALL DIMENSIONS ON THE WORK AND REPORT ANY DISCREPANCY TO THE CONSULTANT BEFORE PROCEEDING. THIS DRAWING IS NOT TO BE USED FOR CONSTRUCTION UNTIL AUTHORIZED IN WRITING BY CONSULTANT.

REVISION

NO.	DATE	DESCRIPTION
1	2024-10-04	ISSUED FOR 50% REVIEW
2	2024-11-01	PROGRESS ISSUANCE
3	2024-11-14	ISSUED FOR PERMIT
4	2024-12-04	ISSUED FOR FAS REVIEW
5	2025-01-24	ISSUED FOR PEER REVIEW
6	2025-01-31	ISSUED FOR BID



Smith + Andersen
1100 - 109 Sheppard Ave East, Toronto, ON, M2N 0N9
416-467-8151 smithandandersen.com

ENFORM
architects

ENFORM Architects Inc.
1284 Sheppard Road, Suite 302B
Toronto, Ontario, Canada M8R 2B7
416-546-7523
www.enformarchitects.com

SEAL:

OWNER:



UNIVERSITY OF TORONTO

PROJECT:
HEALTH AND WELLNESS CENTRE RENOVATION AT KOFFLER

214 COLLEGE ST.
TORONTO, ON M5T 3A1

SHEET CONTENTS:
THIRD FLOOR - PLUMBING AND PIPING LAYOUT

PROJECT NUMBER:
21590.003

DRAWING SCALE:
1:100

DRAWN BY:
AS

CHECKED BY:
RC/DC


DATE:
2024-02-08

SHEET NO.:
TM-3.2

REV:
6

1. PROVIDE AND INSTALL NEW VAV BOX COMPLETE WITH ASSOCIATED HANDLES, SUPPORTS, DUCTWORK, CONTROLS, CONTROL WIRING ETC.
2. PROVIDE AND INSTALL NEW RADPAC COMPLETE WITH NEW RADPAC TANK AND TRIMBS TO EXHAUST HEATING COILS AND RETURN PIPES TO THE OVERFLOW WALL-TOWALL. MODIFY EXISTING HEATING WATER SUPPLY RETURN PIPES TO SUIT NEW AIR AS REQUIRED. REMOVE EXISTING PNEUMATIC CONTROL VALVE AND RELOCATE TO THE NEW WAY-OUT DUCT. VALVE ON SUPPLY SIDE. REFER TO DRAWING FOR LENGTH (TYPICAL).
3. CONNECT NEW DUCTWORK TO EXISTING DUCTWORK AND EXTEND AS INDICATED. REFER TO DRAWING FOR LENGTH (TYPICAL).
4. PROVIDE NEW SIZE OF 24"x24" OR 40"x24" RETURN AIR GRILLE AS INDICATED ON DRAWING.
5. PROVIDE ACoustically LINEAR TRANSFER AIR DUCT IN LOCATION SHOWN, FREE AREA INDICATED. QUOTE DUCT, TOTAL FLOOR TO FLOOR CLEARANCE AND SILENT GLASS PANEL AND SITE CONDITIONS.
 TA-0.4 PROVIDE A TOTAL FREE AREA OF 0.6 SQ. METERS
 TA-0.5 PROVIDE A TOTAL FREE AREA OF 0.7 SQ. METERS
 TA-0.6 PROVIDE A TOTAL FREE AREA OF 0.8 SQ. METERS
 TA-0.7 PROVIDE A TOTAL FREE AREA OF 0.9 SQ. METERS
 TA-0.8 PROVIDE A TOTAL FREE AREA OF 1.0 SQ. METERS
 TA-0.9 PROVIDE A TOTAL FREE AREA OF 1.1 SQ. METERS
6. PROVIDE AND INSTALL NEW NPFA COMB 2 TYPE 1 INCORPORATING HOOD COMPLETE WITH INTEGRAL DETECT, FIRE SUPPRESSANT DISPENSER, GAS DETECT MEASUREMENTS AND BASE BULGING-FIRE ALARM IN WITH ELECTRICAL DIVISION. REFER TO TA-0.3 & TA-0.4 FOR CHITCHER HOOD DETAIL DRAWINGS.
7. PROVIDE ALL DUCTWORK DOWNSTREAM OF TERMINAL EQUIPMENT (I.E. VAV BOX) OUTLET. TO THE EXHAUST. PROVIDE DETAIL DRAWINGS FOR EACH DUCT. PROVIDE DETAIL DRAWINGS FOR EACH DUCT. INCREASE THE DUCT SIZE TO AT LEAST NEAREST EVEN I.E. (PROVIDE 14" FOR 12") OR (16" OUTLET). PROVIDE TRANSITION DUCTS AS REQUIRED.
8. TO BE SET BY THE ARCHITECT. PROVIDE AN O.K. AND AS REQUIRED THE INTERIOR DESIGNER MAY SHOW, REFER TO LOCATIONS, COORDINATE FINAL LOCATION WITH THE INTERIOR DESIGNER WITH OFFICE LOCATION SHOWN. ALL LOCATIONS OUTSIDE OF THIS RANGE SHALL BE REVIEWED WITH THE ARCHITECT.
9. INSTALL THRESHOLDS MINIMALLY AT 1/4" ABOVE THE FINISHED FLOOR UNLESS INDICATED OTHERWISE.

ENFORM Architects Inc.
128A Sterling Road, Suite 302B
Toronto, Ontario, Canada M6R 2B7
t: 647-948-7523
www.enformarchitects.com

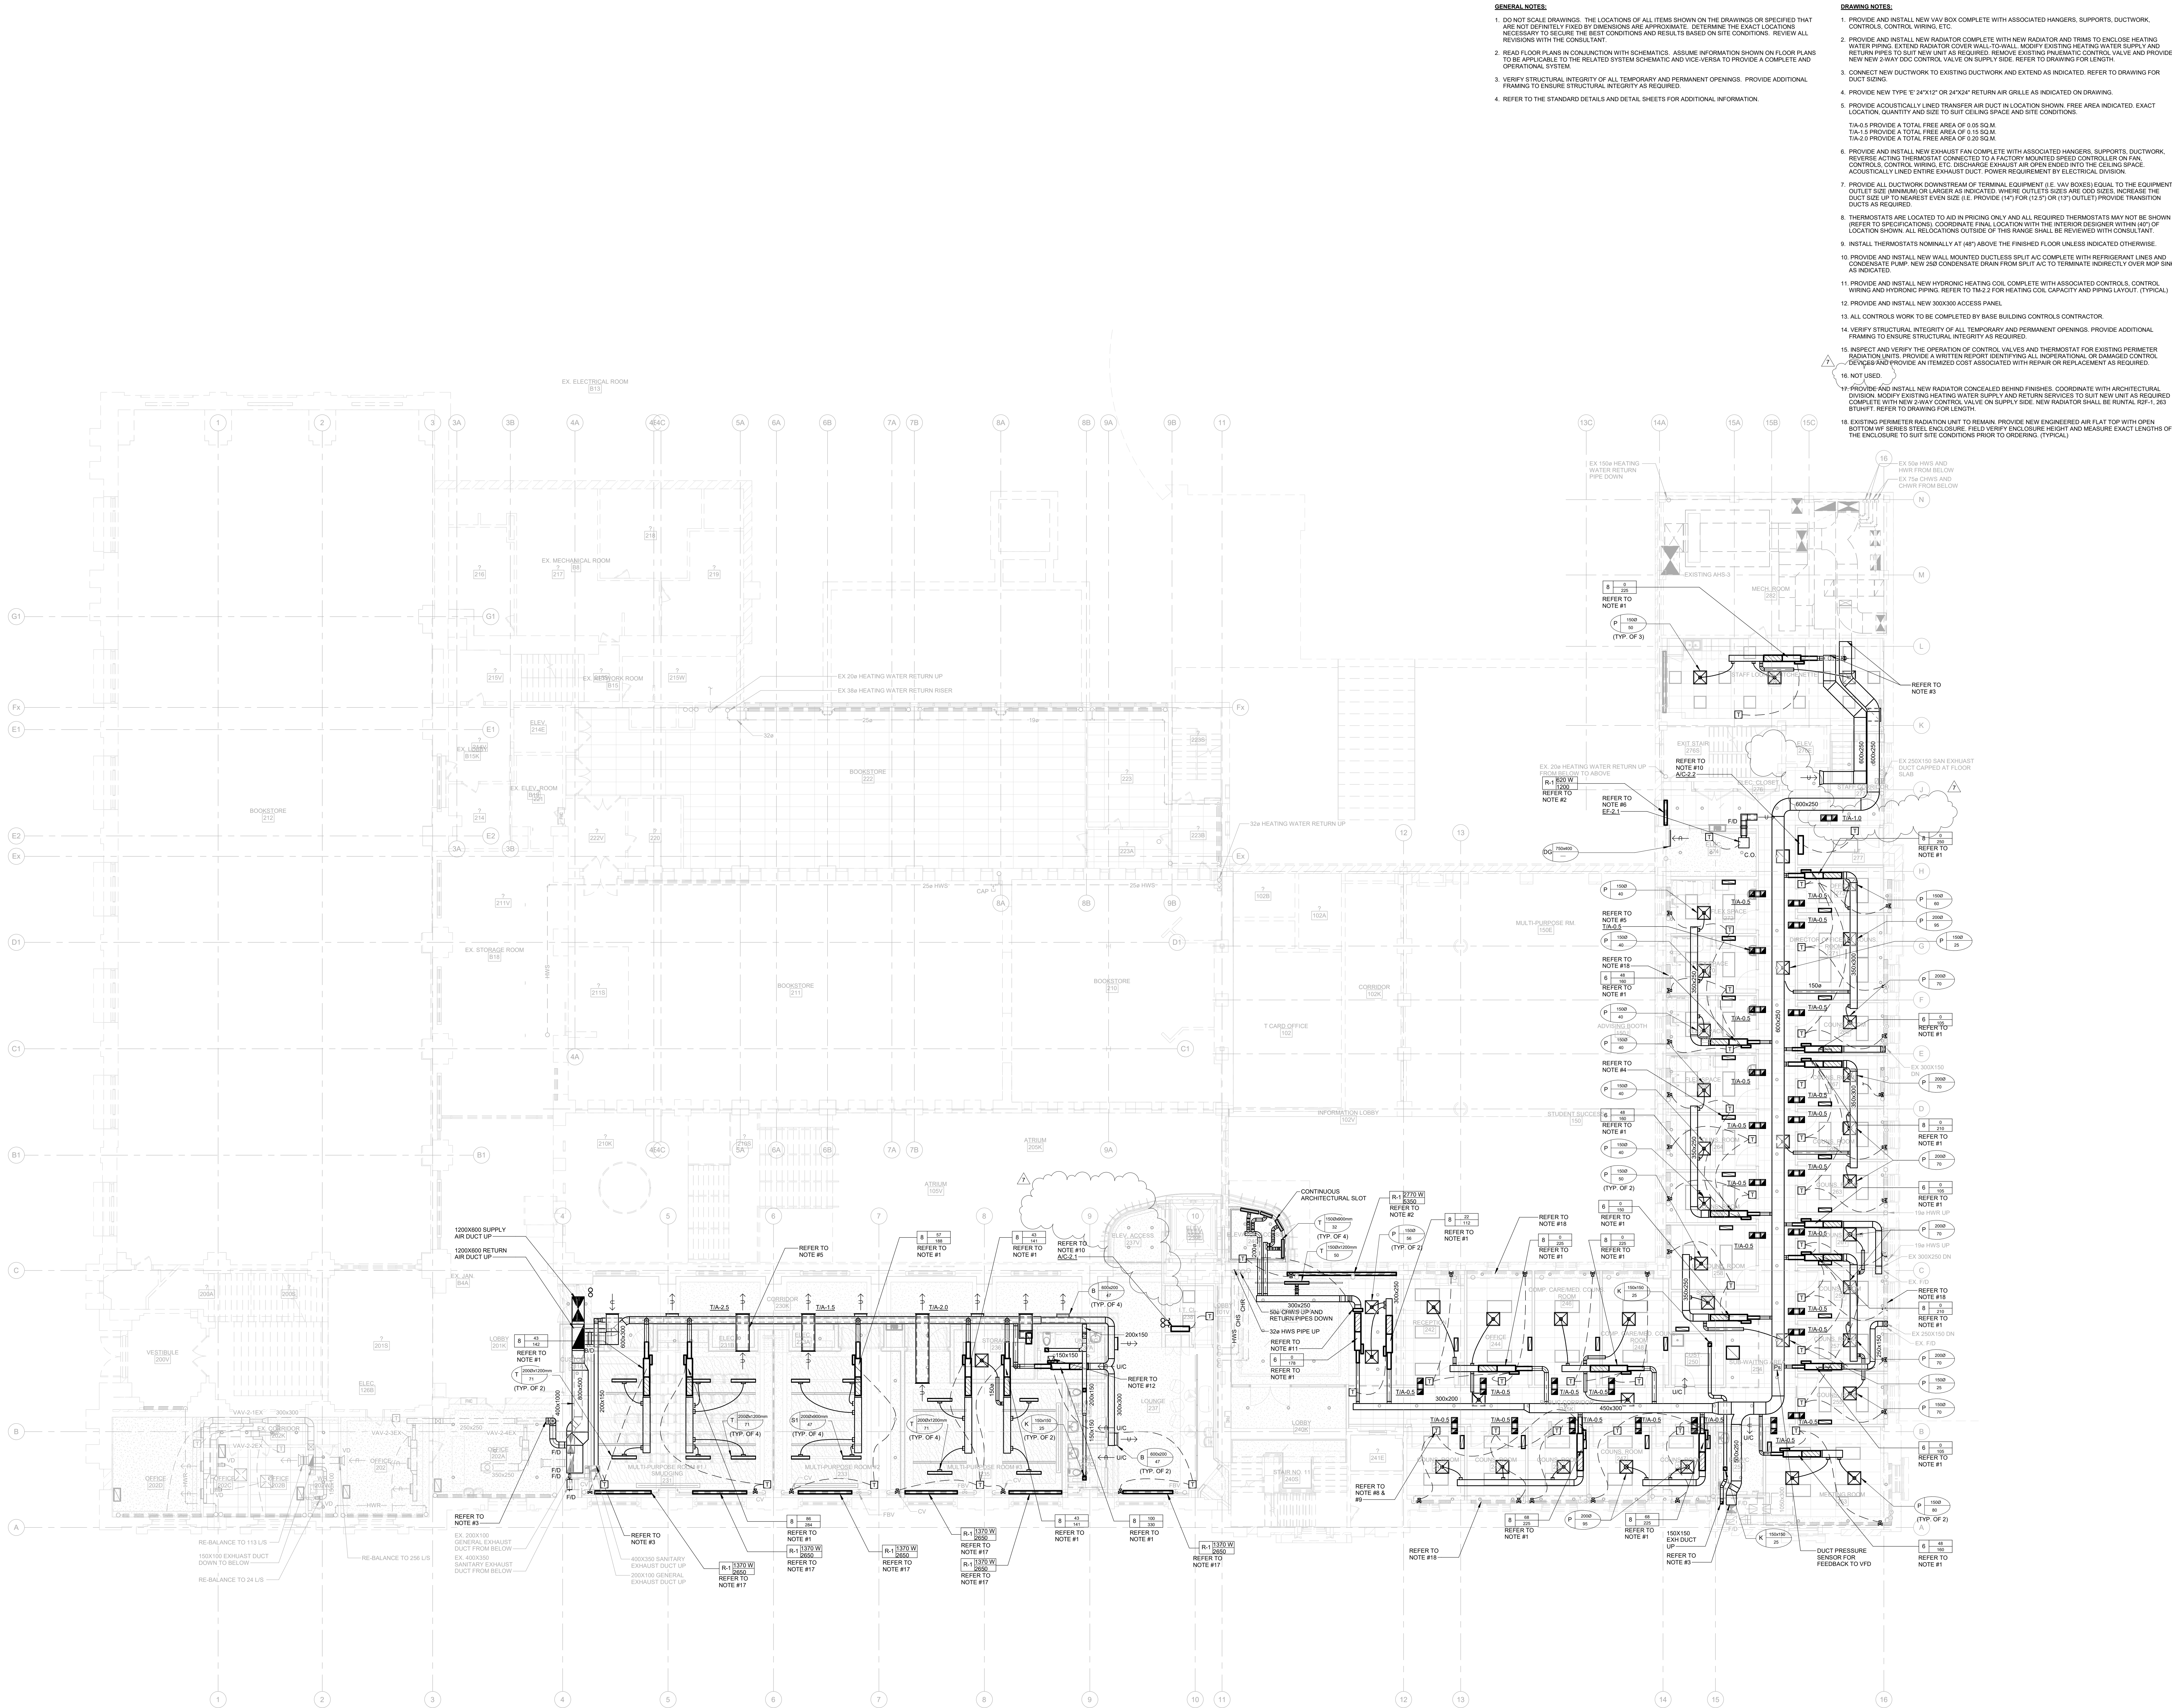


GENERAL NOTES:

1. DO NOT SCALE DRAWINGS. THE LOCATIONS OF ALL ITEMS SHOWN ON THE DRAWINGS OR SPECIFIED THAT ARE NOT DEFINITELY FIXED BY DIMENSIONS ARE APPROXIMATE. DETERMINE THE EXACT LOCATIONS NECESSARY TO REQUIRE THE BEST CONDITIONS AND RESULTS BASED ON SITE CONDITIONS. REVIEW ALL REVISIONS WITH THE CONSULTANT.
2. READ FLOOR PLANS IN CONJUNCTION WITH SCHEMATICS. ASSUME INFORMATION SHOWN ON FLOOR PLANS TO BE APPLICABLE TO THE RELATED SYSTEM SCHEMATIC AND VICE-VERSA TO PROVIDE A COMPLETE AND OPERATIONAL SYSTEM.
3. VERIFY STRUCTURAL INTEGRITY OF ALL TEMPORARY AND PERMANENT OPENINGS. PROVIDE ADDITIONAL FRAMING TO ENSURE STRUCTURAL INTEGRITY AS REQUIRED.
4. REFER TO THE STANDARD DETAILS AND DETAIL SHEETS FOR ADDITIONAL INFORMATION.

DRAWING NOTES:

1. PROVIDE AND INSTALL NEW VAV BOX COMPLETE WITH ASSOCIATED HANGERS, SUPPORTS, DUCTWORK, CONTROLS, CONTROL WIRING, ETC.
2. PROVIDE AND INSTALL NEW RADIATOR COMPLETE WITH NEW RADIATOR AND TRIMS TO ENCLOSE HEATING WATER PIPING. EXTEND RADIATOR COVER WALL-TO-WALL. MODIFY EXISTING HEATING WATER SUPPLY AND RETURN PIPES TO SUIT NEW UNIT AS REQUIRED. REMOVE EXISTING PNEUMATIC CONTROL VALVE AND PROVIDE NEW NEW 2-WAY GPC CONTROL VALVE ON SUPPLY SIDE. REFER TO DRAWING FOR LENGTH.
3. CONNECT NEW DUCTWORK TO EXISTING DUCTWORK AND EXTEND AS INDICATED. REFER TO DRAWING FOR DUCT SIZING.
4. PROVIDE NEW TYPE 'E' 34"X12" OR 24"X24" RETURN AIR GRILLE AS INDICATED ON DRAWING.
5. PROVIDE ACoustically LINED TRANSFER AIR DUCT IN LOCATION SHOWN. FREE AREA INDICATED. EXACT LOCATION, QUANTITY AND SIZE TO SUIT CEILING SPACE AND SITE CONDITIONS.
TIA-3 PROVIDE A TOTAL FREE AREA OF 0.85 SQ M
TIA-15 PROVIDE A TOTAL FREE AREA OF 0.15 SQ M
TIA-23 PROVIDE A TOTAL FREE AREA OF 0.20 SQ M.
6. PROVIDE AND INSTALL NEW EXHAUST FAN COMPLETE WITH ASSOCIATED HANGERS, SUPPORTS, DUCTWORK, REVERSE ACTING THERMOSTAT CONNECTED TO A FACTORY MOUNTED SPEED CONTROLLER ON FAN CONTROLS, CONTROL WIRING, ETC. DISCHARGE EXHAUST AIR OPEN ENDED INTO THE CEILING SPACE. ACoustically LINED ENTIRE EXHAUST DUCT. POWER REQUIREMENT BY ELECTRICAL DIVISION.
7. PROVIDE ALL DUCTWORK DOWNSTREAM OF TERMINAL EQUIPMENT (I.E. VAV BOXES) EQUAL TO THE EQUIPMENT OUTLET SIZE. MINIMUM OR LARGER AS INDICATED. WHERE OUTLET SIZES ARE ODD SIZES, INCREASE THE DUCT SIZE UP TO NEAREST EVEN SIZE (I.E. PROVIDE 14" FOR 12.5" OR 17.5" OUTLET) PROVIDE TRANSITION DUCTS AS REQUIRED.
8. THERMOSTATS ARE LOCATED TO AID IN PIPING ONLY AND ALL REQUIRED THERMOSTATS MAY NOT BE SHOWN (REFER TO SPECIFICATIONS). COORDINATE FINAL LOCATION WITH THE INTERIOR DESIGNER WITHIN 40" OF LOCATION SHOWN. ALL RELOCATIONS OUTSIDE OF THIS RANGE SHALL BE REVIEWED WITH CONSULTANT.
9. INSTALL THERMOSTATS NORMALLY AT 48" ABOVE THE FINISHED FLOOR UNLESS INDICATED OTHERWISE.
10. PROVIDE AND INSTALL NEW WALL MOUNTED DUCTLESS SPLIT A/C COMPLETE WITH REFRIGERANT LINES AND CONDENSATE PUMP. NEW 258 CONDENSATE DRAIN FROM SPLIT A/C TO TERMINATE INDIRECTLY OVER MOP SINK AS INDICATED.
11. PROVIDE AND INSTALL NEW HYDRONIC HEATING COIL COMPLETE WITH ASSOCIATED CONTROLS, CONTROL WIRING AND HYDRONIC PIPING. REFER TO TM-2.2 FOR HEATING COIL CAPACITY AND PIPING LAYOUT. (TYPICAL)
12. PROVIDE AND INSTALL NEW 300X300 ACCESS PANEL.
13. ALL CONTROLS WORK TO BE COMPLETED BY BASE BUILDING CONTROLS CONTRACTOR.
14. VERIFY STRUCTURAL INTEGRITY OF ALL TEMPORARY AND PERMANENT OPENINGS. PROVIDE ADDITIONAL FRAMING TO ENSURE STRUCTURAL INTEGRITY AS REQUIRED.
15. INSPECT AND VERIFY THE OPERATION OF CONTROL VALVES AND THERMOSTAT FOR EXISTING PERIMETER RADIATION UNITS. PROVIDE A WRITTEN REPORT IDENTIFYING ALL INFORMATION ON DAMAGED CONTROL DEVICES AND PROVIDE AN ITEMIZED COST ASSOCIATED WITH REPAIR OR REPLACEMENT AS REQUIRED.
16. NOT USED.
17. PROVIDE AND INSTALL NEW RADIATOR CONCEALED BEHIND FINISHES. COORDINATE WITH ARCHITECTURAL DIVISION. MODIFY EXISTING HEATING WATER SUPPLY AND RETURN SERVICES TO SUIT NEW UNIT AS REQUIRED. COMPLETE WITH NEW 2-WAY CONTROL VALVE ON SUPPLY SIDE. NEW RADIATOR SHALL BE RENTAL R2F-1, 263 STUMPY. REFER TO DRAWING FOR LENGTH.
18. EXISTING PERIMETER RADIATION UNIT TO REMAIN. PROVIDE NEW ENGINEERED AIR FLAT TOP WITH OPEN BOTTOM W/ SERIES STEEL ENCLOSURE. FIELD VERIFY ENCLOSURE HEIGHT AND MEASURE EXACT LENGTHS OF THE EXCLUDE TO SUIT SITE CONDITIONS PRIOR TO ORDERING. (TYPICAL)

KEY PLAN:

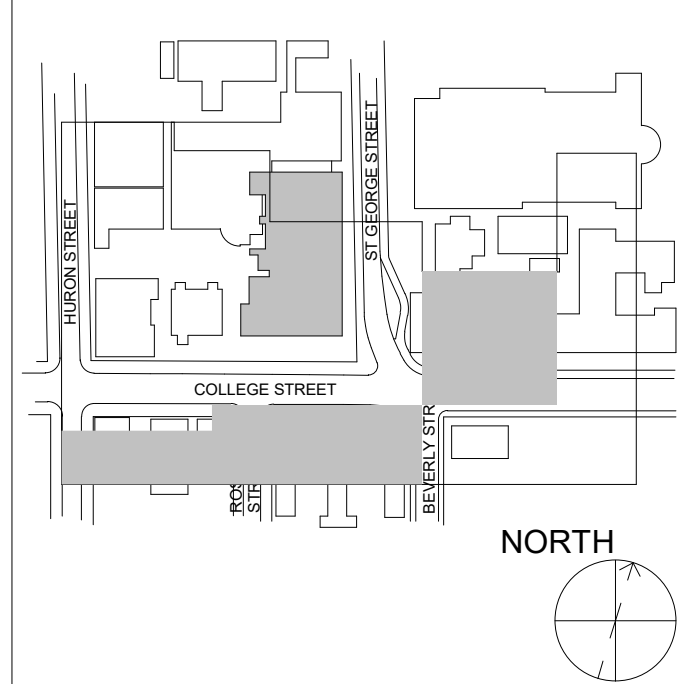

CONSTRUCTOR SHALL CHECK ALL DIMENSIONS ON THE WORK AND REPORT ANY DISCREPANCY TO THE CONSULTANT BEFORE PROCEEDING. THIS DRAWING IS NOT TO BE USED FOR CONSTRUCTION UNTIL AUTHORIZED IN WRITING BY CONSULTANT.

REVISION		
NO.	DATE	DESCRIPTION
1	2024-10-04	ISSUED FOR 50% REVIEW
2	2024-11-01	PROGRESS ISSUANCE
3	2024-11-14	ISSUED FOR PERMIT
4	2024-12-04	ISSUED FOR FAS REVIEW
5	2025-01-24	ISSUED FOR PEER REVIEW
6	2025-03-31	ISSUED FOR BID
7	2025-03-24	Bid Addendum #04



Smith + Andersen
1100 - 109 Sheppard Ave East, Toronto, ON, M2N 0N9
416-467-8151 smithandandersen.com



ENFORM architects inc.
1284 Sheppard Road, Suite 302B
Toronto, Ontario, Canada M8R 2B7
1-877-546-7523
www.enformarchitects.com

SEAL:



**HEALTH AND WELLNESS
CENTRE RENOVATION AT
KOFFLER**

214 COLLEGE ST.
TORONTO, ON M5T 3A1
SHEET CONTENTS:
**SECOND FLOOR - H.V.A.C.
LAYOUT**

PROJECT NUMBER:
21590.003
DRAWING SCALE:
1:100
DRAWN BY: AS
CHECKED BY: RC/DC
DATE: 2024-02-08
SHEET NO.: **TM-2.3**
REV: **7**

RADIATOR SCHEDULE				
TAG	MAKE	MODEL No.	CAPACITY (BTU/H/FT)	AVERAGE WATER TEMPERATURE AWT (F)
R-1	RUNTAL	R2F-1	537	160
				LENGTH (IN)
				REFER TO FLOOR PLANS
1. PROVIDE TRIM COVER TO COMPLETELY COVER ASSOCIATED EXPOSED PIPING.				
2. COLOUR: WHITE				
3. PROVIDE 75 MM CLEARANCE FROM BOTTOM OF RADIATOR.				
4. RADIATOR PIPING CONFIGURATION SHALL MATCH ROUTING ON PLAN DRAWINGS.				


1. PROVIDE TRIM COVER TO COMPLETELY COVER ASSOCIATED EXPOSED PIPING.
2. COLOUR: WHITE
3. PROVIDE 75 MM CLEARANCE FROM BOTTOM OF RADIATOR.
4. RADIATOR PIPING CONFIGURATION SHALL MATCH ROUTING ON PLAN DRAWINGS.

GENERAL NOTES:


1. DO NOT SCALE DRAWINGS. THE LOCATIONS OF ALL ITEMS SHOWN ON THE DRAWINGS OR SPECIFIED THAT ARE NOT EXPLICITLY FIXED BY DIMENSIONS ARE APPROXIMATE. DETERMINE THE EXACT LOCATIONS NECESSARY TO REQUIRE THE BEST CONDITIONS AND RESULTS BASED ON SITE CONDITIONS. REVIEW ALL REVISIONS WITH THE CONSULTANT.
2. READ FLOOR PLANS IN CONJUNCTION WITH SCHEMATICS. ASSUME INFORMATION SHOWN ON FLOOR PLANS TO BE APPLICABLE TO THE RELATED SYSTEM SCHEMATIC AND VICE-VERSA TO PROVIDE A COMPLETE AND OPERATIONAL SYSTEM.
3. VERIFY STRUCTURAL INTEGRITY OF ALL TEMPORARY AND PERMANENT OPENINGS. PROVIDE ADDITIONAL FRAMING TO ENSURE STRUCTURAL INTEGRITY AS REQUIRED.
4. REFER TO THE STANDARD DETAILS AND DETAIL SHEETS FOR ADDITIONAL INFORMATION.

DRAWING NOTES:

1. PROVIDE AND INSTALL NEW VAV BOX COMPLETE WITH ASSOCIATED HANGERS, SUPPORTS, DUCTWORK, CONTROLS, CONTROL WIRING, ETC.
2. PROVIDE AND INSTALL NEW HYDRONIC HEATING COIL COMPLETE WITH ASSOCIATED CONTROLS, CONTROL WIRING AND HYDRONIC PIPING. REFER TO TM-3.2 FOR HEATING COIL CAPACITY AND PIPING LAYOUT. (TYPICAL)
3. CONNECT NEW DUCTWORK TO EXISTING DUCTWORK AND EXTEND AS INDICATED. REFER TO DRAWING FOR DUCT SIZING.
4. PROVIDE NEW TYPE 'E' 24"x12" OR 24"x24" RETURN AIR GRILLE AS INDICATED ON DRAWING.
5. PROVIDE ACoustically LINED TRANSFER AIR DUCT IN LOCATION SHOWN. FREE AREA INDICATED. EXACT LOCATION, QUANTITY AND SIZE TO SUIT CEILING SPACE AND SITE CONDITIONS.
T/A-S PROVIDE A TOTAL FREE AREA OF 0.06 SQ.M.
6. PROVIDE ALL DUCTWORK DOWNSTREAM OF TERMINAL EQUIPMENT (I.E. VAV BOXES) EQUAL TO THE EQUIPMENT OUTLET SIZE IMMEDIATELY LARGER AS INDICATED. WHERE OUTLET SIZES ARE 4000 SIZES INCREASE THE DUCT SIZE UP TO NEAREST EVEN SIZE (I.E. PROVIDE (14") FOR (12") OR (15") OUTLET). PROVIDE TRANSITION DUCTS AS REQUIRED.
7. THERMOSTATS ARE LOCATED TO AD IN PRICING ONLY AND ALL REQUIRED THERMOSTATS MAY NOT BE SHOWN (REFER TO SPECIFICATIONS). COORDINATE FINAL LOCATION WITH THE INTERIOR DESIGNER WITHIN 400' OF LOCATION SHOWN. ALL RELOCATION OUTSIDE OF THIS RANGE SHALL BE REVIEWED WITH CONSULTANT.
8. INSTALL THERMOSTATS NOMINALLY AT (1200MM) ABOVE THE FINISHED FLOOR UNLESS INDICATED OTHERWISE.
9. PROVIDE AND INSTALL NEW RADIATOR COMPLETE WITH RADIATOR COVERS, AND TRIMS TO ENCLOSE PIPING AND EXTEND RADIATOR WALL-TO-WALL. WOODY EXISTING HEATING WATER SUPPLY AND RETURN SERVICES TO SUIT NEW UNIT AS REQUIRED COMPLETE WITH NEW 2WAY CONTROL VALVE ON SUPPLY SIDE. REFER TO DRAWING FOR LENGTH.
10. NEW SANITARY EXHAUST DUCTWORK SERVING WASHROOM TO BE ALUMINUM. THERMALLY INSULATE THE ENTIRE EXHAUST DUCT.
11. CONNECT NEW 250X250 SANITARY EXHAUST DUCT TO EXISTING 300X300 DUCT BELOW ROOF DECK AND EXTEND AS INDICATED.
12. CONNECT NEW 150X150 SANITARY EXHAUST DUCT TO EXISTING 300X300 DUCT BELOW ROOF DECK AND EXTEND AS INDICATED.
13. PROVIDE AND INSTALL NEW WALL MOUNTED DUCTLESS SPLIT A/C COMPLETE WITH REFRIGERANT LINES AND CONDENSATE PUMP. NEW 250 CONDENSATE DRAIN FROM SPLIT A/C TO TERMINATE INDIRECTLY OVER NEW 750 WIDE HUB DRAIN IN THE CEILING SPACE WHERE INDICATED ON DRAWING COMPLETE WITH AIR GAP. NEW 500 HUB DRAIN CONDENSATE LINE TO RUN INSIDE WALL CAVITY AND DOWN TO TAILSTOCK OF NEW SINK UPSTREAM OF P-TRAP.
14. COORDINATE WITH ARCHITECTURAL DIVISION TO HAVE GRILLE ABOVE PATIENT. EXTEND 250x4 DUCT UP TO PENDHOUSE ABOVE AS INDICATED. LABEL DUCTWORK WITH CAUTION. AIRBORNE ISOLATION ROOM EXHAUST.
15. ALL CONTROLS WORK TO BE COMPLETED BY BASE BUILDING CONTROLS CONTRACTOR.
16. VERIFY STRUCTURAL INTEGRITY OF ALL TEMPORARY AND PERMANENT OPENINGS. PROVIDE ADDITIONAL FRAMING TO ENSURE STRUCTURAL INTEGRITY AS REQUIRED.
17. INSPECT AND VERIFY THE OPERATION OF CONTROL VALVES AND THERMOSTAT FOR EXISTING PERIMETER RADIATION UNITS. PROVIDE A WRITTEN REPORT IDENTIFYING ALL OPERATIONAL OR DAMAGED CONTROL DEVICES AND PROVIDE AN ITEMIZED COST ASSOCIATED WITH REPAIR OR REPLACEMENT AS REQUIRED.
18. EXISTING AIR HANDLING UNITS TO REMAIN. INSPECT AND VERIFY THE OPERATION OF EXISTING AHS-3, AHS-4, AHS-7. PROVIDE A WRITTEN REPORT IDENTIFYING ALL IN OPERATIONAL OR DAMAGED CONTROL DEVICES AND PROVIDE AN ITEMIZED COST ASSOCIATED WITH REPAIR OR REPLACEMENT AS REQUIRED.
19. PROVIDE AND INSTALL NEW EXHAUST FAN COMPLETE WITH ASSOCIATED HANGERS, SUPPORTS, DUCTWORK, CONTROLS, CONTROL WIRING, ETC. POWER REQUIREMENT BY ELECTRICAL DIVISION.
20. PROVIDE AND INSTALL NEW BYPASS BOX COMPLETE WITH ASSOCIATED HANGERS, SUPPORTS, DUCTWORK, CONTROLS, CONTROL WIRING, ETC.
21. LOCATION OF 1201/60 - 15 AMP POWER FOR CONTROLS.
22. EXISTING PERIMETER RADIATION UNIT TO REMAIN. PROVIDE NEW ENGINEERED AIR FLAT TOP WITH OPEN BOTTOM W/ SERIES STEEL ENCLOSURE. FIELD VERIFY ENCLOSURE HEIGHT AND MEASURE EXACT LENGTHS OF THE ENCLOSURE TO SUIT SITE CONDITIONS PRIOR TO ORDERING.
23. PROVIDE AND INSTALL NEW EXHAUST FAN COMPLETE WITH ASSOCIATED HANGERS, SUPPORTS, DUCTWORK. REVERSE ACTING THERMOSTAT CONNECTED TO A FACTORY MOUNTED SPEED CONTROLLER ON FAN CONTROLS. CONTROL WIRING, ETC. DISBURSE EXHAUST FAN OPENED INTO THE CEILING SPACE. ACoustically LINED ENTIRE EXHAUST DUCT. POWER REQUIREMENT BY ELECTRICAL DIVISION.
24. PROVIDE NEW SOUND Baffle (S.B.) WITHIN PERIMETER RADIATOR UNIT. (TYPICAL)

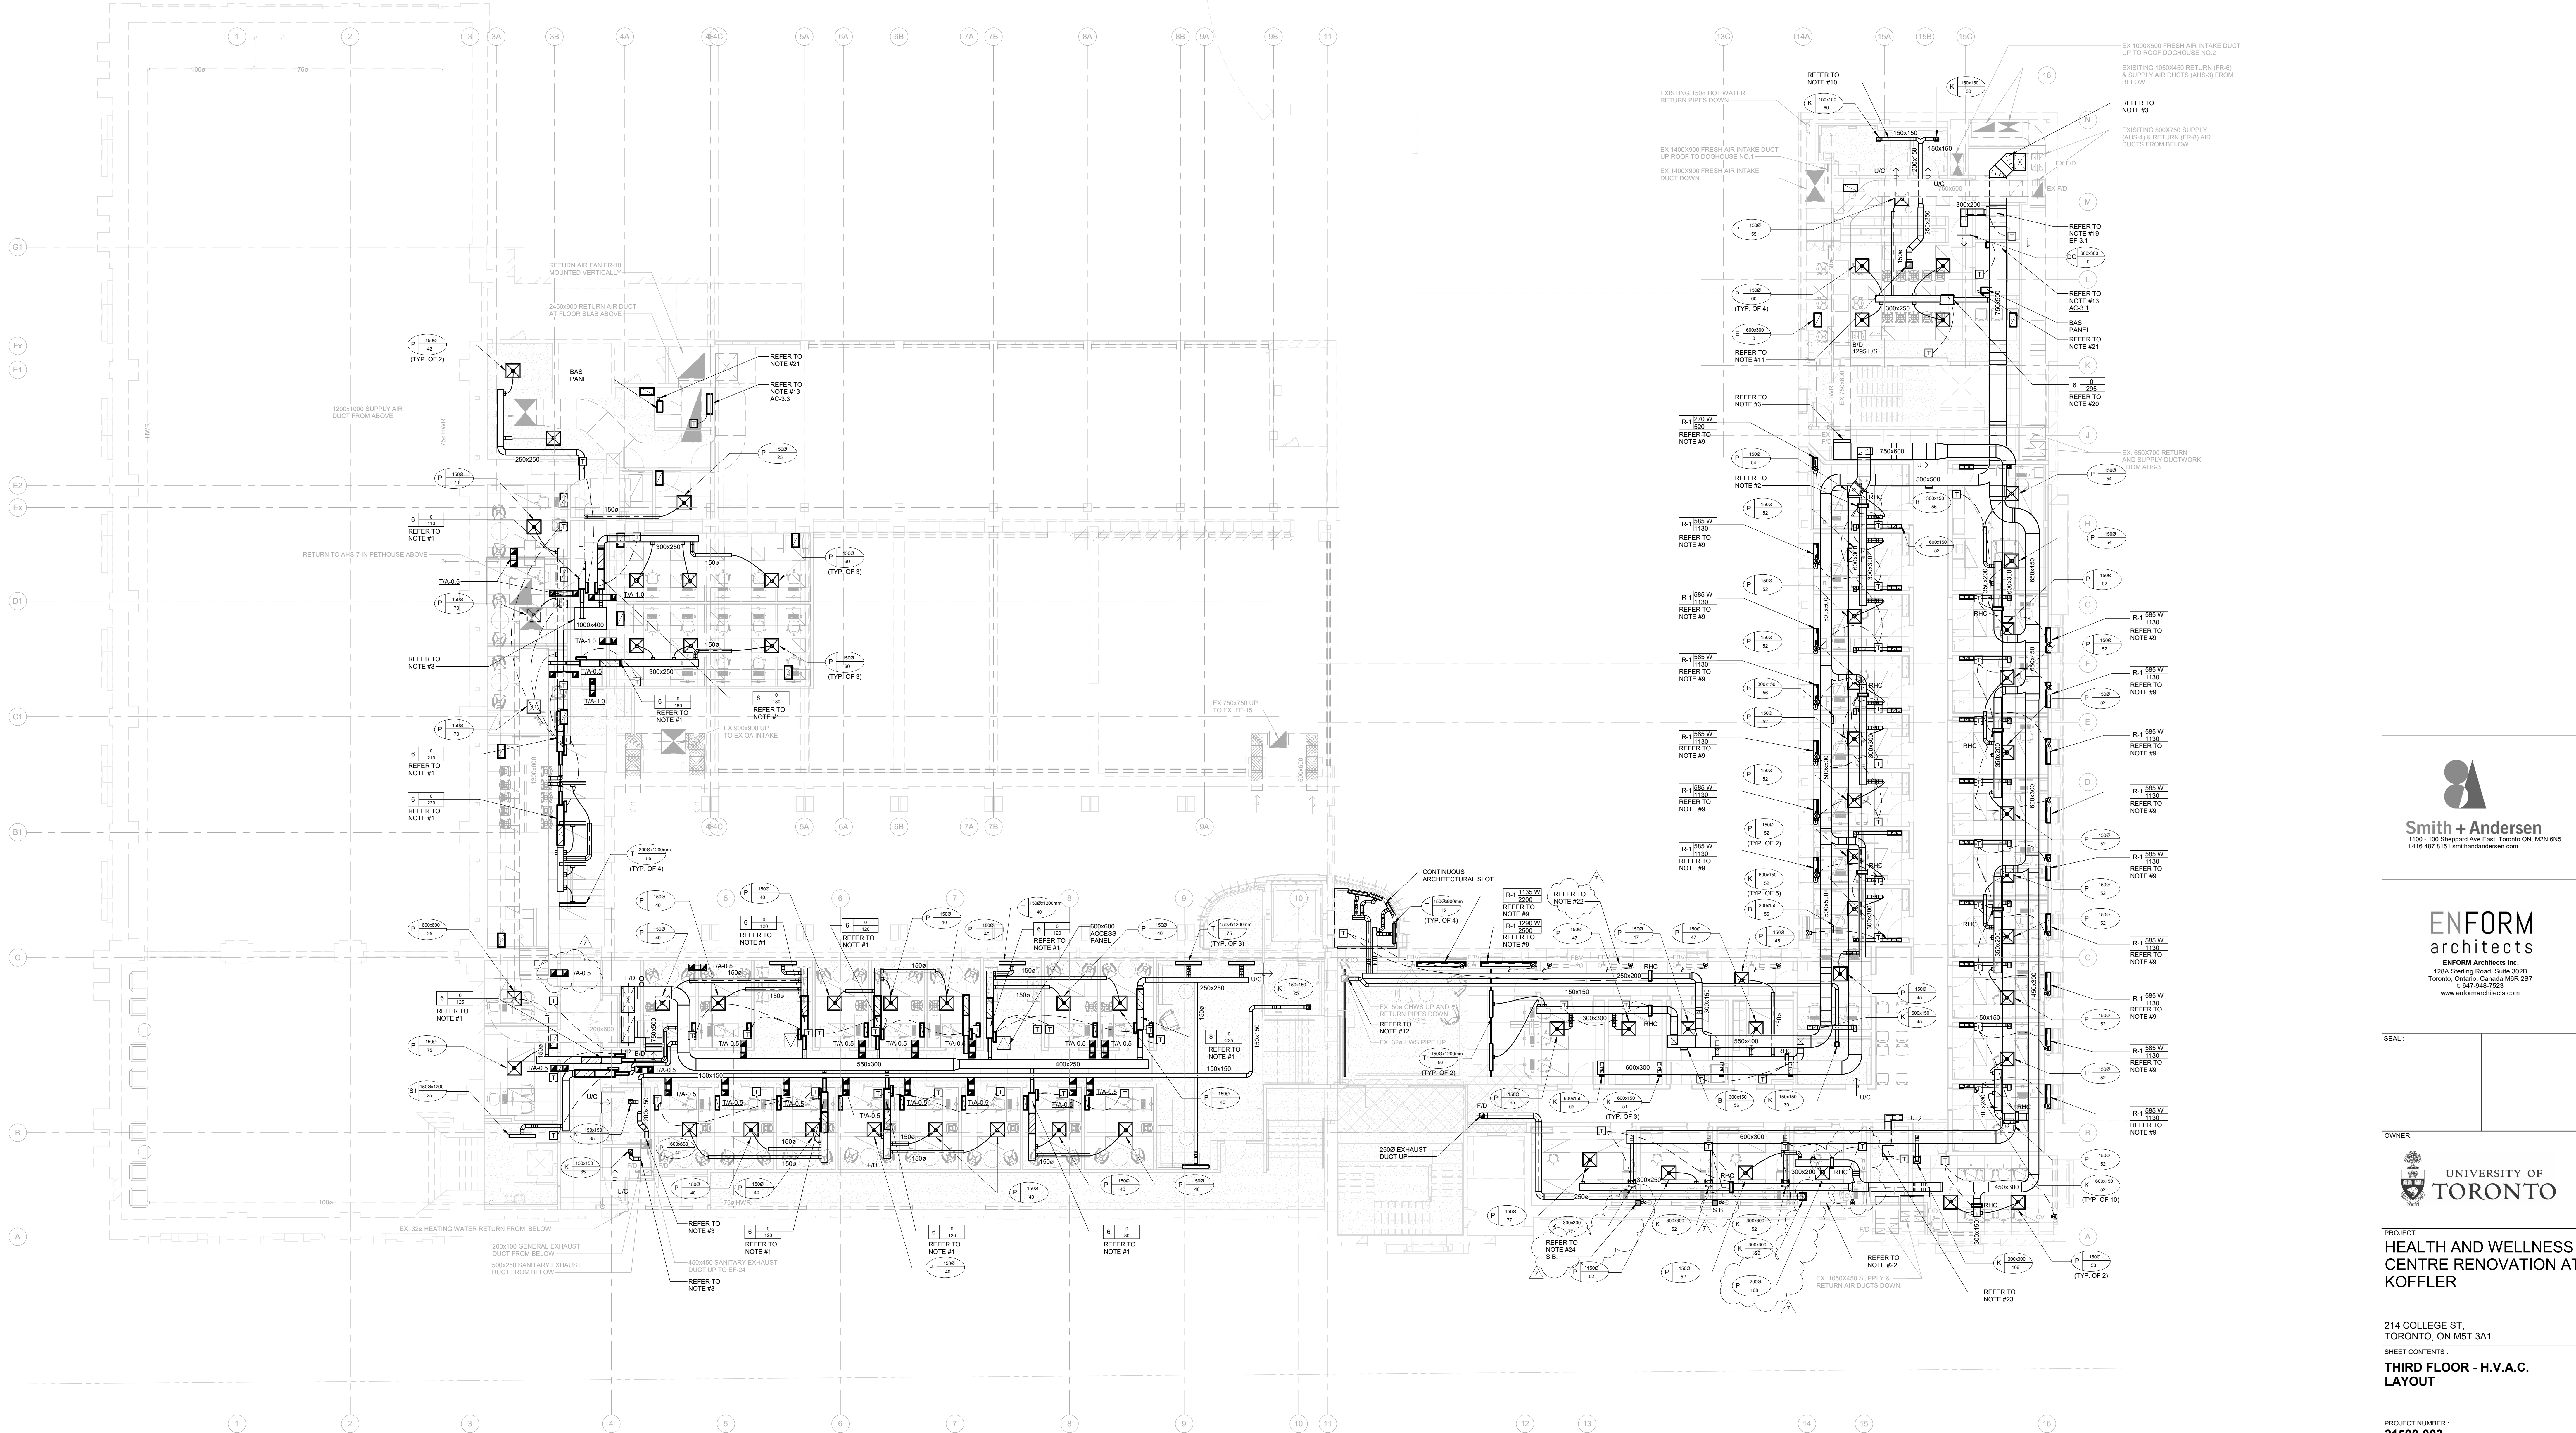

KEY PLAN:

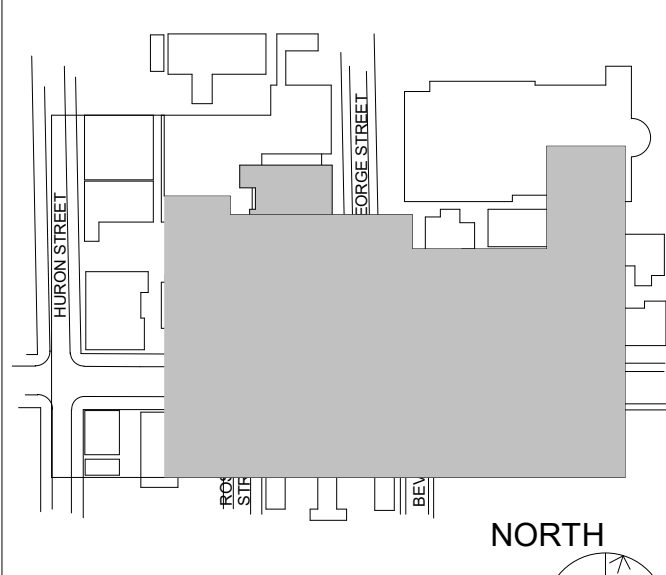

CONSTRUCTOR SHALL CHECK ALL DIMENSIONS ON THE WORK AND REPORT ANY DISCREPANCY TO THE CONSULTANT BEFORE PROCEEDING. THIS DRAWING IS NOT TO BE USED FOR CONSTRUCTION UNTIL AUTHORIZED IN WRITING BY CONSULTANT.

REVISION		
NO.	DATE	DESCRIPTION
1	2024-10-04	ISSUED FOR 50% REVIEW
2	2024-11-01	PROGRESS ISSUANCE
3	2024-11-14	ISSUED FOR PERMIT
4	2024-12-04	ISSUED FOR FAS REVIEW
5	2025-01-24	ISSUED FOR PEER REVIEW
6	2025-01-31	ISSUED FOR BID
7	2025-02-24	Bid Addendum #04

Smith + Andersen
1100 - 109 Sheppard Ave East, Toronto, ON, M2N 0N6
416-467-8153 smithandandersen.com

ENFORM architects
ENFORM Architects Inc.
1284 Sheppard Road, Suite 302B
Toronto, Ontario, Canada M8R 2B7
416-546-7523
www.enformarchitects.com


SEAL:


OWNER:
UNIVERSITY OF TORONTO


PROJECT:
HEALTH AND WELLNESS CENTRE RENOVATION AT COLLEGER

214 COLLEGE ST.
TORONTO, ON M5T 3A1
SHEET CONTENTS:
THIRD FLOOR - H.V.A.C. LAYOUT

PROJECT NUMBER:
21590.003
DRAWING SCALE:
1:100
DRAWN BY:
AS
CHECKED BY:
RC/DC
DATE:
2024-02-08
SHEET NO.:
TM-3.3
REV:
7

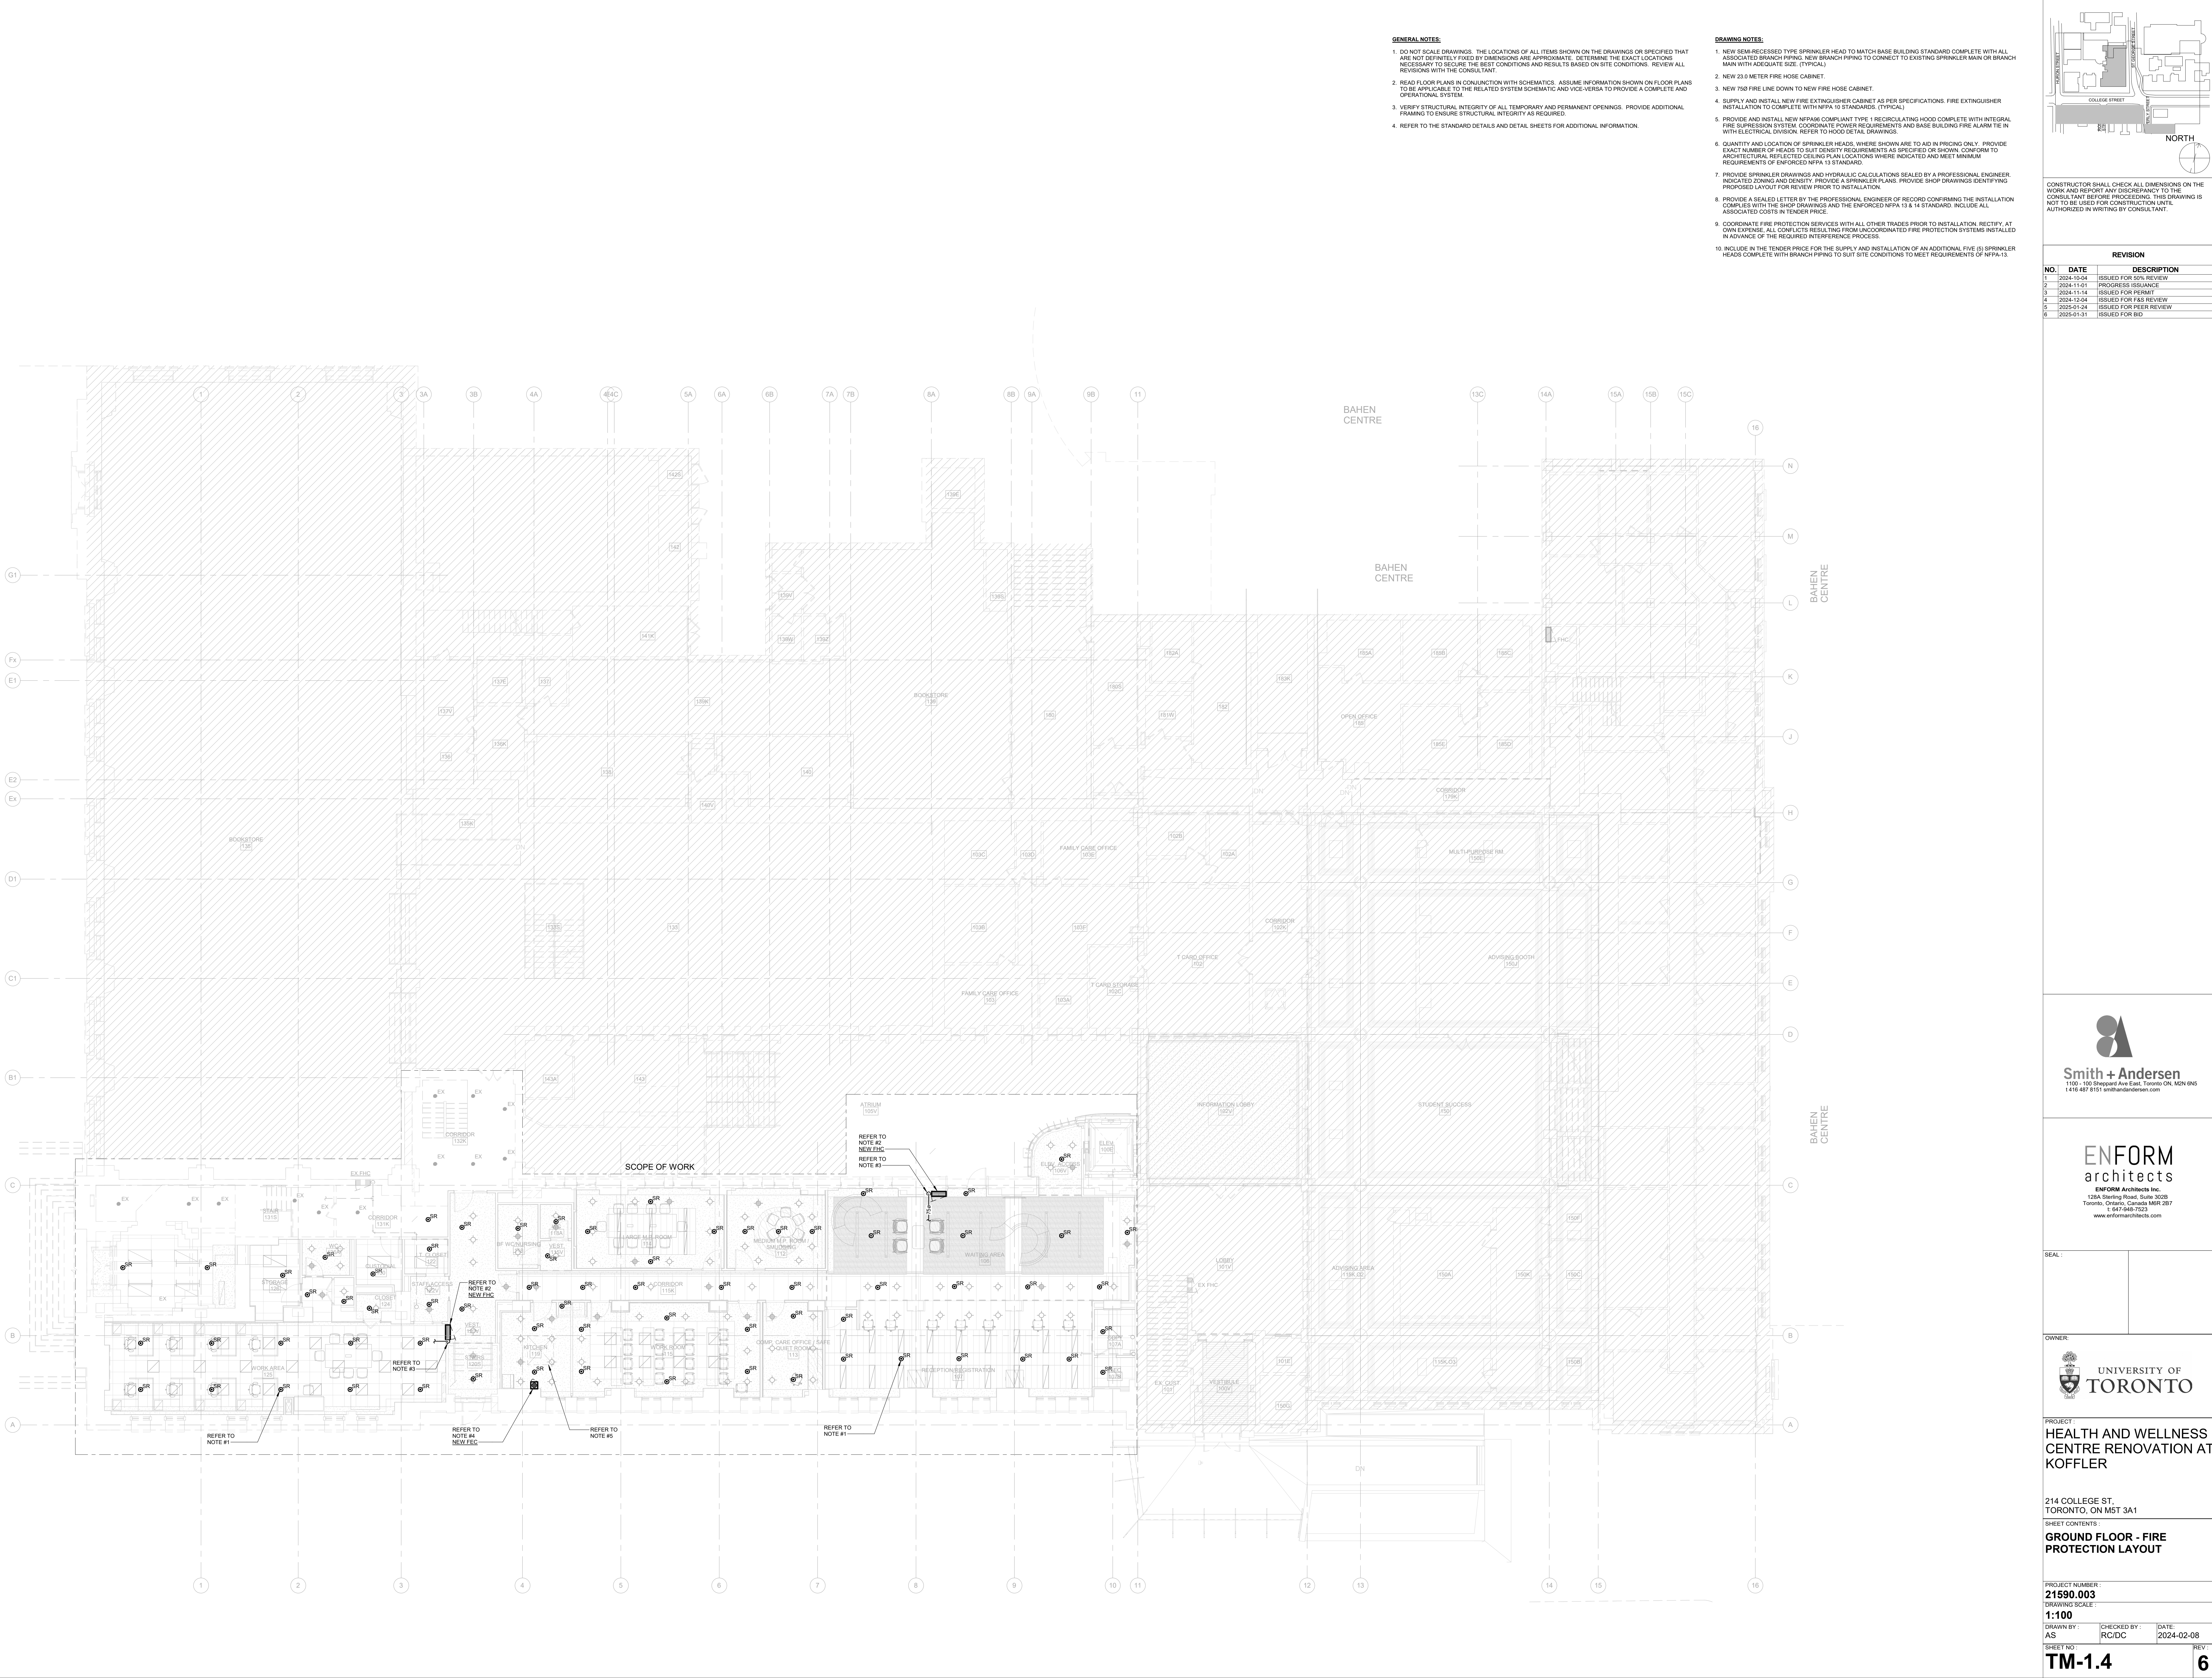

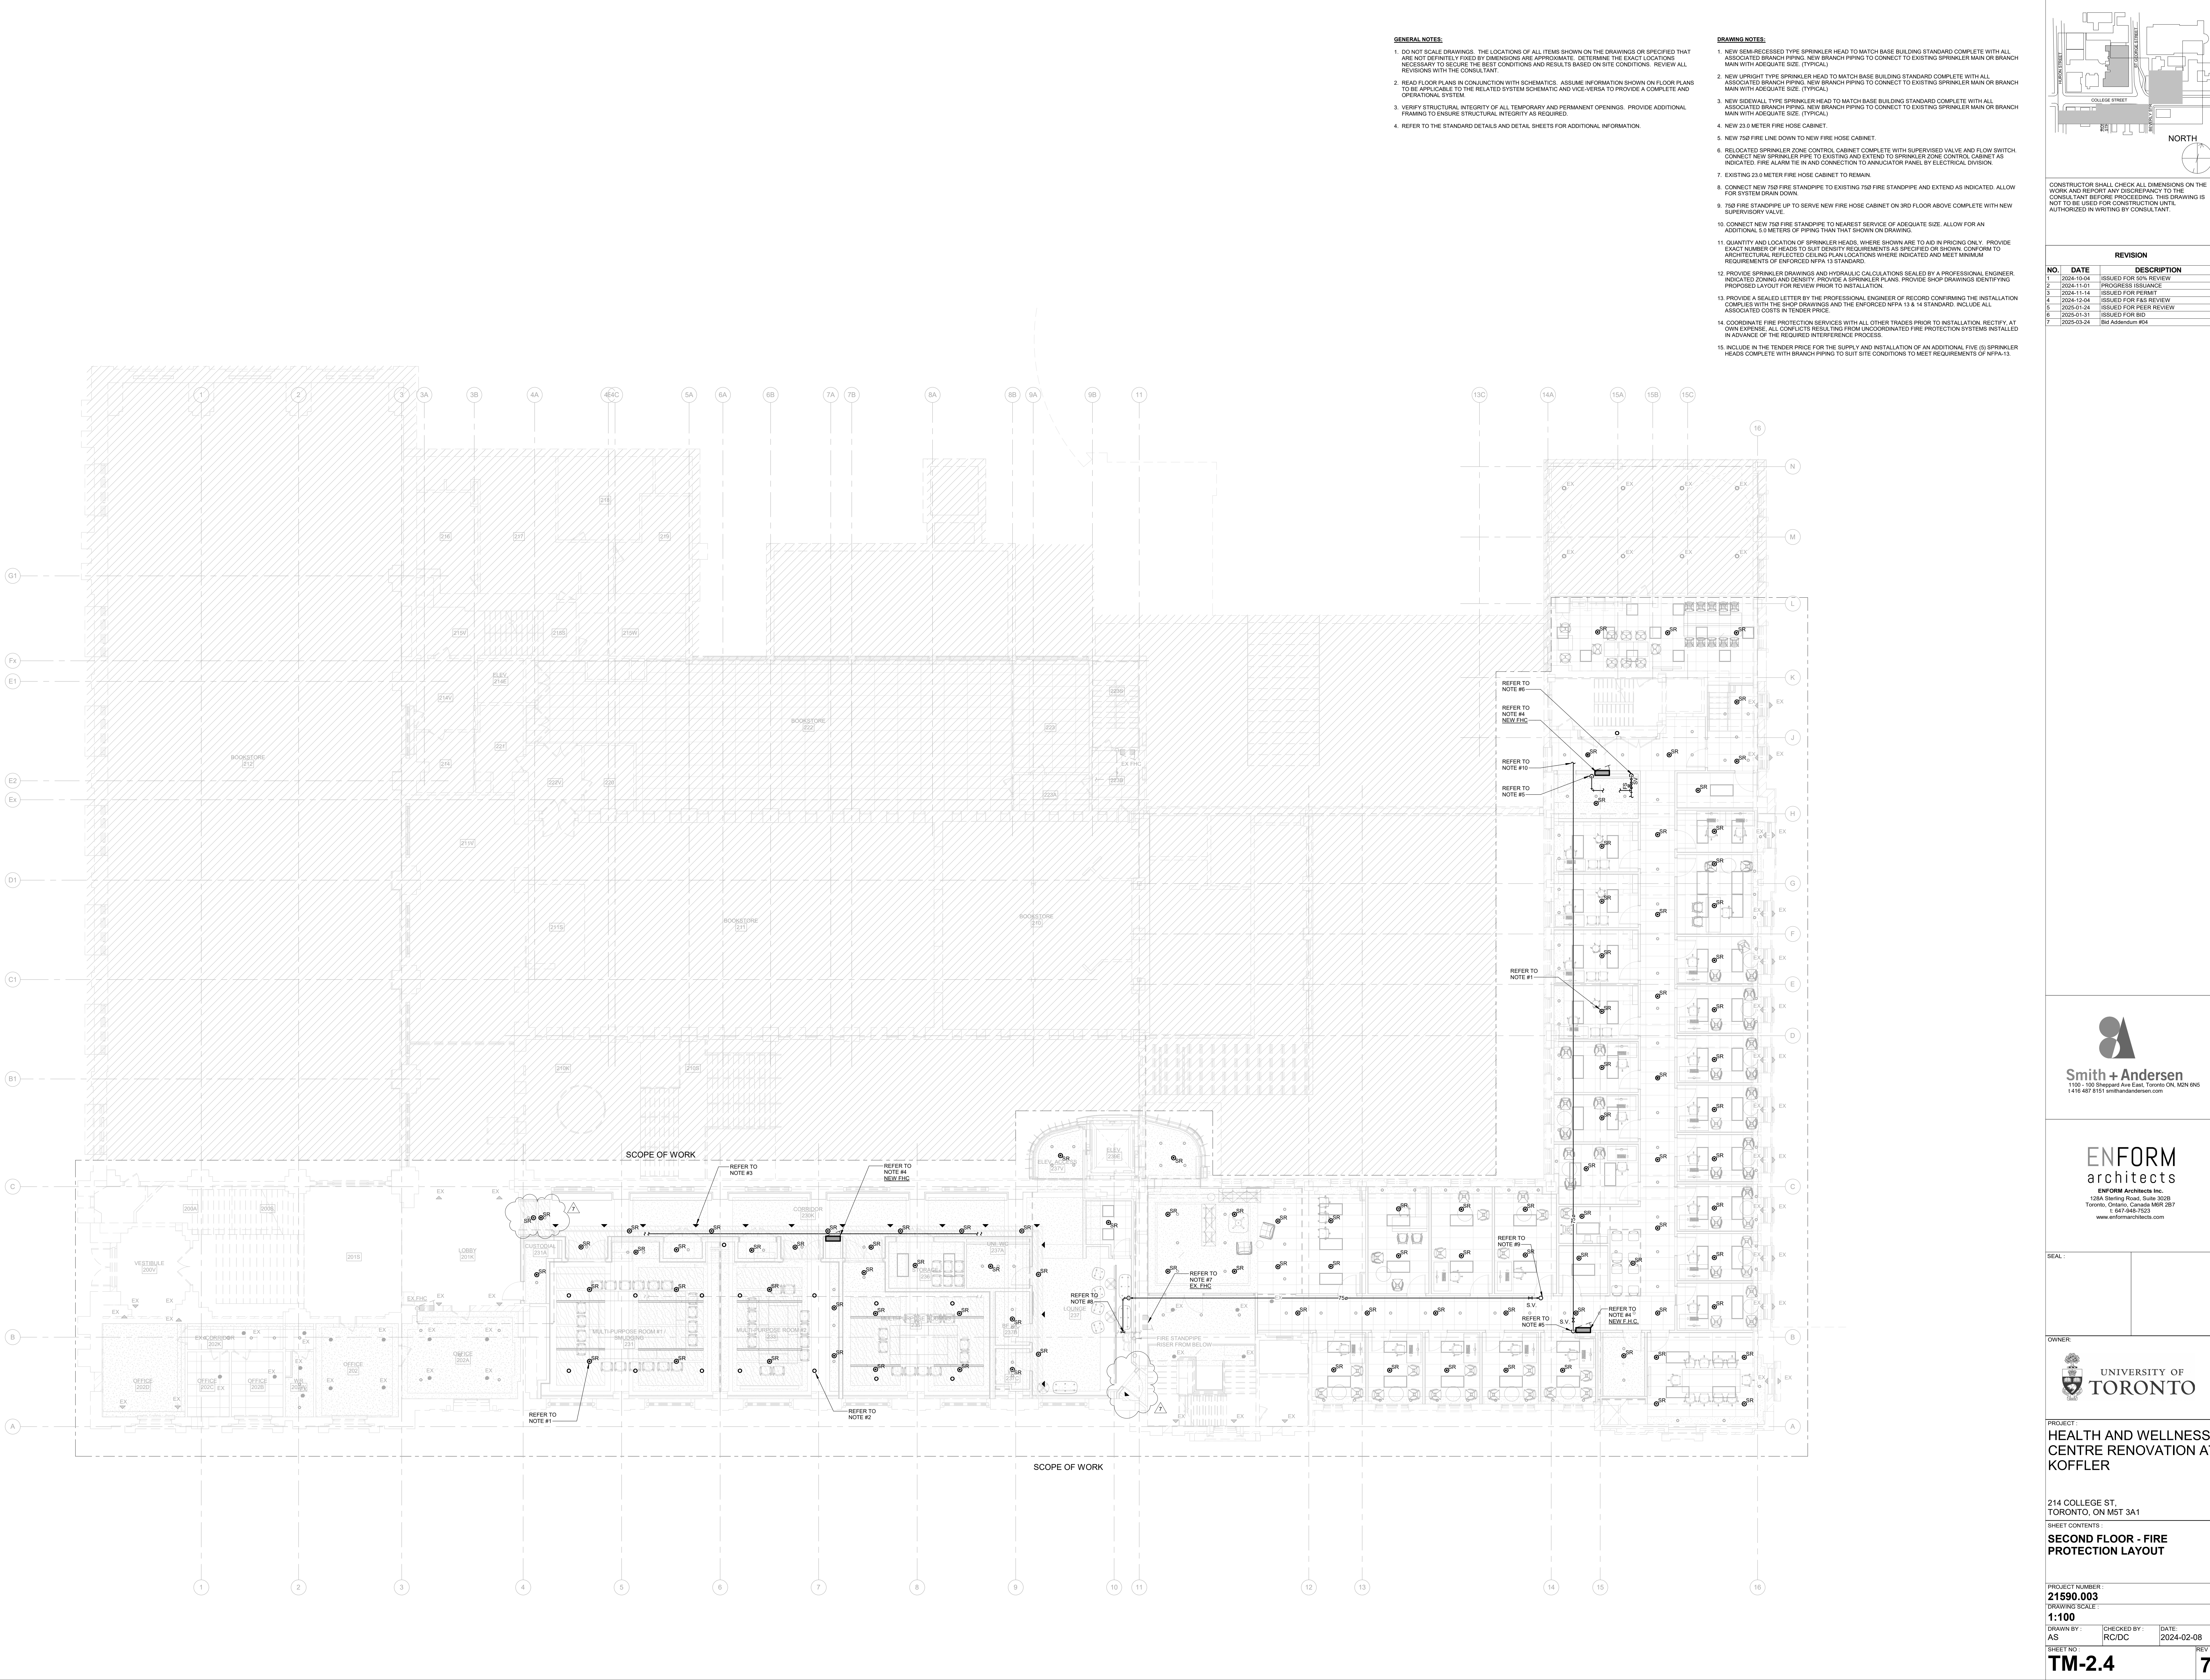

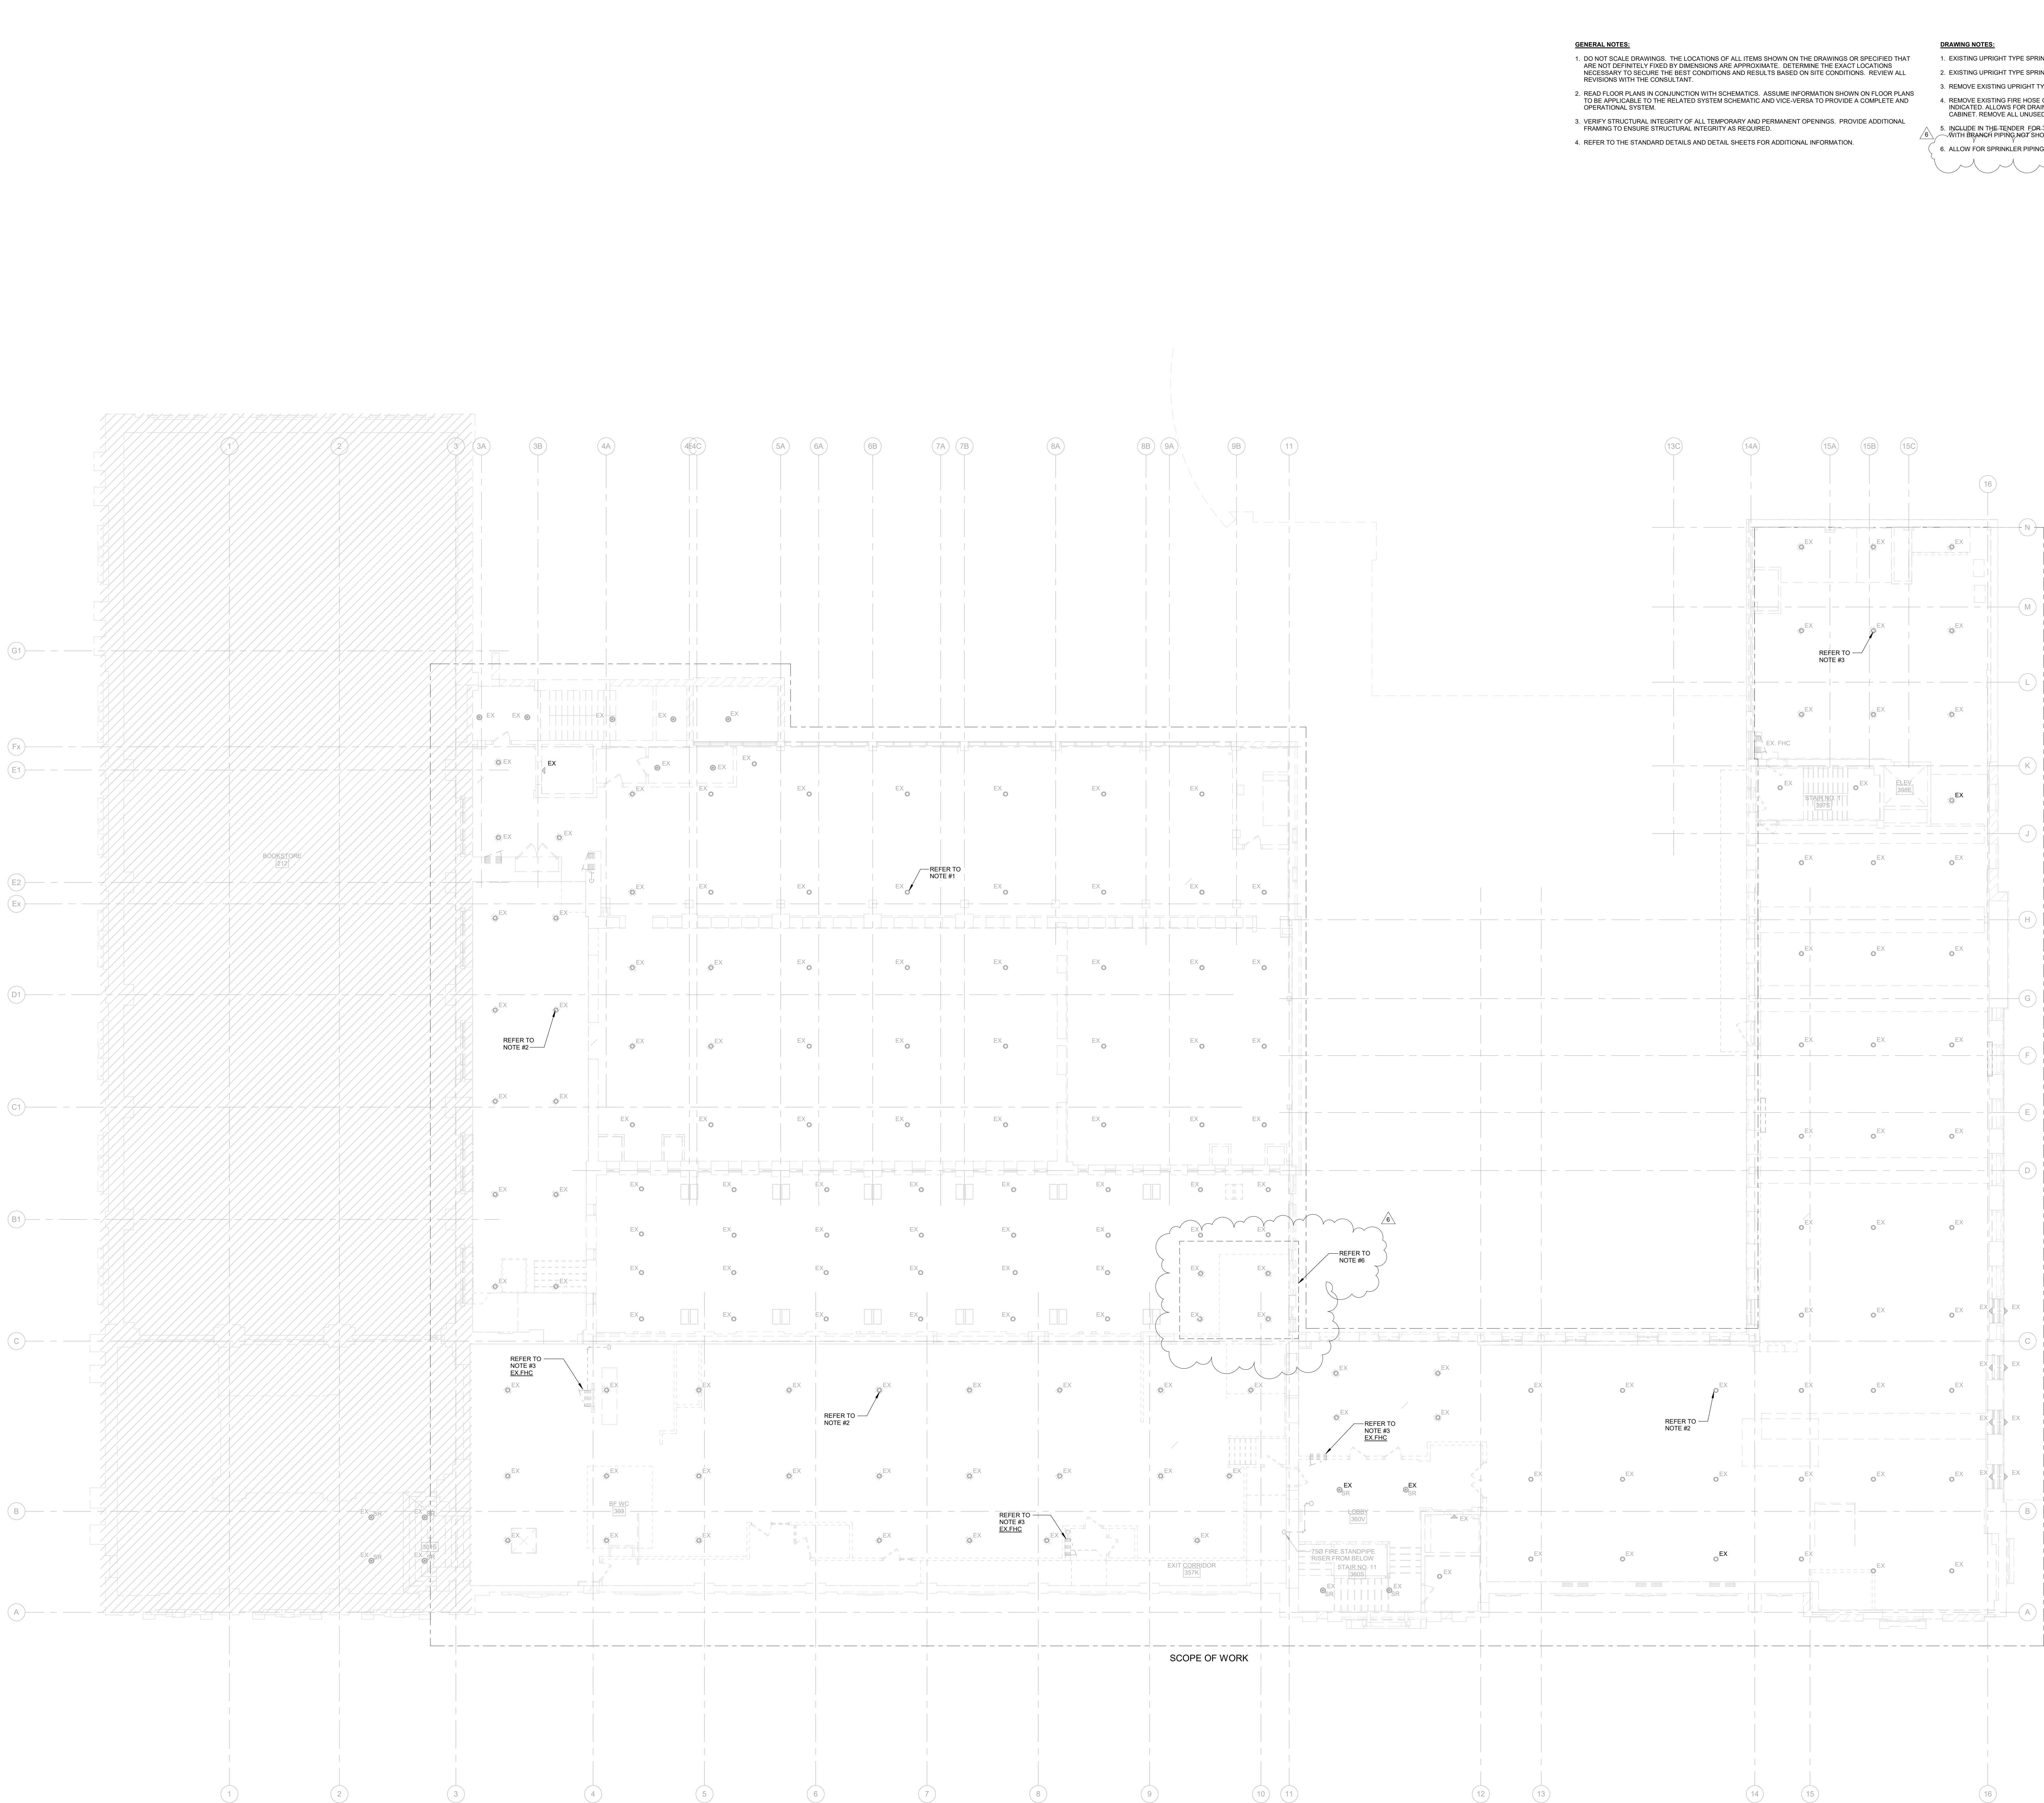


GENERAL NOTES:

- DO NOT SCALE DRAWINGS. THE LOCATIONS OF ALL ITEMS SHOWN ON THE DRAWINGS OR SPECIFIED THAT ARE NOT DEFINITELY FIXED BY DIMENSIONS ARE APPROXIMATE. DETERMINE THE EXACT LOCATIONS NECESSARY TO SECURE THE BEST CONDITIONS AND RESULTS BASED ON SITE CONDITIONS. REVIEW ALL REVISIONS WITH THE CONSULTANT.
- READ FLOOR PLANS IN CONJUNCTION WITH SCHEMATICS. ASSUME INFORMATION SHOWN ON FLOOR PLANS TO BE APPLICABLE TO THE RELATED SYSTEM SCHEMATIC AND VICE-VERSA TO PROVIDE A COMPLETE AND OPERATIONAL SYSTEM.
- VERIFY STRUCTURAL INTEGRITY OF ALL TEMPORARY AND PERMANENT OPENINGS. PROVIDE ADDITIONAL FRAMING TO ENSURE STRUCTURAL INTEGRITY AS REQUIRED.
- REFER TO THE STANDARD DETAILS AND DETAIL SHEETS FOR ADDITIONAL INFORMATION.

DRAWING NOTES:

- EXISTING UPRIGHT TYPE SPRINKLER HEADS TO REMAIN. (TYPICAL)
- EXISTING UPRIGHT TYPE SPRINKLER HEAD AT TRUSS LEVEL TO REMAIN. (TYPICAL)
- REMOVE EXISTING UPRIGHT TYPE SPRINKLER HEADS. (TYPICAL)
- REMOVE EXISTING FIRE HOSE CABINET AND CAP EXISTING 750 FIRE LINE IN THE CEILING SPACE AS INDICATED. ALLOW FOR DRAIN CROWN OF FIRE STANDPIPE RISER AND WELDING OF CAPS AT REMOVED CABINET. REMOVE ALL UNUSED PIPING FROM SITE.
- INCLUDE IN THE TENDER FOR THE REMOVAL OF AN ADDITIONAL FIVE(5) SPRINKLER HEADS COMPLETE WITH BRANCH PIPING NOT SHOWN IN THE DRAWINGS TO SUIT SITE CONDITIONS.
- ALLOW FOR SPRINKLER PIPING RE-WORK TO SUIT NEW ELEVATOR.

KEY PLAN:

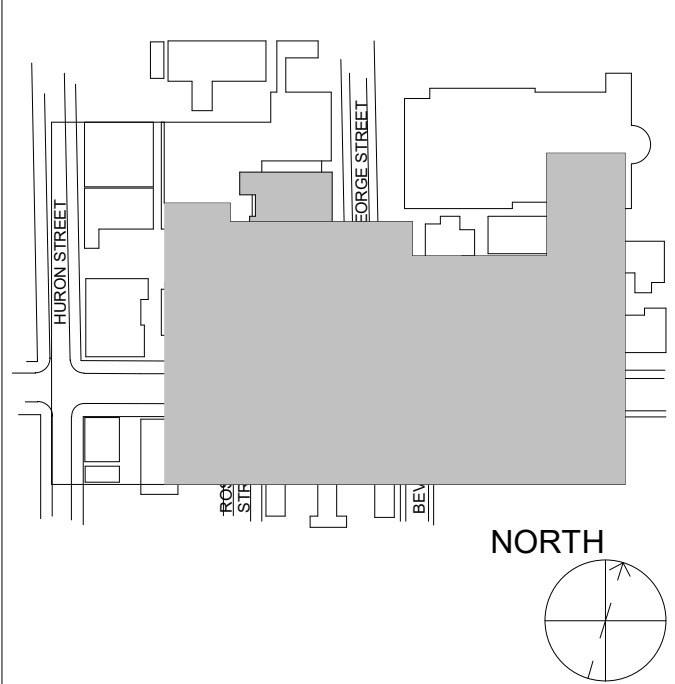

CONSTRUCTOR SHALL CHECK ALL DIMENSIONS ON THE WORK AND REPORT ANY DISCREPANCY TO THE CONSULTANT BEFORE PROCEEDING. THIS DRAWING IS NOT TO BE USED FOR CONSTRUCTION UNTIL AUTHORIZED IN WRITING BY CONSULTANT.

REVISION

NO.	DATE	DESCRIPTION
1	2024-10-04	ISSUED FOR 50% REVIEW
2	2024-11-14	ISSUED FOR PERMIT
3	2024-12-24	ISSUED FOR PRE REVIEW
4	2025-01-24	ISSUED FOR PRE REVIEW
5	2025-01-31	ISSUED FOR BID
6	2025-03-24	BY Addendum #04



Smith + Andersen
1100 - 109 Sheppard Ave East, Toronto, ON, M2N 0N6
416-467-8151 smithandandersen.com

ENFORM
architects

ENFORM Architects Inc.
1284 Sterling Road, Suite 302B
Toronto, Ontario, Canada M6R 2B7
416-596-7523
www.enformarchitects.com

SEAL:

OWNER:



**UNIVERSITY OF
TORONTO**

PROJECT:
**HEALTH AND WELLNESS
CENTRE RENOVATION AT
KOFFLER**

214 COLLEGE ST.
TORONTO, ON M5T 3A1

SHEET CONTENTS:
**THIRD FLOOR - FIRE
PROTECTION DEMOLITION
LAYOUT**

PROJECT NUMBER:

21590.003

DRAWING SCALE:

1:100

DRAWN BY:

AS

CHECKED BY:

RC/DC

DATE:


2024-02-08

SHEET NO:

TM-3.4.1

REV:


6

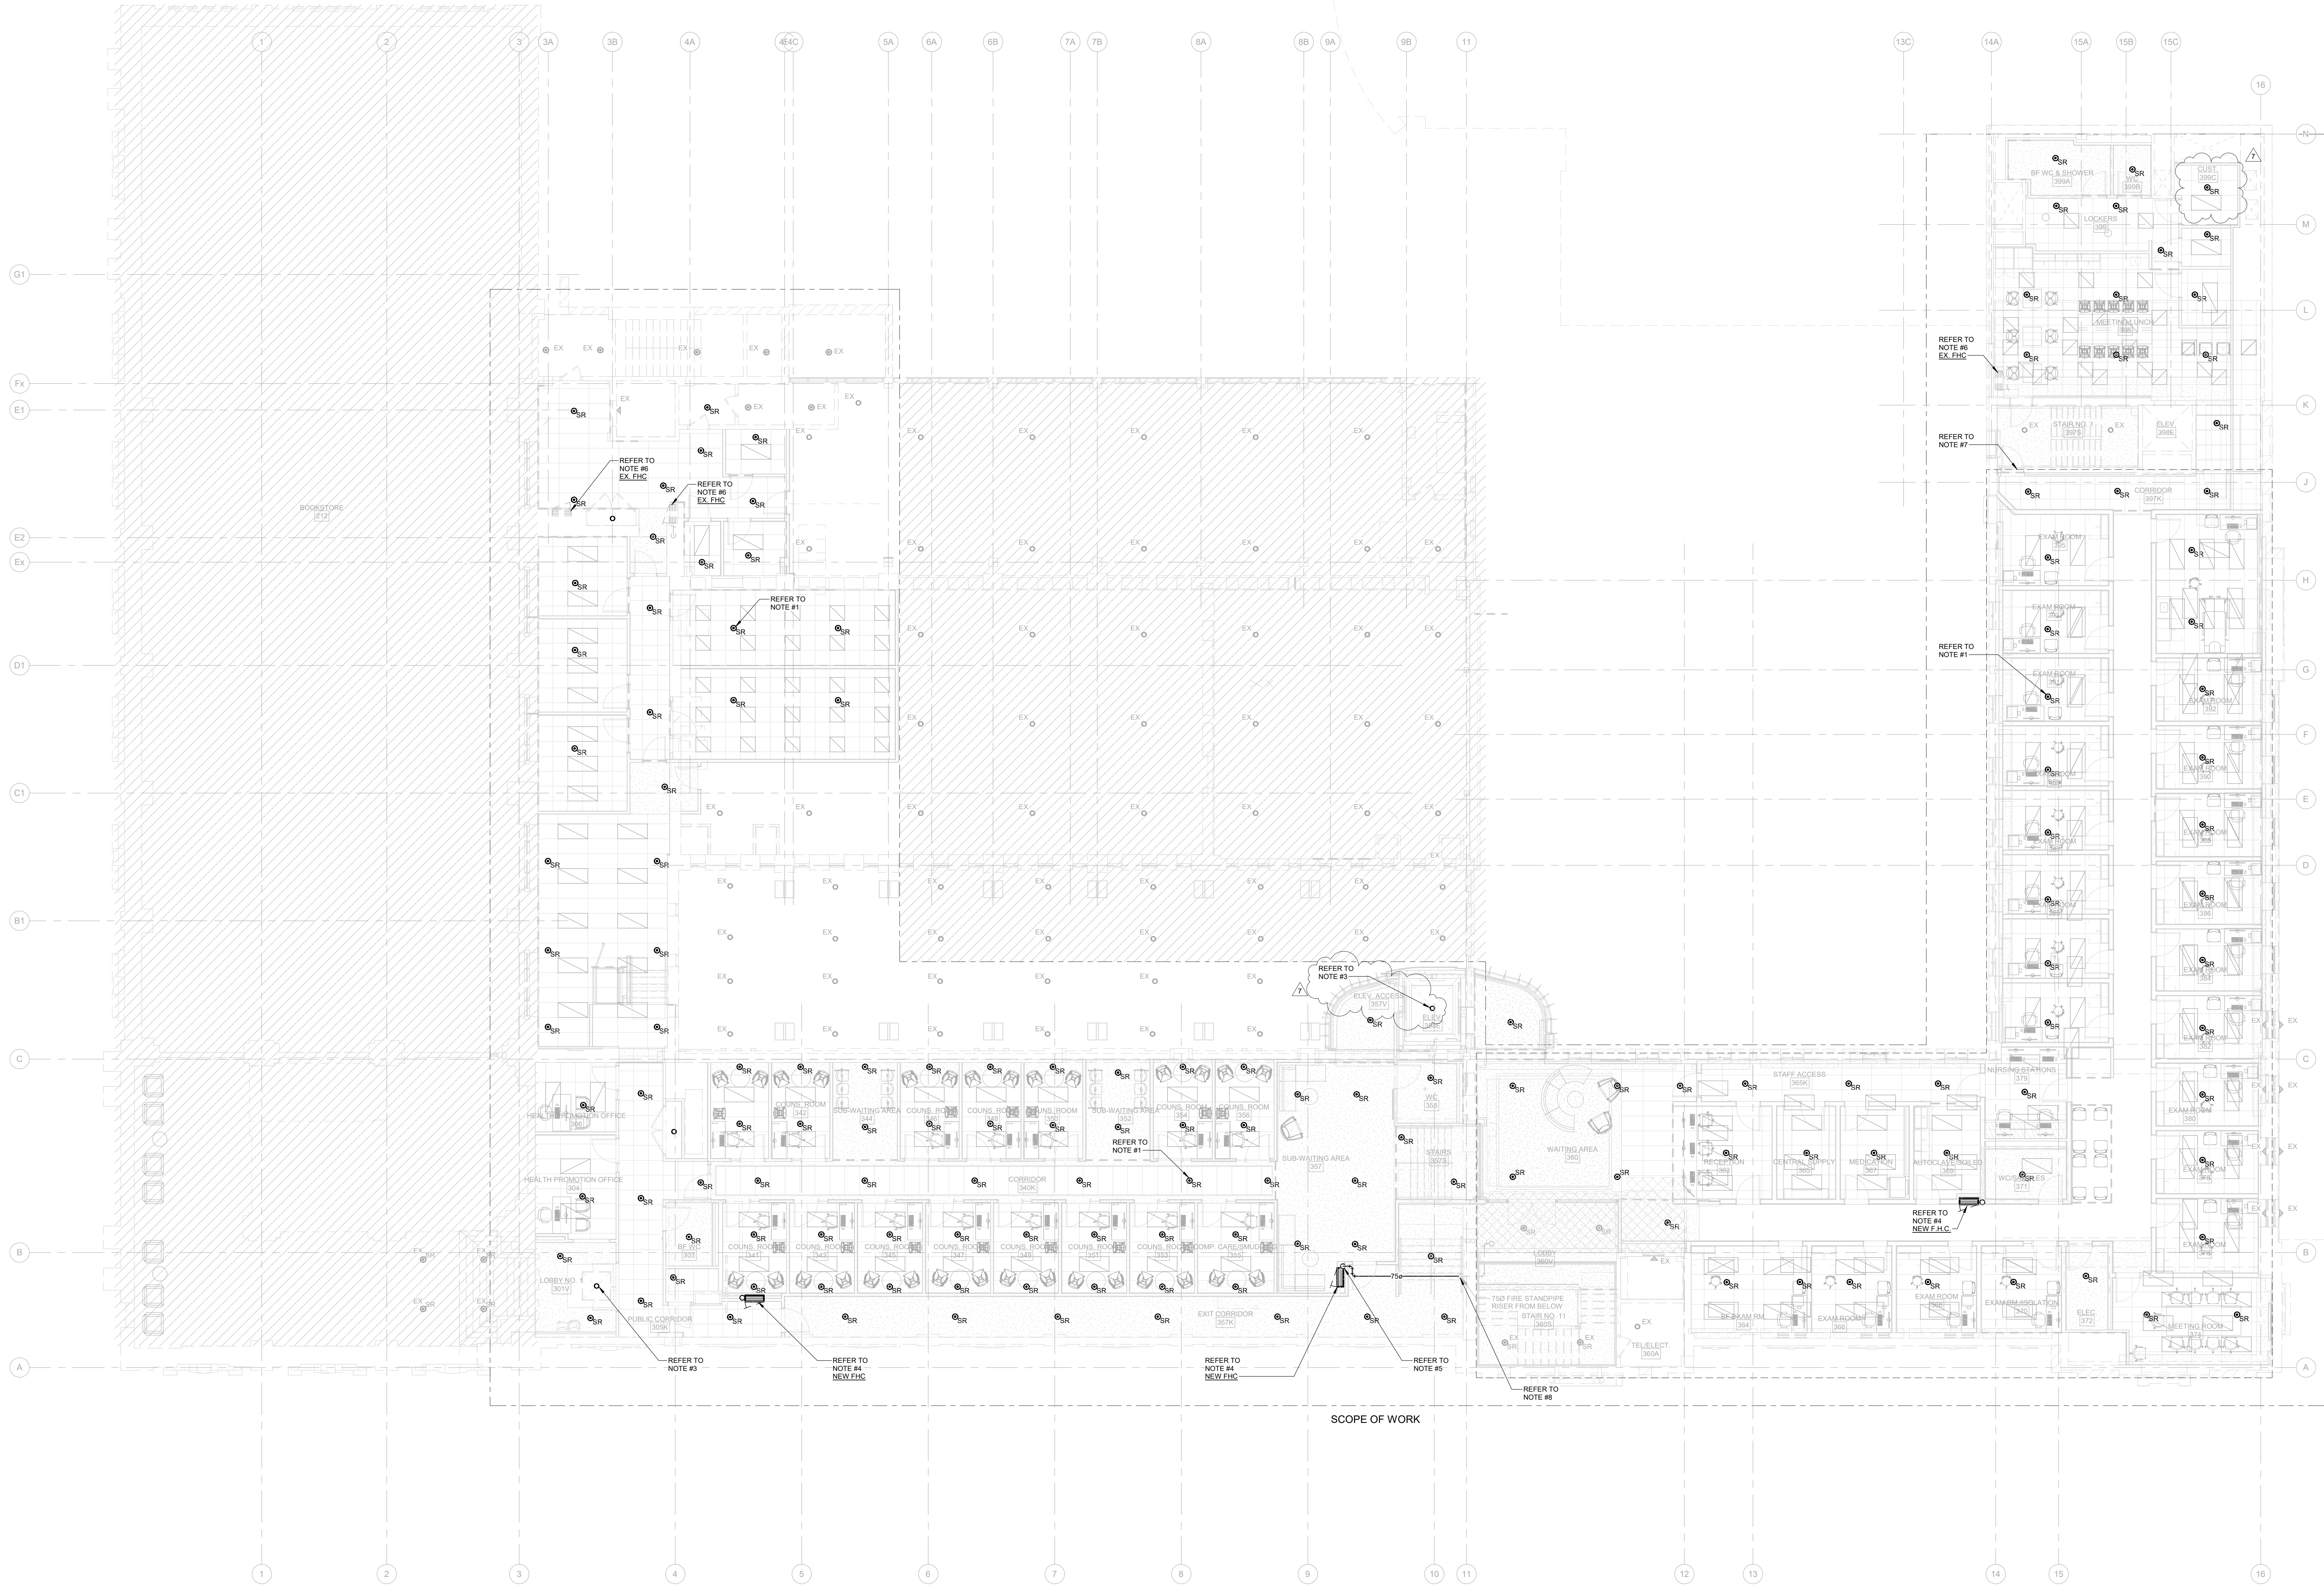

- GENERAL NOTES:**

 - DO NOT SCALE DRAWINGS. THE LOCATIONS OF ALL ITEMS SHOWN ON THE DRAWINGS OR SPECIFIED THAT ARE NOT DEFINITELY FIXED BY DIMENSIONS ARE APPROXIMATE. DETERMINE THE EXACT LOCATION NECESSARY TO SECURE THE BEST CONDITIONS AND RESULTS BASED ON SITE CONDITIONS. REVIEW ALL REVISIONS WITH THE CONSULTANT.
 - READ FLOOR PLANS IN CONJUNCTION WITH SCHEMATICS. ASSUME INFORMATION SHOWN ON FLOOR PLANS TO BE APPLICABLE TO THE RELATED SYSTEM SCHEMATIC AND VICE-VERSA TO PROVIDE A COMPLETE AND OPERATIONAL SYSTEM.
 - VERIFY STRUCTURAL INTEGRITY OF ALL TEMPORARY AND PERMANENT OPENINGS. PROVIDE ADDITIONAL FRAMING TO ENSURE STRUCTURAL INTEGRITY AS REQUIRED.
 - REFER TO THE STANDARD DETAILS AND DETAIL SHEETS FOR ADDITIONAL INFORMATION.
- DRAWING NOTES:**

 - NEW SEMI-RECESSED TYPE SPRINKLER HEAD TO MATCH BASE BUILDING STANDARD COMPLETE WITH ALL ASSOCIATED BRANCH PIPING NEW BRANCH PIPING TO CONNECT TO EXISTING SPRINKLER MAIN OR BRANCH MAIN WITH ADEQUATE SIZE (TYPICAL).
 - NEW SIDEWALL TYPE SPRINKLER HEAD TO MATCH BASE BUILDING STANDARD COMPLETE WITH ALL ASSOCIATED BRANCH PIPING NEW BRANCH PIPING TO CONNECT TO EXISTING SPRINKLER MAIN OR BRANCH MAIN WITH ADEQUATE SIZE (TYPICAL).
 - NEW UPRIGHT TYPE SPRINKLER HEAD SERVING SKYLIGHT/ELEVATOR TO MATCH BASE BUILDING STANDARD COMPLETE WITH ALL ASSOCIATED BRANCH PIPING NEW BRANCH PIPING TO CONNECT TO EXISTING SPRINKLER MAIN OR BRANCH MAIN WITH ADEQUATE SIZE.
 - NEW 28.0 METER FIRE HOSE CABINET.
 - NEW 750 FIRE LINE DOWN TO NEW FIRE HOSE CABINET.
 - EXISTING 22.0 METER FIRE HOSE CABINET TO REMAIN.
 - AREA PROTECTED BY EXISTING UPRIGHT HEADS AT TRUSS LEVEL. REFER TO TM-3.4.1 FOR EXISTING SPRINKLER HEAD LAYOUT.
 - ALLOW FOR STANDPIPE REWORK TO AVOID INTERFERENCE WITH NEW HANDRAIL AND STAIRS.
 - QUANTITY AND LOCATION OF SPRINKLER HEADS WHERE SHOWN ARE TO AD IN PRICING ONLY. PROVIDE EXACT NUMBER OF HEADS TO SUIT DENSITY REQUIREMENTS AS SPECIFIED OR SHOWN CONFORM TO ARCHITECTURAL REFLECTED CEILING PLAN LOCATIONS WHERE INDICATED AND MEET MINIMUM REQUIREMENTS OF ENFORCED NFPA 13 STANDARD.
 - PROVIDE SPRINKLER DRAWINGS AND HYDRAULIC CALCULATIONS SEALED BY A PROFESSIONAL ENGINEER. INDICATED ZONING AND DENSITY. PROVIDE A SPRINKLER PLANS. PROVIDE SHOP DRAWINGS IDENTIFYING PROPOSED LAYOUT FOR REVIEW PRIOR TO INSTALLATION.
 - PROVIDE A SEALED LETTER BY THE PROFESSIONAL ENGINEER OF RECORD CONFIRMING THE INSTALLATION COMPLES WITH THE SHOP DRAWINGS AND THE ENFORCED NFPA 13 & 14 STANDARD. INCLUDE ALL ASSOCIATED COSTS IN TENDER PRICE.
 - COORDINATE FIRE PROTECTION SERVICES WITH ALL OTHER TRADES PRIOR TO INSTALLATION. RECTIFY, AT OWNERS EXPENSE, ALL CONFLICTS ARISING FROM UNCOORDINATED FIRE PROTECTION SYSTEMS INSTALLED IN ADVANCE OF THE REQUIRED INTERFERENCE PROCESS.
 - INCLUDE IN THE TENDER PRICE FOR THE SUPPLY AND INSTALLATION OF AN ADDITIONAL FIVE (5) SPRINKLER HEADS COMPLETE WITH BRANCH PIPING TO SUIT SITE CONDITIONS TO MEET REQUIREMENTS OF NFPA-13.

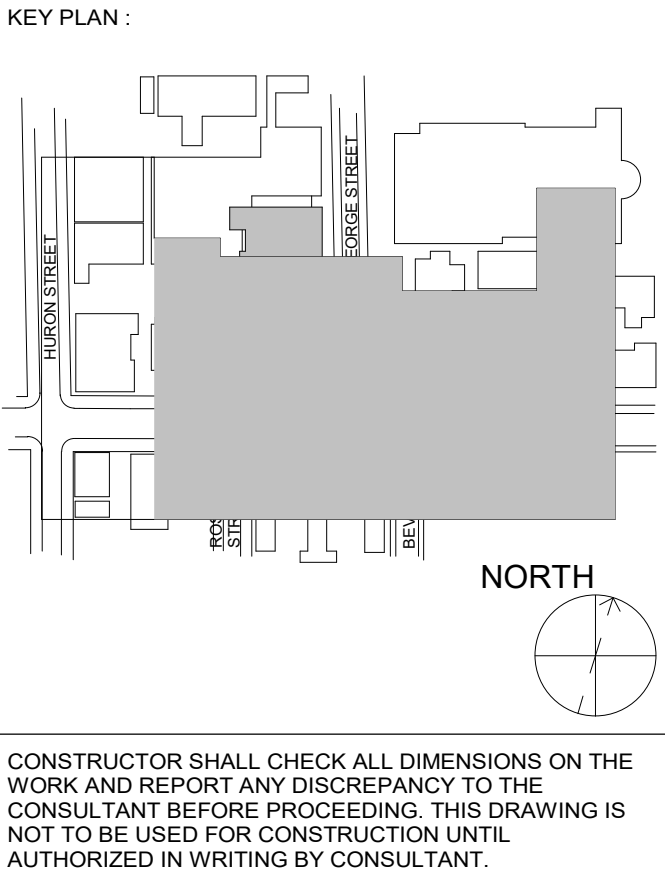

CONSTRUCTOR SHALL CHECK ALL DIMENSIONS ON THE WORK AND REPORT ANY DISCREPANCY TO THE CONSULTANT BEFORE PROCEEDING. THIS DRAWING IS NOT TO BE USED FOR CONSTRUCTION UNTIL AUTHORIZED IN WRITING BY CONSULTANT.

REVISION		
NO.	DATE	DESCRIPTION
1	2024-10-04	ISSUED FOR 50% REVIEW
2	2024-11-01	PROGRESS ISSUANCE
3	2024-11-14	ISSUED FOR PERMIT
4	2024-12-04	ISSUED FOR F&S REVIEW
5	2025-01-24	ISSUED FOR PEER REVIEW
6	2025-01-31	ISSUED FOR BID
7	2025-03-24	Bid Addendum #04



SEAL:



PROJECT: HEALTH AND WELLNESS CENTRE RENOVATION AT KOFFLER

214 COLLEGE ST.
TORONTO, ON M5T 3A1
SHEET CONTENTS:
THIRD FLOOR - FIRE PROTECTION LAYOUT

PROJECT NUMBER: 21590.003	
DRAWING SCALE: 1:100	
DRAWN BY: AS	CHECKED BY: RC/DC
	DATE: 2024-02-08
SHEET NO: TM-3.4	REV: 7

2.3. LINEAR SUPPLY AND RETURN DIFFUSERS

- 2.3.1. All diffusers shown as type "T" shall be T-bar plug-in, 1 slot diffuser modified with square ends to limit side spread, and of lengths shown. Diffuser shall be installed with manufacturer plenum to match the length of the diffuser shown. Provide diffuser with mounting clips to suit in continuous T-bar openings. Pattern controllers shall be split mid length to allow each half of diffuser shall be set for different throw patterns. Throw patterns shall be fully adjustable from vertical to horizontal and variations in between. Provide blank-off panels between diffusers. Pattern controllers and blank-off panels shall be finished matte black. Plenum shall be fabricated from coated steel. Refer to Architectural Details for installation of continuous supply air slot. Duct connection to diffuser shall be of sufficient height to allow for 175 mm (7 in.) clearance from ceiling to underside of duct. EH-Price TBD3 series, Nailor 5800, Krueger PTBA, Carnes DASC.
- 2.3.1.1. Return slots shall match supply and shall have return air sight baffles and mitred corners. Return linear grilles shall be specified as above and indicated as return on the Drawings.

2.4. WALL AND DUCT GRILLES

- 2.4.1. All supply registers shown as type "B" shall be standard double deflection type with adjustable horizontal face bars and vertical rear bars. Frame shall be gasketed. Construction shall be aluminum with prime coat. Registers larger than listed sizes shall be shop fabricated in Sections such that the Sections will appear as one integral register when installed. The integral volume control damper shall be of the opposed blade type and shall be constructed of cold rolled steel. The damper shall be operable from the register face. The damper shall be coated or galvanized steel. E.H. Price 620D, Nailor 5100 Series, Krueger 5880 Series, Carnes RNGM.

2.5. RETURN, EXHAUST AND TRANSFER GRILLES


- 2.5.1. Return grilles shown as type "E" shall be size as shown and shall be egg crate type with aluminum construction. Egg crate shall be 12 mm (1/2 in.) deep, formed of 12 mm (1/2 in.) wide aluminum strips on 12 mm (1/2 in.) centres. Strips shall be approximately 0.64 mm (0.025 in.) thick. Grilles shall be enclosed in a channel frame for inverted T-bar mounting or with a flanged frame for plaster or gypsum ceiling mounting. Grilles shall lay on inverted T-bar ceiling suspension system. Colour shall match adjacent ceiling tiles. E.H. Price Series 80, Nailor 5100 Series, Krueger EGC5 Series, Carnes RAPA.
- 2.5.2. Return registers shown as type "K" shall be standard return grilles with horizontal fixed bars set at approximately 45 deg. for wall returns and set straight for ceiling return. Key operated damper shall be mounted behind. General appearance, type of material and finish shall match the type "..." supply register. E.H. Price 530, Nailor 6100 Series, Krueger S80, Carnes model RSBAH.
- 2.5.3. Transfer Grilles shown as type "J" shall be standard single deflection fixed blade type. Finish shall match wall. E.H. Price model 535/E/L/0m, Nailor 6155H/V, Krueger S85
- 2.5.4. Door transfer grilles shown as typ "DG" unless otherwise specified shall be fire rated door grille. Nailor 61DGD-FR,

PART 3 EXECUTION

3.1. INSTALLATION

- 3.1.1. Refer to the Architectural Drawings for actual locations of diffusers, grilles and registers and install to suit these Drawings. The Mechanical Drawings show intent and number of diffusers, grilles and registers required.
- 3.1.2. Provide transfer grilles in all finished spaces where air is transferred though a ceiling or partition.
- 3.1.3. For exposed ductwork installations, all connections to grilles shall be oversized and shall have in-turned flanges to meet the flange of the grilles and the duct. Out-turned or exposed flanges with screw mounting shall not be accepted.
- 3.1.4. For special mounting of diffusers, grilles and registers refer to Architectural Drawings.

EQUIPMENT NO.			KEU-1.1	
System			Kitchen Ecology Unit	
Location			Ground Floor - Storage	
Service			Kitchen	
Airflow Rate	cfm	L/s	1,907	900
External Static Pressure	In H2O	Pa	1.0	249
Motor	hp	kW	10.00	7.46
Power	hp	kW	6.30	4.70
Electrical			208/3/60	
Full Load Amps	A		5.2	
Make			Hailton	
Model			RAH 1.0 RH	
Blower Model			EBM 355	
Unit Weight	lbs		1194	
Remarks				

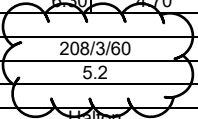

BID ADDENDUM

PROJECT NAME: **HEALH AND WELLNESS CENTRE RENOVATION AT KOFFLER**

COMPANY: **ENFORM ARCHITECTS**

ATTENTION: **Alan Fraser**

PROJECT NO.: **21590.003.E.001**

DATE: **2025-03-25**

BID ADDENDUM NO.: **#04**

ISSUED BY: **Wun Yan Chow**

The following amendments are hereby made as part of the Contract Documents. The following revisions and/or additions shall be made to contract documents and the cost shall be included in the Tender Price.

1.0 RESPONSE TO RFI

1.1 Regarding RFI Items we have the following response:

Question	Answer
As per floor plan fixture L3A is 1' x 4' whereas fixture schedule description indicates it is 2' x 2' fixture. Pls. confirm size & type of fixture required on site.	Refer to revised luminaire schedule.
E401 – As per floor plan fixture L3B is 2' x 2' whereas fixture schedule description indicates it is 1' x 4' fixture. Pls. confirm size & type of fixture required on site.	Refer to revised luminaire schedule.
E402 – As per floor plan fixture L3B is 2' x 2' whereas fixture schedule description indicates it is 1' x 4' fixture. Pls. confirm size & type of fixture required on site.	Refer to revised luminaire schedule.
E403 - Need fixture schedule for fixture B5 shown at grid 14 / B-C	B5 tag has been revised to L2.
E403 – As per floor plan fixture L3B is 2' x 2' whereas fixture schedule description indicates it is 1' x 4' fixture. Pls. confirm size & type of fixture required on site.	Refer to revised luminaire schedule.
Q9. Please confirm if the cable tray shown on the Telecom 'TC' series drawings can be used to carry all A/V, Communication and Security cables too or it is dedicated to only comm division.	Cable tray may be used for communication and AV wiring. Security wiring shall be in conduit.
Please provide response to below RFI, • L3A and L3B Description on lighting schedule and actual on drawings is different. Please clarify • Please provide specs for B5 • Type B Fixture on schedule ask for 2 feet but on drawings measurement is 6 feet please clarify	1. Refer to revised luminaire schedule. 2. B5 tag has been revised to L2. 3. Type B fixture is three 2' fixtures connected end-to-end. Luminaire schedule updated to reflect this.



2.0 DRAWINGS

2.1 Refer to E022 IT/LAN ROOM PLANS (included herein)

- 2.1.1 Delete one (1) duplex and one (1) data outlet from plywood backboard. (Typ. of 5)
- 2.1.2 Revise one (1) L5-30R outlet to one (1) 5-15R outlet at data rack. (Typ. of 5)
- 2.1.3 Delete duplex/data outlet for security equipment on plywood backboard. (Typ. of 5)
- 2.1.4 Revise location of power of electric strike security door access (typ. 4).
- 2.1.5 Adjust location of security panel power (122, 238, 277, 325B, 399E)

2.2 Refer to E023 LUMINAIRE SCHEDULE (included herein)

- 2.2.1 Revised luminaire schedule.

2.3 Refer to E024 RISER DIAGRAM (included herein)

- 2.3.1 Revised lighting control device schedule.
- 2.3.2 Dimming wires to be provided for lighting fixtures to Encelium power pack(s) regardless if lighting zone is dimmed.

2.4 Refer to E031 PANEL SCHEDULE (included herein)

- 2.5 Revised panel schedules.

2.6 Refer to E032 PANEL SCHEDULE (included herein)

- 2.7 Revised panel schedules.

2.8 Refer to E033 PANEL SCHEDULE (included herein)

- 2.9 Revised panel schedules.



2.10 Refer to E301-M2 LEVEL 01 UPPER MEZZ - POWER PLAN (included herein)

- 2.10.1 Drawing added to show scope for mezzanine power.
- 2.10.2 Provide quad/data outlet in M201 for BAS workstation. Coordinate location on site with mechanical.
- 2.10.3 Provide power/data outlet in M202 for BAS controller. Coordinate location on site with mechanical.

2.11 Refer to E302 LEVEL 02 POWER PLAN (included herein)

- 2.11.1 Provide two (2) new outlets in Area 258.
- 2.11.2 Relocate power to security door access from #231B to #238. Refer to 3/E022.
- 2.11.3 Provide power/data outlet for BAS controller in #282. Coordinate location on site with mechanical prior to work commencing.

2.12 Refer to E305 ROOF – POWER PLAN (included herein)

- 2.12.1 Provide power/data outlet for BAS controller in penthouse 2, 3. Coordinate location on site with mechanical prior to work commencing.

2.13 Refer to E307 LEVEL 01 – PATHWAY LAYOUT (included herein)

- 2.13.1 Delete conduits from 1F up to 2F 231B.

2.14 Refer to E309 LEVEL 03 – PATHWAY LAYOUT (included herein)

- 2.14.1 Showing routing of cable tray. Refer to communications drawings for specifications.

2.15 Refer to E401 LEVEL 01 – LIGHTING PLAN (included herein)

- 2.15.1 Removed ALC/LCM/WM devices. Refer to E401-A for locations/qty.

2.16 Refer to E401-A LEVEL 01 – LIGHTING CONTROL PLAN (included herein)

- 2.16.1 Revised lighting controls throughout.



2.17 Refer to E402 LEVEL 02 – LIGHTING PLAN (included herein)

- 2.17.1 Removed ALC/LCM/WM devices. Refer to E402-A for locations/qty.
- 2.17.2 Revised lighting in #254.

2.18 Refer to E402-A LEVEL 02 – LIGHTING CONTROL PLAN (included herein)

- 2.18.1 Revised lighting controls for throughout.
- 2.18.2 Provide LCM for lighting in 230.
- 2.18.3 Revised LCM to ALC throughout.
- 2.18.4 Revised lighting control for exam/counseling rooms.
- 2.18.5 Revised sequence of operations.

2.19 Refer to E403 LEVEL 03 – LIGHTING PLAN (included herein)

- 2.19.1 Clarify lighting fixture type in #371.
- 2.19.2 Removed ALC/LCM/WM devices. Refer to E403-A for locations/qty.
- 2.19.3 Delete one (1) L8 fixture and shift one (1) L8 fixture in 396.




2.20 Refer to E403-A LEVEL 03 – LIGHTING CONTROL PLAN (included herein)

- 2.20.1 Revised lighting control for smaller/individual rooms throughout.
- 2.20.2 Provide LCM for lighting in 230.
- 2.20.3 Revised LCM to ALC throughout.
- 2.20.4 Revised lighting control for exam/counseling rooms.
- 2.20.5 Revised sequence of operations.

3.0 CLARIFICATION

- 3.1.1 Coordination

END OF ELECTRICAL BID ADDENDUM

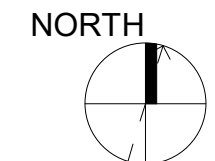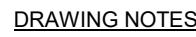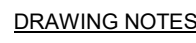

ENFORM Architects Inc.
128A Sterling Road, Suite 302B
Toronto, Ontario, Canada M6R 2B7
t: 647-948-7523
www.enformarchitects.com

SEAL

Classification

Section 26 06 05.16 - LUMINAIRE SCHEDULE				File Name: Koffler Luminaire Schedule_21.03.2025			Smith + Andersen	
Project Name:								
Project number:								
TYPE	VOLT.	LAMP(S)	DIMENSIONS	DESCRIPTION	DRIVERS/POWER SUPPLY	MANUFACTURER/CATALOGUE NUMBER	MINIMUM PERFORMANCE REQUIRED (DELIVERED)	LOCATED
LED: AMBIENT / GENERAL PURPOSE LIGHTING								
L1	120V	LED 10W/ft 3500 K 90 CRI	W: 3.5" H: 4" L: Varies	Suspended 2" Direct LED Linear With Diffuse Lens. Row mounted installation in various lengths. Extruded aluminum housing. White, black, and grey finishes are standard. Regressed opalized lens for minimization of glare and diffuse lighting optic. To be suspended using aircraft cable and recessed canopy. Certified to UL and CUL standards. Architect to confirm finishes and mounting heights prior to ordering.	0-10V dimming driver	Edison / ED VECTOR 2+ (10W-DD-120V-DL-SX-OR-xx-35K/90CRI)	1030 lumens/ft	Wood Slat Ceilings
L1A	120V	LED 10W/ft 3500 K 90 CRI	W: 2.56" H: 2.75" L: Varies	Recessed 2" Direct LED With Diffuse Lens and Trim. Row mounted installation in various lengths. Extruded aluminum housing. White, black, and grey finishes are standard. Regressed opalized lens for minimization of glare and diffuse lighting optic. Certified to UL and CUL standards. Architect to confirm finishes prior to ordering.	0-10V dimming driver	Edison / ED VECTOR+ (10W-DD-120V-DL-RS-OP-xx-35K/90CRI)	1030 lumens/ft	Drywall Ceilings
L1B	120V	LED 10W/ft 3500 K 90 CRI	W: 2.56" H: 2.75" L: Varies	Recessed 2" Direct LED With Diffuse Lens and Trim - Continuous Pattern. Row mounted installation in various lengths. Extruded aluminum housing. White, black, and grey finishes are standard. Regressed opalized lens for minimization of glare and diffuse lighting optic. Certified to UL and CUL standards. Architect to confirm finishes prior to ordering.	0-10V dimming driver	Edison / ED VECTOR+ (10W-DD-120V-DL-RS-OP-xx-35K/90CRI)	1030 lumens/ft	Feature Corridor
L2	UNV	LED 11W 3500 K 90 CRI	Dia. 5" H: 5/8"	5" Round Surface-Mounted Slim LED Downlight. 5/8" profile appears recessed. Installs into most standard j-boxes. One piece flange injection molded white (aluminum or black finish available). High transmittance diffuse lens. Non-conductive fixture for shower light applications. Certified to UL and CUL standards. Energy Star Certified. Damp Location Rated. Architect to confirm finishes prior to ordering.	0-10V dimming driver	Lightolier / SlimSurface (SSR-9-35K-7-xx-210U)	650 lumens	Corridors
L3	UNV	LED 42 W 3500 K 90 CRI	W: 2' L: 4' H: 2.25"	Slim 2'x4' Flat Panel LED with Configurable CTT. Robust die-formed steel back plate to ensure durability. Aluminum frame weld and ground for seamless appearance. Certified to UL and CUL standards. Damp Location Rated. Architect to confirm finishes and mounting kit prior to ordering.	0-10V dimming driver	Metalux / CGTX Panel (24-CGTX-55HE-L935-HCD)	2364 lumens	T-Bar Ceiling
L3A	UNV	LED 40 W 3500 K 90 CRI	W: 1' L: 4' H: 2.25"	Slim 1'x4' Flat Panel LED with Configurable CCT. Robust die-formed steel back plate to ensure durability. Aluminum frame weld and ground for seamless appearance. Certified to UL and CUL standards. Damp Location Rated. Architect to confirm finishes and mounting kit prior to ordering.	0-10V dimming driver	Metalux / CGTX Panel (14-CGTX-70HE-L935-HCD)	4252 lumens	T-Bar Ceiling
L3B	UNV	LED 63 W 3500 K 90 CRI	W: 2' L: 2' H: 2.25"	Slim 2'x2' Flat Panel LED with Configurable CCT. Robust die-formed steel back plate to ensure durability. Aluminum frame weld and ground for seamless appearance. Certified to UL and CUL standards. Damp Location Rated. Architect to confirm finishes and mounting kit prior to ordering.	0-10V dimming driver	Metalux / CGTX Panel (22-CGTX-45HE-L935-HCD)	5583 lumens	T-Bar Ceiling
L4	120V	LED 10 W 3500 K 90 CRI	W:7.09" H: 6" L:7.09"	Adjustable Recessed Square LED Downlight. High efficiency metalized integral reflector. Spot 25 degree beam optic. Adjustable trim assembly can be tilted up to 25 degrees in both directions. Suitable for recessed non insulated ceilings and dry locations. Certified to CSA and UL Standards. Architect to confirm finishes prior to	0-10V dimming driver	Edison / TS+ (1x-Single-10W-DD-120V-DL-RT-SP-xx-35K/90CRI)	1050 lumens	Elevator Lobby
L5	24V	LED 6.2 W/ft 3500 K 90 CRI	W:16 mm H: 13.8 mm L: Varies	Linear LED Cove Light Strip. Opalized lens for diode-free illumination. Seamless snap-together installation. IP20 rated for damp locations. Closet approved. 120 degree diffuse beam angle. Aluminum finish. Certified to UL and CUL standards.	0-10V dimming driver	Feellux / FLX Six HDPro (HDP-35K-C90-SF-STD-V-xx-HW-FDC)	408 lumens/ft	Cove / Under Cabinet


Classification

Section 26 06 05.16 - LUMINAIRE SCHEDULE				File Name: Koffler Luminaire Schedule_21.03.2025			Smith + Andersen	
Project Name:								
Project number:								
TYPE	VOLT.	LAMP(S)	DIMENSIONS	DESCRIPTION	DRIVERS/POWER SUPPLY	MANUFACTURER/CATALOGUE NUMBER	MINIMUM PERFORMANCE REQUIRED (DELIVERED)	LOCATED
L6	24 V	LED 4.4 W/ft 3500 K 90 CRI	W:15 mm H: 15 mm L: Varies	Bendable LED Cove Light Tape. Opalized lens for diode free illumination. UV resistant silicon material. Dual Bend. Field Cuttable. 120 degree light output. Maximum length of 5m. IP65 with field termination.	0-10V dimming driver	Feellux / FN 3D - 35K-C90-xx-EXL-FLEX-HW-0-10V-120V	255 lumens/ft	Smudging Room
L7	100-277 VAC	LED 52 W 4000 K 90 CRI	W:1.57" H:1.97" L: 47.75"	Linear 100x100 Degree LED Grazer. Extruded anodized aluminum housing with white powder-coated finish. Polycarbonate lens. Fixtures are connected end-to-end. Rated IP20 for Dry/Damp Locations. Certified to UL and cUL standards. To be mounted on custom bracket.	DMX remote dimming driver	ColorKinetics / Pure Style IntelliHue Powercore 100x100 (123-000025-03)	1677 lumens	LEVEL 3 Truss Ceiling
L8	UNV	LED 6.8 W 3500 K (selectable) 90 CRI	W: 4.37" H: 0.42" L: 18"	Surface Mounted LED Under Cabinet Lighting. Fixture has 5 selectable temperatures from 2700K-5000K. Extruded aluminum housing and color-matched end caps with a sleek overall height of only 3/4". UL and cUL certified. Damp location rated. Architect to confirm fixture finishes prior to ordering.	ELV/TRIAC dimming driver with Integral Switching	Halo / HU30M-SCTD-18-P-x	1917 lumens	Under Cabinet - Sinks
L9	UNV	LED 19.8 W 3500 K 95 CRI	Dia: 4.92" H: 8.66"	Narrow Beam LED Surface Mounted Cylinder. Faceted and smooth reflector with an 18 degree beam optic. Extruded aluminum cylinder housing. Monopoint surface mounted connection. UL listed. Architect to confirm finishes prior to ordering.	0-10V remote dimming driver	Senso / Leto 11 (SM-20-35K-F18-NA-xx)	1917 lumens	LEVEL 3 Truss Ceiling
LED: EXTERIOR LIGHTING								
G1	120V	LED 21 W 3500 K 80 CRI	W: 3.94" H: 3.94" L: 10.63"	Outdoor LED Wall-Mount. IP68, Class 1, IK08. Marine-grade die-cast aluminum alloy housing. Safety glass lens. Rectangular asymmetric Type II optic. ADA compliant. Architect to confirm finishes prior to ordering.	0-10V integral dimming driver	WE-EF / RLS420 131-9982	1397 lumens	Exterior Lighting
G2	120V	LED 6.8 W 3500 K 80 CRI	W: 3.94" H: 3.62" L: 9.84"	Outdoor LED Step-Light. IP68, Class 1, IK08. Marine-grade die-cast aluminum alloy housing. Safety glass lens. Rectangular asymmetric Type II optic. ADA compliant. Architect to confirm finishes prior to ordering.	0-10V remote dimming driver	WE-EF / STI259-LDL18 1130-0405	178 lumens	Exterior Lighting
LED: EMERGENCY LIGHTING								
B	UNV	LED 84 W 3500 K >80 CRI	W: 15-13/64" H: 5-3/4" L: See Architectural Drawings (2' fixtures connected end-to-end)	2' Tamper Resistant LED Vaportite connected end to end. Compact and durable fiberglass reinforced polyester housing. Frosted lens made from high impact polycarbonate. Wet location and rated up to IP69 and NEMA 4X. High performance efficacy. NOTE: Three fixtures to be connected end to end.	Emergency Only	Cooper / VRRV4S-12-DRF-UNV-EL10W-2-WL	10000 lumens	Elevator Pit


- NOTES:
- All luminaires need to be consistent on technology and must match reference standard description regardless of catalogue number. Where finishes are not indicated, allow for special finish. Manufacturer/Catalogue number not listed will not be considered.
 - The Electrical Contractor is responsible for the supply and installation of all fixed per unit cost luminaires as part of the base electrical contract. The Electrical Contractor is responsible for the installation of all cash allowance luminaires as part of the base electrical contract. Refer to specification 16505 or 26 51 13.00 for more details.
 - LEDs are to be latest technology to provide maximum lumens, binmed, best colour and longest life at time of purchase. Drivers are to be the latest technology at time of purchase.
 - LED luminaire dimensions listed are the maximum size allowed. Luminaires provided can be smaller than the dimension listed.
 - All luminaire diameters and depths listed are the maximum size allowed. Luminaires provided can be smaller than the dimension listed.
 - All LED luminaires that present signs of failure on site, within the warranty period, must be replaced at no cost to the owner. If temporary luminaires are required to replace any failed LED luminaires, during the waiting time for parts (i.e. drivers, boards, heat sinks, etc.), the labour cost including installation, transportation, handling, storage, maintenance, disposal and installation of temporary luminaires shall be the responsibility of the owner. A minimum of 10% of the total luminaire cost shall be set aside for temporary luminaires. The owner shall be responsible for the cost of temporary luminaires and the labour cost including installation, transportation, handling, storage, maintenance, disposal and installation of temporary luminaires.

Classification

Section 26 06 05.16 - LUMINAIRE SCHEDULE				File Name: Koffler Luminaire Schedule_21.03.2025			Smith + Andersen	
Project Name:								
Project number:								
TYPE	VOLT.	LAMP(S)	DIMENSIONS	DESCRIPTION	DRIVERS/POWER SUPPLY	MANUFACTURER/CATALOGUE NUMBER	MINIMUM PERFORMANCE REQUIRED (DELIVERED)	LOCATED
temporary luminaire supply, temporary luminaire removal and reinstallation or the LED fixture must be provided at no cost to the owner. Additional electrical costs, associated with higher wattage temporary luminaires, must be reimbursed with interest to the owner by the manufacturer.								
7. In case of failure of an LED luminaire, whether complete failure or partial failure, a independent third party testing Laboratory (approved by Smith + Andersen) shall be commissioned by the manufacturer or vendor to perform tests on samples taken from the failed luminaires installed on corresponding site. All reporting including the test results must be submitted to Smith + Andersen for evaluation and final approval.								
8. Any additional time (related to luminaire manufacturing issues) spent by Smith + Andersen will be billed at our hourly rates to the manufacturer or vendor.								
9. All LED parts and accessories must be replaceable on site without removal of the luminaire.								
10. Equivalents will only be considered at Smith + Andersen discretion prior to tender close. Sample must be supplied with plug and cord for mock-up.								
11. When a mock-up is requested, the full order of luminaires are on hold until approval and verification of the mock-up findings.								
12. Poles and bases are to be designed to accommodate wind conditions to avoid damage due to wind-induced vibrations. Shop Drawings are to be signed by a structural engineer registered in the local jurisdiction.								
13. Alternates are acceptable for all luminaires under the Ambient / General Purpose Lighting and Landscape / Exterior - General Purpose sections.								
14. Alternates are not acceptable for all luminaires under the Specialty / Decorative / High Performance or Landscape / Exterior - Specialty / Decorative / High Performance sections.								
15. Be responsible for providing the required quantity of LED drivers to suit the luminaire layout shown on the Drawings.								
16. Where continuous LED linear luminaires cross from interior to exterior spaces, provide separate drivers for the interior and exterior portions of the continuous run.								

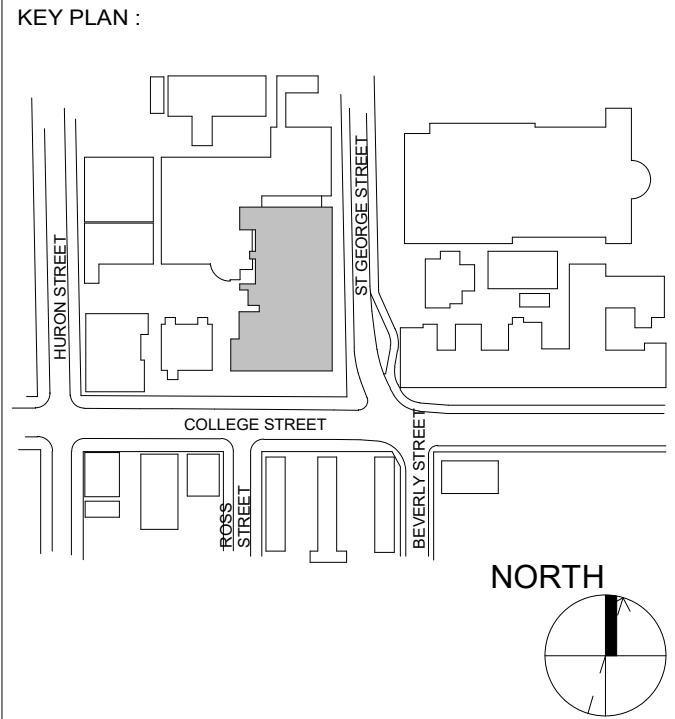

REVISION	
NO.	DATE DESCRIPTION
1	2024-10-04 ISSUED FOR 50%
2	2024-11-15 PERMIT
3	2024-12-04 ISSUED FOR FAS REVIEW
4	2024-12-23 ISSUED FOR FAS REVIEW
5	2025-01-24 ISSUED FOR PEER REVIEW
6	2025-01-31 ISSUED FOR BID
10	2025-03-25 BID ADDENDUM #04



Smith + Andersen
1100 - 109 Sheppard Ave East, Toronto, ON, M2N 0N6
416-467-8151 smithandandersen.com

ENFORM
architects

ENFORM Architects Inc.
1284 Sheppard Road, Suite 302B
Toronto, Ontario, Canada M8R 2B7
416-546-7523
www.enformarchitects.com

SEAL:

OWNER:


UNIVERSITY OF TORONTO

PROJECT:
HEALTH AND WELLNESS CENTRE RENOVATION AT KOFFLER

214 COLLEGE ST.
TORONTO, ON M5T 3A1

SHEET CONTENTS:
LUMINAIRE SCHEDULE

PROJECT NUMBER:
21590.003

DRAWING SCALE:

DRAWN BY:
Author


CHECKED BY:
Checker

DATE:
Issue Date


SHEET NO.:
E023

REV: 10


LIGHTING CONTROL DEVICE SCHEDULE		
TYPE	DESCRIPTION	MANUFACTURER/CATALOGUE NO.
OS A	24V DUAL TECH LOW VOLTAGE OCCUPANCY SENSOR	WATTSTOPPER DT-305 CW
OS	ENCELIUM WIRED OCCUPANCY SENSOR	9659-EN-GOPH-1500-QB2
OS HB	ENCELIUM WIRED HIGH BAY OCCUPANCY SENSOR	50357-EN-GOPH-HB-GB2
D	ENCELIUM 3 SCENE WALL STATION	ENCELIUM EN-VS-SC3-GB2-WH
D ₀₂	ENCELIUM 5 SCENE WALL STATION	ENCELIUM EN-VS-SC5-GB2-WH
D ₀₃	ENCELIUM WALL DIMMER	ENCELIUM EN-VS-4B-GB2-WH
D ₀₄	ENCELIUM WALL SWITCH (ON/OFF ONLY)	ENCELIUM EN-VS-2B-GB2-WH
D ₀₅	ENCELIUM TOUCHSCREEN	ENCELIUM KX4
OS	WALL MOUNTED OCCUPANCY SENSOR	WATTSTOPPER DW-100-24-W CW
WM	WIRED MANAGER	EN-M-GB2-X (X: EN-ECU-G4-PD0 (EXTEND)
ALC	AREA LIGHTING CONTROLLER	ENCELIUM EN-ALC-1R10V-GB2-BK
LCM	LIGHTING CONTROL MODULE	ENCELIUM EN-LCM-1R10V-GB2-BK

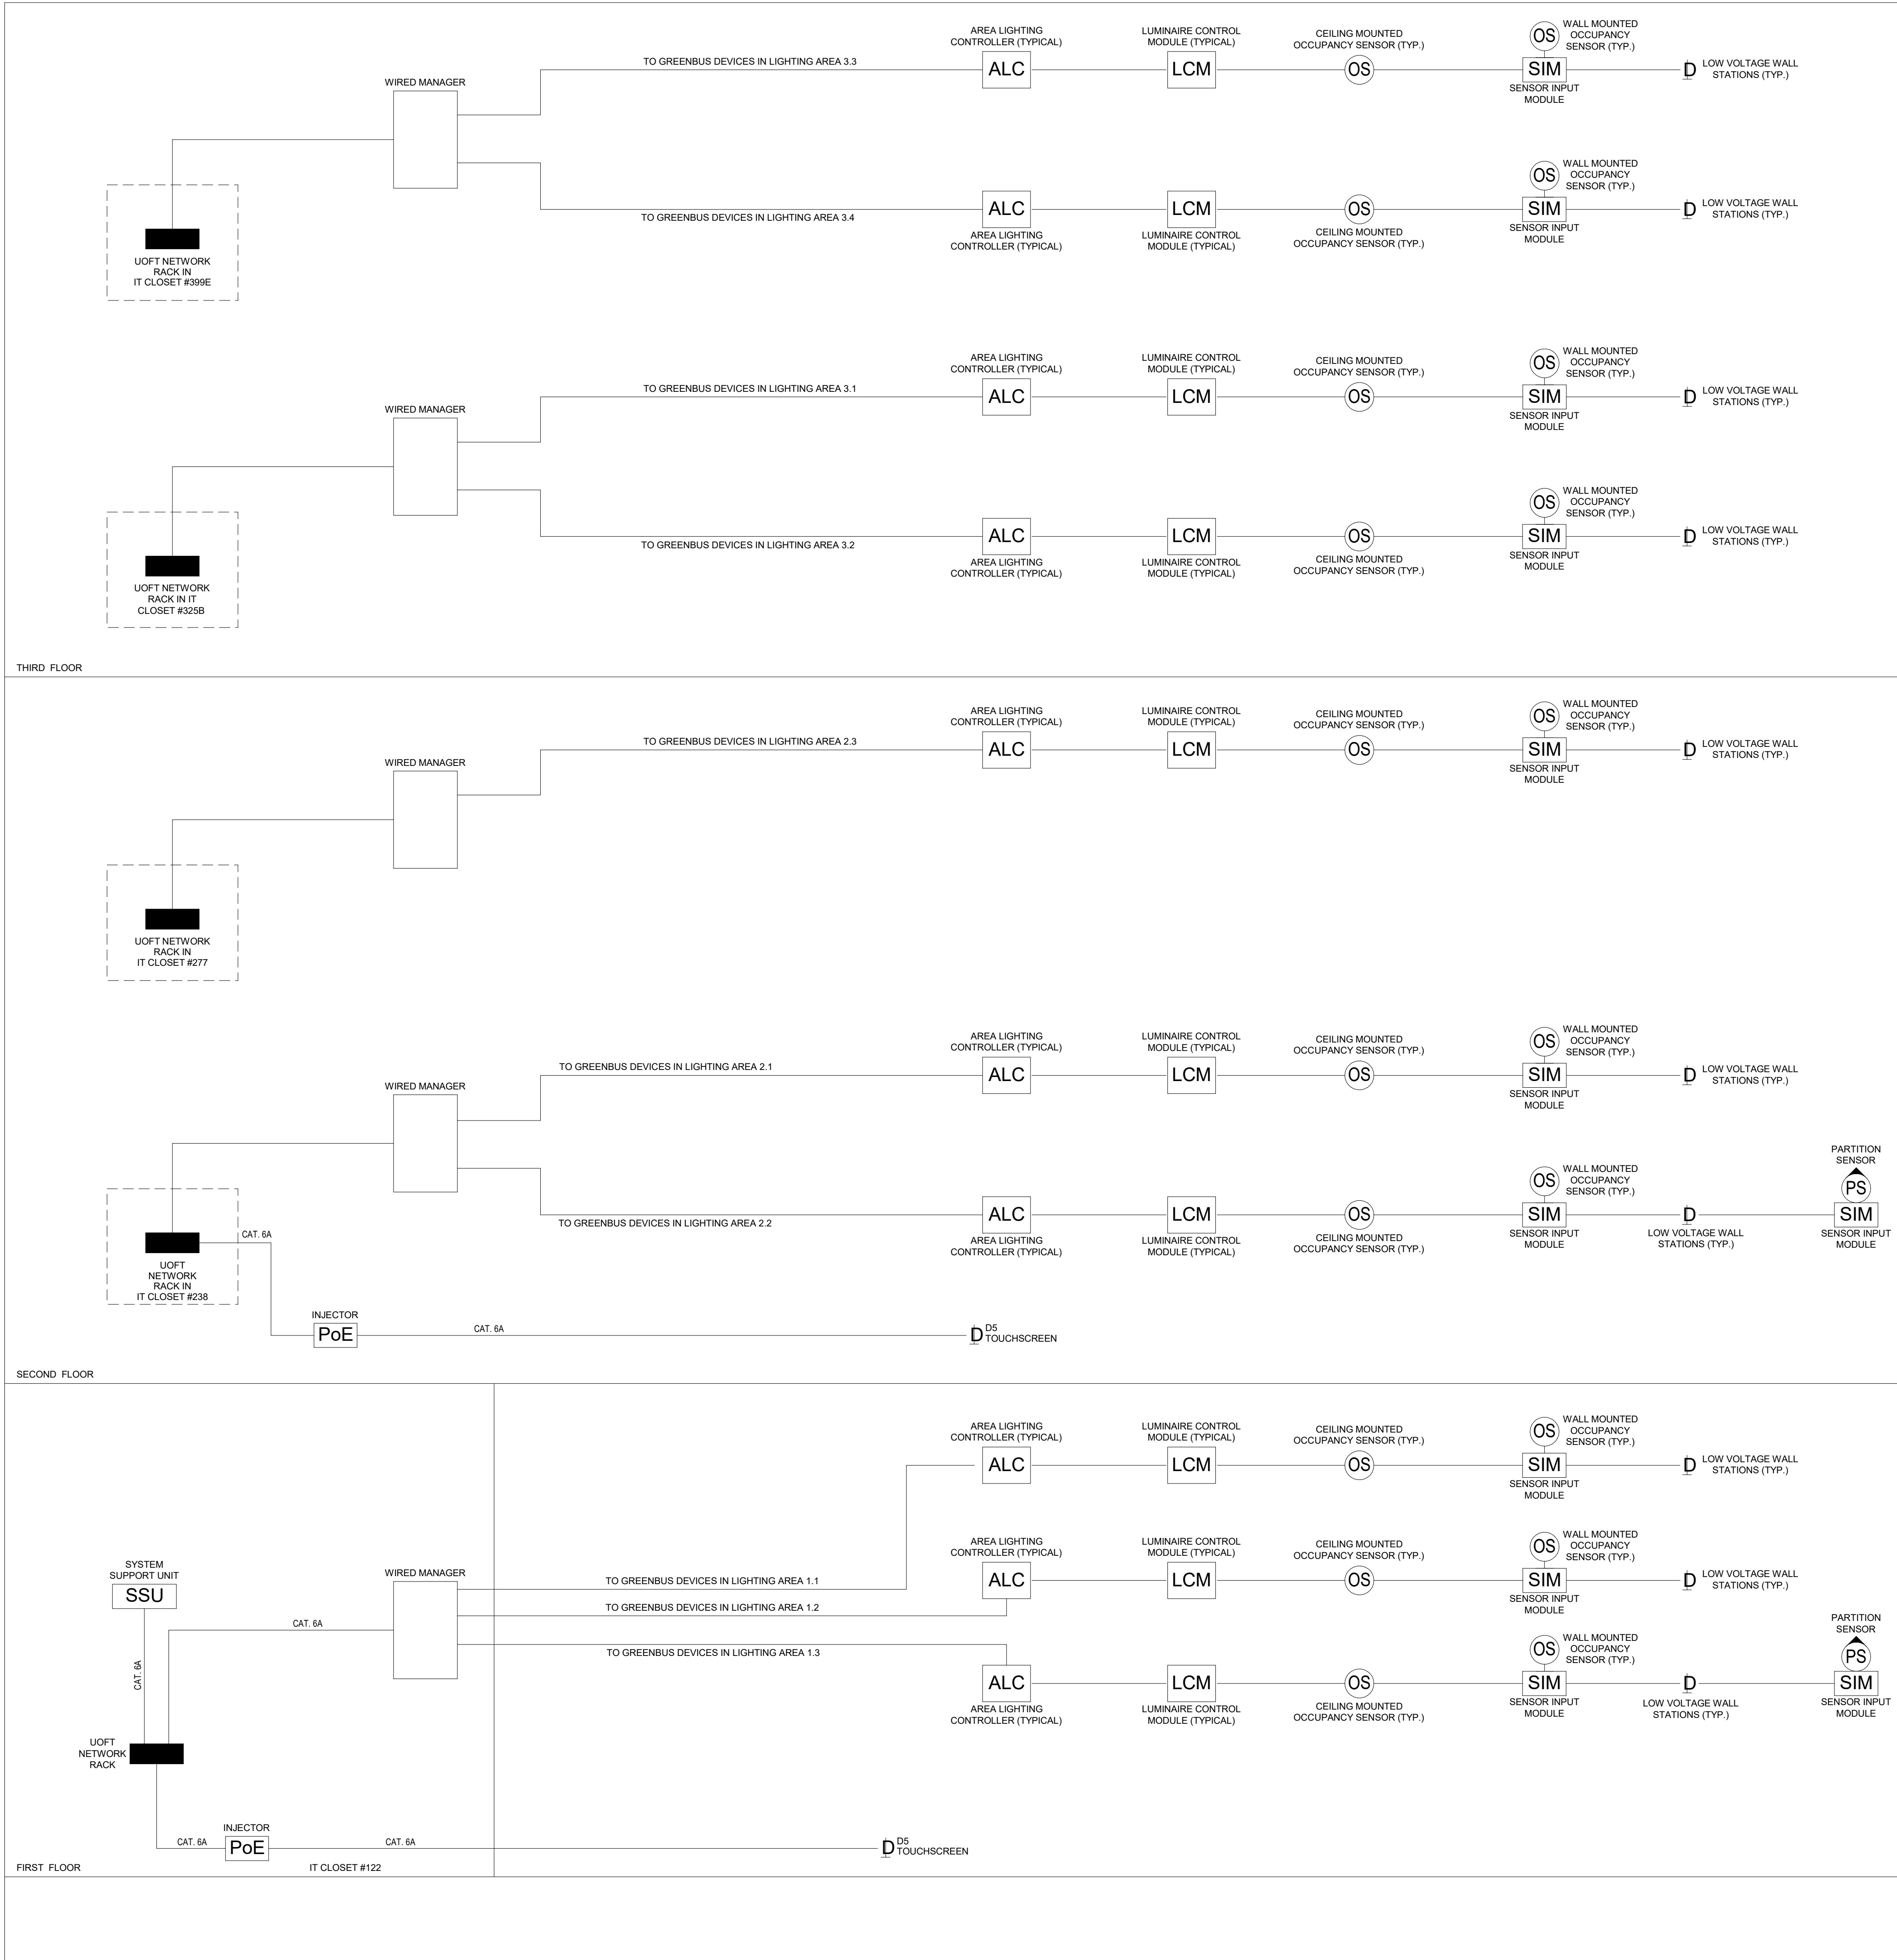

- GENERAL NOTE:**
 - ENCELIUM LIGHTING CONTROL SYSTEM IS A LONG LEAD ITEM. THE EXPECTED DELIVERY TIME CAN VARY BETWEEN 3 TO 6 MONTHS. CONTRACTOR IS ADVISED TO REVIEW THE DRAWINGS AND PLACE PURCHASE ORDER AS SOON AS POSSIBLE AFTER AWARDING THE CONTRACT. IN ORDER TO AVOID ANY DELAYS TO PROJECT SCHEDULE.
 - REFER TO ELECTRICAL SPECIFICATION AND ALLOW FOR ADDITIONAL VISITS OF LIGHTING CONTROLS SPECIALIST AS REQUIRED. INCLUDE ALL ASSOCIATED COST IN TENDER PRICE AS REQUIRED.
- LIGHTING CONTROL NOTES:**
 - EXACT LOCATION OF DEVICES TO BE CONFIRMED ON SITE.
 - PROVIDE ENGRAVING KIT FOR ALL WALL BUTTONS, AS REQUIRED.
 - DEVICES IN EACH ROOM SHALL OPERATE WITH OPEN TOPOLOGY AND CAN BE REARRANGED.
 - PROVIDE STAINLESS STEEL COVER PLATE FOR WALL STATIONS.
 - ALL CONTROL DEVICES TO BE INSTALLED WITHIN BACKBOXES AS REQUIRED.
 - ALL LOW VOLTAGE AND CONTROL WIRING SHALL BE INSTALLED INSIDE EMT CONDUITS.
 - CONTRACTOR MUST ADHERE TO ENCELIUM DRAWINGS. ANY MODIFICATIONS TO ENCELIUM DRAWINGS REQUIRE FACTORY APPROVAL.
 - SENSORS MUST BE INSTALLED AS PER INDUSTRY STANDARD. REFER TO MANUFACTURER INSTRUCTION SHEET INCLUDED WITH SENSOR HARDWARE. ALL SENSORS MUST BE MOUNTED AT LEAST 6 FEET AWAY FROM AIR VENTS & HEAT EXCHANGERS.
 - UNLESS OTHERWISE NOTED, ALL SENSORS WILL OPERATE AUTO ON, AUTO OFF WITH A TIMEOUT OF 11 MINUTES.
 - UNLESS OTHERWISE NOTED, ALL ENCELIUM WIRED MANAGERS SHOULD BE CONNECTED TO NORMAL POWER.
 - COORDINATE WITH ENCELIUM TECHNICIAN TO ASSIGN SWITCHES TO THE RESPECTIVE FUTURE GROUPING, AS INDICATED ON LIGHTING ZONES LAYOUTS.
 - ENCELIUM WIRED MANAGER (M), SYSTEM SUPPORT UNIT (SSU) AND WIRELESS MANAGER (WM) IS TO BE CONNECTED TO FAS NETWORK. ONE IP ADDRESS PER DEVICE MUST BE PROVIDED TO ENCELIUM PRIOR TO SYSTEM START UP.
 - NETWORK RUNS MUST NOT EXCEED 100M (328FT.). ANY MODIFICATIONS TO ENCELIUM DRAWINGS REQUIRE FACTORY APPROVAL.
 - REFER TO THE ENCENIUM CONTRACTOR'S INSTALLATION GUIDE FOR SYSTEM INFORMATION, CUT SHEETS, AND WIRING DIAGRAMS.
 - SYSTEM NEEDS TO BE TESTED PRIOR TO REQUESTING SYSTEM STARTUP SERVICES. PLEASE REFER TO ENCENIUM CONTRACTOR MANUAL FOR TESTING PROCEDURE USING GREENBUS II TESTER AND/OR EEM 64 INSTALLATION MODE.
 - END USER NETWORK ACCESS TO THE ENCENIUM SERVER (SSU) MUST BE ARRANGED PRIOR TO SYSTEM TRAINING.
 - ENCENIUM PHASE CUT DIMMING MODULE (PCDM) HAS A MAXIMUM OUTPUT RATING OF: 120 VAC, 450W, 3.8A MAX.
 - USE MINIMUM 3/4" CONDUIT FOR GREENBUS CABLEING.
 - ALLOW FOR THE COST TO PROVIDE POE INJECTORS AS REQUIRED.
 - ALLOW FOR SYSTEM INTEGRATION TO LUT ENCENIUM SERVER (INCLUDING, BUT NOT LIMITED TO, SWAPPING, SET-UP, DATA COLLECTION, ETC.).
 - DIMMING WIRING SHALL BE PROVIDED IF FIXTURE COMES WITH DIMMABLE DRIVER.
 - REFER TO LIGHTING CONTROL PLANS FOR DEVICE TYPES.
- PARTITION SENSORS NOTES:**
 - THE PARTITION SENSOR MUST PROVIDE A HIGH SIGNAL WHEN AT CLOSED STATE AND THE ROOMS SHOULD ACT/OPERATES SEPARATELY.
 - THE PARTITION SENSOR MUST PROVIDE A LOW SIGNAL WHEN AT OPEN STATE AND THE ROOMS SHOULD ACT/OPERATES COMBINED.

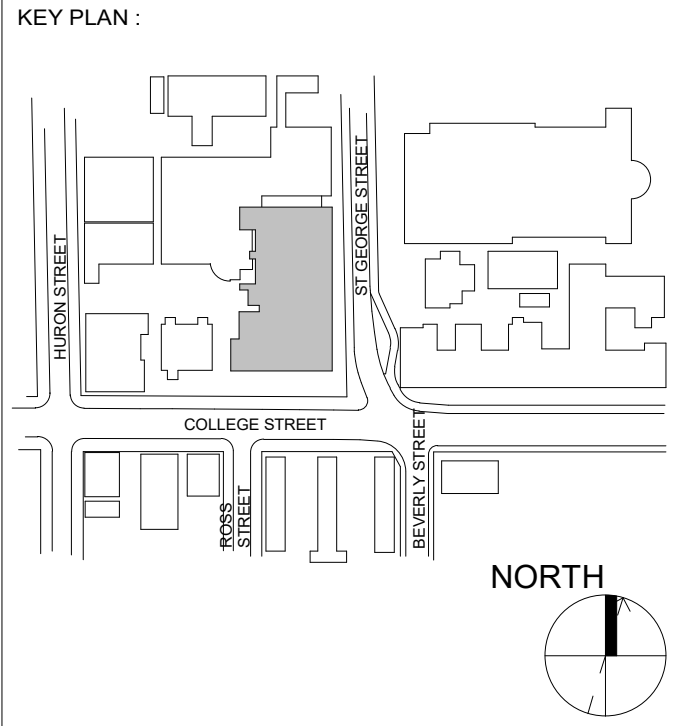

REVISION		
NO.	DATE	DESCRIPTION
1	2024-10-04	ISSUED FOR 50%.
2	2024-11-15	PERMIT
3	2024-12-04	ISSUED FOR FAS REVIEW
4	2024-12-23	ISSUED FOR FAS REVIEW
5	2025-01-24	ISSUED FOR FAS REVIEW
6	2025-01-31	ISSUED FOR BID
10	2025-03-25	BID ADDENDUM #04

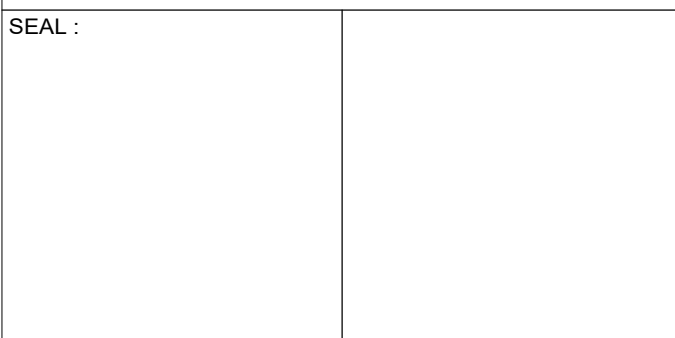

PROJECT:
**HEALTH AND WELLNESS
CENTRE RENOVATION AT
KOFFLER**

214 COLLEGE ST.
TORONTO, ON M5T 3A1
SHEET CONTENTS:
RISER DIAGRAM

PROJECT NUMBER: 21590.003		
DRAWING SCALE: 1 : 100		
DRAWN BY: Author	CHECKED BY: Checker	DATE: Issue Date
SHEET NO.: E024	REV:	10

UNIVERSITY OF TORONTO									
BLDG #:		PANEL TAG		143-NLP-03-02-BA		DATE MODIFIED: 2025-02-13		CONNECTED LOAD (W)	
CONNECTED LOAD (W)	DEMAND FACTOR	TOTAL DEMAND (W)	DESCRIPTION (Item, Room Number(s))	BKR (A)	CT	CT BKR (A)	DESCRIPTION (Item, Room Number(s))	CONNECTED LOAD (W)	DEMAND FACTOR
110	0.60	66	LIGHTING, 320K, 325V	15	1A	2	SPACE		0
336	0.60	201.6	LIGHTING, 320, 322, 324	15	3B	4	SPACE		0
462	0.60	277.2	LIGHTING, 304, 306, 307	15	5B	6	SPACE		0
424	0.60	254.4	LIGHTING, 323	15	7A	8	SPACE		0
669	0.60	413.4	LIGHTING, 321	15	9B	10	SPACE		0
0	0	0	SPARE	15	11B	12	SPACE		0
0	0	0	SPARE	15	13A	14	SPACE		0
0	0	0	SPARE	15	15B	16	SPACE		0
0	0	0	SPARE	15	17B	18	SPACE		0
0	0	0	SPARE	15	19B	20	SPACE		0
0	0	0	SPARE	15	21B	22	SPACE		0
0	0	0	SPARE	15	23B	24	SPACE		0
0	0	0	SPARE	15	25B	26	SPACE		0
0	0	0	SPARE	15	27B	28	SPACE		0
0	0	0	SPARE	15	29B	30	SPACE		0
0	0	0	SPARE	15	31A	32	SPACE		0
0	0	0	SPARE	15	33B	34	SPACE		0
0	0	0	SPARE	15	35B	36	SPACE		0
0	0	0	SPARE	15	37A	38	SPACE		0
0	0	0	SPARE	15	39B	40	SPACE		0
0	0	0	SPARE	15	41B	42	SPACE		0
BLDG: 143		FLOOR: 3		ROOM: 325		NEW TAG: N/A			
RATINGS: 100A		120/208V		3 PHASE		4 WIRE		S.C.: 10	
FED. FROM:		PANEL TAG: 143-NLP-03-02-BA		BLDG #: 143		ROOM #: 325		BREAKER SIZE: 100A/3P	
								FEEDER SIZE: 100A/3P	

143-NLP-03-02-BA.dwg

PANEL 143-NLP-03-02-BA SCHEDULE SCALE: NTS

UNIVERSITY OF TORONTO									
BLDG #:		PANEL TAG		143-NLP-03-02-BB		DATE MODIFIED: 2025-02-13		CONNECTED LOAD (W)	
CONNECTED LOAD (W)	DEMAND FACTOR	TOTAL DEMAND (W)	DESCRIPTION (Item, Room Number(s))	BKR (A)	CT	CT BKR (A)	DESCRIPTION (Item, Room Number(s))	CONNECTED LOAD (W)	DEMAND FACTOR
624	1.00	624	LIGHTING, 350, 360V, 360K	15	1A	2	SPACE		0
450	1.00	450	LIGHTING, 364,366,368,370	15	3B	4	SPACE		0
542	1.00	542	LIGHTING, 374, 376, 380, 382	15	5B	6	SPACE		0
0	0	0	SPARE	15	7A	8	SPACE		0
0	0	0	SPARE	15	9B	10	SPACE		0
0	0	0	SPARE	15	11B	12	SPACE		0
0	0	0	SPARE	15	13A	14	SPACE		0
0	0	0	SPARE	15	15B	16	SPACE		0
0	0	0	SPARE	15	17B	18	SPACE		0
0	0	0	SPARE	15	19B	20	SPACE		0
0	0	0	SPARE	15	21B	22	SPACE		0
0	0	0	SPARE	15	23B	24	SPACE		0
0	0	0	SPARE	15	25B	26	SPACE		0
0	0	0	SPARE	15	27B	28	SPACE		0
0	0	0	SPARE	15	29B	30	SPACE		0
0	0	0	SPARE	15	31A	32	SPACE		0
0	0	0	SPARE	15	33B	34	SPACE		0
0	0	0	SPARE	15	35B	36	SPACE		0
0	0	0	SPARE	15	37A	38	SPACE		0
0	0	0	SPARE	15	39B	40	SPACE		0
0	0	0	SPARE	15	41B	42	SPACE		0
BLDG: 143		FLOOR: 3		ROOM: 355A		NEW TAG: N/A			
RATINGS: 100A		120/208V		3 PHASE		4 WIRE		S.C.: 10	
FED. FROM:		PANEL TAG: 143-NLP-03-02-BB		BLDG #: 143		ROOM #: 355A		BREAKER SIZE: 100A/3P	
								FEEDER SIZE: 4 #2 AWG + #6 AWG BY 1-1/2"	

143-NLP-03-02-BB.dwg

PANEL 143-NLP-03-02-BB SCHEDULE SCALE: NTS

UNIVERSITY OF TORONTO									
BLDG #:		PANEL TAG		143-NLP-03-02-BC		DATE MODIFIED: 2025-02-13		CONNECTED LOAD (W)	
CONNECTED LOAD (W)	DEMAND FACTOR	TOTAL DEMAND (W)	DESCRIPTION (Item, Room Number(s))	BKR (A)	CT	CT BKR (A)	DESCRIPTION (Item, Room Number(s))	CONNECTED LOAD (W)	DEMAND FACTOR
667	1.00	667	LIGHTING, 386, 390, 390C	15	1A	2	SPACE		0
882	1.00	882	LIGHTING, 379, 381, 383, 385, 387, 389, 391, 393, 395	15	3B	4	SPACE		0
1000	1.00	1000	LIGHTING, 370K, 377	15	5B	6	SPACE		0
640	1.00	640	LIGHTING, 384, 386, 388, 392, 394	15	7A	8	SPACE		0
0	0	0	SPARE	15	9B	10	SPACE		0
0	0	0	SPARE	15	11B	12	SPACE		0
0	0	0	SPARE	15	13A	14	SPACE		0
0	0	0	SPARE	15	15B	16	SPACE		0
0	0	0	SPARE	15	17B	18	SPACE		0
0	0	0	SPARE	15	19B	20	SPACE		0
0	0	0	SPARE	15	21B	22	SPACE		0
0	0	0	SPARE	15	23B	24	SPACE		0
0	0	0	SPARE	15	25B	26	SPACE		0
0	0	0	SPARE	15	27B	28	SPACE		0
0	0	0	SPARE	15	29B	30	SPACE		0
0	0	0	SPARE	15	31A	32	SPACE		0
0	0	0	SPARE	15	33B	34	SPACE		0
0	0	0	SPARE	15	35B	36	SPACE		0
0	0	0	SPARE	15	37A	38	SPACE		0
0	0	0	SPARE	15	39B	40	SPACE		0
0	0	0	SPARE	15	41B	42	SPACE		0
BLDG: 143		FLOOR: 3		ROOM: 390D		NEW TAG: N/A			
RATINGS: 100A		120/208V		3 PHASE		4 WIRE		S.C.: 10	
FED. FROM:		PANEL TAG: 143-NLP-03-02-BC		BLDG #: 143		ROOM #: 390D		BREAKER SIZE: 100A/3P	
								FEEDER SIZE: 4 #2 AWG + #6 AWG BY 1-1/2"	

143-NLP-03-02-BC.dwg


PANEL 143-NLP-03-02-BC SCHEDULE SCALE: NTS

UNIVERSITY OF TORONTO									
BLDG #:		PANEL TAG		143-NLP-01-02-BA		DATE MODIFIED: 2025-02-13		CONNECTED LOAD (W)	
CONNECTED LOAD (W)	DEMAND FACTOR	TOTAL DEMAND (W)	DESCRIPTION (Item, Room Number(s))	BKR (A)	CT	CT BKR (A)	DESCRIPTION (Item, Room Number(s))	CONNECTED LOAD (W)	DEMAND FACTOR
440	0.60	264	LIGHTING, 112, 114	15	1A	2	SPACE		0
645	0.60	387	LIGHTING, 106, 110K, 119V, 120V, 120S, 122V	15	3B	4	SPACE		0
730	0.60	438	LIGHTING, 107A, 107	15	5B	6	SPACE		0
281.4	0.60	0	LIGHTING, OUTDOORS	15	7A	8	SPACE		0
0	0	0	SPARE	15	9B	10	SPACE		0
0	0	0	SPARE	15	11B	12	SPACE		0
0	0	0	SPARE	15	13A	14	SPACE		0
0	0	0	SPARE	15	15B	16	SPACE		0
0	0	0	SPARE	15	17B	18	SPACE		0
0	0	0	SPARE	15	19B	20	SPACE		0
0	0	0	SPARE	15	21B	22	SPACE		0
0	0	0	SPARE	15	23B	24	SPACE		0
0	0	0	SPARE	15	25B	26	SPACE		0
0	0	0	SPARE	15	27B	28	SPACE		0
0	0	0	SPARE	15	29B	30	SPACE		0
0	0	0	SPARE	15	31A	32	SPACE		0
0	0	0	SPARE	15	33B	34	SPACE		0
0	0	0	SPARE	15	35B	36	SPACE		0
0	0	0	SPARE	15	37A	38	SPACE		0
0	0	0	SPARE	15	39B	40	SPACE		0
0	0	0	SPARE	15	41B	42	SPACE		0
BLDG: 143		FLOOR: 1		ROOM: 107B		NEW TAG: N/A			
RATINGS: 100A		120/208V		3 PHASE		4 WIRE		S.C.: 10	
FED. FROM:		PANEL TAG: 143-NLP-01-02-BA		BLDG #: 143		ROOM #: 107B		BREAKER SIZE: 100A/3P	
								FEEDER SIZE: 4 #2 AWG + #6 AWG BY 1-1/2"	


143-NLP-01-02-BA.dwg

PANEL 143-NLP-01-02-BA SCHEDULE SCALE: NTS

UNIVERSITY OF TORONTO									
BLDG #:		PANEL TAG		143-NLP-01-02-BB		DATE MODIFIED: 2025-02-13		CONNECTED LOAD (W)	
CONNECTED LOAD (W)	DEMAND FACTOR	TOTAL DEMAND (W)	DESCRIPTION (Item, Room Number(s))	BKR (A)	CT	CT BKR (A)	DESCRIPTION (Item, Room Number(s))	CONNECTED LOAD (W)	DEMAND FACTOR
530	0.60	318	LIGHTING, 125	15	1A	2	SPACE		0
424	0.60	254.4	LIGHTING, 124, 126	15	3B	4	SPACE		0
148	0.60	88.8	LIGHTING, 113, 115, 119	15	5B	6	SPACE		0
0	0	0	SPARE	15	7A	8	SPACE		0
0	0	0	SPARE	15	9B	10	SPACE		0
0	0	0	SPARE	15	11B	12	SPACE		0
0	0	0	SPARE	15	13A	14	SPACE		0
0	0	0	SPARE	15	15B	16	SPACE		0
0	0	0	SPARE	15	17B	18	SPACE		0
0	0	0	SPARE	15	19B	20	SPACE		0
0	0	0	SPARE	15	21B	22	SPACE		0
0	0	0	SPARE	15	23B	24	SPACE		0
0	0	0	SPARE	15	25B	26	SPACE		0
0	0	0	SPARE	15	27B	28	SPACE		0
0	0	0	SPARE	15	29B	30	SPACE		0
0	0	0	SPARE	15	31A	32	SPACE		0
0	0	0	SPARE	15	33B	34	SPACE		0
0	0	0	SPARE	15	35B	36	SPACE		0
0	0	0	SPARE	15	37A	38	SPACE		0
0	0	0	SPARE	15	39B	40	SPACE		0

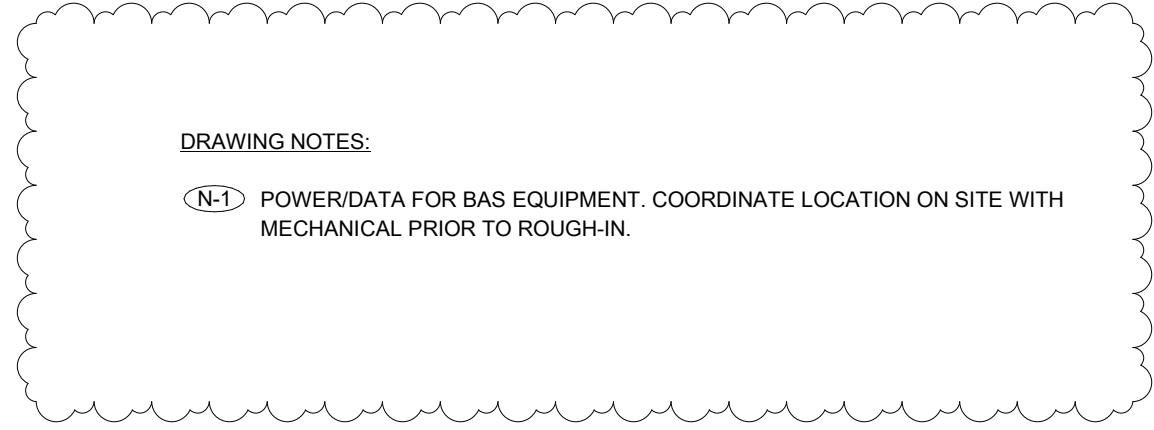

- [illegible]

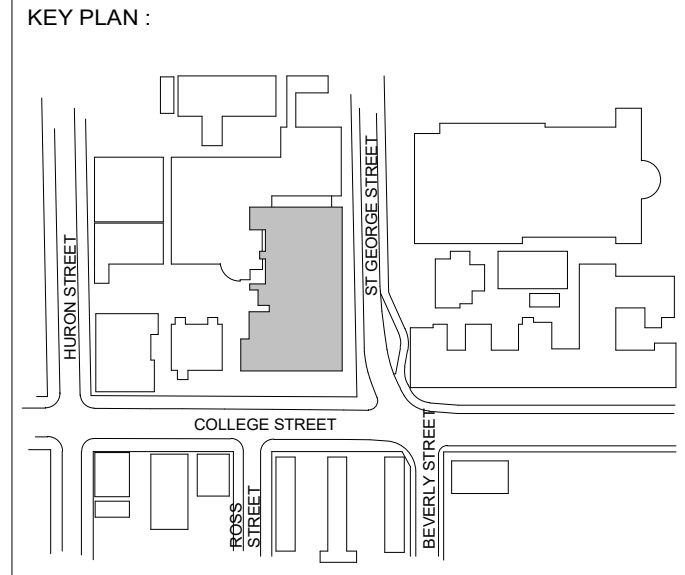

REVISION		
NO.	DATE	DESCRIPTION
1	2024-10-04	ISSUED FOR 50% PERMIT
2	2024-11-15	
3	2024-12-04	ISSUED FOR F&S REVIEW
4	2024-12-23	ISSUED FOR F&S REVIEW
5	2025-01-24	ISSUED FOR PEER REVIEW
6	2025-01-31	ISSUED FOR BID
10	2025-03-25	BID ADDENDUM #04



ENFORM
architects

ENFORM Architects Inc.
128A Sterling Road, Suite 302B
Toronto, Ontario, Canada M6R 2B7
t: 647-948-7523
www.enformarchitects.com

SEAL

UNIVERSITY OF
TORONTO

PROJECT :
HEALTH AND WELLNESS
CENTRE RENOVATION AT
KOFFLER

214 COLLEGE ST.
TORONTO, ON M5T 3A1

**LEVEL 01 UPPER MEZZ -
POWER PLAN**

PROJECT NUMBER:	21590.003
DRAWING SCALE :	

1 : 100

DRAWN BY :

Author

SHEET NO :
500

E30


CHECKED BY:	DATE:
-------------	-------

Checker	
---------	--

1. MO

1-M2

10

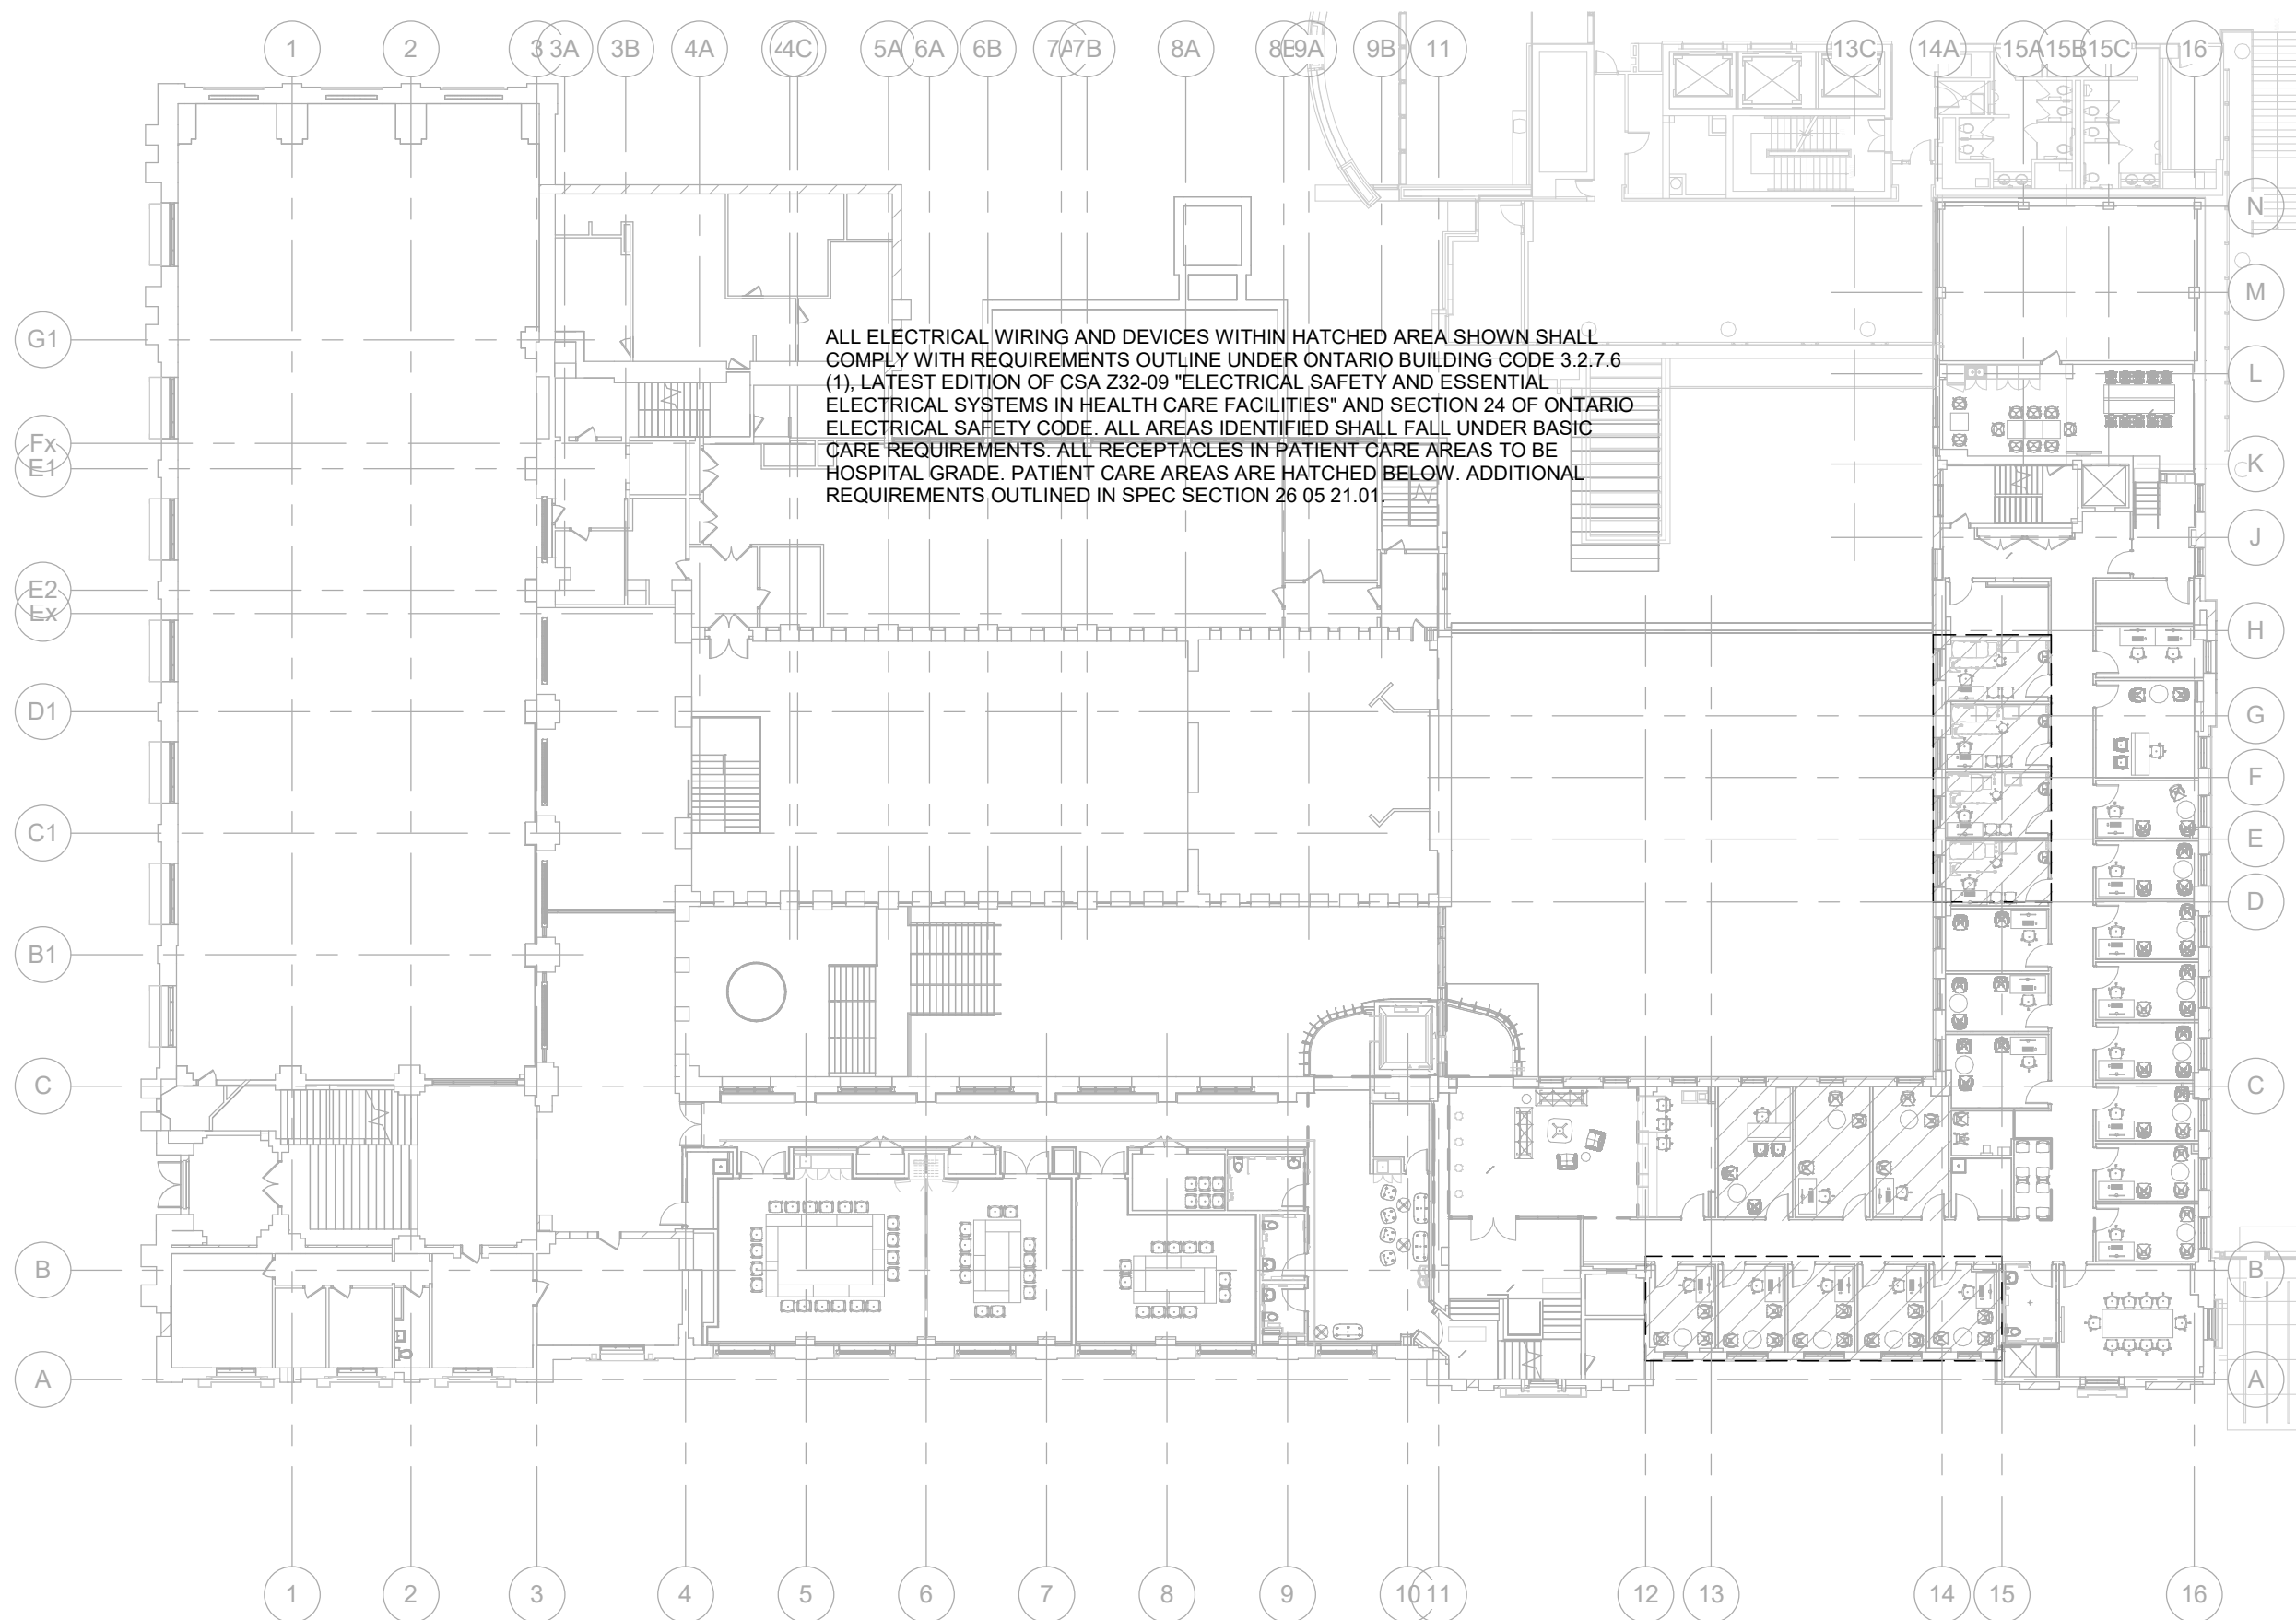


DRAWING NOTES:

1. THESE DRAWINGS SHALL BE READ IN CONJUNCTION WITH INTERIOR DESIGNER/ARCHITECT'S DRAWINGS FOR DIMENSIONS, HEIGHTS, CONSTRUCTION DETAILING, FINISHES AND COLOURS.
2. CIRCUITING IN PART IS DIAGRAMMATIC INTENDED TO SHOW GENERAL CIRCUIT ARRANGEMENT AND PANEL DESIGNATION.
3. PROVIDE EMT CONDUIT IN AREAS WITH EXPOSED CEILINGS. EX. CABLES MAY BE USED FOR FINAL CONNECTIONS TO LIGHTING FIXTURES OR EQUIPMENT WITH A MAXIMUM HORIZONTAL RUN LENGTH OF 3 FEET / 1 METER. PAINT CONDUITS TO MATCH ARCHITECTURAL BACKGROUNDS. MOUNT EXIT SIGNS, OCCUPANCY SENSORS, EXIT SIGNS, CAMERAS, WAPS AND ALL OTHER CEILING MOUNTED DEVICES WITH STEPS SUCH THAT THEY ARE ON THE SAME PLANE AS SUSPENDED LIGHTING FIXTURES. COORDINATE CEILING AND WALL HEIGHTS WITH INTERIOR DESIGNER DRAWINGS.
4. VERIFY EXACT POWER REQUIREMENTS AND RECEPTACLE TYPES FOR SPECIAL EQUIPMENT WITH MANUFACTURER PRIOR TO INSTALLATION. PROVIDE HARDWARE CONNECTIONS FOR DISHWASHERS AND COPIERS ETC. IN LIEU OF RECEPTACLES OR VICE VERSA, AS REQUIRED.
5. REFER TO INTERIOR DESIGNER/ARCHITECT DRAWINGS FOR THE COLOUR OF COVERPLATES AND MOUNTING HEIGHTS.
6. MARK UP OUTLET AND DEVICE LOCATIONS AND OBTAIN APPROVAL BY DESIGN CONSULTANT PRIOR TO INSTALLATION.
7. PROVIDE SUITABLE LABELS ON ALL RECEPTACLES AND SYSTEM FURNITURE. LABELS TO INCLUDE BOTH PANEL AND CIRCUIT DESIGNATION. REVIEW LABEL SIZE AND TYPE WITH CONSULTANT PRIOR TO INSTALLATION.
8. CONFIRM ELECTRICAL REQUIREMENTS AND EXACT LOCATION OF ALL MECHANICAL/COMMUNICATIONARY EQUIPMENT WITH MECHANICAL/COMMUNICATIONARY DRAWINGS AND CONTRACTOR PRIOR TO ROUGHINS. NO ADDITIONAL COSTS WILL BE APPROVED FOR ANY REVISIONS/MODIFICATIONS REQUIRED BY ANY TRADE OR CONTRACTOR DUE TO THE LACK OF COORDINATION BETWEEN TRADES AND CONTRACTORS.
9. ROUTE ALL CONDUIT SYSTEMS AROUND DUCT WORK, BEAMS AND PIPING AS REQUIRED TO ACCOMMODATE LAYOUT SHOWN. REFER TO MECHANICAL DRAWINGS AND ARCHITECTURAL DRAWINGS FOR ADDITIONAL DETAILS.
10. COORDINATE ALL WORK TO SUP PROJECT PHASE SCHEDULE. COORDINATE PHASING WITH ARCHITECT/INTERIOR DESIGNER. PHASING IF SHOWN IS FOR REFERENCE PURPOSES ONLY.
11. UNLESS OTHERWISE NOTED, POWER TO BE FED FROM PANELS LOCATED ON THIS FLOOR.
12. ALLOW FOR THE RENOVATING OF EXISTING CONDUIT FEEDERS TO ACCOMMODATE NEW SCOPE OF WORK AND/OR INTERFERENCES.

GENERAL NOTES:

1. THESE DRAWINGS SHALL BE READ IN CONJUNCTION WITH INTERIOR DESIGNER/ARCHITECT'S DRAWINGS FOR DIMENSIONS, HEIGHTS, CONSTRUCTION DETAILING, FINISHES AND COLOURS.
2. CIRCUITING IN PART IS DIAGRAMMATIC INTENDED TO SHOW GENERAL CIRCUIT ARRANGEMENT AND PANEL DESIGNATION.
3. PROVIDE EMT CONDUIT IN AREAS WITH EXPOSED CEILINGS. EX. CABLES MAY BE USED FOR FINAL CONNECTIONS TO LIGHTING FIXTURES OR EQUIPMENT WITH A MAXIMUM HORIZONTAL RUN LENGTH OF 3 FEET / 1 METER. PAINT CONDUITS TO MATCH ARCHITECTURAL BACKGROUNDS. MOUNT EXIT SIGNS, OCCUPANCY SENSORS, EXIT SIGNS, CAMERAS, WAPS AND ALL OTHER CEILING MOUNTED DEVICES WITH STEPS SUCH THAT THEY ARE ON THE SAME PLANE AS SUSPENDED LIGHTING FIXTURES. COORDINATE CEILING AND WALL HEIGHTS WITH INTERIOR DESIGNER DRAWINGS.
4. VERIFY EXACT POWER REQUIREMENTS AND RECEPTACLE TYPES FOR SPECIAL EQUIPMENT WITH MANUFACTURER PRIOR TO INSTALLATION. PROVIDE HARDWARE CONNECTIONS FOR DISHWASHERS AND COPIERS ETC. IN LIEU OF RECEPTACLES OR VICE VERSA, AS REQUIRED.
5. REFER TO INTERIOR DESIGNER/ARCHITECT DRAWINGS FOR THE COLOUR OF COVERPLATES AND MOUNTING HEIGHTS.
6. MARK UP OUTLET AND DEVICE LOCATIONS AND OBTAIN APPROVAL BY DESIGN CONSULTANT PRIOR TO INSTALLATION.
7. PROVIDE SUITABLE LABELS ON ALL RECEPTACLES AND SYSTEM FURNITURE. LABELS TO INCLUDE BOTH PANEL AND CIRCUIT DESIGNATION. REVIEW LABEL SIZE AND TYPE WITH CONSULTANT PRIOR TO INSTALLATION.
8. CONFIRM ELECTRICAL REQUIREMENTS AND EXACT LOCATION OF ALL MECHANICAL/COMMUNICATIONARY EQUIPMENT WITH MECHANICAL/COMMUNICATIONARY DRAWINGS AND CONTRACTOR PRIOR TO ROUGHINS. NO ADDITIONAL COSTS WILL BE APPROVED FOR ANY REVISIONS/MODIFICATIONS REQUIRED BY ANY TRADE OR CONTRACTOR DUE TO THE LACK OF COORDINATION BETWEEN TRADES AND CONTRACTORS.
9. ROUTE ALL CONDUIT SYSTEMS AROUND DUCT WORK, BEAMS AND PIPING AS REQUIRED TO ACCOMMODATE LAYOUT SHOWN. REFER TO MECHANICAL DRAWINGS AND ARCHITECTURAL DRAWINGS FOR ADDITIONAL DETAILS.
10. COORDINATE ALL WORK TO SUP PROJECT PHASE SCHEDULE. COORDINATE PHASING WITH ARCHITECT/INTERIOR DESIGNER. PHASING IF SHOWN IS FOR REFERENCE PURPOSES ONLY.
11. UNLESS OTHERWISE NOTED, POWER TO BE FED FROM PANELS LOCATED ON THIS FLOOR.
12. ALLOW FOR THE RENOVATING OF EXISTING CONDUIT FEEDERS TO ACCOMMODATE NEW SCOPE OF WORK AND/OR INTERFERENCES.

KEY PLAN:

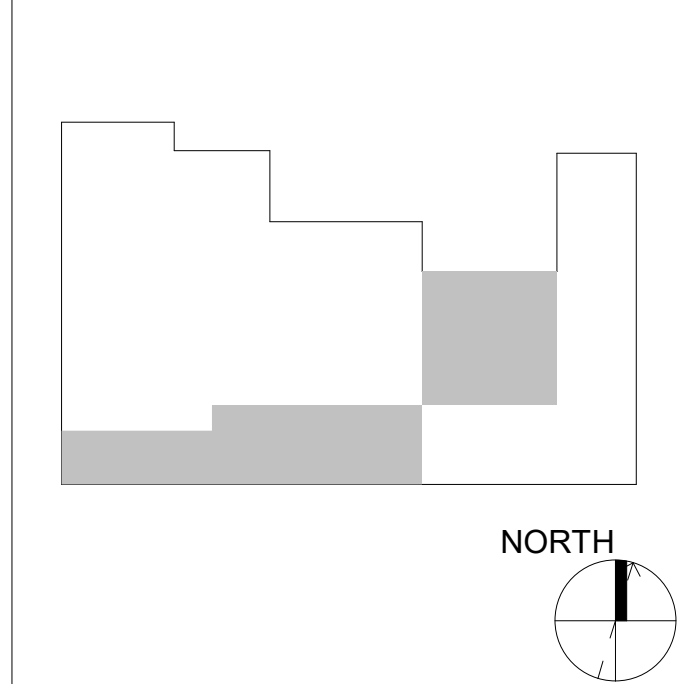

REVISION

NO.	DATE	DESCRIPTION
1	2024-10-04	ISSUED FOR 50% PERMIT
2	2024-11-15	PERMIT
3	2024-12-24	ISSUED FOR FAS REVIEW
4	2024-12-23	ISSUED FOR FAS REVIEW
5	2025-01-24	ISSUED FOR PEER REVIEW
6	2025-01-31	ISSUED FOR BID
7	2025-02-21	BID ADDENDUM #03
8	2025-03-25	BID ADDENDUM #04

Smith + Andersen
1100 - 109 Sheppard Ave East, Toronto, ON, M2N 6N6
416-467-8151 smithandandersen.com

ENFORM architects
ENFORM Architects Inc.
1284 Sheppard Road, Suite 302B
Toronto, Ontario, Canada M8R 2B7
1.416.546.7523
www.enformarchitects.com

SEAL:

UNIVERSITY OF TORONTO

PROJECT:
HEALTH AND WELLNESS CENTRE RENOVATION AT KOFFLER

214 COLLEGE ST.
TORONTO, ON M5T 3A1

SHEET CONTENTS:
LEVEL 02 - POWER PLAN

PROJECT NUMBER:
21590.003

DRAWING SCALE:
As indicated

DRAWN BY:
Author


CHECKED BY:
Checker

DATE:
Issue Date

REV:

E302

10

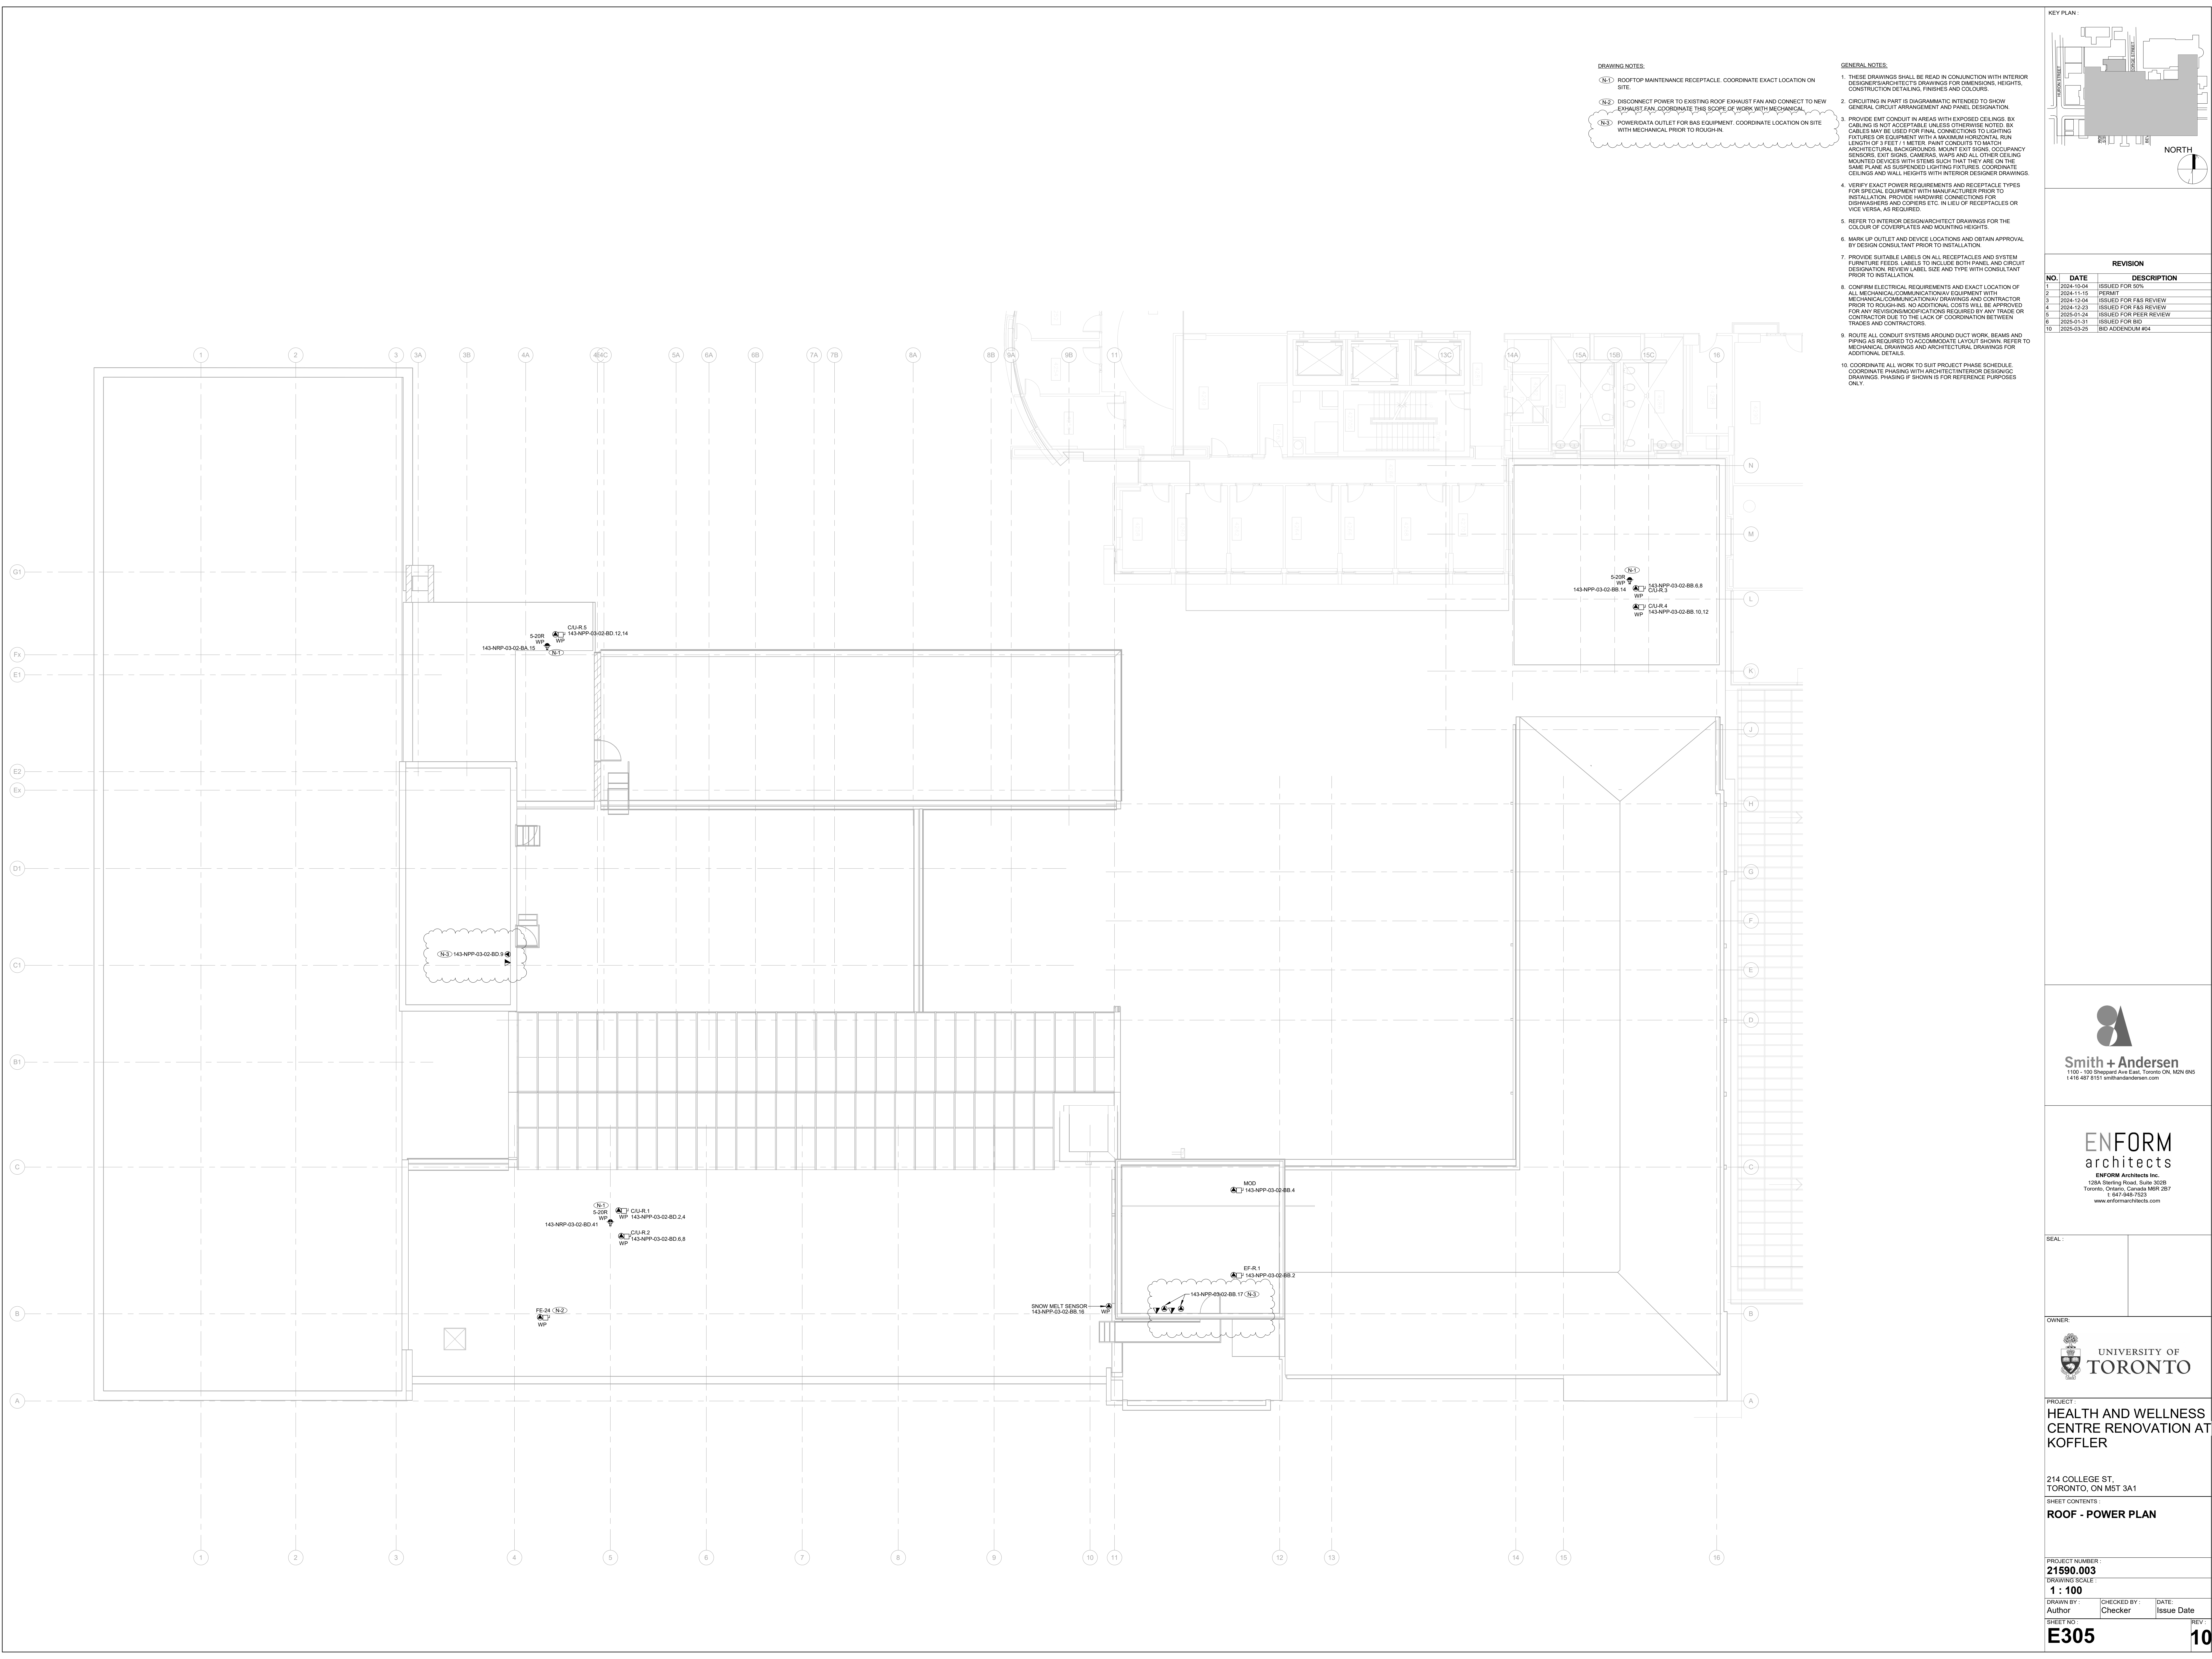


DRAWING NOTES:

1. THESE DRAWINGS SHALL BE READ IN CONJUNCTION WITH INTERIOR DESIGNER/ARCHITECT'S DRAWINGS FOR DIMENSIONS, HEIGHTS, CONSTRUCTION DETAILING, FINISHES AND COLOURS.
2. DISCONNECT POWER TO EXISTING ROOF EXHAUST FAN AND CONNECT TO NEW EXHAUST FAN. COORDINATE THIS SCOPE OF WORK WITH MECHANICAL.
3. PROVIDE EMT CONDUIT IN AREAS WITH EXPOSED CEILINGS. BX CABLEING IS NOT ACCEPTABLE UNLESS OTHERWISE NOTED. BX CABLES MAY BE USED FOR FINAL CONNECTIONS TO LIGHTING FIXTURES OR EQUIPMENT WITH A MAXIMUM HORIZONTAL RUN LENGTH OF 3 FEET (1.1 METERS). PANT CONDUITS TO MOUNT ARCHITECTURAL BACKGROUNDS, MOUNT EXIT SIGNS, OCCUPANCY SENSORS, EXIT SIGNS, CAMERAS, WAPS AND ALL OTHER CEILING MOUNTED DEVICES WITH STEERS SUCH THAT THEY ARE ON THE SAME PLANE AS SUSPENDED LIGHTING FIXTURES. COORDINATE CEILING AND WALL HEIGHTS WITH INTERIOR DESIGNER DRAWINGS.
4. VERIFY EXACT POWER REQUIREMENTS AND RECEPTACLE TYPES FOR SPECIAL EQUIPMENT WITH MANUFACTURER PRIOR TO INSTALLATION. PROVIDE HARDWARE CONNECTIONS FOR DISHWASHERS AND COFFERS ETC. IN LIEU OF RECEPTACLES OR VICE VERSA, AS REQUIRED.
5. REFER TO INTERIOR DESIGNER/ARCHITECT DRAWINGS FOR THE COLOUR OF COVERPLATES AND MOUNTING HEIGHTS.
6. MARK UP OUTLET AND DEVICE LOCATIONS AND OBTAIN APPROVAL BY DESIGN CONSULTANT PRIOR TO INSTALLATION.
7. PROVIDE SUITABLE LABELS ON ALL RECEPTACLES AND SYSTEM FURNITURE. LABELS TO INCLUDE BOTH PANEL AND CIRCUIT DESIGNATION. REVIEW LABEL SIZE AND TYPE WITH CONSULTANT PRIOR TO INSTALLATION.
8. CONFIRM ELECTRICAL REQUIREMENTS AND EXACT LOCATION OF ALL MECHANICAL/COMMUNICATIONARY EQUIPMENT WITH MECHANICAL/COMMUNICATIONARY DRAWINGS AND CONTRACTOR PRIOR TO ROUGHINS. NO ADDITIONAL COSTS WILL BE APPROVED FOR ANY REVISIONS/RELOCATIONS REQUIRED BY ANY TRADE OR CONTRACTOR DUE TO THE LACK OF COORDINATION BETWEEN TRADES AND CONTRACTORS.
9. ROUTE ALL CONDUIT SYSTEMS AROUND DUCT WORK, BEAMS AND PIPING AS REQUIRED TO ACCOMMODATE LAYOUT SHOWN. REFER TO MECHANICAL DRAWINGS AND ARCHITECTURAL DRAWINGS FOR ADDITIONAL DETAILS.
10. COORDINATE ALL WORK TO SUIT PROJECT PHASE SCHEDULE. COORDINATE PHASING WITH ARCHITECT/INTERIOR DESIGNER'S DRAWINGS. PHASING IF SHOWN IS FOR REFERENCE PURPOSES ONLY.

GENERAL NOTES:

1. THESE DRAWINGS SHALL BE READ IN CONJUNCTION WITH INTERIOR DESIGNER/ARCHITECT'S DRAWINGS FOR DIMENSIONS, HEIGHTS, CONSTRUCTION DETAILING, FINISHES AND COLOURS.
2. DISCONNECT POWER TO EXISTING ROOF EXHAUST FAN AND CONNECT TO NEW EXHAUST FAN. COORDINATE THIS SCOPE OF WORK WITH MECHANICAL.
3. PROVIDE EMT CONDUIT IN AREAS WITH EXPOSED CEILINGS. BX CABLEING IS NOT ACCEPTABLE UNLESS OTHERWISE NOTED. BX CABLES MAY BE USED FOR FINAL CONNECTIONS TO LIGHTING FIXTURES OR EQUIPMENT WITH A MAXIMUM HORIZONTAL RUN LENGTH OF 3 FEET (1.1 METERS). PANT CONDUITS TO MOUNT ARCHITECTURAL BACKGROUNDS, MOUNT EXIT SIGNS, OCCUPANCY SENSORS, EXIT SIGNS, CAMERAS, WAPS AND ALL OTHER CEILING MOUNTED DEVICES WITH STEERS SUCH THAT THEY ARE ON THE SAME PLANE AS SUSPENDED LIGHTING FIXTURES. COORDINATE CEILING AND WALL HEIGHTS WITH INTERIOR DESIGNER DRAWINGS.
4. VERIFY EXACT POWER REQUIREMENTS AND RECEPTACLE TYPES FOR SPECIAL EQUIPMENT WITH MANUFACTURER PRIOR TO INSTALLATION. PROVIDE HARDWARE CONNECTIONS FOR DISHWASHERS AND COFFERS ETC. IN LIEU OF RECEPTACLES OR VICE VERSA, AS REQUIRED.
5. REFER TO INTERIOR DESIGNER/ARCHITECT DRAWINGS FOR THE COLOUR OF COVERPLATES AND MOUNTING HEIGHTS.
6. MARK UP OUTLET AND DEVICE LOCATIONS AND OBTAIN APPROVAL BY DESIGN CONSULTANT PRIOR TO INSTALLATION.
7. PROVIDE SUITABLE LABELS ON ALL RECEPTACLES AND SYSTEM FURNITURE. LABELS TO INCLUDE BOTH PANEL AND CIRCUIT DESIGNATION. REVIEW LABEL SIZE AND TYPE WITH CONSULTANT PRIOR TO INSTALLATION.
8. CONFIRM ELECTRICAL REQUIREMENTS AND EXACT LOCATION OF ALL MECHANICAL/COMMUNICATIONARY EQUIPMENT WITH MECHANICAL/COMMUNICATIONARY DRAWINGS AND CONTRACTOR PRIOR TO ROUGHINS. NO ADDITIONAL COSTS WILL BE APPROVED FOR ANY REVISIONS/RELOCATIONS REQUIRED BY ANY TRADE OR CONTRACTOR DUE TO THE LACK OF COORDINATION BETWEEN TRADES AND CONTRACTORS.
9. ROUTE ALL CONDUIT SYSTEMS AROUND DUCT WORK, BEAMS AND PIPING AS REQUIRED TO ACCOMMODATE LAYOUT SHOWN. REFER TO MECHANICAL DRAWINGS AND ARCHITECTURAL DRAWINGS FOR ADDITIONAL DETAILS.
10. COORDINATE ALL WORK TO SUIT PROJECT PHASE SCHEDULE. COORDINATE PHASING WITH ARCHITECT/INTERIOR DESIGNER'S DRAWINGS. PHASING IF SHOWN IS FOR REFERENCE PURPOSES ONLY.

KEY PLAN:

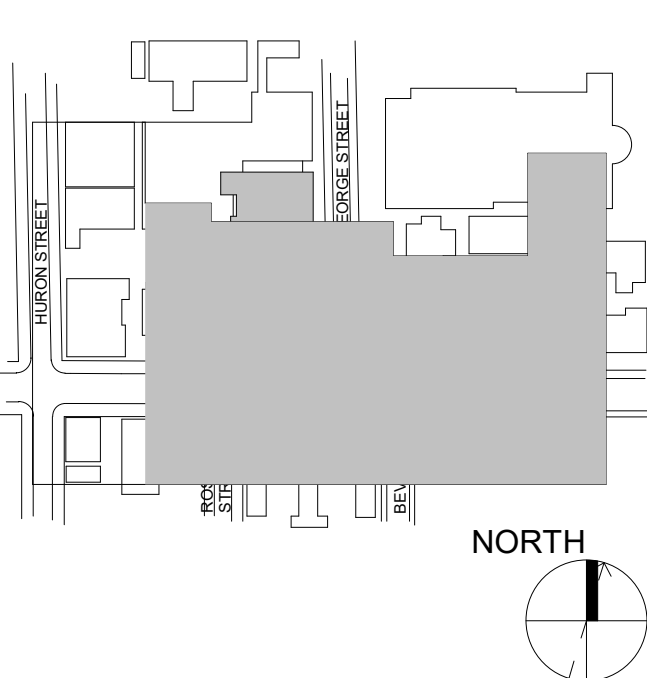

REVISION

NO.	DATE	DESCRIPTION
1	2024-03-01	ISSUED FOR 50%
2	2024-11-15	PERMIT
3	2024-12-04	ISSUED FOR P&S REVIEW
4	2024-12-23	ISSUED FOR P&S REVIEW
5	2025-01-24	ISSUED FOR P&S REVIEW
6	2025-01-31	ISSUED FOR BID
10	2025-03-25	BID ADDENDUM #04



Smith + Andersen
1100 - 109 Sheppard Ave East, Toronto ON, M2N 0N5
416-467-8153 smithandandersen.com

ENFORM
architects

ENFORM Architects Inc.
1284 Sheppard Road, Suite 302B
Toronto, Ontario, Canada M8R 2B7
1-877-546-7523
www.enformarchitects.com

SEAL:

OWNER:



**UNIVERSITY OF
TORONTO**

PROJECT:
**HEALTH AND WELLNESS
CENTRE RENOVATION AT
KOFFLER**

214 COLLEGE ST.
TORONTO, ON M5T 3A1

SHEET CONTENTS:
ROOF - POWER PLAN

PROJECT NUMBER:

21590.003

DRAWING SCALE:

1 : 100

DRAWN BY:

Author

CHECKED BY:

Checker

DATE:

Issue Date


SHEET NO.:

E305

REV:


10

KEY PLAN

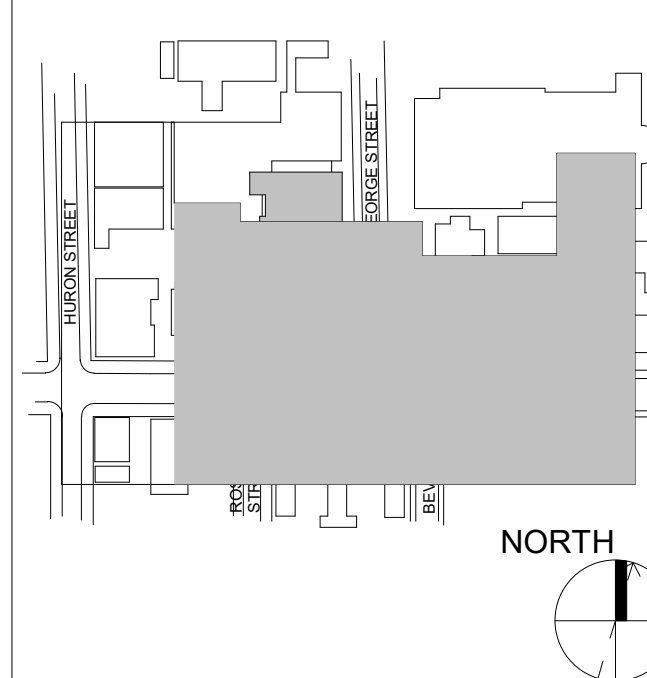

7. THESE DRAWINGS WILL BE READ IN CONJUNCTION WITH COMMUNICATIONS, SECURITY AND AV DRAWINGS FOR COMPLETE SCOPE OF WORK FOR CONDUIT PATHWAYS. ADDITIONAL FEES WILL NOT BE PERMITTED DUE TO LACK OF COORDINATION.

REVISION		
NO.	DATE	DESCRIPTION
1	2024-10-04	ISSUED FOR 50%
2	2024-11-15	PERMIT
3	2024-12-04	ISSUED FOR F&S REVIEW
4	2024-12-23	ISSUED FOR F&S REVIEW
5	2025-01-24	ISSUED FOR PEER REVIEW
6	2025-01-31	ISSUED FOR BID
8	2025-03-14	BID ADDENDUM #02

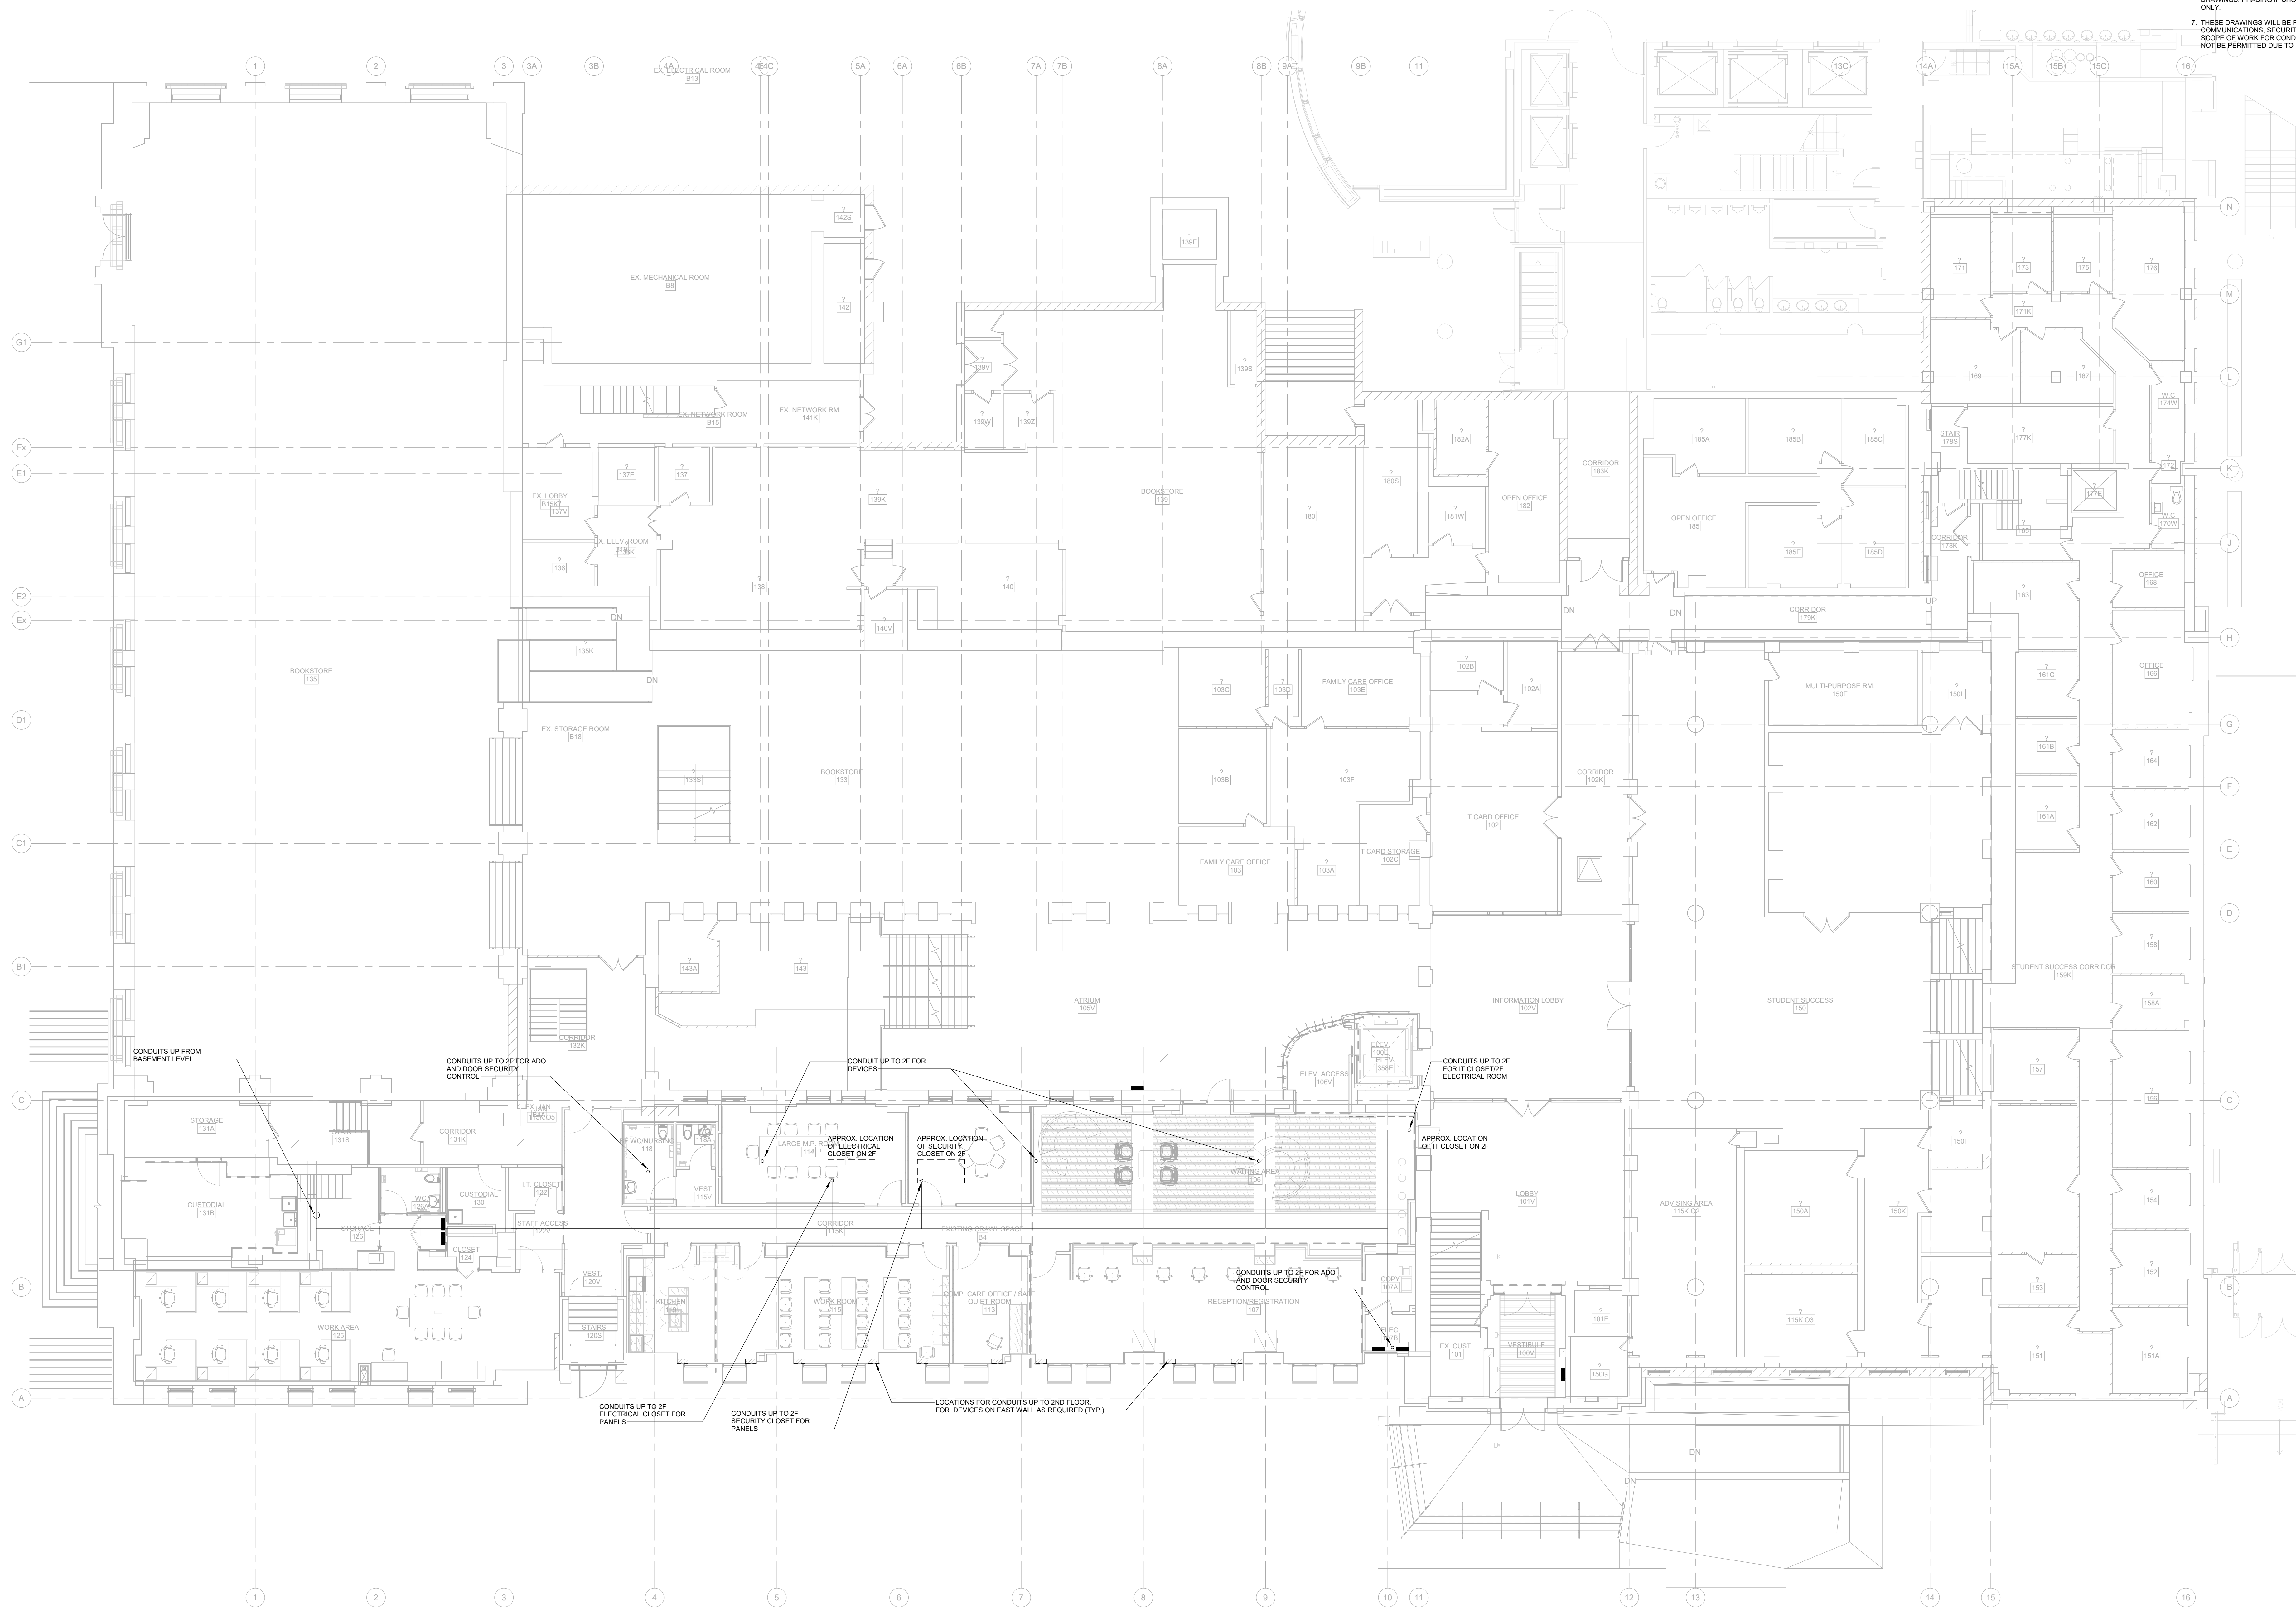

Smith + Andersen
1100 • 100 Sheppard Ave East, Toronto ON, M2N 6N5
t 416 487 8151 smithandandersen.com

ENFORM
architects

ENFORM Architects Inc.
128A Sterling Road, Suite 302B
Toronto, Ontario, Canada M6R 2B7
t: 647-948-7523
www.enformarchitects.com

SEAL :

OWNER:

 UNIVERSITY OF
TORONTO

PROJECT:
HEALTH AND WELLNESS
CENTRE RENOVATION AT
KOFFLER

214 COLLEGE ST,
TORONTO, ON M5T 3A1

SHEET CONTENTS :


LEVEL 01 - PATHWAY LAYOUT

PROJECT NUMBER :	21590.003
DRAWING SCALE :	

DRAWING CODE : 1 : 100		
DRAWN BY : Author	CHECKED BY : Checker	DATE: Issue Date

7/11/07	Checker	Issue Date
SHEET NO : E307		RE : 8

KEY PLAN:

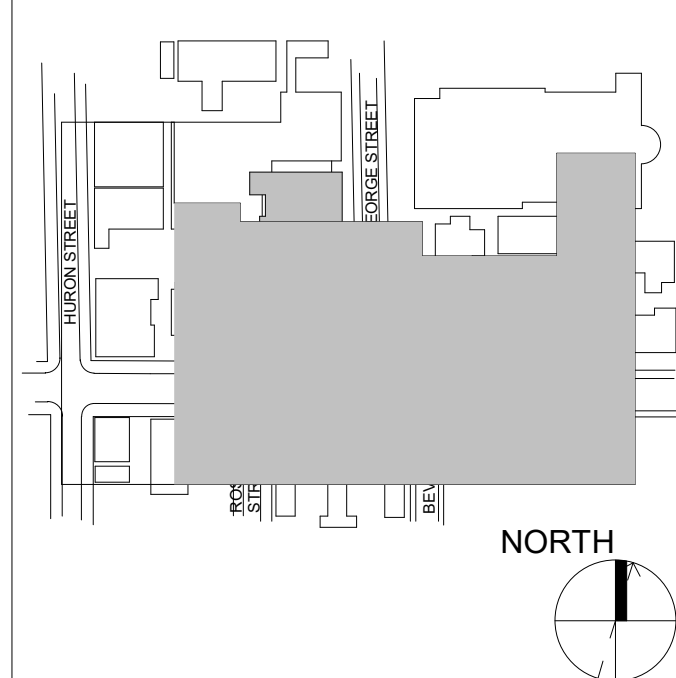

GENERAL NOTES:

1. THESE DRAWINGS SHALL BE READ IN CONJUNCTION WITH INTERIOR DESIGNER/ARCHITECT'S DRAWINGS FOR DIMENSIONS, HEIGHTS, CONSTRUCTION DETAILING, FINISHES AND COLOURS.
2. SHOWN IS PROPOSED ROUTING ONLY. EXACT ROUTING TO BE CONFIRMED ON SITE.
3. MAIN CONDUITS SHALL BE RUN ALONG CORRIDOR WHERE POSSIBLE.
4. PROVIDE EMT CONDUIT IN AREAS WITH EXPOSED CEILING. BX CABLE IS NOT ACCEPTABLE UNLESS OTHERWISE NOTED. BX CABLES MAY BE USED FOR FINAL CONNECTIONS TO LIGHTING FIXTURES OR EQUIPMENT WITH A MAXIMUM HORIZONTAL RUN LENGTH OF 3 FEET / 1 METER. PANT CONDUITS TO MATCH ARCHITECTURAL BACKGROUNDS. MOUNT EXIT SIGNS, OCCUPANCY SENSORS, EXIT SIGNS, CAMERAS, WAFS AND ALL OTHER CEILING MOUNTED DEVICES WITH STEMS SUCH THAT THEY ARE ON THE SAME PLANE AS SUSPENDED LIGHTING FIXTURES. COORDINATE CEILING AND WALL HEIGHTS WITH INTERIOR DESIGNER DRAWINGS.
5. ROUTE ALL CONDUIT SYSTEMS AROUND DUCT WORK, BEAMS AND PIPING AS REQUIRED TO ACCOMMODATE LAYOUT SHOWN. REFER TO MECHANICAL DRAWINGS AND ARCHITECTURAL DRAWINGS FOR ADDITIONAL DETAILS.
6. COORDINATE ALL WORK TO SUIT PROJECT PHASE SCHEDULE. COORDINATE PHASING WITH ARCHITECT/INTERIOR DESIGN/CC DRAWINGS. PHASING IF SHOWN IS FOR REFERENCE PURPOSES ONLY.
7. THESE DRAWINGS WILL BE READ IN CONJUNCTION WITH COMMUNICATIONS SECURITY AND AV DRAWINGS FOR COMPLETE SCOPE OF WORK FOR CONDUIT PATHWAYS. ADDITIONAL FEES WILL NOT BE PERMITTED DUE TO LACK OF COORDINATION.

REVISION		
NO.	DATE	DESCRIPTION
1	2024-10-04	ISSUED FOR 50% PERMIT
2	2024-11-15	PERMIT
3	2024-12-04	ISSUED FOR P&S REVIEW
4	2024-12-23	ISSUED FOR P&S REVIEW
5	2025-01-24	ISSUED FOR P&S REVIEW
6	2025-01-31	ISSUED FOR BID
10	2025-03-25	BID ADDENDUM #04



SEAL:

OWNER:



PROJECT:
**HEALTH AND WELLNESS
CENTRE RENOVATION AT
KOFFLER**

214 COLLEGE ST.
TORONTO, ON M5T 3A1

SHEET CONTENTS:
LEVEL 03 - PATHWAY LAYOUT

PROJECT NUMBER:
21590.003

DRAWING SCALE:

1 : 100


DRAWN BY: CHECKED BY: DATE:

Author Checker Issue Date

SHEET NO. REV:

E309

10

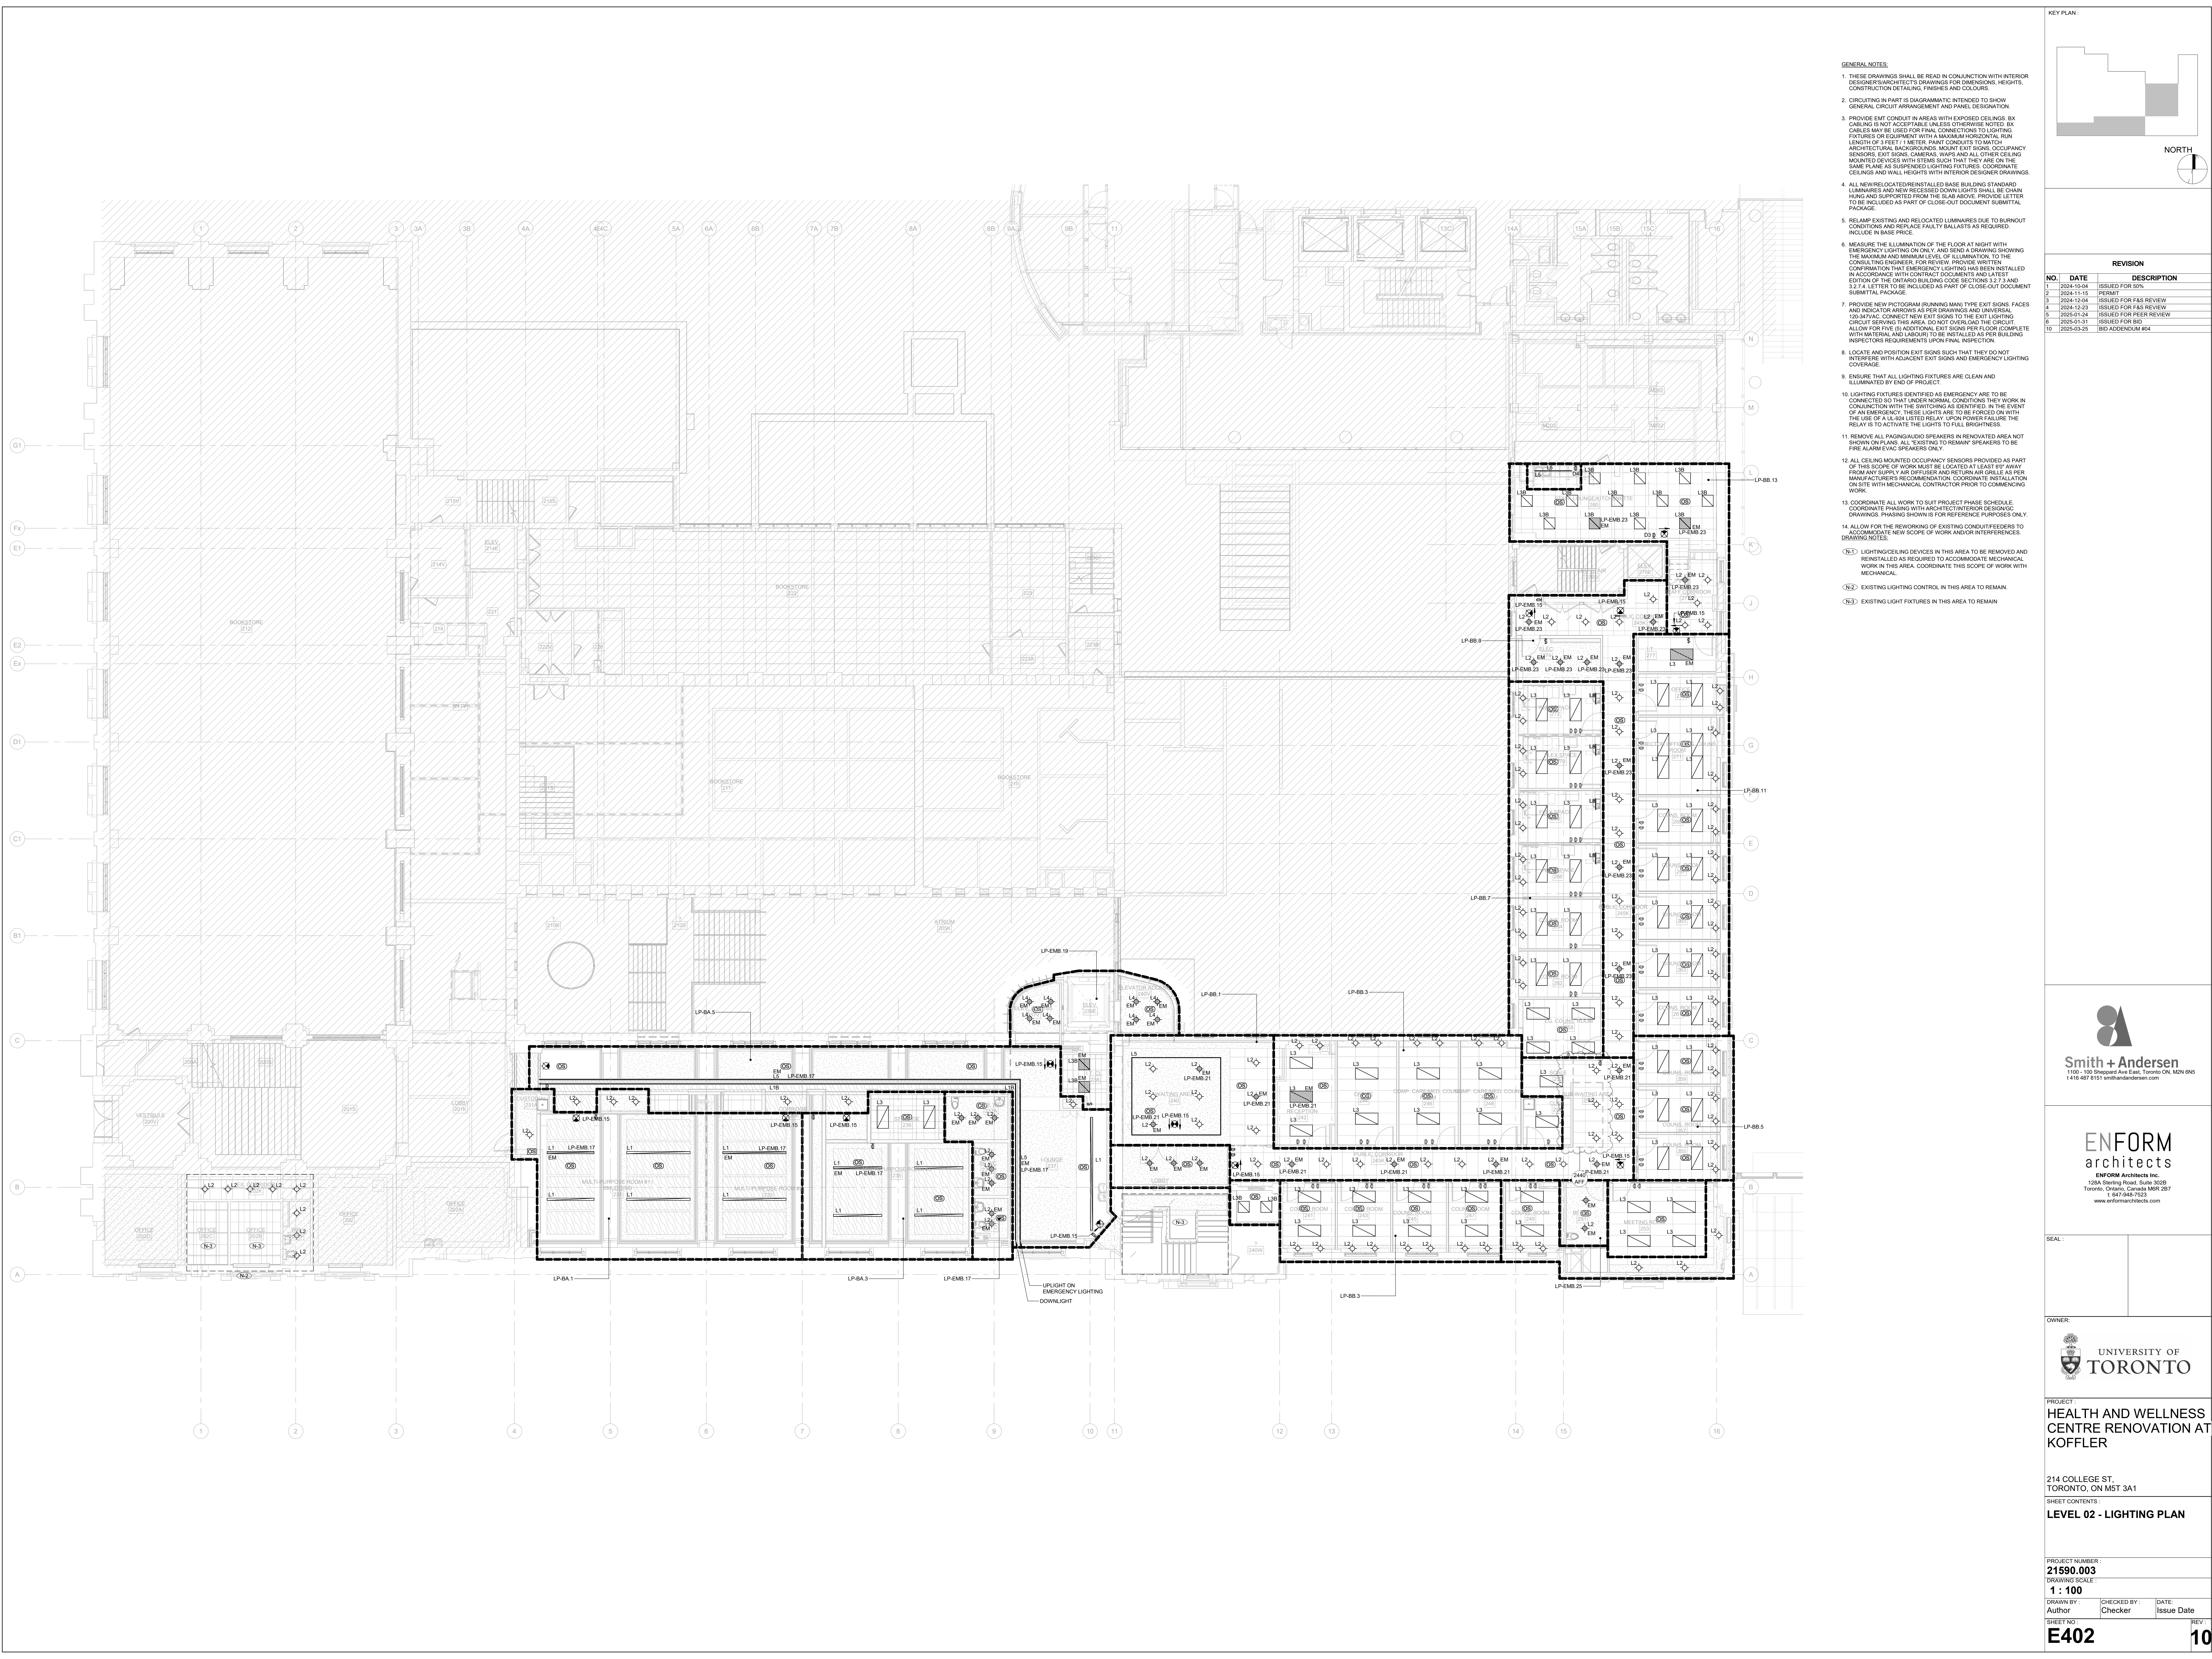

- GENERAL NOTES:**
- THESE DRAWINGS SHALL BE READ IN CONJUNCTION WITH INTERIOR DESIGNER/ARCHITECT'S DRAWINGS FOR DIMENSIONS, HEIGHTS, CONSTRUCTION DETAILING, FINISHES AND COLOURS.
 - CIRCUITING IN PART IS DIAGRAMMATIC INTENDED TO SHOW GENERAL CIRCUIT ARRANGEMENT AND PANEL DESIGNATION.
 - PROVIDE EMT CONDUIT IN AREAS WITH EXPOSED CEILINGS. EX. CABLEING IS NOT ACCEPTABLE UNLESS OTHERWISE NOTED. BX CABLES MAY BE USED FOR FINAL CONNECTIONS TO LIGHTING FIXTURES. EQUIPMENT SHALL BE MOUNTED WITH A MINIMUM RUN LENGTH OF 3 FEET / 1 METER. PAINT CONDUITS TO MATCH ARCHITECTURAL BACKGROUND. MOUNT EXIT SIGNS, OCCUPANCY SENSORS, EXIT SIGNS, CAMERAS, WAPS AND ALL OTHER CEILING MOUNTED DEVICES WITH STUDS SUCH THAT THEY ARE ON THE SAME PLANE AS SUSPENDED LIGHTING FIXTURES. COORDINATE CEILING AND WALL HEIGHTS WITH INTERIOR DESIGNER DRAWINGS.
 - ALL NEW/RELOCATED/REINSTALLED BASE BUILDING STANDARD LUMINAIRES AND NEW RECESSED DOWN LIGHTS SHALL BE CHAIN HUNG AND SUPPORTED FROM THE SLAB ABOVE. PROVIDE LETTER TO BE INCLUDED AS PART OF CLOSE-OUT DOCUMENT SUBMITTAL PACKAGE.
 - RELAMP EXISTING AND RELOCATED LUMINAIRES DUE TO BURNOUT CONDITIONS AND REPLACE FAULTY BALLASTS AS REQUIRED. INCLUDE IN BASE PRICE.
 - MEASURE THE ILLUMINATION OF THE FLOOR AT NIGHT WITH EMERGENCY LIGHTING ON ONLY. AND SEND A DRAWING SHOWING THE MAXIMUM AND MINIMUM LEVEL OF ILLUMINATION. TO THE CONSULTING ENGINEER FOR REVIEW. PROVIDE WRITTEN CONFIRMATION THAT EMERGENCY LIGHTING HAS BEEN INSTALLED IN ACCORDANCE WITH CONTRACT DOCUMENTS AND LATEST EDITION OF THE ONTARIO BUILDING CODE SECTIONS 3.2.7.3 AND 3.2.7.4. LETTER TO BE INCLUDED AS PART OF CLOSE-OUT DOCUMENT SUBMITTAL PACKAGE.
 - PROVIDE NEW PICTOGRAM (RUNNING MAN) TYPE EXIT SIGNS, FACES AND INDICATOR ARROWS AS PER DRAWINGS AND UNIVERSAL 120-347VAC. CONNECT NEW EXIT SIGNS TO THE EXIT LIGHTING CIRCUIT SERVING THIS AREA. DO NOT OVERLOAD THE CIRCUIT. ALLOW FOR FIVE (5) ADDITIONAL EXIT SIGNS PER FLOOR (COMPLETE WITH MATERIAL AND LABOUR) TO BE INSTALLED AS PER BUILDING INSPECTORS REQUIREMENTS UPON FINAL INSPECTION.
 - LOCATE AND POSITION EXIT SIGNS SUCH THAT THEY DO NOT INTERFERE WITH ADJACENT EXIT SIGNS AND EMERGENCY LIGHTING COVERAGE.
 - ENSURE THAT ALL LIGHTING FIXTURES ARE CLEAN AND ILLUMINATED BY END OF PROJECT.
 - LIGHTING FIXTURES IDENTIFIED AS EMERGENCY ARE TO BE CONNECTED SO THAT UNDER NORMAL CONDITIONS THEY WORK IN CONJUNCTION WITH THE SWITCHING AS IDENTIFIED. IN THE EVENT OF AN EMERGENCY, THESE LIGHTS ARE TO BE FORCED ON WITH THE USE OF A UL624 LISTED RELAY. UPON POWER FAILURE THE RELAY IS TO ACTIVATE THE LIGHTS TO FULL BRIGHTNESS.
 - REMOVE ALL PAGING/AUDIO SPEAKERS IN RENOVATED AREA NOT SHOWN ON PLANS. ALL "EXISTING TO REMAIN" SPEAKERS TO BE FIRE ALARM EVAC SPEAKERS ONLY.
 - ALL CEILING MOUNTED OCCUPANCY SENSORS PROVIDED AS PART OF THIS SCOPE OF WORK MUST BE LOCATED AT LEAST 6" AWAY FROM ANY SUPPLY AIR DIFFUSER AND RETURN AIR GRILLE AS PER MANUFACTURER'S RECOMMENDATION. COORDINATE INSTALLATION ON SITE WITH MECHANICAL CONTRACTOR PRIOR TO COMMENCING WORK.
 - COORDINATE ALL WORK TO SUB PROJECT PHASE SCHEDULE. COORDINATE PHASING WITH ARCHITECT/INTERIOR DESIGNER. DRAWINGS PHASING SHOWN IS FOR REFERENCE PURPOSES ONLY.
 - ALLOW FOR THE REWORKING OF EXISTING CONDUIT/FEEDERS TO ACCOMMODATE NEW SCOPE OF WORK AND/OR INTERFERENCES. DRAWING NOTES:
 - (L1) LIGHTING/CEILING DEVICES IN THIS AREA TO BE REMOVED AND REINSTALLED AS REQUIRED TO ACCOMMODATE MECHANICAL WORK IN THIS AREA. COORDINATE THIS SCOPE OF WORK WITH MECHANICAL.
 - (L2) EXISTING LIGHTING CONTROL IN THIS AREA TO REMAIN.
 - (L3) EXISTING LIGHT FIXTURES IN THIS AREA TO REMAIN.

KEY PLAN:

REVISION

NO.	DATE	DESCRIPTION
1	2024-10-04	ISSUED FOR 50%.
2	2024-11-15	PERMIT
3	2024-12-04	ISSUED FOR P&S REVIEW
4	2024-12-23	ISSUED FOR P&S REVIEW
5	2025-01-24	ISSUED FOR P&S REVIEW
6	2025-01-31	ISSUED FOR BID
10	2025-03-25	BID ADDENDUM #04

Smith + Andersen
1100 - 109 Sheppard Ave East, Toronto, ON, M2N 0N9
416-467-8151 smithandandersen.com

ENFORM
architects

ENFORM Architects Inc.
1286 Sheppard Road, Suite 302B
Toronto, Ontario, Canada M8R 2B7
416-546-7523
www.enformarchitects.com

SEAL:

OWNER:

UNIVERSITY OF TORONTO

PROJECT:

HEALTH AND WELLNESS CENTRE RENOVATION AT KOFFLER

214 COLLEGE ST.
TORONTO, ON M5T 3A1

SHEET CONTENTS:

LEVEL 02 - LIGHTING PLAN

PROJECT NUMBER:
21590.003


DRAWING SCALE:
1 : 100

DRAWN BY:	CHECKED BY:	DATE:
Author	Checker	Issue Date

SHEET NO.: **E402**

REV:

10

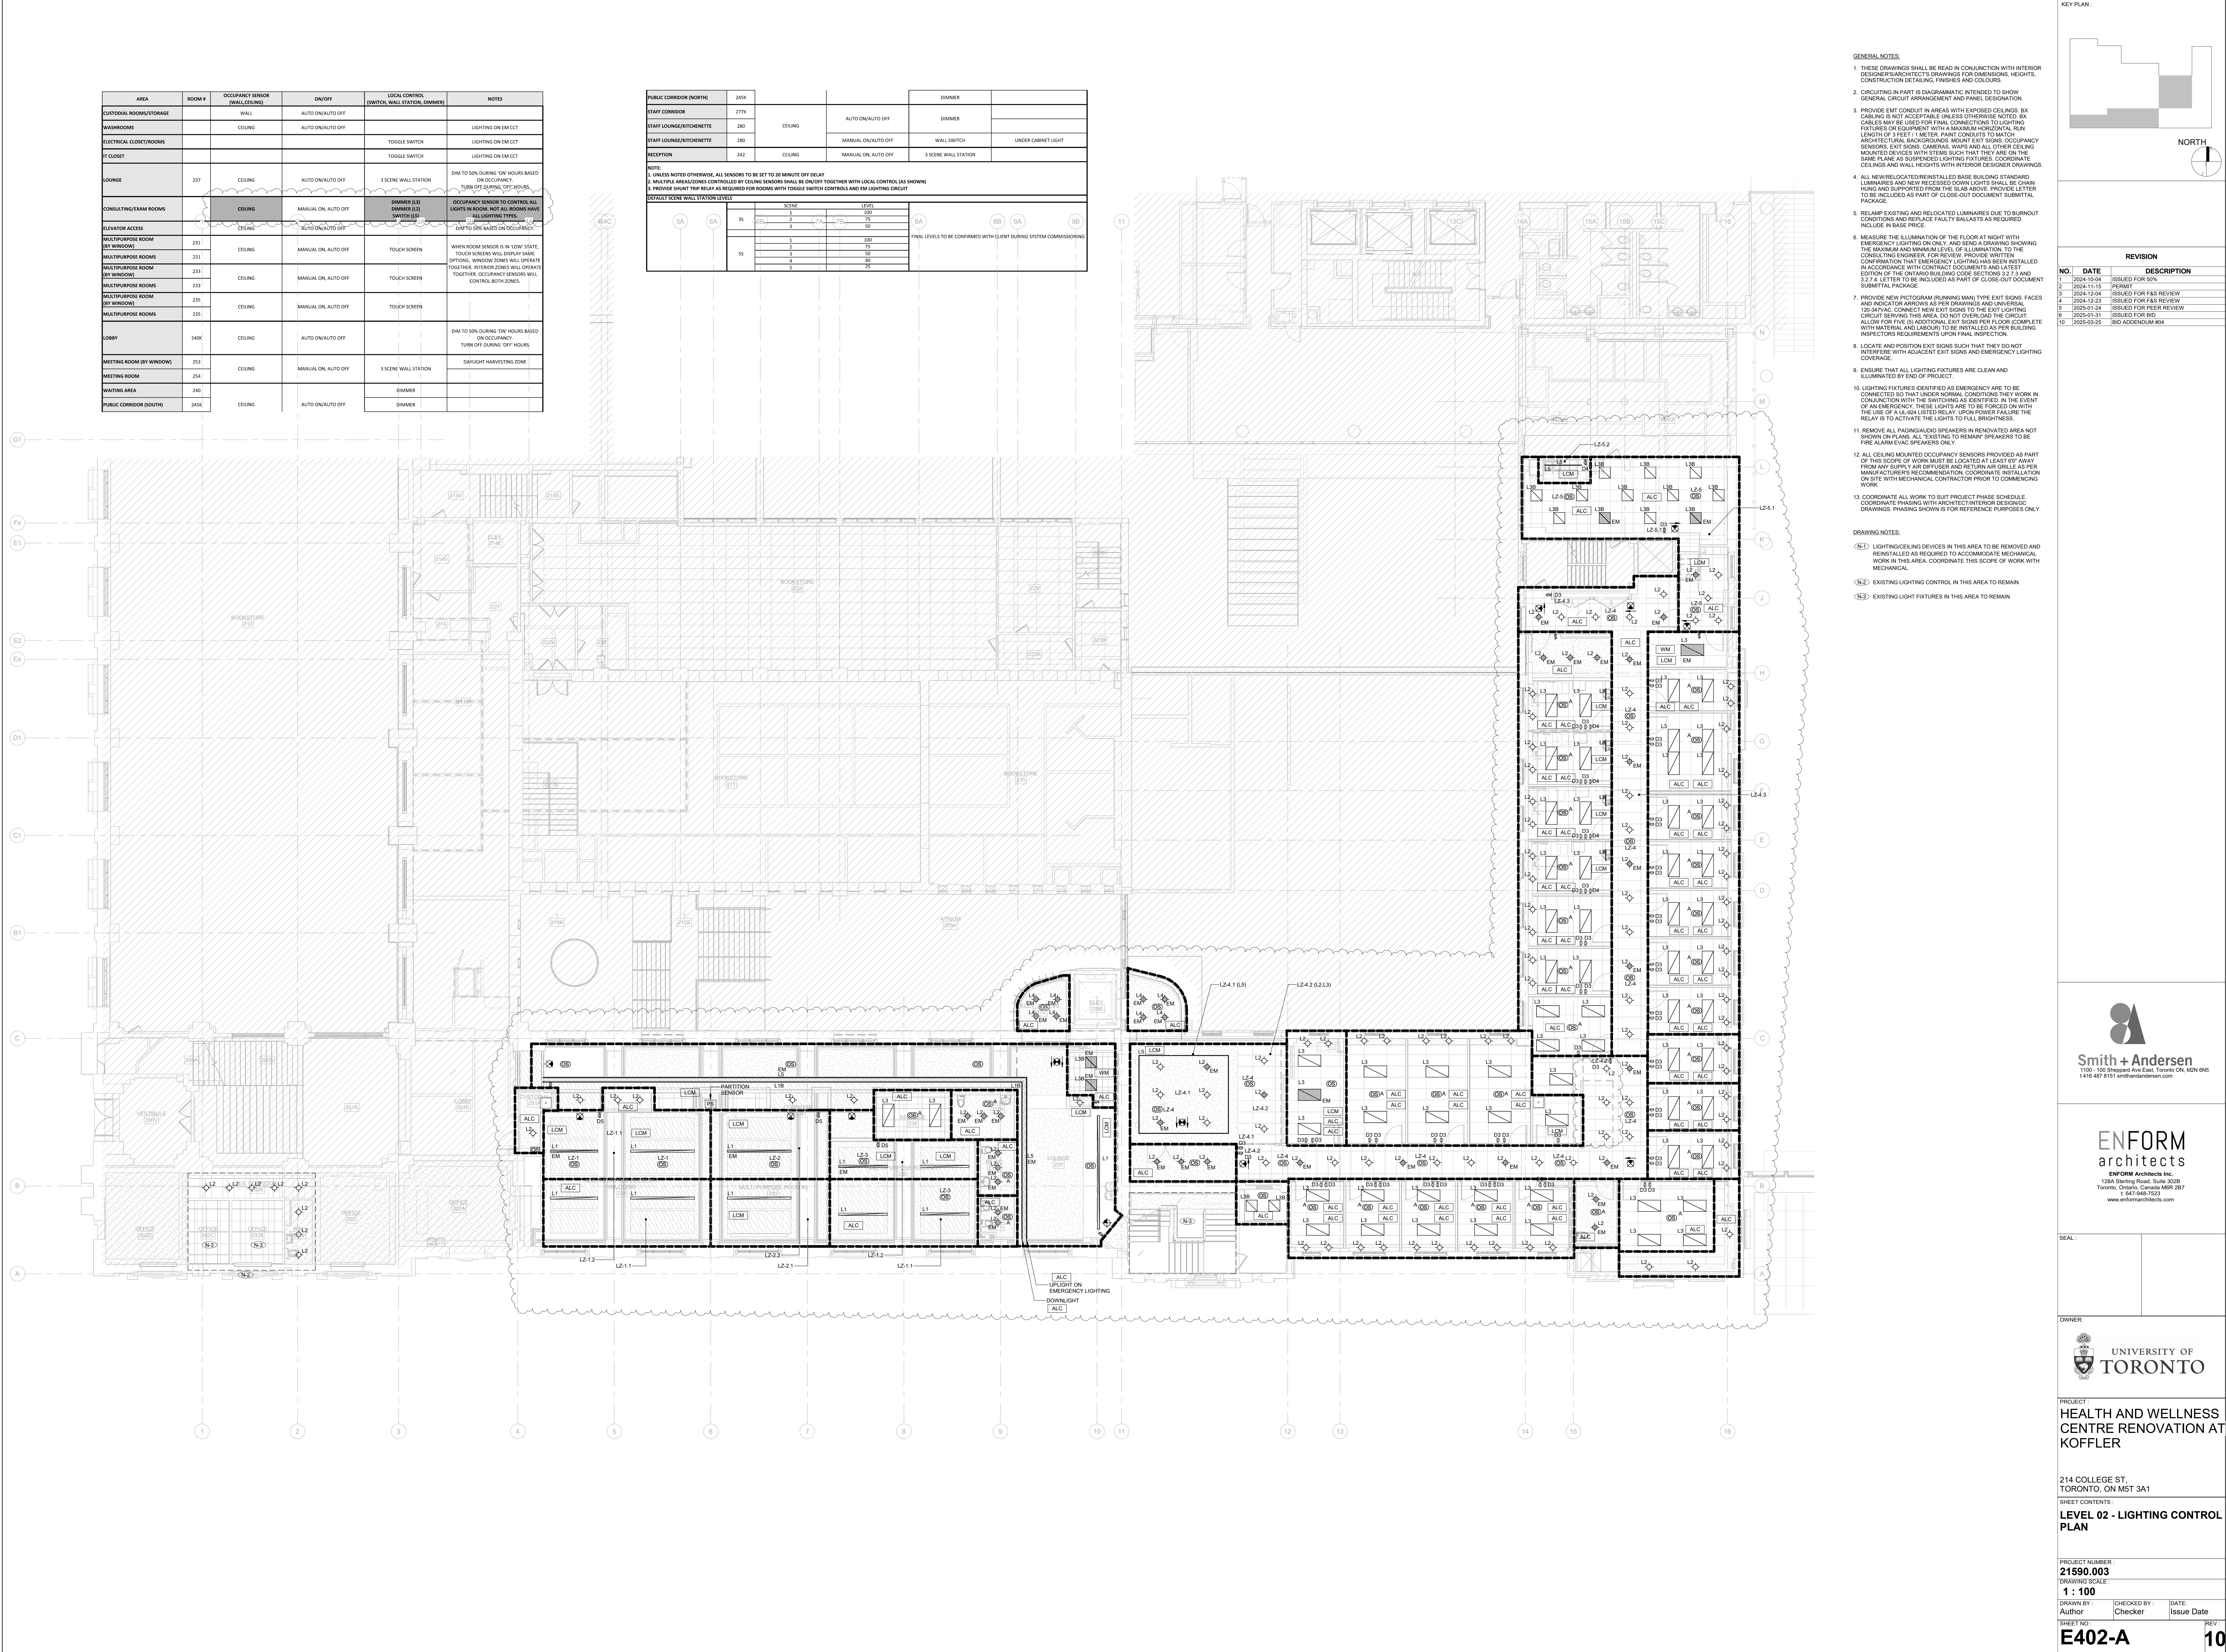

- GENERAL NOTES:**
1. THESE DRAWINGS SHALL BE READ IN CONJUNCTION WITH INTERIOR DESIGNER/ARCHITECT'S DRAWINGS FOR DIMENSIONS, HEIGHTS, CONSTRUCTION DETAILING, FINISHES AND COLOURS.
 2. CIRCUITING IN PART IS DIAGRAMMATIC INTENDED TO SHOW GENERAL CIRCUIT ARRANGEMENT AND PANEL DESIGNATION.
 3. PROVIDE EMT CONDUIT IN AREAS WITH EXPOSED CEILINGS. EX CABLEING IS NOT ACCEPTABLE UNLESS OTHERWISE NOTED. EX CABLES MAY BE USED FOR FINAL CONNECTIONS TO LIGHTING FIXTURES EQUIPPED WITH A MAXIMUM HORIZONTAL RUN LENGTH OF 3 FEET / 1 METER. PANT CONDUITS TO MATCH ARCHITECTURAL BACKGROUND. MOUNT EXIT SIGNS, OCCUPANCY SENSORS, EXIT SIGNS, CAMERAS, WAPS AND ALL OTHER CEILING MOUNTED DEVICES WITH STRAPS SUCH THAT THEY ARE ON THE SAME PLANE AS SUSPENDED LIGHTING FIXTURES. COORDINATE CEILING AND WALL HEIGHTS WITH INTERIOR DESIGNER DRAWINGS.
 4. ALL NEW/RELOCATED/REINSTALLED BASE BUILDING STANDARD LUMINAIRES AND NEW RECESSED DOWN LIGHT SHALL BE CHAIN HUNG AND SUPPORTED FROM THE SLAB ABOVE. PROVIDE LETTER TO BE INCLUDED AS PART OF CLOSE-OUT DOCUMENT SUBMITTAL PACKAGE.
 5. RELAMP EXISTING AND RELOCATED LUMINAIRES DUE TO BURNOUT CONDITIONS AND REPLACE FAULTY BALLASTS AS REQUIRED. INCLUDE IN BASE PRICE.
 6. MEASURE THE ILLUMINATION OF THE FLOOR AT NIGHT WITH EMERGENCY LIGHTING ON ONLY. AND SEND A DRAWING SHOWING THE MAXIMUM AND MINIMUM LEVEL OF ILLUMINATION. TO THE CONSULTING ENGINEER. FOR REVIEW. PROVIDE WRITTEN CONFIRMATION THAT EMERGENCY LIGHTING HAS BEEN INSTALLED IN ACCORDANCE WITH CONTRACT DOCUMENTS AND LATEST EDITION OF THE ONTARIO BUILDING CODE SECTIONS 3.2.7.3 AND 3.2.1.4. LETTER TO BE INCLUDED AS PART OF CLOSE-OUT DOCUMENT SUBMITTAL PACKAGE.
 7. PROVIDE NEW PICTOGRAM (RUNNING MAN) TYPE EXIT SIGNS, FACES AND INDICATOR ARROWS AS PER DRAWINGS AND UNIVERSAL 120-3A/7AC. CONNECT NEW EXIT SIGNS TO THE EXIT LIGHTING CIRCUIT SERVING THIS AREA. DO NOT OVERLOAD THE CIRCUIT. ALLOW FOR FIVE (5) ADDITIONAL EXIT SIGNS PER FLOOR (COMPLETE WITH MATERIAL AND LABOUR) TO BE INSTALLED AS PER BUILDING INSPECTORS REQUIREMENTS UPON FINAL INSPECTION.
 8. LOCATE AND POSITION EXIT SIGNS SUCH THAT THEY DO NOT INTERFERE WITH ADJACENT EXIT SIGNS AND EMERGENCY LIGHTING COVERAGE.
 9. ENSURE THAT ALL LIGHTING FIXTURES ARE CLEAN AND ILLUMINATED BY END OF PROJECT.
 10. LIGHTING FIXTURES IDENTIFIED AS EMERGENCY ARE TO BE CONNECTED SO THAT UNDER NORMAL CONDITIONS THEY WORK IN CONJUNCTION WITH THE SWITCHING AS IDENTIFIED. IN THE EVENT OF AN EMERGENCY, THESE LIGHTS ARE TO BE FORCED ON WITH THE USE OF A UL624 LISTED RELAY. UPON POWER FAILURE THE RELAY IS TO ACTIVATE THE LIGHTS TO FULL BRIGHTNESS.
 11. REMOVE ALL PAGINGS/AUDIO SPEAKERS IN RENOVATED AREA NOT SHOWN ON PLANS. ALL EXISTING TO REMAIN SPEAKERS TO BE FIRE ALARM EVAC SPEAKERS ONLY.
 12. ALL CEILING MOUNTED OCCUPANCY SENSORS PROVIDED AS PART OF THIS SCOPE OF WORK MUST BE LOCATED AT LEAST 5' AWAY FROM ANY SUPPLY AIR DIFFUSER AND RETURN AIR GRILLE AS PER MANUFACTURERS RECOMMENDATION. COORDINATE INSTALLATION ON SITE WITH MECHANICAL CONTRACTOR PRIOR TO COMMENCING WORK.
 13. COORDINATE ALL WORK TO OUR PROJECT PHASE SCHEDULE. COORDINATE PHASING WITH ARCHITECT/INTERIOR DESIGN/MECHANICAL. PHASING SHOWN IS FOR REFERENCE PURPOSES ONLY.

- DRAWING NOTES:**
- (L1) LIGHTING/CEILING DEVICES IN THIS AREA TO BE REMOVED AND REINSTALLED AS REQUIRED TO ACCOMMODATE MECHANICAL WORK IN THIS AREA. COORDINATE THIS SCOPE OF WORK WITH MECHANICAL.
 - (L2) EXISTING LIGHTING CONTROL IN THIS AREA TO REMAIN.
 - (L3) EXISTING LIGHT FIXTURES IN THIS AREA TO REMAIN.

KEY PLAN:

REVISION

NO.	DATE	DESCRIPTION
1	2024-10-04	ISSUED FOR 50% PERMIT
2	2024-11-15	PERMIT
3	2024-12-04	ISSUED FOR P&S REVIEW
4	2024-12-23	ISSUED FOR P&S REVIEW
5	2025-01-24	ISSUED FOR P&S REVIEW
6	2025-01-31	ISSUED FOR BID
10	2025-03-25	BID ADDENDUM #04

Smith + Andersen
1100 - 109 Sheppard Ave East, Toronto, ON, M2N 0N9
416-467-8153 smithandandersen.com

ENFORM architects
ENFORM Architects Inc.
1284 Sheppard Road, Suite 302B
Toronto, Ontario, Canada M8R 2B7
416-546-7523
www.enformarchitects.com

SEAL:

OWNER:

UNIVERSITY OF TORONTO

PROJECT:

HEALTH AND WELLNESS CENTRE RENOVATION AT KOFFLER

214 COLLEGE ST.
TORONTO, ON M5T 3A1

SHEET CONTENTS:

LEVEL 02 - LIGHTING CONTROL PLAN

PROJECT NUMBER:
21590.003

DRAWING SCALE:
1 : 100


DRAWN BY:
Author

CHECKED BY:
Checker

DATE:
Issue Date

SHEET NO.:
E402-A

REV:
10

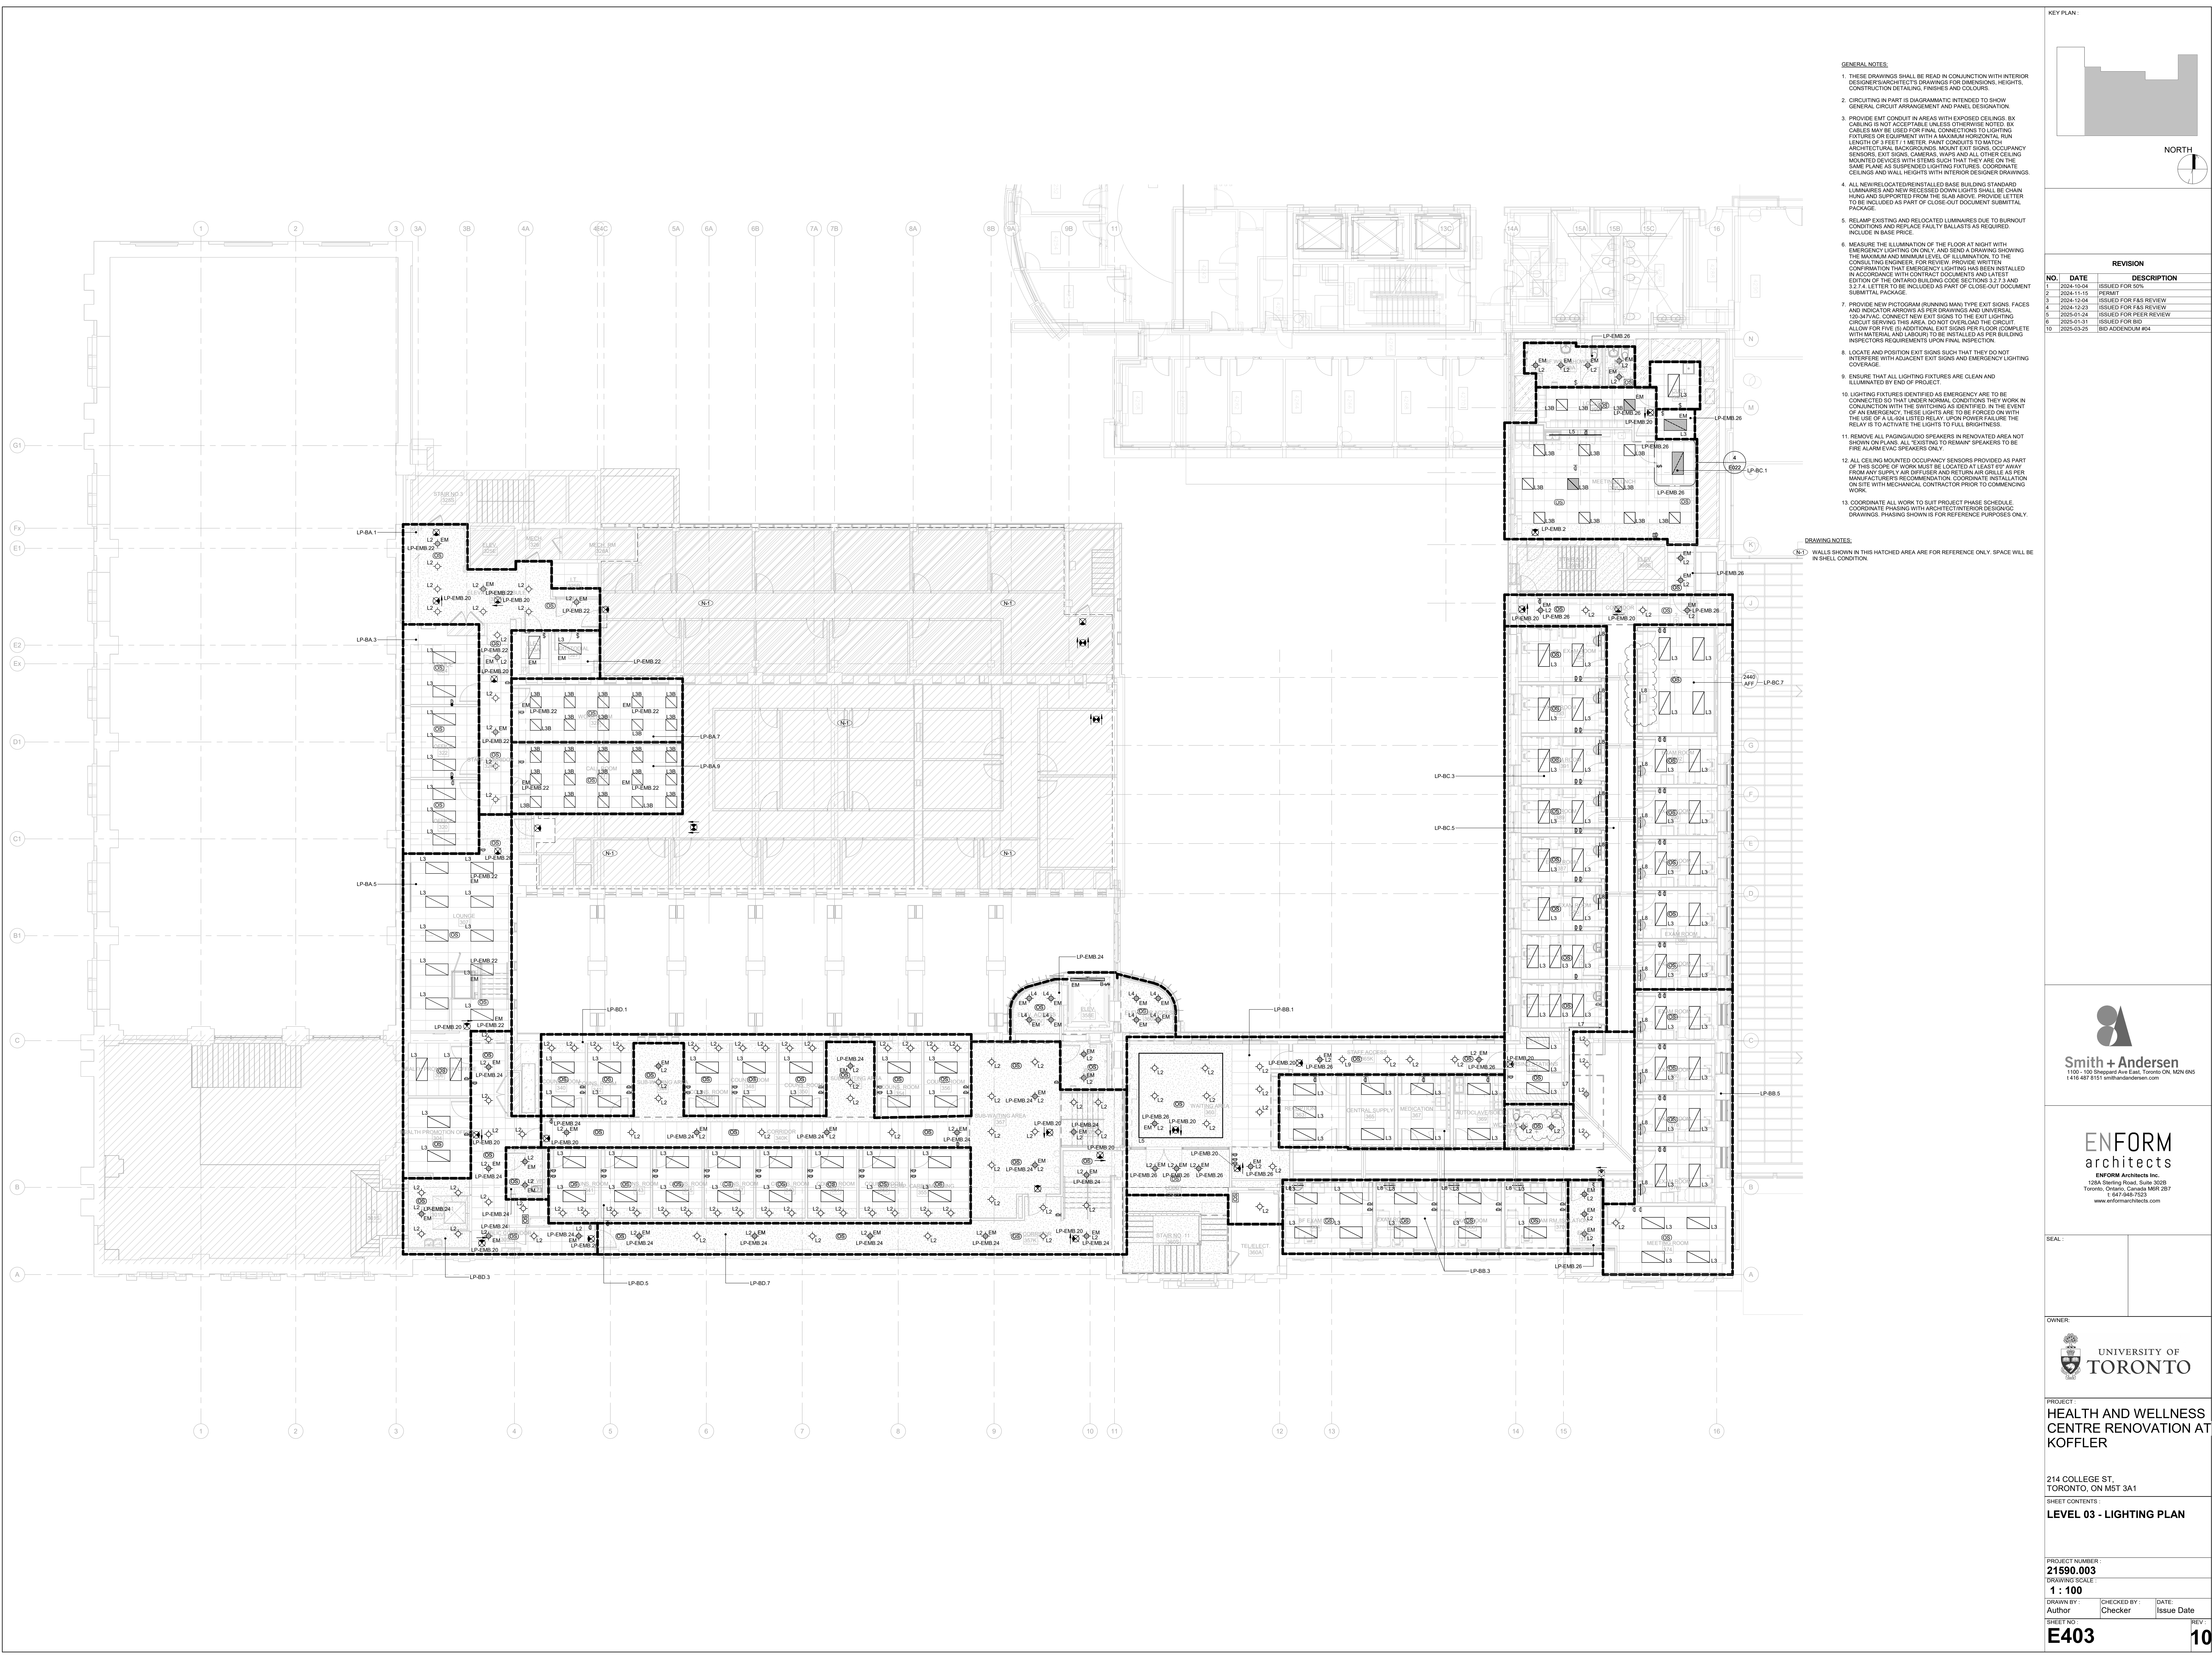

- GENERAL NOTES:**
- THESE DRAWINGS SHALL BE READ IN CONJUNCTION WITH INTERIOR DESIGNER/ARCHITECT'S DRAWINGS FOR DIMENSIONS, HEIGHTS, CONSTRUCTION DETAILING, FINISHES AND COLOURS.
 - CIRCUITING IN PART IS DIAGRAMMATIC INTENDED TO SHOW GENERAL CIRCUIT ARRANGEMENT AND PANEL DESIGNATION.
 - PROVIDE EMT CONDUIT IN AREAS WITH EXPOSED CEILINGS. EX CABLEING IS NOT ACCEPTABLE UNLESS OTHERWISE NOTED. BX CABLES MAY BE USED FOR FINAL CONNECTIONS TO LIGHTING FIXTURES. EQUIPMENT SHALL BE MOUNTED WITH A MINIMUM HORIZONTAL RUN LENGTH OF 3 FEET / 1 METER. PAINT CONDUITS TO MATCH ARCHITECTURAL BACKGROUND. MOUNT EXIT SIGNS, OCCUPANCY SENSORS, EXIT SIGNS, CAMERAS, WAPS AND ALL OTHER CEILING MOUNTED DEVICES WITH STEMS SUCH THAT THEY ARE ON THE SAME PLANE AS SUSPENDED LIGHTING FIXTURES. COORDINATE CEILING AND WALL HEIGHTS WITH INTERIOR DESIGNER DRAWINGS.
 - ALL NEW/RELOCATED/REINSTALLED BASE BUILDING STANDARD LUMINAIRES AND NEW RECESSED DOWN LIGHTS SHALL BE CHAIN HUNG AND SUPPORTED FROM THE SLAB ABOVE. PROVIDE LETTER TO BE INCLUDED AS PART OF CLOSE-OUT DOCUMENT SUBMITTAL PACKAGE.
 - RE-LAMP EXISTING AND RELOCATED LUMINAIRES DUE TO BURNOUT CONDITIONS AND REPLACE FAULTY BALLASTS AS REQUIRED. INCLUDE IN BASE PRICE.
 - MEASURE THE ILLUMINATION OF THE FLOOR AT NIGHT WITH EMERGENCY LIGHTING ON ONLY. AND SEND A DRAWING SHOWING THE MAXIMUM AND MINIMUM LEVEL OF ILLUMINATION. TO THE CONSULTING ENGINEER. FOR REVIEW. PROVIDE WRITTEN CONFIRMATION THAT EMERGENCY LIGHTING HAS BEEN INSTALLED IN ACCORDANCE WITH CONTRACT DOCUMENTS AND LATEST EDITION OF THE ONTARIO BUILDING CODE SECTIONS 3.2.7.3 AND 3.2.7.4. LETTER TO BE INCLUDED AS PART OF CLOSE-OUT DOCUMENT SUBMITTAL PACKAGE.
 - PROVIDE NEW PICTOGRAM (RUNNING MAN) TYPE EXIT SIGNS, FACES AND INDICATOR ARROWS AS PER DRAWINGS AND UNIVERSAL 120-347-AC. CONNECT NEW EXIT SIGNS TO THE EXIT LIGHTING CIRCUIT SERVING THIS AREA. DO NOT OVERLOAD THE CIRCUIT. ALLOW FOR FIVE (5) ADDITIONAL EXIT SIGNS PER FLOOR (COMPLETE WITH MATERIAL AND LABOUR) TO BE INSTALLED AS PER BUILDING INSPECTORS REQUIREMENTS UPON FINAL INSPECTION.
 - LOCATE AND POSITION EXIT SIGNS SUCH THAT THEY DO NOT INTERFERE WITH ADJACENT EXIT SIGNS AND EMERGENCY LIGHTING COVERAGE.
 - ENSURE THAT ALL LIGHTING FIXTURES ARE CLEAN AND ILLUMINATED BY END OF PROJECT.
 - LIGHTING FIXTURES IDENTIFIED AS EMERGENCY ARE TO BE CONNECTED SO THAT UNDER NORMAL CONDITIONS THEY WORK IN CONJUNCTION WITH THE SWITCHING AS IDENTIFIED. IN THE EVENT OF AN EMERGENCY, THESE LIGHTS ARE TO BE FORCED ON WITH THE USE OF A UL-624 LISTED RELAY. (UPON POWER FAILURE THE RELAY IS TO ACTIVATE THE LIGHTS TO FULL BRIGHTNESS).
 - REMOVE ALL PAGING/AUDIO SPEAKERS IN RENOVATED AREA NOT SHOWN ON PLANS. ALL EXISTING TO REMAIN SPEAKERS TO BE FIRE ALARM/IVAC SPEAKERS ONLY.
 - ALL CEILING MOUNTED OCCUPANCY SENSORS PROVIDED AS PART OF THIS SCOPE OF WORK MUST BE LOCATED AT LEAST 5' FROM ANY SUPPLY AIR DIFFUSER AND RETURN AIR GRILLE AS PER MANUFACTURER'S RECOMMENDATION. COORDINATE INSTALLATION ON SITE WITH MECHANICAL CONTRACTOR PRIOR TO COMMENCING WORK.
 - COORDINATE ALL WORK TO SUIT PROJECT PHASE SCHEDULE. COORDINATE PHASING WITH ARCHITECT/INTERIOR DESIGNER. DRAWINGS. PHASING SHOWN IS FOR REFERENCE PURPOSES ONLY.

DRAWING NOTES:

(Hatched Area) WALLS SHOWN IN THE HATCHED AREA ARE FOR REFERENCE ONLY. SPACE WILL BE IN SHELL CONDITION.

KEY PLAN:

REVISION

NO.	DATE	DESCRIPTION
1	2024-03-04	ISSUED FOR 50%
2	2024-11-15	PERMIT
3	2024-12-24	ISSUED FOR P&S REVIEW
4	2024-12-23	ISSUED FOR P&S REVIEW
5	2025-01-24	ISSUED FOR P&S REVIEW
6	2025-01-31	ISSUED FOR BID
10	2025-03-25	BID ADDENDUM #04

OWNER

UNIVERSITY OF TORONTO

PROJECT:

HEALTH AND WELLNESS CENTRE RENOVATION AT KOFFLER

214 COLLEGE ST.
TORONTO, ON M5T 3A1

SHEET CONTENTS:

LEVEL 03 - LIGHTING PLAN

PROJECT NUMBER:
21590.003

DRAWING SCALE:
1 : 100

DRAWN BY:
Author

CHECKED BY:
Checker

DATE:
Issue Date

SHEET NO.:
E403

REV:
10


AREA	ROOM #	OCCUPANCY SENSOR	ON/OFF	LOCAL CONTROL	NOTES
CURTAINAL ROOMS/STORAGE		WALL	AUTO ON/AUTO OFF	[SWITCH, WALL STATION, DIMMER]	
WASHROOMS		CEILING	AUTO ON/AUTO OFF		LIGHTING ON EM CCT
BE WASHROOM & SHOWER	399A			TOGGLE SWITCH	LIGHTING ON EM CCT
ELECTRICAL CLOSET/ROOMS				TOGGLE SWITCH	LIGHTING ON EM CCT
IT CLOSET				TOGGLE SWITCH	LIGHTING ON EM CCT
LOBBY	360V	CEILING	AUTO ON/AUTO OFF		DM TO 50% BASED ON OCCUPANCY
CONSULTING/EXAM ROOMS		CEILING	MANUAL ON/AUTO OFF	DIMMER (L3) SWITCH (L4)	OCCUPANCY SENSOR TO CONTROL ALL LIGHTS IN ROOM. NOT ALL ROOMS HAVE ALL LIGHTING TYPES.
ELEVATOR ACCESS		CEILING	AUTO ON/AUTO OFF		DM TO 50% BASED ON OCCUPANCY
ELEVATOR VESTIBULE	355V	CEILING	AUTO ON/AUTO OFF		DM TO 50% BASED ON OCCUPANCY
STAFF CORRIDOR	352K			DIMMER	
LOUNGE	357	CEILING	AUTO ON/AUTO OFF	DIMMER	DM TO 50% BASED ON OCCUPANCY
PUBLIC CORRIDOR	350A			DIMMER	
CORRIDOR	340K			DIMMER	
SUB-WAITING AREA	344,352	CEILING	AUTO ON/AUTO OFF		
SUB-WAITING AREA	357			DIMMER	
ENT CORRIDOR	357K			DIMMER	
WAITING AREA	360			DIMMER	
CORRIDOR	370K	CEILING	AUTO ON/AUTO OFF	DIMMER	DM TO 50% BASED ON OCCUPANCY
VACCINE SEATING AREA	377			DIMMER	
CORRIDOR	397K			DIMMER	

MEETING/LUNCH	396	CEILING (FIXTURES TO BE ON/OFF TOGETHER)	AUTO ON/AUTO OFF	DIMMER	AUTO ON TO 50%
LOCKERS	399				
MEETING/LUNCH (A FIXTURE)	396		MANUAL ON/AUTO OFF	WALL SWITCH	UNDER CABINET LIGHT

NOTE:
1. UNLESS NOTED OTHERWISE, ALL SENSORS TO BE SET TO 20 MINUTE OFF DELAY.
2. MULTIPLE ZONE ZONES CONTROLLED BY CEILING SENSORS SHALL BE ON/OFF TOGETHER WITH LOCAL CONTROL (AS SHOWN).
3. PROVIDE SHUNT TRIP RELAY AS REQUIRED FOR ROOMS WITH TOGGLE SWITCH CONTROLS AND EM LIGHTING CIRCUIT.

SCENE	LEVEL
35	1 100
	2 75
	3 50
55	1 100
	2 75
	3 50
	4 25
	5 25

FINAL LEVELS TO BE CONFIRMED WITH CLIENT DURING SYSTEM COMMISSIONING

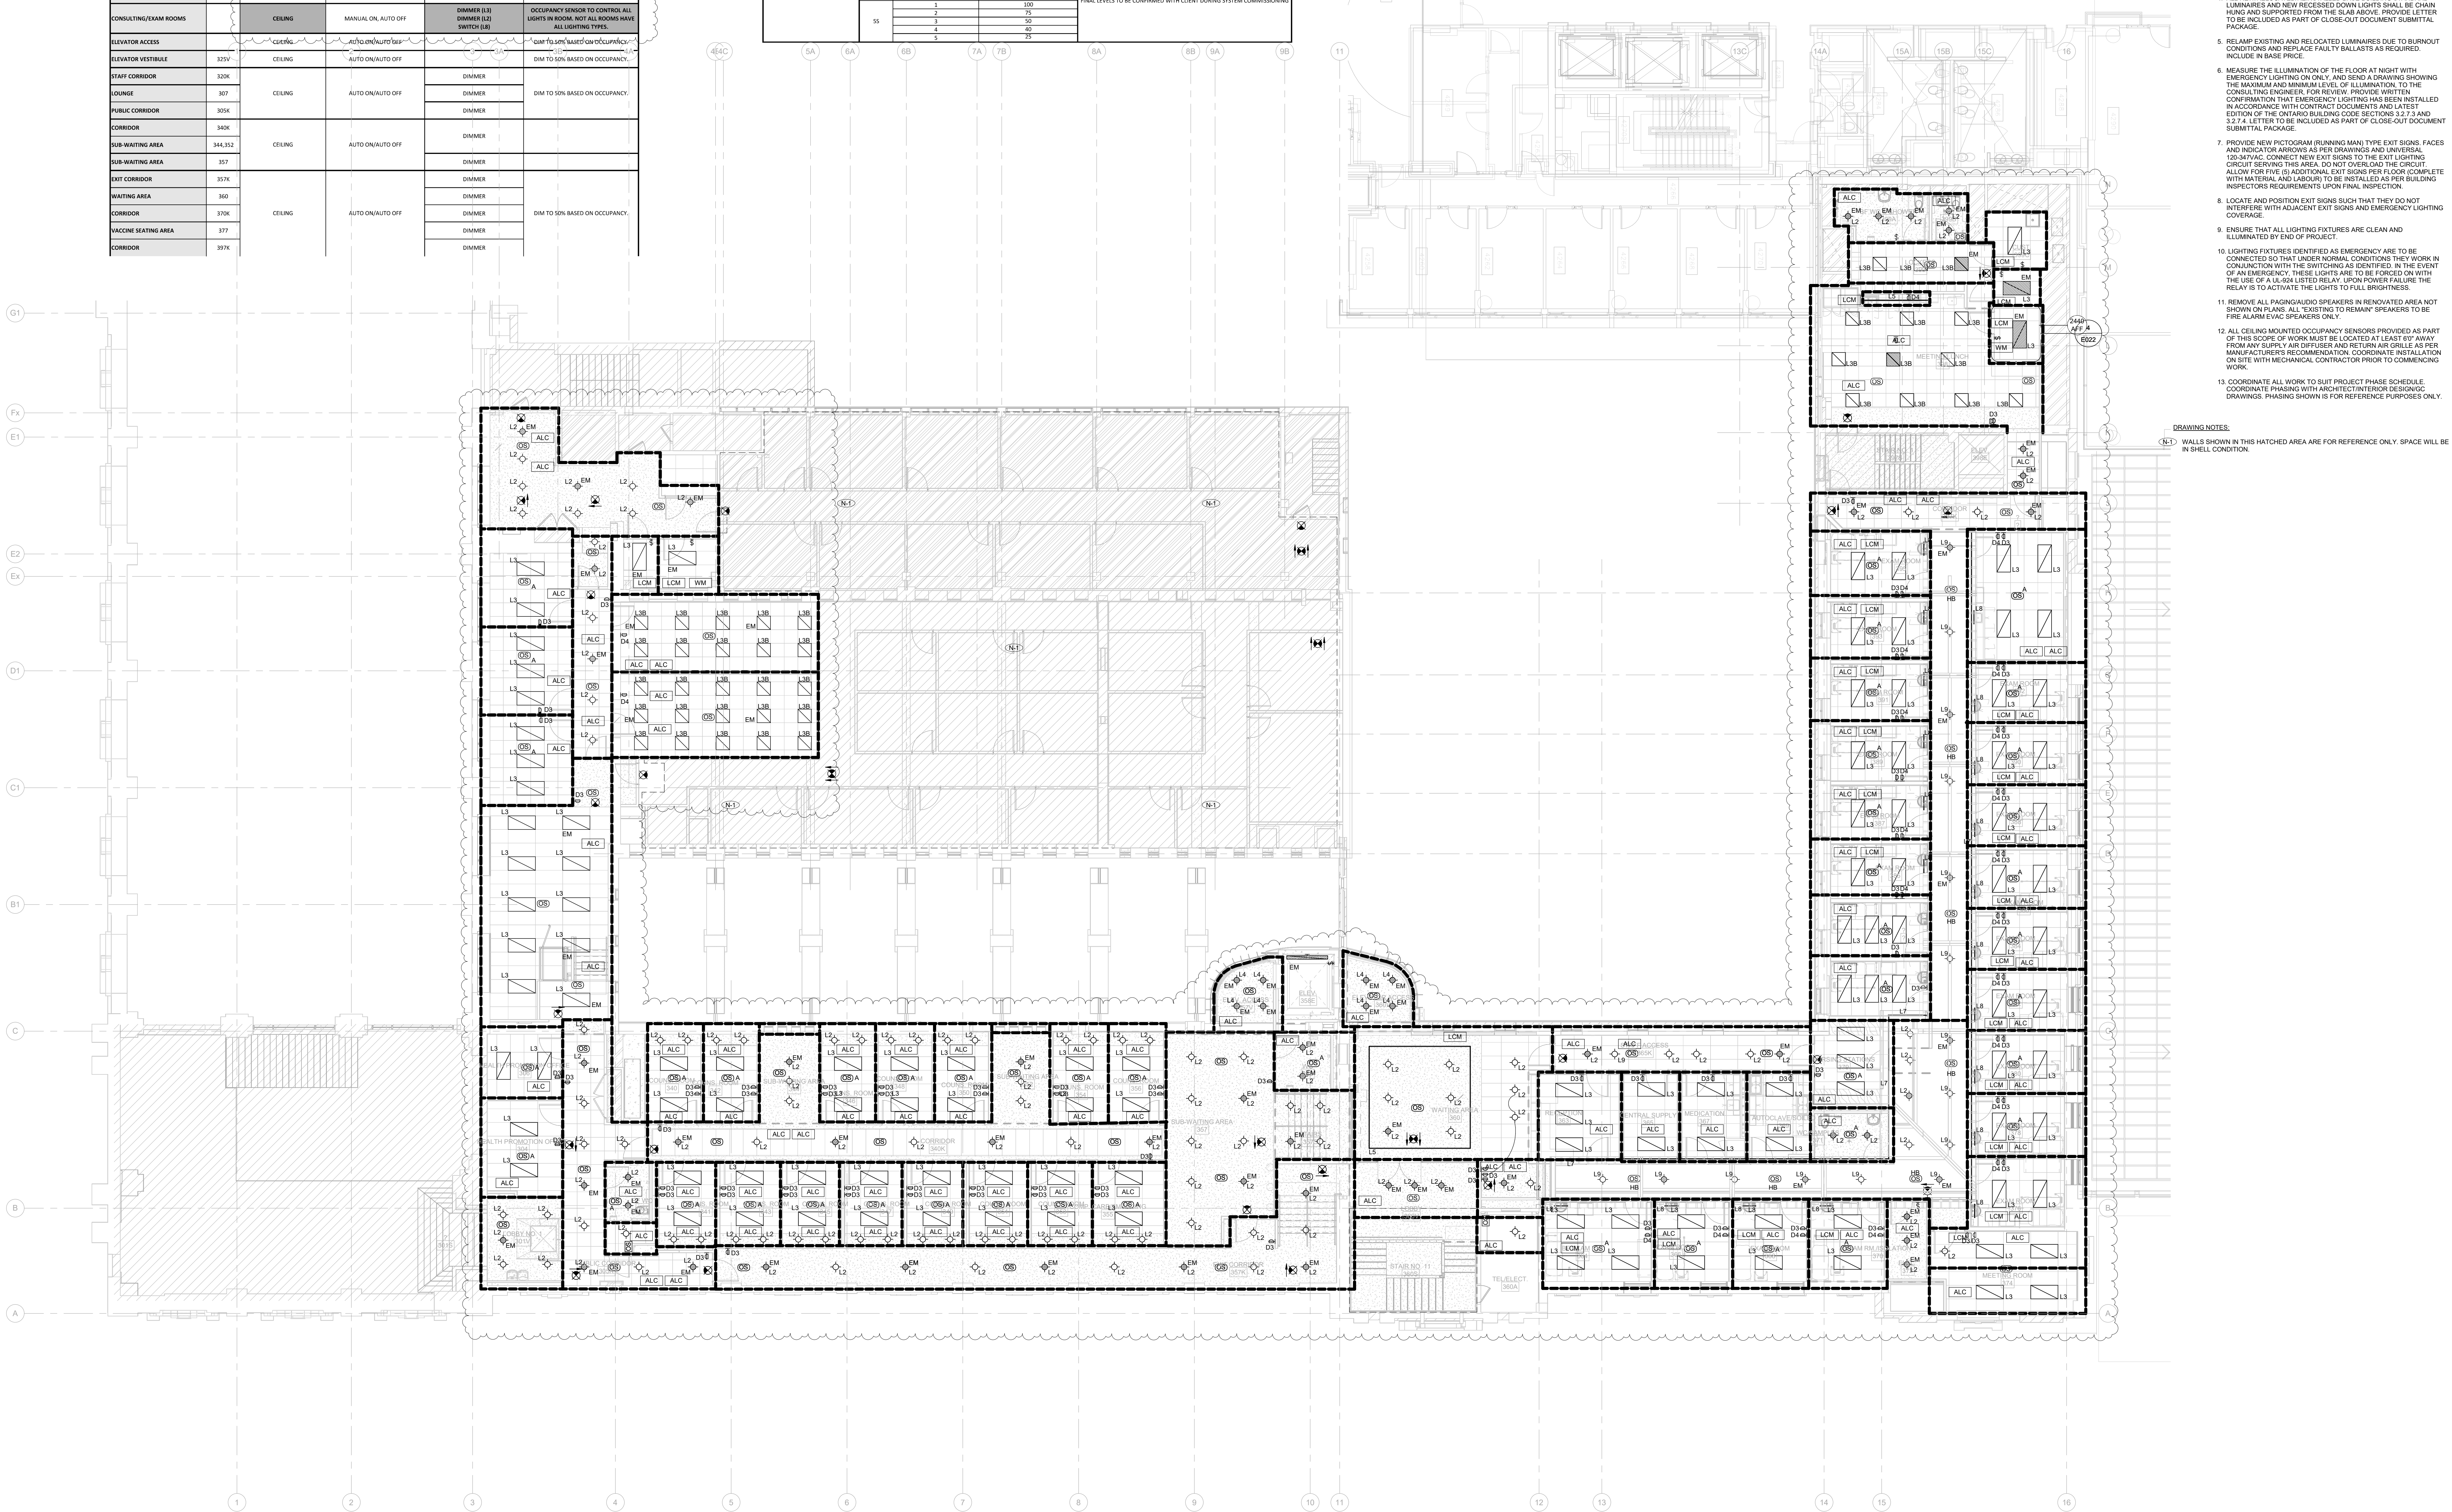

- GENERAL NOTES:
- THESE DRAWINGS SHALL BE READ IN CONJUNCTION WITH INTERIOR DESIGNER/ARCHITECT'S DRAWINGS FOR DIMENSIONS, HEIGHTS, CONSTRUCTION DETAILING, FINISHES AND COLOURS.
 - CIRCUITING IN PART IS DIAGRAMMATIC INTENDED TO SHOW GENERAL CIRCUIT ARRANGEMENT AND PANEL DESIGNATION.
 - PROVIDE EMT CONDUIT IN AREAS WITH EXPOSED CEILINGS. EX. CABLES ARE NOT ACCEPTABLE UNLESS OTHERWISE NOTED. EX. CABLES MAY BE USED FOR FINAL CONNECTIONS TO LIGHTING. ARCHITECTURAL DIMENSIONS MOUNT EXIT SIGNS, OCCUPANCY SENSORS, EXIT SIGNS, CAMERAS, WAPS AND ALL OTHER CEILING MOUNTED DEVICES WITHIN 200MM OF THE CEILING. PROVIDE LETTER TO BE INCLUDED AS PART OF CLOSE-OUT DOCUMENT SUBMITTAL PACKAGE.
 - ALL NEW/RELOCATED/REINSTALLED BASE BUILDING STANDARD LUMINAIRES AND NEW RECESSED DOWN LIGHTS SHALL BE CHAIN HUNG AND SUPPORTED FROM THE SLAB ABOVE. PROVIDE LETTER TO BE INCLUDED AS PART OF CLOSE-OUT DOCUMENT SUBMITTAL PACKAGE.
 - RELAMP EXISTING AND RELOCATED LUMINAIRES DUE TO BURNOUT CONDITIONS AND REPLACE FAULTY BALLASTS AS REQUIRED. INCLUDE IN BASE PRICE.
 - MEASURE THE ILLUMINATION OF THE FLOOR AT NIGHT WITH EMERGENCY LIGHTING ON ONLY. AND SEND A DRAWING SHOWING THE MAXIMUM AND MINIMUM LEVEL OF ILLUMINATION. TO THE CONSULTING ENGINEER. FOR REVIEW. PROVIDE WRITTEN CONFIRMATION THAT EMERGENCY LIGHTING HAS BEEN INSTALLED IN ACCORDANCE WITH CONTRACT DOCUMENTS AND LATEST EDITION OF THE ONTARIO BUILDING CODE SECTIONS 3.2.7.3 AND 3.2.1.4. LETTER TO BE INCLUDED AS PART OF CLOSE-OUT DOCUMENT SUBMITTAL PACKAGE.
 - PROVIDE NEW PICTOGRAM (RUNNING MAN) TYPE EXIT SIGNS, FACES AND INDICATOR ARROWS AS PER DRAWINGS AND UNIVERSAL 120-347-AC. CONNECT NEW EXIT SIGNS TO THE EXIT LIGHTING CIRCUIT SERVING THIS AREA. DO NOT OVERLOAD THE CIRCUIT. ALLOW FOR FIVE (5) ADDITIONAL EXIT SIGNS PER FLOOR (COMPLETE WITH MATERIAL AND LABOUR) TO BE INSTALLED AS PER BUILDING INSPECTORS REQUIREMENTS UPON FINAL INSPECTION.
 - LOCATE AND POSITION EXIT SIGNS SUCH THAT THEY DO NOT INTERFERE WITH ADJACENT EXIT SIGNS AND EMERGENCY LIGHTING COVERAGE.
 - ENSURE THAT ALL LIGHTING FIXTURES ARE CLEAN AND ILLUMINATED BY END OF PROJECT.
 - LIGHTING FIXTURES IDENTIFIED AS EMERGENCY ARE TO BE CONNECTED SO THAT UNDER NORMAL CONDITIONS THEY WORK IN CONJUNCTION WITH THE SWITCHING AS IDENTIFIED. IN THE EVENT OF AN EMERGENCY, THESE LIGHTS ARE TO BE FORCED ON WITH THE USE OF A UL624 LISTED RELAY. (UPON POWER FAILURE THE RELAY IS TO ACTIVATE THE LIGHTS TO FULL BRIGHTNESS).
 - REMOVE ALL PAGING/AUDIO SPEAKERS IN RENOVATED AREA NOT SHOWN ON PLANS. ALL EXISTING TO REMAIN SPEAKERS TO BE FIRE ALARM EVAC SPEAKERS ONLY.
 - ALL CEILING MOUNTED OCCUPANCY SENSORS PROVIDED AS PART OF THIS SCOPE OF WORK MUST BE LOCATED AT LEAST 8' AWAY FROM ANY SUPPLY AIR DIFFUSER AND RETURN AIR GRILLE AS PER MANUFACTURER'S RECOMMENDATION. COORDINATE INSTALLATION ON SITE WITH MECHANICAL CONTRACTOR PRIOR TO COMMENCING WORK.
 - COORDINATE ALL WORK TO SUIT PROJECT PHASE SCHEDULE. COORDINATE PHASING WITH ARCHITECT/INTERIOR DESIGNER. DRAWINGS. PHASING SHOWN IS FOR REFERENCE PURPOSES ONLY.

DRAWING NOTES:
(Hatched) WALLS SHOWN IN THE HATCHED AREA ARE FOR REFERENCE ONLY. SPACE WILL BE IN SHELL CONDITION.

KEY PLAN:

NORTH

REVISION	
NO.	DATE
1	2024-10-04
2	2024-11-15
3	2024-12-04
4	2024-12-23
5	2025-01-24
6	2025-01-31
7	2025-03-21
8	2025-03-28

DESCRIPTION	
1	ISSUED FOR 50%
2	PERMIT
3	ISSUED FOR P&S REVIEW
4	ISSUED FOR P&S REVIEW
5	ISSUED FOR P&S REVIEW
6	ISSUED FOR BID
7	BID ADDENDUM #03
8	BID ADDENDUM #04

Smith + Andersen
1100 - 109 Sheppard Ave East, Toronto, ON, M2N 6N6
416-467-8153 smithandandersen.com

ENFORM
architects

ENFORM Architects Inc.
1284 Sheppard Road, Suite 302B
Toronto, Ontario, Canada M8R 2B7
416-546-7523
www.enformarchitects.com

SEAL:

OWNER:

UNIVERSITY OF
TORONTO

PROJECT:
HEALTH AND WELLNESS
CENTRE RENOVATION AT
KOFFLER

214 COLLEGE ST.
TORONTO, ON M5T 3A1

SHEET CONTENTS:
LEVEL 03 - LIGHTING CONTROL
PLAN

PROJECT NUMBER:
21590.003
DRAWING SCALE:
1 : 100
DRAWN BY:
Author
CHECKED BY:
Checker
DATE:
Issue Date
REV:

SHEET NO.:
E403-A

10

ADDENDUM

PROJECT NAME: Health And Wellness Centre Renovation at Koffler

COMPANY: Enform

ATTENTION: Alan Fraser

PROJECT NO.: 21590.003.D.001

DATE: 2025-03-25

ADDENDUM NO.: ADD-D-04

ISSUED BY: Joshua Blizzard

The following amendments are hereby made as part of the Contract Documents. The following revisions and/or additions shall be made to contract documents and the cost shall be included in the Tender Price.

1.0 DRAWINGS

1.1 Refer to Drawing TC-0.0 – Cover Page (**included herein**)

1.1.1 Replace entire drawing with one attached.

1.2 Refer to Drawing TC-0.1 – Drawing List, General Notes, Abbreviations, Legends, and Details (**included herein**)

1.2.1 Replace entire drawing with one attached.

1.3 Refer to Drawing TC-0.2 – Communications Telecom Rooms Details (**included herein**)

1.3.1 Replace entire drawing with one attached.

1.4 Refer to Drawing TC-0.3 – Communications Riser Diagram (**included herein**)

1.4.1 Replace entire drawing with one attached.

1.5 Refer to Drawing TC-B1.1 – Basement Level Communications Layout (**included herein**)

1.5.1 Replace entire drawing with one attached.

1.6 Refer to Drawing TC-1.1 – 1st Floor Communications Layout (**included herein**)

1.6.1 Replace entire drawing with one attached.

1.7 Refer to Drawing TC-1.2 – 1st Floor Wireless Access Point Plan (**included herein**)

1.7.1 Replace entire drawing with one attached.

1.8 Refer to Drawing TC-1M.1 – Upper Mezzanine Communications Layout (**included herein**)

1.8.1 Replace entire drawing with one attached.




- 1.9 Refer to Drawing TC-2.1 – 2nd Floor Communications Layout (included herein)**
 - 1.9.1 Replace entire drawing with one attached.
- 1.10 Refer to Drawing TC-2.2 – 2nd Floor Wireless Access Points Plan (included herein)**
 - 1.10.1 Replace entire drawing with one attached.
- 1.11 Refer to Drawing TC-3.1 – 3rd Floor Communications Layout (included herein)**
 - 1.11.1 Replace entire drawing with one attached.
- 1.12 Refer to Drawing TC-3.2 – 3rd Floor Wireless Access Points Plan (included herein)**
 - 1.12.1 Replace entire drawing with one attached.
- 1.13 Refer to Drawing TC-MP.1 – Mechanical Penthouse Communications Layout (included herein)**
 - 1.13.1 Replace entire drawing with one attached.

END OF TELECOMMUNICATIONS ADDENDUM

HEALTH AND WELLNESS CENTRE RENOVATION AT KOFFLER

214 COLLEGE ST, TORONTO, ON M5T 3A1

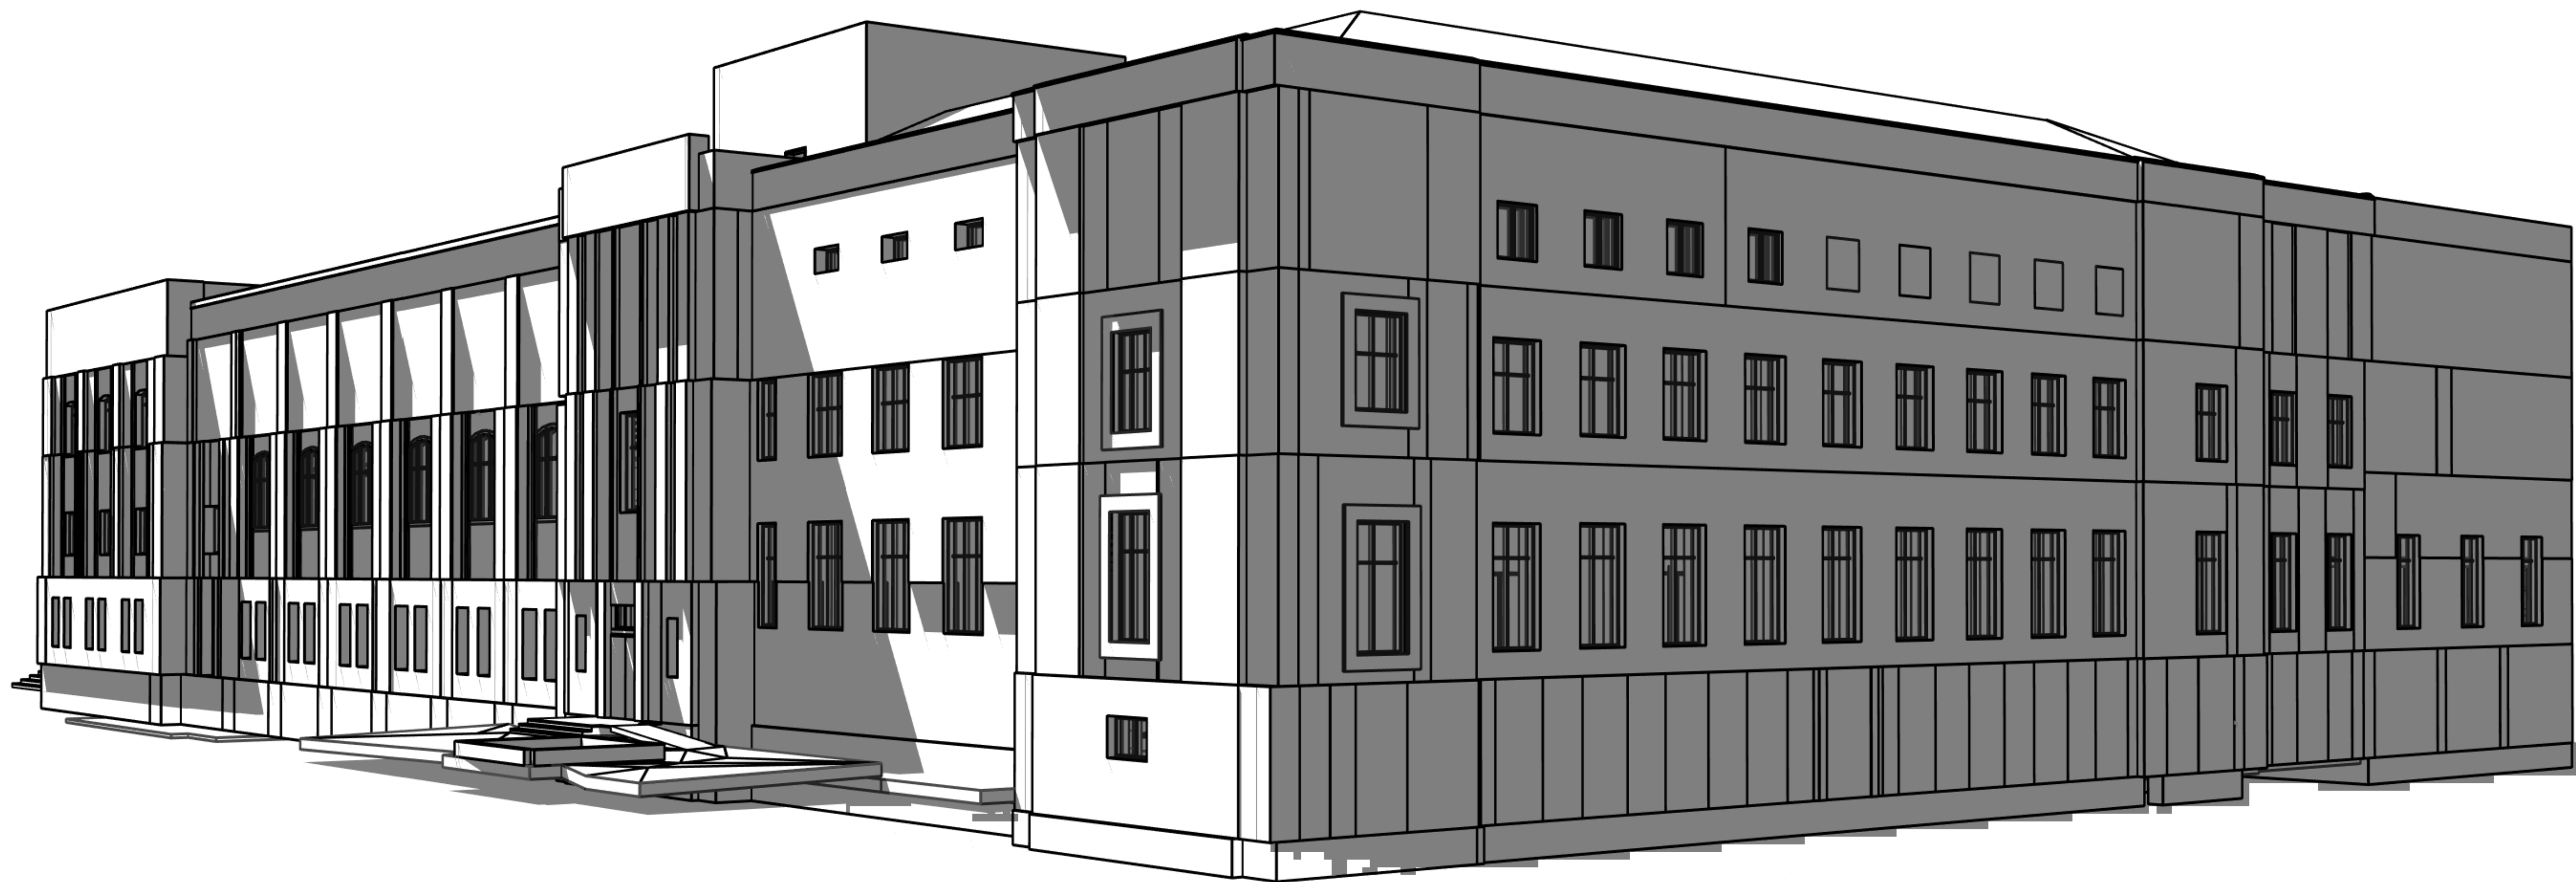

KEY PLAN:

REVISION		
NO.	DATE	DESCRIPTION
1	2024-10-04	ISSUED FOR 50%
3	2024-12-04	ISSUED FOR F&S REVIEW



Smith + Andersen
1100 - 109 Sheppard Ave East, Toronto ON, M2N 0N9
416-467-8151 smithandersen.com

ENFORM
architects

ENFORM Architects Inc.
1284 Sterling Road, Suite 302B
Toronto, Ontario, Canada M6R 2B7
416-548-1723
www.enformarchitects.com

SEAL:



PROJECT:
**HEALTH AND WELLNESS
CENTRE RENOVATION AT
KOFFLER**

214 COLLEGE ST,
TORONTO, ON M5T 3A1

SHEET CONTENTS:
COVER PAGE

PROJECT NUMBER:

21590.003


DRAWING SCALE:

DRAWN BY: CHECKED BY: DATE:

Author Checker Issue Date

SHEET NO. REV:

TC-0.0 **3**

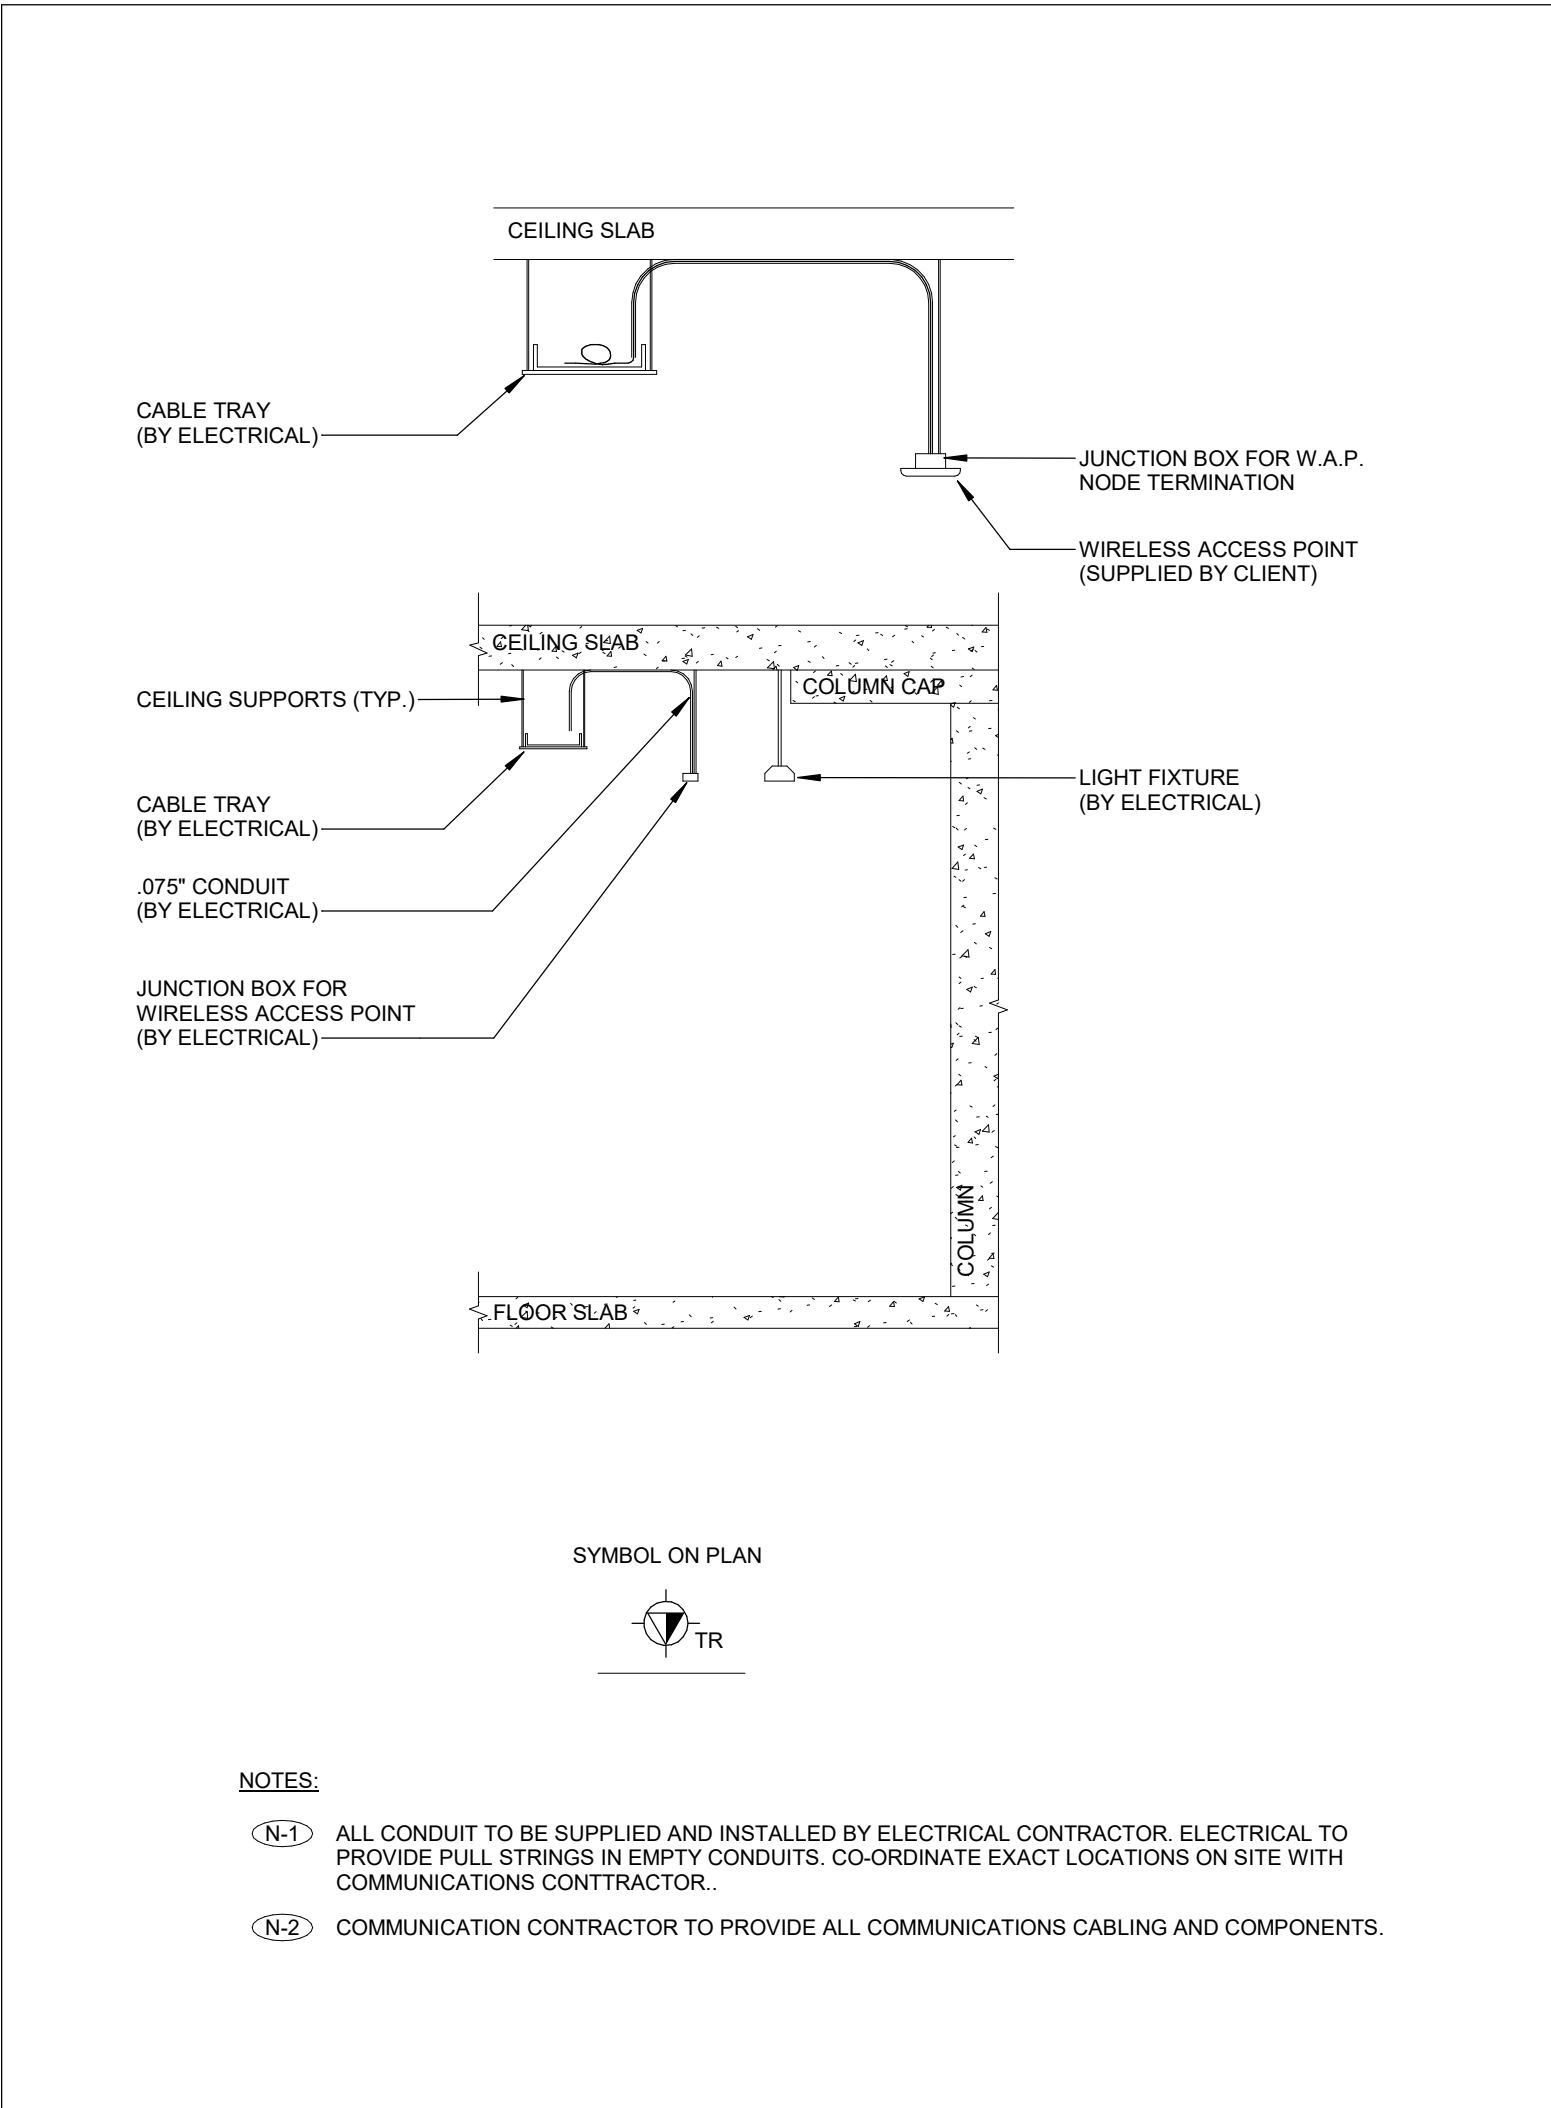


10 WIRELESS ACCESS POINT ROUTING AND TERMINATION DETAIL - CABLE TRAY
TC-0.1 NTS




7 DUAL J-HOOK WITH PROPER COILED
TC-0.1 NTS




10 WIRELESS ACCESS POINT ROUTING AND TERMINATION DETAIL - CABLE TRAY
TC-0.1 NTS

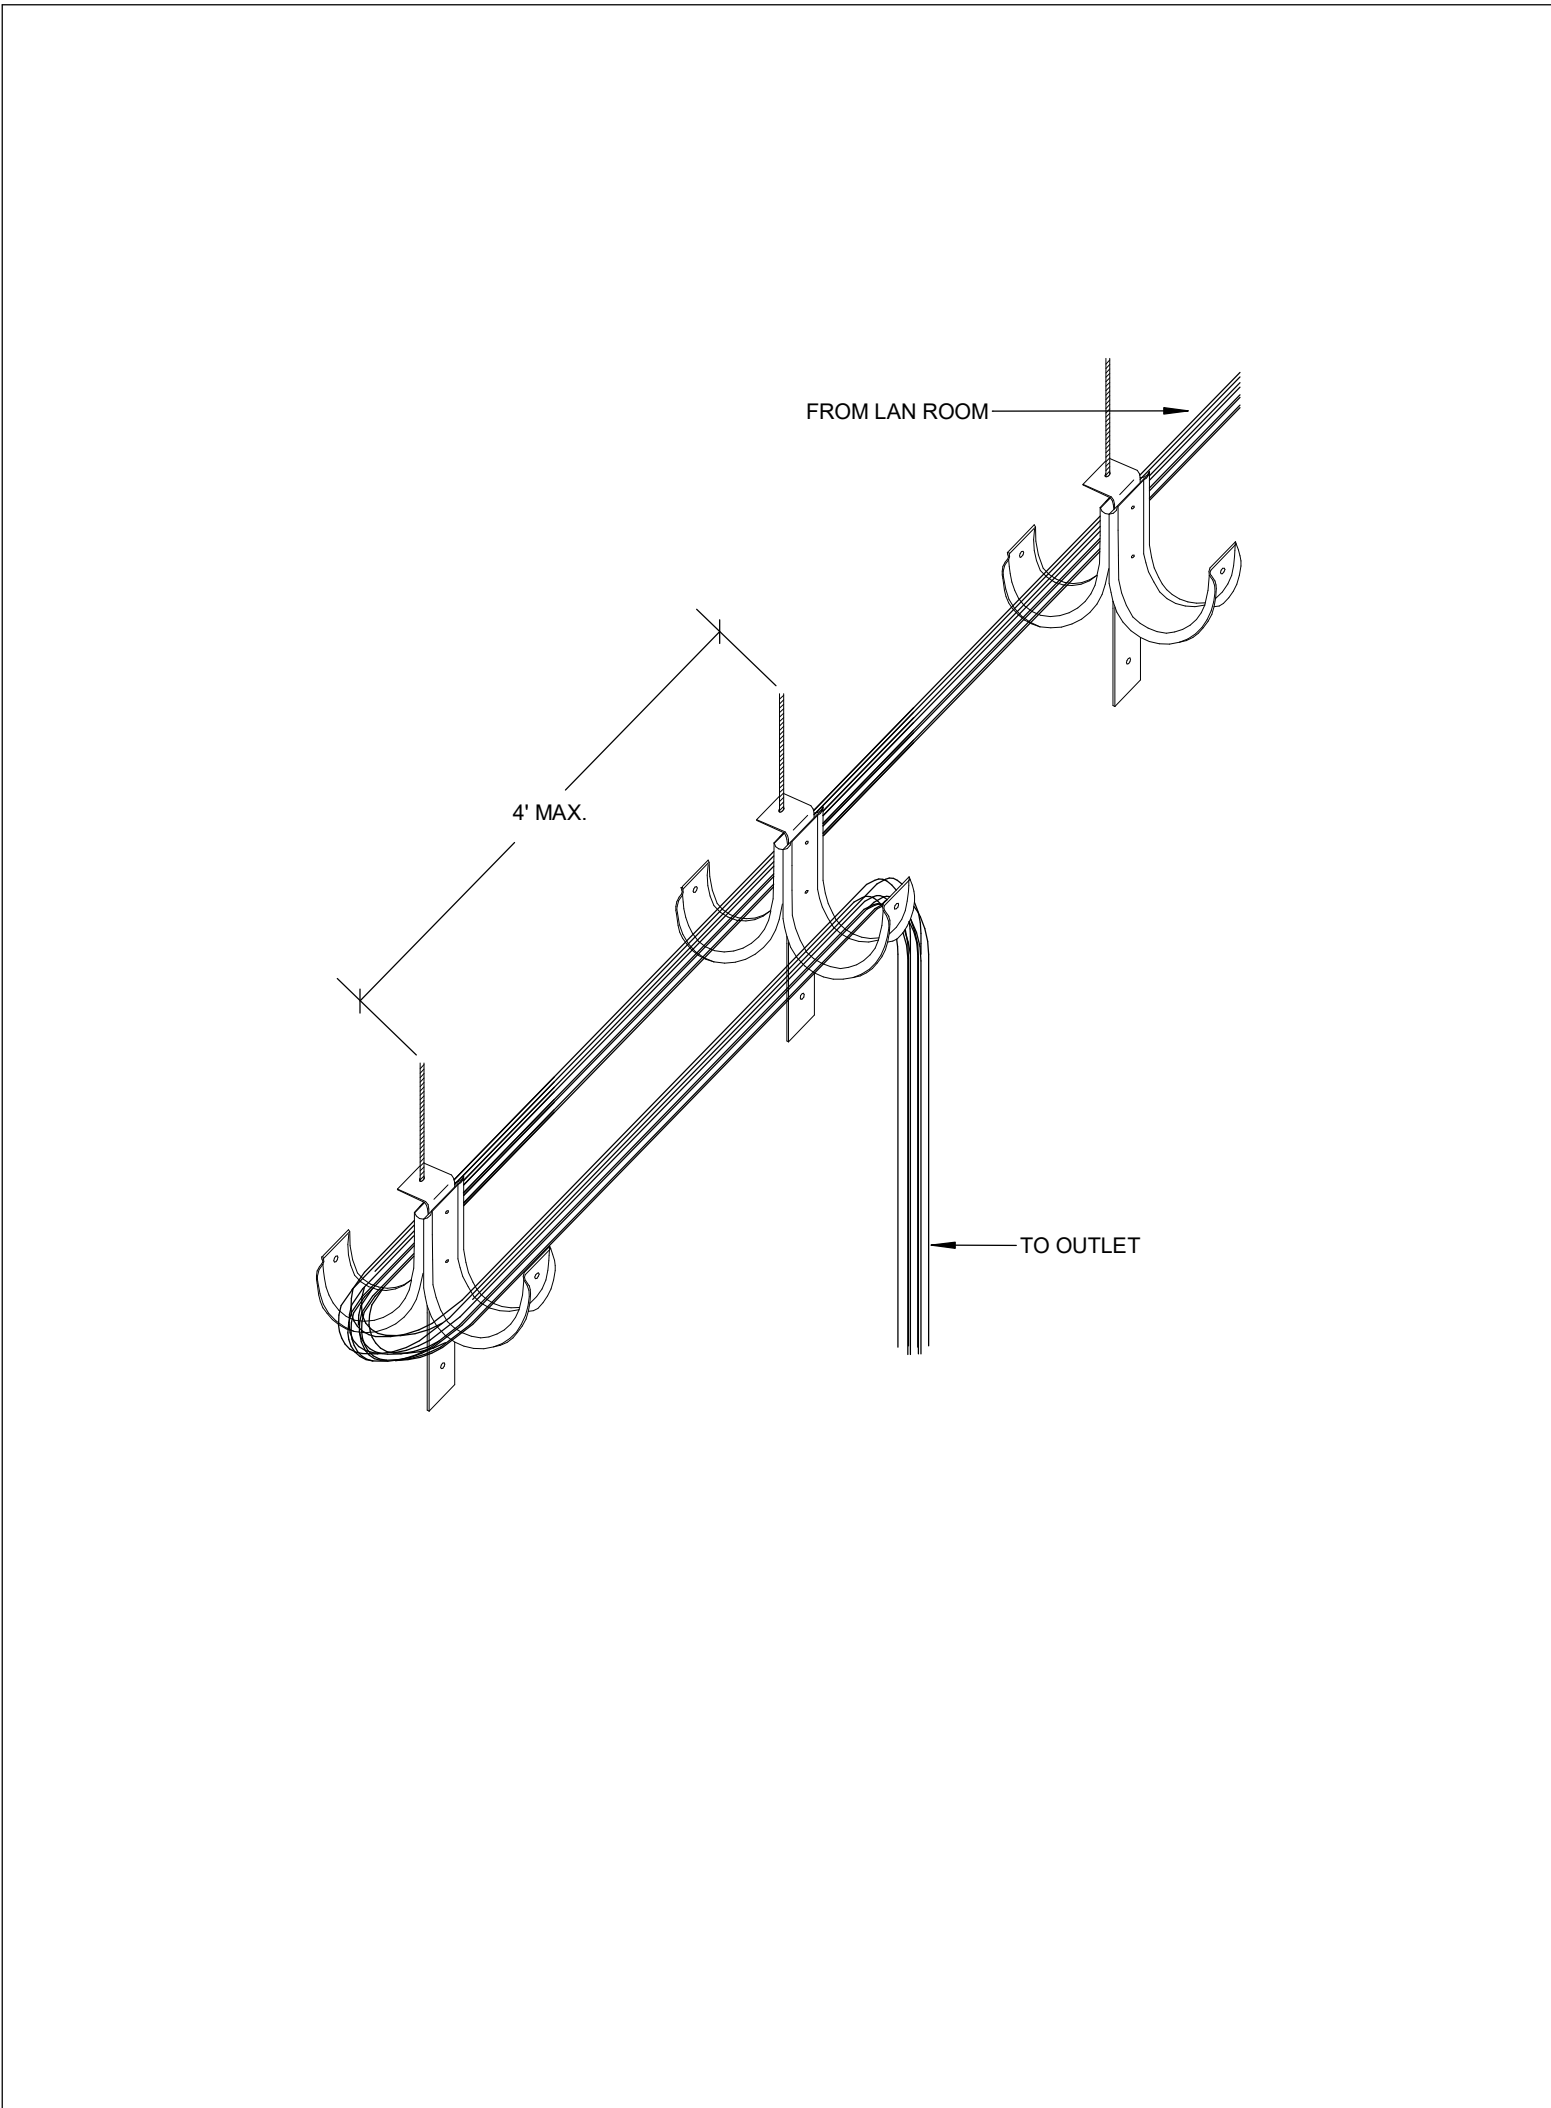


7 DUAL J-HOOK WITH PROPER COILED
TC-0.1 NTS

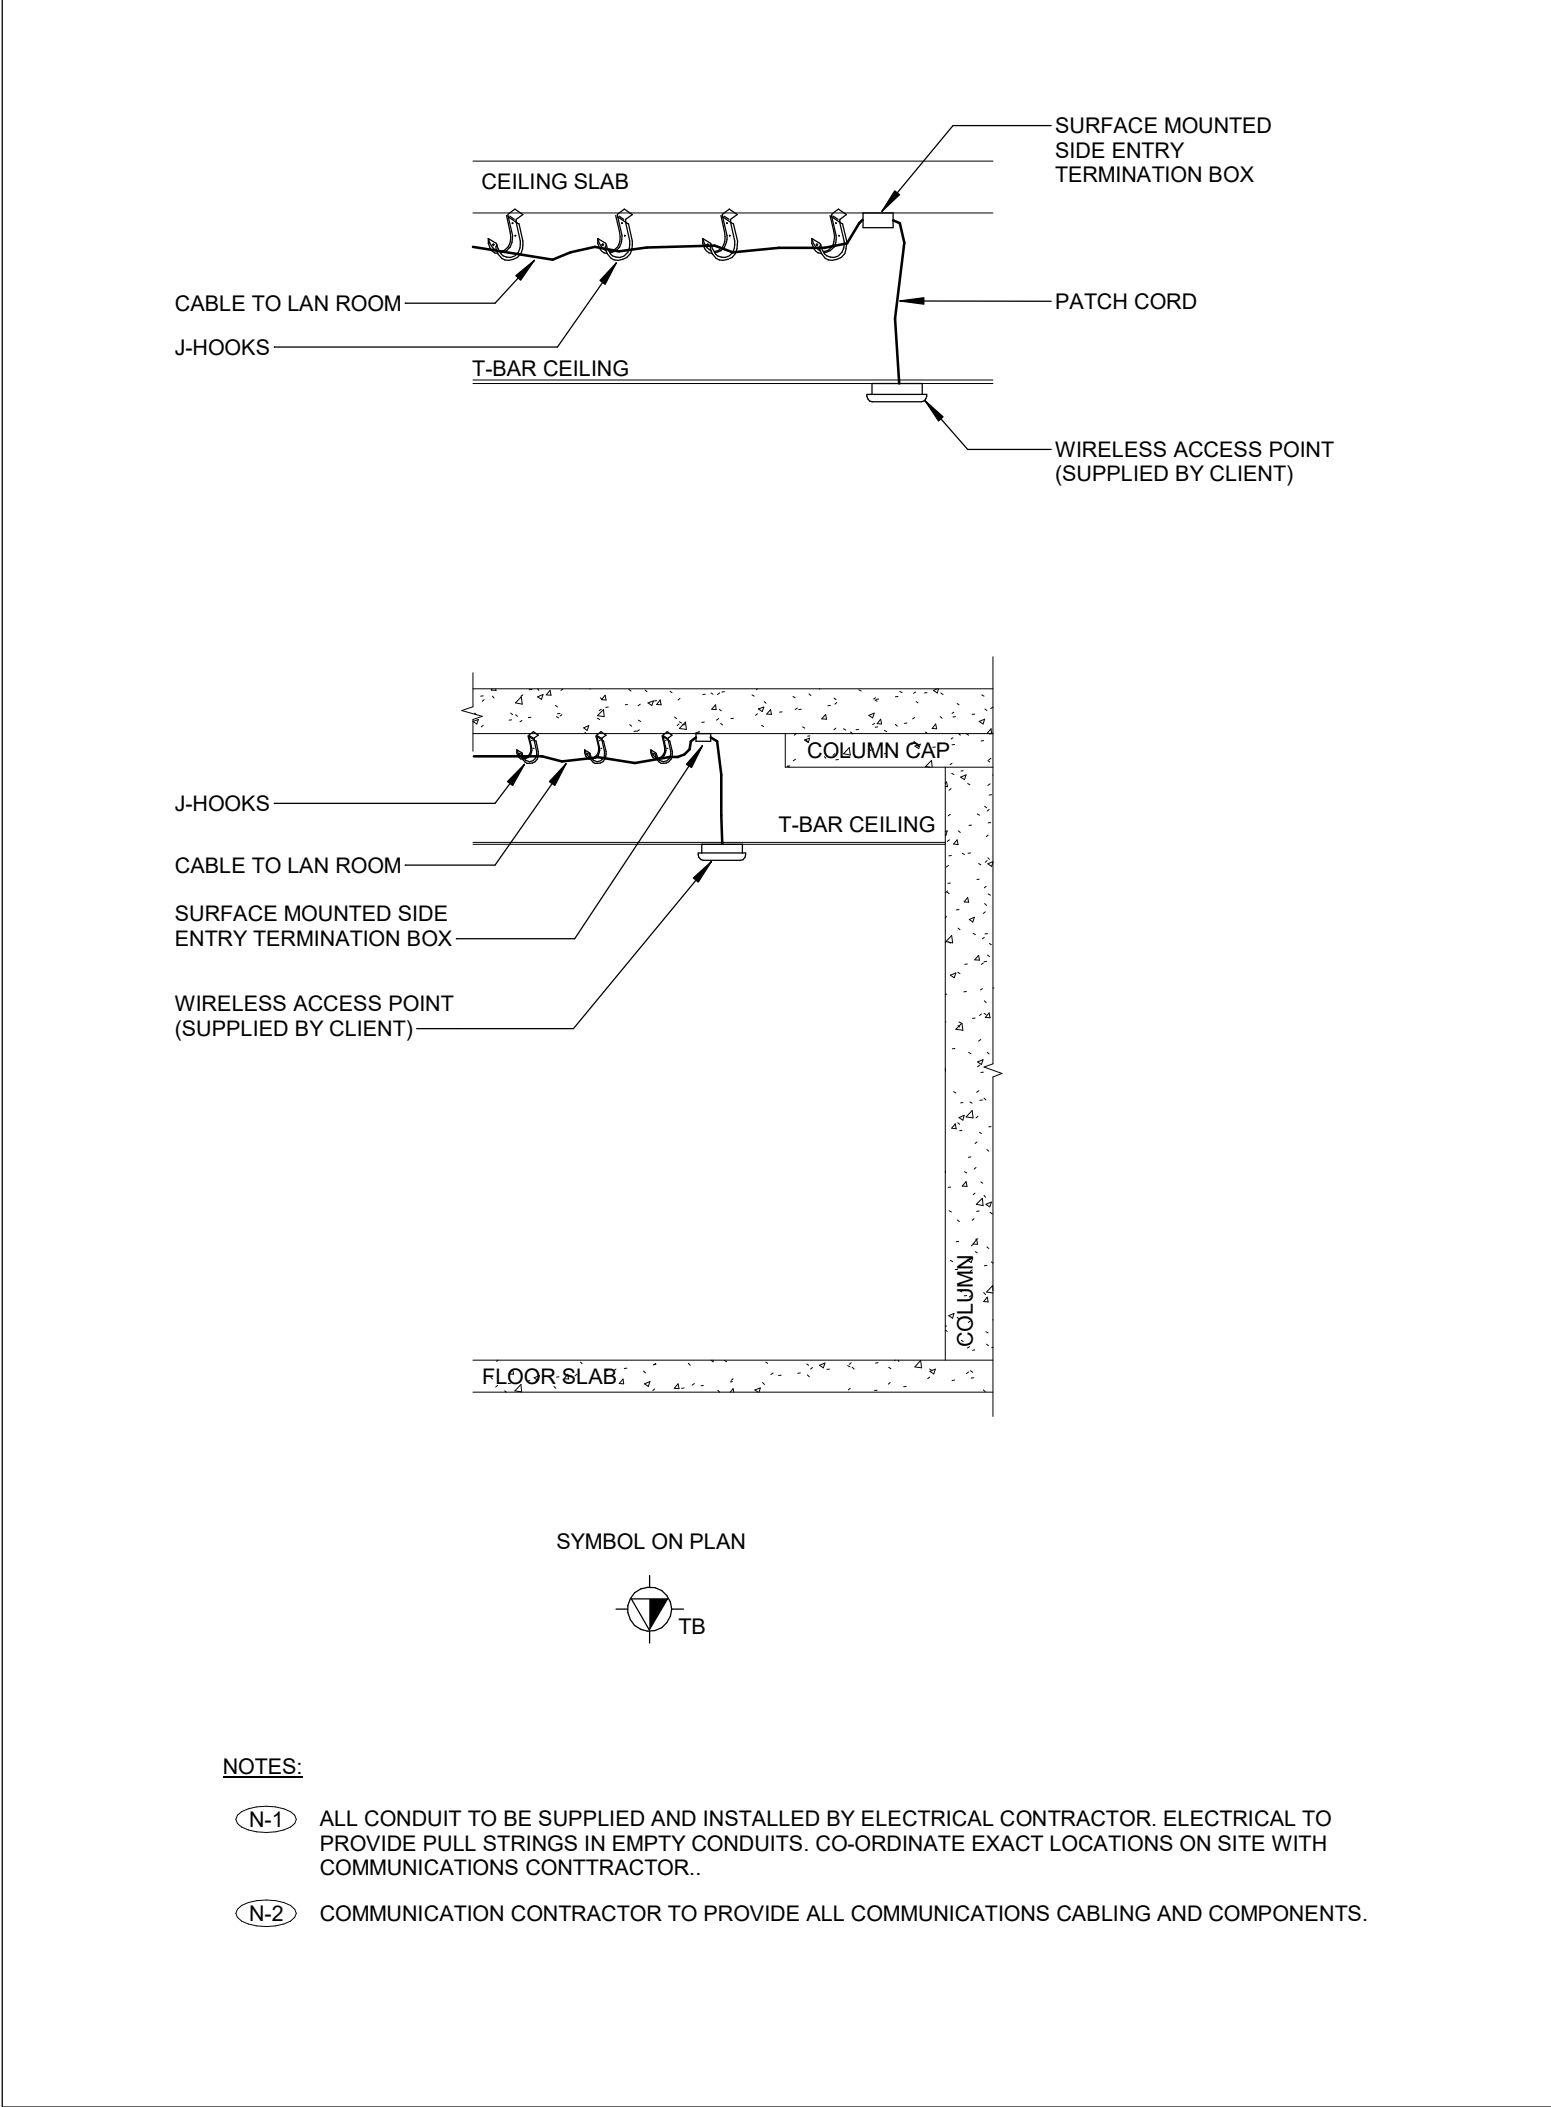


8 WIRELESS ACCESS POINT ROUTING AND TERMINATION DETAIL - ACCESSIBLE CEILING #1
TC-0.1 NTS

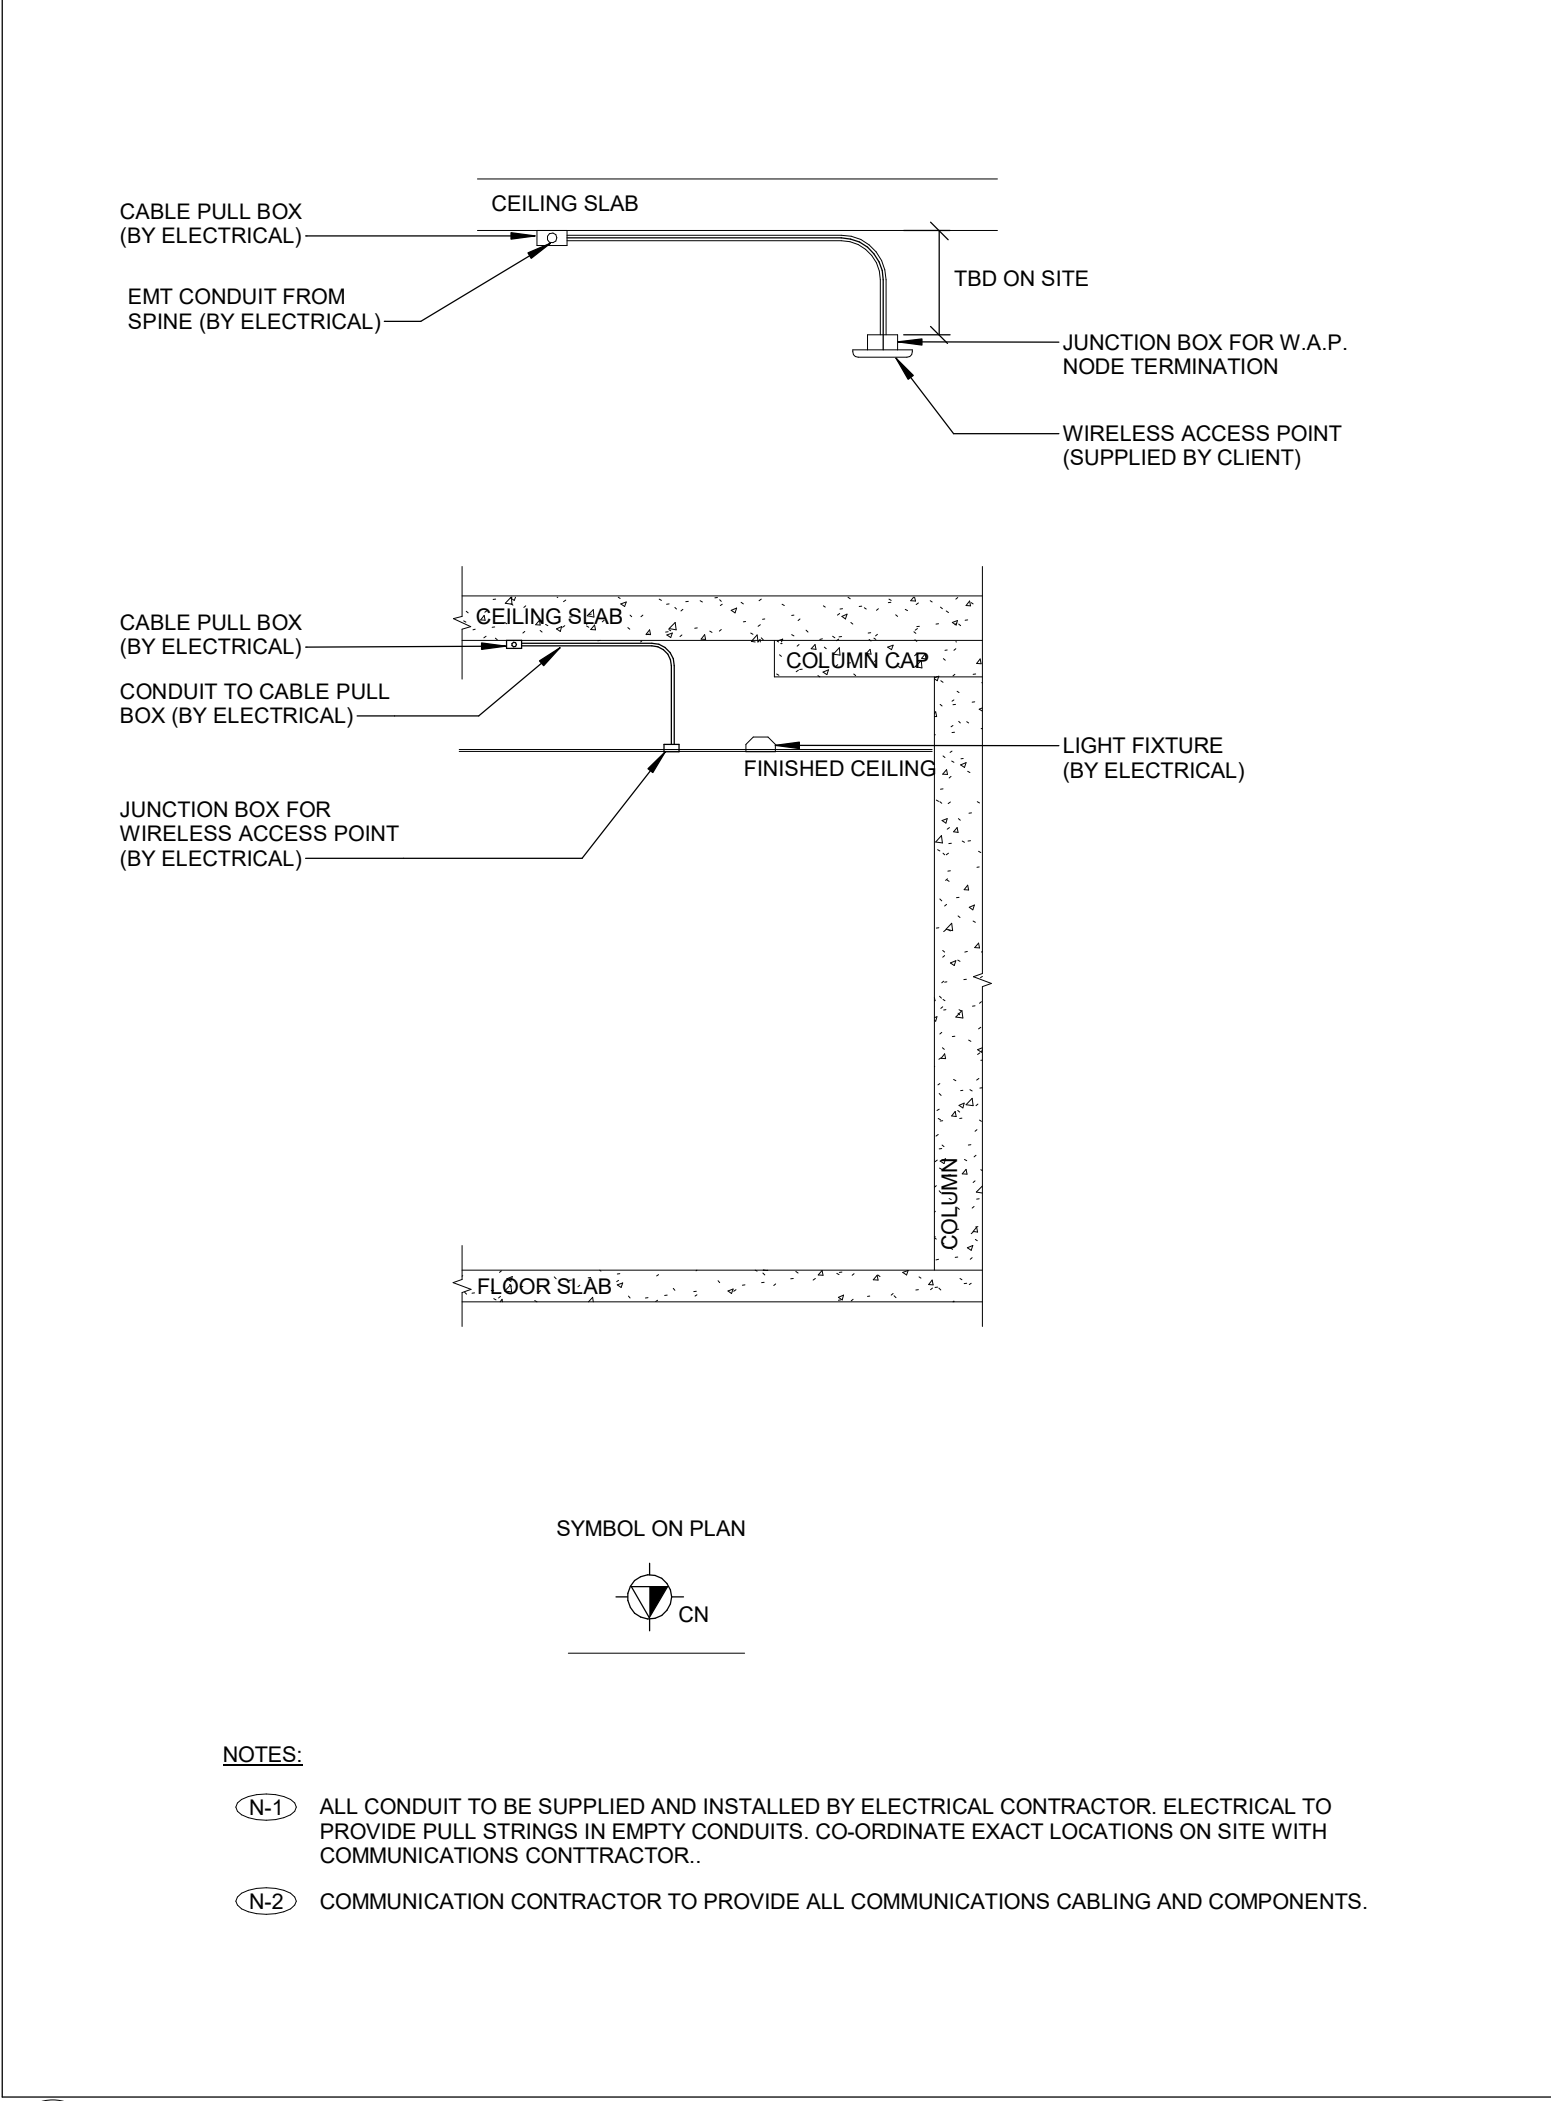


9 WIRELESS ACCESS POINT ROUTING AND TERMINATION DETAIL - CONDUIT SPINE
TC-0.1 NTS

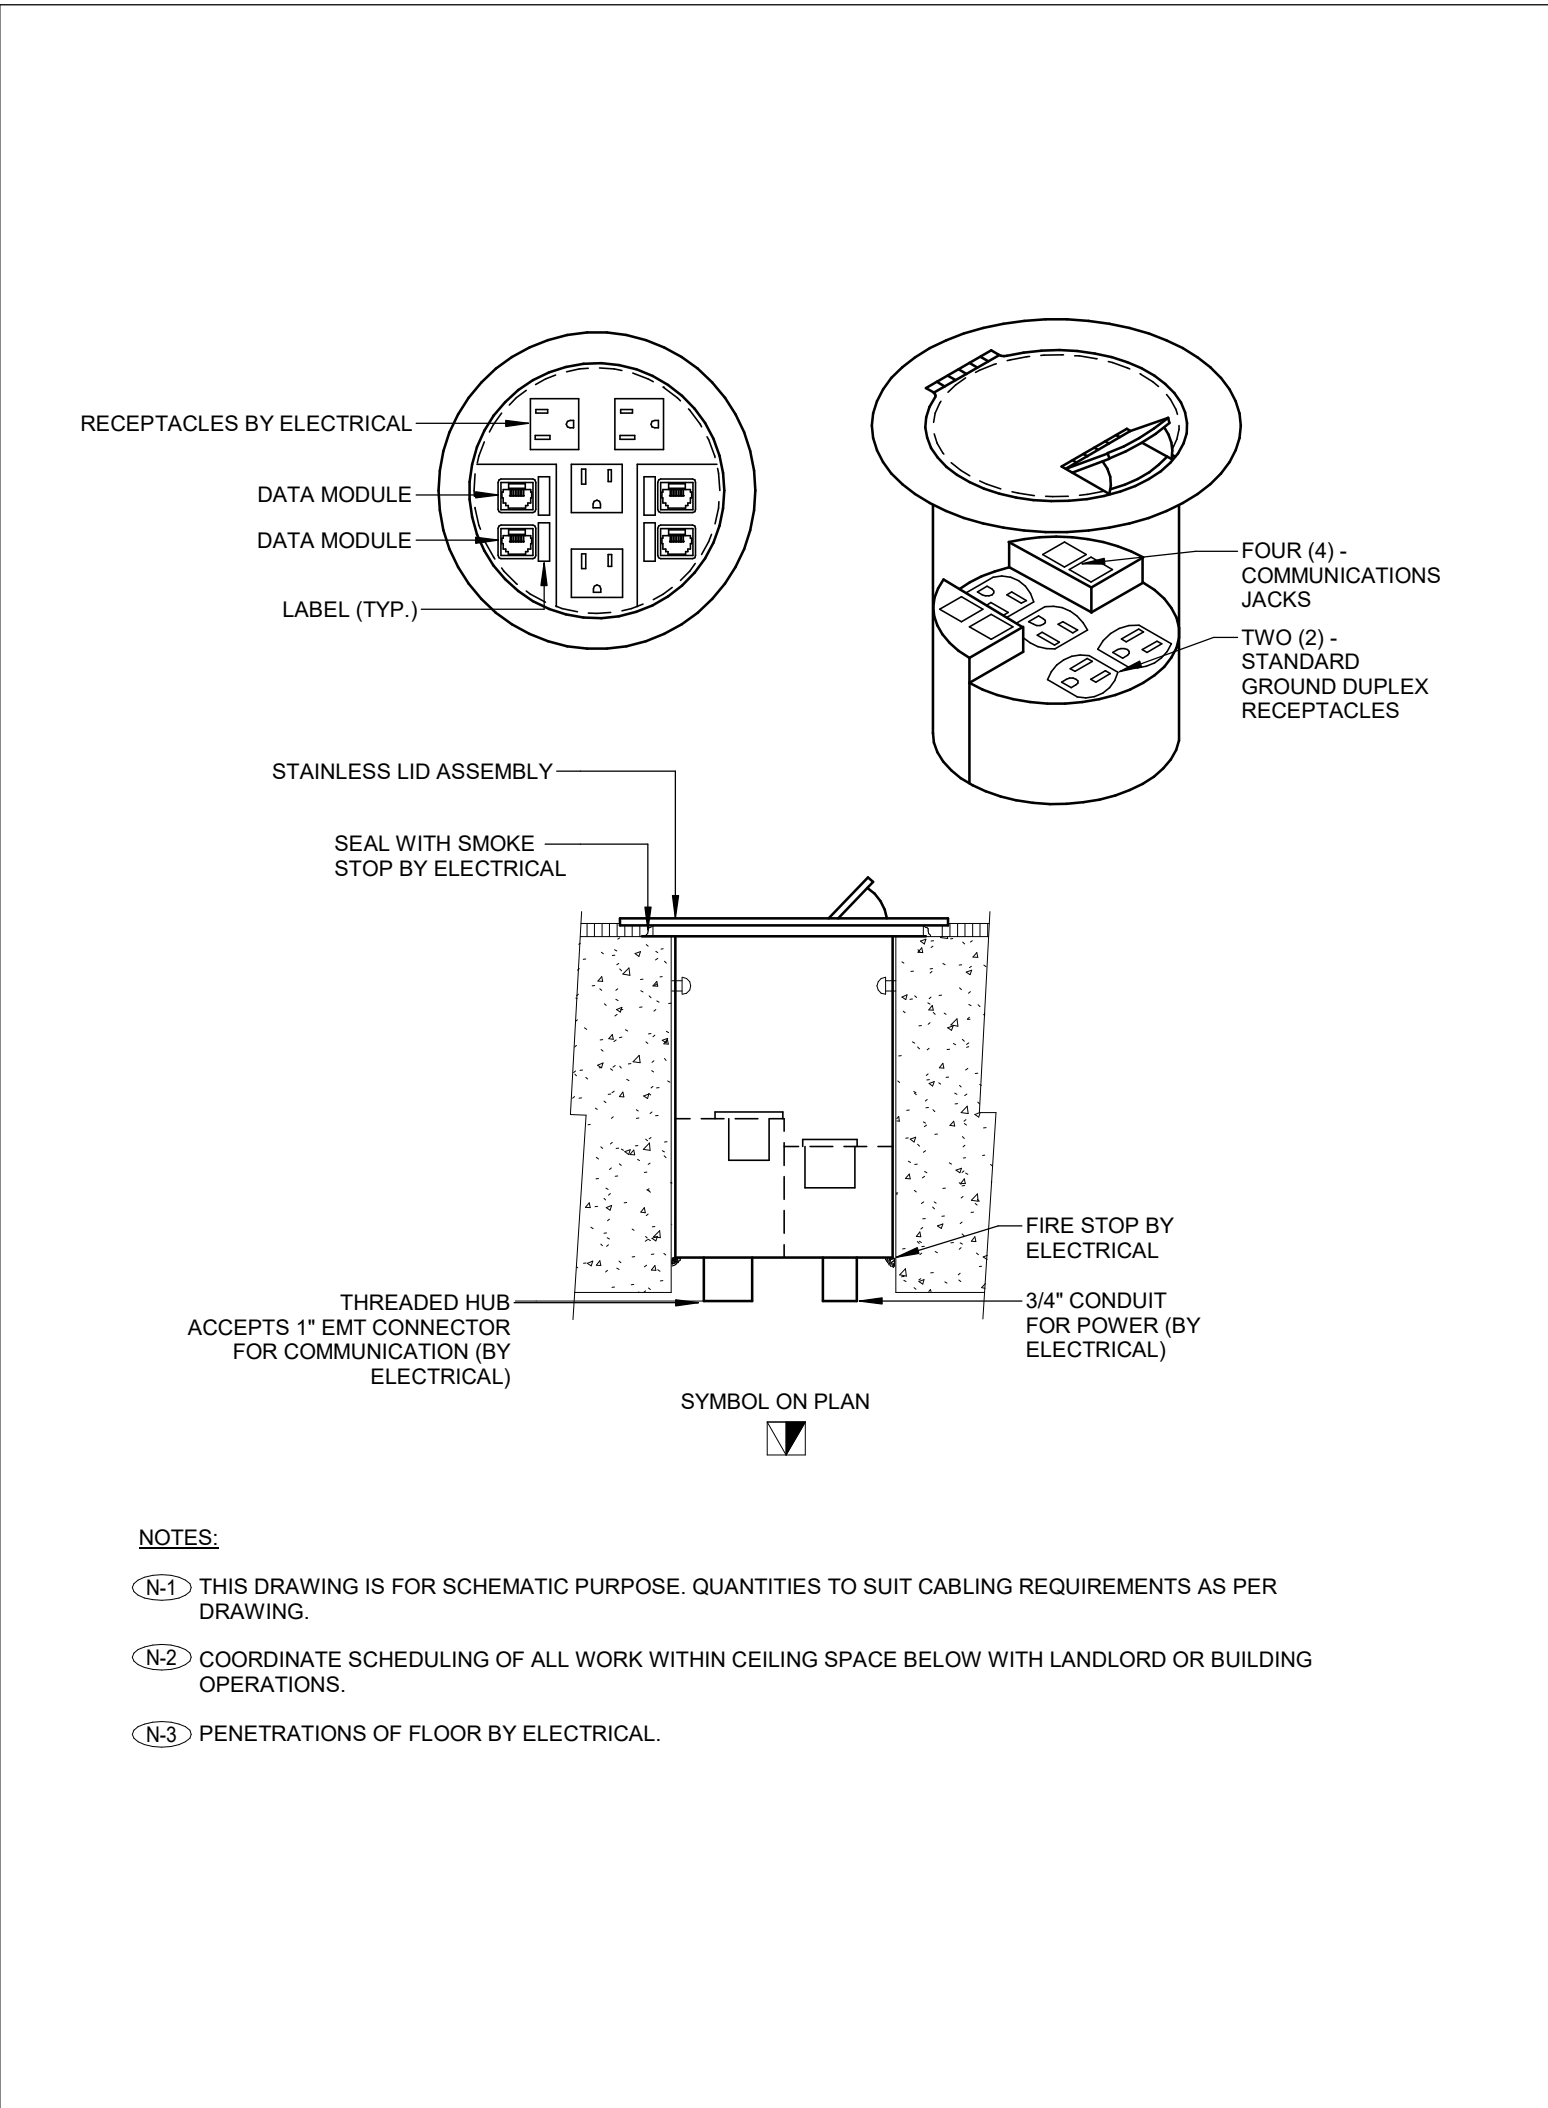


4 POKE-THROUGH DATA OUTLET
TC-0.1 NTS

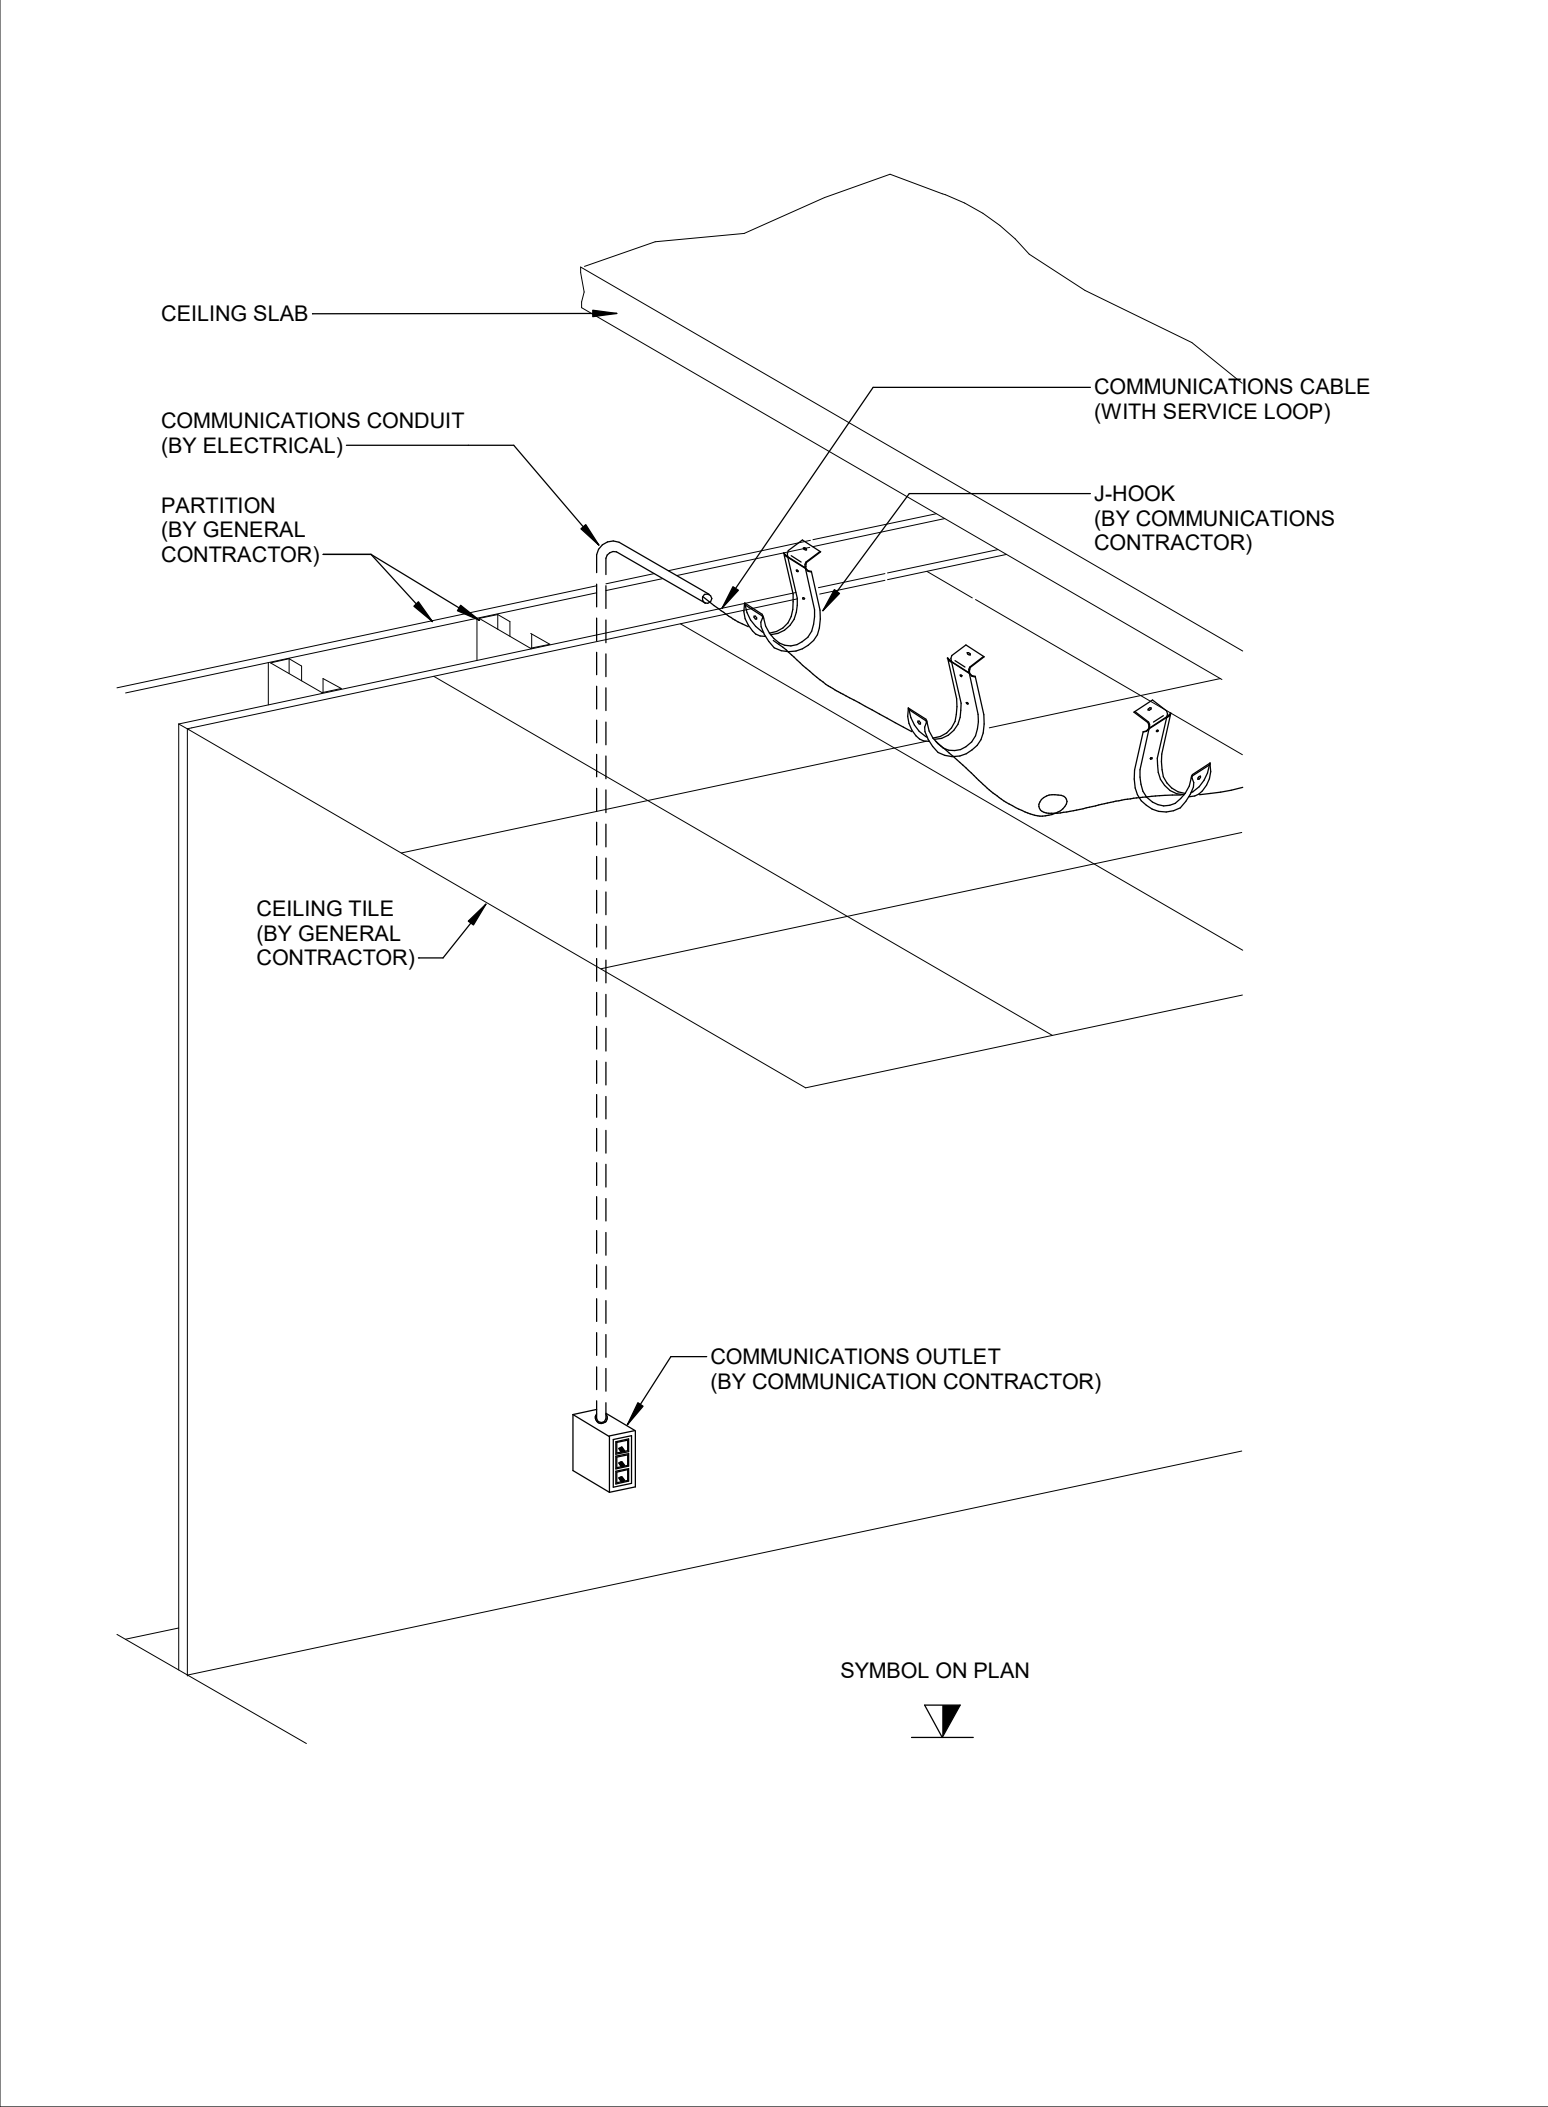


5 TYPICAL COMMUNICATIONS CABLE WALL ROUTING DETAIL - ACCESSIBLE CEILING
TC-0.1 NTS

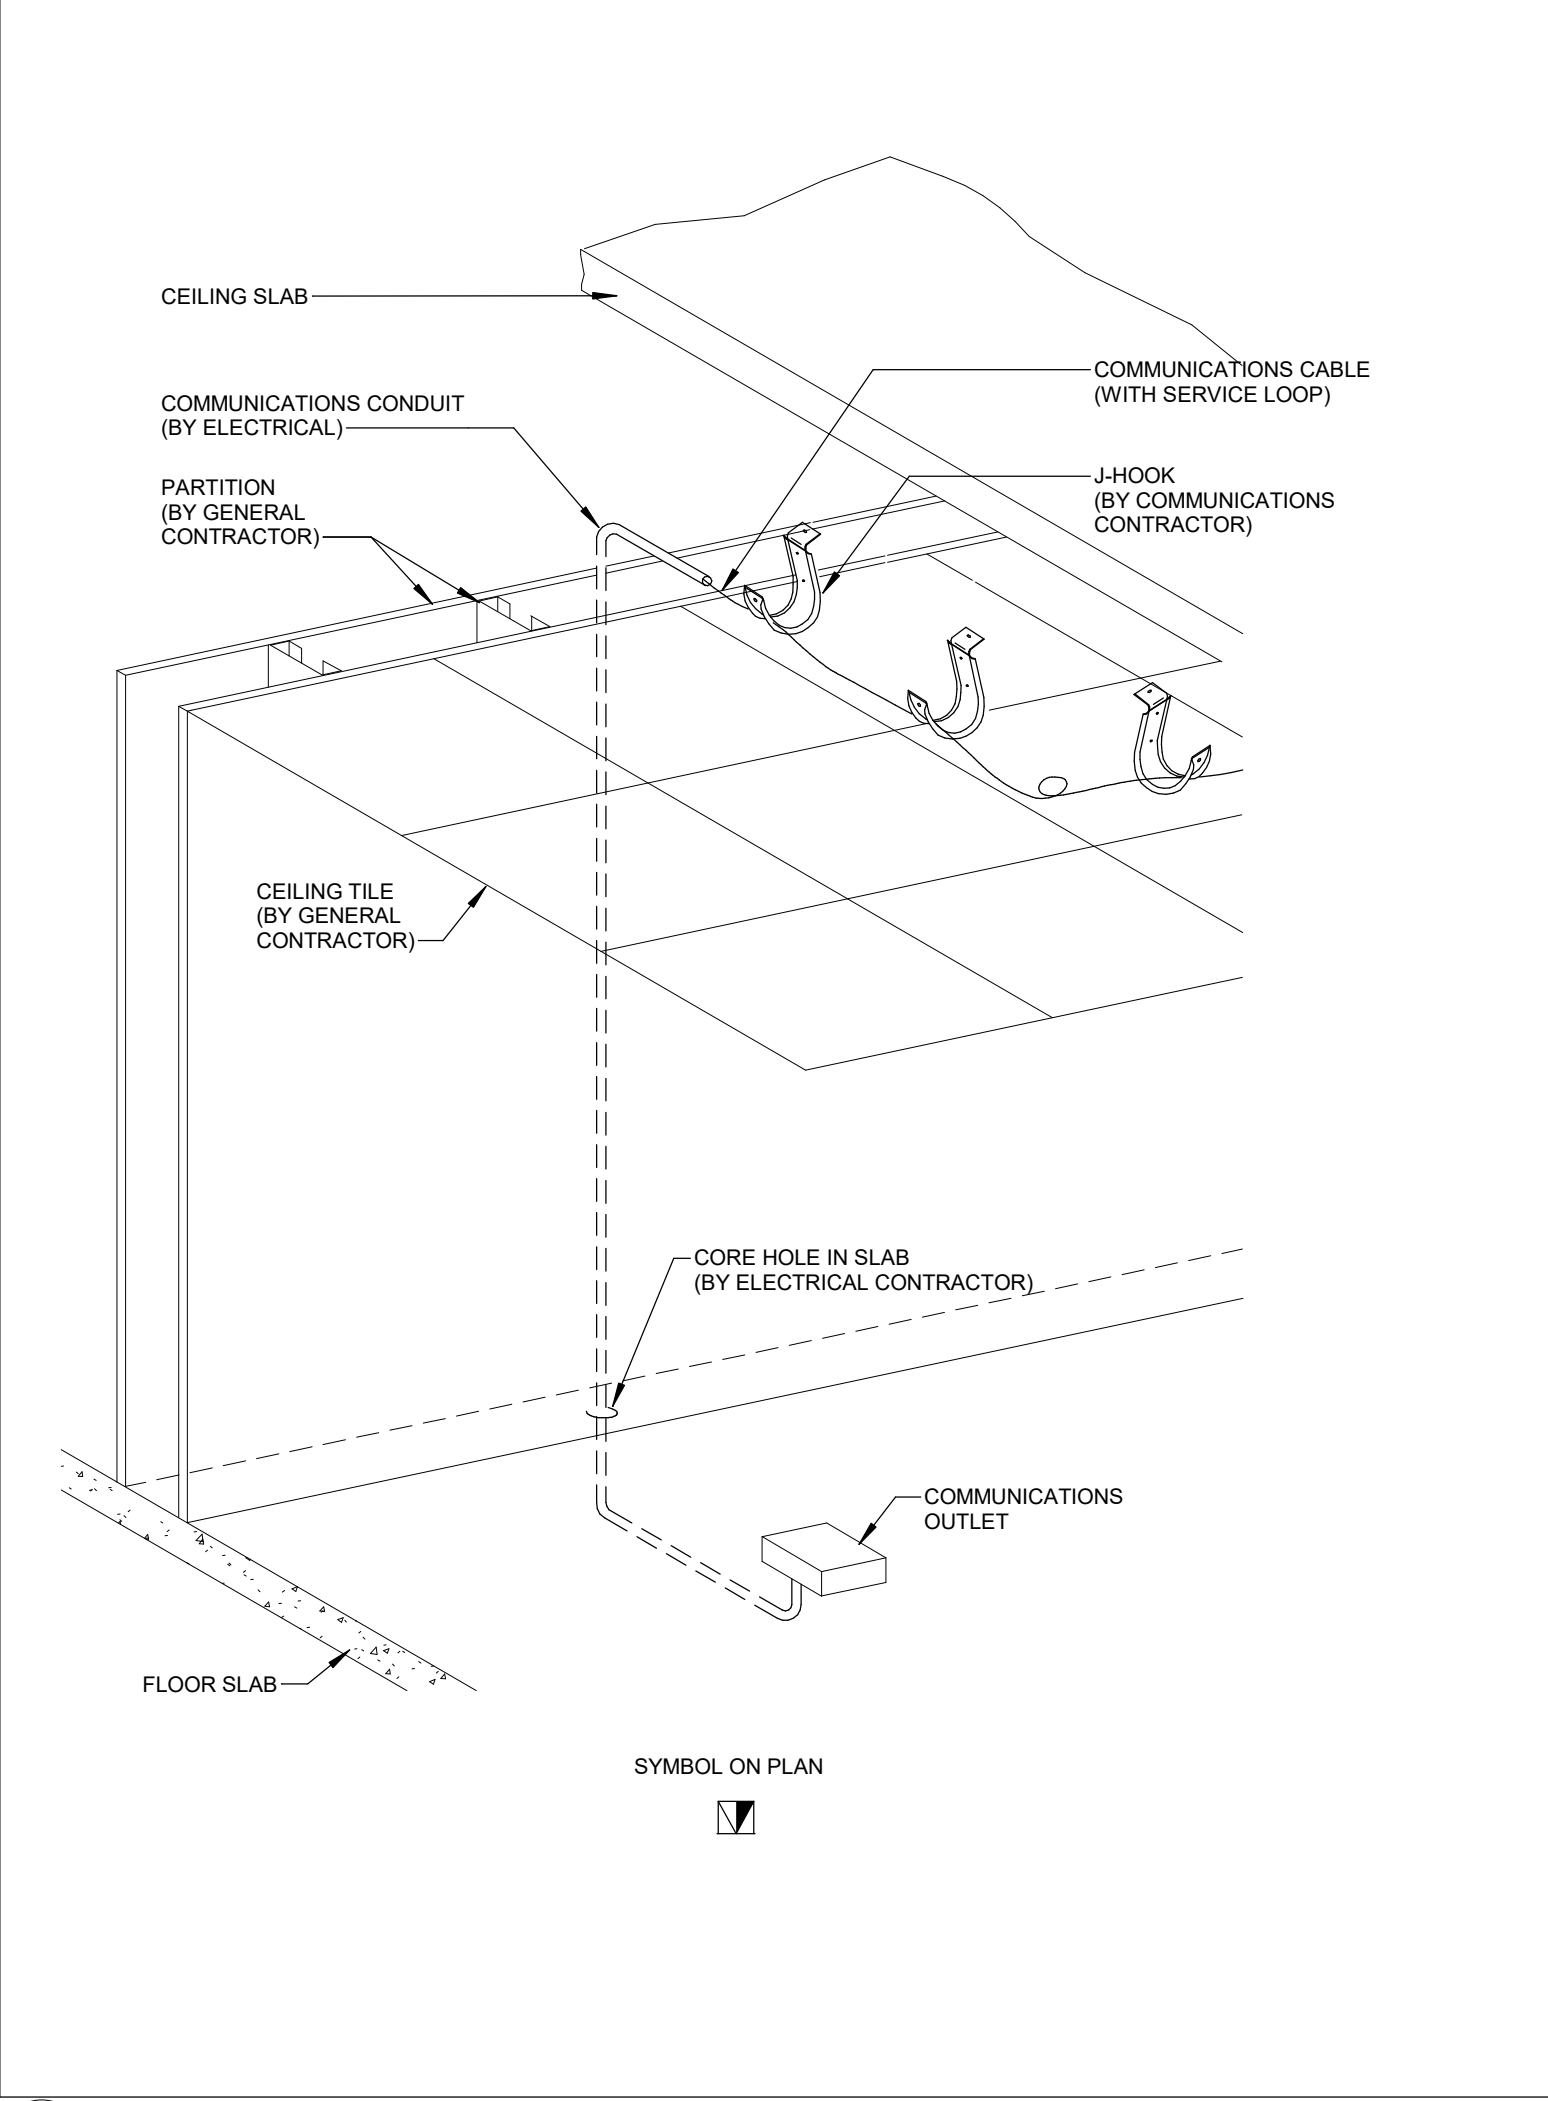


6 TYPICAL COMMUNICATIONS CABLE WALL ROUTING DETAIL - ACCESSIBLE CEILING #2
TC-0.1 NTS

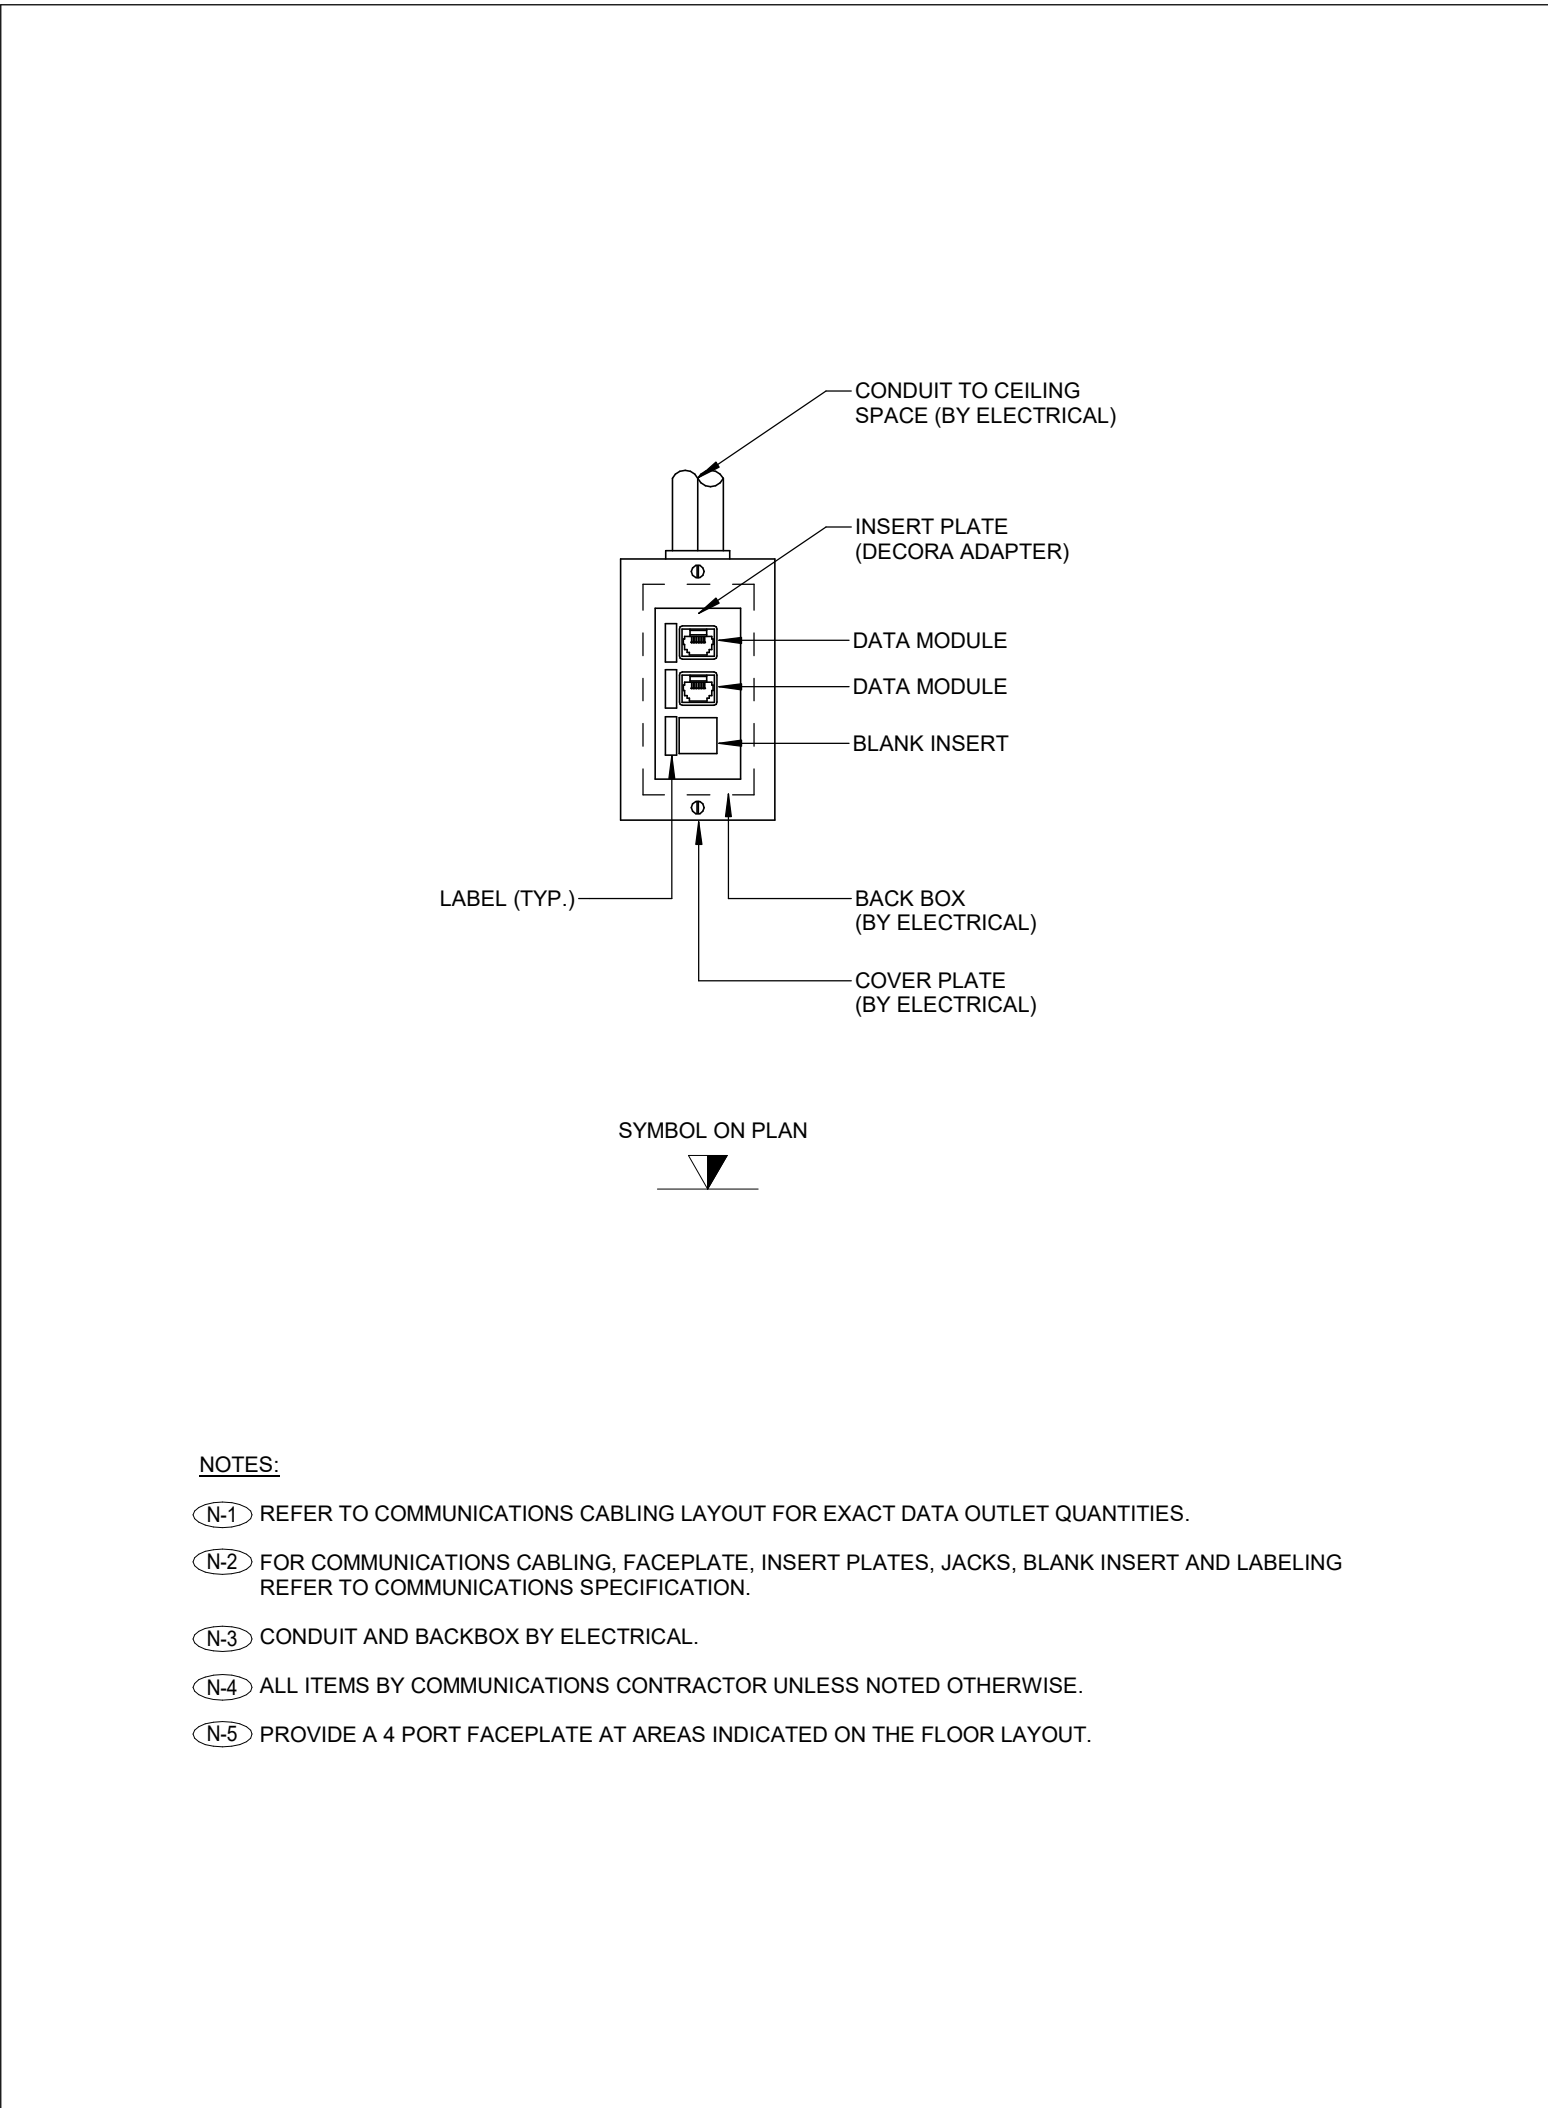

1 TYPICAL WALL MOUNTED COMMUNICATIONS OUTLET DETAIL
TC-0.1 NTS

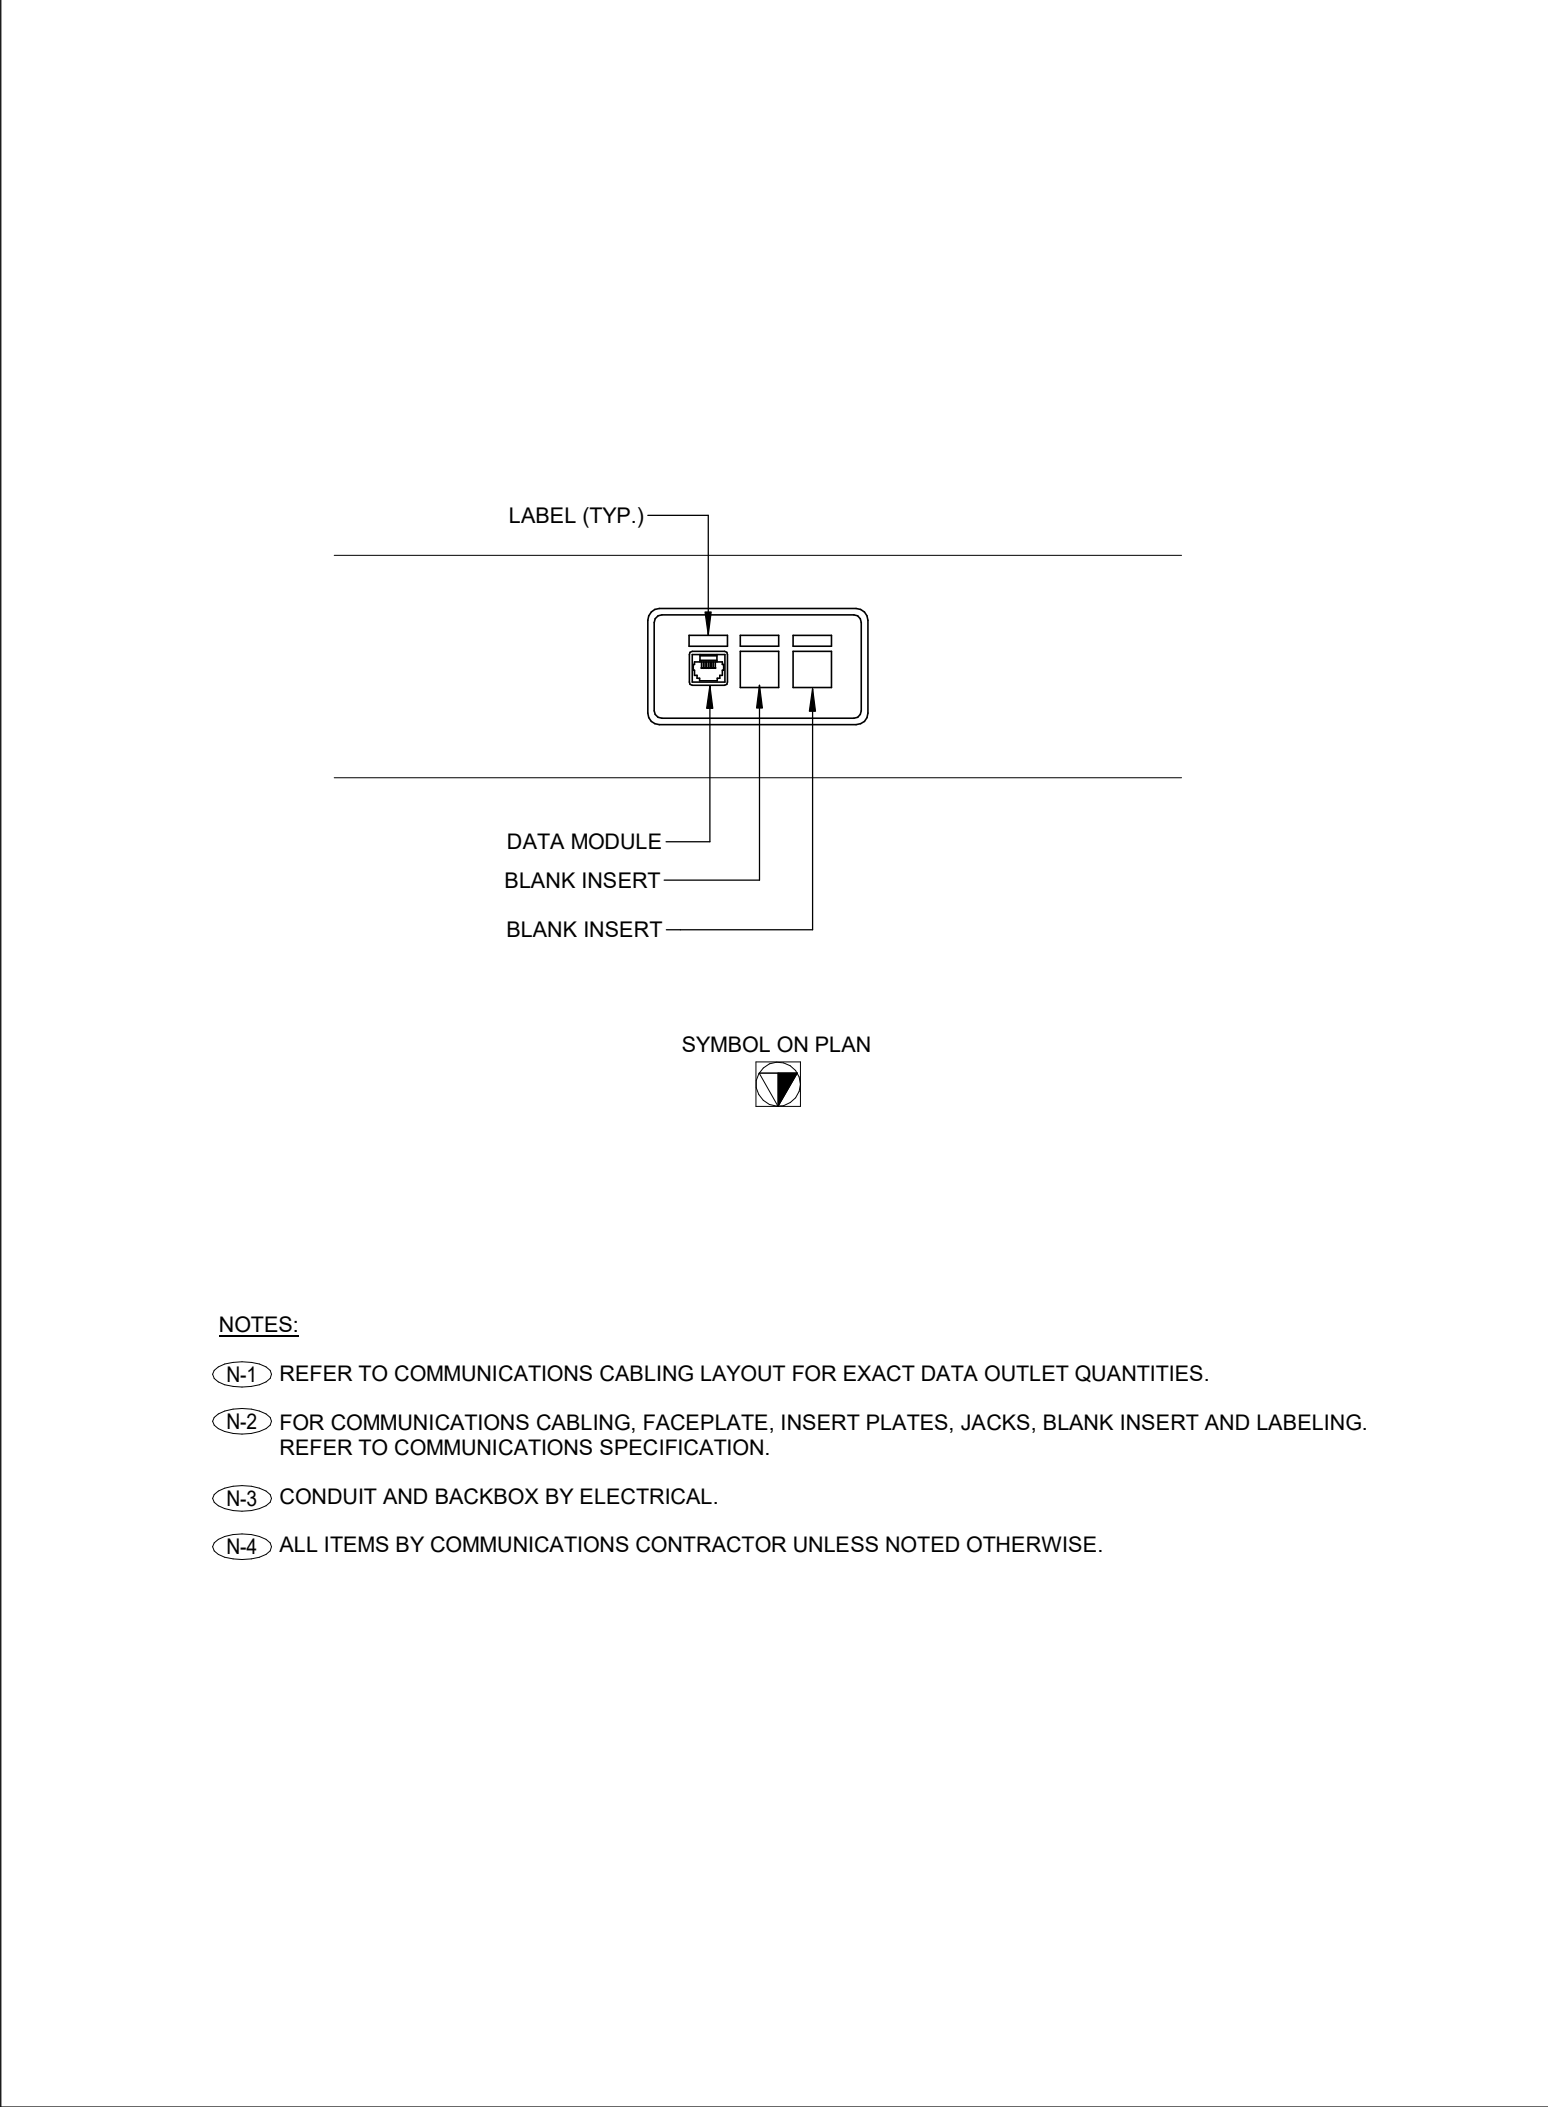

2 TYPICAL FURNITURE MOUNTED COMMUNICATIONS OUTLET DETAIL
TC-0.1 NTS

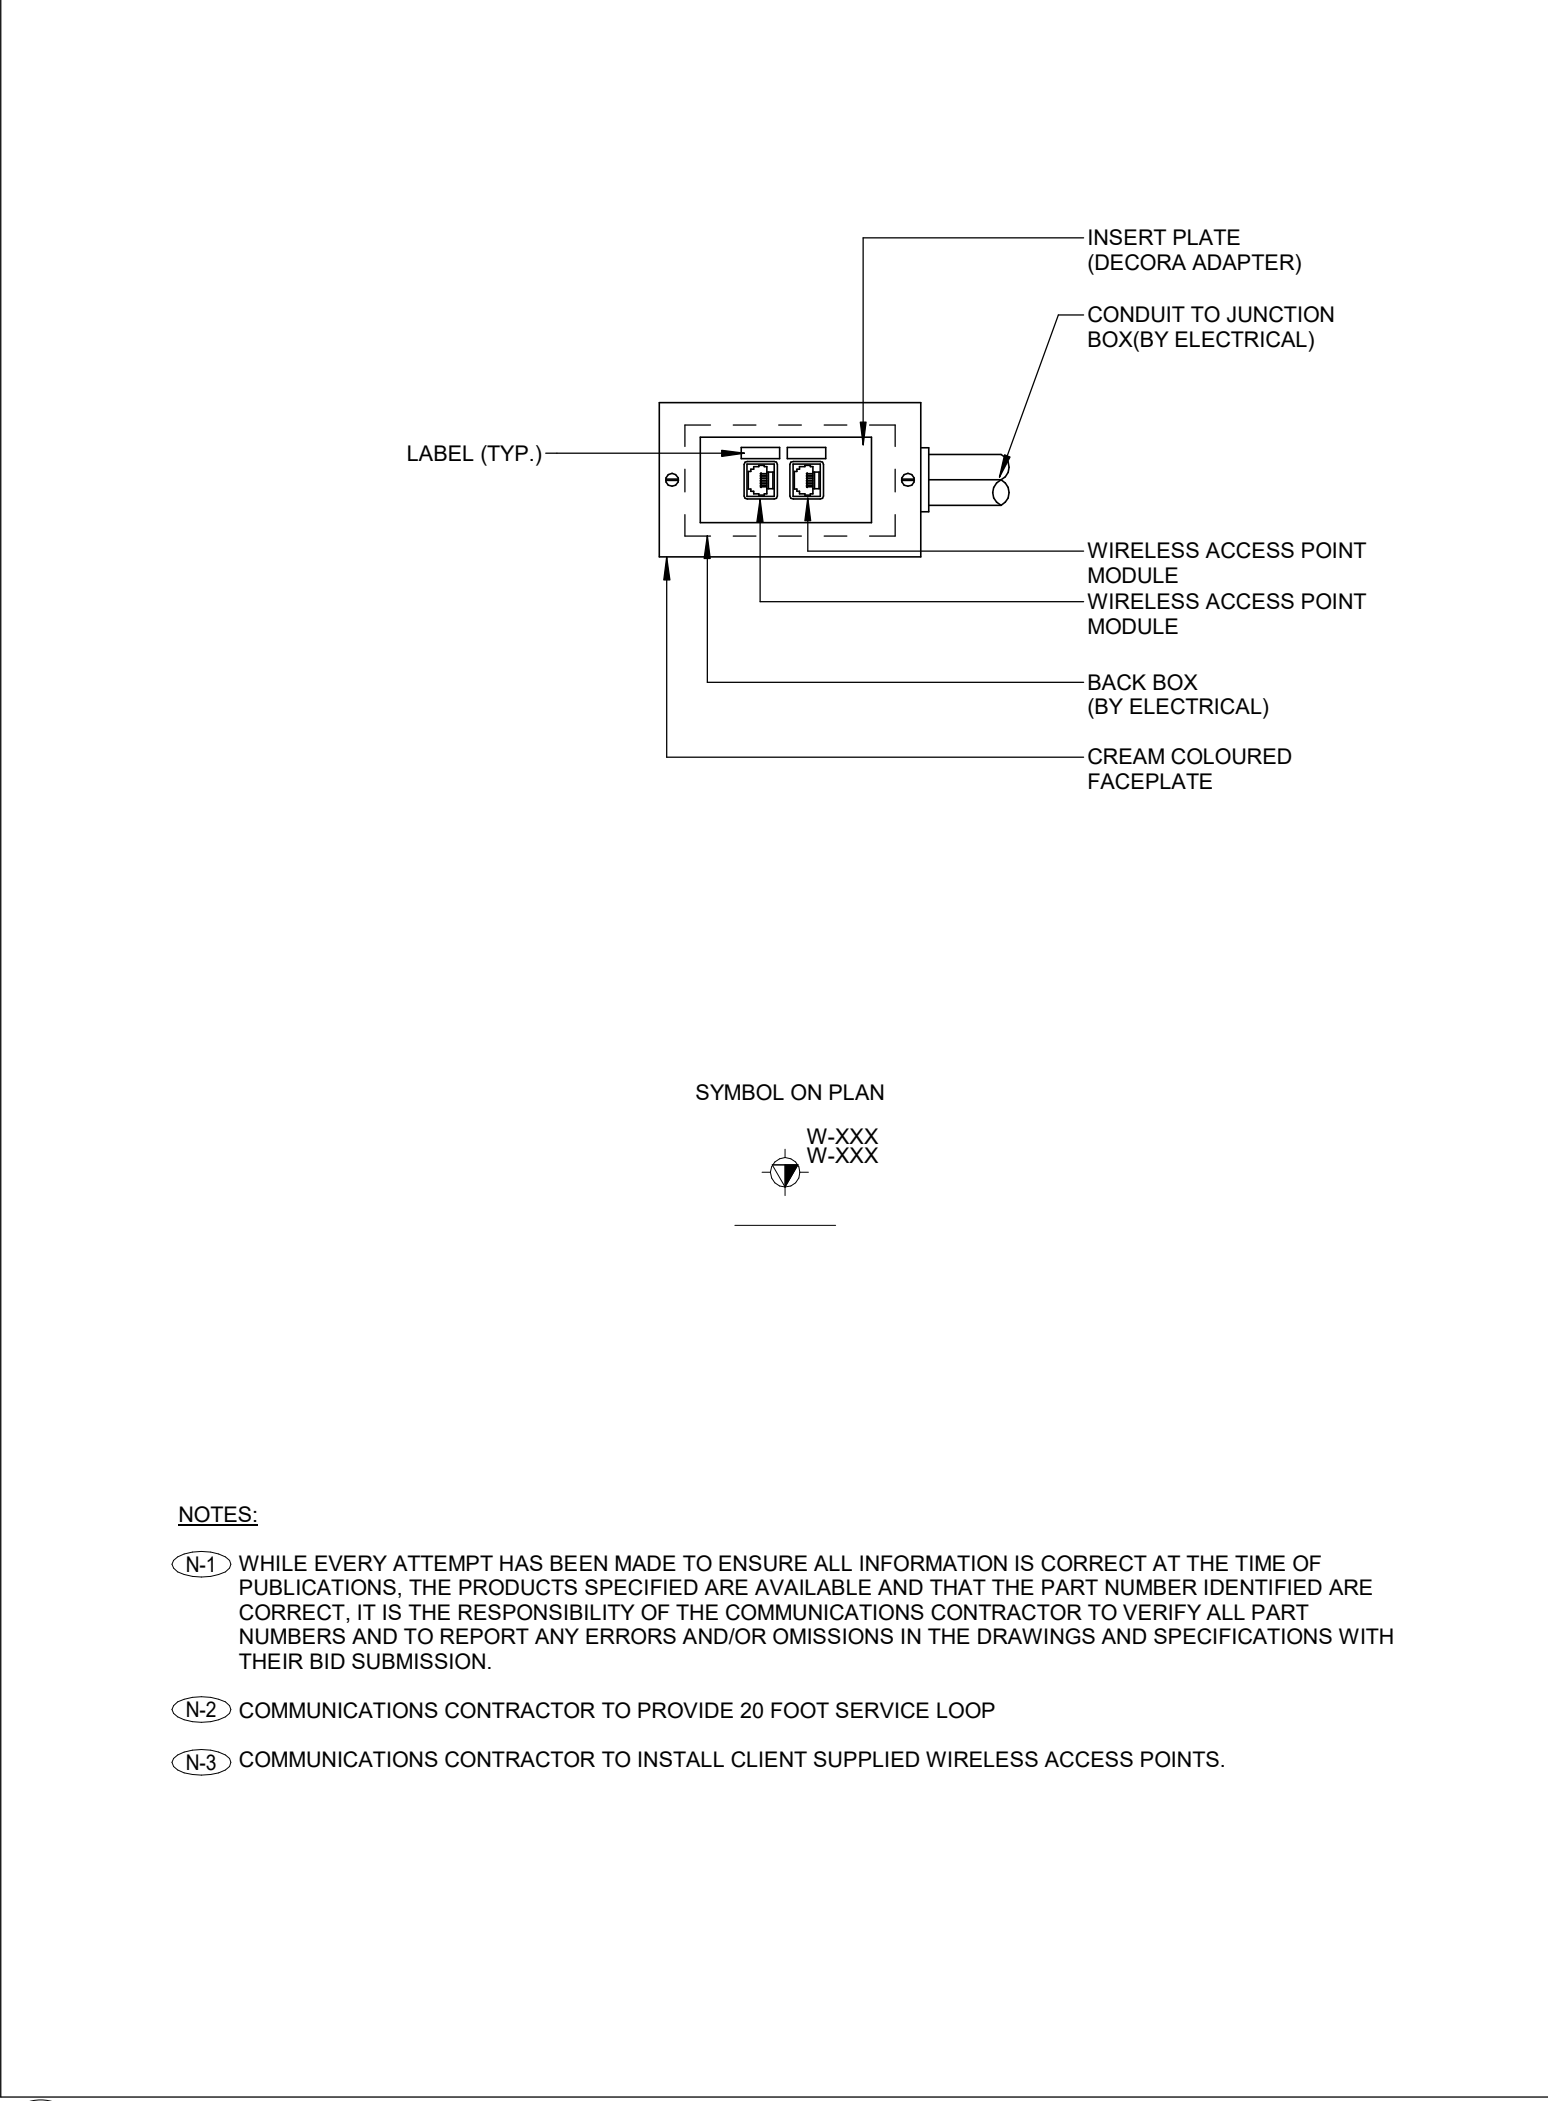

3 WIRELESS ACCESS POINT 2-PORT MDVO SIDE ENTRY TERMINATION BOX DETAIL
TC-0.1 NTS

SHEET No.	SHEET NAME	SCALE
TC-0.0	COVER PAGE	N.T.S.
TC-0.1	DRAWING LIST, GENERAL NOTES, ABBREVIATIONS, LEGENDS AND DETAILS	N.T.S.
TC-0.2	COMMUNICATIONS TELECOM ROOMS DETAILS	N.T.S.
TC-0.3	COMMUNICATIONS RISER DIAGRAM	N.T.S.
TC-0.1.1	LEVEL 01 COMMUNICATIONS LAYOUT	1:100
TC-0.1.2	LEVEL 02 COMMUNICATIONS LAYOUT	1:100
TC-0.1.3	LEVEL 03 COMMUNICATIONS LAYOUT	1:100
TC-0.1.4	LEVEL 04 COMMUNICATIONS LAYOUT	1:100
TC-0.1.5	LEVEL 05 COMMUNICATIONS LAYOUT	1:100
TC-0.1.6	LEVEL 06 COMMUNICATIONS LAYOUT	1:100
TC-0.1.7	LEVEL 07 COMMUNICATIONS LAYOUT	1:100
TC-0.1.8	LEVEL 08 COMMUNICATIONS LAYOUT	1:100
TC-0.1.9	LEVEL 09 COMMUNICATIONS LAYOUT	1:100
TC-0.1.10	LEVEL 10 COMMUNICATIONS LAYOUT	1:100
TC-0.1.11	LEVEL 11 COMMUNICATIONS LAYOUT	1:100
TC-0.1.12	LEVEL 12 COMMUNICATIONS LAYOUT	1:100
TC-0.1.13	LEVEL 13 COMMUNICATIONS LAYOUT	1:100
TC-0.1.14	LEVEL 14 COMMUNICATIONS LAYOUT	1:100
TC-0.1.15	LEVEL 15 COMMUNICATIONS LAYOUT	1:100
TC-0.1.16	LEVEL 16 COMMUNICATIONS LAYOUT	1:100
TC-0.1.17	LEVEL 17 COMMUNICATIONS LAYOUT	1:100
TC-0.1.18	LEVEL 18 COMMUNICATIONS LAYOUT	1:100
TC-0.1.19	LEVEL 19 COMMUNICATIONS LAYOUT	1:100
TC-0.1.20	LEVEL 20 COMMUNICATIONS LAYOUT	1:100

ABBREVIATIONS			
AFF	ABOVE FINISHED FLOOR	BP	BLANK PLATE
DAS	DISTRIBUTED ANTENNA SYSTEM	E	EXISTING TO REMAIN
ER	EXISTING TO BE REMOVED	FTD	FIBRE TO THE DESK
JB	JUNCTION BOX	KW	KILOWATTS
R	EXISTING TO BE RELOCATED	RR	REMOVE AND REINSTALL
RSD	ROOM SCHEDULING DEVICE	TYP	TYPICAL - TO BE INTERPRETED AS THE SAME AS COMPARABLE FEATURES
V	VOLTS	WAP	WIRELESS ACCESS POINT
WP	EXTERIOR/WEATHERPROOF		

LEGEND			
8	DETAIL NUMBER	12	SECTION NUMBER
8	DRAWING NUMBER	12	DRAWING NUMBER
8	REVISION BUBBLE	12	REVISION NUMBER
▼	WALL MOUNTED DATA AND/OR VOICE OUTLETS. COMMUNICATIONS CABLE TYPE AS PER SPECIFICATION.	4	REVISION NUMBER
▼	WALL MOUNTED DATA OUTLET. COMMUNICATION CABLE TYPE AS PER SPECIFICATION.		
▼	WALL MOUNTED VOICE OUTLET. COMMUNICATION CABLE TYPE AS PER SPECIFICATION.		
▼	WALL MOUNTED AUDIO VISUAL CONNECTION. COMMUNICATION CABLE TYPE AS PER SPECIFICATION.		
▼	FLOOR MOUNTED DATA AND/OR VOICE OUTLETS. COMMUNICATIONS CABLE TYPE AS PER SPECIFICATION.		
▼	FLOOR MOUNTED DATA OUTLET. COMMUNICATION CABLE TYPE AS PER SPECIFICATION.		
▼	FLOOR MOUNTED VOICE OUTLET. COMMUNICATION CABLE TYPE AS PER SPECIFICATION.		
▼	FURNITURE MOUNTED DATA AND/OR VOICE OUTLETS. COMMUNICATIONS CABLE TYPE AS PER SPECIFICATION.		
▼	FURNITURE MOUNTED DATA OUTLET. COMMUNICATION CABLE TYPE AS PER SPECIFICATION.		
▼	FURNITURE MOUNTED VOICE OUTLET. COMMUNICATION CABLE TYPE AS PER SPECIFICATION.		
▼	WIREMOLD MOUNTED DATA AND/OR VOICE OUTLETS. COMMUNICATIONS CABLE TYPE AS PER SPECIFICATION.		
▼	CEILING MOUNTED DATA OUTLET(S). CABLE TYPE AS PER SPECIFICATION.		
▼	CEILING MOUNTED DATA OUTLET. COMMUNICATION CABLE TYPE AS PER SPECIFICATION.		
▼	CEILING MOUNTED VOICE OUTLET. COMMUNICATION CABLE TYPE AS PER SPECIFICATION.		
▼	CEILING MOUNTED AUDIO VISUAL CONNECTION. COMMUNICATION CABLE TYPE AS PER SPECIFICATION.		
▼	4-PAIR HORIZONTAL COPPER DATA CABLE FOR SECURITY CAMERA CABLEING.		
▼	4-PAIR HORIZONTAL COPPER DATA CABLE LABELING SCHEME SHOWN IS GENERIC. VERIFY EXACT LABELING SCHEME PRIOR TO INSTALLATION. LETTER DENOTES CABLE TYPE: D = DATA, V = VOICE, W = WIRELESS ACCESS POINT, AV = AUDIO/VISUAL DATA, S = SECURITY		
▼	COAXIAL CATV OUTLET		
▼	FEED POINT FOR COMMUNICATIONS CABLEING. LETTER DENOTES FEED LOCATION: W = WALL, F = FLOOR, P = PAC POLE, WM = WIREMOLD		
▼	CONDUIT FOR COMMUNICATIONS CABLEING. SIZE AND QUANTITY AS NOTED. BY ELECTRICAL UNLESS OTHERWISE NOTED.		
▼	CABLE TRAY FOR COMMUNICATIONS CABLEING. SIZE AS NOTED. BY ELECTRICAL CONTRACTOR UNLESS OTHERWISE NOTED.		
▼	GRID POINT BOUNDARY		
▼	NOT IN CONTRACT		

NOTE: NOT ALL SYMBOLS APPLY. CONTRACTOR TO REFER TO FLOOR PLANS.

- GENERAL NOTES:
- REFER TO ARCHITECTURAL PLANS FOR DIMENSIONS, HEIGHTS, PARTITION TYPES, CEILING TYPES, CONSTRUCTION DETAILS, MOUNTING DETAILS, FINISHES, AND COLOURS.
 - WHILE EVERY ATTEMPT HAS BEEN MADE TO ENSURE ALL INFORMATION IS CORRECT AT THE TIME OF PUBLICATION, THE PRODUCTS SPECIFIED ARE AVAILABLE AND THAT THE PART NUMBER IDENTIFIED ARE CORRECT. IT IS THE RESPONSIBILITY OF THE COMMUNICATIONS CONTRACTOR TO VERIFY ALL PART NUMBERS AND TO REPORT ANY ERRORS AND/OR OMISSIONS IN THE DRAWINGS AND SPECIFICATIONS WITH THEIR BID SUBMISSION.
 - ALL ITEMS BY COMMUNICATIONS CONTRACTOR UNLESS OTHERWISE NOTED.
 - REVIEW ALL PROJECT RELATED ARCHITECTURAL, MECHANICAL, ELECTRICAL, SECURITY AND AV DRAWINGS AND SPECIFICATIONS. DISCERN AND COORDINATE ALL OVERLAPPING WORK WITH COMMUNICATIONS SYSTEMS TO AVOID COLLISIONS AND CONFLICTS OF DEVICES.
 - DEVICES SHALL NOT BE INSTALLED IN WALL AREAS THAT ARE DESIGNATED TO HAVE MARKER BOARD, FABRIC PANELS, OR ACCENT FINISHES/DETAIL UNLESS INDICATED SPECIFICALLY ON AN ELEVATED DRAWING.
 - DEVICES SHALL NOT BE INSTALLED ABOVE ANY FURNITURE, AND SHALL BE LOCATED WHERE THERE IS ADEQUATE ACCESS FOR USE UNLESS INDICATED SPECIFICALLY ON AN ELEVATED DRAWING.
 - INFORM THE ENGINEER'S REPRESENTATIVE AND GENERAL CONTRACTOR OF ALL DEVICE AND FURNITURE CONFLICTS PRIOR TO INSTALLATION. OBTAIN RESOLUTION TO DEVICE AND FURNITURE CONFLICTS FROM THE ENGINEER'S REPRESENTATIVE PRIOR TO INSTALLATION.

KEY PLAN:

REVISION		
NO.	DATE	DESCRIPTION
1	2024-10-04	ISSUED FOR 50% REVIEW
2	2024-12-04	ISSUED FOR EAS REVIEW
3	2025-01-31	ISSUED FOR BID
4	2025-03-25	BID ADDENDUM #04

10

10


10

10
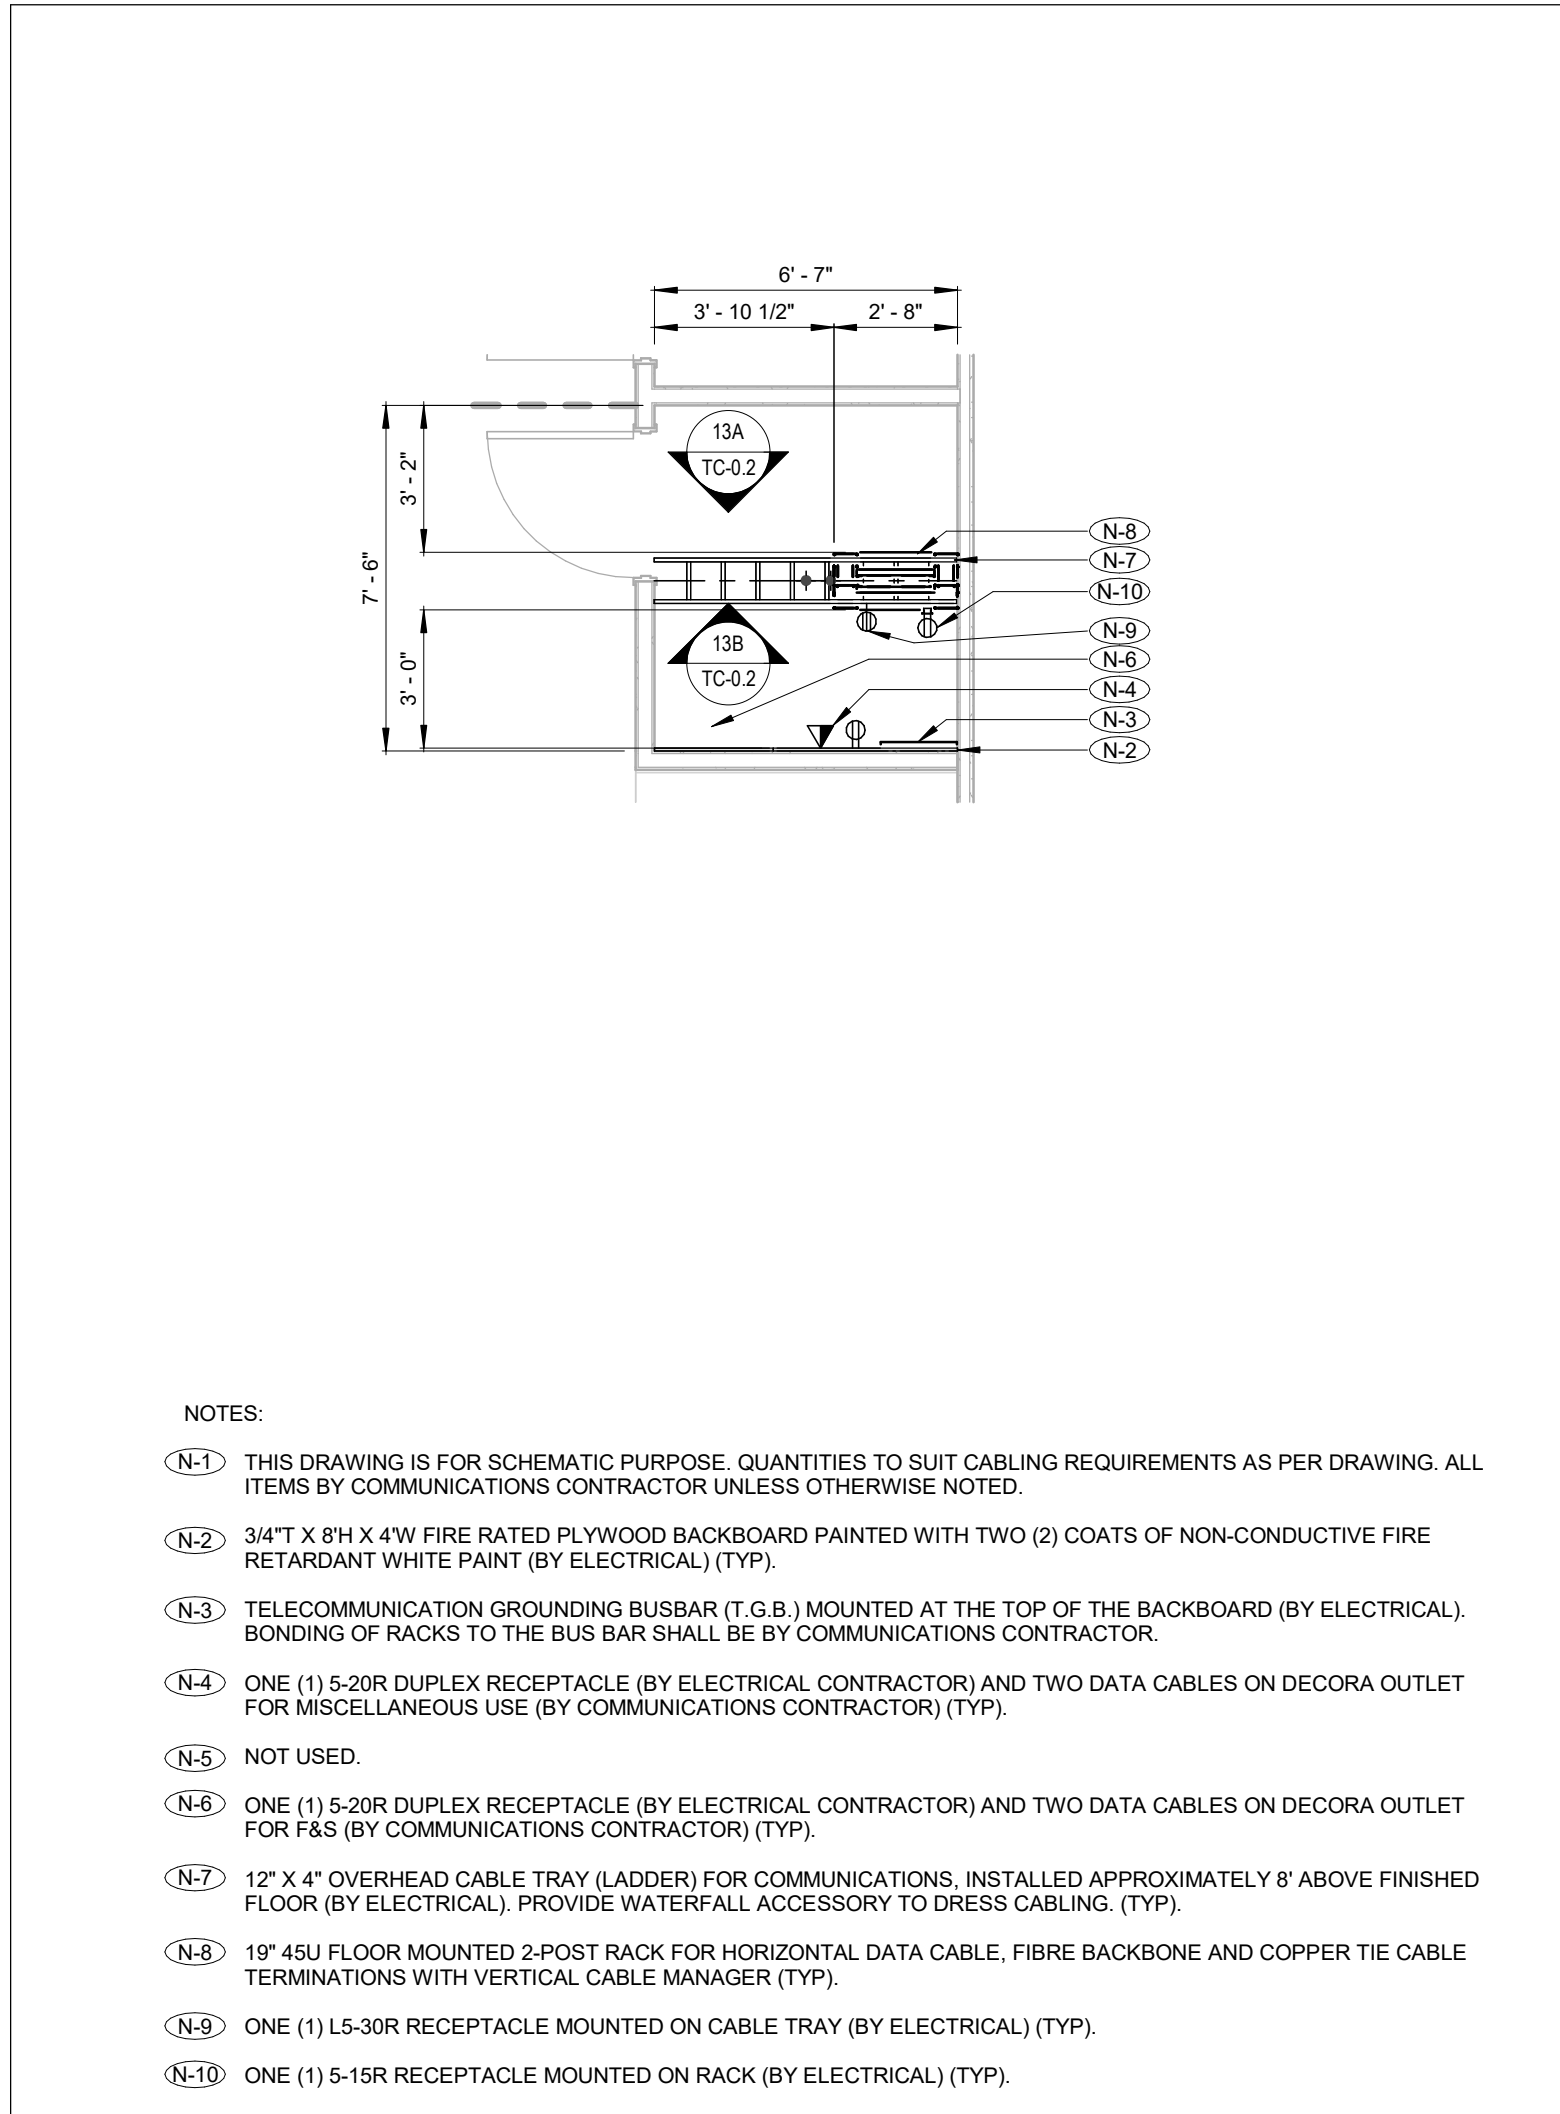


13 I.T. CLOSET 399E PLAN DETAIL
TC-0.2 1:50

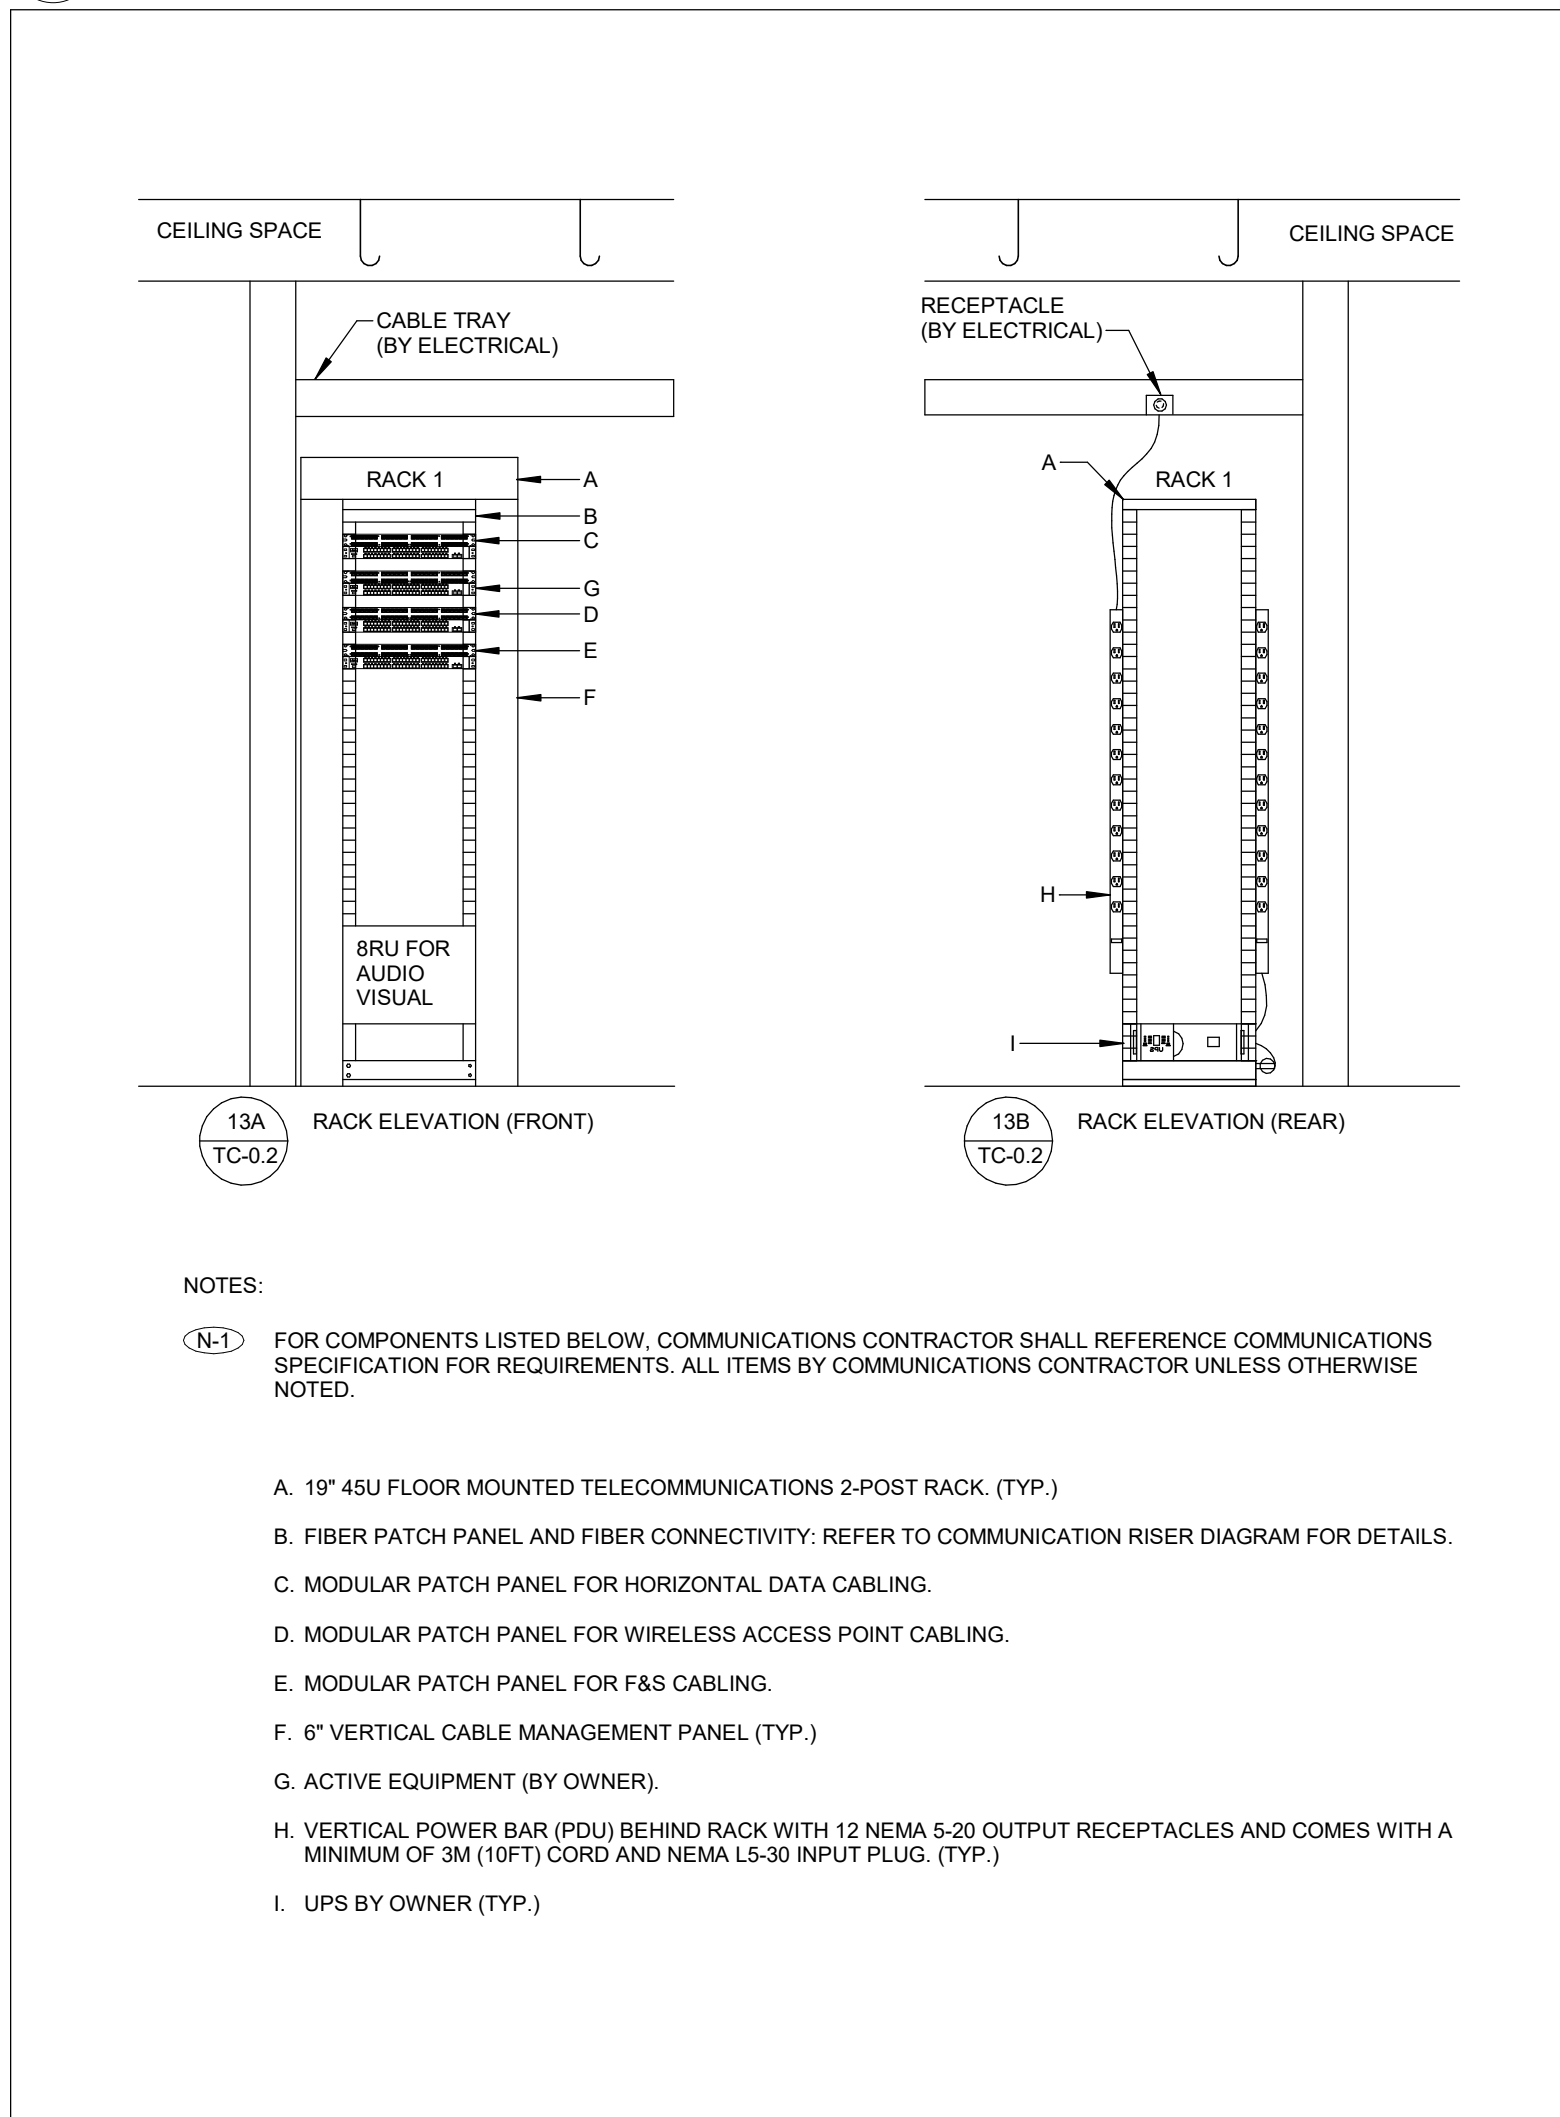

 
14 LEVEL 03 COMMUNICATIONS RACK ELEVATION DETAIL - I.T. 399C CLOSET
TC-0.2 NTS

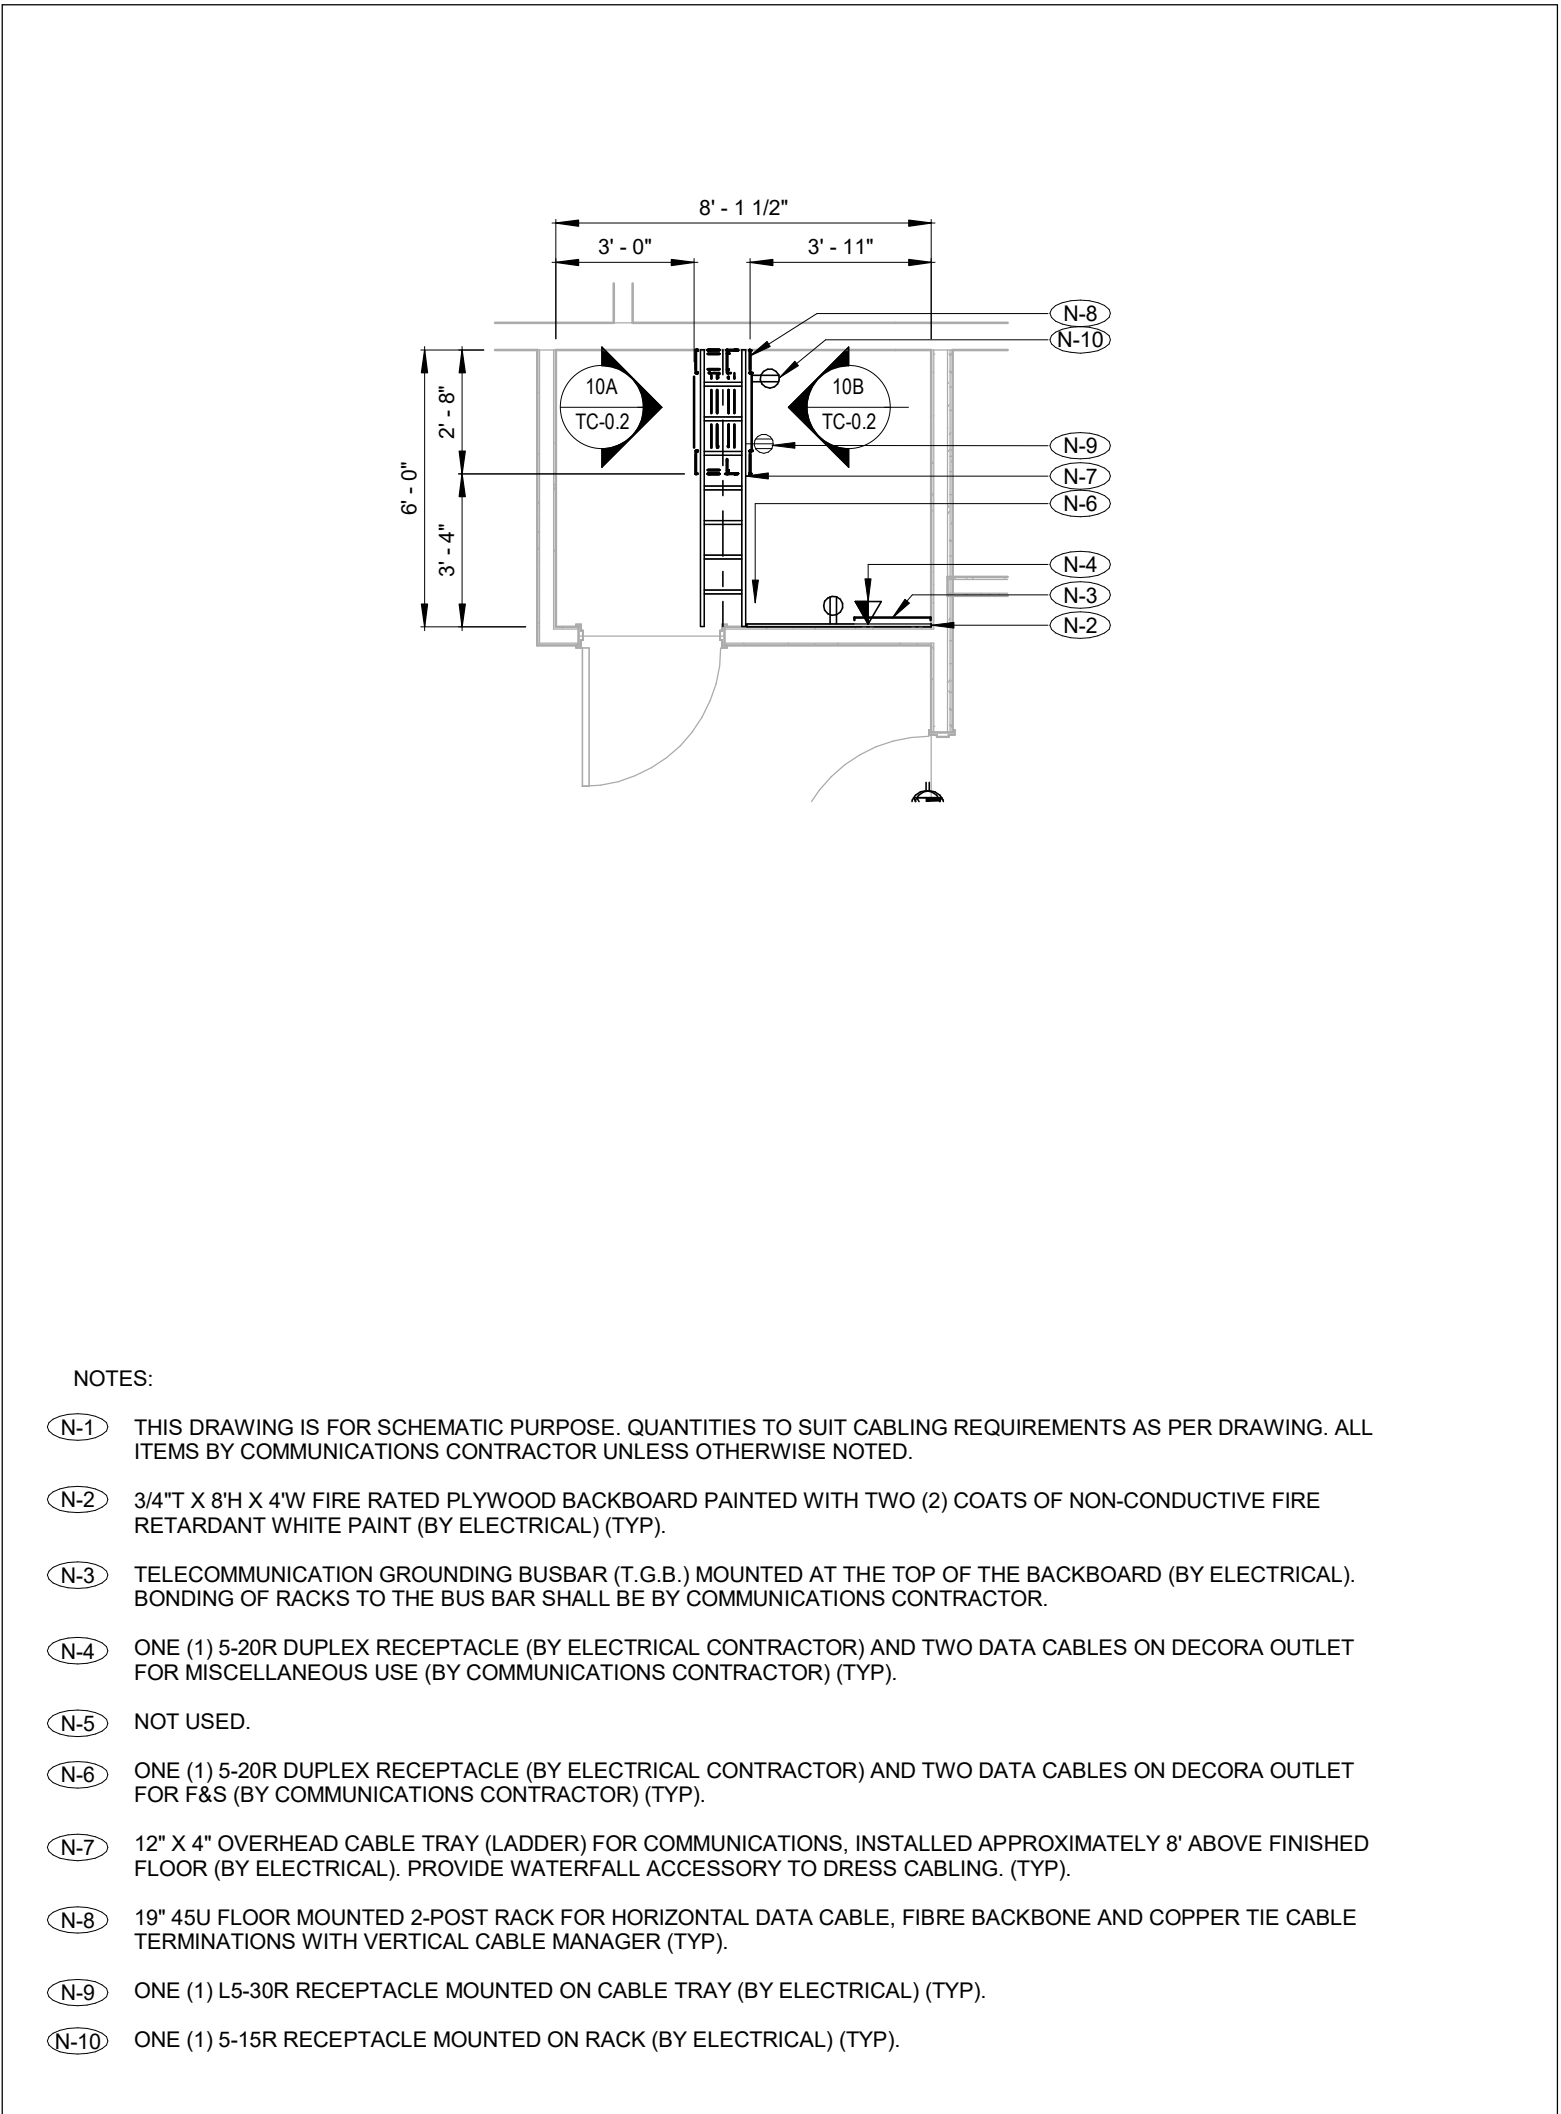


10 I.T. CLOSET 325 PLAN DETAIL
TC-0.2 1:50

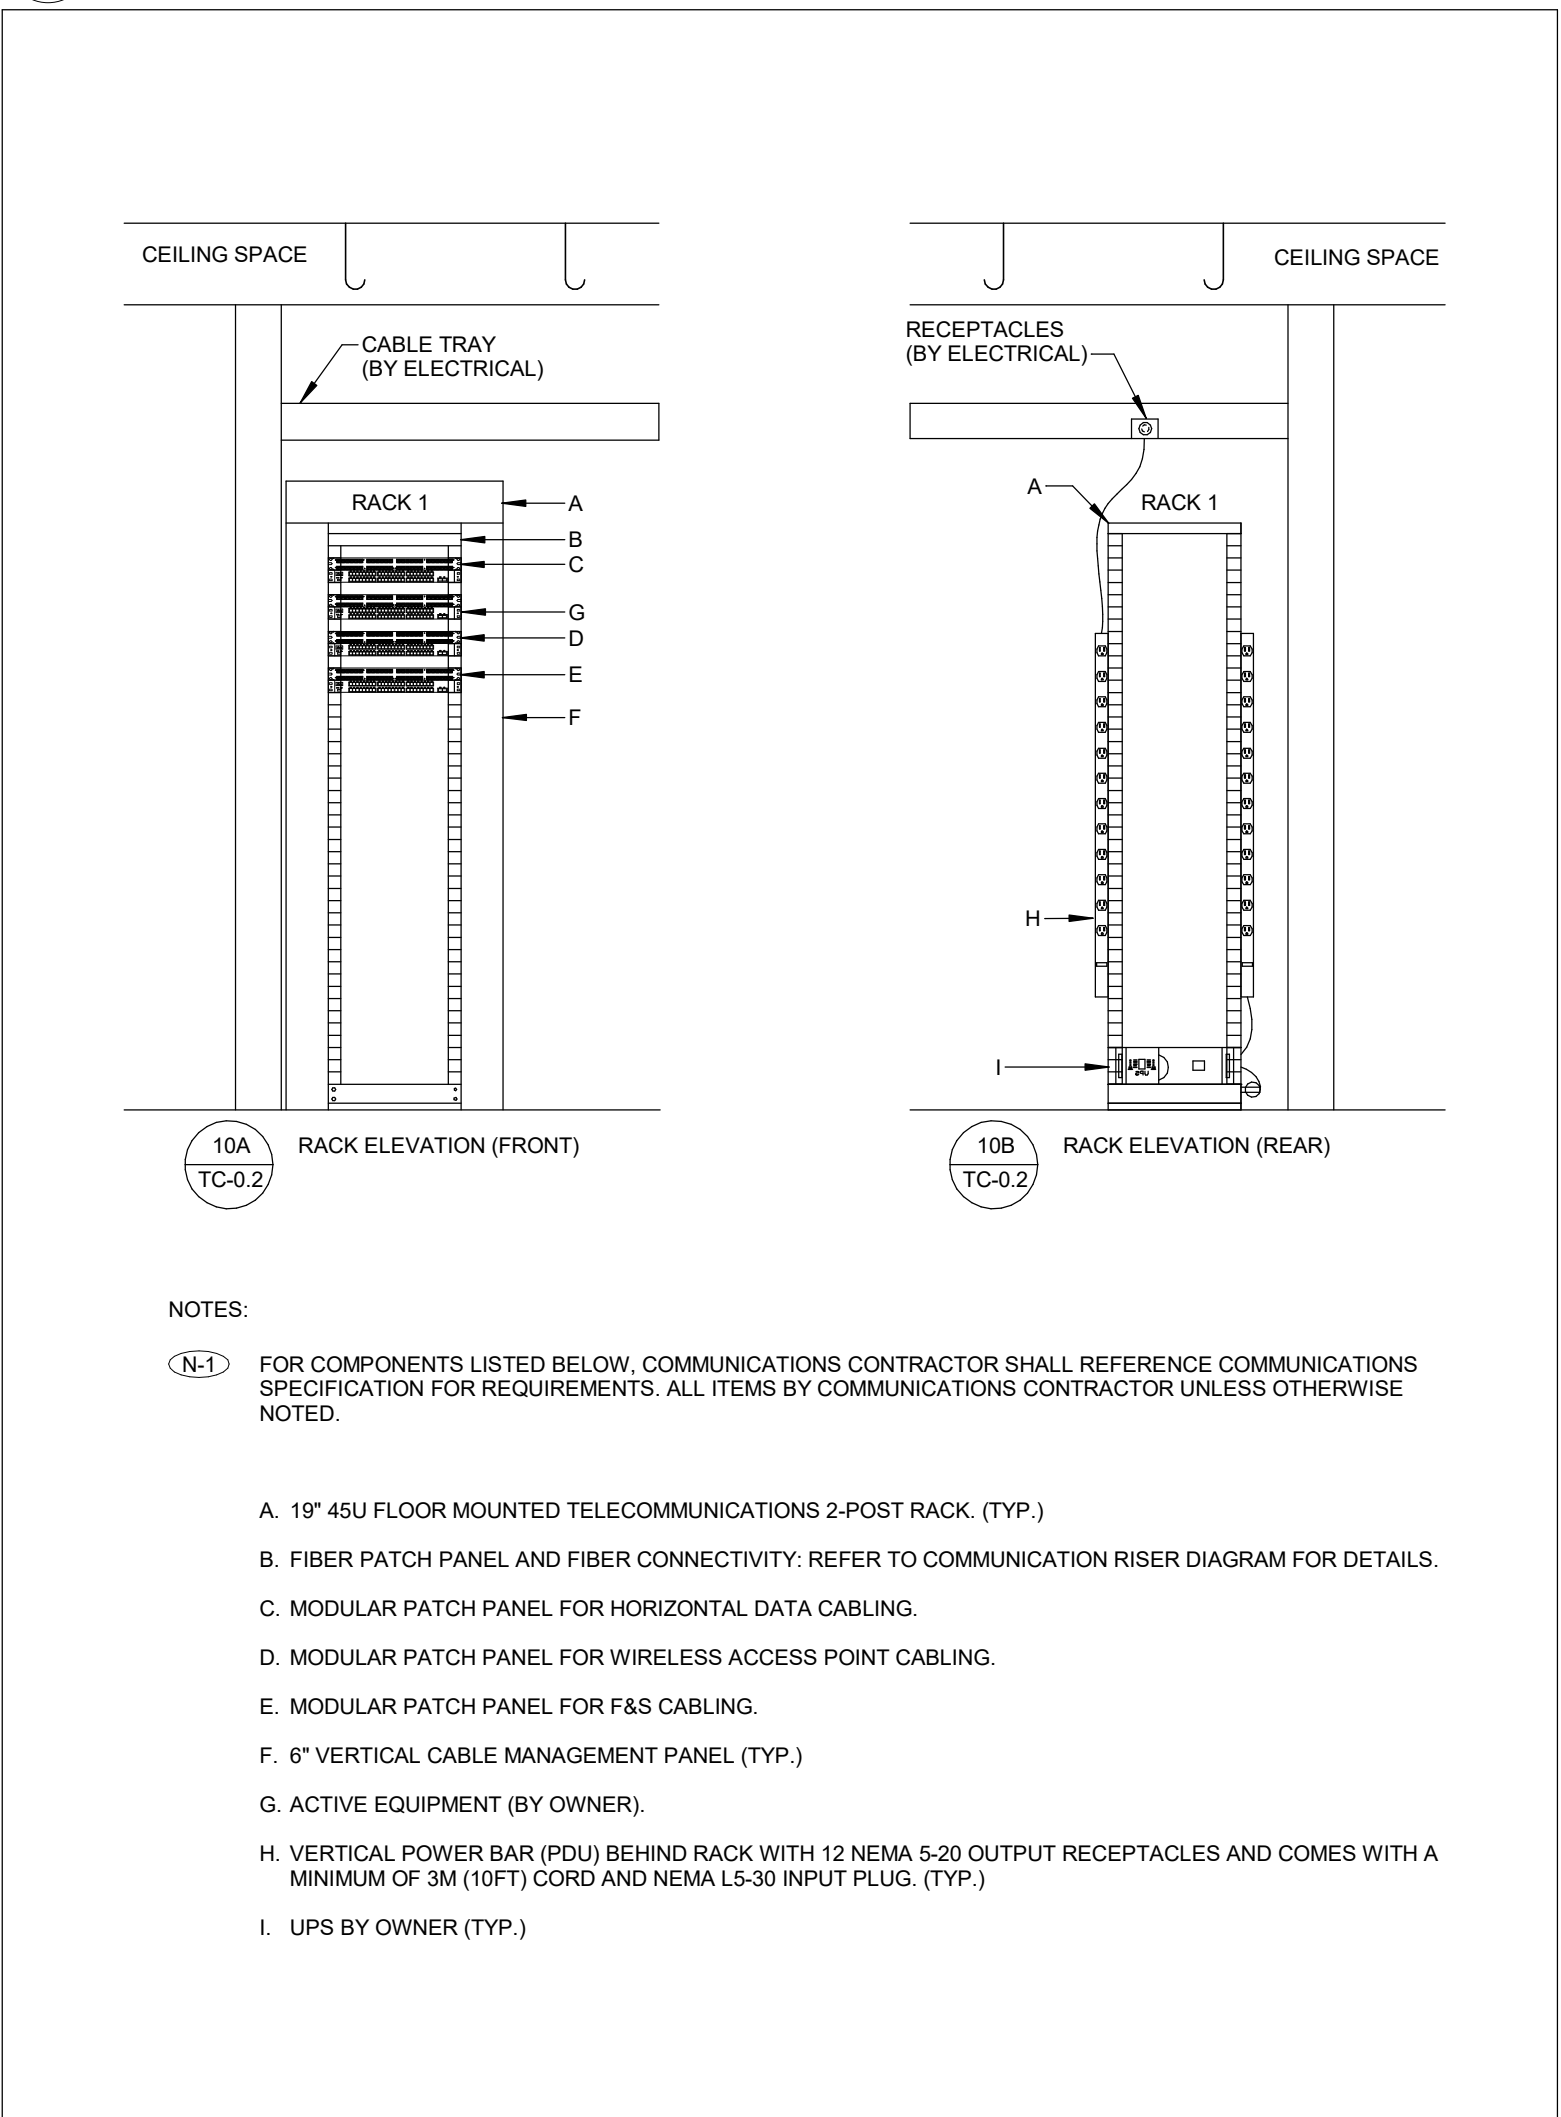


11 LEVEL 03 COMMUNICATIONS RACK ELEVATION DETAIL - I.T. 327 CLOSET
TC-0.2 NTS

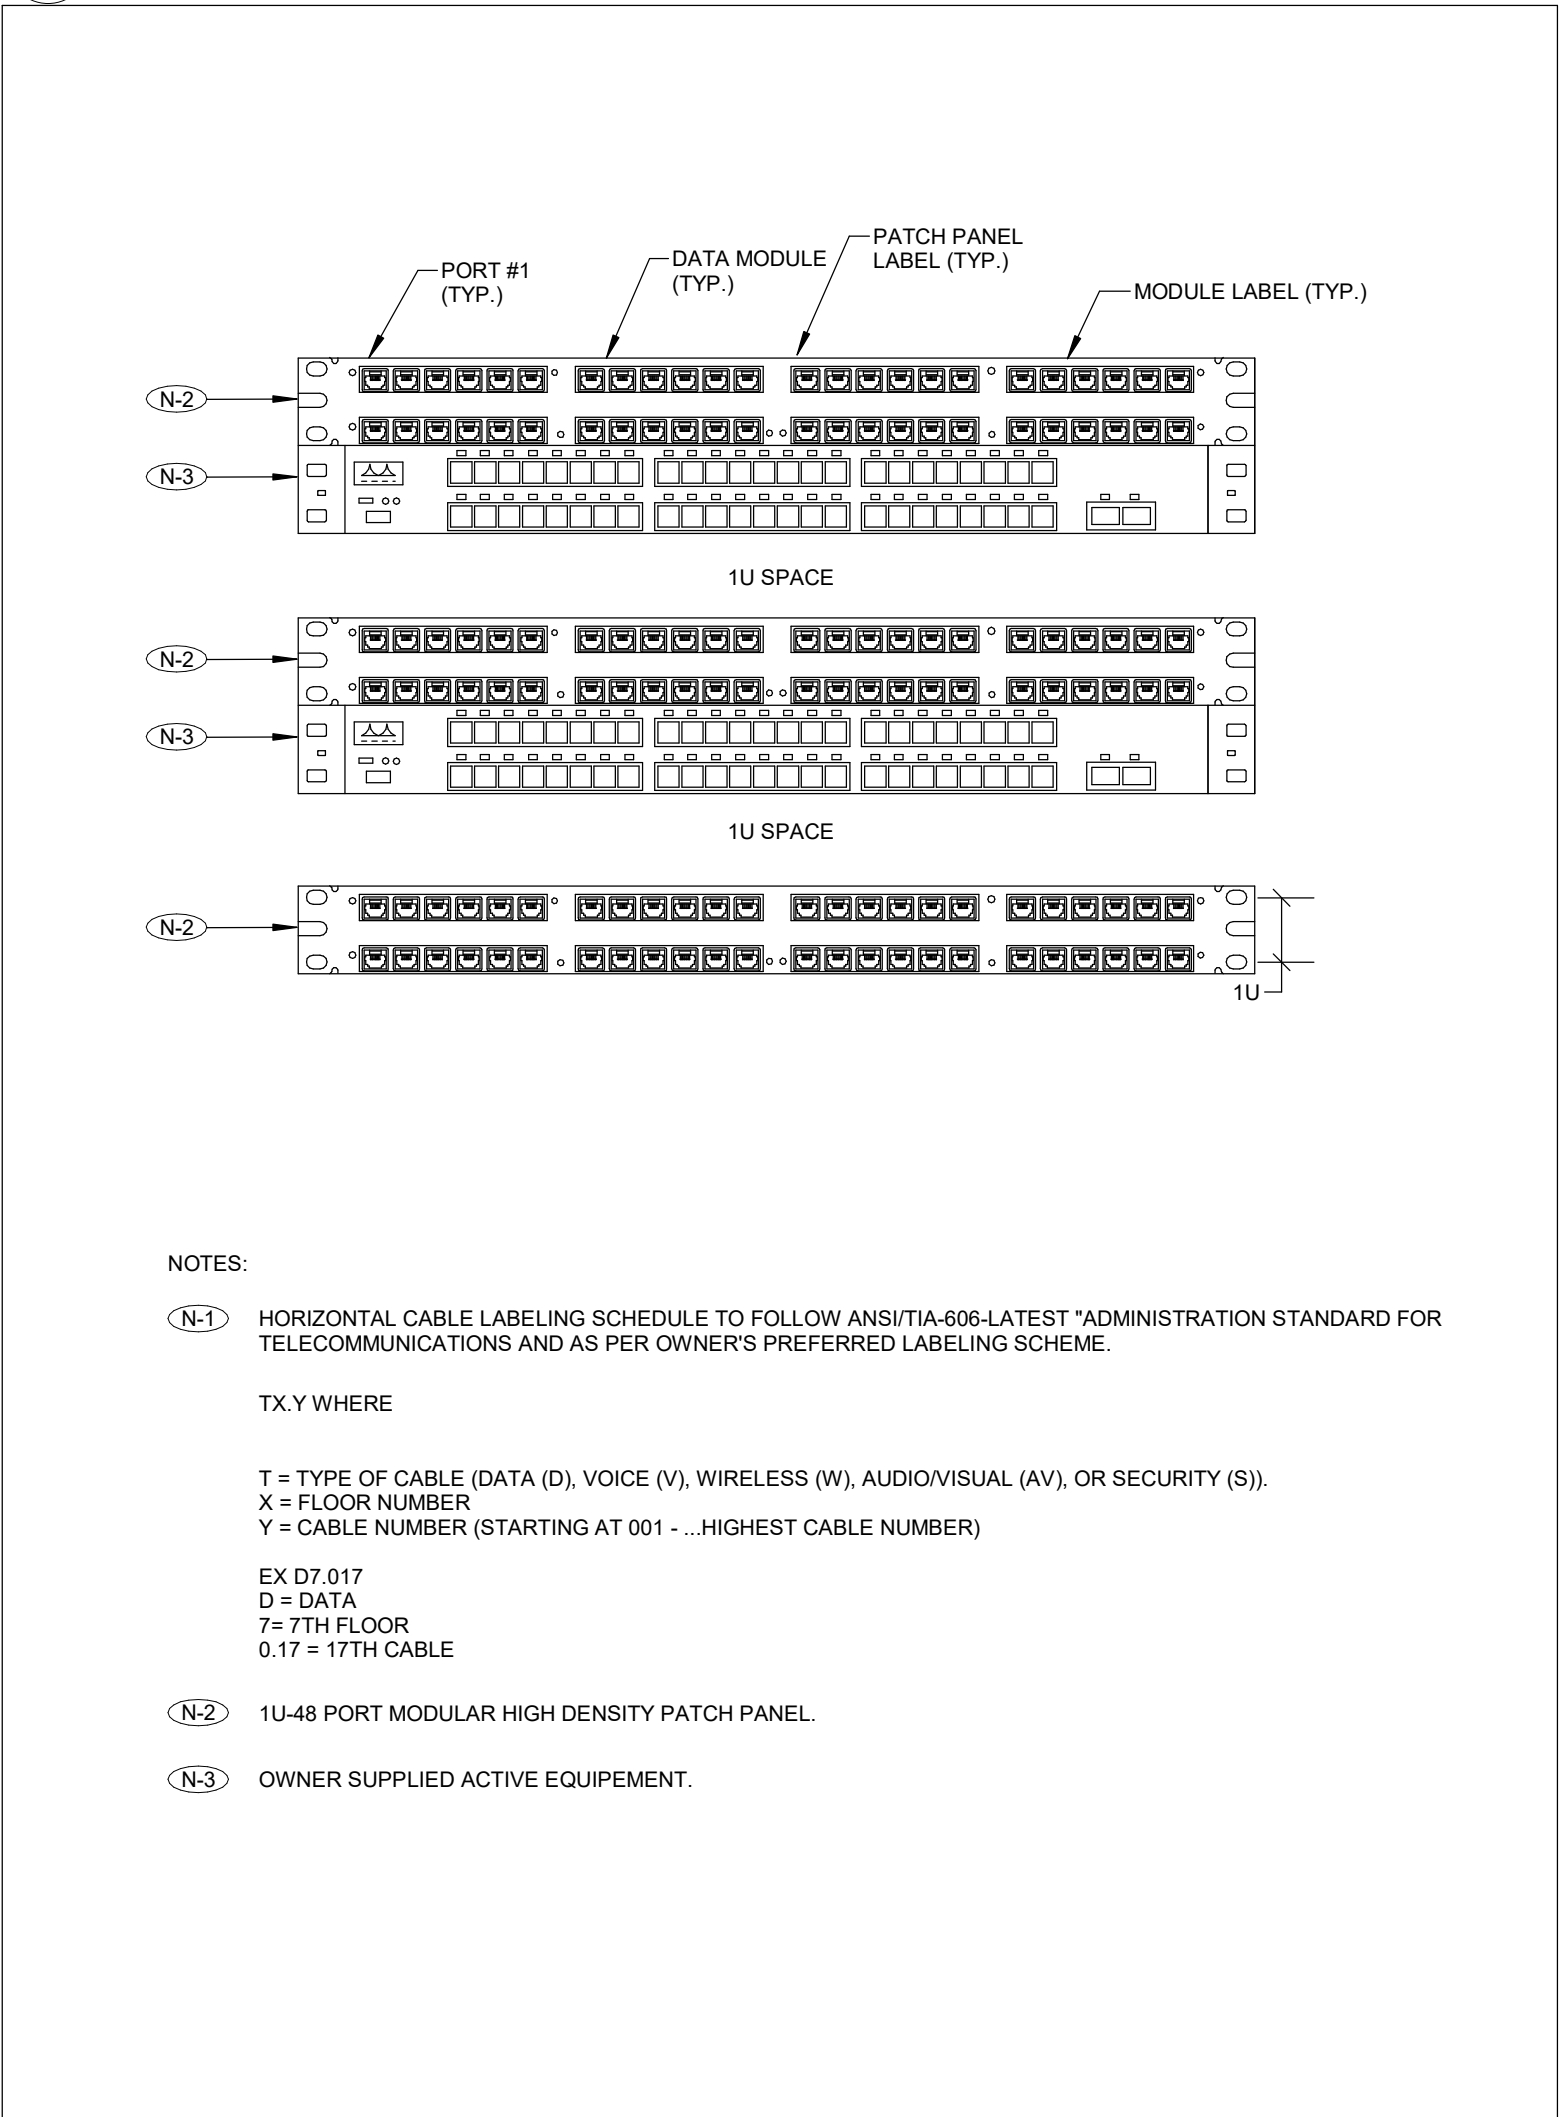


12 COMMUNICATIONS MODULAR PATCH PANEL STACKING DETAIL
TC-0.2 NTS

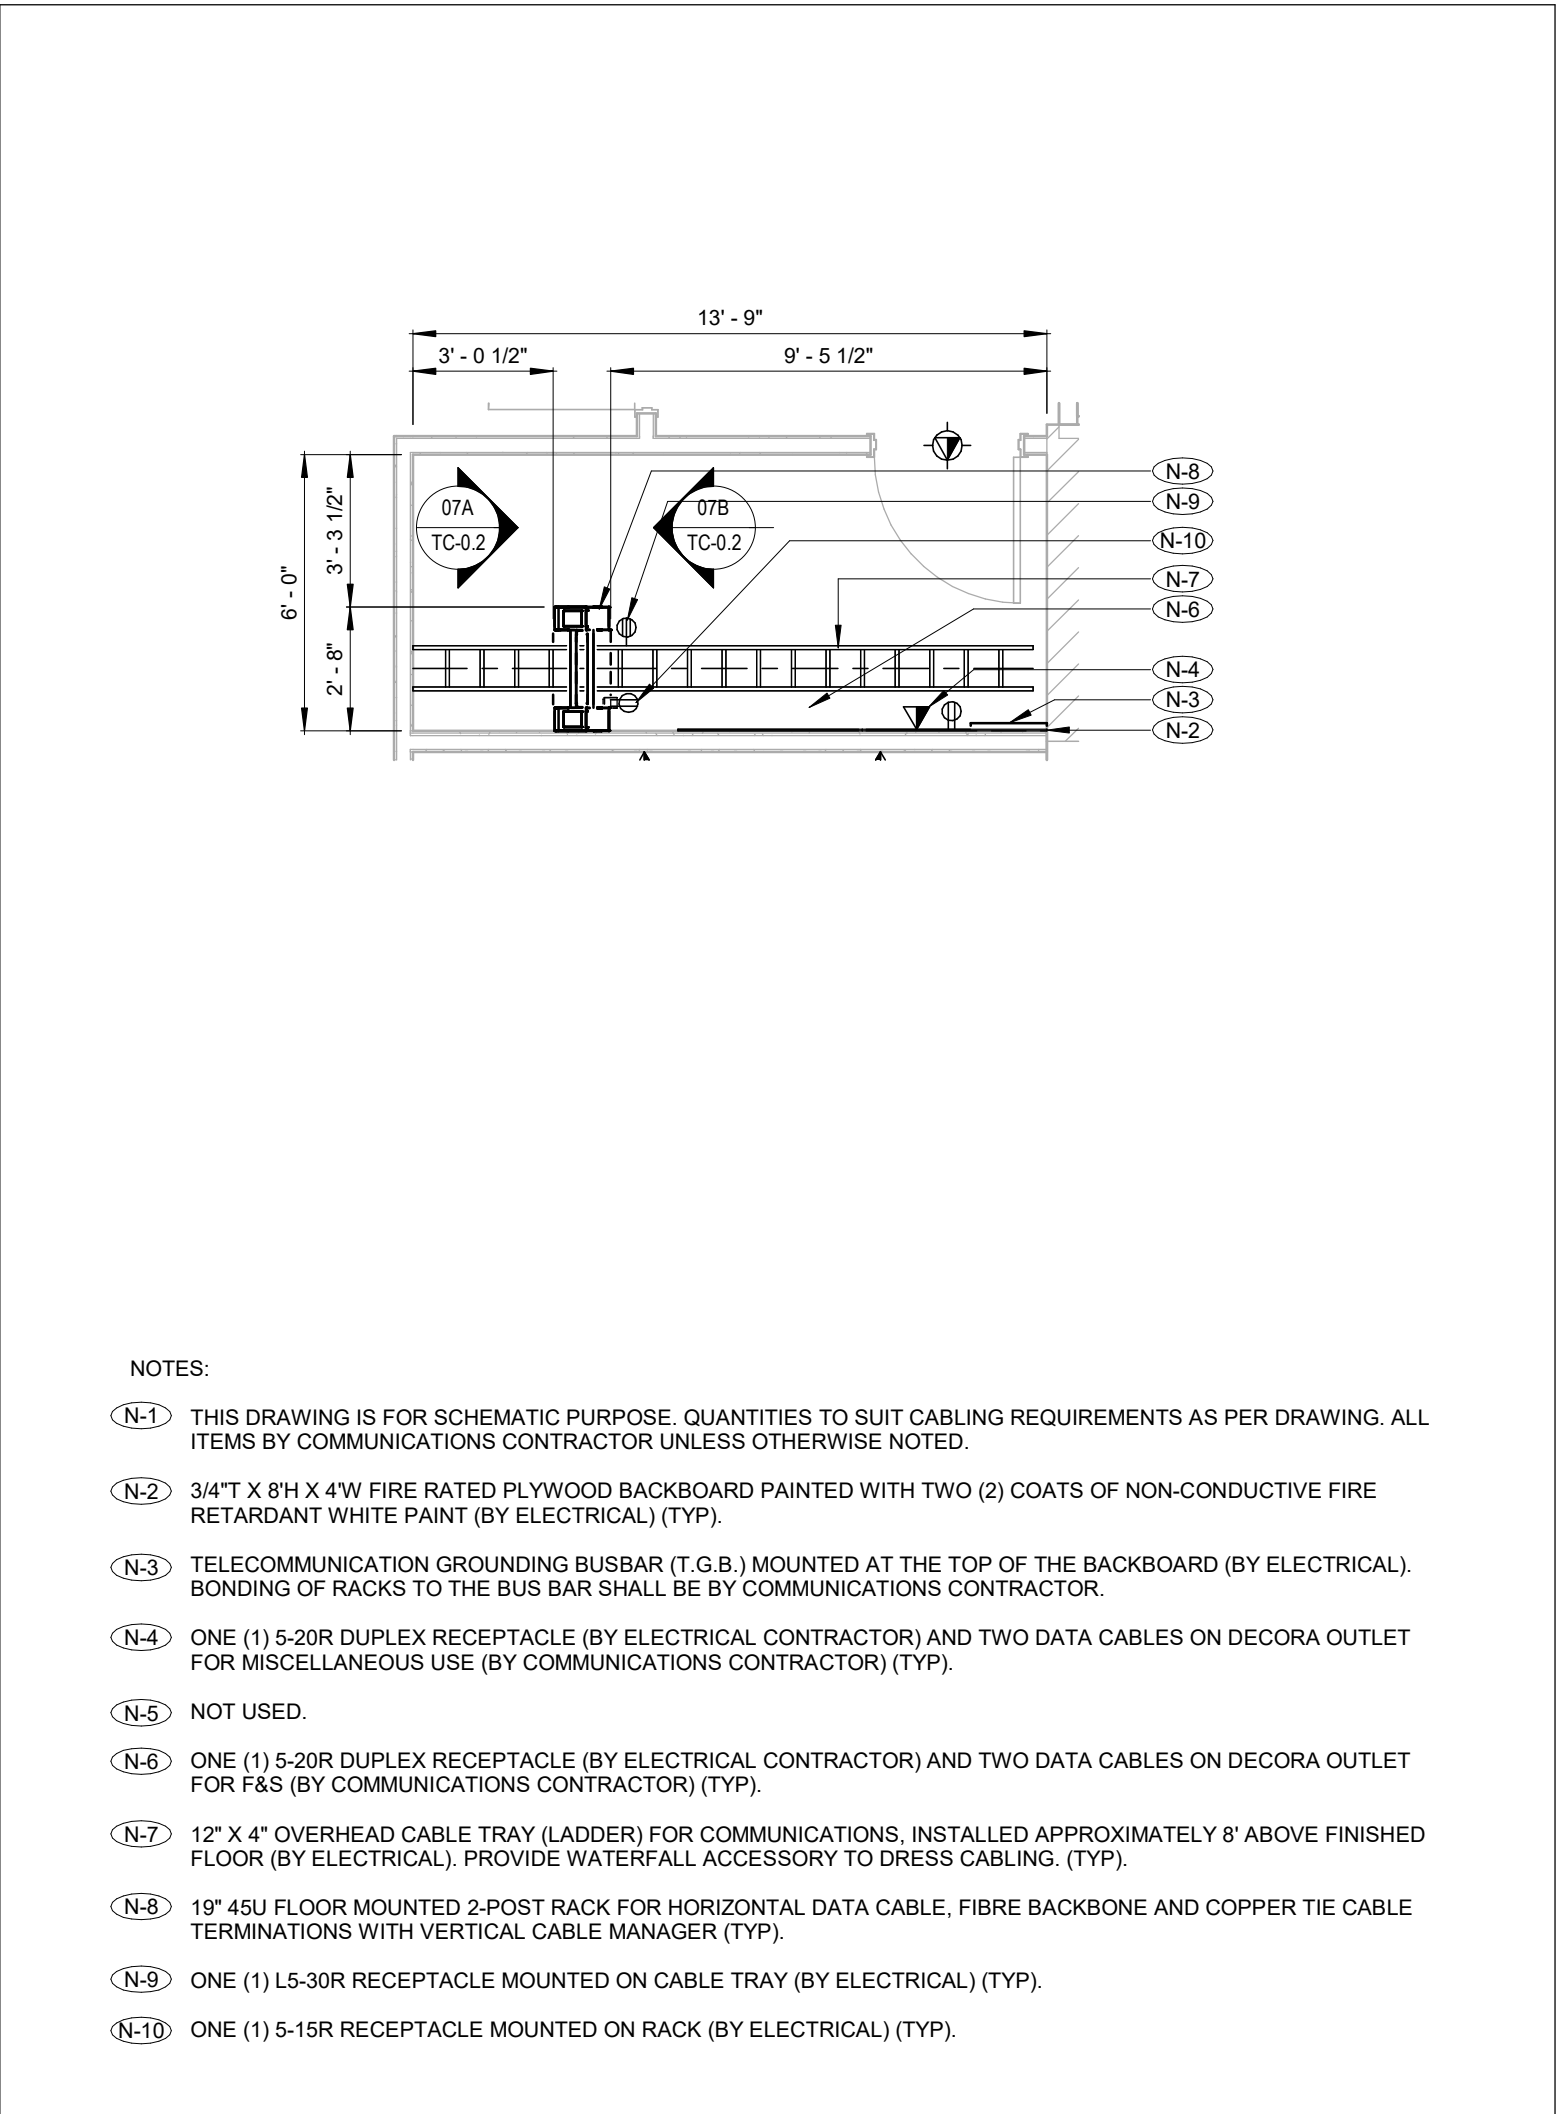


7 I.T. CLOSET 277 PLAN DETAIL
TC-0.2 1:50

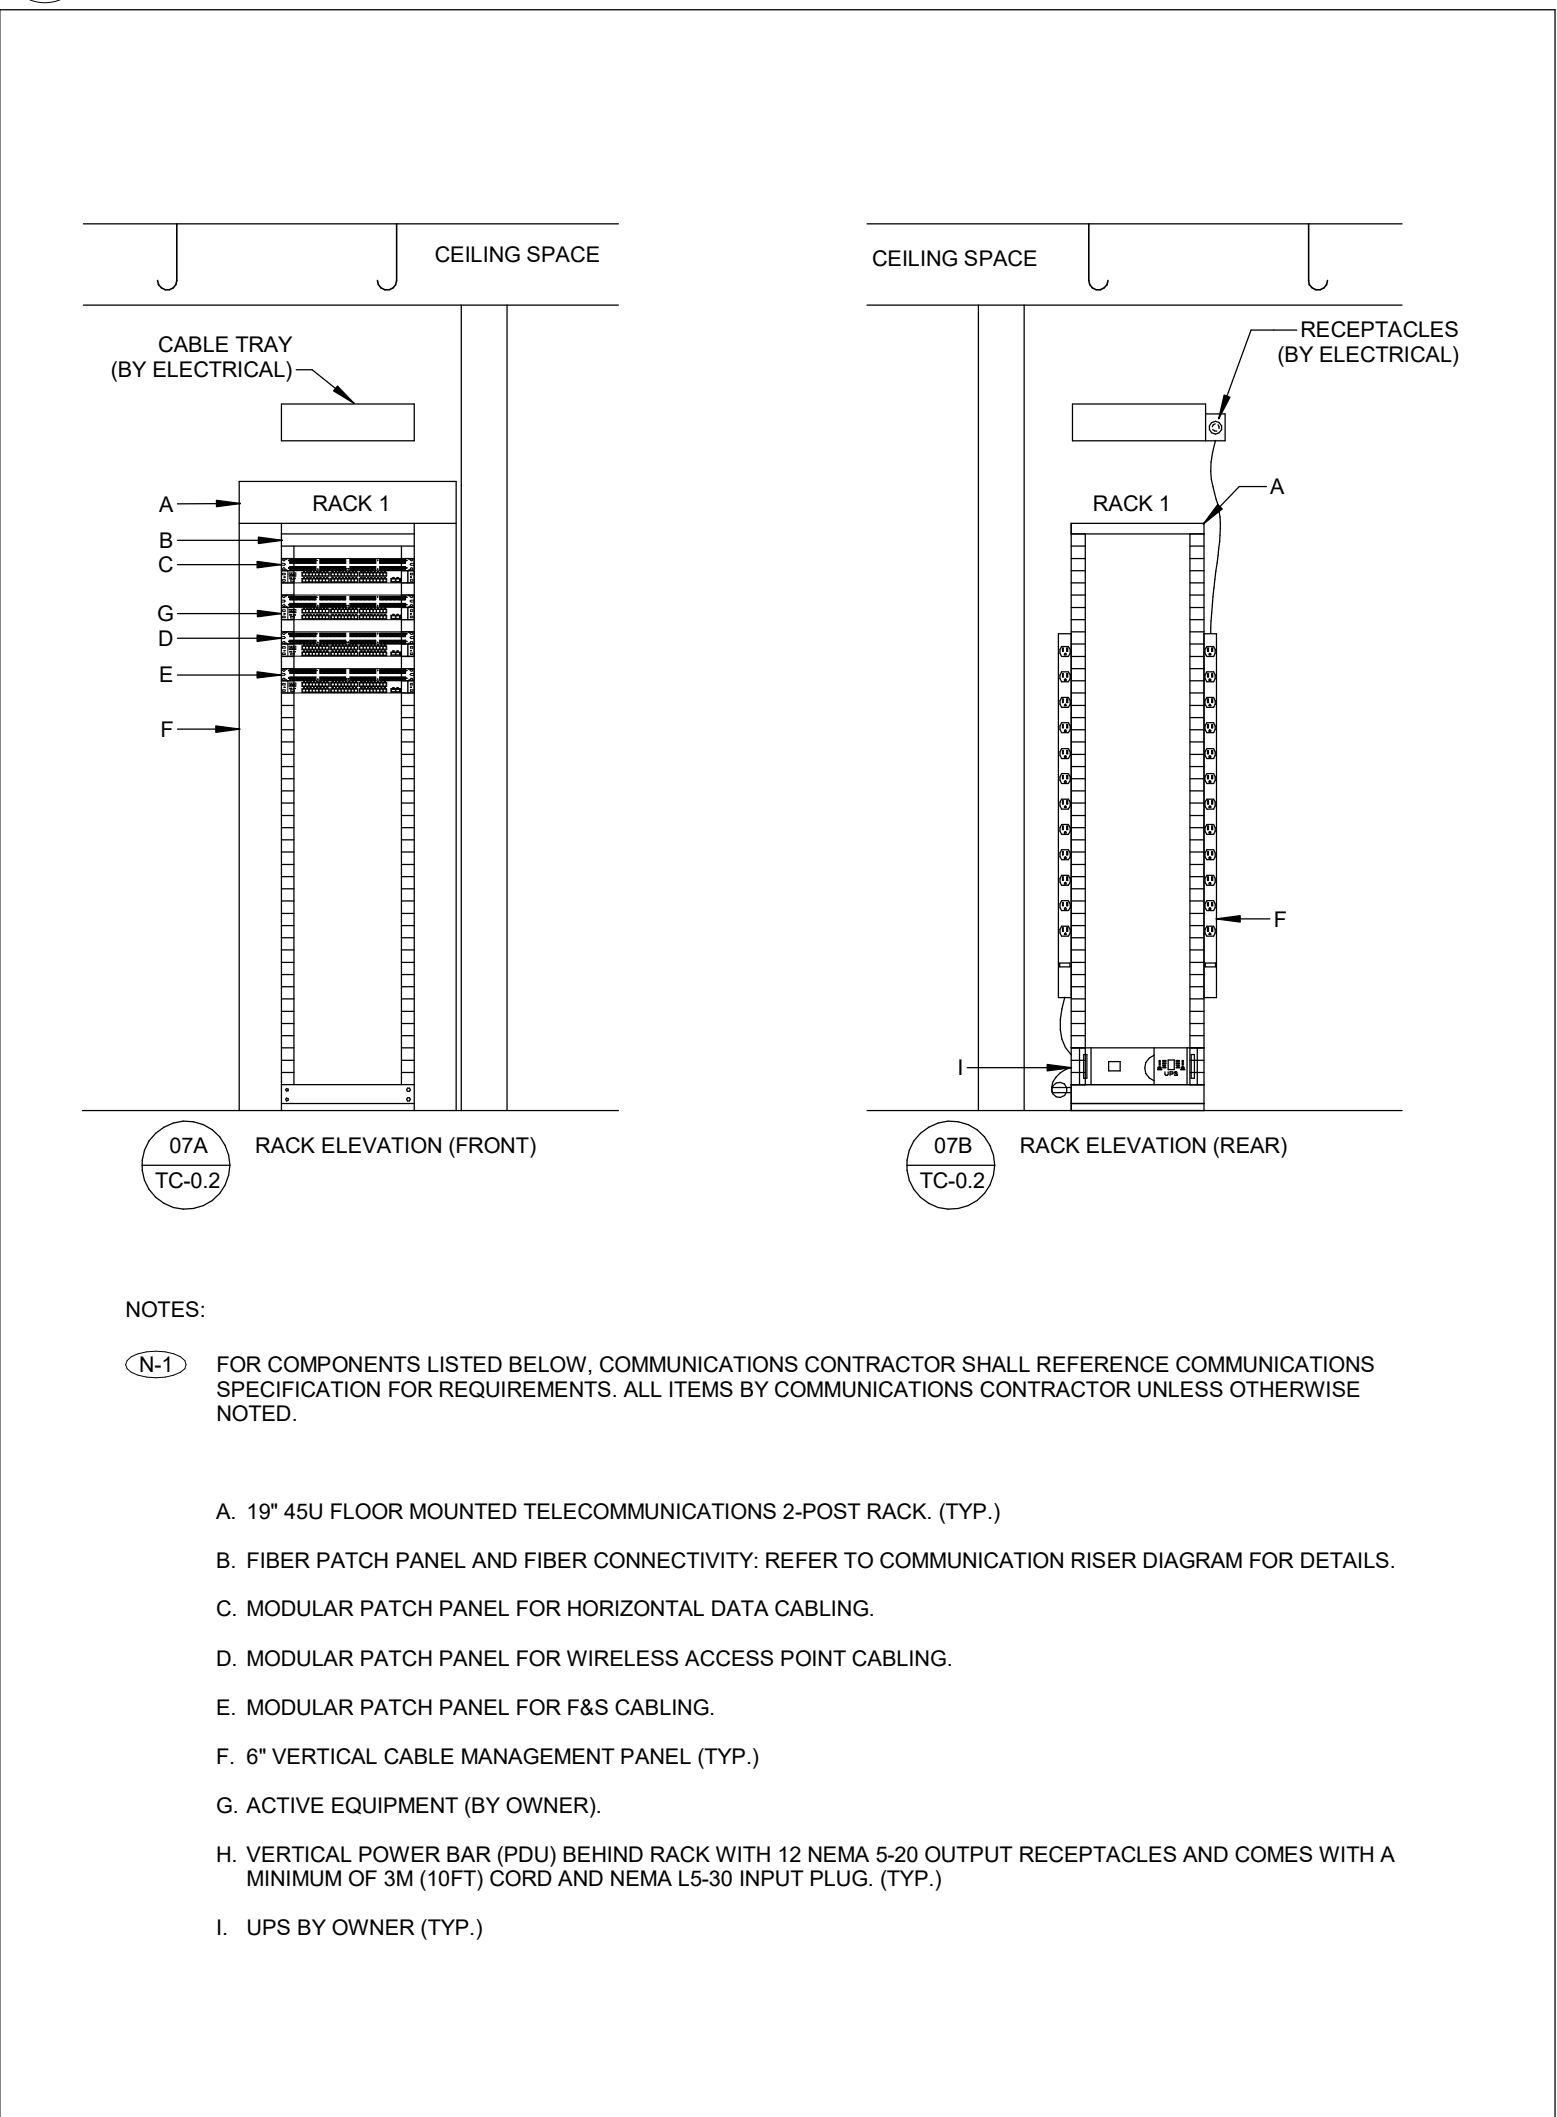


8 LEVEL 02 COMMUNICATIONS RACK ELEVATION DETAIL - I.T. 277 CLOSET
TC-0.2 NTS

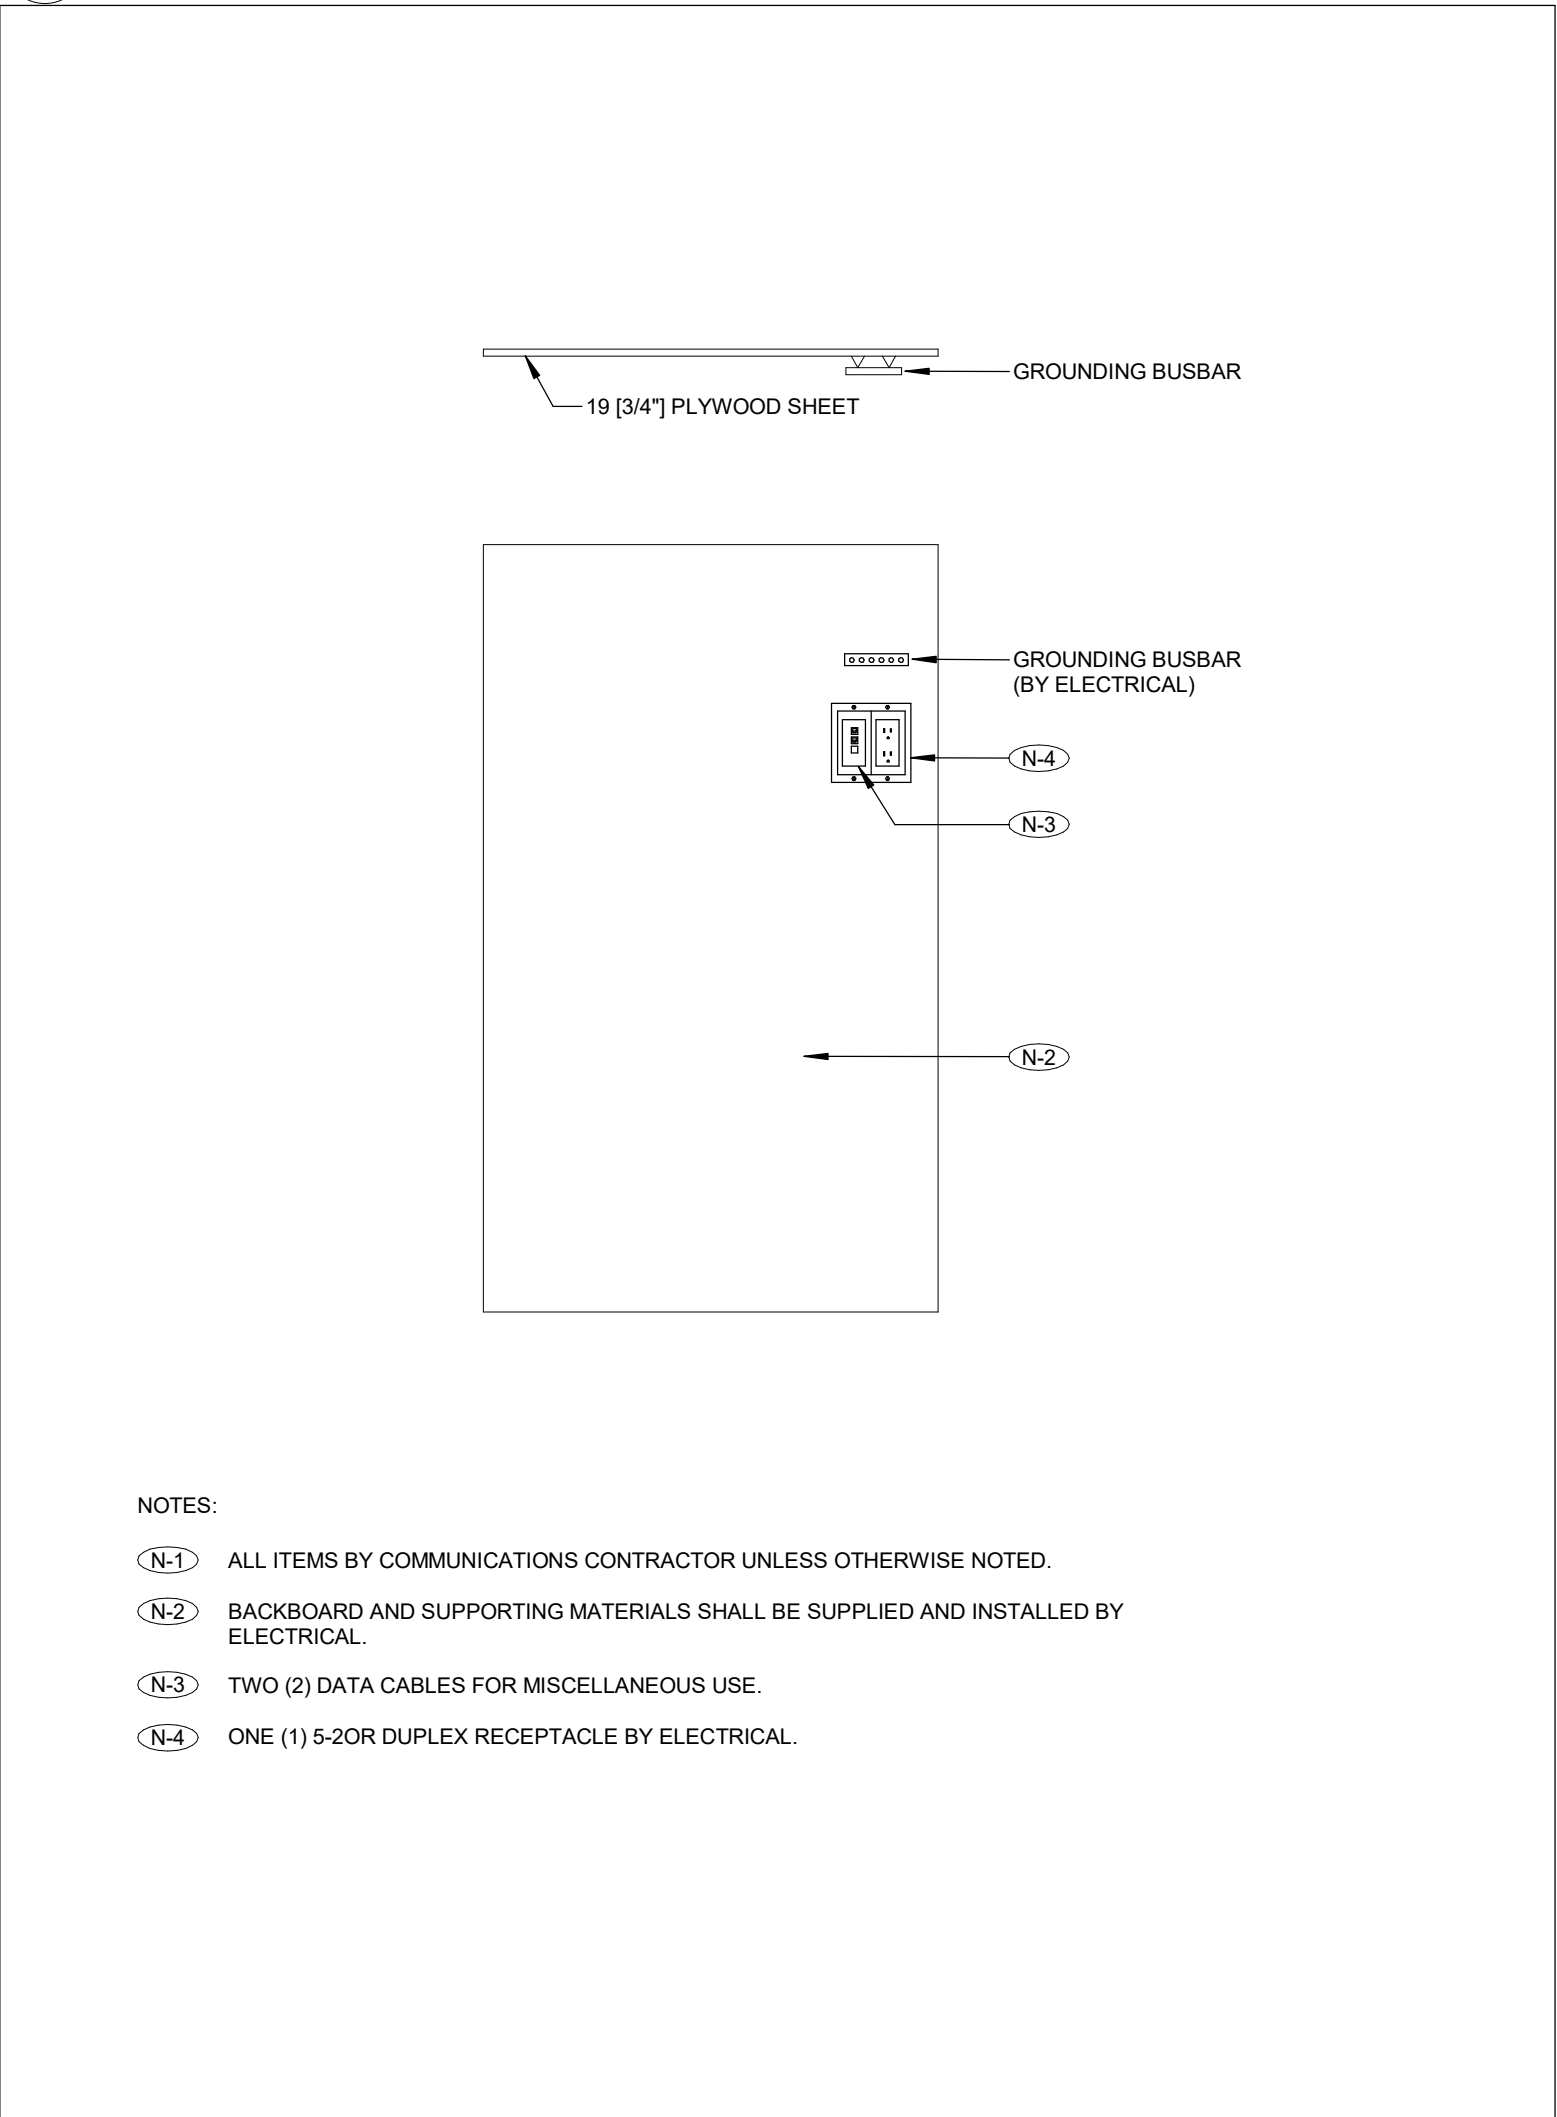


9 COMMUNICATIONS BACKBOARD ELEVATION DETAIL
TC-0.2 NTS

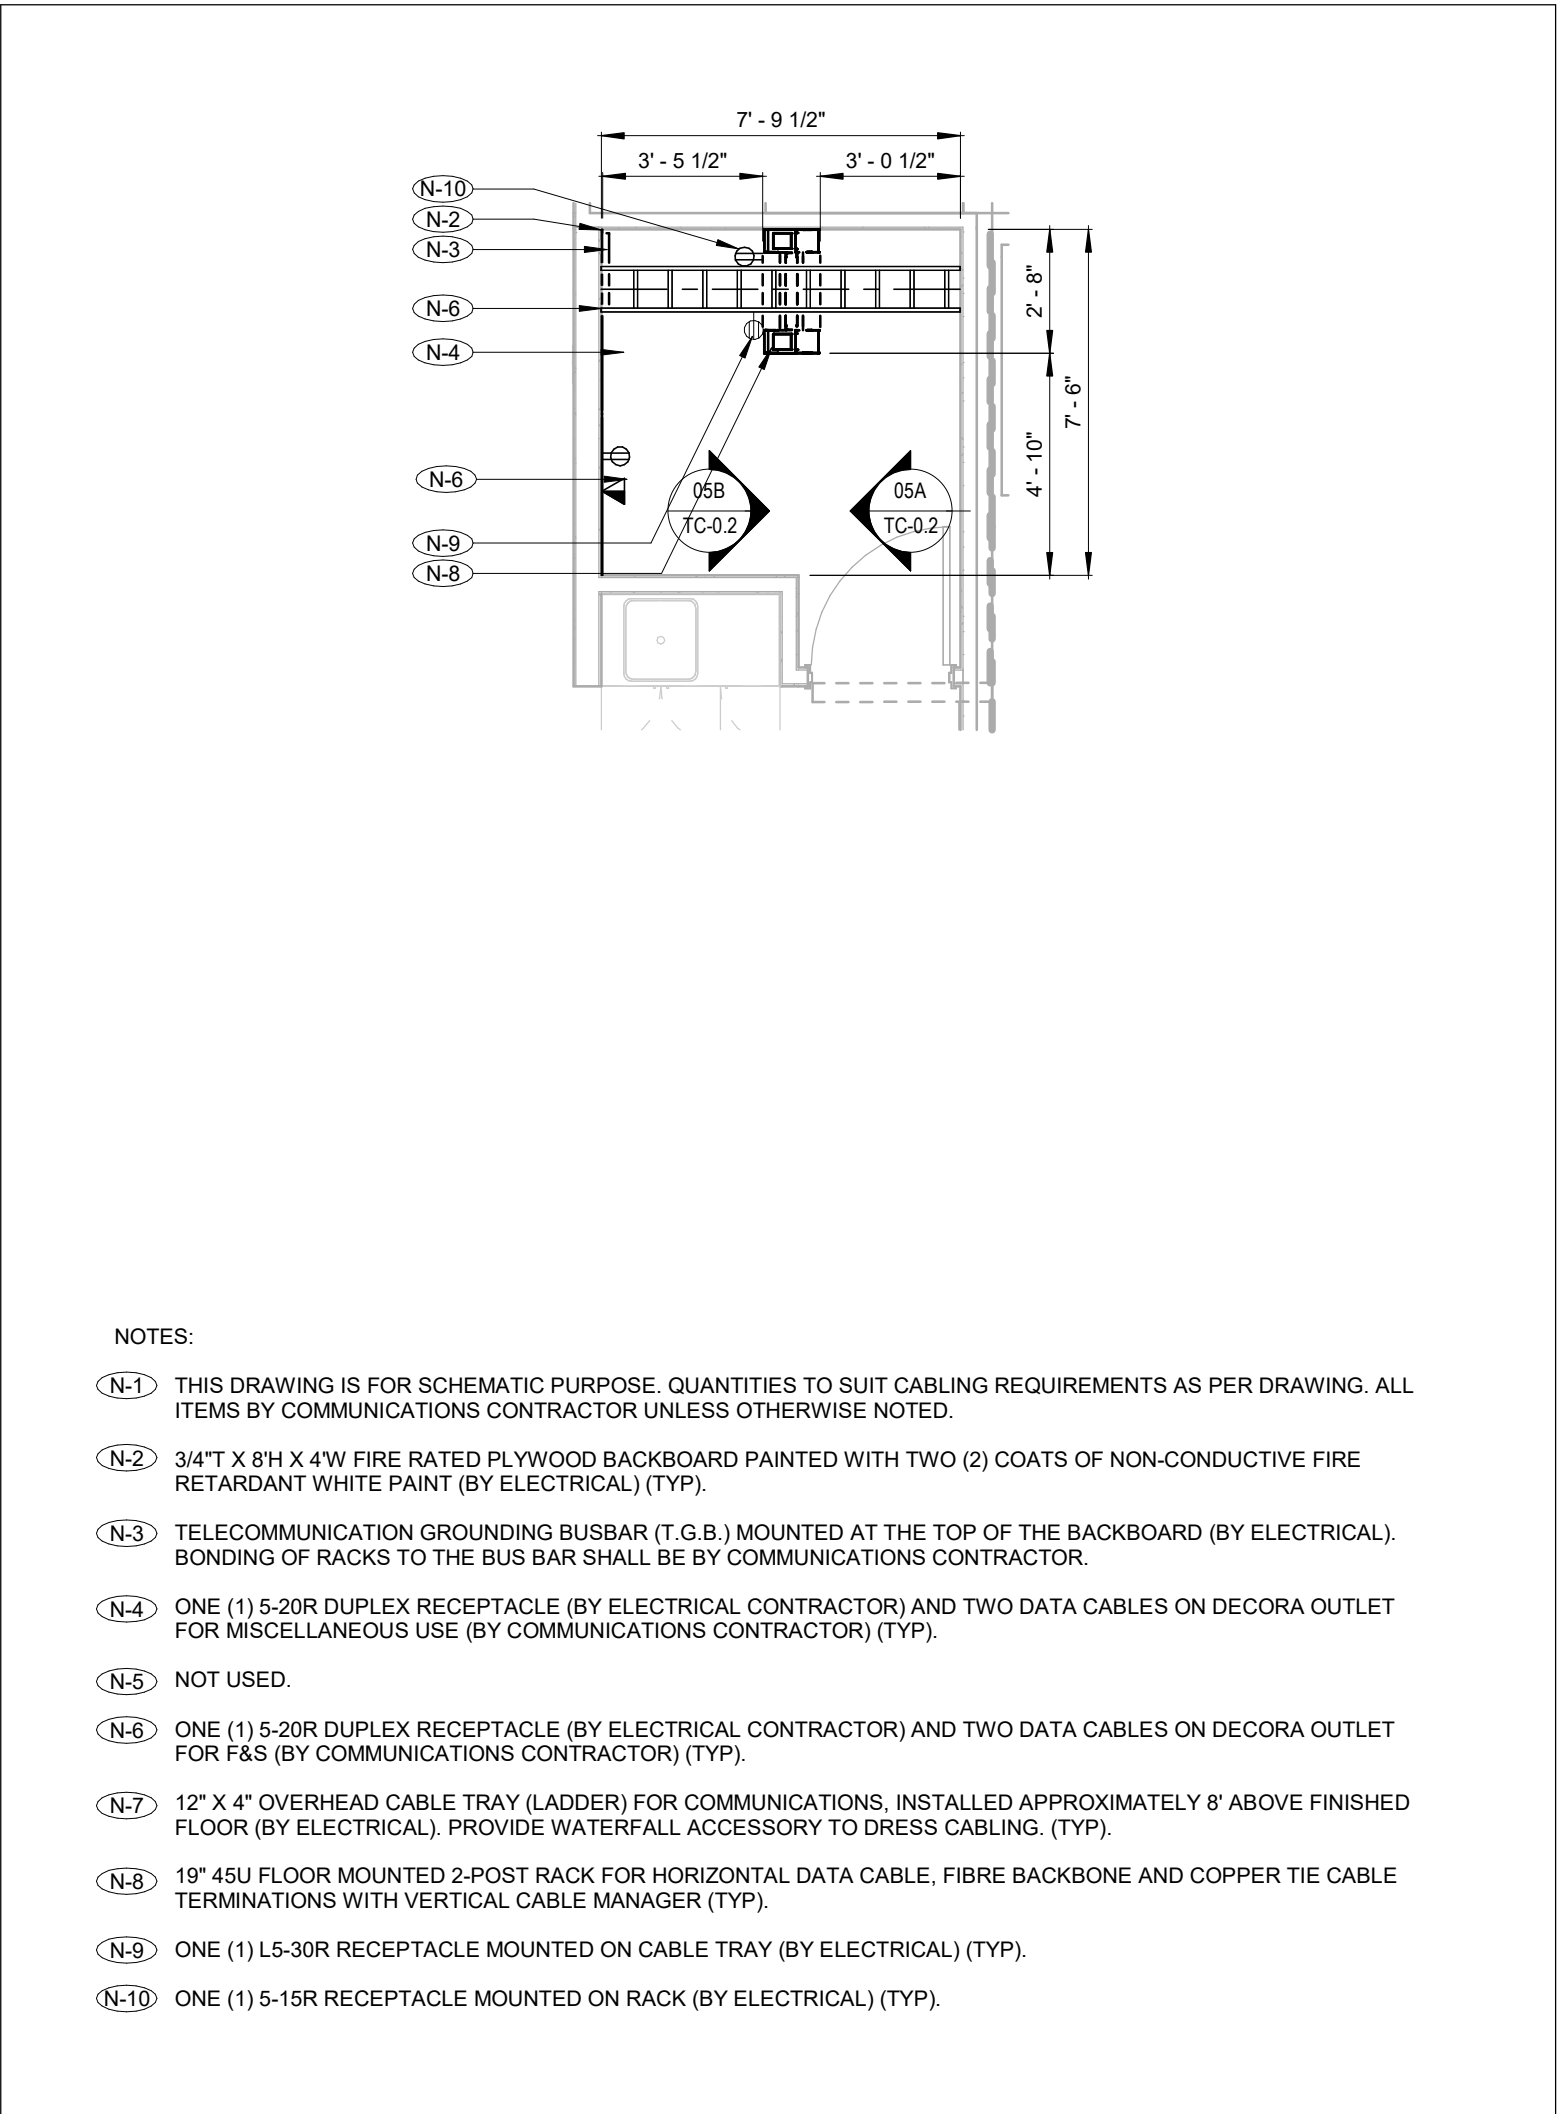


4 I.T. CLOSET 238 PLAN DETAIL
TC-0.2 1:50

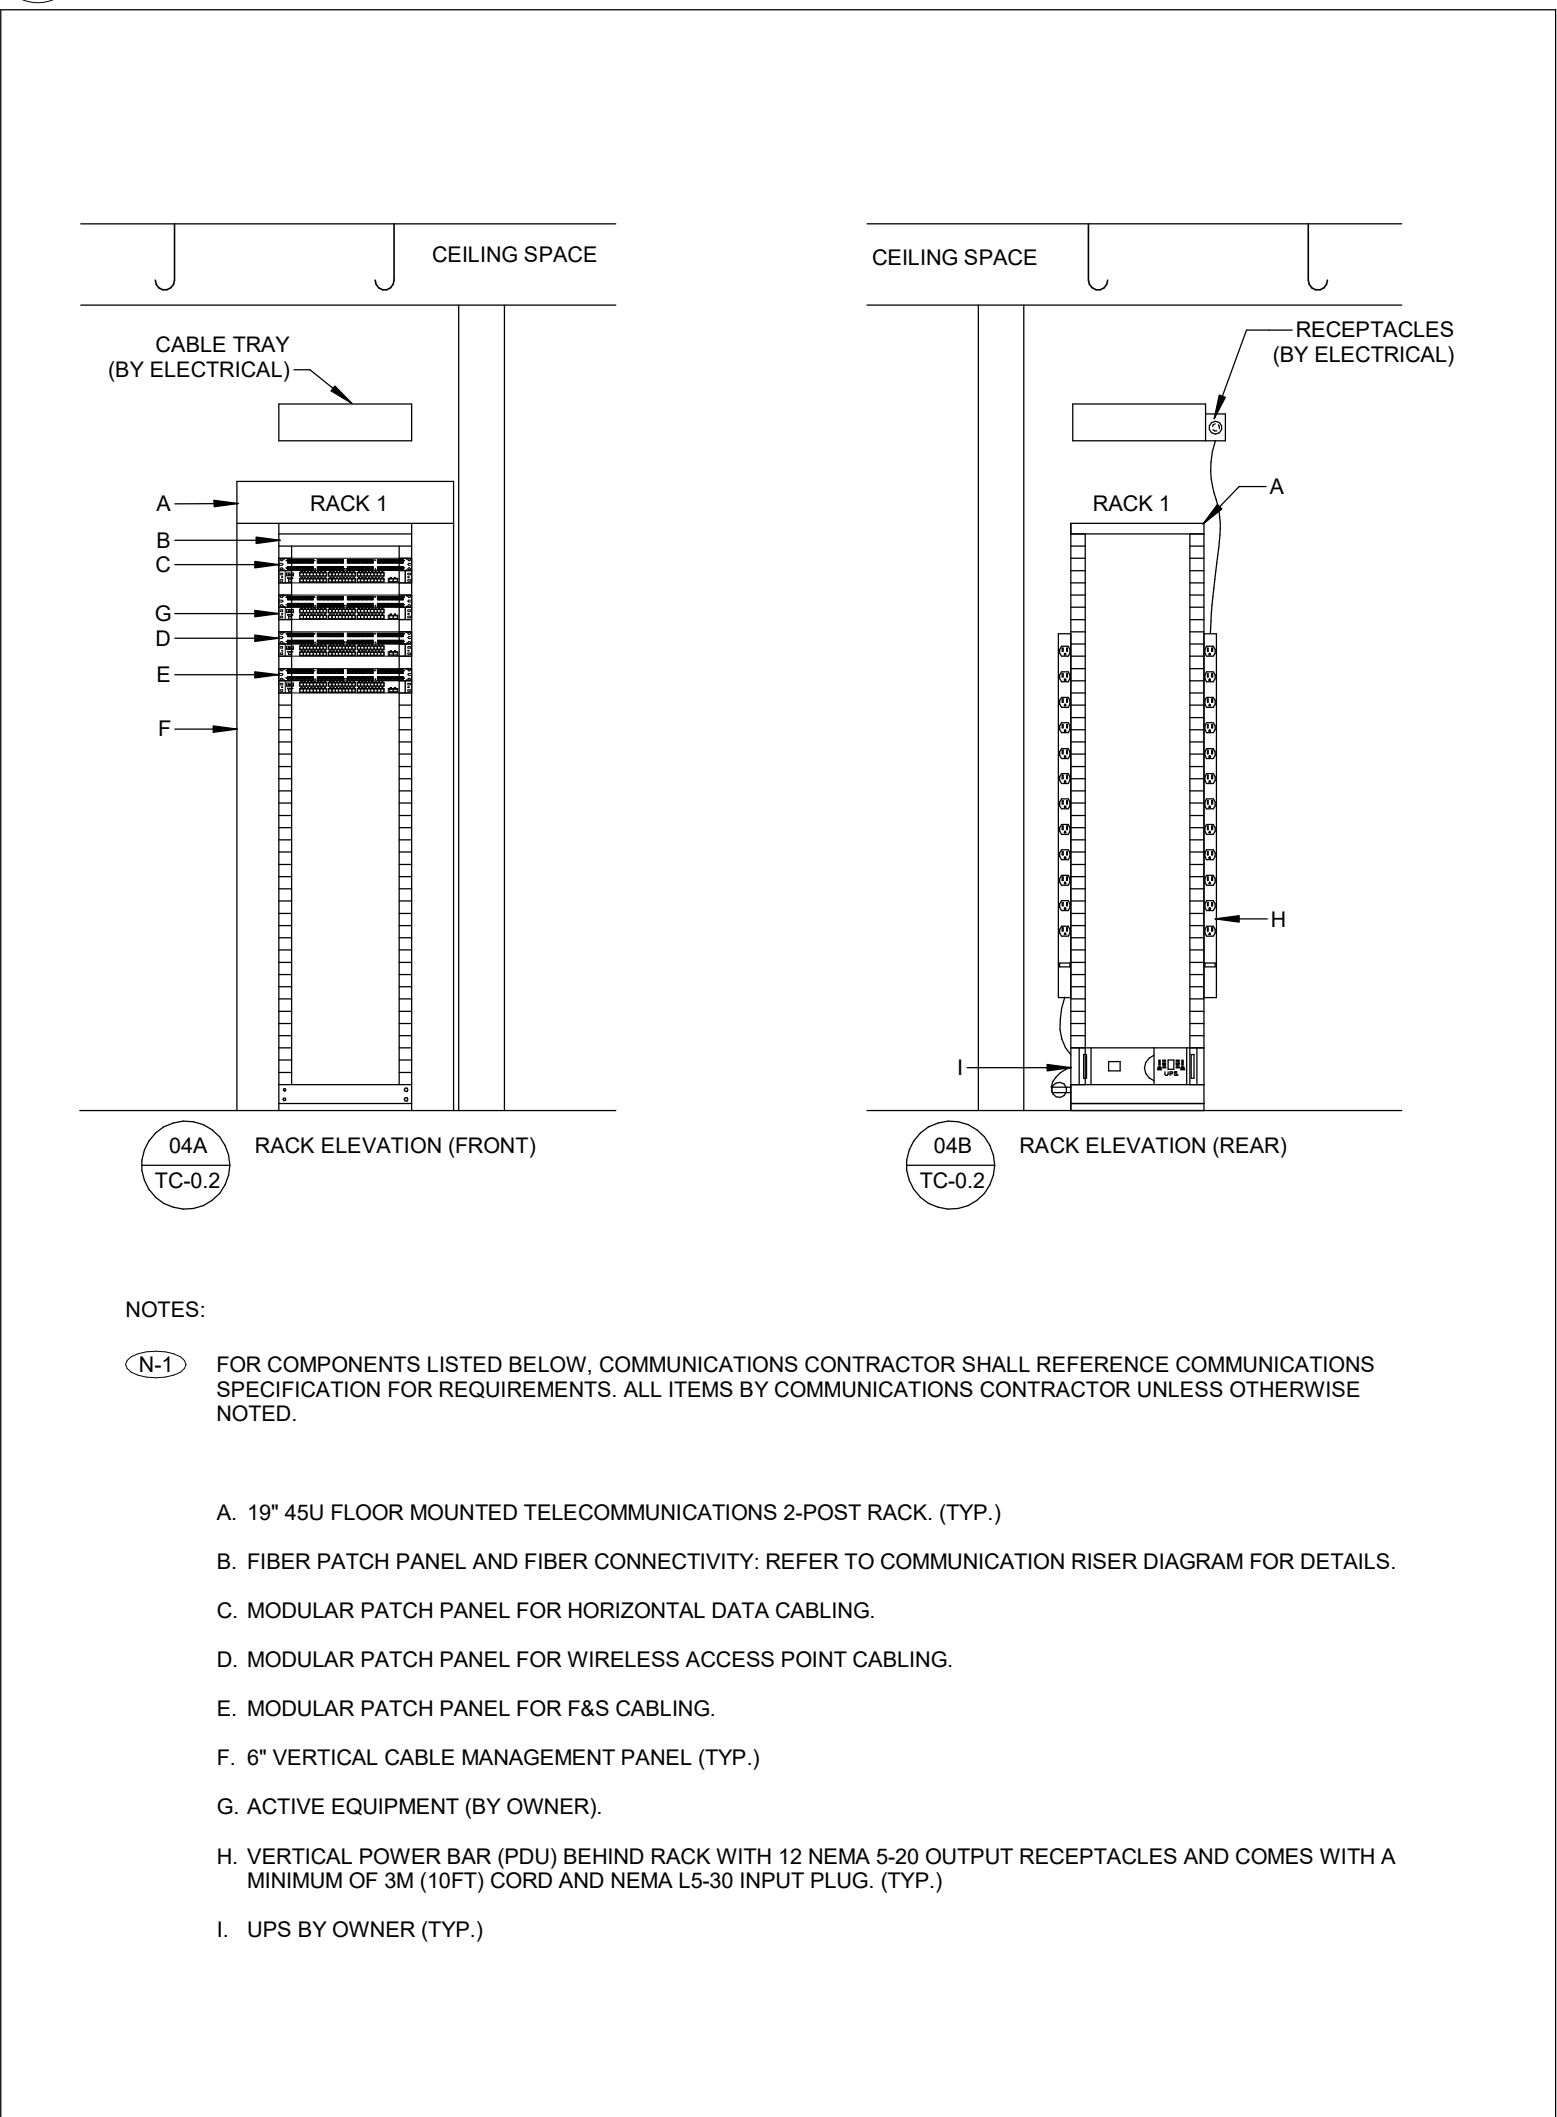


5 LEVEL 02 COMMUNICATIONS RACK ELEVATION DETAIL - I.T. 238 CLOSET
TC-0.2 NTS

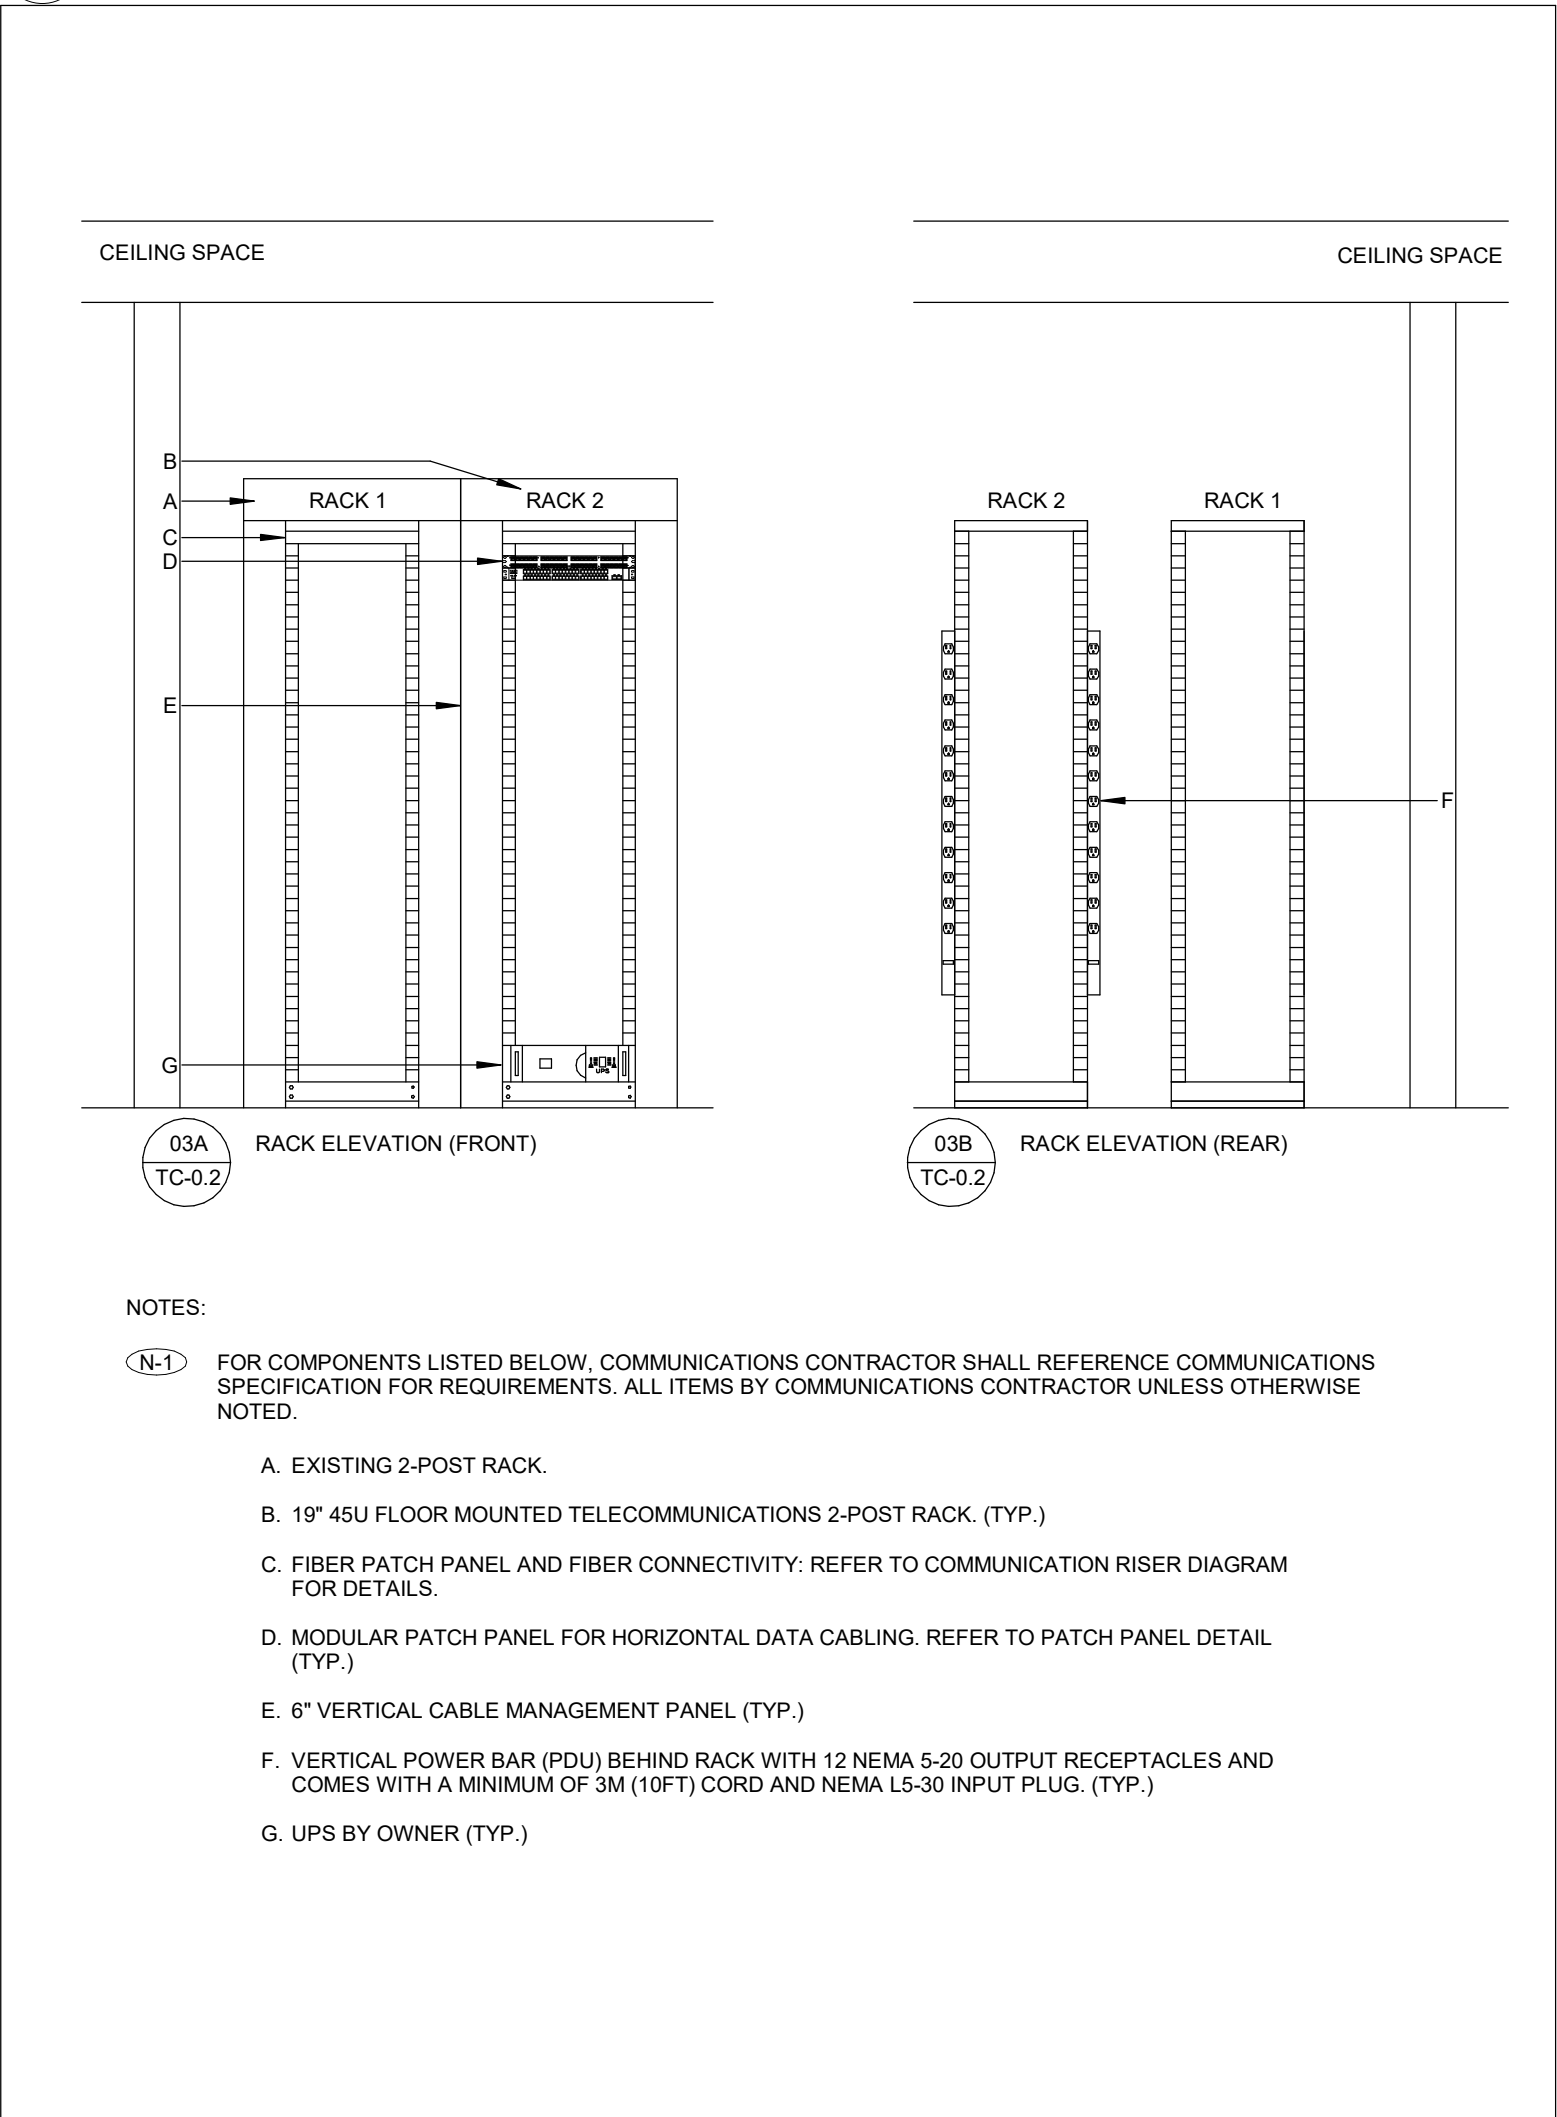


6 LEVEL 00 COMMUNICATIONS RACK ELEVATION DETAIL - BASEMENT NETWORK ROOM B15
TC-0.2 NTS

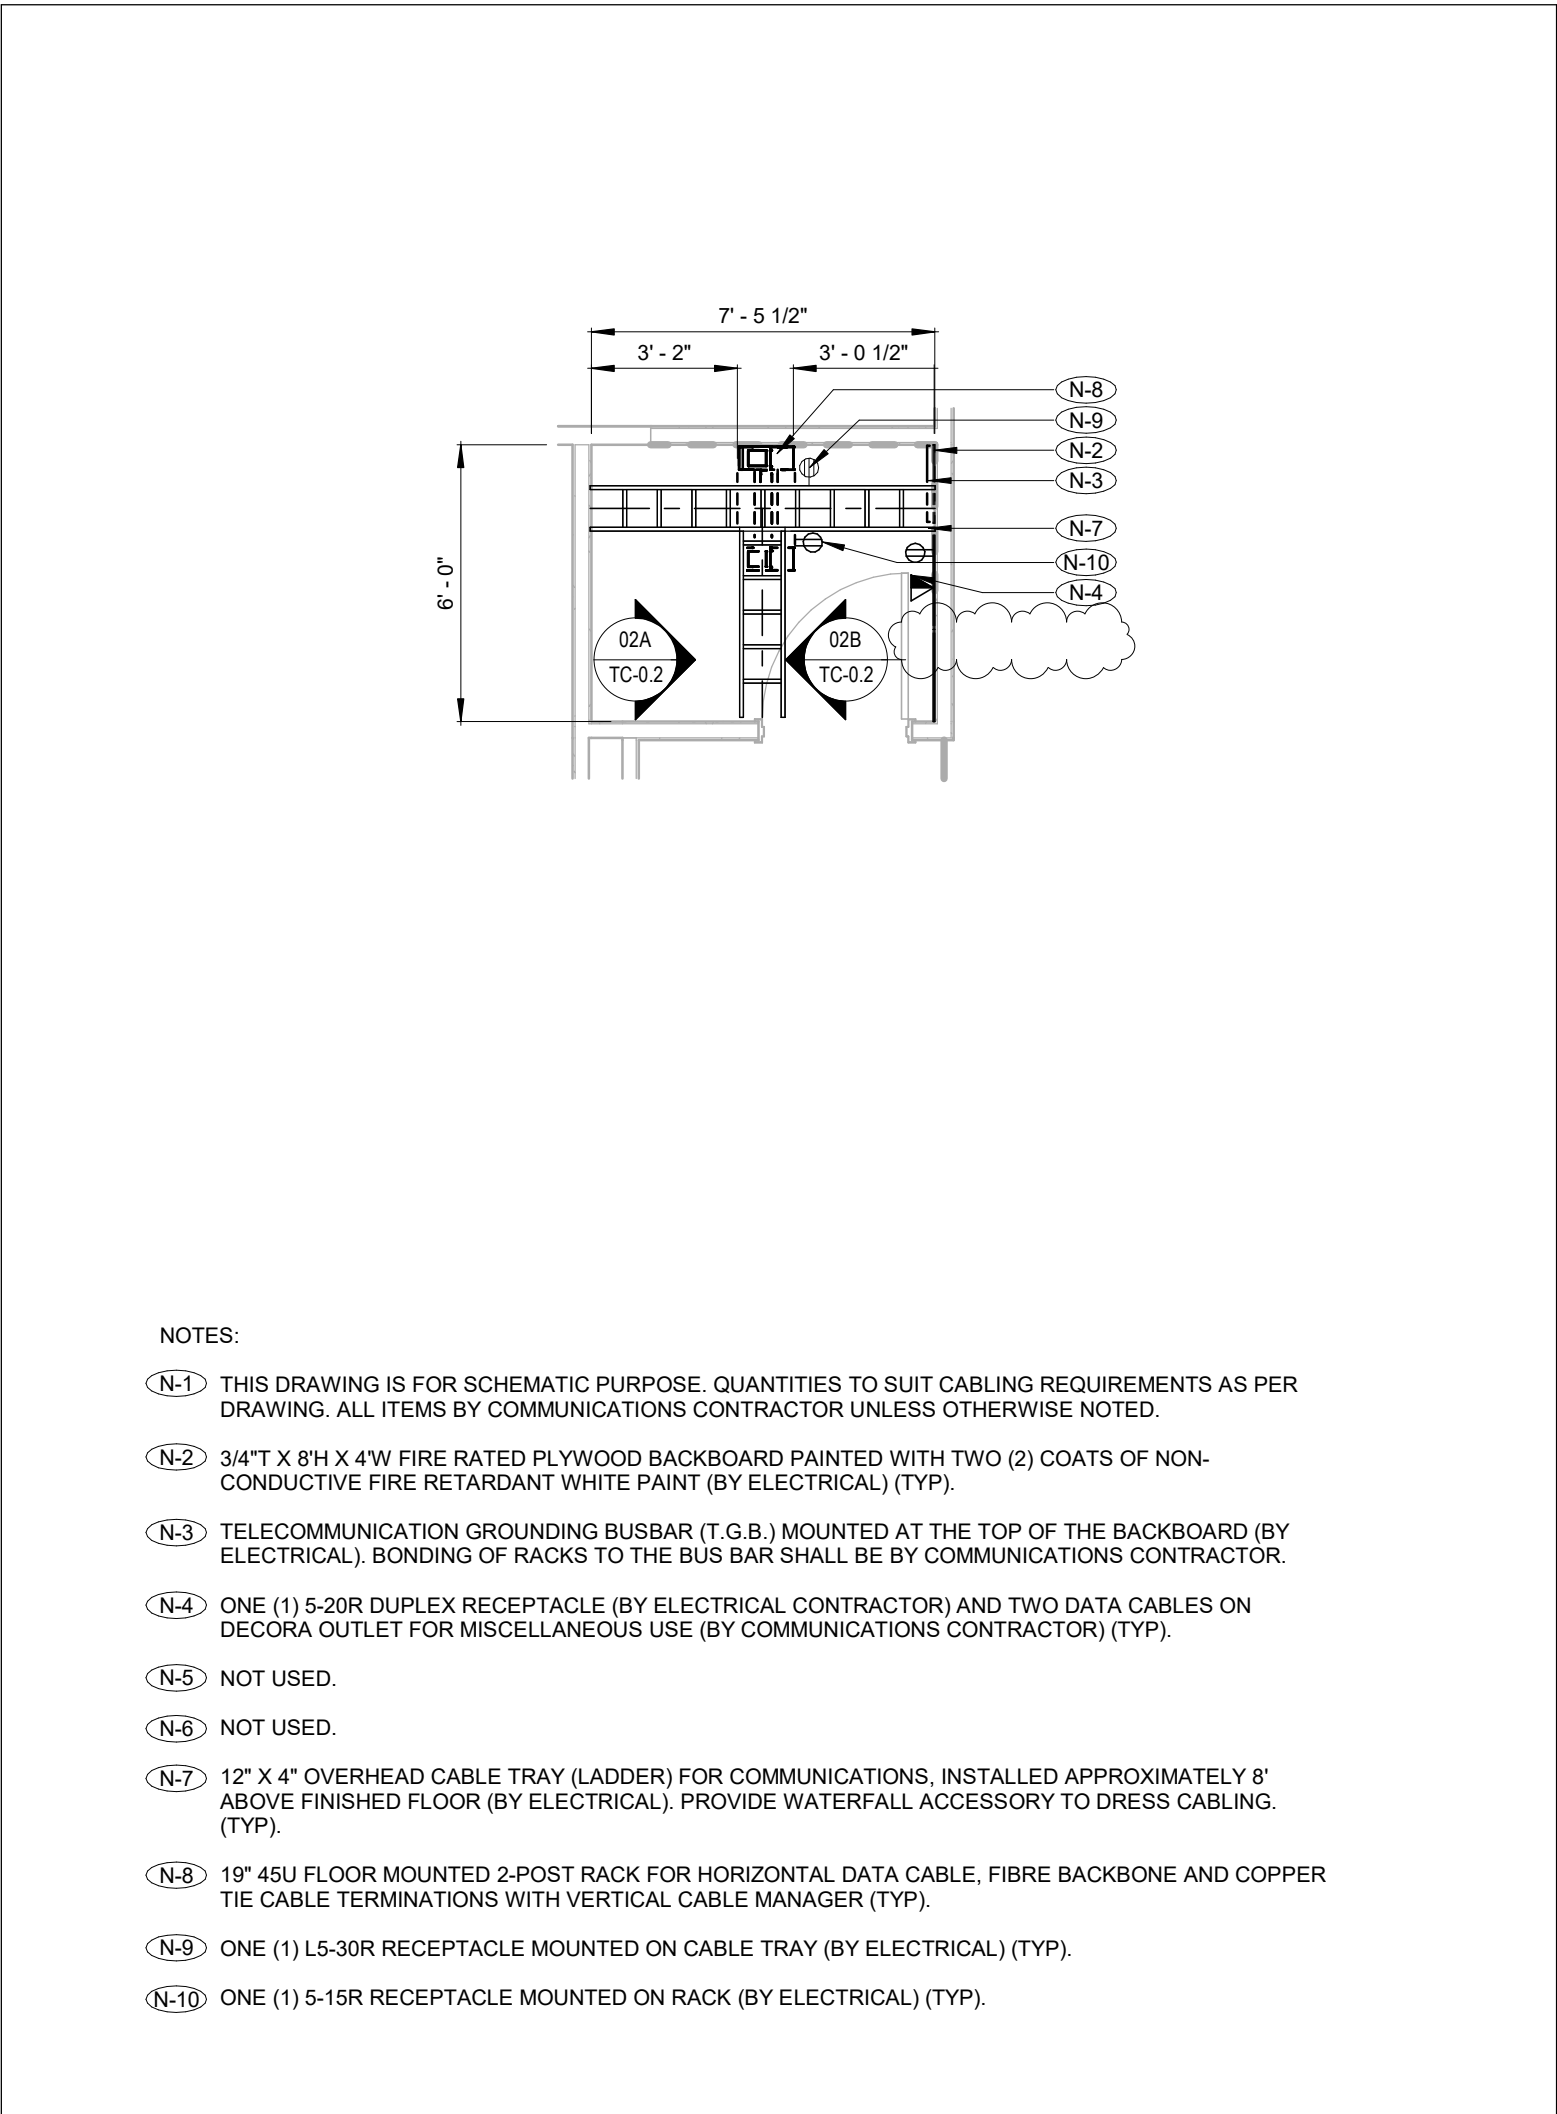

1 I.T. CLOSET 122 PLAN DETAIL
TC-0.2 1:50

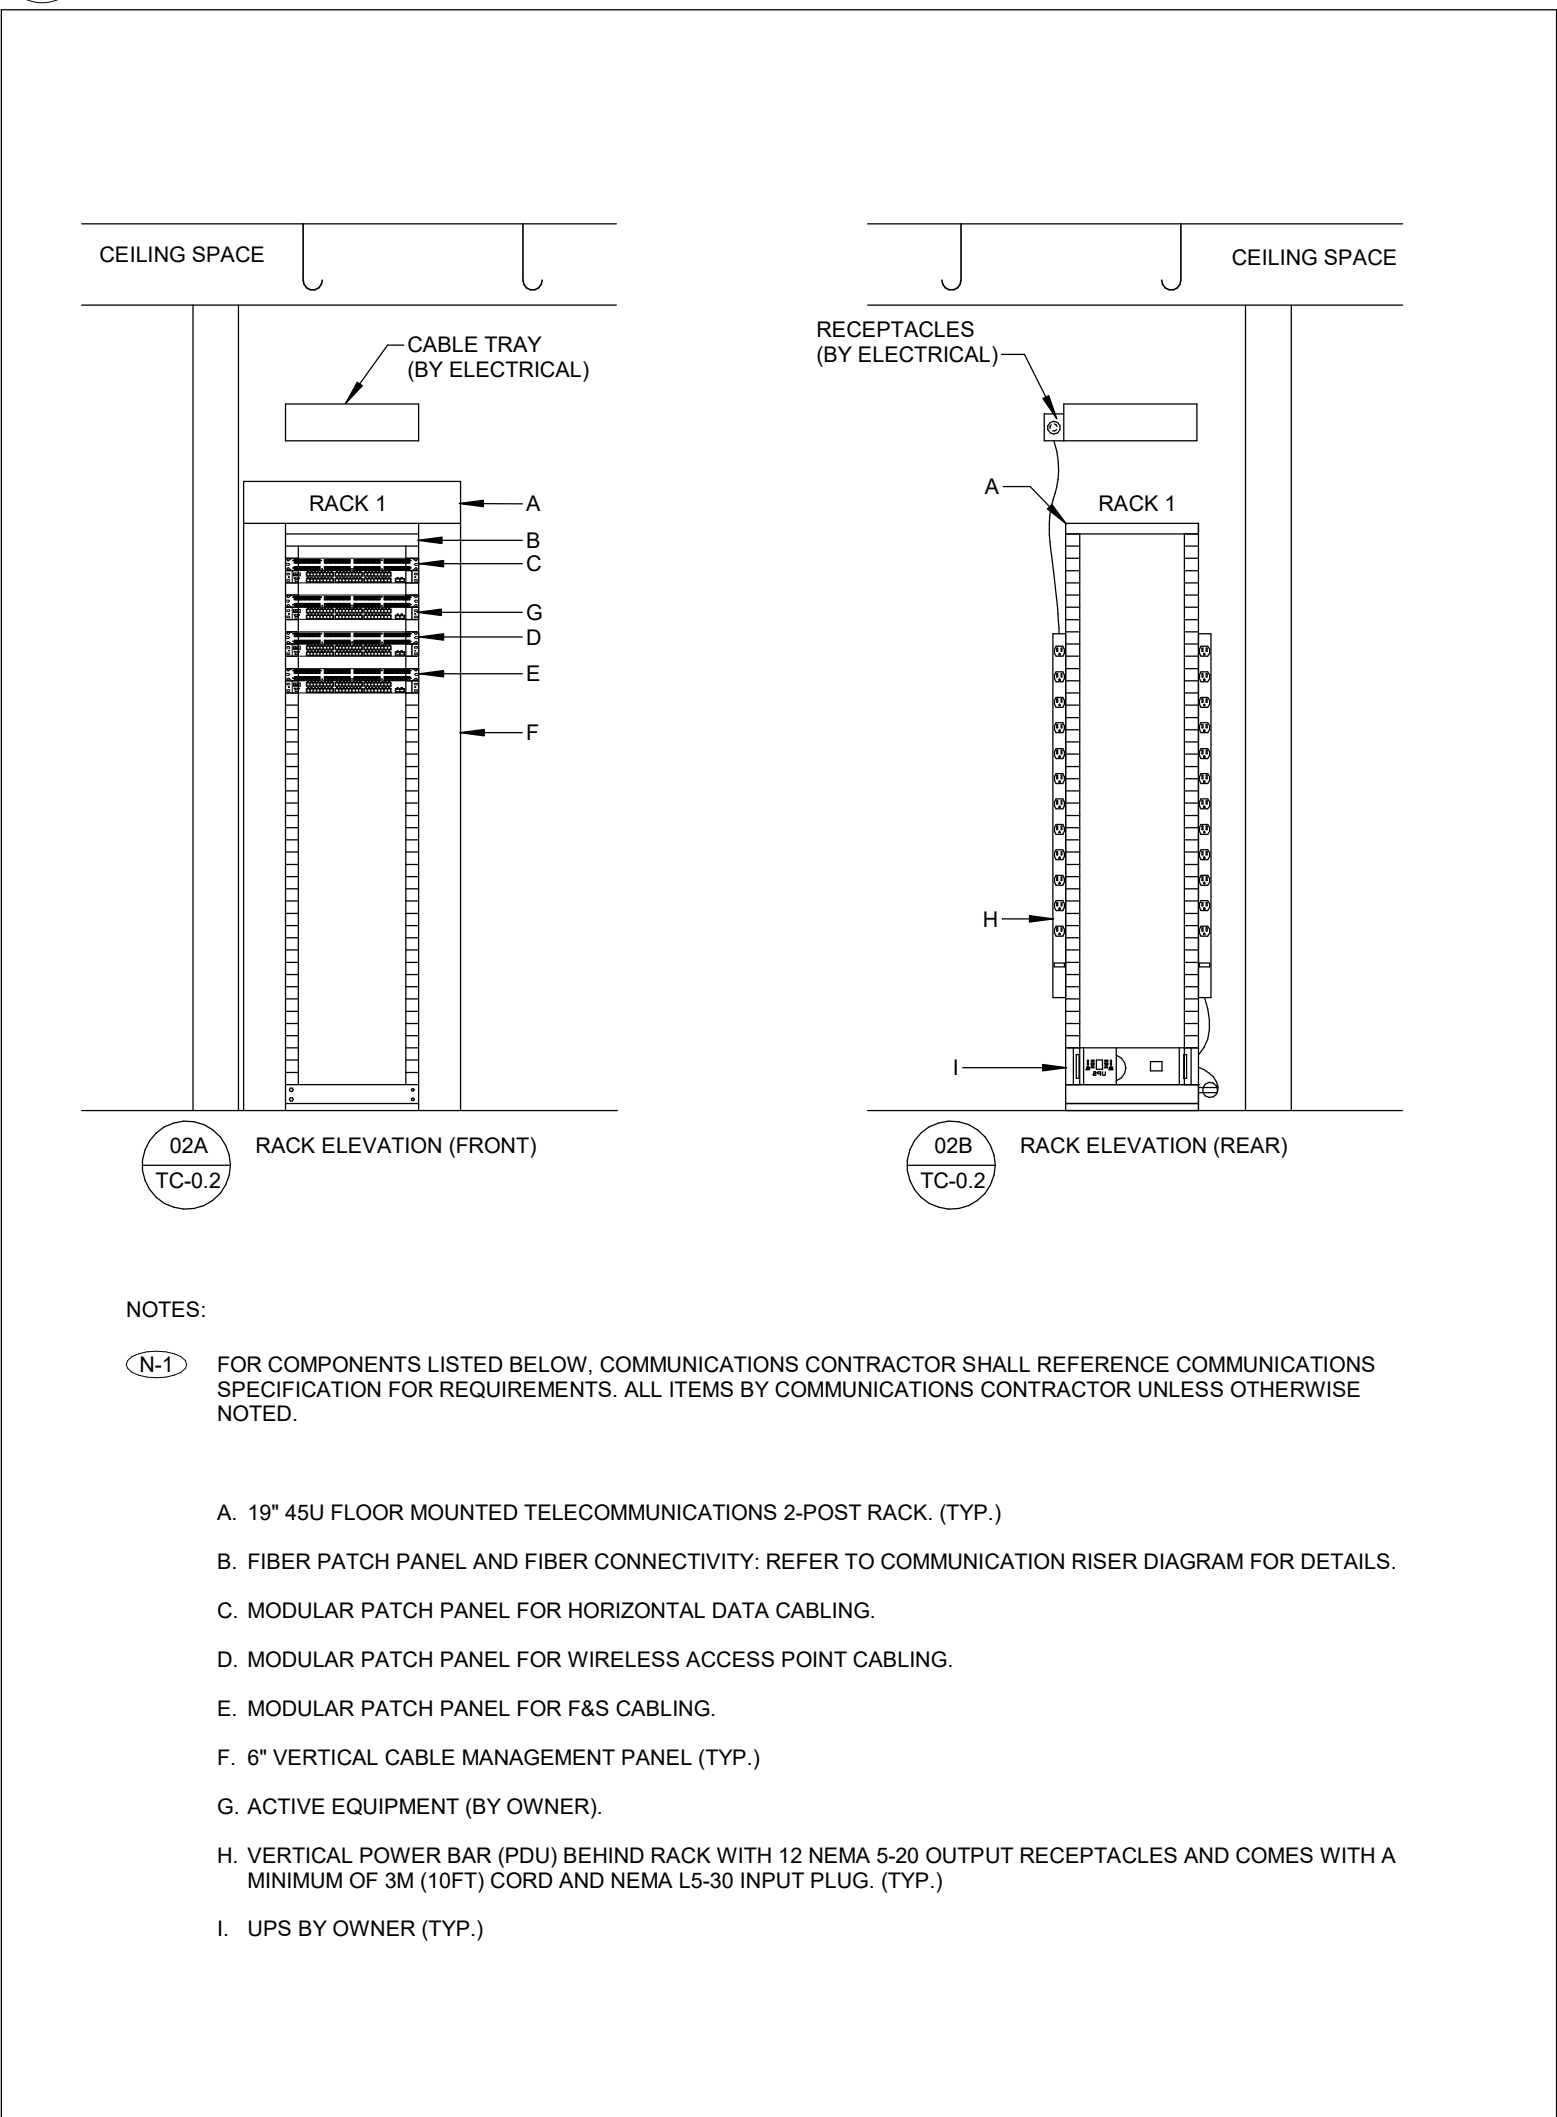

2 LEVEL 01 COMMUNICATIONS RACK ELEVATION DETAIL - I.T. 122 CLOSET
TC-0.2 NTS

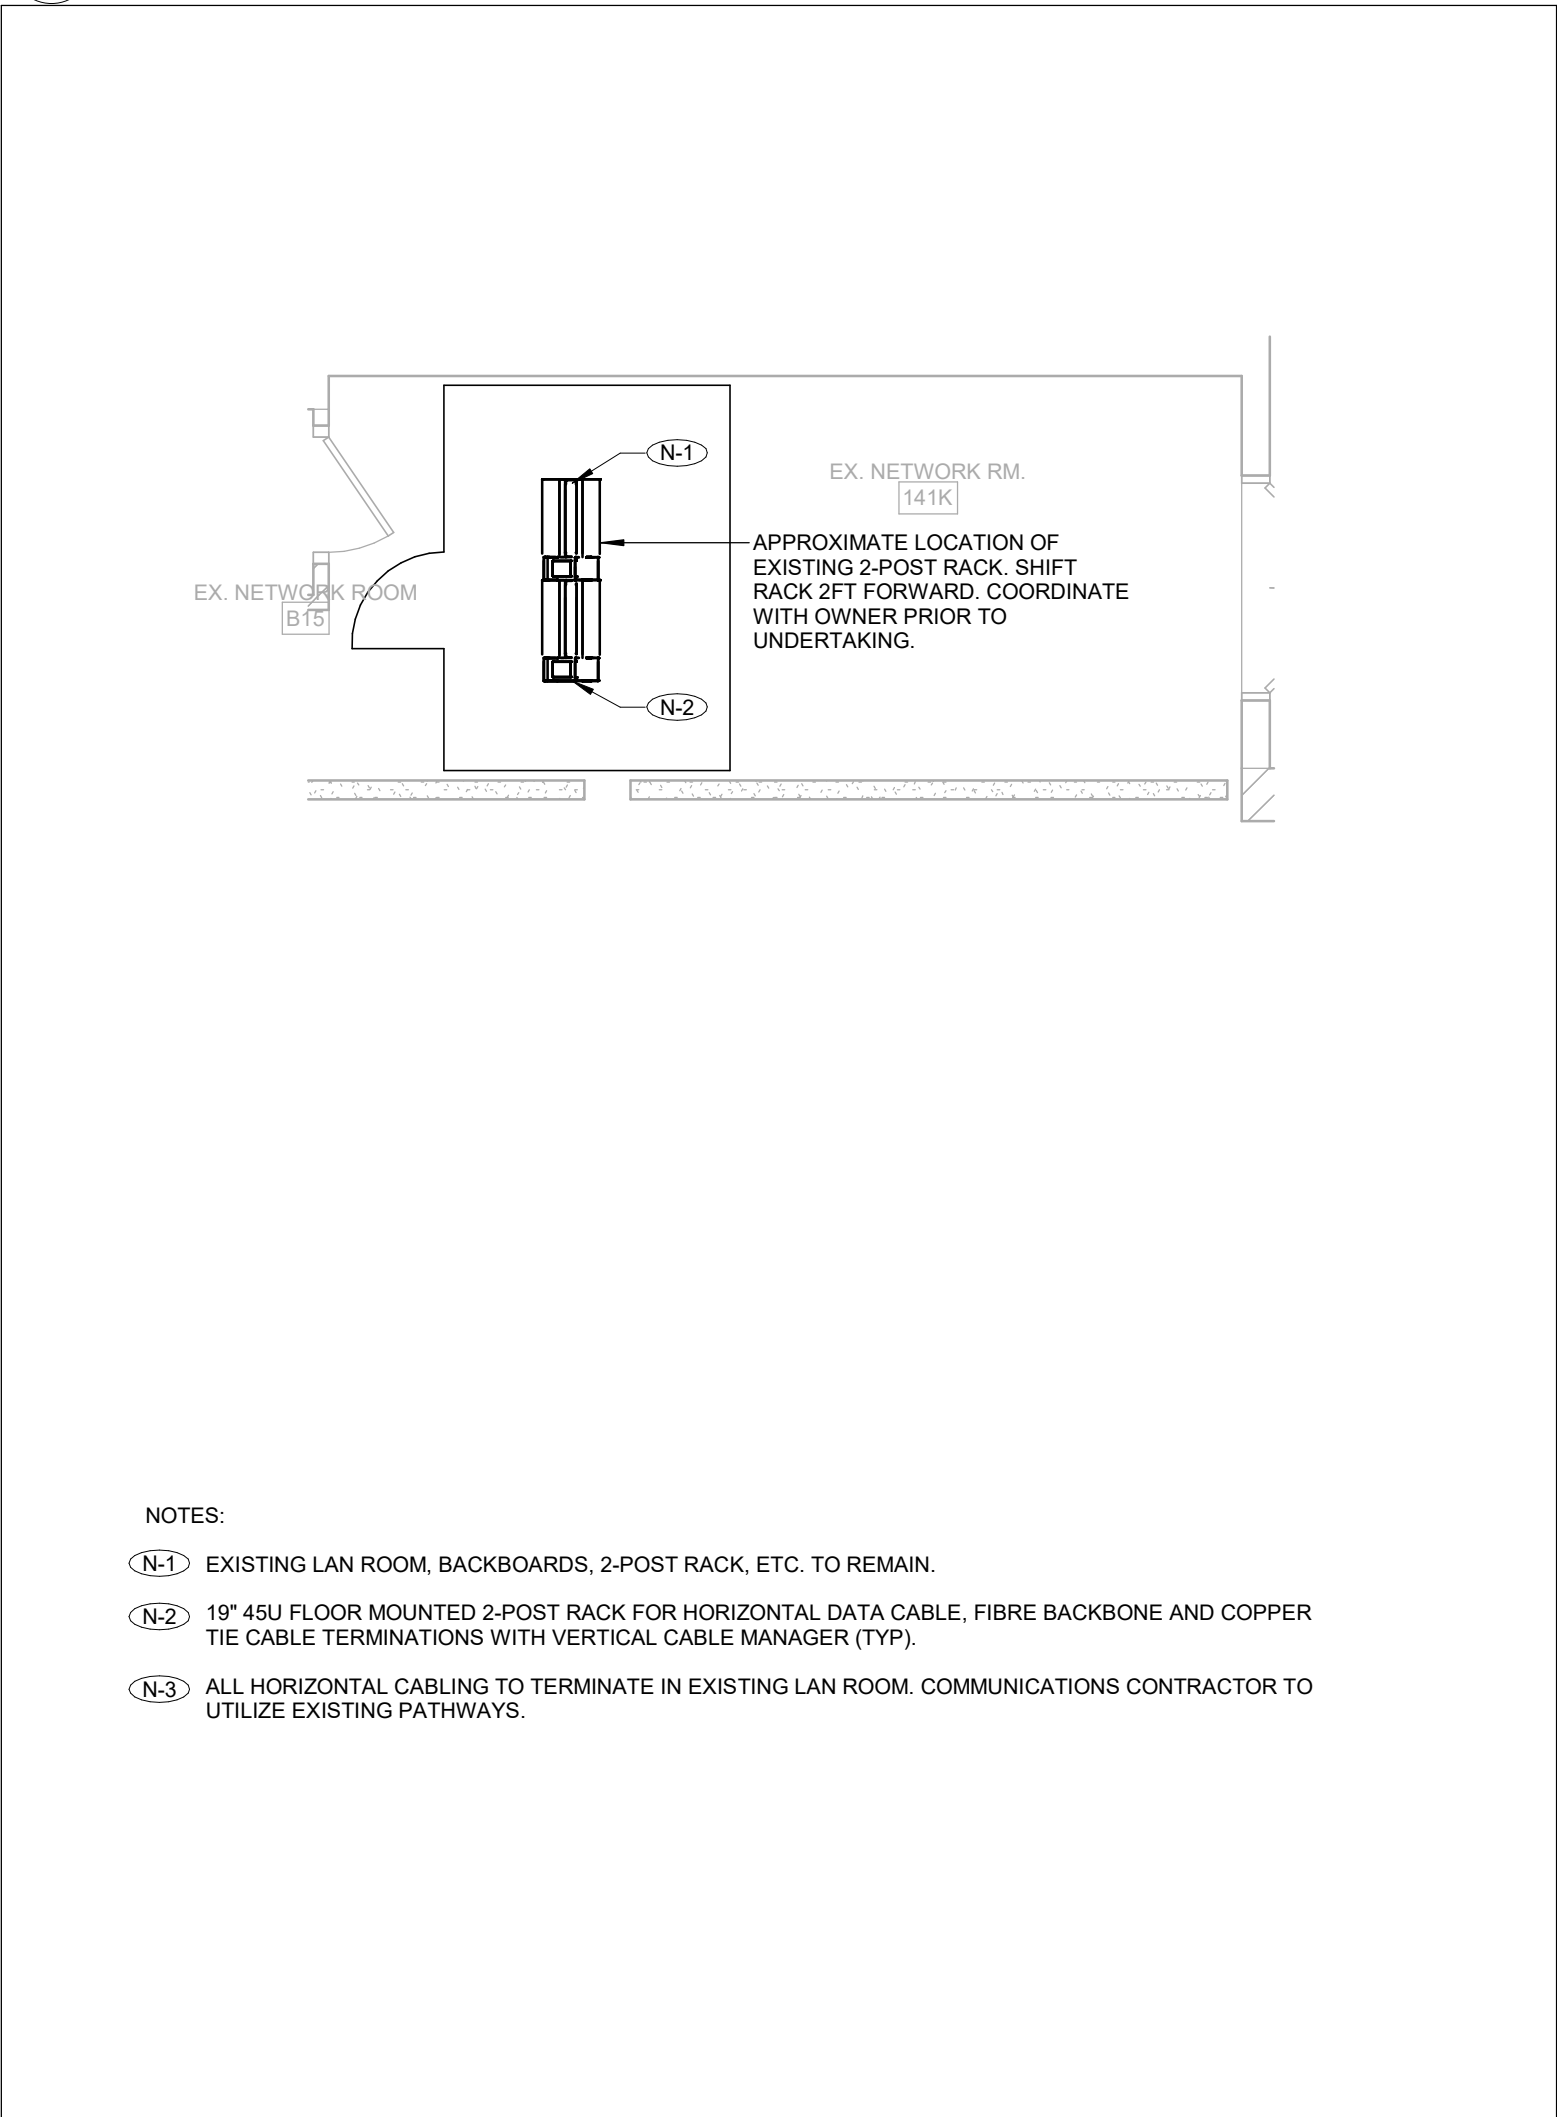

3 BASEMENT NETWORK ROOM B15 PLAN DETAIL
TC-0.2 1:50

KEY PLAN:

REVISION		
NO.	DATE	DESCRIPTION
1	2024-10-04	ISSUED FOR 50%.
3	2024-12-04	ISSUED FOR FAS REVIEW
6	2025-01-31	ISSUED FOR BID
9	2025-03-21	BID ADDENDUM #03
10	2025-03-25	BID ADDENDUM #04

Smith + Andersen
1100 - 109 Sheppard Ave East, Toronto, ON, M2N 0N9
416-467-8153 smithandandersen.com

ENFORM architects
ENFORM Architects Inc.
1284 Sheppard Road, Suite 302B
Toronto, Ontario, Canada M8R 2B7
416-548-7523
www.enformarchitects.com

SEAL:

OWNER: **UNIVERSITY OF TORONTO**

PROJECT: **HEALTH AND WELLNESS CENTRE RENOVATION AT KOFFLER**

214 COLLEGE ST.
TORONTO, ON M5T 3A1


 
 
 
SHEET CONTENTS:
COMMUNICATIONS TELECOM ROOMS DETAILS

PROJECT NUMBER:
21590.003


DRAWING SCALE:
As indicated

DRAWN BY: **Author** CHECKED BY: **Checker** DATE: **Issue Date**

SHEET NO: **TC-0.2** REV: **10**

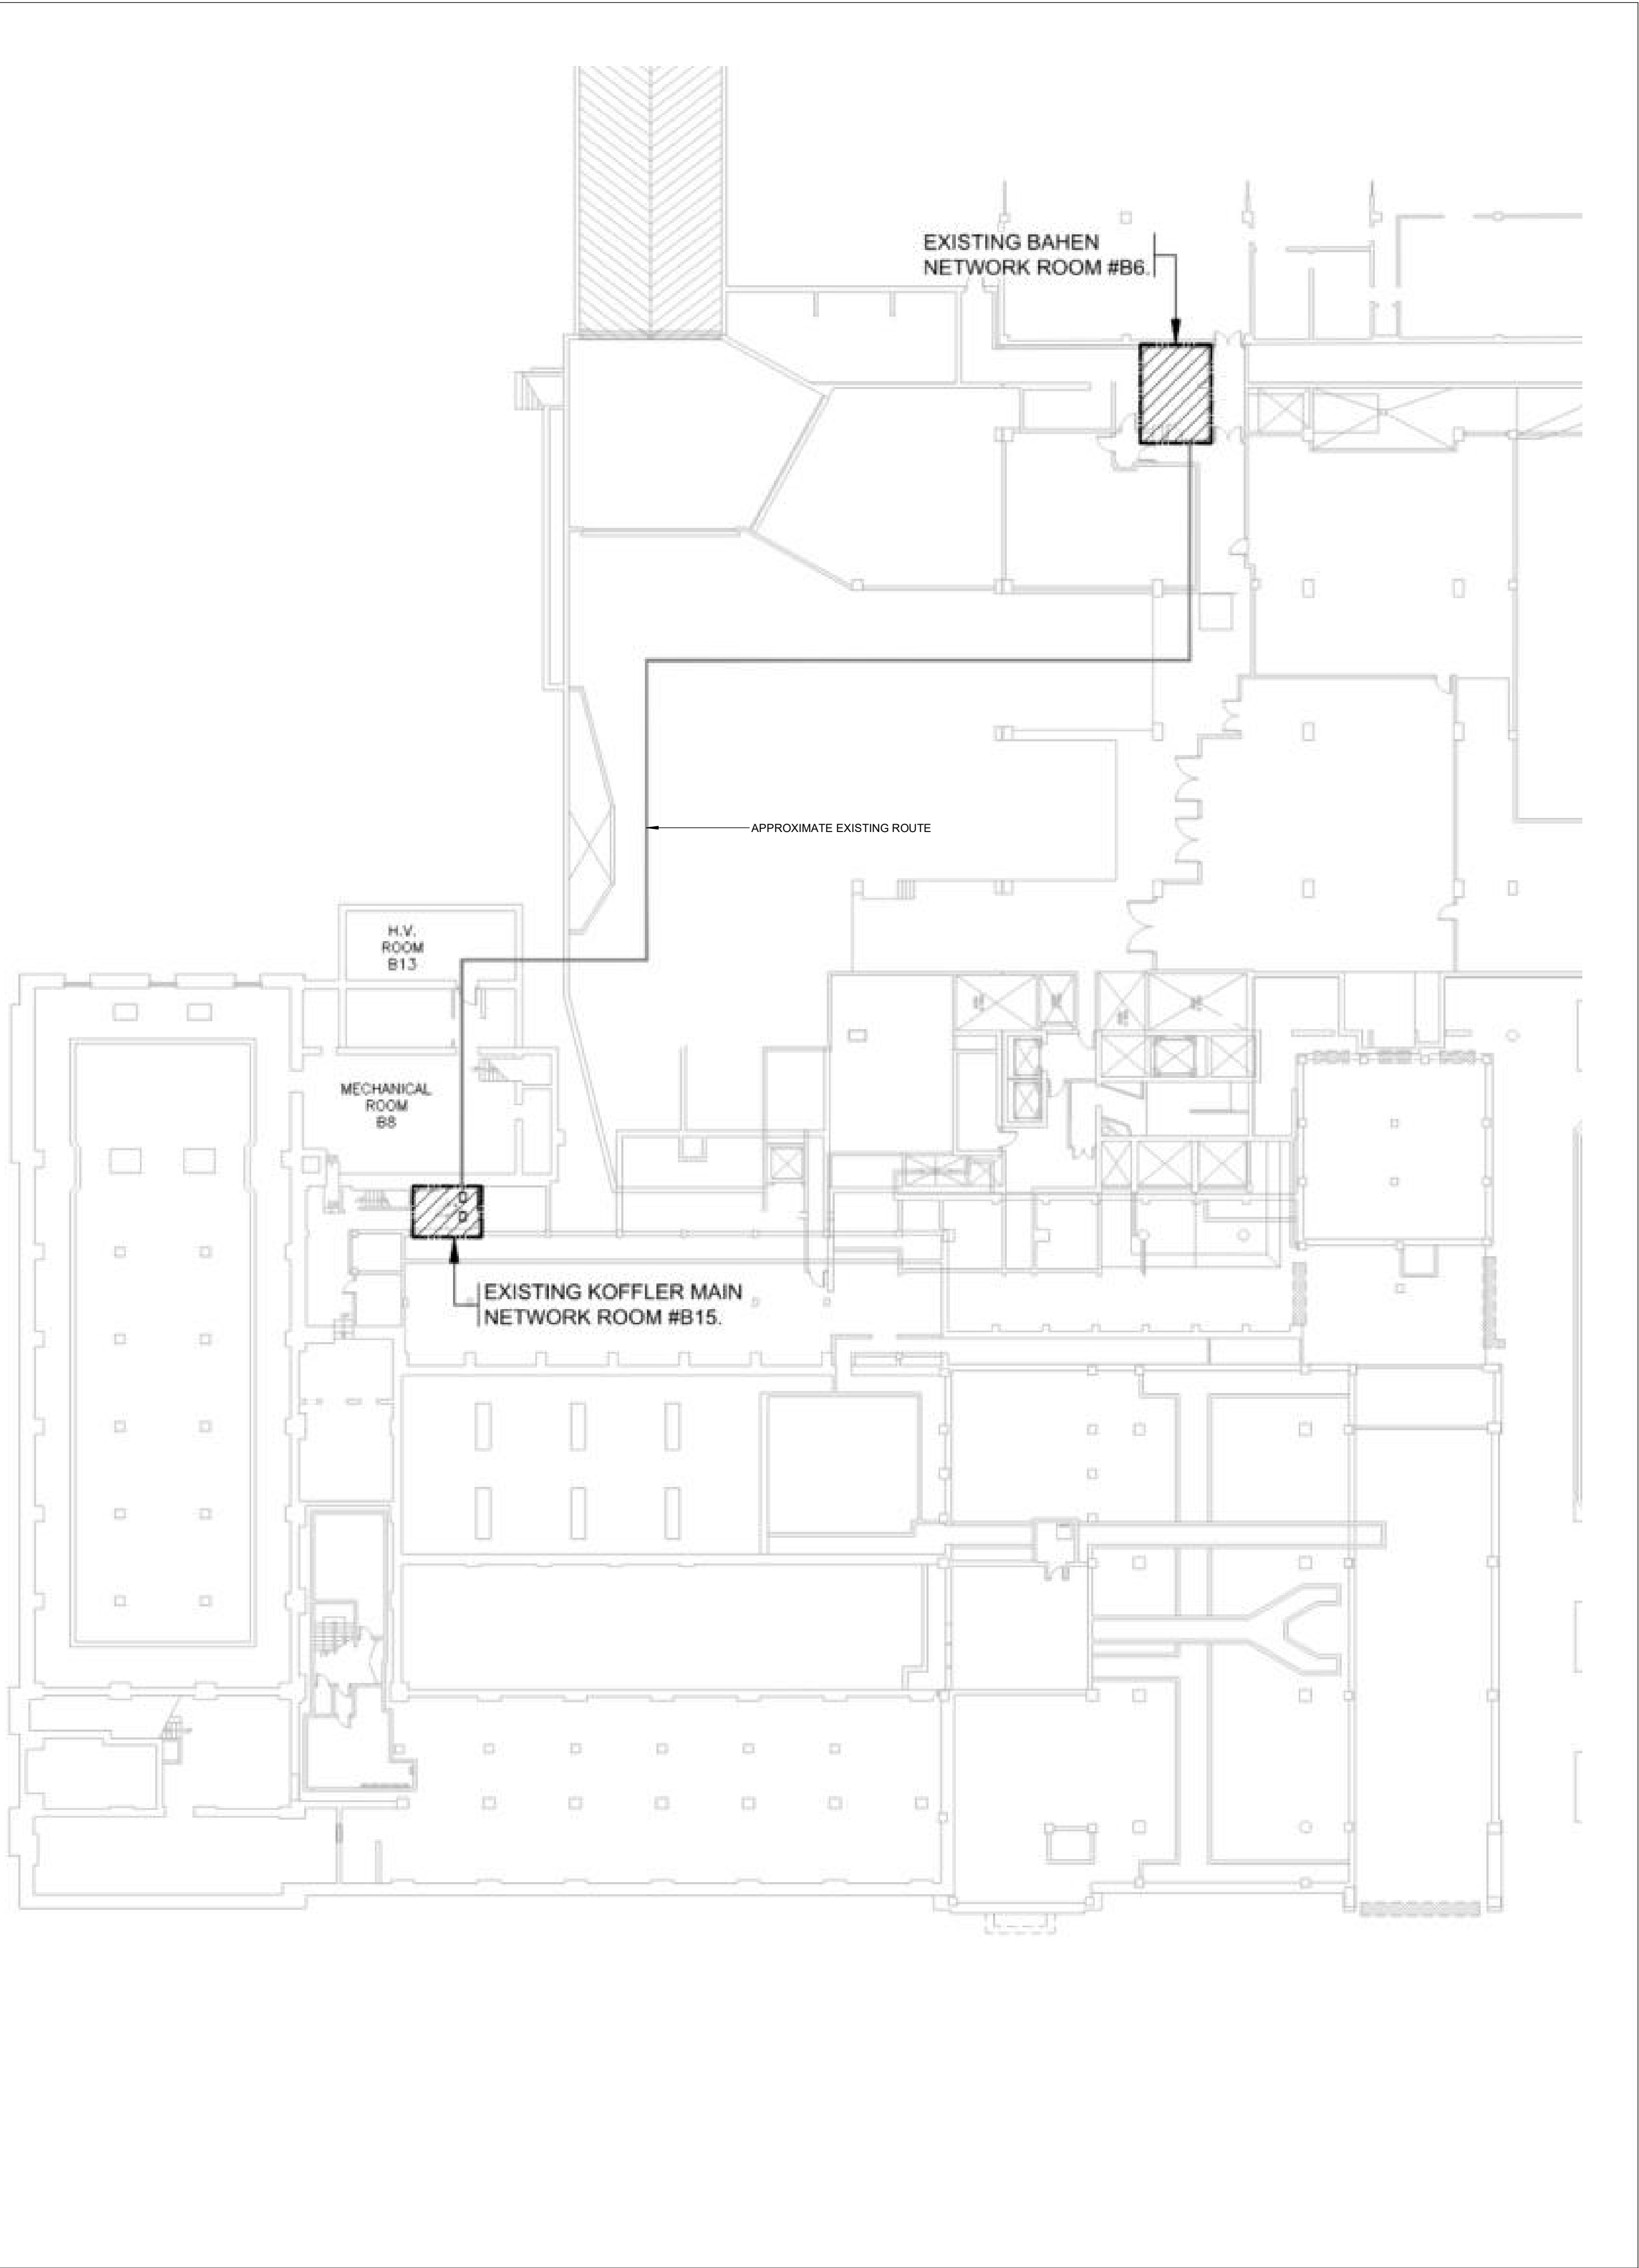


2 COMMUNICATIONS BASEMENT LEVEL KEYPLAN
TC-03 NTS

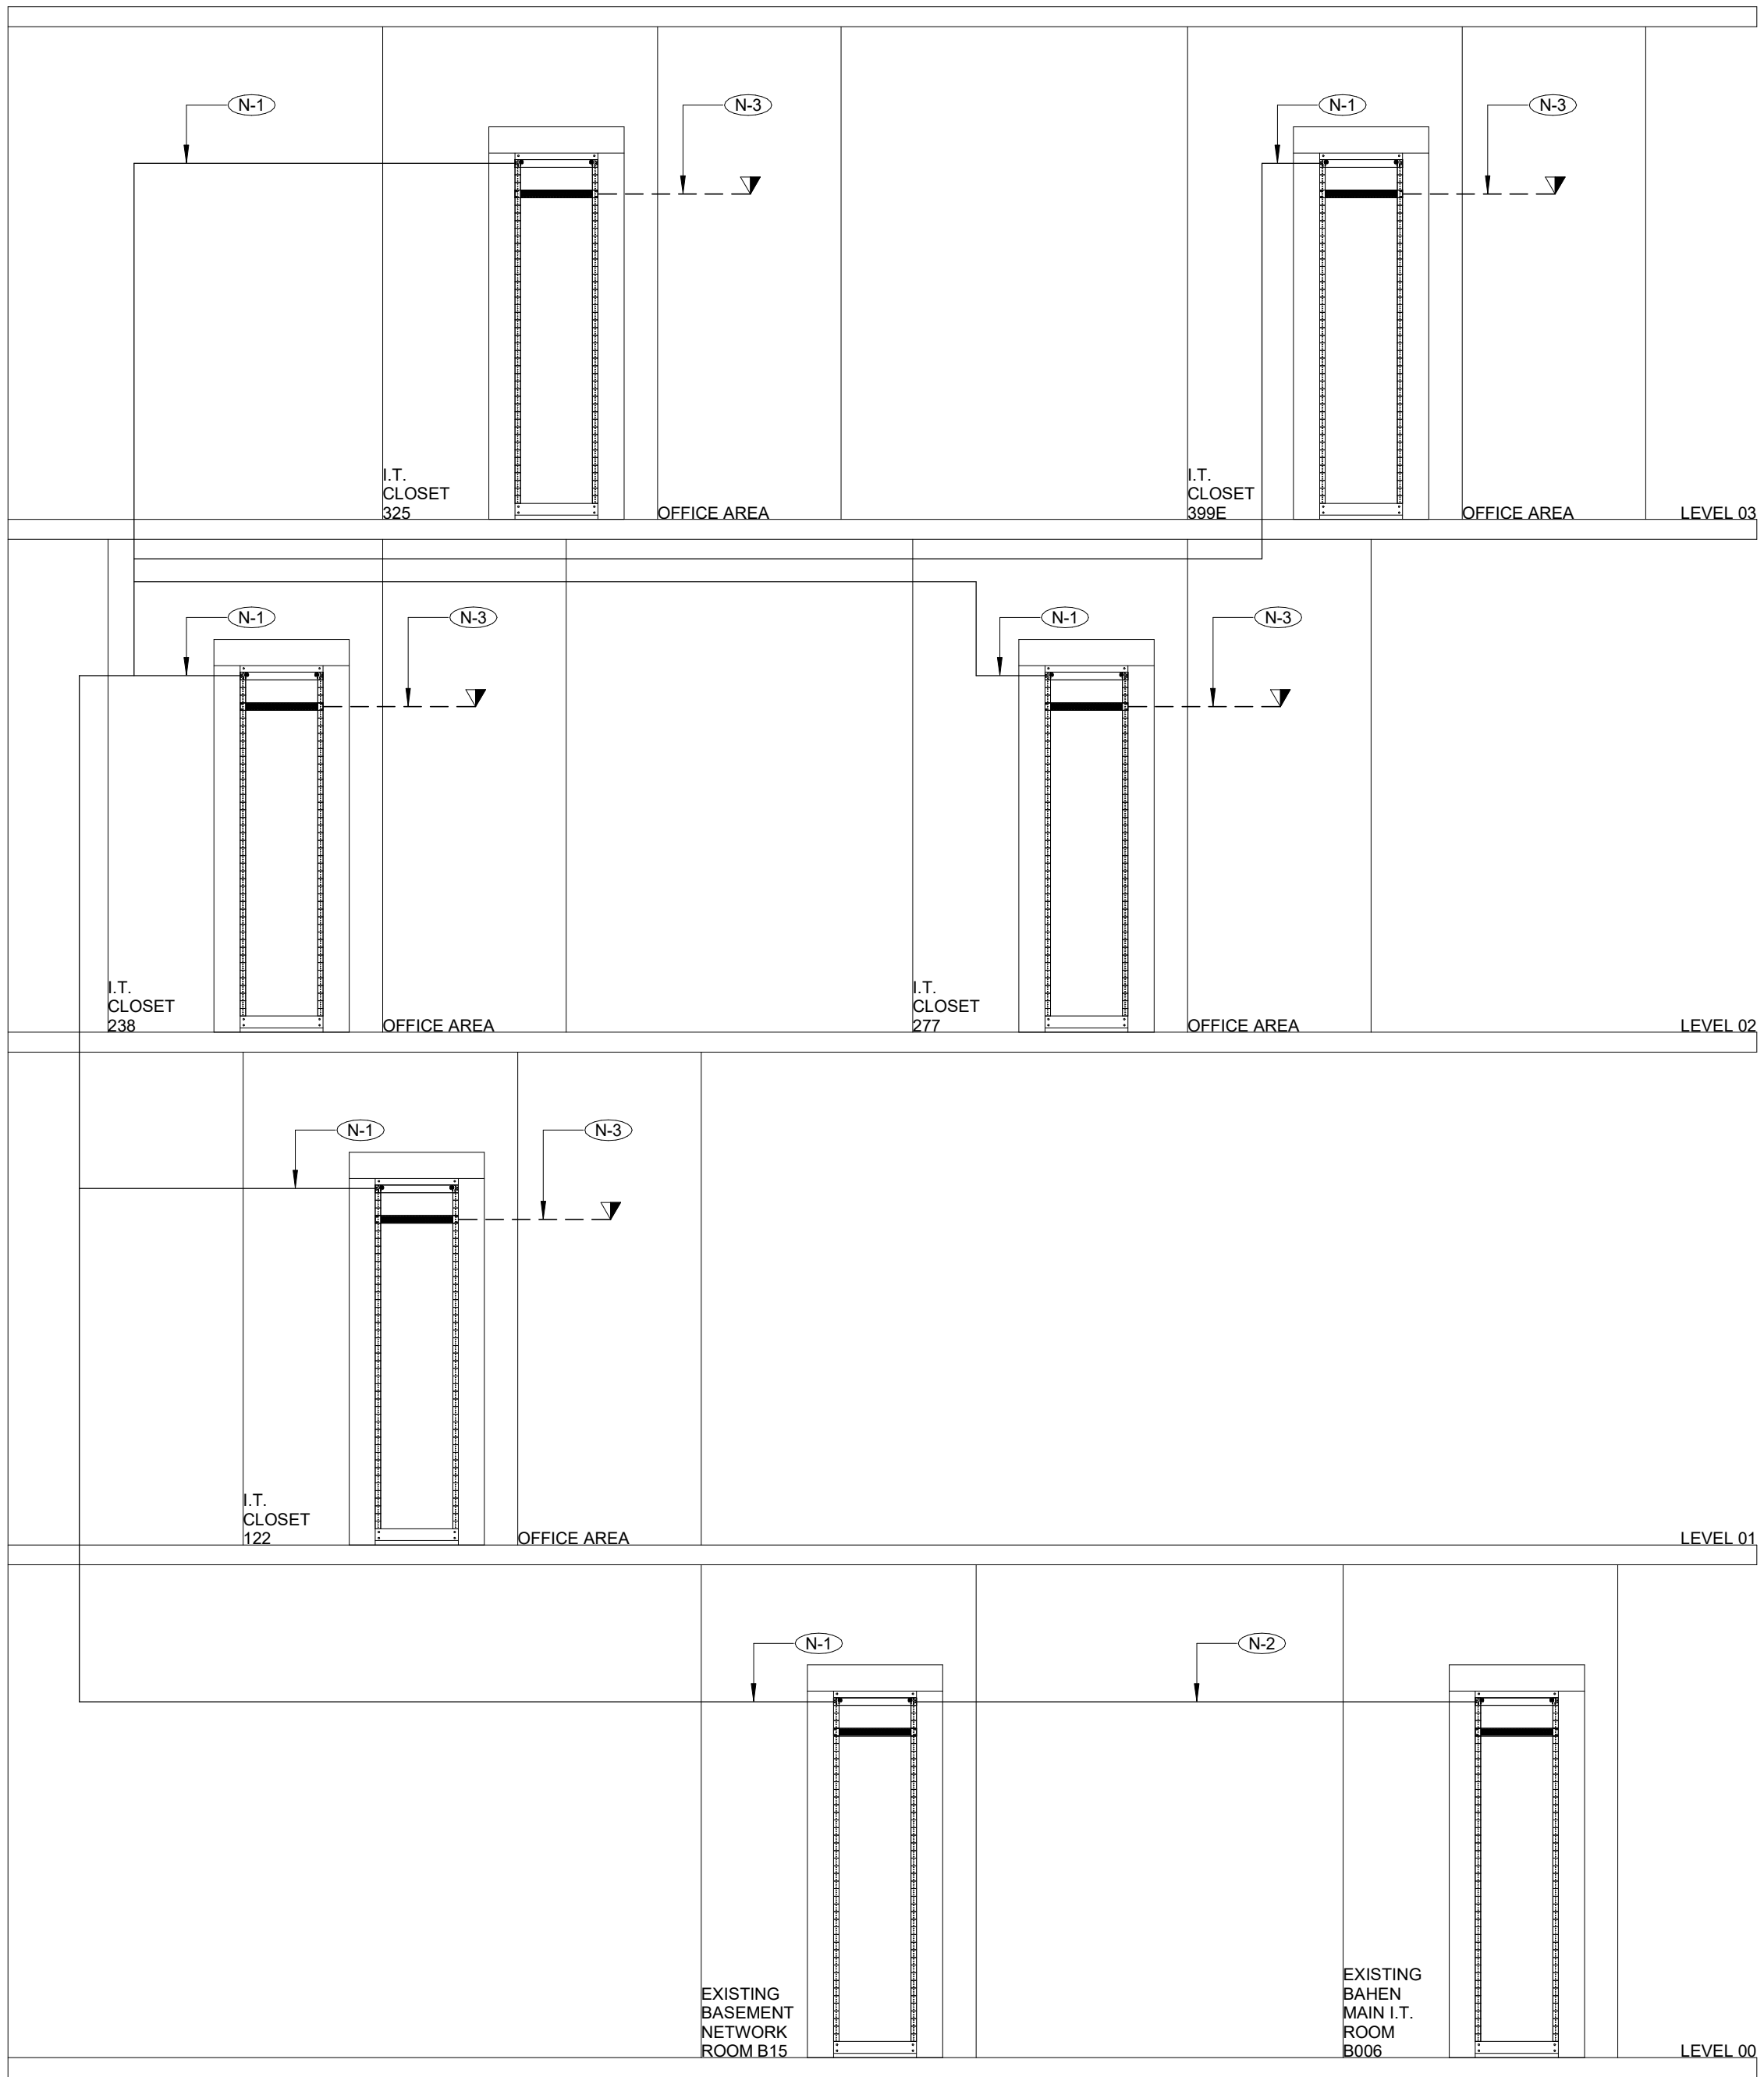


- GENERAL NOTES
1. RISER IS DIAGRAMMATIC ONLY. FOR COMPONENTS LISTED BELOW REFERENCE COMMUNICATIONS SPECIFICATION FOR REQUIREMENTS.
 2. ALL ITEMS BY COMMUNICATIONS CONTRACTOR UNLESS OTHERWISE NOTED.
 3. PROVIDE ADEQUATE FIRE STOPPING AS REQUIRED.

- NOTES:
- 1. PROVIDE ONE (1) 24-STRAND SINGLEMODE, OS2, ONFP FIBER BACKBONE CABLE WITH LC CONNECTORS FROM EXISTING BASEMENT LAN ROOM TO EACH TELECOM ROOM (TYP).
 - 2. PROVIDE ONE (1) ARMORED 48-STRAND SINGLEMODE, OS2, ONFP FIBER BACKBONE CABLE WITH LC CONNECTORS FROM EXISTING BAHEN MAIN T. ROOM B06 TO EXISTING BASEMENT NETWORK ROOM B15. ALLOW FOR 200 FT OF FIBER.
 - 3. HORIZONTAL CABLEING TO OFFICE AREA BY COMMUNICATIONS CONTRACTOR.

1 COMMUNICATIONS RISER DIAGRAM
TC-03 NTS

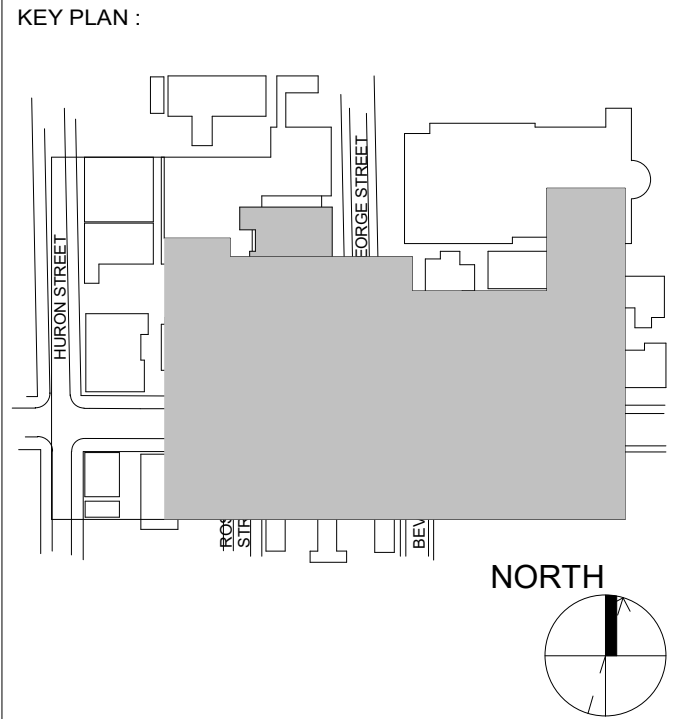

REVISION	
NO.	DESCRIPTION
1	2024-10-04 ISSUED FOR 50%
2	2024-12-04 ISSUED FOR F&S REVIEW
3	2025-01-31 ISSUED FOR BID
4	2025-03-25 BID ADDENDUM #04

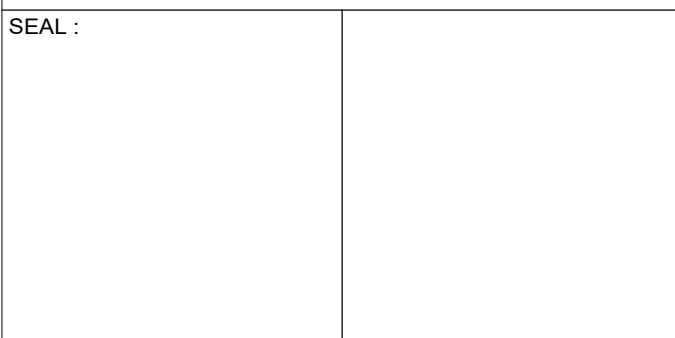

PROJECT:
HEALTH AND WELLNESS
CENTRE RENOVATION AT
KOFFLER

214 COLLEGE ST.
TORONTO, ON M5T 3A1

SHEET CONTENTS:
COMMUNICATIONS RISER
DIAGRAM


PROJECT NUMBER:
21590.003

DRAWING SCALE:
NTS


DRAWN BY: CHECKED BY: DATE:
Author Checker Issue Date

SHEET NO.: REV: 10

TC-0.3

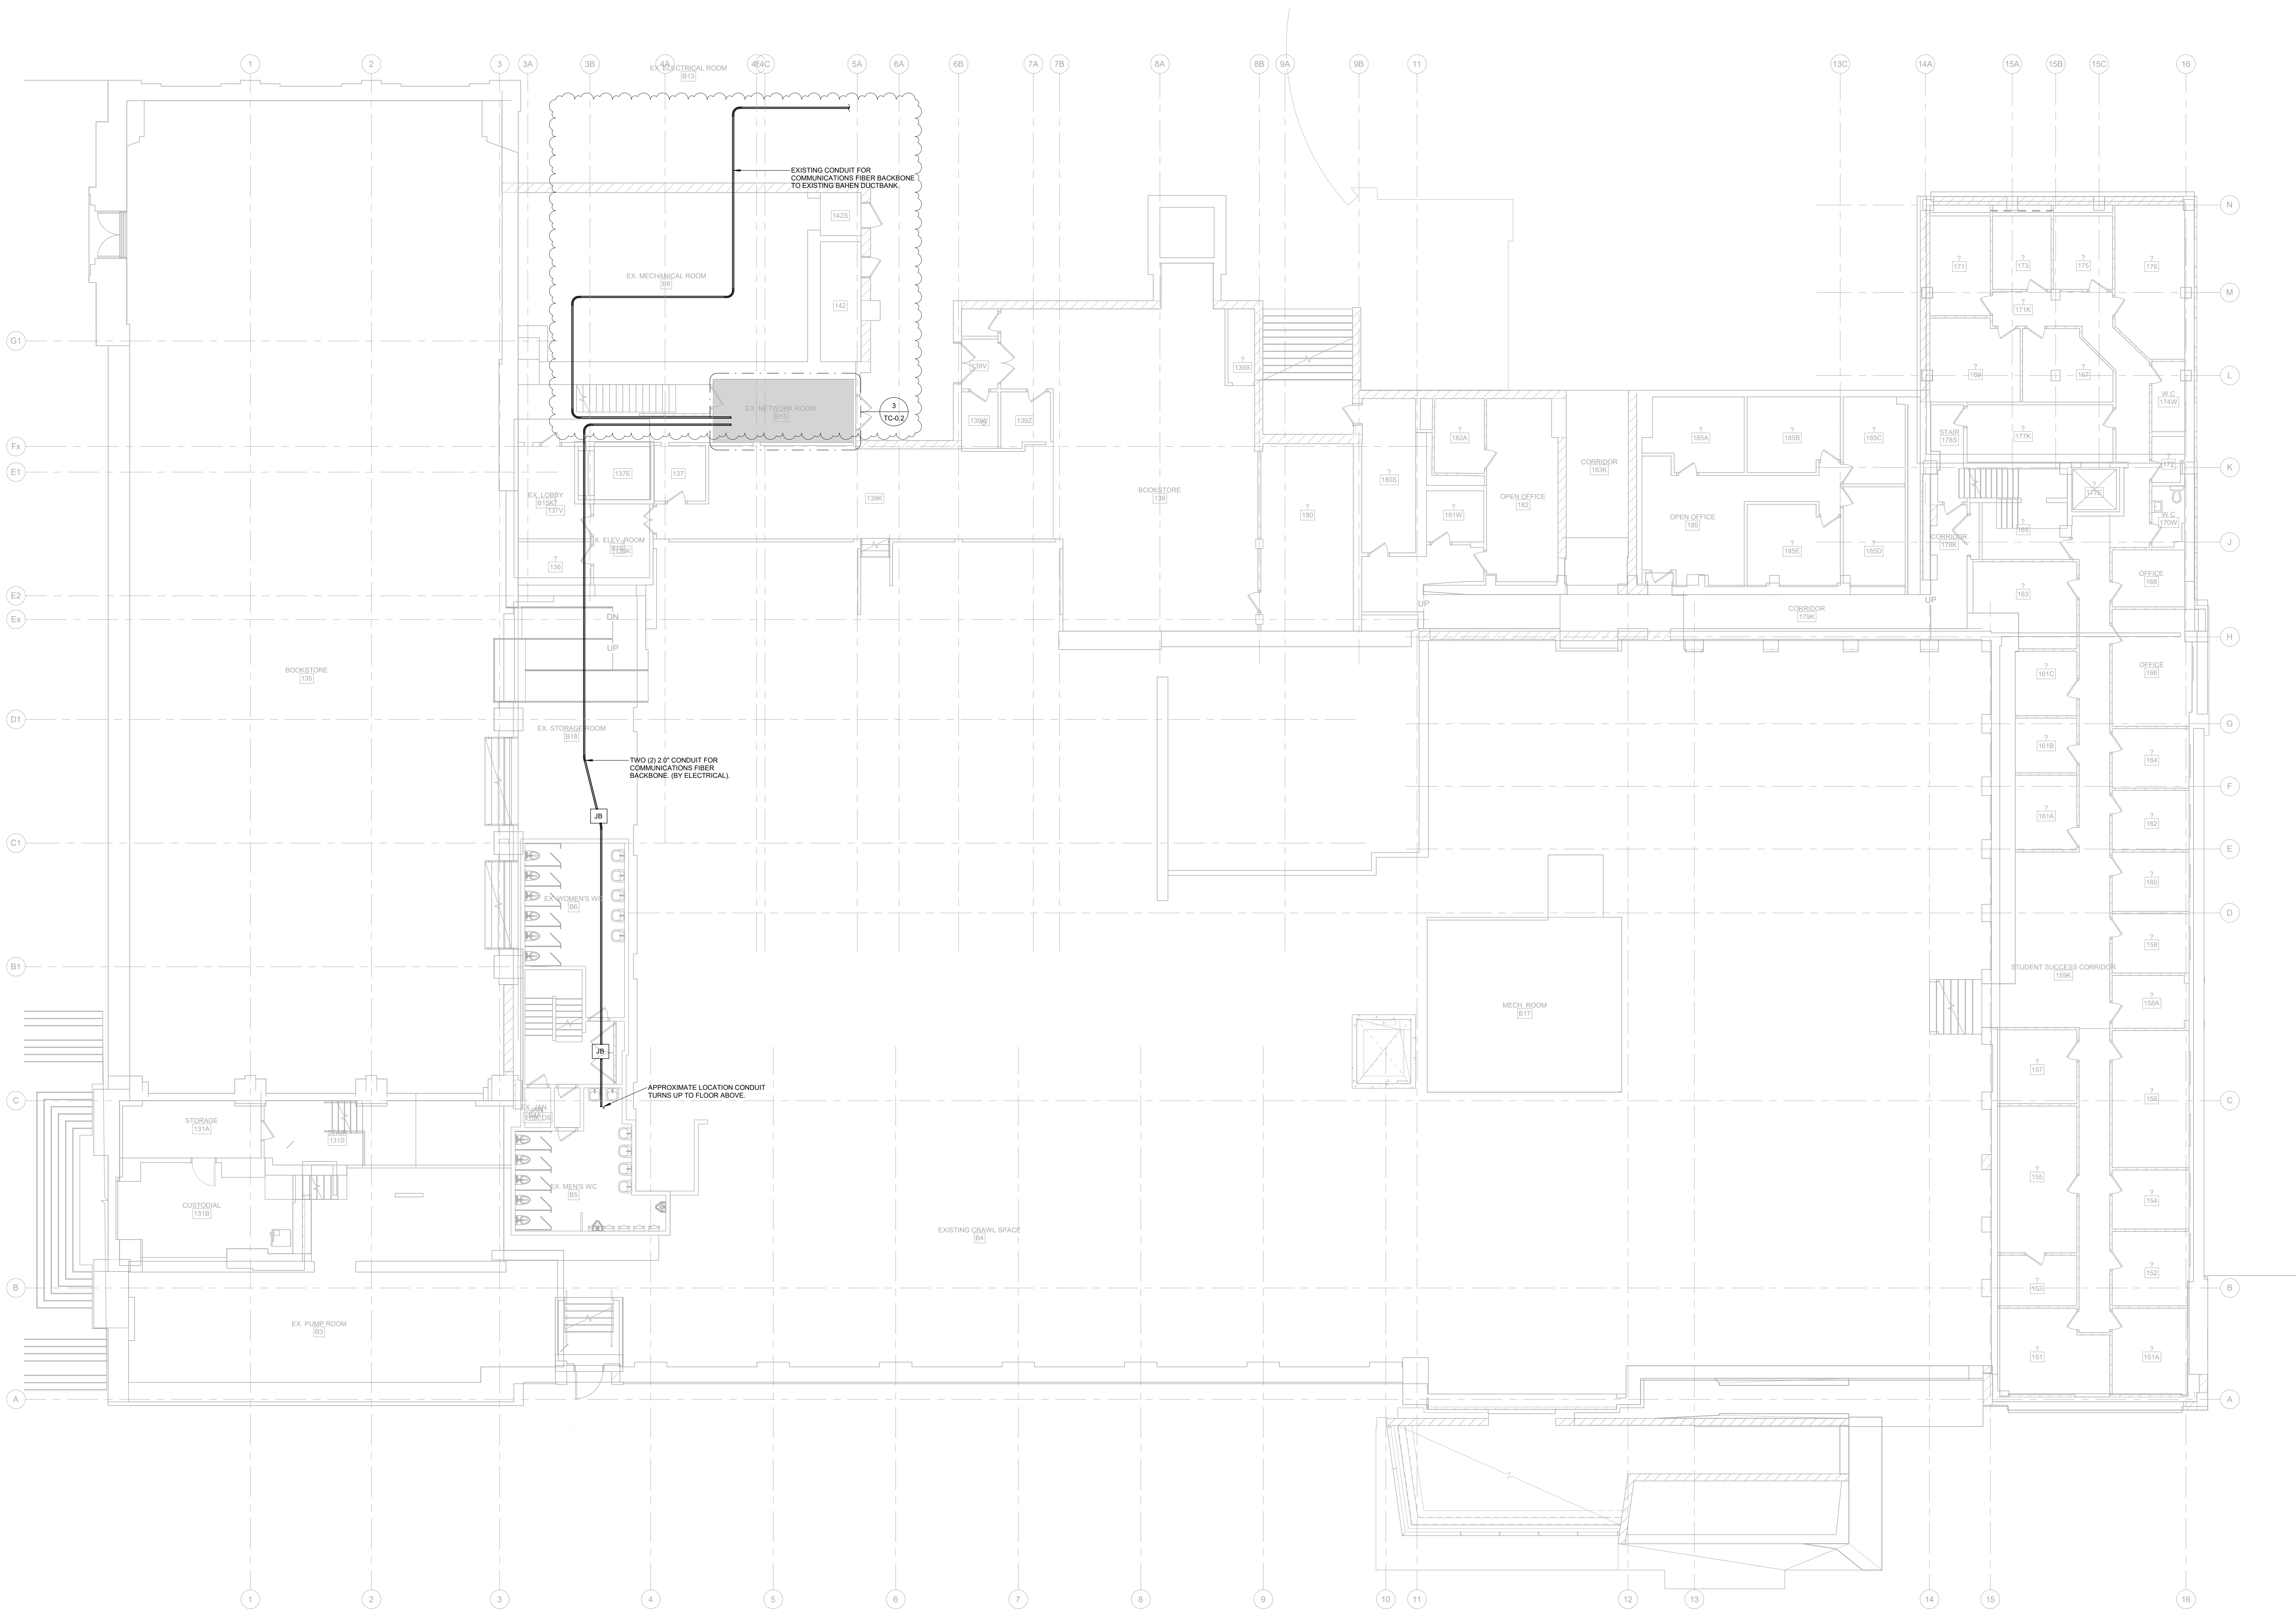

KEY PLAN:

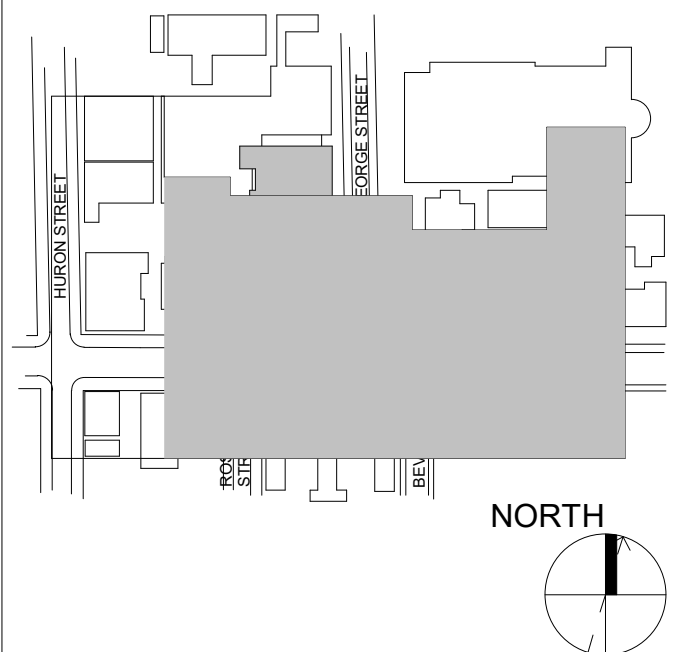

REVISION	
NO.	DATE
1	2024-10-04
2	2024-12-04
3	2025-01-31
4	2025-03-25

ISSUED FOR 50%
ISSUED FOR F&S REVIEW
ISSUED FOR BID
BID ADDENDUM #04

SMITH + ANDERSEN

1100 - 109 Sheppard Ave East, Toronto, ON, M2N 0N5
416-467-8151 smithandersen.com

ENFORM architects

ENFORM Architects Inc.
128A Sterling Road, Suite 302B
Toronto, Ontario, Canada M6R 2B7
1-877-648-7523
www.enformarchitects.com

SEAL:

OWNER:

UNIVERSITY OF TORONTO

PROJECT:

HEALTH AND WELLNESS CENTRE RENOVATION AT KOFFLER

214 COLLEGE ST.
TORONTO, ON M5T 3A1

SHEET CONTENTS:

LEVEL 00 COMMUNICATIONS LAYOUT

PROJECT NUMBER:

21590.003

DRAWING SCALE:

1 : 100

DRAWN BY:

Author

CHECKED BY:

Checker

DATE:



Issue Date

SHEET NO:


TC-B1.1

REV:

10

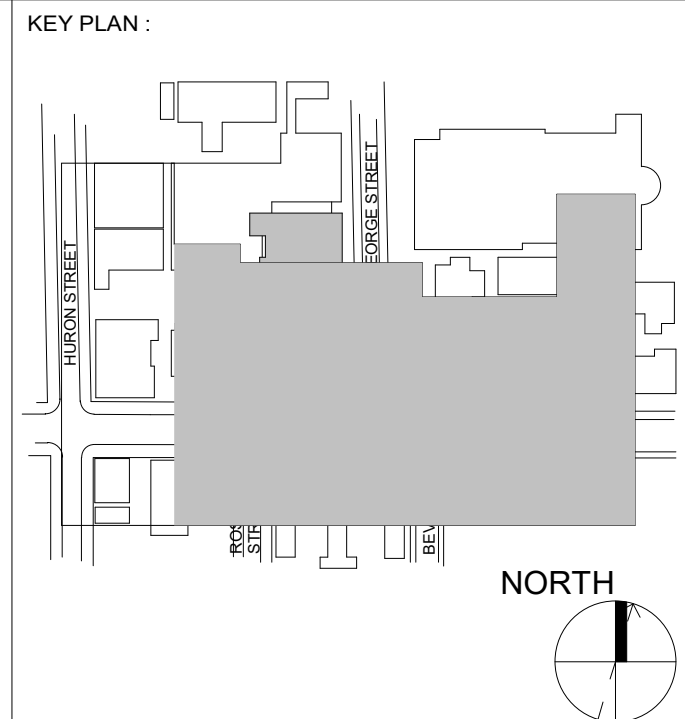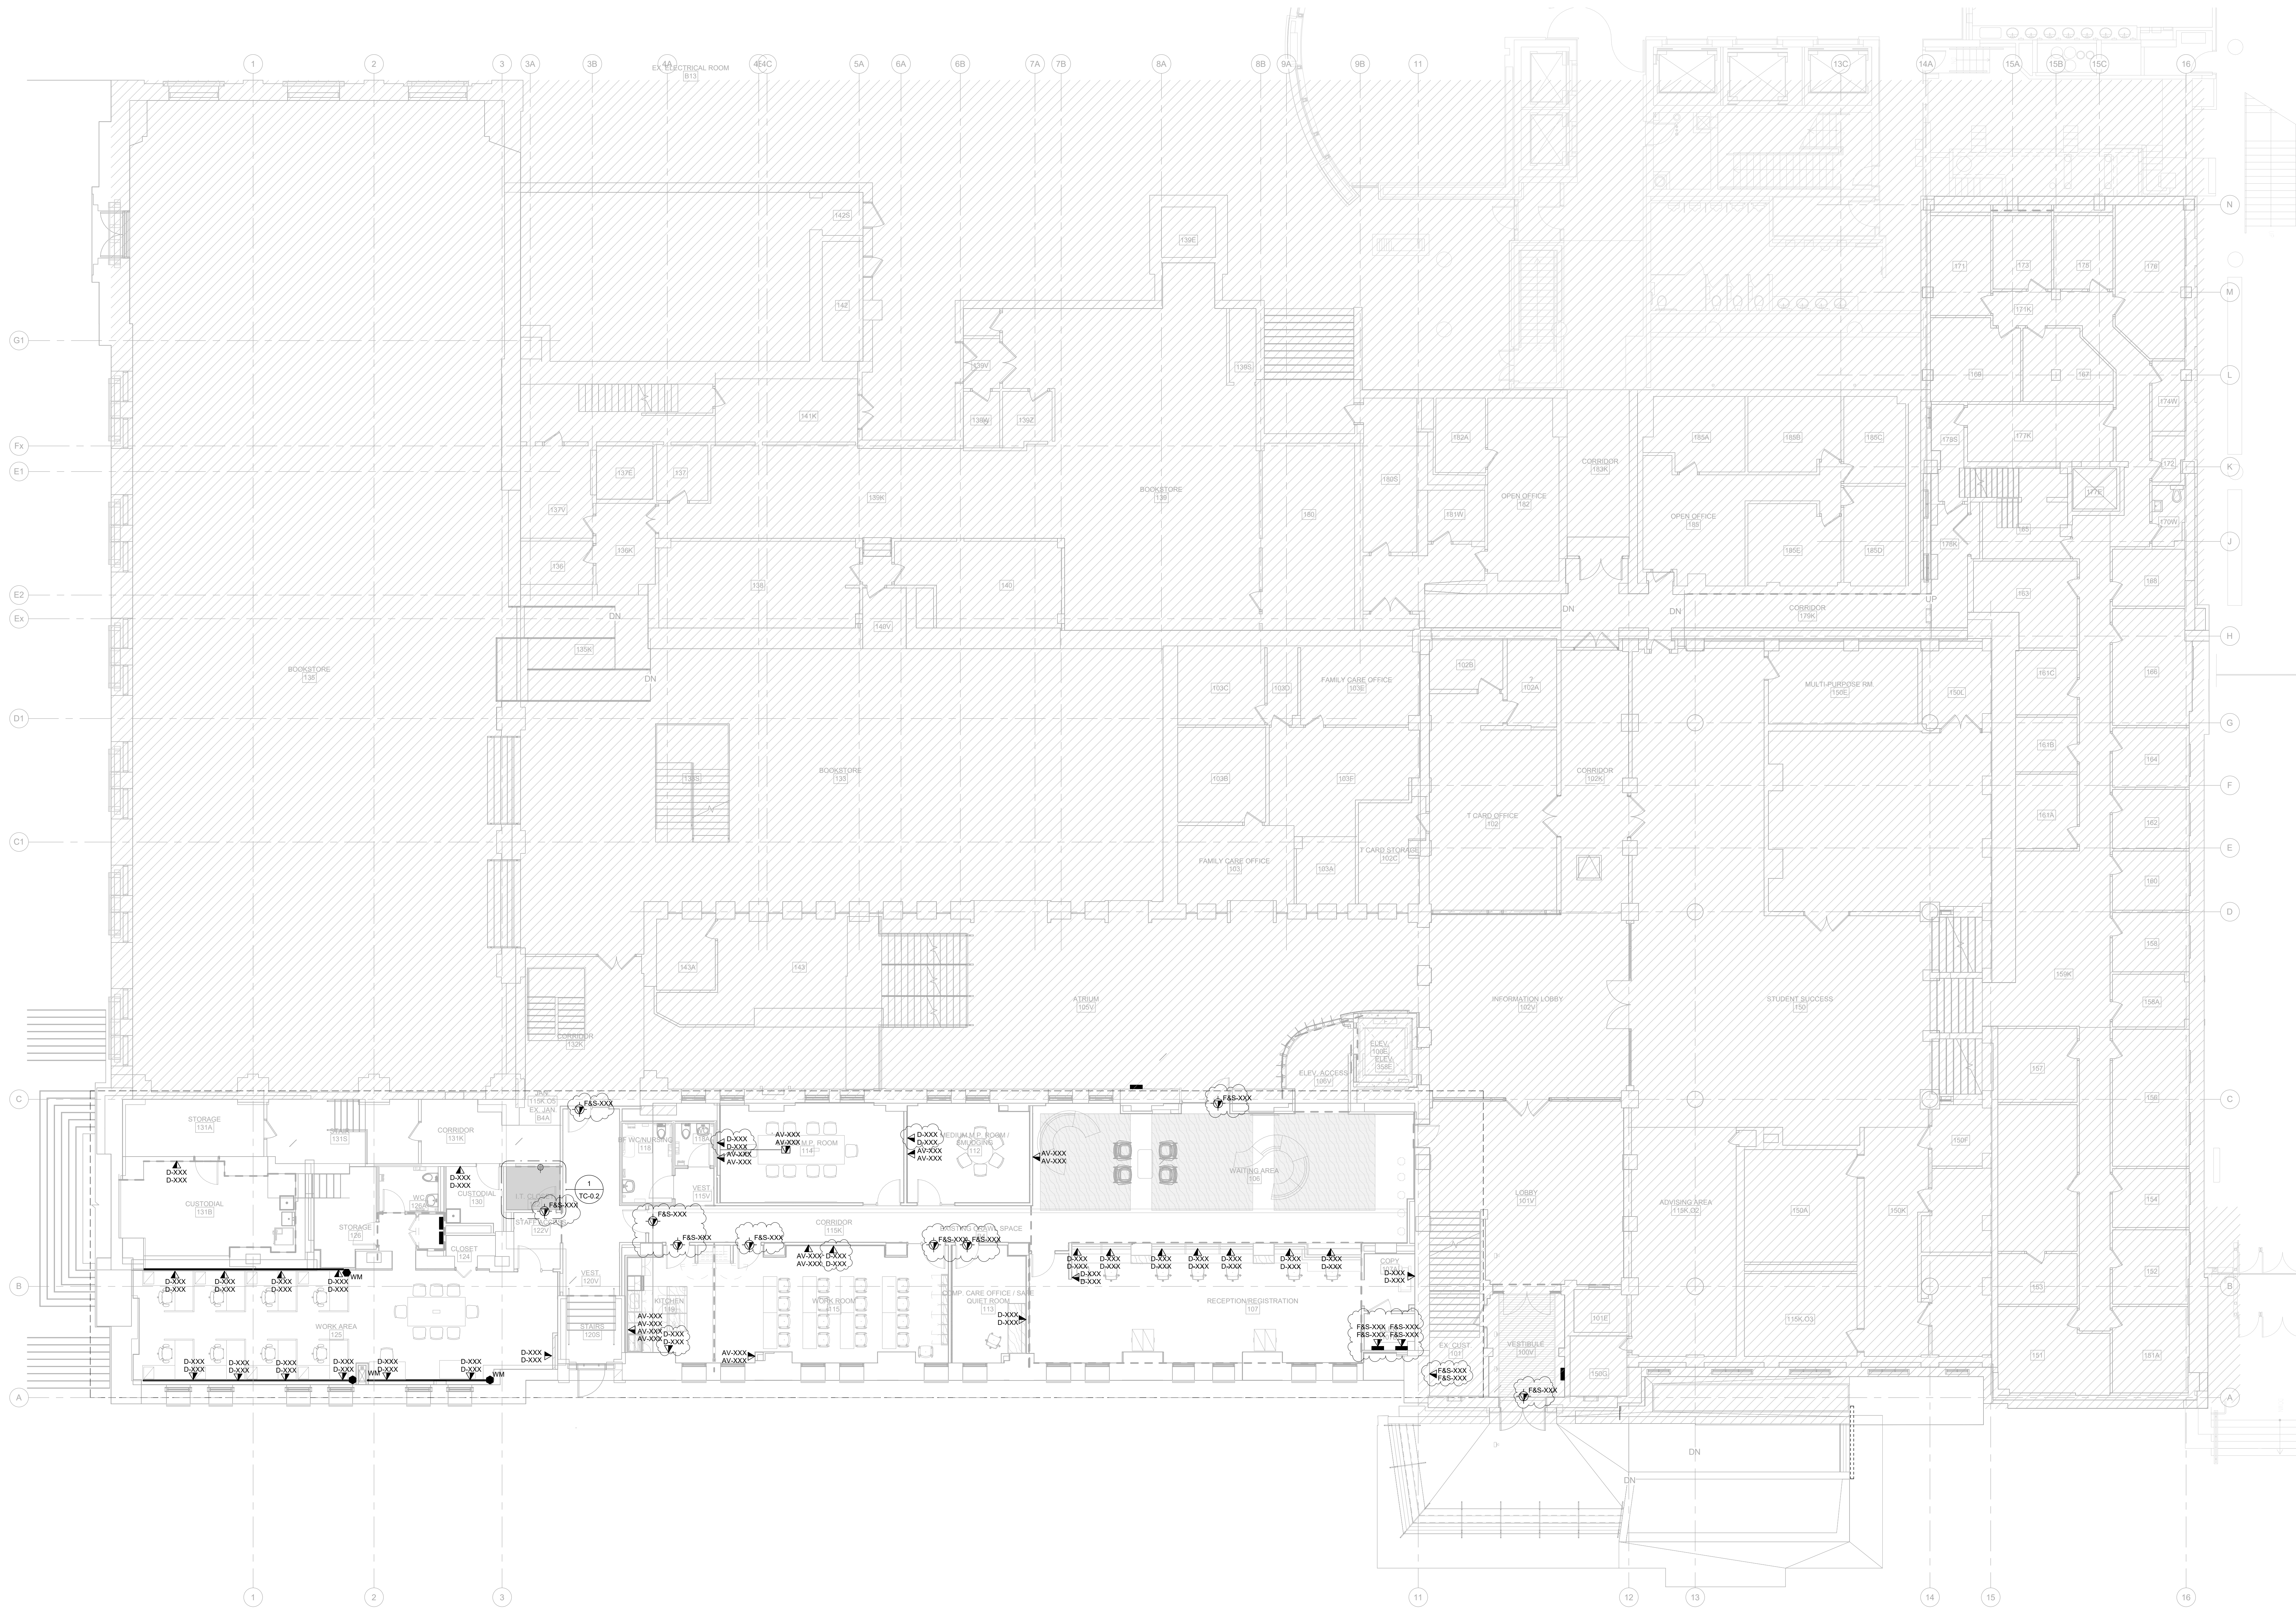

REVISION	
NO.	DESCRIPTION
1	2024-10-04 ISSUED FOR 50%
3	2024-12-04 ISSUED FOR FAS REVIEW
6	2025-01-31 ISSUED FOR BID
10	2025-03-25 BID ADDENDUM #04

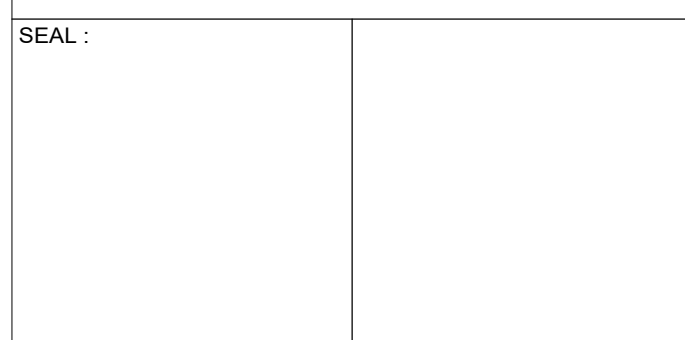


PROJECT:
**HEALTH AND WELLNESS
CENTRE RENOVATION AT
KOFFLER**

214 COLLEGE ST.
TORONTO, ON M5T 3A1
SHEET CONTENTS:
**LEVEL 01 COMMUNICATIONS
LAYOUT**

PROJECT NUMBER:
21590.003
DRAWING SCALE:
1 : 100

DRAWN BY: CHECKED BY: DATE:
Author Checker Issue Date

SHEET NO.: **TC-1.1** REV: **10**

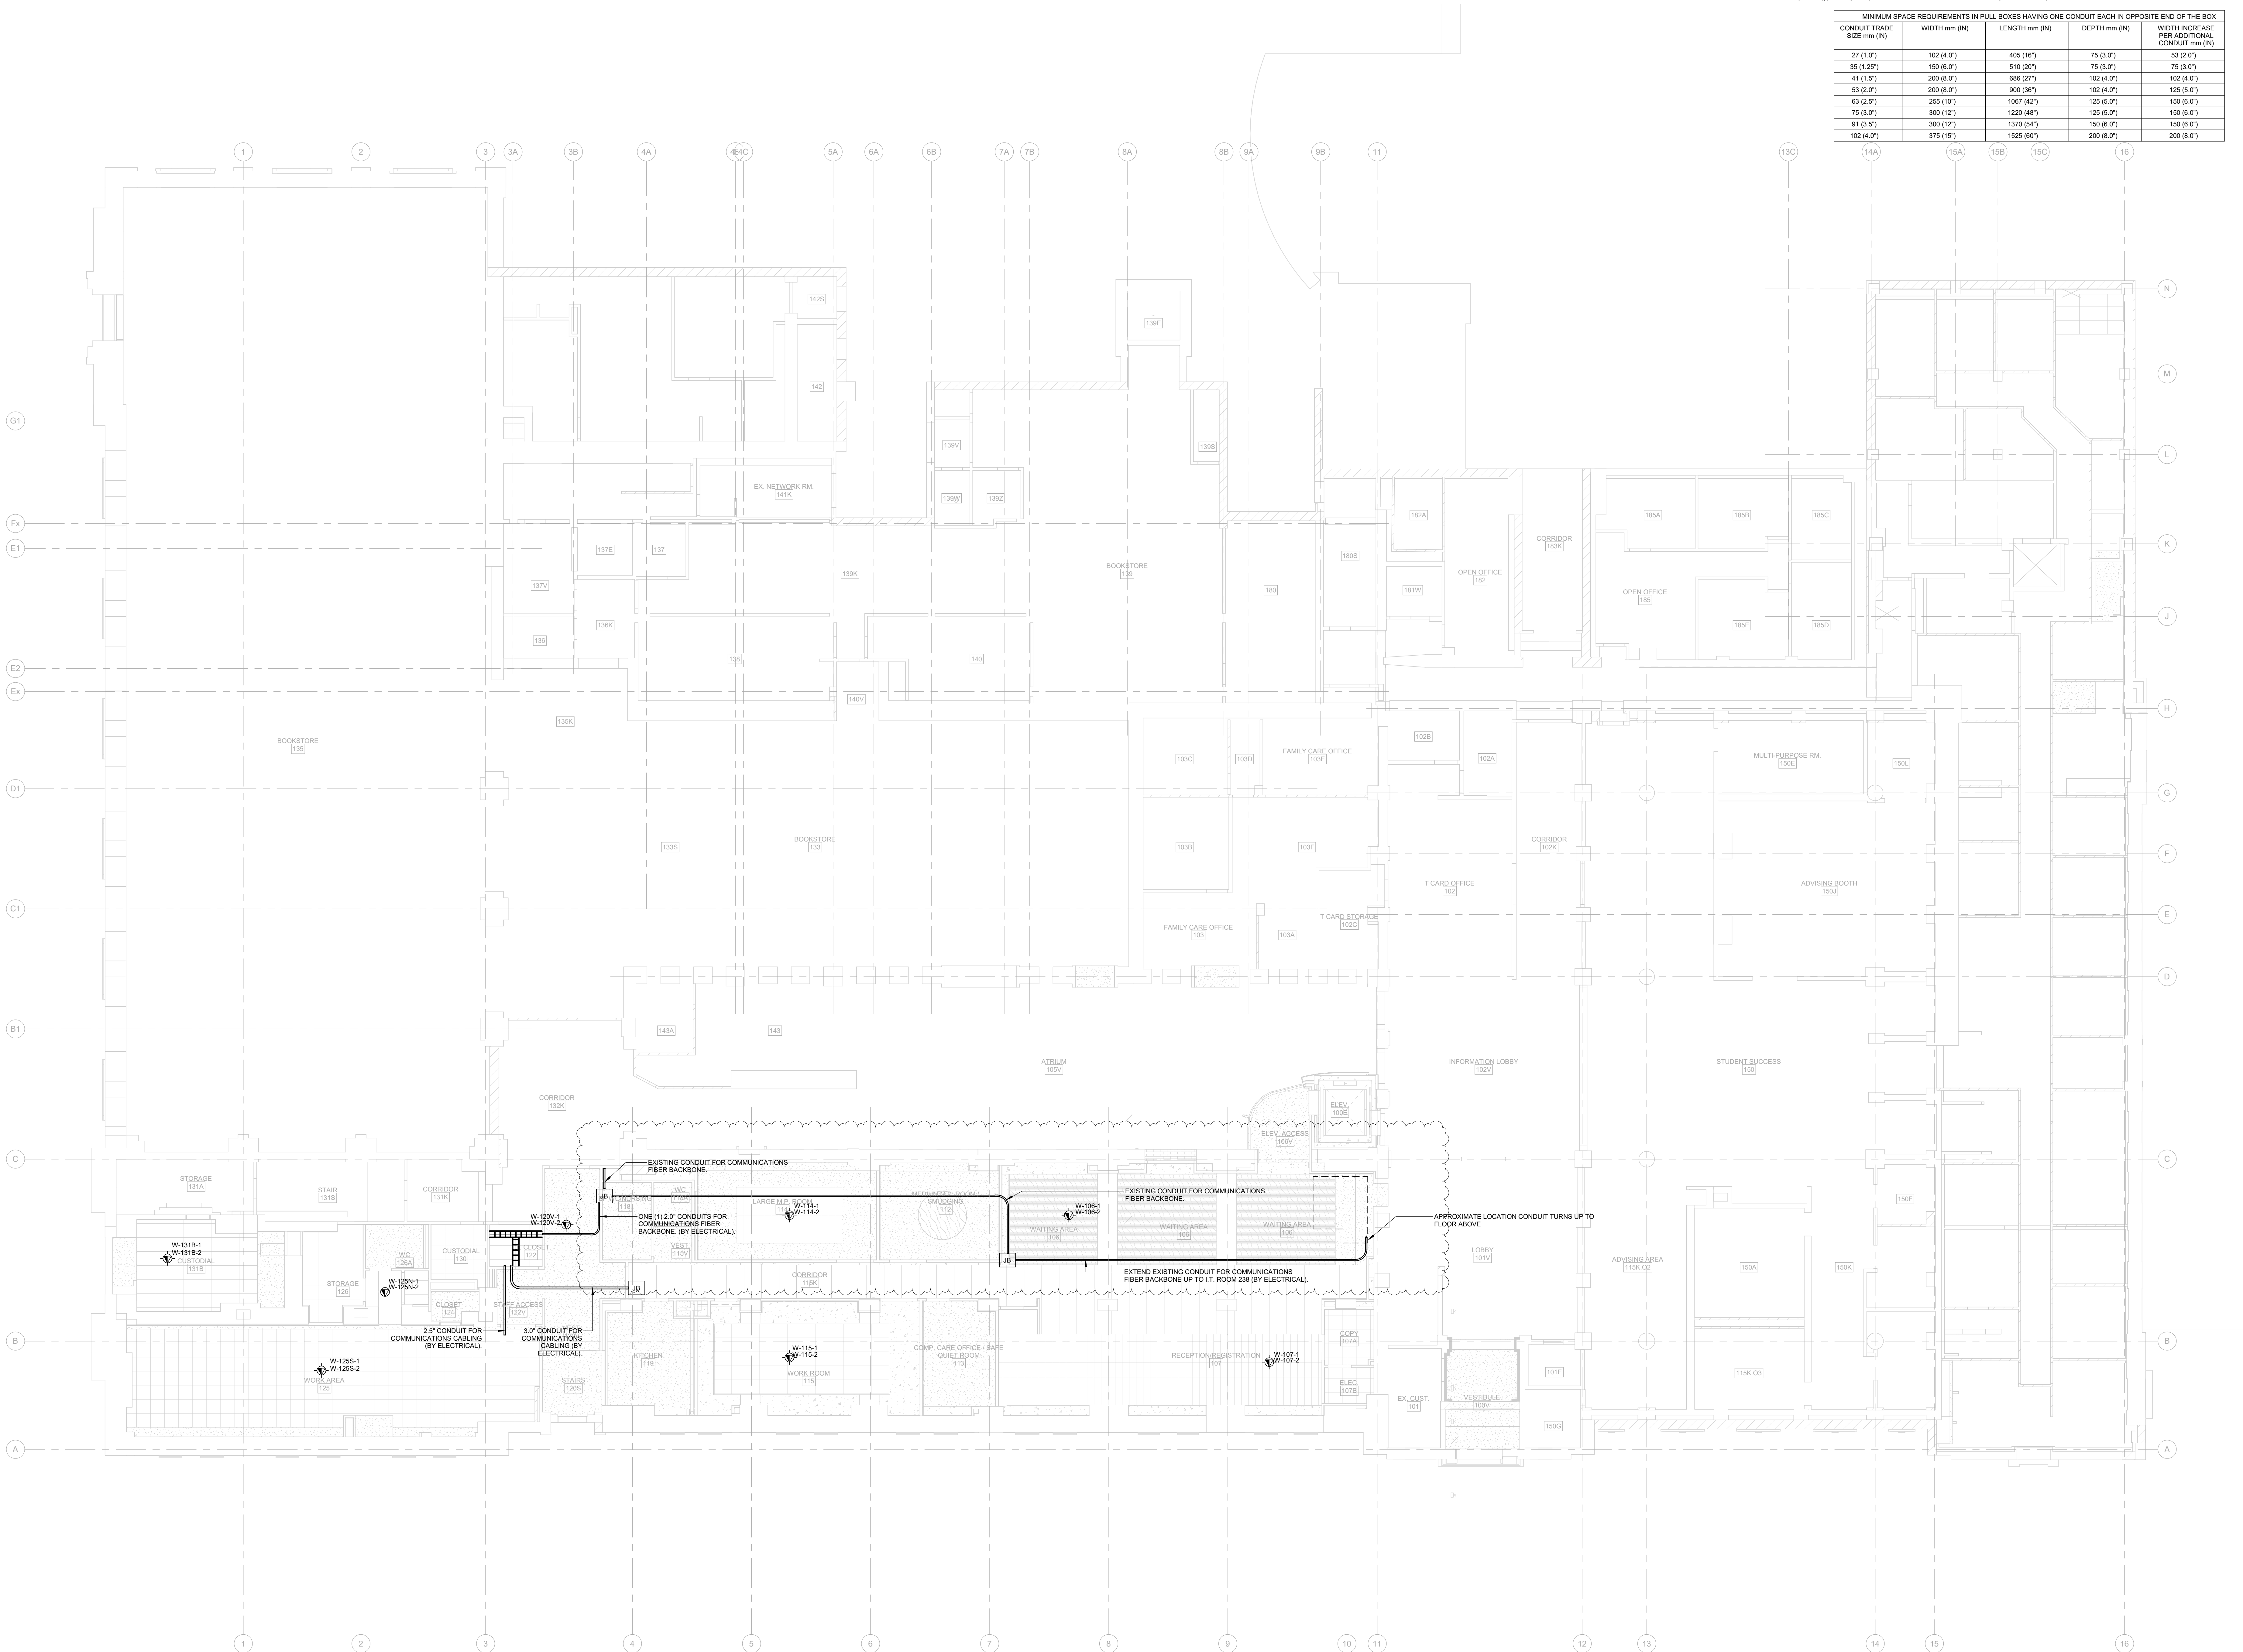

GENERAL NOTES:

1. INSTALL OWNER SUPPLIED WIRELESS ACCESS POINTS. COORDINATE WITH OWNER FOR WAP PICK UP FROM: UNIVERSITY OF TORONTO H-TS, 4 BANCROFT AVENUE, ROOM 103. USE CABLE LABELS NOTED ON PLAN.

2. ALL CONDUITS ARE PROVIDED BY ELECTRICAL CONTRACTOR. CONDUIT ROUTES SHOWN ARE DIAGRAMMATIC. ELECTRICAL CONTRACTOR TO VERIFY ROUTE ON SITE, MAKING ADJUSTMENTS AS NEEDED. ELECTRICAL CONTRACTOR TO PROVIDE PULL BOXES IN SECTIONS OF CONDUIT THAT ARE:


2.1. 30M (100FT) OR LONGER.

2.2. CONTAIN MORE THAN TWO 90 DEGREE BENDS, OR

2.3. CONTAIN A REVERSE BEND.

3. ADEQUATE PULL BOX SIZE SHALL BE DETERMINED BASED ON TABLE BELOW:

MINIMUM SPACE REQUIREMENTS IN PULL BOXES HAVING ONE CONDUIT EACH IN OPPOSITE END OF THE BOX				
CONDUIT TRADE SIZE mm (IN)	WIDTH mm (IN)	LENGTH mm (IN)	DEPTH mm (IN)	WIDTH INCREASE PER ADDITIONAL CONDUIT mm (IN)
27 (1.07)	102 (4.07)	405 (16")	75 (3.07)	53 (2.07)
35 (1.38)	150 (5.97)	510 (20")	75 (3.07)	75 (3.07)
41 (1.61)	200 (8.07)	595 (23")	102 (4.07)	102 (4.07)
53 (2.07)	200 (8.07)	900 (36")	102 (4.07)	125 (5.07)
63 (2.5)	255 (10")	1087 (42")	125 (5.07)	150 (6.07)
75 (3.07)	300 (12")	1230 (48")	125 (5.07)	150 (6.07)
91 (3.57)	300 (12")	1370 (54")	150 (6.07)	150 (6.07)
102 (4.07)	375 (15")	1525 (60")	200 (8.07)	200 (8.07)

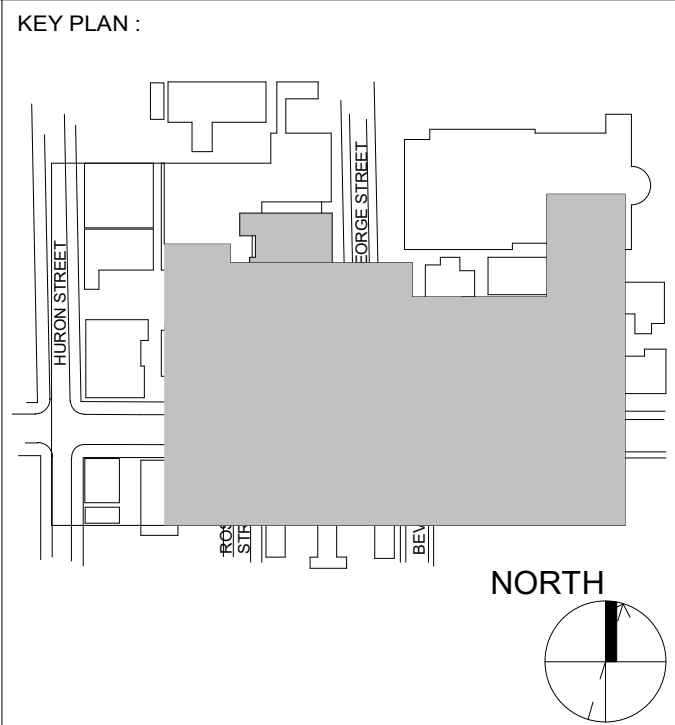

REVISION	
NO.	DATE DESCRIPTION
1	2024-10-04 ISSUED FOR 50%
3	2024-12-04 ISSUED FOR FAS REVIEW
6	2025-01-31 ISSUED FOR BID
10	2025-03-25 BID ADDENDUM #04



SEAL:



PROJECT:
**HEALTH AND WELLNESS
CENTRE RENOVATION AT
KOFFLER**

214 COLLEGE ST.
TORONTO, ON M5T 3A1



SHEET CONTENTS:
**LEVEL 01 WIRELESS ACCESS
POINT PLAN**

PROJECT NUMBER:
21590.003


DRAWING SCALE:
1 : 100

DRAWN BY: CHECKED BY: DATE: DATE:
Author Checker Issue Date

SHEET NO.: **TC-1.2** REV: **10**

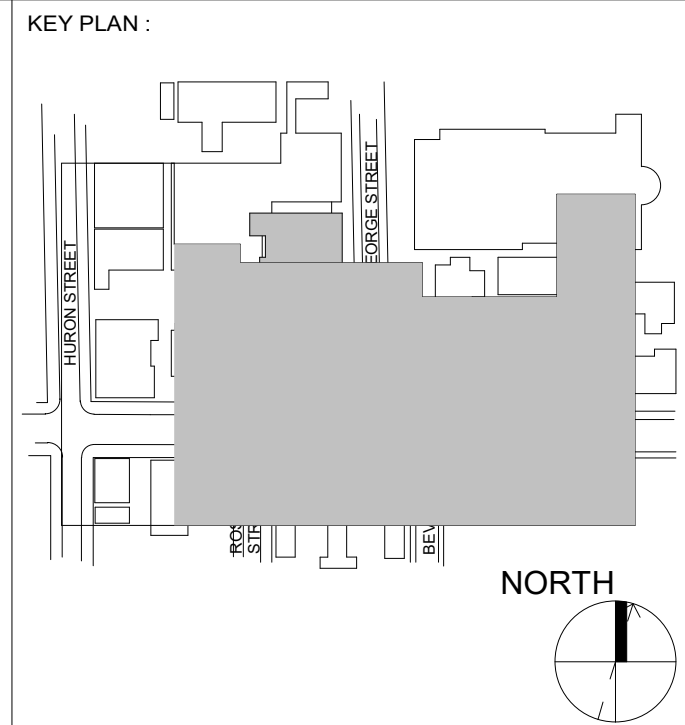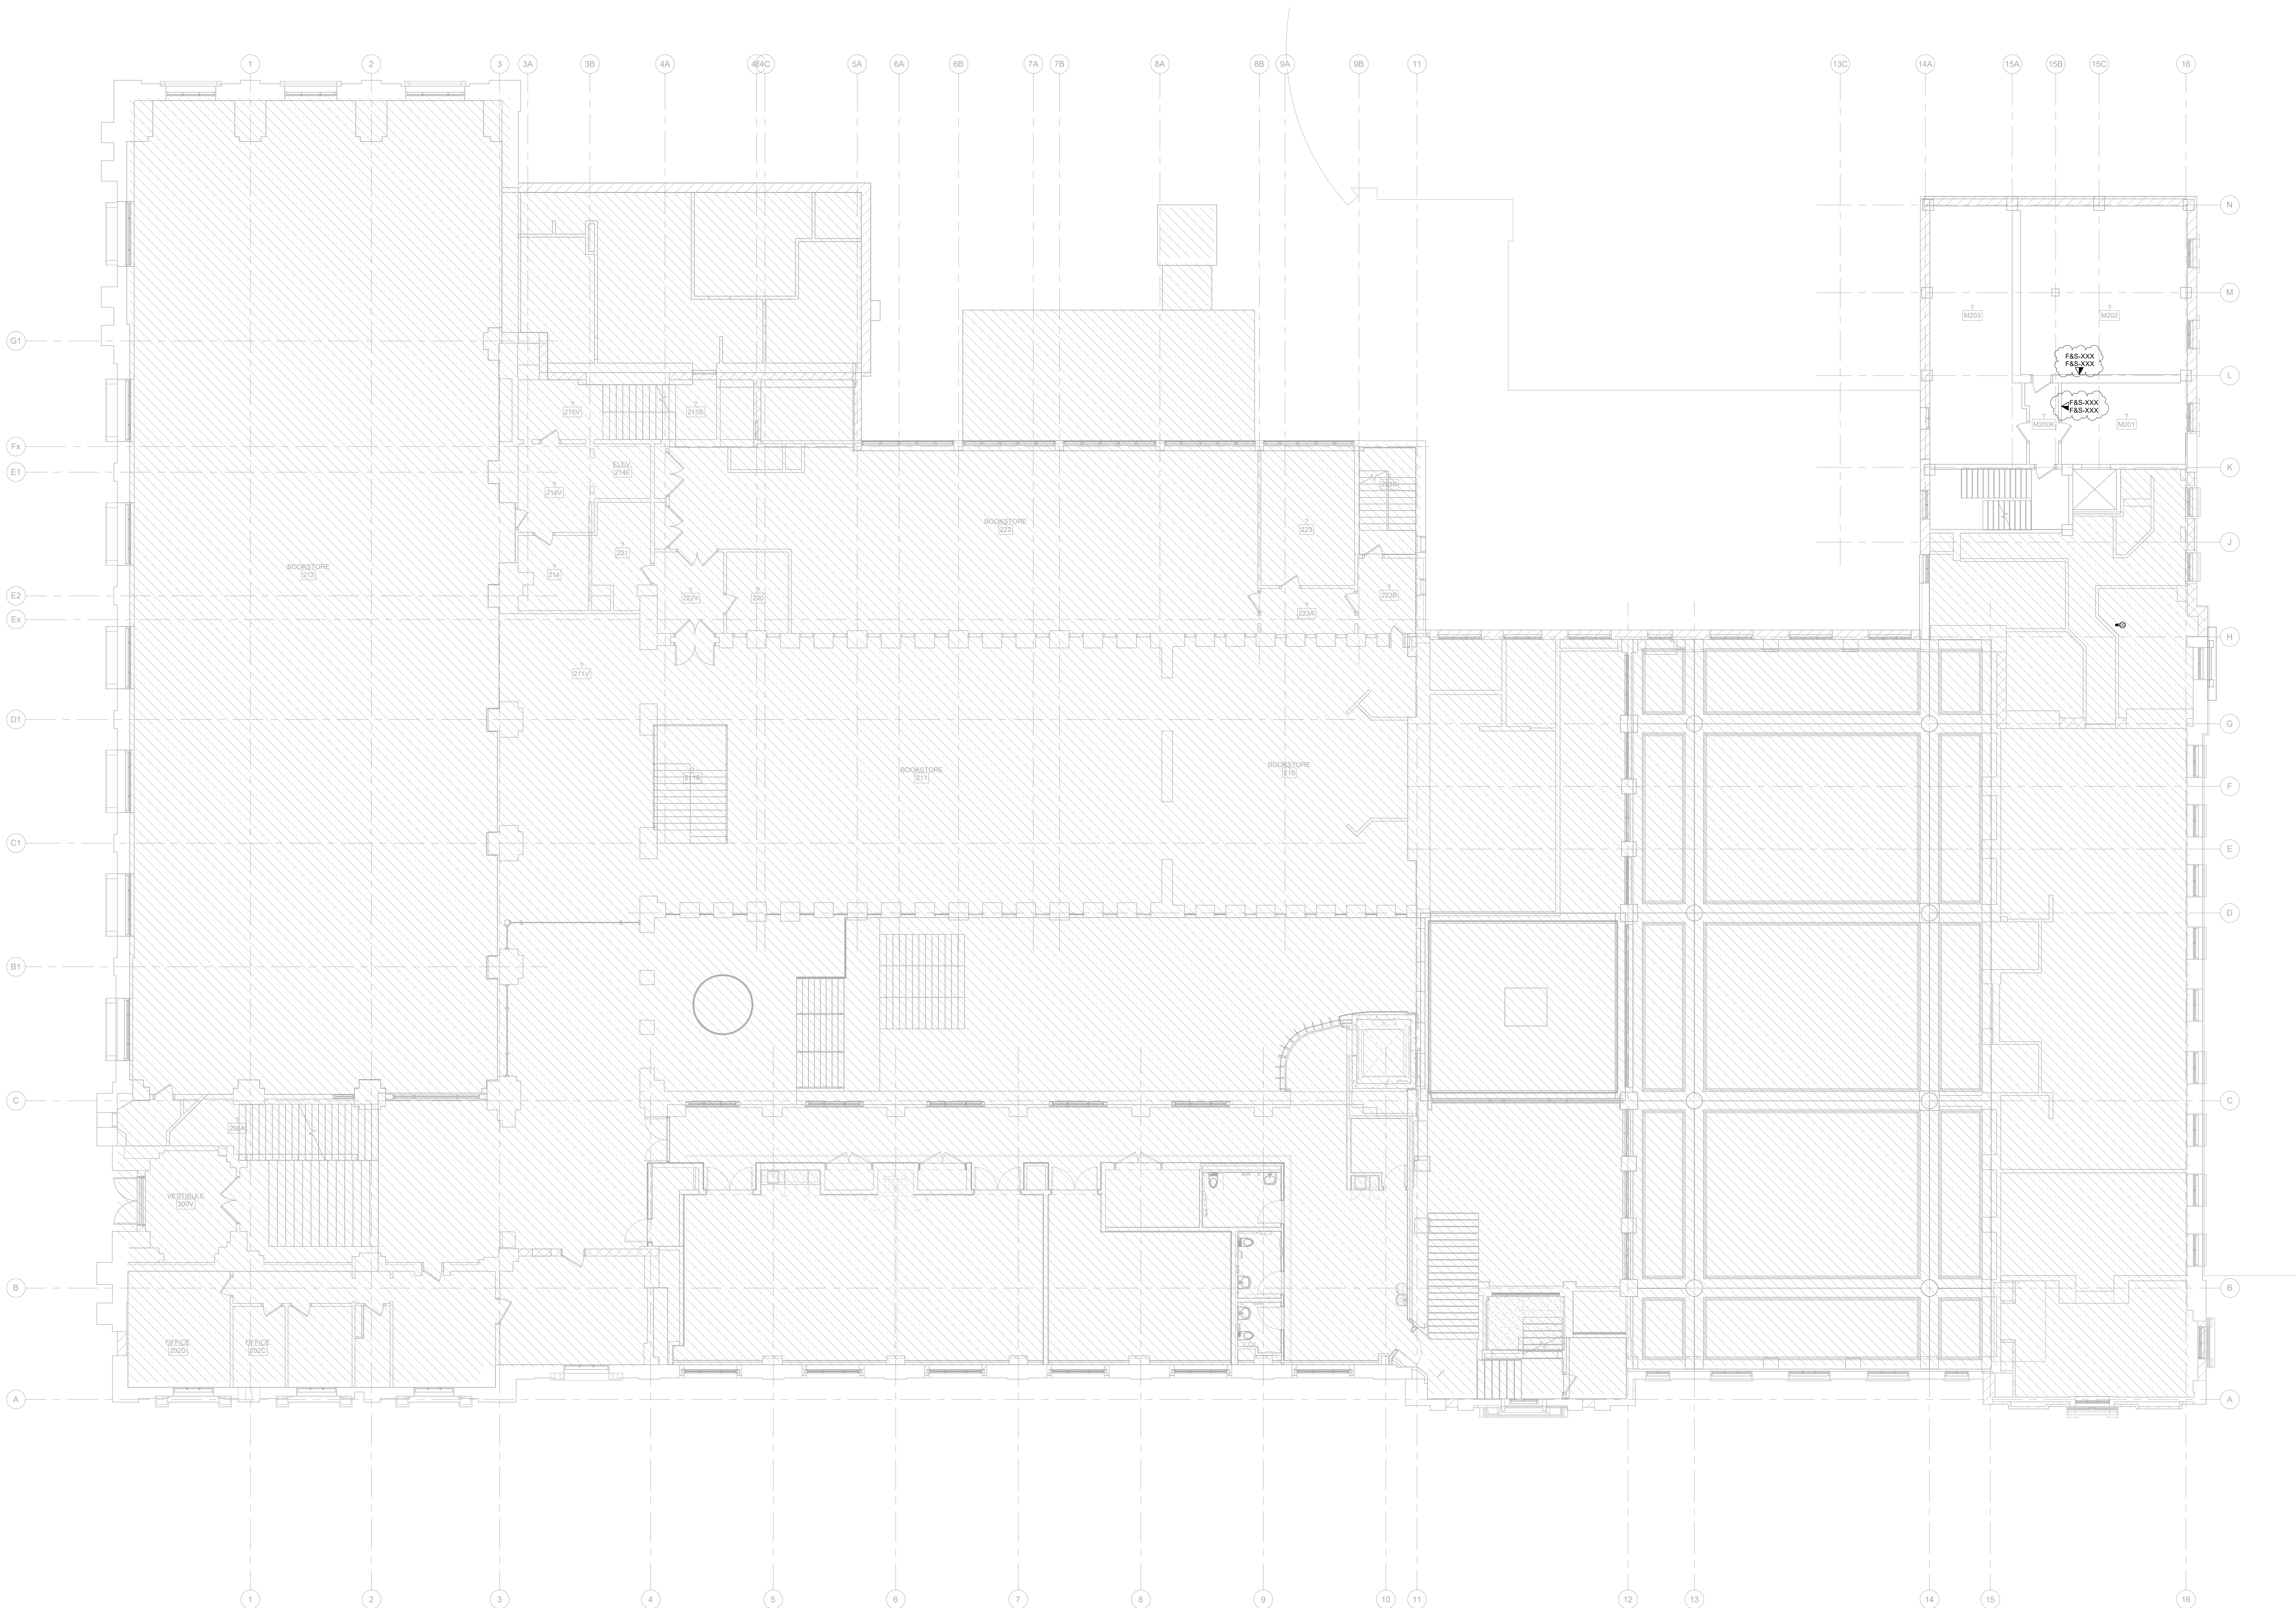

REVISION		
NO.	DATE	DESCRIPTION
10	2025-03-25	BID ADDENDUM #04

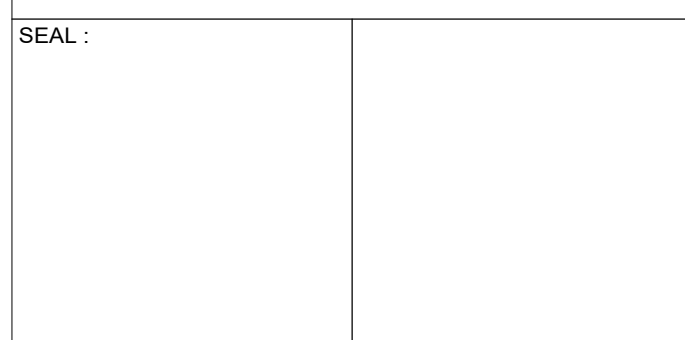

PROJECT:
**HEALTH AND WELLNESS
CENTRE RENOVATION AT
KOFFLER**

214 COLLEGE ST.
TORONTO, ON M5T 3A1

SHEET CONTENTS:
LEVEL 1 UPPER MEZZANINE

PROJECT NUMBER:
21590.003

DRAWING SCALE:
1 : 100

DRAWN BY: CHECKED BY: DATE:
Author Checker Issue Date

SHEET NO.: **TC-1M.1** REV: **10**

(N-1) COMMUNICATIONS CABLES LOCATED FROM THE DIVIDING LINE TO THE DIRECTION OF THE ARROW ARE TO BE TERMINATED AT I.T. CLOSET 235.

(N-2) COMMUNICATIONS CABLES LOCATED FROM THE DIVIDING LINE TO THE DIRECTION OF THE ARROW ARE TO BE TERMINATED AT I.T. ROOM 277.

(N-3) CONDUITS FOR COMMUNICATIONS ROUGH-INS TERMINATE AT NEAREST JUNCTION BOX.

A map of the study area showing the location of the study site (shaded gray) relative to Hinton Street, Dog Street, and the River. A north arrow is included.



ENFORM Architects Inc.
28A Sterling Road, Suite 302B
Toronto, Ontario, Canada M6R 2B7
t: 647-948-7523
www.enformarchitects.com




UNIVERSITY OF
TORONTO

14 COLLEGE ST,
TORONTO, ON M5T 3A1


PROJECT NUMBER :
1590.003
DRAWING SCALE :
1 : 100

DRAWN BY:	CHECKED BY:	DATE:
Author	Checker	Issue Date

SHEET NO:	REV:
TC-2.1	10

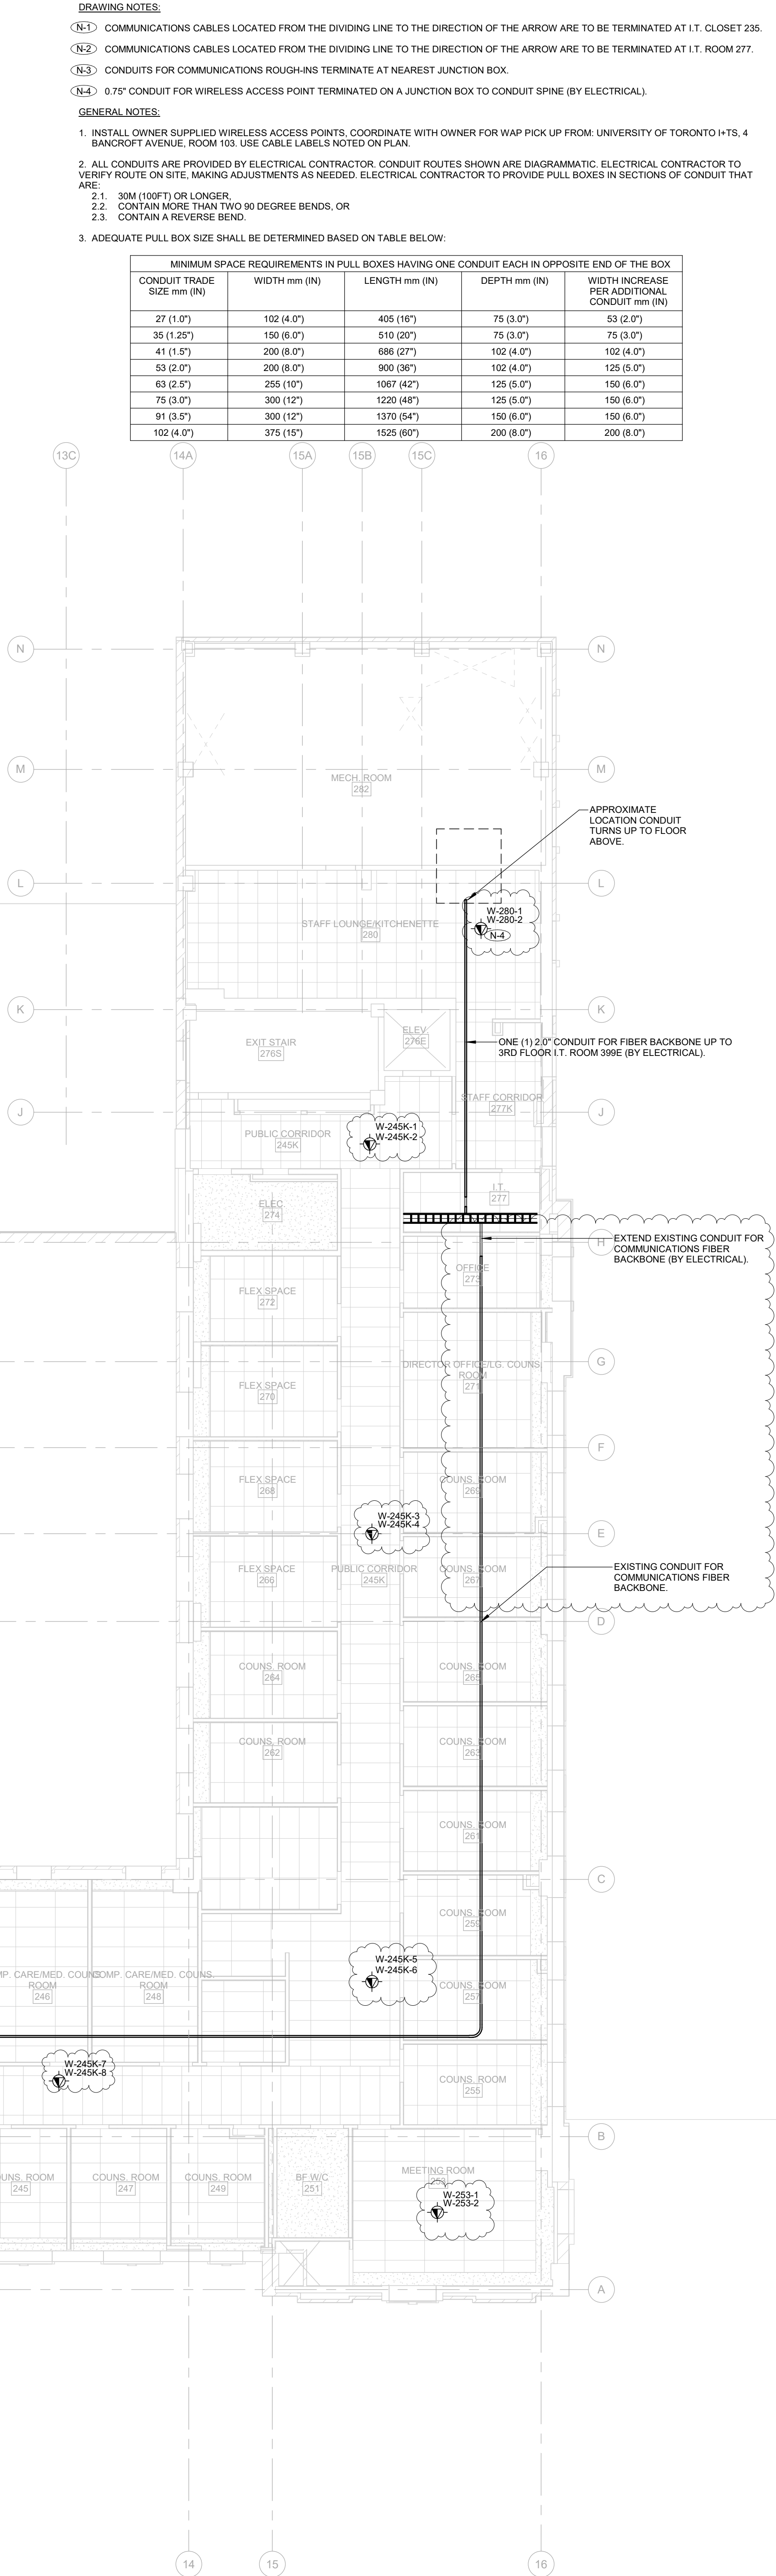

MINIMUM SPACE REQUIREMENTS IN PULL BOXES HAVING ONE CONDUIT EACH IN OPPOSITE END OF THE BOX				
CONDUIT TRADE SIZE (mm (IN))	WIDTH (mm (IN))	LENGTH (mm (IN))	DEPTH (mm (IN))	WIDTH INCREASE PER ADDITIONAL CONDUIT (mm (IN))
27 (1.07)	102 (4.0)	406 (16")	75 (3.0")	53 (2.0")
31 (1.25)	150 (6.0)	554 (22")	75 (3.0")	75 (3.0")
41 (1.57)	200 (8.0)	686 (27")	102 (4.0")	102 (4.0")
51 (2.0)	250 (10.0)	803 (31")	102 (4.0")	125 (5.0")
63 (2.5)	255 (10")	1067 (42")	125 (5.0")	150 (6.0")
75 (3.0)	325 (12.5)	1220 (48")	125 (5.0")	150 (6.0")
91 (3.57)	300 (12")	1370 (54")	150 (6.0")	150 (6.0")
102 (4.0)	375 (15")	1525 (60")	200 (8.0")	200 (8.0")

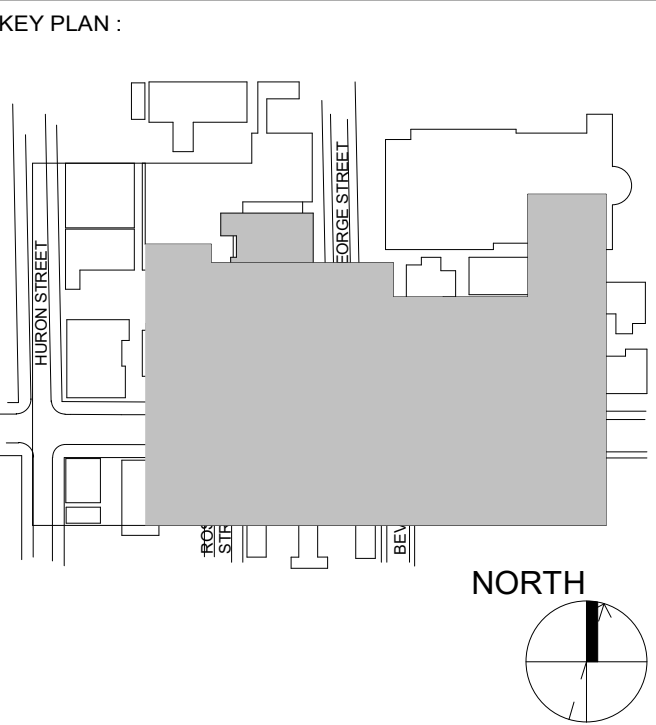

REVISION		
NO.	DATE	DESCRIPTION
	2024-10-04	ISSUED FOR 50%
	2024-12-04	ISSUED FOR F&S REVIEW
	2025-01-31	ISSUED FOR BID
0	2025-03-25	BID ADDENDUM #04



ENFORM
architects

ENFORM Architects Inc.
128A Sterling Road, Suite 302B
Toronto, Ontario, Canada M6R 2B7
t: 647-948-7523
www.enformarchitects.com

SEAL



PROJECT :
HEALTH AND WELLNESS
CENTRE RENOVATION AT
KOFFLER

214 COLLEGE ST,
TORONTO, ON M5T 3A1


SHEET CONTENTS :

**LEVEL 02 WIRELESS ACCESS
POINT PLAN**


PROJECT NUMBER : 21590.003		
DRAWING SCALE : 1 : 100		
DRAWN BY : Author	CHECKED BY : Checker	DATE: Issue Date

SHEET NO :
TC-2.2

DRAWING NOTES:
(N1) COMMUNICATIONS CABLES LOCATED FROM THE DIVIDING LINE TO THE DIRECTION OF THE ARROW ARE TO BE TERMINATED AT I.T. ROOM 325B.
(N2) COMMUNICATIONS CABLES LOCATED FROM THE DIVIDING LINE TO THE DIRECTION OF THE ARROW ARE TO BE TERMINATED AT I.T. ROOM 399E.

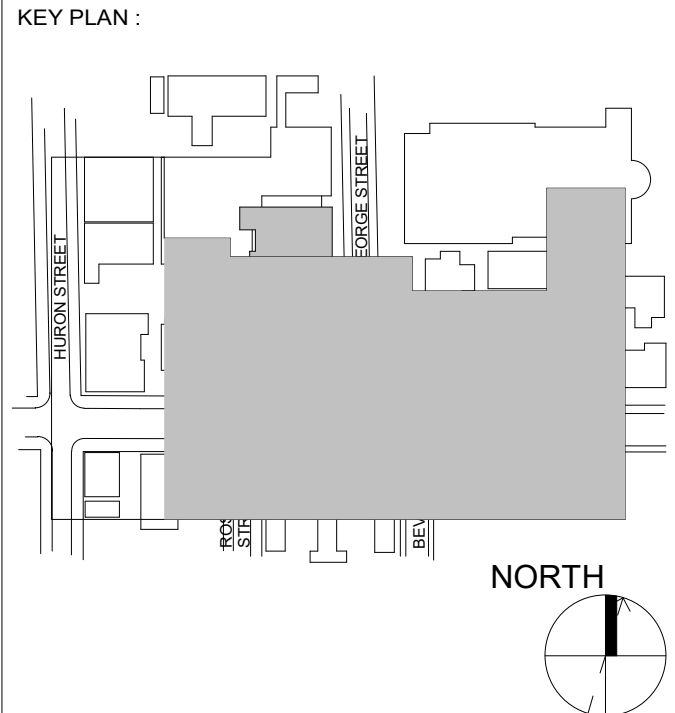

REVISION		
NO.	DATE	DESCRIPTION
1	2024-10-04	ISSUED FOR 50%
3	2024-12-04	ISSUED FOR F&S REVIEW
6	2025-01-31	ISSUED FOR BID
10	2025-03-25	BID ADDENDUM #04

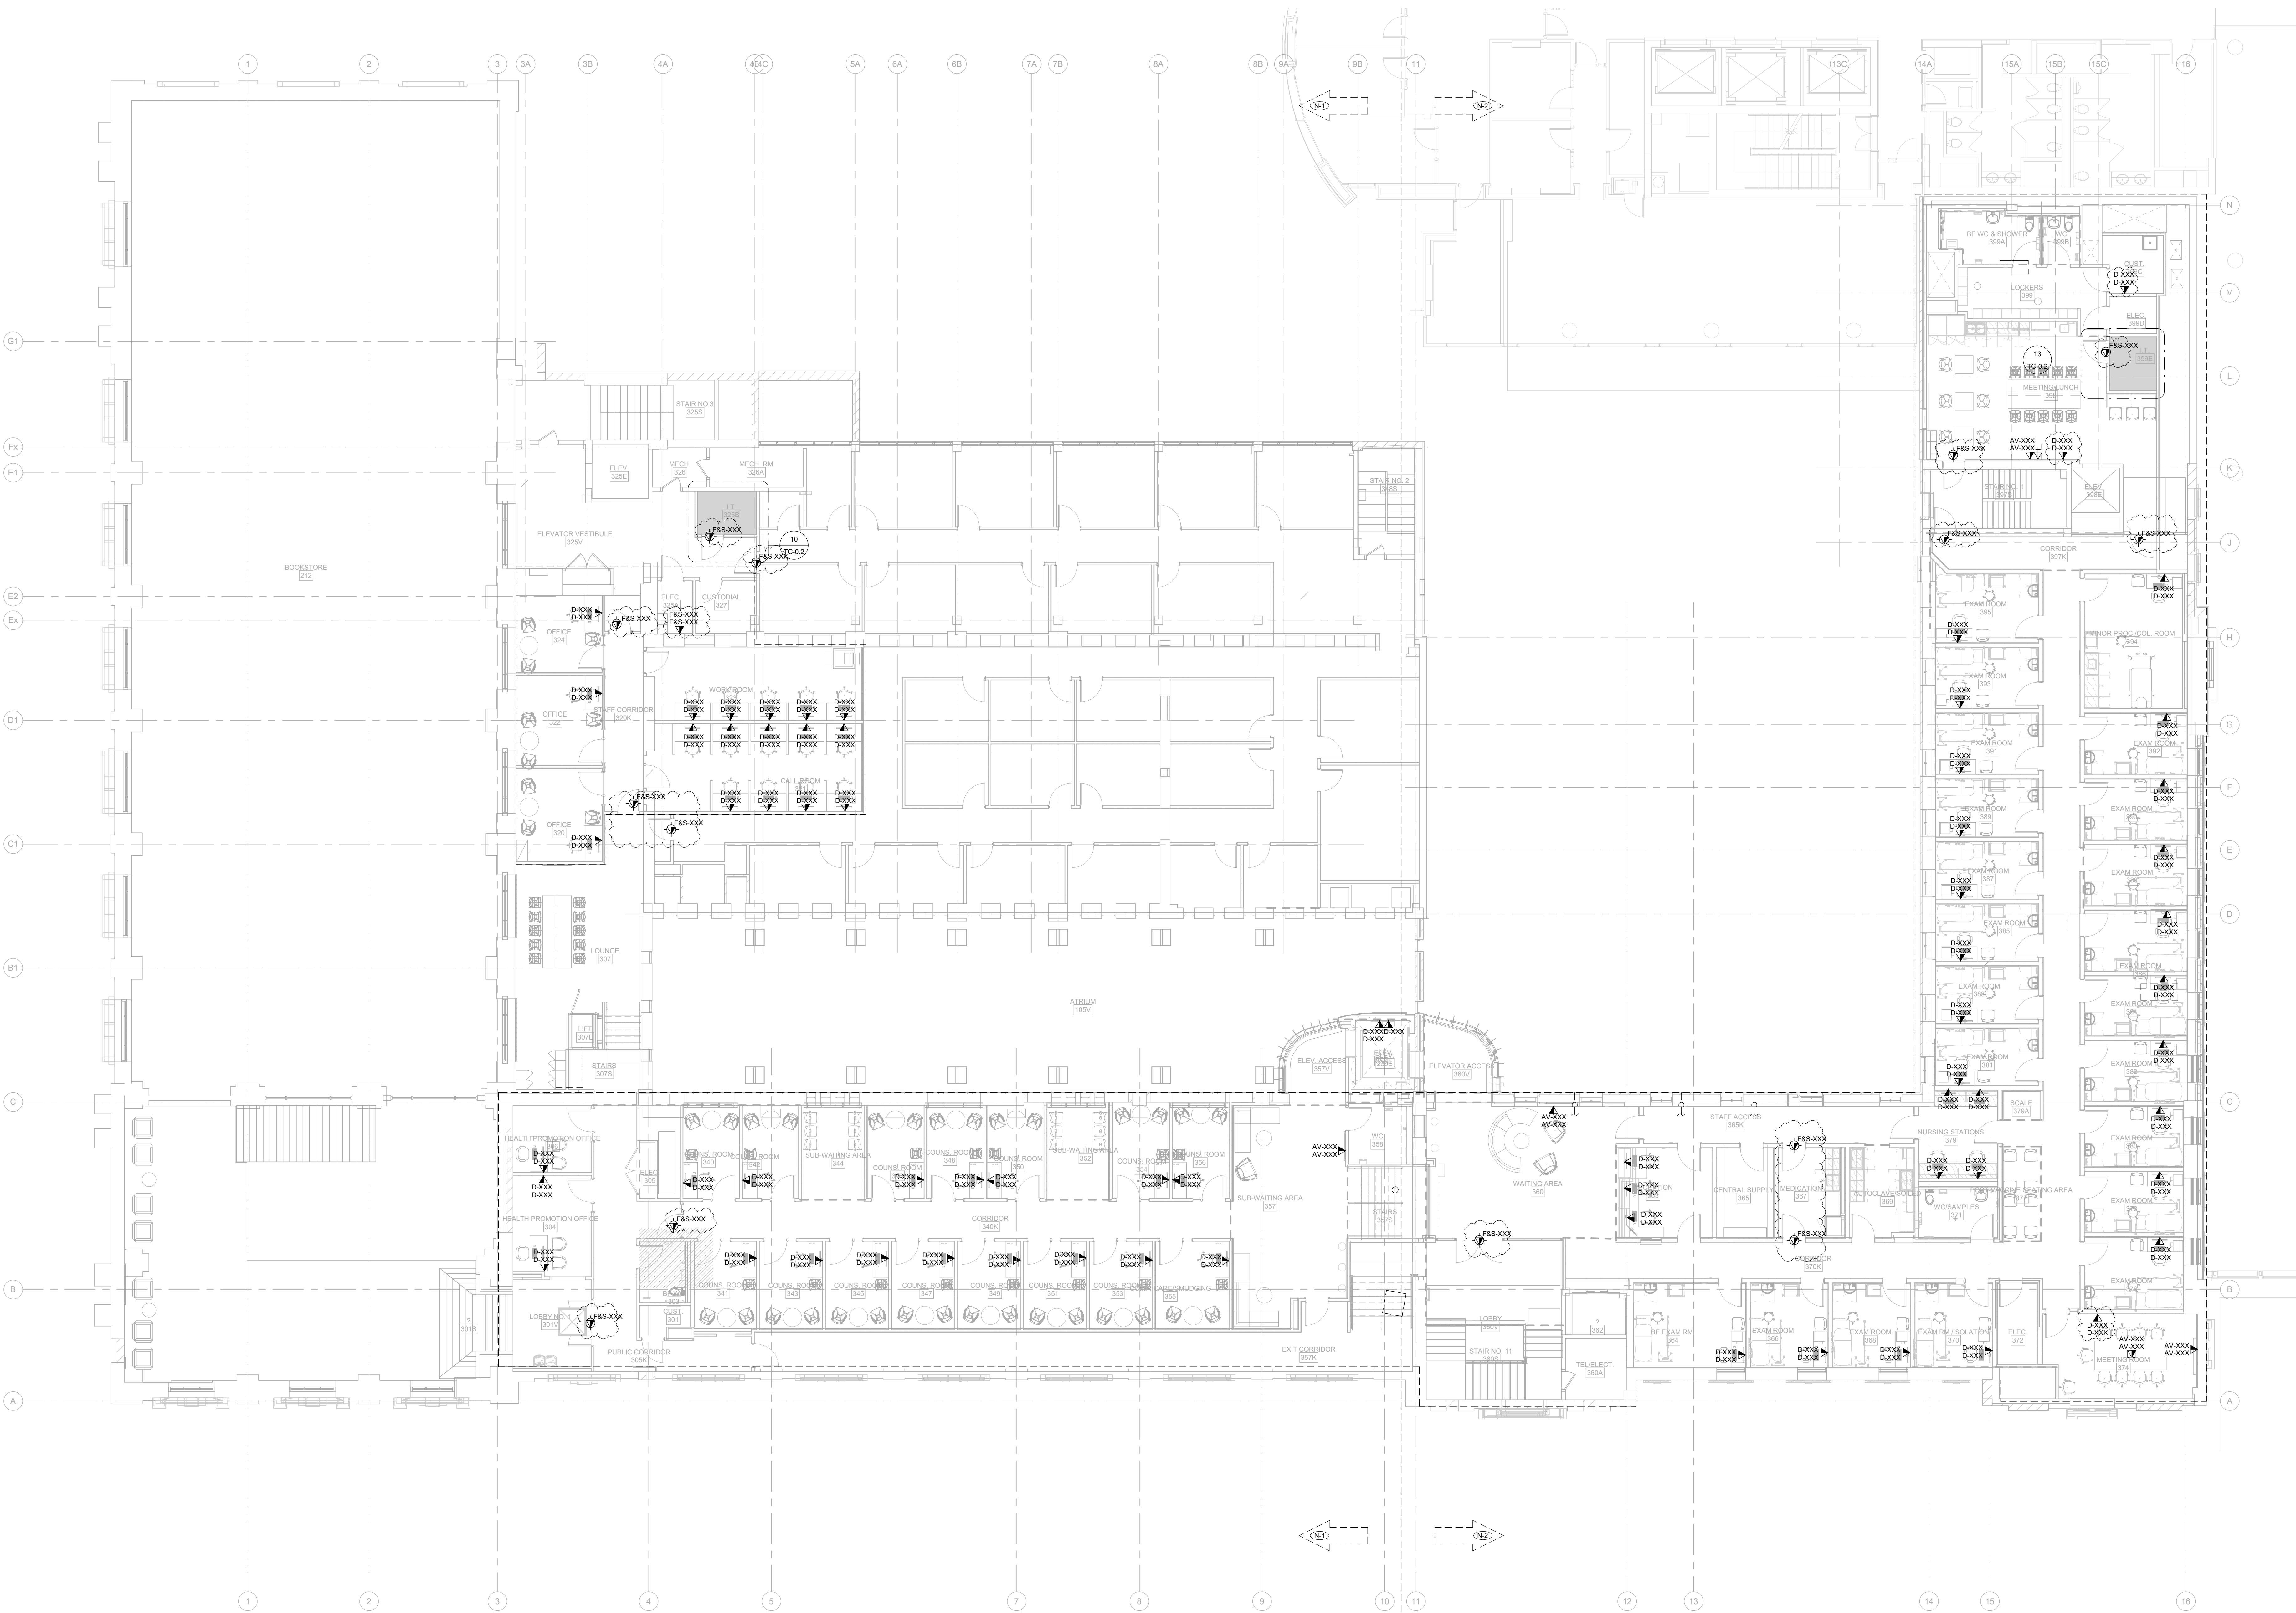

SEAL:



PROJECT:
HEALTH AND WELLNESS
CENTRE RENOVATION AT
KOFFLER


214 COLLEGE ST.
TORONTO, ON M5T 3A1

SHEET CONTENTS:
LEVEL 03 COMMUNICATIONS
LAYOUT

PROJECT NUMBER:
21590.003
DRAWING SCALE:
1 : 100

DRAWN BY: CHECKED BY: DATE:
Author Checker Issue Date

SHEET NO.: REV:
TC-3.1 10

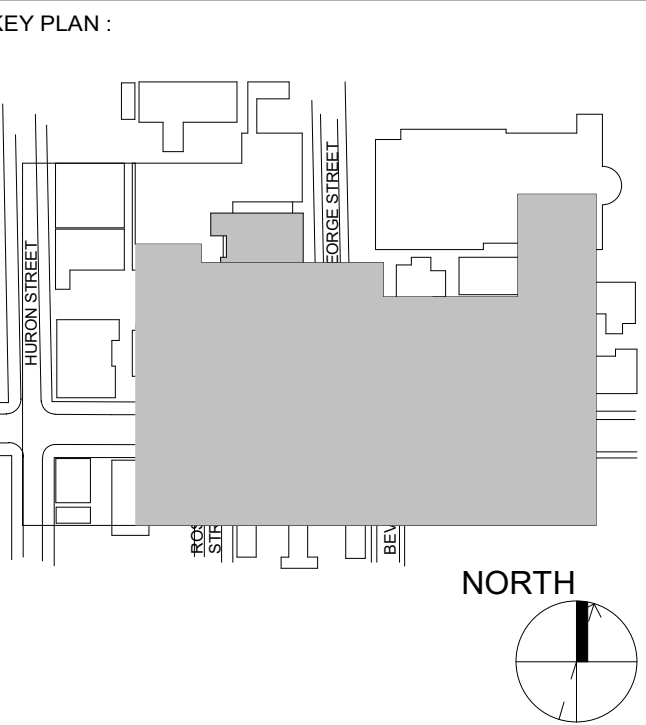

REVISION		
O.	DATE	DESCRIPTION
	2024-10-04	ISSUED FOR 50%
	2024-12-04	ISSUED FOR F&S REVIEW
	2025-01-31	ISSUED FOR BID
	2025-03-25	BID ADDENDUM #04



ENFORM
architects

ENFORM Architects Inc.
128A Sterling Road, Suite 302B
Toronto, Ontario, Canada M6R 2B7
t: 647-948-7523
www.enformarchitects.com

AL



PROJECT :
HEALTH AND WELLNESS
CENTRE RENOVATION AT
KOFFLER

14 COLLEGE ST,
TORONTO, ON M5T 3A1

SHEET CONTENTS :

LEVEL 03 WIRELESS ACCESS	1
POINT PLAN	1

PROJECT NUMBER
1590 003

DRAWING SCALE:

1 : 100



RAWN BY :
author

SHEET NO :

TC-2

1C-5.2

10

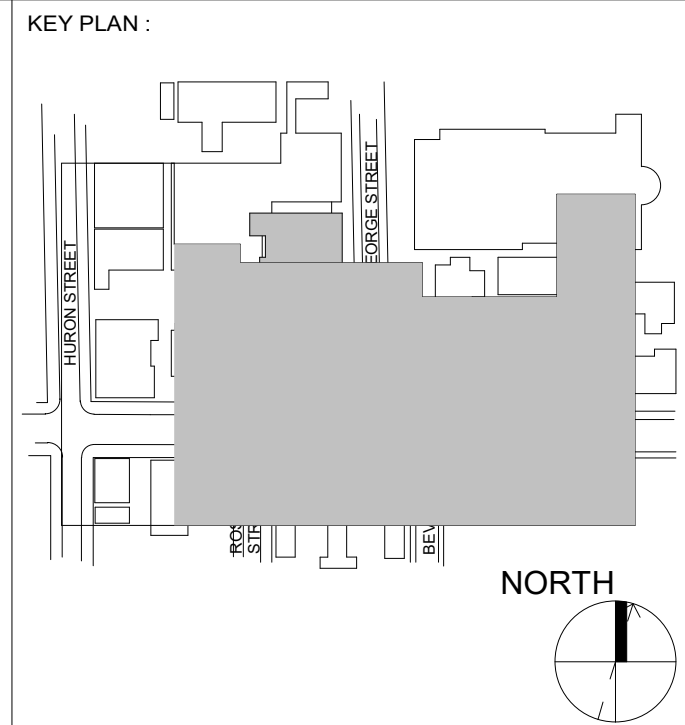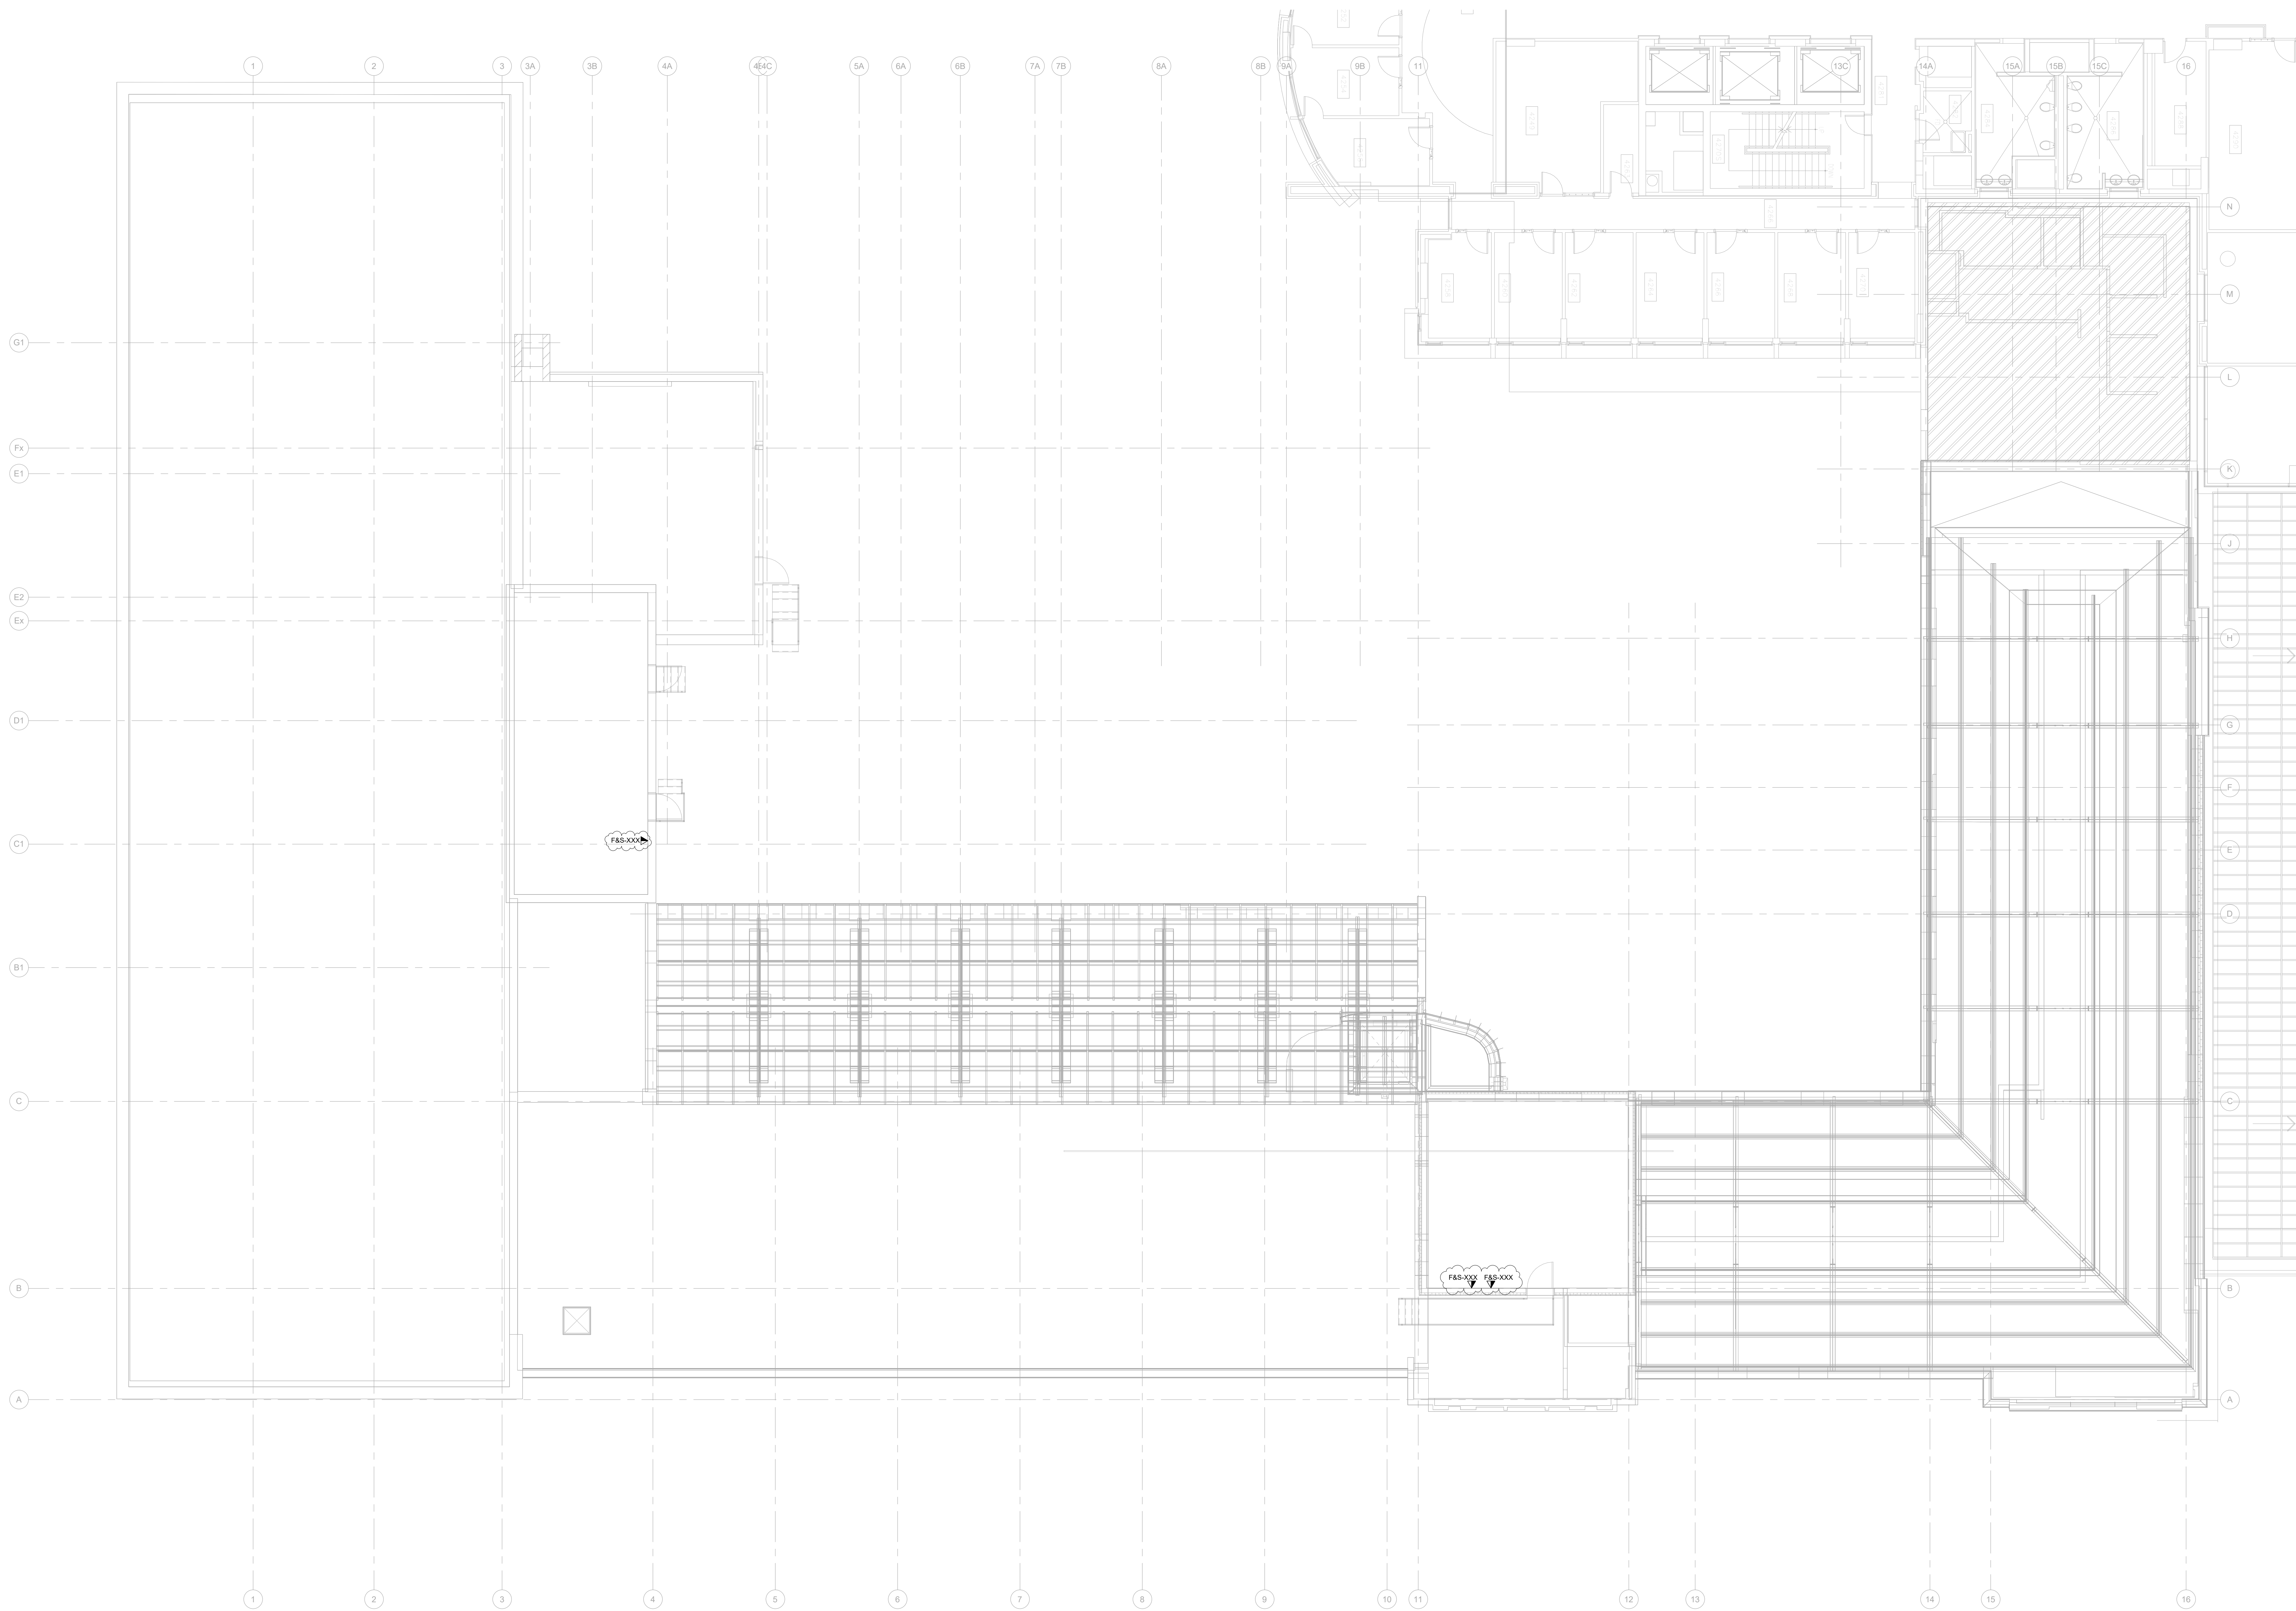

REVISION		
NO.	DATE	DESCRIPTION
1	2024-10-04	ISSUED FOR 50%
10	2025-03-25	BID ADDENDUM #04



SEAL:



PROJECT:
**HEALTH AND WELLNESS
CENTRE RENOVATION AT
KOFFLER**

214 COLLEGE ST.
TORONTO, ON M5T 3A1

SHEET CONTENTS:
**MECHANICAL PENTHOUSE
COMMUNICATIONS LAYOUT**

PROJECT NUMBER:
21590.003

DRAWING SCALE:
1 : 100

DRAWN BY: CHECKED BY: DATE:
Author Checker Issue Date

SHEET NO.: **TC-MP.1** REV: **10**