

**PART 1 - ADDENDUM**

**1.1. INTENT**

- 1.1.1. This Addendum is issued to provide for modifications and/or clarifications during Bidding and forms part of Bid and Contract Documents for above Project.
- 1.1.2. Except as otherwise specified herein, or as shown on accompanying Drawings, work required by this Addendum shall be in accordance with Specifications dated January 31, 2025 and Drawings accompanying same and previously issued Addenda.

**PART 2 - SPECIFICATIONS - PROCUREMENT AND CONTRACTING REQUIREMENTS GROUP AND SPECIFICATIONS GROUP**

**2.1. SPECIFICATIONS REVISIONS**

- 2.1.1. Specification pages listed below accompany and form part of this Addendum.
- 2.1.2. Each revised Section voids and supersedes previously issued Section of same number in its entirety. Each page is marked at bottom with a "Revised & Reissued" entry that includes date of this issue. Extent of new, revised and/or deleted text is defined by leading and trailing 1... ..1 symbol, as applicable.
- 2.1.3. A new Section is added with this issue. Each page is marked at bottom with an "Issued" entry that includes date of this issue.
- 2.1.4. Revised Sections and Pages:

<u>Section Number</u>	<u>Rev No.</u>	<u>Section Title</u>	<u>Page Numbers</u>
00 01 10	05	Table of Contents	1 thru 8
09 72 17	00	Hygienic Vinyl Wall and Ceiling Panels	1 thru 6

**PART 3 - CLARIFICATIONS**

**3.1. GENERAL CLARIFICATIONS**

- 3.1.1. Following are general clarification items which form part of this Addendum:
  - 3.1.1.1. Question No. 69:
    - 3.1.1.1.1. Question: Please confirm width of ceiling C5, 2498 mm, above entries/ vestibules (bulkheads) into Rooms 231, 233 and 235, and note in section 7/A602.
    - 3.1.1.1.2. Answer: Widths added to Drawings A313 and A602.
  - 3.1.1.2. Question No. 70:
    - 3.1.1.2.1. Question: Please clarify the callout for F10A wall finish at the face of the bulkhead in Lounge 237, 2/A213. This only in reference to the 100 mm vertical return, and F10A does not continue up the face of the bulkhead?
    - 3.1.1.2.2. Answer: F10B continues to underside of bulkhead. Note added which states that the F10A upturn is only 100 mm high. Reference Section added.
  - 3.1.1.3. Question No. 71:
    - 3.1.1.3.1. Question: Please clarify: In Addendum 03, wood ceiling C5 is deleted from details 12,13/A600, but C5 is still in the area concerned with 12,13/A600 on RCP Plan A313.
    - 3.1.1.3.2. Answer: The reference Tag has been removed from Drawing A313. C5 is not shown in 12/A600 or 13/A600.

- 3.1.1.4. Question No. 72:
- 3.1.1.4.1. Question: Please clarify: In Addendum 03, wood ceiling C5 is deleted from details 7/A602. Also, wood ceiling panels have to be fixed on ceiling support system which S&I by others instead of adhered to GWB substrate shown on 7/A602.
- 3.1.1.4.2. Answer: Given the construction of the bulkhead, wood panels are to be adhered to gypsum substrate as a separate type, not C5.
- 3.1.1.5. Question No. 73:
- 3.1.1.5.1. Question: Please provide specification for RF-3 and CT-2 as per addendum #5. Please confirm LVT-1 for wall finish at level 3 couns. room as per room finish schedule.
- 3.1.1.5.2. Answer:
- 3.1.1.5.2.1. The RF-3 product is "Marmoleum Ohmex - 73146 serene grey" by Forbo Flooring System or equivalent and reviewed by Consultant. A minimum of 1 grounding strap must be installed for every 46 m<sup>2</sup> (500 sq ft) and the grounding strap should be grounded to the building by a licensed electrician.
- 3.1.1.5.2.2. CT-2 is PCT-4 in the MATERIAL AND FINISH SCHEDULE. Drawing A013 Schedule - Room Finishes has been updated to include PCT-4 and PCT-5 which applies to kitchens/kitchenettes.
- 3.1.1.5.2.3. Finishes Schedule for the level 3 counselling rooms has been revised. Refer to Drawing A013.
- 3.1.1.6. Question No. 74:
- 3.1.1.6.1. Question: Please confirm that the guards at the windows as per note 44 on page A218 are the same details as the glass guards on 4/A705 with MT-5 bronze finish.
- 3.1.1.6.2. Answer: No. Refer to 4 & 5/A008 which applies to Lounge 307, Office 320, Office 322 and Office 324.
- 3.1.1.7. Question No. 75:
- 3.1.1.7.1. Question: Is there a Specification Section for the Fiberglass Reinforced Plastic (FRP) Wall Sheets to be installed in the Room 399A WC & SHOWER and as a backsplash for the exam room vanities?
- 3.1.1.7.2. Answer: Refer to Section 09 72 17.

#### **PART 4 - DRAWINGS**

##### **4.1. DRAWING NO: A008**

- 4.1.1. Drawing No. A008 attached is modified as follows:
- 4.1.2. Glass Screen 4/A008 description revised.

##### **4.2. DRAWING NO: A013**

- 4.2.1. Drawing No. A013 attached is modified as follows:
- 4.2.1.1. Wall Finish Schedule for the level 3 counselling rooms has been revised.
- 4.2.1.2. Finishes Schedule updated to include PCT-4 and PCT-5.

##### **4.3. DRAWING NO: A213**

- 4.3.1. Drawing No. A213 attached is modified as follows:
- 4.3.1.1. Note added which states that the F10A upturn is only 100 mm high. Reference Section added.

**4.4. DRAWING NO: A313**

4.4.1. Drawing No. A313 attached is modified as follows:

4.4.1.1. Note added which states that the F10A upturn is only 100 mm high.

4.4.1.2. Reference tags to C5 removed.

**4.5. DRAWING NO: A602**

4.5.1. Drawing No. A602 attached is modified as follows:

4.5.1.1. Reference tag to C5 removed from Elevation 16 and Section 8.

**4.6. DRAWING NO: A801**

4.6.1. Drawing No. A801 attached is modified as follows:

4.6.1.1. PCT-4 added to elevations 1 and 4.

**PART 5 - ELECTRICAL**

**5.1. ELECTRICAL REQUIREMENTS**

5.1.1. Electrical Consultant has issued "Bid Addendum No. #05" which is 2 pages and dated "March 28, 2025" and forms part of this Addendum.

**PART 6 - COMMUNICATIONS**

**6.1. COMMUNICATIONS REQUIREMENTS**

6.1.1. Communications Consultant has issued "Addendum No. ADD-D-05" which is 1 page and dated "March 28, 2025" and forms part of this Addendum.

**PART 7 - ELECTRONIC SAFETY AND SECURITY**

**7.1. ELECTRONIC SAFETY AND SECURITY REQUIREMENTS**

7.1.1. Electronic Safety and Security Consultant has issued "Addendum No. 05" which is 1 page and dated "March 28, 2025" and forms part of this Addendum.

**END OF SECTION**

<b>PROCUREMENT AND CONTRACTING REQUIREMENTS GROUP</b>					
<b>DIVISION 00 – PROCUREMENT AND CONTRACTING REQUIREMENTS</b>					
<b>INTRODUCTORY INFORMATION</b>					
<b>Section No.</b>	<b>Section Title</b>	<b>Rev. No.</b>	<b>Date</b>	<b>Consult.</b>	<b>Page No's</b>
00 00 01	PROJECT TITLE PAGE	--	2025-01-31	EAI	1 Only
00 01 05	LIST OF CONSULTANTS	00	2025-01-31	EAI	1 and 2
<b>00 01 10</b>	<b>TABLE OF CONTENTS</b>	<b>05</b>	<b>2025-03-28</b>	<b>EAI</b>	<b>1 thru 8</b>
00 01 15	LIST OF DRAWINGS	00	2025-01-31	EAI	1 and 2
00 01 20	LIST OF SCHEDULES	01	2025-03-21	EAI	1 Only
<b>PROCUREMENT REQUIREMENTS</b>					
00 30 00	AVAILABLE INFORMATION	00	2025-01-31	EAI	1 and 2
<b>CONTRACTING REQUIREMENTS</b>					
00 65 37	MAINTENANCE MATERIAL FORM (SPECIMEN)	00	2025-01-31	EAI	1 Only
*00 70 00	"AGREEMENT BETWEEN OWNER AND CONTRACTOR", "DEFINITIONS" AND "GENERAL CONDITIONS", STANDARD CONSTRUCTION DOCUMENT CCDC 2 - 2020				Not Enclosed
00 71 00	AMENDMENTS TO DEFINITIONS	00	2025-01-31	EAI	1 and 2
00 91 01	BID ADDENDUM NO. 1		2025-03-07	EAI	1 thru 3
00 91 02	ADDENDUM NO. 2		2025-07-14	EAI	1 thru 3
00 91 03	ADDENDUM NO. 3		2025-03-21	EAI	1 thru 11
00 91 04	ADDENDUM NO. 4		2025-03-25	EAI	1 thru 4
<b>00 91 05</b>	<b>ADDENDUM NO. 5</b>		<b>2025-03-28</b>	<b>EAI</b>	<b>1 thru 3</b>
<b>SPECIFICATIONS GROUP</b>					
<b>GENERAL REQUIREMENTS SUBGROUP</b>					
<b>DIVISION 01 – GENERAL REQUIREMENTS</b>					
01 33 23	INTERFERENCE DRAWINGS	00	2025-03-07	EAI	1 Only
*01 35 91	HERITAGE PROTECTIVE MEASURES	00	2025-01-31	EVOQ	1 thru 5
*01 42 16	HERITAGE DEFINITIONS	00	2025-01-31	EVOQ	1 and 2
<b>FACILITY CONSTRUCTION SUBGROUP</b>					
<b>DIVISION 02 – EXISTING CONDITIONS</b>					
02 41 00	DEMOLITION AND SALVAGE	00	2025-01-31	EAI	1 thru 6
*02 42 20	REMOVAL AND SALVAGE OF HERITAGE MATERIALS	01	2025-03-07	EVOQ	1 thru 5

<b><i>DIVISION 03 – CONCRETE</i></b>					
*03 01 37	CONCRETE RESTORATION	04	2025-01-31	EC	1 thru 14
*03 10 00	CONCRETE FORMING	04	2025-01-31	EC	1 thru 11
*03 20 00	CONCRETE REINFORCEMENT	04	2025-01-31	EC	1 thru 7
*03 30 00	CAST-IN-PLACE CONCRETE	04	2025-01-31	EC	1 thru 18
*03 30 53	MISCELLANEOUS CAST-IN-PLACE CONCRETE	00	2025-01-31	HKA	1 thru 4
03 35 13	CONCRETE FLOOR FINISHING	00	2025-01-31	EAI	1 thru 7
03 54 00	CAST CEMENT UNDERLAYMENT	00	2025-01-31	EAI	1 thru 5
<b><i>DIVISION 04 – MASONRY</i></b>					
*04 03 01	COMMON WORK RESULTS FOR HERITAGE MASONRY	00	2025-01-31	EVOQ	1 thru 7
*04 03 01.13	HERITAGE MASONRY CLEANING	00	2025-01-31	EVOQ	1 thru 9
*04 03 05.13	HERITAGE MORTARING	00	2025-01-31	EVOQ	1 thru 7
*04 03 05.21	HERITAGE REPOINTING	00	2025-01-31	EVOQ	1 thru 5
*04 03 42.13	HERITAGE STONE REPAIRING	00	2025-01-31	EVOQ	1 thru 7
*04 03 43.16	HERITAGE STONE REPLACING	00	2025-01-31	EVOQ	1 thru 3
*04 03 43.19	HERITAGE STONE DISMANTLING	00	2025-01-31	EVOQ	1 thru 5
*04 03 43.20	HERITAGE STONE REBUILDING	00	2025-01-31	EVOQ	1 thru 3
04 20 00	MASONRY UNITS	00	2025-01-31	EAI	1 thru 17
<b><i>DIVISION 05 – METALS</i></b>					
*05 12 00	STRUCTURAL STEEL	04	2025-01-31	EC	1 thru 22
*05 31 10	STEEL DECK	04	2025-01-31	EC	1 thru 8
05 41 00	STRUCTURAL METAL STUD FRAMING SYSTEM	00	2025-01-31	EAI	1 thru 11
05 50 00	METAL FABRICATIONS	00	2025-01-31	EAI	1 thru 8
05 51 00	METAL STAIRS AND BALUSTRADES	00	2025-01-31	EAI	1 thru 6
05 73 13	GLAZED DECORATIVE METAL RAILINGS	00	2025-01-31	EAI	1 thru 10
<b><i>DIVISION 06 – WOOD, PLASTICS AND COMPOSITES</i></b>					
06 10 00	ROUGH CARPENTRY	00	2025-01-31	EAI	1 thru 4
06 40 00	ARCHITECTURAL WOODWORK	00	2025-01-31	EAI	1 thru 7
06 61 16	SOLID SURFACING FABRICATIONS	00	2025-01-31	EAI	1 thru 7
06 90 00	GENERAL INSTALLATIONS	00	2025-01-31	EAI	1 thru 4
<b><i>DIVISION 07 – THERMAL AND MOISTURE PROTECTION</i></b>					
07 11 13	BITUMINOUS DAMPPROOFING	00	2025-03-21	EAI	1 thru 3
07 16 16	CRYSTALLINE WATERPROOFING	00	2025-01-31	EAI	1 thru 5
07 18 13	MECHANICAL ROOM WATERPROOFING	00	2025-01-31	EAI	1 thru 5
07 21 00	BUILDING INSULATION	00	2025-01-31	EAI	1 thru 6
07 21 19	FOAMED-IN-PLACE INSULATION	00	2025-01-31	EAI	1 thru 3
07 21 29	SPRAYED INSULATION	00	2025-01-31	EAI	1 thru 4
07 25 00	MISCELLANEOUS AIR/VAPOUR BARRIERS	00	2025-01-31	EAI	1 thru 7
07 42 44	ALUMINUM MODULAR PLATE SYSTEM	00	2025-01-31	EAI	1 thru 10

07 52 16	MODIFIED BITUMINOUS MEMBRANE ROOFING	00	2025-01-31	EAI	1 thru 16
07 62 00	SHEET METAL FLASHING AND TRIM	00	2025-01-31	EAI	1 thru 4
07 81 00	SPRAYED FIRE-RESISTIVE MATERIALS	00	2025-01-31	EAI	1 thru 6
07 81 23	INTUMESCENT FIRE RESISTIVE COATINGS	00	2025-01-31	EAI	1 thru 9
07 84 00	FIRESTOPPING AND SMOKE SEALS	00	2025-01-31	EAI	1 thru 13
07 92 00	JOINT SEALANTS	00	2025-01-31	EAI	1 thru 10
07 95 13	EXPANSION JOINT ASSEMBLIES	00	2025-01-31	EAI	1 thru 6
<b>DIVISION 08 – OPENINGS</b>					
*08 03 52.71	HERITAGE WOOD WINDOW AND DOOR REHABILITATION	00	2025-01-31	EVOQ	1 thru 6
08 06 80	GLAZING SCHEDULE	00	2025-01-31	EAI	1 thru 4
08 11 13	HOLLOW METAL DOORS AND FRAMES	00	2025-01-31	EAI	1 thru 9
08 11 16	ALUMINUM DOORS AND FRAMES	00	2025-01-31	EAI	1 thru 7
08 15 00	PLASTIC LAMINATE WOOD DOORS	00	2025-01-31	EAI	1 thru 6
08 31 13	ACCESS DOORS AND FRAMES	00	2025-01-31	EAI	1 thru 4
08 33 25	FIRE-RATED OVERHEAD COILING DOORS	00	2025-01-31	EAI	1 thru 5
08 43 14	ALUMINUM FRAMED FIRE-RATED STOREFRONTS	00	2025-01-31	EAI	1 thru 10
08 44 13	GLAZED ALUMINUM CURTAIN WALL	00	2025-01-31	EAI	1 thru 30
08 51 13	ALUMINUM WINDOWS	00	2025-01-31	EAI	1 thru 16
*08 71 00	FINISH HARDWARE	00	2025-01-31	UCSH	1 thru 9
08 71 13	AUTOMATIC DOOR OPERATORS	00	2025-01-31	EAI	1 thru 6
08 80 00	GLASS AND GLAZING	00	2025-01-31	EAI	1 thru 9
08 91 00	<del>DELETED LOUVRES</del>	<del>00</del>	<del>2025-01-31</del>	<del>EAI</del>	<del>1 thru 7</del>
<b>DIVISION 09 – FINISHES</b>					
*09 03 91	HERITAGE PAINTING	00	2025-01-31	EVOQ	1 thru 6
09 21 16	GYPSUM BOARD ASSEMBLIES	00	2025-01-31	EAI	1 thru 16
09 27 13	GLASS-FIBRE-REINFORCED GYPSUM FABRICATIONS	00	2025-01-31	EAI	1 thru 4
09 30 00	TILING	00	2025-01-31	EAI	1 thru 11
09 51 13	ACOUSTICAL PANEL CEILINGS	00	2025-01-31	EAI	1 thru 8
09 60 13	TACTILE WARNING SURFACING	02	2025-03-25	EAI	1 thru 5
09 62 19	LAMINATE FLOORING	00	2025-01-31	EAI	1 thru 6
09 65 13	RESILIENT BASE AND ACCESSORIES	00	2025-01-31	EAI	1 thru 3
09 65 43	LINOLEUM	00	2025-01-31	EAI	1 thru 6
<b>09 72 17</b>	<b>HYGIENIC VINYL WALL AND CEILING PANELS</b>	<b>00</b>	<b>2025-03-28</b>	<b>EAI</b>	<b>1 thru 6</b>
09 84 13	FIXED SOUND-ABSORPTIVE PANELS	00	2025-01-31	EAI	1 thru 4
09 91 00	PAINTING	00	2025-01-31	EAI	1 thru 16
09 96 03	HIGH-PERFORMANCE INTERIOR COATINGS	00	2025-01-31	EAI	1 thru 4
<b>DIVISION 10 – SPECIALTIES</b>					
10 22 26	FOLDING PANEL OPERABLE PARTITIONS	00	2025-01-31	EAI	1 thru 4
10 28 00	WASHROOM ACCESSORIES	01	2025-03-21	EAI	1 thru 5
10 51 13	METAL LOCKERS	01	2025-03-21	EAI	1 thru 4

<b><i>DIVISION 12 – FURNISHINGS</i></b>					
12 24 13	MANUAL ROLLER WINDOW SHADES	00	2025-01-31	EAI	1 thru 6
12 24 14	MOTORIZED ROLLER WINDOW SHADES	00	2025-01-31	EAI	1 thru 7
12 48 16	ENTRANCE FLOOR GRILLES	00	2025-01-31	EAI	1 thru 3
*12 93 00	SITE FURNISHINGS	00	2025-01-31	HKA	1 Only
<b><i>DIVISION 14 – CONVEYING EQUIPMENT</i></b>					
*14 20 00	ELEVATORS: GENERAL		2025-01-31	KJA	1 thru 19
*14 21 23	MRL PASSENGER ELEVATOR		2025-01-31	KJA	1 thru 35
*14 41 00	PLATFORM LIFT		2025-01-31	KJA	1 thru 9
*14900	ELEVATORS: MAINTENANCE		2025-01-31	KJA	1 thru 21
<b><i>FACILITY SERVICES SUBGROUP</i></b>					
<b><i>DIVISION 20 – MECHANICAL GENERAL REQUIRMENTS</i></b>					
*20 05 00	GENERAL INSTRUCTIONS FOR MECHANICAL SECTIONS	00	2025-01-31	S+A	1 thru 20
*20 05 01	ABBREVIATIONS	00	2025-01-31	S+A	1 thru 6
*20 05 02	AS-BUILT DRAWINGS	00	2025-01-31	S+A	1 and 2
*20 05 03	SHOP DRAWINGS	00	2025-01-31	S+A	1 and 2
*20 05 05	SELECTIVE DEMOLITION FOR MECHANICAL SERVICES	00	2025-01-31	S+A	1 thru 4
*20 05 29	HANGERS AND SUPPORTS	00	2025-01-31	S+A	1 thru 5
*20 05 48	VIBRATION AND NOISE CONTROL	00	2025-01-31	S+A	1 thru 6
*20 05 53	PIPE AND DUCTWORK IDENTIFICATION	00	2025-01-31	S+A	1 and 2
*20 05 54	NAMEPLATES	00	2025-01-31	S+A	1 Only
*20 05 55	VALVE TAGS AND CHARTS	00	2025-01-31	S+A	1 Only
*20 05 63	ACCESS DOORS AND ACCESSIBILITY	00	2025-01-31	S+A	1 and 2
*20 05 73	EXCAVATION AND BACKFILL FOR MECHANICAL WORK	00	2025-01-31	S+A	1 and 2
*20 05 83	SLEEVES AND ESCUTCHEONS	00	2025-01-31	S+A	1 thru 3
*20 05 88	CUTTING AND PATCHING	00	2025-01-31	S+A	1 and 2
*20 07 00	INSULATION	00	2025-01-31	S+A	1 thru 15
*20 08 02	CLEANING AND PROTECTION	00	2025-01-31	S+A	1 Only
*20 08 03	OPERATING AND MAINTENANCE INSTRUCTIONS	00	2025-01-31	S+A	1 thru 3
<b><i>DIVISION 21 – FIRE SUPPRESSION</i></b>					
*21 12 00	STANDPIPE AND FIRE HOSE SYSTEM	00	2025-01-31	S+A	1 and 2
*21 12 26	FIRE HOSE CABINETS	00	2025-01-31	S+A	1 and 2
*21 13 00	SPRINKLER SYSTEMS	00	2025-01-31	S+A	1 thru 7
*21 25 00	PORTABLE FIRE EXTINGUISHERS	00	2025-01-31	S+A	1 Only
<b><i>DIVISION 22 – PLUMBING</i></b>					
*22 05 76	CLEANOUTS	00	2025-01-31	S+A	1 Only
*22 11 13	PIPES, VALVES AND FITTINGS (PLUMBING SYSTEM)	00	2025-01-31	S+A	1 thru 9

*22 11 23.29	CIRCULATORS	00	2025-01-31	S+A	1 Only
*22 13 19.13	FLOOR DRAINS	00	2025-01-31	S+A	1 and 2
*22 13 19.26	INTERCEPTORS	00	2025-01-31	S+A	1 Only
*22 42 00	FIXTURES AND TRIM	00	2025-01-31	S+A	1 thru 4
*22 42 46	FIXTURE CARRIERS	00	2025-01-31	S+A	1 and 2
*22 47 13	REFRIGERATED DRINKING FOUNTAINS AND BOTTLE FILLERS	00	2025-01-31	S+A	1 Only
<b><i>DIVISION 23 – HEATING, VENTILATING AND AIR CONDITIONING</i></b>					
*23 05 93.16	TESTING AND BALANCING PIPING SYSTEMS	00	2025-01-31	S+A	1 Only
*23 05 93.26	TESTING AND BALANCING AIR SYSTEMS	00	2025-01-31	S+A	1 and 2
*23 09 00	BUILDING AUTOMATION SYSTEM (BAS)	00	2025-01-31	S+A	1 thru 28
*23 09 23	SEQUENCE OF OPERATION FOR BAS	00	2025-01-31	S+A	1 thru 5
*23 21 13.23	PIPING, VALVES & FITTINGS (EXCEPT PLUMBING)	00	2025-01-31	S+A	1 thru 10
*23 23 01	REFRIGERANT PIPING	00	2025-01-31	S+A	1 thru 5
*23 25 26	CLEANING AND FILLING	00	2025-01-31	S+A	1 thru 3
*23 31 13	DUCTWORK AND SPECIALTIES	00	2025-01-31	S+A	1 thru 12
*23 34 53	ROOM VENTILATORS	00	2025-01-31	S+A	1 and 2
*23 36 16	VARIABLE VOLUME BOXES	00	2025-01-31	S+A	1 thru 3
*23 37 13	DIFFUSERS, GRILLES AND REGISTERS	00	2025-01-31	S+A	1 thru 3
*23 81 26	UNITARY AIR CONDITIONING UNITS	00	2025-01-31	S+A	1 and 2
*23 82 16	COILS	00	2025-01-31	S+A	1 and 2
*23 82 33	CONVECTOR RADIATORS	00	2025-01-31	S+A	1 and 2
	*HEATING COIL SCHEDULE		2025-01-31	S+A	1 Only
	*VAV SCHEDULE		2025-01-31	S+A	1 Only
	*AC UNIT SCHEDULE		2025-03-20	S+A	1 Only
	*KITCHEN ECOLOGY UNIT SCHEDULE		2025-01-31	S+A	1 Only
	*FAN SCHEDULE		2025-03-20	S+A	1 Only
<b><i>DIVISION 26 – ELECTRICAL</i></b>					
*26 01 00	OPERATING AND MAINTENANCE INSTRUCTIONS	00	2025-01-31	S+A	1 thru 3
*26 05 01	GENERAL INSTRUCTIONS FOR ELECTRICAL SECTIONS	00	2025-01-31	S+A	1 thru 25
*26 05 03	AS-BUILT DRAWINGS	00	2025-01-31	S+A	1 and 2
*26 05 04	SUBMITTALS/SHOP DRAWINGS	00	2025-01-31	S+A	1 and 2
*26 05 05	MOUNTING HEIGHTS	00	2025-01-31	S+A	1 and 2
*26 05 21	WIRES AND CABLES UNDER 2000 V	00	2025-01-31	S+A	1 thru 7
*26 05 21.01	PATIENT CARE WIRING	00	2025-01-31	S+A	1 thru 4
*26 05 26	GROUNDING + BONDING	00	2025-01-31	S+A	1 thru 4
*26 05 29	HANGERS AND SUPPORTS	00	2025-01-31	S+A	1 Only
*26 05 31	SPLITTERS, JUNCTION, PULL BOXES AND CABINETS	00	2025-01-31	S+A	1 and 2
*26 05 32	OUTLET BOXES, CONDUIT BOXES AND FITTINGS	00	2025-01-31	S+A	1 and 2
*26 05 34	CONDUITS, CONDUIT FASTENERS AND FITTINGS	00	2025-01-31	S+A	1 thru 4
*26 05 36	CABLE TRAYS	00	2025-01-31	S+A	1 thru 4
*26 05 40	POKE-THRU DEVICES	00	2025-01-31	S+A	1 and 2

*26 05 53	IDENTIFICATION	00	2025-01-31	S+A	1 thru 5
*26 05 63	ACCESS DOORS AND ACCESSIBILITY	00	2025-01-31	S+A	1 and 2
*26 05 73	ELECTRICAL POWER SYSTEM STUDIES	00	2025-01-31	S+A	1 thru 4
*26 05 83	SLEEVES	00	2025-01-31	S+A	1 and 2
*26 05 88	CUTTING AND PATCHING	00	2025-01-31	S+A	1 and 2
*26 08 01	TECHNICAL SERVICES DIVISION STARTUP SERVICE	00	2025-01-31	S+A	1 thru 12
*26 09 24	LIGHTING CONTROL EQUIPMENT - ADDRESSABLE LOW VOLTAGE	00	2025-01-31	S+A	1 thru 13
*26 12 17	DRY TYPE TRANSFORMERS - 600V PRIMARY	00	2025-01-31	S+A	1 thru 3
*26 24 13	SWITCHBOARDS	00	2025-01-31	S+A	1 thru 4
*26 24 17	PANELBOARDS - BREAKER TYPE	00	2025-01-31	S+A	1 thru 3
*26 27 02	SURGE PROTECTIVE DEVICE	00	2025-01-31	S+A	1 thru 5
*26 27 13	ELECTRONIC METERING	00	2025-01-31	S+A	1 thru 10
*26 27 19	MULTI-OUTLET ASSEMBLIES	00	2025-01-31	S+A	1 and 2
*26 27 26	WIRING DEVICES	00	2025-01-31	S+A	1 thru 4
*26 28 14	FUSES LOW VOLTAGE	00	2025-01-31	S+A	1 and 2
*26 28 21	MOULDED CASE AND INSULATED CASE CIRCUIT BREAKERS	00	2025-01-31	S+A	1 thru 4
*26 28 23	DISCONNECT SWITCHES - FUSED AND NON-FUSED	00	2025-01-31	S+A	1 and 2
*26 29 00	MOTOR STARTERS TO 600 V	00	2025-01-31	S+A	1 thru 6
*26 51 13	LIGHTING EQUIPMENT	00	2025-01-31	S+A	1 thru 8
*26 60 10	SNOW MELTING SYSTEM	00	2025-01-31	S+A	1 thru 4
*26 60 30	ROOF AND GUTTER DE-ICING SYSTEMS	00	2025-01-31	S+A	1 thru 3
<b>DIVISION 27 – COMMUNICATIONS</b>					
*27 00 05.10	GENERAL INSTRUCTIONS FOR TELECOMMUNICATIONS SECTIONS	00	2025-01-31	S+A	1 thru 8
*27 00 05.20	DEFINITIONS AND ABBREVIATIONS	00	2025-01-31	S+A	1 thru 9
*27 00 05.30	CODES, STANDARDS AND REGULATIONS	00	2025-01-31	S+A	1 thru 3
*27 00 05.50	CONTRACT DOCUMENTS	00	2025-01-31	S+A	1 Only
*27 00 05.60	ADMINSTRATIVE REQUIREMENTS	00	2025-01-31	S+A	1 thru 4
*27 00 05.70	PROJECT SPECIFIC REQUIREMENTS	00	2025-01-31	S+A	1 thru 3
*27 00 06	FIRE STOPPING AND WATER PROOFING	00	2025-01-31	S+A	1 thru 4
*27 05 28	PATHWAYS FOR TELECOMMUNICATIONS SYSTEMS	00	2025-01-31	S+A	1 thru 5
*27 05 53	IDENTIFICATION FOR TELECOMMUNICATIONS SYSTEMS	00	2025-01-31	S+A	1 and 2
*27 08 00	COMMISSIONING FOR TELECOMMUNICATIONS SECTIONS	00	2025-01-31	S+A	1 thru 6
*27 11 16	TELECOMMUNICATIONS CABINETS, RACKS, FRAMES AND ENCLOSURES	00	2025-01-31	S+A	1 thru 3
*27 11 19	TELECOMMUNICATIONS TERMINATION BLOCKS AND PATCH PANELS	00	2025-01-31	S+A	1 Only
*27 13 23	TELECOMMUNICATIONS OPTICAL FIBRE BACKBONE CABLING	00	2025-01-31	S+A	1 thru 4
*27 15 00.19	DATA TELECOMMUNICATIONS HORIZONTAL CABLING	00	2025-01-31	S+A	1 thru 3
*27 15 33.00	TELECOMMUNICATIONS COAXIAL HORIZONTAL CABLING	00	2025-01-31	S+A	1 and 2

*27 15 43	TELECOMMUNICATIONS FACEPLATES AND CONNECTORS	00	2025-01-31	S+A	1 thru 4
*27 16 19	TELECOMMUNICATIONS PATCH CORDS AND CROSS CONNECT WIRE	00	2025-01-31	S+A	1 and 2
	*COMMUNICATIONS INFRASTRUCTURE SPECIFICATIONS, STANDARDS AND PRACTICES		2025-01	UofT	38 pages
<b>DIVISION 28 – ELECTRONIC SAFETY AND SECURITY</b>					
*28 00 03	ADMINISTRATIVE REQUIREMENTS		2025-01-31	S+A	1 thru 3
*28 00 05.30	CODES, STANDARDS, AND REGULATIONS		2025-01-31	S+A	1 thru 3
*28 00 06	FIRE STOPPING AND WATER PROOFING		2025-01-31	S+A	1 thru 4
*28 01 00	GENERAL INSTRUCTIONS FOR ESS SECTIONS		2025-01-31	S+A	1 thru 6
*28 01 01	OPERATION AND MAINTENANCE OF ELECTRONIC SAFETY AND SECURITY		2025-01-31	S+A	1 Only
*28 05 00	RACEWAYS FOR SECURITY SYSTEM	00	2025-01-31	S+A	1 Only
*28 05 00	COMMON WORK RESULTS FOR ELECTRONIC SAFETY AND SECURITY		2025-01-31	S+A	1 and 2
*28 05 03	RECORD DRAWINGS		2025-01-31	S+A	1 thru 3
*28 05 04	SUBMITTALS - SHOP DRAWINGS		2025-01-31	S+A	1 and 2
*28 05 05.20	DEFINITIONS AND ABBREVIATIONS		2025-01-31	S+A	1 thru 6
*28 05 13	CONDUCTORS AND CABLES FOR ELECTRONIC SAFETY AND SECURITY		2025-01-31	S+A	1 thru 4
*28 05 26	GROUNDING AND BONDING FOR ELECTRONIC SAFETY AND SECURITY		2025-01-31	S+A	1 and 2
*28 05 28	PATHWAYS FOR ELECTRONIC SAFETY AND SECURITY		2025-01-31	S+A	1 thru 3
*28 05 53	IDNETIFICATION FOR ELECTRONIC SAFETY AND SECURITY		2025-01-31	S+A	1 and 2
*28 08 00	COMMISSIONING OF ELECTRONIC SAFETY AND SECURITY		2025-01-31	S+A	1 thru 3
*28 31 02	MULTIPLEX FIRE ALARM SYSTEM	00	2025-01-31	S+A	1 thru 18
<b>SITE AND INFRASTRUCTURE SUBGROUP</b>					
<b>DIVISION 32 – EXTERIOR IMPROVEMENTS</b>					
*32 13 13	CONCRETE PAVING	00	2025-01-31	HKA	1 thru 5
*32 14 13	UNIT PAVING	00	2025-01-31	HKA	1 and 2
*32 93 00	PLANTING	00	2025-01-31	HKA	1 thru 6

**LEGEND**

\* - Specifications prepared by Consultants other than ENFORM Architects Inc. have been prefixed with an asterisk. These Specifications are not included under, nor governed by ENFORM Architects Inc.'s seal.

**Consultant's Abbreviations:**

UofT	University of Toronto	Owner
EAI	ENFORM Architects Inc.	Architectural (A)
EC	Entuitive Corporation	Structural Consultant (S)
EVOQ	EVOQ Architecture	Heritage Consultant
UCSH	Upper Canada Specialty Hardware Limited	Hardware Consultant

S+A     *Smith + Andersen*  
S+A     *Smith + Andersen*  
KJA     *KJA Consultants Inc.*  
MBII    *Mulvey & Banani International Inc.*  
HKA     *Henry Kortekaas and Associates Inc.*

*Mechanical Consultant (M)*  
*Electrical Consultant (E)*  
*Vertical Transportation Consultant*  
*Security Consultant*  
*Landscape Consultant (L)*

***END OF SECTION***

**PART 1 - GENERAL**

**1.1. GENERAL INSTRUCTIONS**

- 1.1.1. Read and conform to:
  - 1.1.1.1. CCDC 2 - 2020, Stipulated Price Contract as amended in the Contract Documents.
  - 1.1.1.2. Division 1 requirements and documents referred to therein.

**1.2. SUMMARY**

- 1.2.1. Section Includes: Provide hygienic vinyl wall and ceiling panels including but not limited to following:
  - 1.2.1.1. hygienic vinyl wall panels for showers and backsplashes.
- 1.2.2. Related Sections: Following description of work is included for reference only and shall not be presumed complete:
  - 1.2.2.1. Provision of "Maintenance Material Form" for receiving extra/spare material for Owner's future use: Section 00 65 37, Maintenance Material Form (Specimen).
  - 1.2.2.2. Provision of carbon impact design requirements: Section 01 33 30, Carbon Impact Design Requirements.
  - 1.2.2.3. Provision of concrete block walls: Section 04 20 00, Masonry Units.
  - 1.2.2.4. Provision of gypsum board partitions: Section 09 21 16, Gypsum Board Assemblies.

**1.3. REFERENCES**

- 1.3.1. Abbreviations and Acronyms:
  - 1.3.1.1. EPD: Environmental Product Declaration.
  - 1.3.1.2. HPD: Health Product Declaration.
- 1.3.2. Reference Standards:
  - 1.3.2.1. ISO 14025:2016 - Environmental labels and declarations - Type III environmental declarations - Principles and procedures
  - 1.3.2.2. ISO 21930:2017 - Sustainable in buildings and civil engineering works - Core rules for environmental product declarations of construction products and services

**1.4. SUBMITTALS**

- 1.4.1. Product Data:
  - 1.4.1.1. Submit manufacturer's literature, data sheets for each type of material provided under this Section. Ensure data sheets provide required information. Submit 3 copies of detailed instructions for maintaining, preserving and keeping materials in clean and safe conditions and give adequate warning of maintenance practices or materials detrimental to specified materials. Submit manufacturer's installation instructions.
  - 1.4.1.2. EPDs: When available, submit Product-specific Type III EPD or industry-wide (generic) EPD conforming to ISO 14025, ISO 21930 or other recognized environmental Product declaration framework demonstrating carbon impact of materials using life cycle analysis methods.
  - 1.4.1.3. HPDs: When available, submit documentation demonstrating chemical inventory of materials to at least 0.1% (1000 ppm) and conforming to 1 of following standards:
    - 1.4.1.3.1. Health Product Declaration open Standard.
    - 1.4.1.3.2. Cradle to Cradle v2 Basic level.

- 1.4.1.3.3. Cradle to Cradle v3 Bronze level.
- 1.4.1.3.4. Or other recognized material ingredient framework.
- 1.4.2. Shop Drawings: Submit Shop Drawings indicating materials, details and accessories in accordance with Section 01 30 00 including a layout diagram indicating location of each panel and joining method.
- 1.4.3. Samples: Submit samples in accordance with Section 01 30 00. Submit following samples in sizes indicated:
  - 1.4.3.1. hygienic vinyl wall panel material 300 mm (12") square.

**1.5. CLOSEOUT SUBMITTALS**

- 1.5.1. Operation and Maintenance Data: Submit maintenance instructions in accordance with Section 01 70 00.

**1.6. MAINTENANCE MATERIAL SUBMITTALS**

- 1.6.1. Extra Stock Materials: Supply 5% from same production run as installed. Execute Section 00 65 37.

**1.7. QUALITY ASSURANCE**

- 1.7.1. Qualifications:
  - 1.7.1.1. Installers: Provide work of this Section executed by competent installers with minimum 5 years' experience in the application of Products, systems and assemblies specified and with approval and training of the Product manufacturers.
- 1.7.2. Mock-Ups: Construct minimum 10 m<sup>2</sup> (100 sq ft) mock-up sample at Project location designated by Consultant for review. Once reviewed with no objections recorded, sample remains part of finished work and used as a quality reference standard for balance of Project.

**1.8. DELIVERY, STORAGE AND HANDLING**

- 1.8.1. Storage and Handling Requirements:
  - 1.8.1.1. Stack panels on a solid flat surface and precondition for 8 hours in temperatures and humidity conditions approximating operating environment of finished room.
  - 1.8.1.2. Store adhesives, sealants and accessories in an area with minimum temperatures of 18 deg C (60 deg F) and maximum 26 deg C (80 deg F) for a minimum 48 hours prior to installation.

**1.9. SITE CONDITIONS**

- 1.9.1. Ambient Conditions:
  - 1.9.1.1. Maintain temperature between 18 deg C to 26 deg C (65 deg F to 80 deg F) and humidity below 80% 24 hours before, during and 48 hours after installation.
  - 1.9.1.2. Ensure electrical items (power outlets, etc.) are roughed-in where possible.
  - 1.9.1.3. Remove any existing electrical equipment fixed to or in close proximity to walls and replace upon completion of installation.

**1.10. WARRANTY**

- 1.10.1. Manufacturer Warranty: Warrant work of this Section for period of 10 years against defects and/or deficiencies in accordance with General Conditions of the Contract. Promptly correct any defects or deficiencies which become apparent within warranty period, to satisfaction of Consultant and at no expense to Owner. Defects include but are not limited to; buckling, opening of seams and bond failure.

## **PART 2 - PRODUCTS**

### **2.1. MANUFACTURERS**

- 2.1.1. Manufacturer List: Products of following manufacturers are permitted subject to conformance to requirements of Drawings, Schedules and Specifications:
- 2.1.1.1. Altro Canada Inc.; [www.altrofloors.com](http://www.altrofloors.com)
- 2.1.1.2. Bioclad Ltd.; [www.bioclad.com](http://www.bioclad.com)
- 2.1.2. Substitution Limitations: Comparable Products from other manufacturers not listed herein may be reviewed provided they meet requirements of this Specification.

### **2.2. MATERIALS**

- 2.2.1. Performance/Design Criteria:
- 2.2.1.1. Carbon Impact Design: Preference will be given to those manufacturers who have provided EPDs outlining their programs for reducing their Operational and Embodied Carbon footprints as specified herein.
- 2.2.1.2. Material Ingredient Disclosure: Preference will be given to those manufacturers who have provided HPDs or similar documentation identifying their Product chemical content as specified herein.
- 2.2.2. Hygienic Vinyl Wall Panels: Supply 2.5 mm (0.10") thick x 1220 mm (48") extruded vinyl sheet having a maximum working temperature of 60 deg C (140 deg F), "Whiterock Satins" by Altro Canada Inc. or "BioClad® Antimicrobial PVC Wall Cladding" by Bioclad Ltd. in colour selected by Consultant from manufacturer's full colour range.
- 2.2.3. Vinyl Welding Rod: "Altro Weldrod" by Altro Canada Inc. or "PVC 'H' Trim Welded" by Bioclad Ltd.
- 2.2.4. Joint Strips:
- 2.2.4.1. 2-Part Joint Strip: "A831/25/\* Colours" by Altro Canada Inc. 2500 mm (98-1/2") long.
- 2.2.4.2. 2-Part Joint Strip: "A831/30/\* Colours" by Altro Canada Inc. 2972 mm (118") long.
- 2.2.5. Cut-Tile Transition Strips:
- 2.2.5.1. 2-Part Joint Strip: "G831/30/\* Colours" by Altro Canada Inc. 2500 mm (98-1/2") long.
- 2.2.6. Start and Edge Trim:
- 2.2.6.1. 2-Part Start and Edge Trim: "A833/25/\* Colours" by Altro Canada Inc. 2500 mm (98-1/2") long.
- 2.2.6.2. 2-Part Start and Edge Trim: "A833/30/\* Colours" by Altro Canada Inc. 2972 mm (118") long.
- 2.2.7. Acrylic Adhesive: For dry, climate controlled areas, use "AltroFix W49" by Altro Canada Inc., a 1-part, water-based, acrylic adhesive as recommended by manufacturer.
- 2.2.8. Polyurethane Adhesive: Default adhesive for most installations, suitable for wet areas, non-climate controlled areas and non-absorbent surfaces, use "AltroFix W39" by Altro Canada Inc., a 2-part resin-based polyurethane adhesive as recommended by manufacturer.

## **PART 3 - EXECUTION**

### **3.1. EXAMINATION**

- 3.1.1. Verification of Conditions: Verify actual site dimensions and location of adjacent materials prior to commencing work. Notify Consultant in writing of any conditions which would be detrimental to the installation.

3.1.2. Evaluation and Assessment: Commencement of work implies acceptance of previously completed work.

**3.2. PREPARATION**

3.2.1. Surface Preparation: Ensure substrate is dry, well sealed and free of dirt, loose paint, wax and grease. Glossy surfaces may require sanding or priming before installation to help promote adhesion.

**3.3. INSTALLATION**

3.3.1. Panel Fitting:

3.3.1.1. Mark a datum line around wall perimeters using a water level, laser or other suitable leveling device. Take measurements from this line to determine top and bottom lines for cutting purposes.

3.3.1.2. When measuring, allow for minimum 3 mm (1/8") gap at ceiling, door and window frames, pipes and any projections to accommodate for possible panel expansion. After fixing panel, seal gaps using specified sealant.

3.3.1.3. When fitting to the top of flash-covered sheet vinyl, allow for a 19 mm (3/4") gap to accommodate transition strip.

3.3.1.4. Thermoform inside corners, outside corners and specific shapes to suit contours of building.

3.3.1.5. Cut panels using power saws equipped with laminate cutting blades or by scoring with a laminate scoring knife, folding then breaking.

3.3.1.6. Bevel leading edges to receive following:

3.3.1.6.1. joint strip.

3.3.1.6.2. transition strip.

3.3.1.6.3. start and edge strip.

3.3.1.7. Strip burrs from panel edges in preparation for heat welding joints.

3.3.1.8. When fitting for heat welded joints, ensure a 1.6 mm (1/16") gap is maintained sheet to sheet.

3.3.2. Panel Fixing: Fix panels using 1 of following methods:

3.3.2.1. Adhesive Method:

3.3.2.1.1. Cut and fit sheet as required.

3.3.2.1.2. Clean back of panel using safe solvent cleaner. Avoid use of ketones, acetones or any solvents that may cause damage to panel.

3.3.2.1.3. Apply double-sided adhesive tape to top and bottom of sheet.

3.3.2.1.4. Apply adhesive tape to window and door openings where sheet has a tendency to pull away from substrate prior to adhesive cure.

3.3.2.1.5. It may be necessary to prime wall on area directly corresponding to tape position using a non-flammable contact adhesive.

3.3.2.1.6. Apply adhesive to back of sheet using recommended trowel, as indicated herein. In some cases it may be more convenient to apply adhesive to substrate.

3.3.2.1.7. Apply sheet to wall and line up any reference marks before pressing into place. Use a white rubber mallet for initial contact with adhesive tape.

3.3.2.1.8. Ensure adequate adhesive transfer by thoroughly rolling entire panel surface using a wall roller.

3.3.2.1.9. Following are recommended trowel sizes for wall surfaces:

	<b>Surface</b>	<b>Example</b>	<b>Recommended Trowel</b>
3.3.2.1.9.1.	Rough	Concrete Block or Brick	1/4" x 1/4" x 1/4" Square Notch
3.3.2.1.9.2.	Semi-Smooth	Painted Block	5/16" x 1/8" Square Notch
3.3.2.1.9.3.	Smooth	Gypsum Board, Plywood, Glazed Wall Tile	1/8" x 1/8" x 1/8" U Notch

3.3.2.1.10. Note: Above is only a guideline. It is responsibility of installer to ensure adequate transfer of adhesive takes place. Coverage must be minimum 80%. Consult adhesive label.

3.3.2.1.11. Surfaces must be reasonable in plane, structurally sound and tested to standard moisture requirements.

3.3.2.2. Pin Fix Method:

3.3.2.2.1. Cut and fit sheet as required.

3.3.2.2.2. Bevel all edges to receive jointing or edge strips.

3.3.2.2.3. Mark out for rivets in accordance with manufacturer's recommended layout pattern and pre-drill using a 9 mm (3/8") drill bit.

3.3.2.2.4. Clean back of sheet with safe solvent cleaner and remove protective film from sheet face for inserting of pins.

3.3.2.2.5. Apply anti-static agent to front of sheet to prevent dust/static build-up.

3.3.2.2.6. Apply recommended adhesive to back of sheet.

3.3.2.2.7. Position sheet on wall, drill through 1 of the center holes using a 6.5 mm (5/16") masonry bit.

3.3.2.2.8. Place rivet in hole and drive home the center pin with a hammer. If the pin is hammered farther than necessary, the backup adhesive may be displaced causing a permanent depression in panel at pin area.

3.3.2.2.9. Continue in this manner, always working from center outwards.

3.3.2.3. System 2001: Contact manufacturer for information about installing System 2001.

3.3.3. Panel Jointing: There are 3 methods used for joining sheet to sheet, as follows:

3.3.3.1. Joint Strip:

3.3.3.1.1. Fit joint strip to panel edge and knock fully over until division bar rests against panel edge.

3.3.3.1.2. Place edge of next sheet snugly against front edge of the "H" section and roll sheet into adhesive.

3.3.3.1.3. Knock the "H" section back towards the second sheet leaving a 3 mm (1/8") gap on both sides of the division bar.

3.3.3.2. Silicone Sealant:

3.3.3.2.1. Use a manufacturer recommended scraper or similar tool to remove burrs from panel edge.

3.3.3.2.2. Leave a 3 mm (1/8") gap between sheets.

3.3.3.2.3. Mask both panel edges leaving gap exposed.

3.3.3.2.4. Fill gap fully with silicone sealant.

3.3.3.2.5. Smooth sealant flush to panel surface and remove tape before sealant skins over.

3.3.3.3. Heat Welding:

3.3.3.3.1. Apply double-sided adhesive tape flush to panel edges.

3.3.3.3.2. Remove burrs from panel edges.

- 3.3.3.3.3. Place each successive panel allowing for a 1.6 mm (1/16") gap between each panel.
- 3.3.3.3.4. Clean both seam area and weld rod with safe solvent cleaner; 1 that will not attack the vinyl or leave a film. For example, isopropyl alcohol.
- 3.3.3.3.5. Test weld on a scrap piece of material before proceeding. Proceed only when temperature and speed have been satisfied.
- 3.3.3.3.6. Weld may be trimmed flush when semi-cooled using the round part of the trimming spatula.
- 3.3.4. Jointing Sheet to Coved Vinyl Flooring: Panels can be joined to coved sheet vinyl flooring using 1 of following 2 methods:
  - 3.3.4.1. High Impact Transition Strip:
    - 3.3.4.1.1. When using transition strip, vertical joint strip should stop 9 mm (3/8") short of the bottom of the sheet.
    - 3.3.4.1.2. Cut away back of joint strip.
    - 3.3.4.1.3. Install transition strip when panels have been installed.
    - 3.3.4.1.4. Apply a bead of clear silicone sealant between flooring material and bottom edge of transition strip.
    - 3.3.4.1.5. In order to follow the thermoformed internal and external corners notch the transition strip. Remove 19 mm (3/4") from each side of the corner.
  - 3.3.4.2. Overlapping:
    - 3.3.4.2.1. Extend panel down a minimum of 25 mm (1") past top of flooring material.
    - 3.3.4.2.2. Use extra adhesive to fill gap.
    - 3.3.4.2.3. Apply a bead of recommended sealant along bottom edge of panel.
- 3.3.5. Finishing Edges: Panel edges may be finished using 1 of following methods:
  - 3.3.5.1. Start and Edge Trim.
  - 3.3.5.2. Heavy Duty Edge Trim.
  - 3.3.5.3. A bead of recommended sealant.

#### **3.4. SITE QUALITY CONTROL**


- 3.4.1. Non-Conforming Work: Replace damaged work which cannot be satisfactorily repaired, restored or cleaned, to satisfaction of Consultant at no cost to Owner.

#### **3.5. CLEANING**


- 3.5.1. Clean adjacent surfaces, which have been soiled or otherwise marred, to completely remove evidence of material causing same.
- 3.5.2. Initial Cleaning: Upon removing protective film from panels, clean with an anti-static solution.
- 3.5.3. Regular Maintenance: Hygienic wall and ceiling panels can be readily cleaned by washing with generous amounts of water or a diluted neutral soap/detergent solution. Latter having added advantage of making panel surface temporarily anti-static. To reduce buildup of static, cleaning panels with an anti-static solution is recommended. Some cleaning agents may adversely affect panels. Only use manufacturer approved Products. Do not use materials containing abrasives or solvents. Although recommended maximum continuous working temperature of hygienic wall and ceiling panels is 60 deg C (140 deg F), panels may be pressure cleaned for sterilization purposes.

#### **END OF SECTION**


REVISION		
NO.	DATE	DESCRIPTION
1	11/20/2024	PROGRESS COORDINATION
2	11/27/2024	BUILDING PERMIT
3	12/12/2024	PER REVIEW
4	01/21/2025	PER REVIEW
5	01/21/2025	ISSUED FOR BID
6	03/20/2025	BID ADDENDUM #3
7	03/26/2025	BID ADDENDUM #5

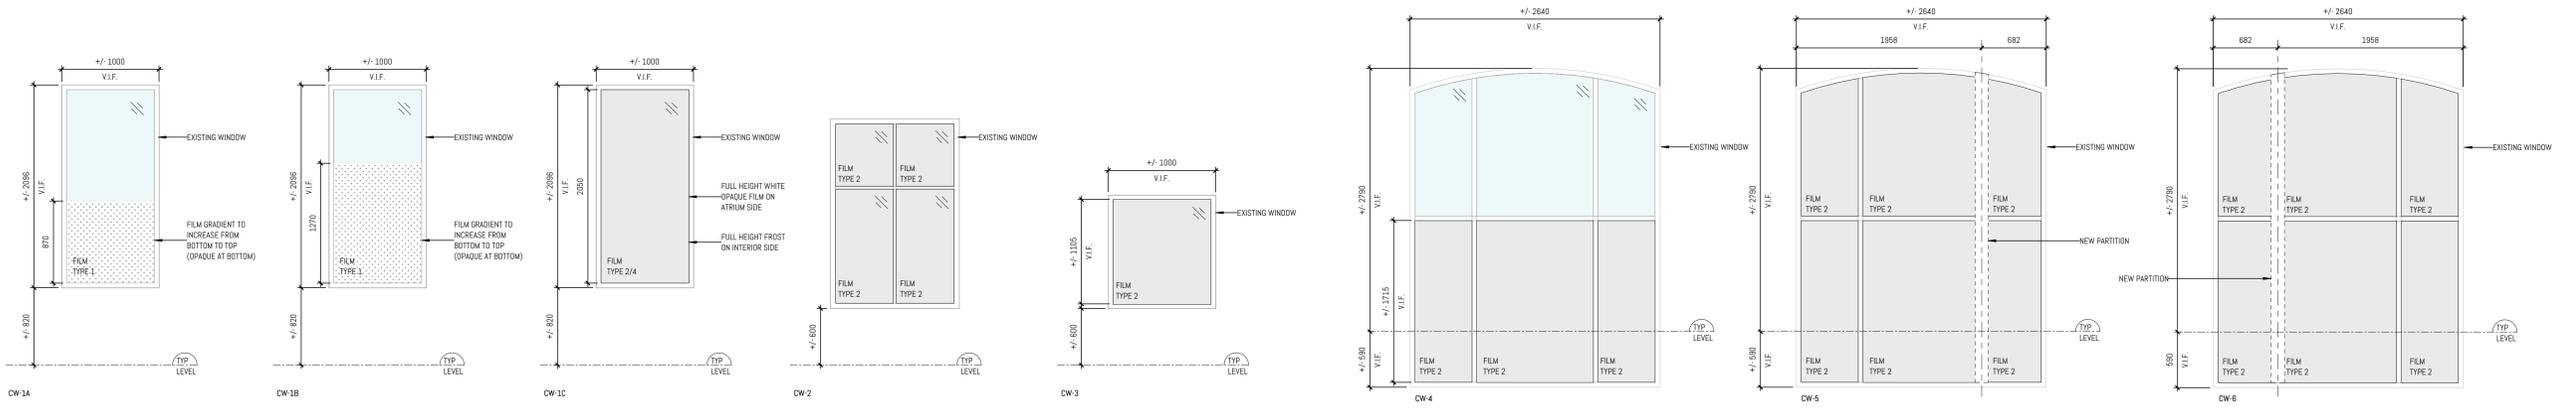


NEW WORK - FILM ON EXISTING GLAZING SCHEDULE  
1:25

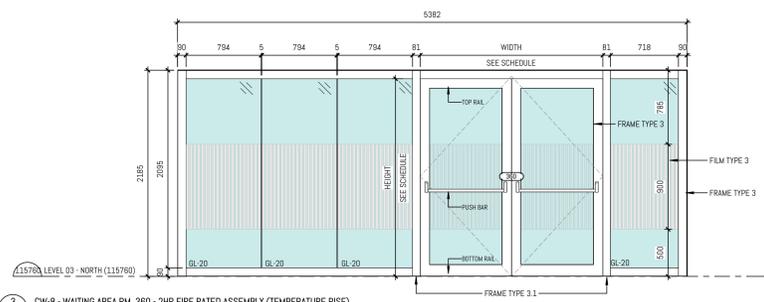


CW-8 - WAITING AREA RM. 380 - 2HR FIRE RATED ASSEMBLY (TEMPERATURE RISE)  
1:25

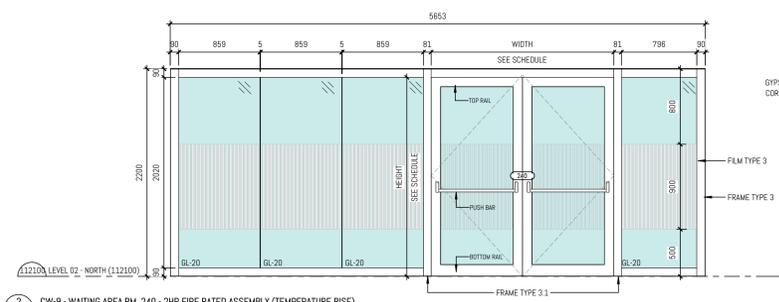


CW-9 - WAITING AREA RM. 240 - 2HR FIRE RATED ASSEMBLY (TEMPERATURE RISE)  
1:25

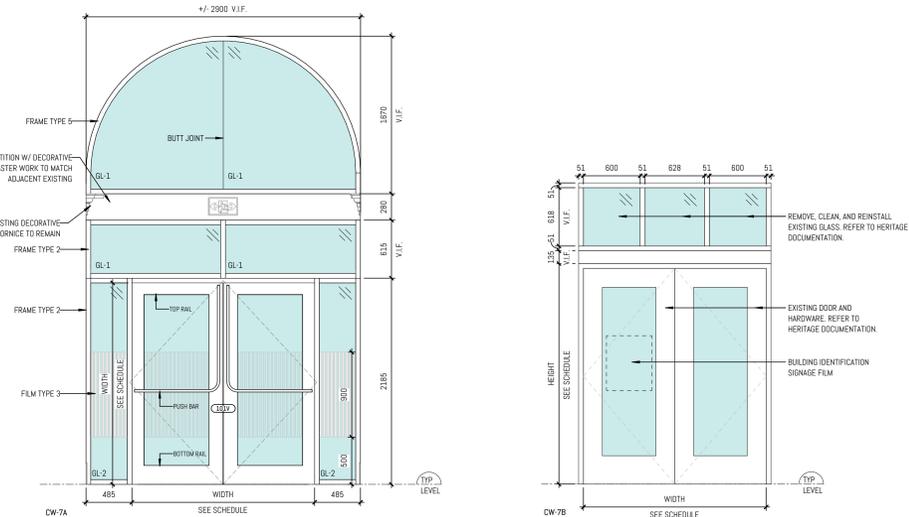


INTERIOR ELEVATION - NEW ALUM DOOR + SCREEN  
EXTERIOR ELEVATION - EXISTING HERITAGE ENTRANCE DOOR AND UPPER LIGHT  
1:25

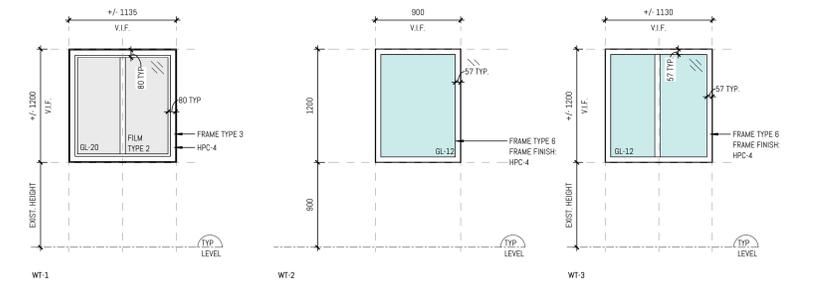


NEW WORK - EXTERIOR WINDOW SCHEDULE  
1:25

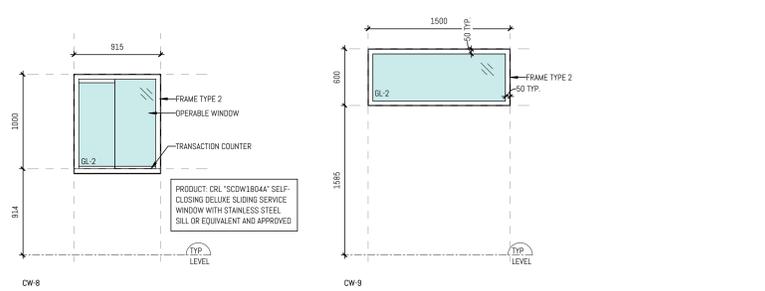

NEW WORK - INTERIOR SCREEN SCHEDULE  
1:25

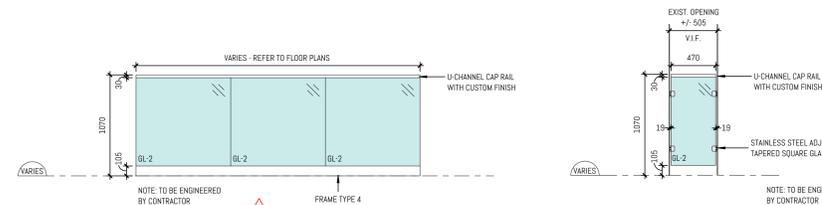

GLASS GUARD - LOUNGE 307, OFFICE 320, OFFICE 322, OFFICE 324 - BOOKSTORE WINDOWS  
GLASS GUARD - LOUNGE 307 - ATRIUM WINDOWS  
1:25

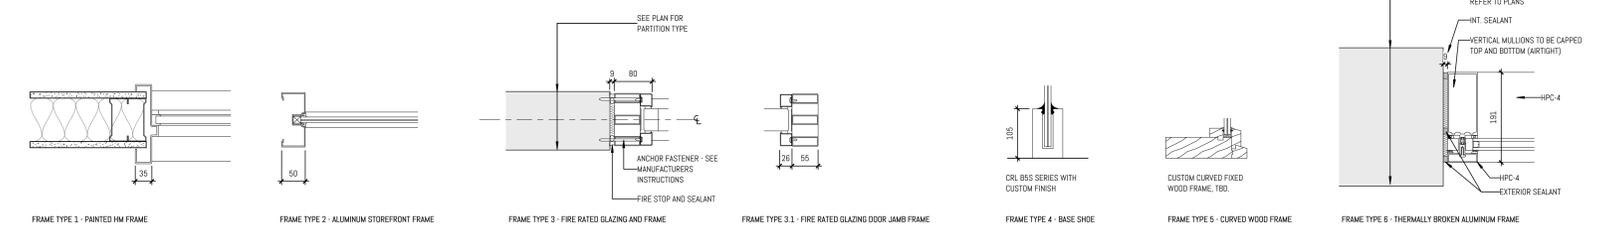

NEW WORK - INTERIOR FRAME TYPES  
1:5

**GLAZING SCHEDULE**

- GL-1: 19mm LAMINATED (FRAMED GLAZING)
  - A. LITE #1 (OUTER)
    - 6mm LOW IRON, TEMPERED
  - B. 1.52mm PVB INTERLAYER
  - C. LITE #2 (MIDDLE)
    - 6mm LOW IRON, TEMPERED
  - D. 12.7mm ARGON FILLED CAVITY
  - E. LITE #3 (INNER)
    - 6mm LOW IRON, TEMPERED
- GL-2: 6mm CLEAR TEMPERED
- GL-3: 9.5mm (3/8") CLEAR TEMPERED


**HIGH PERFORMANCE COATING SCHEDULE**

COATING	COLOR FINISH
HPC-1	HIGH PERFORMANCE COATING COLOUR FINISH: "LIGHT BRONZE" ANODIZED
HPC-2	HIGH PERFORMANCE COATING COLOUR FINISH: "LIGHT BRONZE" ANODIZED
HPC-3	HIGH PERFORMANCE COATING COLOUR FINISH: SOLID/OKALMA WHITE
HPC-4	HIGH PERFORMANCE COATING COLOUR FINISH: MATCH EXISTING WINDOWS
HPC-5	HIGH PERFORMANCE COATING COLOUR FINISH: BLACK

**GLAZING NOTES:**

- CONTRACTOR TO SITE VERIFY DIMENSIONS FOR ALL GLAZING SYSTEMS.
- UNLESS OTHERWISE NOTED, ALL GLAZING DIMENSIONS ARE MEASURED TO ROUGH OPENING.
- DOOR IN STC RATED PARTITIONS REQUIRED ARE TO ACHIEVE A MINIMUM STC-35
- DOOR PANELS ARE TO BE SOLID CORE WOOD WITH A MIN. DENSITY OF 30 KG/M<sup>3</sup>
- PROVIDE PERIMETER SEALS (PEMCO 988 PERIMETER SEAL OR APPROVED EQUIVALENT)
- PROVIDE AUTOMATIC DOOR BOTTOMS (PEMCO 303 S IN DOUBLE DOORS REQUIRING ACOUSTIC PERFORMANCE)
- PROVIDE MIN. 2 X 6.25MM LAMINATED SAFETY GLASS OR 9.5MM (3/8") TEMPERED TO ACHIEVE A MINIMUM STC-35.
- GLAZED SCREENS IN STC RATED PARTITIONS REQUIRED ARE TO ACHIEVE A MINIMUM STC-35
- GLAZING IN DOORS & Sidelights
- REFER TO GLAZING SCHEDULE ON A008 FOR GLAZING TYPES.

- GL-10: TRIPLE GLAZED SPANDREL UNIT - EXTERIOR CURTAIN WALL
  - A. LITE #1 (OUTER)
    - 6mm LOW IRON, HEAT STRENGTHENED
    - LOW E COATING ON SURFACE #2
  - B. 12.7mm ARGON FILLED CAVITY
  - C. LITE #2 (MIDDLE)
    - 6mm LOW IRON, TEMPERED
  - D. 12.7mm ARGON FILLED CAVITY
  - E. LITE #3 (INNER)
    - 6mm LOW IRON, TEMPERED
  - FACTORY BACKPAINT ON SURFACE #6 (COLOUR TBD)
- GL-11: TRIPLE GLAZED UNIT - EXTERIOR CURTAIN WALL
  - A. LITE #1 (OUTER)
    - 6mm LOW IRON, HEAT STRENGTHENED
    - LOW E COATING ON SURFACE #2
  - B. 12.7mm ARGON FILLED CAVITY
  - C. LITE #2 (MIDDLE)
    - 6mm LOW IRON, TEMPERED
  - D. 12.7mm ARGON FILLED CAVITY
  - E. LITE #3 (INNER)
    - 6mm LOW IRON, TEMPERED
- GL-12: DOUBLE GLAZED - PUNCHED WINDOWS
  - A. LITE #1 (OUTER)
    - 6mm LOW IRON, HEAT STRENGTHENED
    - LOW E COATING ON SURFACE #2
  - B. 12.7mm ARGON FILLED CAVITY
  - C. LITE #2 (INNER)
    - 6mm LOW IRON, TEMPERED
- GL-13: (LAMINATED GUARDS + INTERIOR CURTAIN WALL)
  - A. LITE #1 (OUTER)
    - 6mm LOW IRON, TEMPERED
  - B. 1.52mm PVB INTERLAYER (SENTRYGLAS INTERLAYER)
  - C. LITE #2 (INNER)
    - 6mm LOW IRON, TEMPERED
- GL-20:
  - A. CERAMIC FIRE RATED GLAZING SYSTEM TO PROVIDE 2HR FIRE FRAME SYSTEM TO SUIT PERFORMANCE REQUIREMENTS. COLOUR TO BE SELECTED FROM MANUFACTURER'S STANDARD RANGE
  - B. CERAMIC FIRE RATED GLAZING TO PROVIDE INDICATED RATING

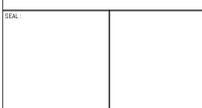


UNIVERSITY OF TORONTO  
HEALTH & WELLNESS CENTRE  
AT KOFFLER RENOVATION

PROJECT NUMBER: <b>23-011 (P143-19-100)</b>		
DRAWING SCALE: <b>AS SHOWN</b>		
DRAWN BY: NE	CHECKED BY: AF	DATE: 2025-01-31
SHEET NO: <b>A008</b>	REV: <b>7</b>	


Schedule Level	Number	Name	FLOORS			WALLS		CEILING		Comments
			Floor Finish	Base Finish	Wall Material	Wall Finish	Ceiling Material	Ceiling Finish		
LEVEL 01	100V	VESTIBULE	PCT-2	EXIST / PCT-3	EXIST	PT-1	EXIST	PT-3		
LEVEL 01	101V	LOBBY	CP-1	EXIST / PCT-3	EXIST	PT-1	EXIST	PT-3	REPLACE EXISTING CP1 TO MATCH	
LEVEL 01	106	WAITING AREA	RF-1	WN-1 / WD-3	DWB	WP-2 / PT-1	ACT-5 / CP-4	CP-2 / PT-3	ALL ELEMENTS (SLAB, DOCTS, ETC.) ABOVE WOOD CEILING TO BE PAINTED BLACK	
LEVEL 01	106V	ELEV ACCESS	RF-1	WN-1	DWB	PT-1 / PCT-4	DWB	PT-3		
LEVEL 01	107	RECEPTION/REGISTRATION	RF-1	WN-1	DWB	PT-1 / WP-2	ACT-1 / GWB / ACT-5	CP-2 / PT-3		
LEVEL 01	107A	COPY	RF-1	WN-1	DWB	PT-1	ACT-2	-		
LEVEL 01	107B	ELEC.	RF-1	WN-1	DWB	PT-1	ACT-2	-		
LEVEL 01	112	MEDIUM M.P. ROOM / SMOODING	LVT-1	WN-1	DWB	WP-1 / PT-1	CP-2 / GWB	PT-3		
LEVEL 01	113	CNMP CARE OFFICE / SAFE QUIET ROOM	LVT-1	WN-1 / WD-3	DWB	PT-1 / WP-3	GWB	PT-3		
LEVEL 01	114	LARGE M.P. ROOM	LVT-1	WN-1	DWB	WP-1 / PT-1	ACT-1 / GWB	PT-3		
LEVEL 01	115	WORK ROOM	LVT-1	WN-1 / WD-3	DWB	PT-1 / WP-3	ACT-3 / GWB	PT-3		
LEVEL 01	115K	CORRIDOR	RF-1	WN-1	DWB	PT-1	ACT-5 / GWB	PT-3		
LEVEL 01	115V	MEET	RF-1	WN-1	DWB	PT-1	GWB	PT-3		
LEVEL 01	118	BF WC/NURSING	RF-1	INTEGRAL COVE	DWB	PT-1 / CT-1	GWB	PT-3		
LEVEL 01	118A	WC	RF-1	INTEGRAL COVE	DWB	PT-1 / CT-1	GWB	PT-3		
LEVEL 01	118	KITCHEN	LVT-1	WN-1	DWB	PT-1 / PCT-5	GWB	PT-3		
LEVEL 01	120S	STAIRS	PCT-1	WN-1	EXIST / GWB	PT-1	GWB	PT-3	REPLACE FLOOR AND STAIR FINISH	
LEVEL 01	120W	MEET	RF-1	WN-1	EXIST / GWB	PT-1	ACT-2A	-		
LEVEL 01	122	IT. CLOSET	RF-3	WN-1	DWB	PT-1	EXIST	-	ANTI-STATIC FLOOR FINISH	
LEVEL 01	122V	STAFF ACCESS	RF-1	WN-1	EXIST / GWB	PT-1	GWB	PT-3		
LEVEL 01	124	CLOSET	LVT-1	WN-1	DWB	PT-1	GWB	PT-3		
LEVEL 01	125	WORK AREA	LVT-1	WN-1	DWB	PT-1	ACT-2A / GWB	PT-3		
LEVEL 01	126	STORAGE	RF-1	WN-1	DWB	PT-1	GWB	PT-3		
LEVEL 01	126A	WC	RF-1	INTEGRAL COVE	DWB	PT-1 / CT-1	GWB	PT-3		
LEVEL 01	126B	ELEC.	RF-1	WN-1	DWB	PT-1	ACT-2	-		
LEVEL 01	130	CUSTOMAL	EPD-1	INTEGRAL COVE	DWB	PT-1	GWB	PT-3	BACKSPLASH TO BE PROVIDED BEHIND MOP SINK	
LEVEL 01	131B	CUSTOMAL	EPD-1	INTEGRAL COVE	DWB	PT-1	EXIST / GWB	PT-3	BACKSPLASH TO BE PROVIDED BEHIND MOP SINK	
LEVEL 01	131K	CORRIDOR	EXIST	EXIST / WN-1	EXIST / GWB	PT-1	EXIST	-		
LEVEL 01	132K	CORRIDOR	EXIST	EXIST / WN-1	EXIST / GWB	PT-1	EXIST	-	PAINT ALL GWS UP TO THE LINE OF THE EXIST. BRICK	

LEVEL 02	202	OFFICE	LVT-3	WN-1	EXIST	PT-1	EXIST	PT-3	
LEVEL 02	202A	OFFICE	LVT-1	WN-1	EXIST	PT-1	EXIST	PT-3	
LEVEL 02	202B	OFFICE	LVT-1	WN-1	EXIST	PT-1	EXIST	PT-3	
LEVEL 02	202C	OFFICE	LVT-1	WN-1	EXIST	PT-1	EXIST	PT-3	
LEVEL 02	202D	OFFICE	LVT-1	WN-1	EXIST	PT-1	EXIST	PT-3	
LEVEL 02	202K	EX CORRIDOR	LVT-1	WN-1	EXIST	PT-1	EXIST	PT-3	
LEVEL 02	202W	WR	RF-1	WN-1	EXIST	PT-1 / EXIST CT	EXIST	PT-3	
LEVEL 02	230K	CORRIDOR	RF-1	WN-1 / WD-3	EXIST	PT-1 / WN-1	EXIST	CP-2 / PT-3	
LEVEL 02	231	MULTI-PURPOSE ROOM #1 / SMOODING	RF-2	WD-3 / WN-1	DWB	WP-1 / PT-1	ACT-5	CP-3 / PT-3	
LEVEL 02	231A	CUSTOMAL	EPD-1	WN-1	DWB	PT-1	GWB	PT-3	
LEVEL 02	231B	ELEC.	RF-1	WN-1	DWB	PT-1	ACT-3B	-	
LEVEL 02	233	MULTI-PURPOSE ROOM #2	RF-2	WD-3 / WN-1	DWB	WP-1 / PT-1	EXIST	CP-3 / PT-3	
LEVEL 02	233A	SECURITY	RF-1	WN-1	DWB	PT-1	ACT-3B	-	
LEVEL 02	235	MULTI-PURPOSE ROOM #3	RF-2	WD-3 / WN-1	DWB	WP-1 / PT-1	EXIST	CP-3 / PT-3	
LEVEL 02	236	STORAGE	RF-1	WN-1	DWB	PT-1	ACT-3B	-	
LEVEL 02	237	LOUNGE	RF-1	WD-3 / WN-1	DWB	PT-1 / WP-3	ACT-5 / GWB	PT-3	
LEVEL 02	237A	LN WC	RF-1	INTEGRAL COVE	DWB	PT-1 / CT-1	GWB	PT-3	
LEVEL 02	237B	BF WC	RF-1	INTEGRAL COVE	DWB	PT-1 / CT-1	GWB	PT-3	
LEVEL 02	237C	WC	RF-1	INTEGRAL COVE	DWB	PT-1 / CT-1	GWB	PT-3	
LEVEL 02	237V	ELEV ACCESS	RF-1	WN-1	DWB	PT-1 / PCT-4	DWB	PT-3	
LEVEL 02	238	IT. CL.	RF-3	WN-1	DWB	PT-1	EXIST / GWB	PT-3	ANTI-STATIC FLOOR FINISH
LEVEL 02	240	WAITING AREA	RF-1	WN-1	DWB	PT-1 / PCT-4	GWB	PT-3	
LEVEL 02	240K	LOBBY	PCT-2	PCT-2	EXIST	PT-1	EXIST	PT-3	
LEVEL 02	240V	ELEVATOR ACCESS	RF-1	WN-1	DWB	PT-1 / PCT-4	GWB	PT-3	
LEVEL 02	241	COUNS. ROOM	WN-1	WN-1	EXIST / GWB	PT-1	ACT-3 / GWB	PT-3	
LEVEL 02	242	RECEPTION	RF-1	WN-1	DWB	PT-1	ACT-3	-	
LEVEL 02	243	COUNS. ROOM	LVT-1	WN-1	EXIST / GWB	PT-1	ACT-3 / GWB	PT-3	
LEVEL 02	244	OFFICE	LVT-1	WN-1	DWB	PT-1	ACT-3 / GWB	PT-3	
LEVEL 02	245	COUNS. ROOM	LVT-1	WN-1	EXIST / GWB	PT-1	ACT-3 / GWB	PT-3	
LEVEL 02	245K	PUBLIC CORRIDOR	RF-1	WN-1	DWB	PT-1	ACT-3 / GWB	PT-3	
LEVEL 02	246	CNMP CARE/MED. COUNS. ROOM	LVT-1	WN-1	DWB	PT-1	ACT-3 / GWB	PT-3	
LEVEL 02	247	COUNS. ROOM	LVT-1	WN-1	DWB	PT-1	ACT-3 / GWB	PT-3	
LEVEL 02	248	CNMP CARE/MED. COUNS. ROOM	LVT-1	WN-1	DWB	PT-1	ACT-3 / GWB	PT-3	
LEVEL 02	249	COUNS. ROOM	LVT-1	WN-1	EXIST / GWB	PT-1	ACT-3 / GWB	PT-3	
LEVEL 02	250	CLUST	EPD-1	INTEGRAL COVE	DWB	PT-1	ACT-3	PT-3	BACKSPLASH TO BE PROVIDED BEHIND MOP SINK
LEVEL 02	251	BF WC	RF-1	INTEGRAL COVE	DWB	PT-1 / CT-1	GWB	PT-3	
LEVEL 02	253	MEETING ROOM	LVT-1	WN-1	EXIST / GWB	PT-1 / WP-2	ACT-3 / GWB	PT-3	
LEVEL 02	255	COUNS. ROOM	LVT-1	WN-1	DWB	PT-1	ACT-3 / GWB	PT-3	
LEVEL 02	257	COUNS. ROOM	LVT-1	WN-1	DWB	PT-1	ACT-3 / GWB	PT-3	
LEVEL 02	258	SCALE	RF-1	WN-1	DWB	PT-1	GWB	PT-3	252
LEVEL 02	259	COUNS. ROOM	LVT-1	WN-1	DWB	PT-1	ACT-3 / GWB	PT-3	
LEVEL 02	260	LG. COUNS. ROOM	LVT-1	WN-1	DWB	PT-1	ACT-3	PT-3	258
LEVEL 02	261	COUNS. ROOM	LVT-1	WN-1	DWB	PT-1	ACT-3 / GWB	PT-3	
LEVEL 02	262	COUNS. ROOM	LVT-1	WN-1	DWB	PT-1	ACT-3 / GWB	PT-3	
LEVEL 02	263	COUNS. ROOM	LVT-1	WN-1	DWB	PT-1	ACT-3 / GWB	PT-3	
LEVEL 02	264	COUNS. ROOM	LVT-1	WN-1	DWB	PT-1	ACT-3 / GWB	PT-3	
LEVEL 02	265	COUNS. ROOM	LVT-1	WN-1	DWB	PT-1	ACT-3 / GWB	PT-3	
LEVEL 02	266	FLEX SPACE	RF-2	WN-1	DWB	PT-1	ACT-3 / GWB	PT-3	
LEVEL 02	267	COUNS. ROOM	WN-1	WN-1	DWB	PT-1	ACT-3 / GWB	PT-3	
LEVEL 02	268	FLEX SPACE	RF-2	WN-1	DWB	PT-1	ACT-3 / GWB	PT-3	
LEVEL 02	269	COUNS. ROOM	LVT-1	WN-1	DWB	PT-1	ACT-3 / GWB	PT-3	
LEVEL 02	270	FLEX SPACE	RF-2	WN-1	DWB	PT-1	ACT-3 / GWB	PT-3	
LEVEL 02	271	DIRECTOR OFFICE/ LG. COUNS. ROOM	LVT-1	WN-1	DWB	PT-1	ACT-3 / GWB	PT-3	
LEVEL 02	272	FLEX SPACE	RF-2	WN-1	DWB	PT-1	ACT-3 / GWB	PT-3	
LEVEL 02	273	OFFICE	LVT-1	WN-1	DWB	PT-1	ACT-3 / GWB	PT-3	
LEVEL 02	274	ELEC.	RF-1	WN-1	DWB	PT-1	GWB	PT-3	
LEVEL 02	277	IT	RF-9	WN-1	DWB	PT-1	ACT-3B	-	ANTI-STATIC FLOOR FINISH
LEVEL 02	277K	STAFF CORRIDOR	RF-1/PCT-1	WN-1	DWB	PT-1	ACT-2	-	
LEVEL 02	280	STAFF LOUNGE/KITCHENETTE	LVT-3/PCT-1	EXIST / WN-1	EXIST / GWB	PT-1 / PCT-5	ACT-2	-	

LEVEL 03	301	CLUST	EPD-1	INTEGRAL COVE	EXIST / GWB	PT-1	ACT-3	-	BACKSPLASH TO BE PROVIDED BEHIND MOP SINK
LEVEL 03	301V	LOBBY NO. 1	PCT-2	WN-1	DWB	PT-1	GWB	PT-3	
LEVEL 03	303	BF WC	RF-1	INTEGRAL COVE	DWB	PT-1 / CT-1	GWB	PT-3	
LEVEL 03	304	HEALTH PROMOTION OFFICE	LVT-1	WN-1	DWB	PT-1	ACT-2	-	
LEVEL 03	305	ELEC.	RF-1	WN-1	DWB	PT-1	EXP	-	
LEVEL 03	305K	PUBLIC CORRIDOR	RF-1	WN-1	EXIST / GWB	PT-1	ACT-2	-	
LEVEL 03	306	HEALTH PROMOTION OFFICE	LVT-1	WN-1	DWB	PT-1	ACT-2	-	
LEVEL 03	307	LOUNGE	RF-1	WN-1	DWB	PT-1	EXIST / GWB / ACT-3	PT-3	
LEVEL 03	307S	STAIRS	PCT-1	WN-1	DWB	PT-1	EXIST	PT-3	
LEVEL 03	320	OFFICE	LVT-1	WN-1	EXIST / GWB	PT-1	ACT-2	-	
LEVEL 03	320K	STAFF CORRIDOR	RF-1	WN-1	EXIST / GWB	PT-1	ACT-2	-	
LEVEL 03	321	CALL ROOM	LVT-1	WN-1	EXIST / GWB	PT-1	ACT-2	-	
LEVEL 03	322	OFFICE	LVT-1	WN-1	EXIST / GWB	PT-1	ACT-2	-	
LEVEL 03	323	WORK ROOM	LVT-1	WN-1	EXIST / GWB	PT-1	ACT-2	-	
LEVEL 03	324	OFFICE	LVT-1	WN-1	EXIST / GWB	PT-1	ACT-2	-	
LEVEL 03	325A	ELEC.	RF-1	WN-1	EXIST / GWB	PT-1	ACT-3	-	
LEVEL 03	325V	ELEVATOR VESTIBULE	RF-1	WN-1	EXIST / GWB	PT-1	ACT-3	-	
LEVEL 03	327	CUSTOMAL	EPD-1	WN-1	EXIST / GWB	PT-1	ACT-3	-	
LEVEL 03	340	COUNS. ROOM	LVT-1	WN-1	EXIST / GWB	PT-1	ACT-3 / GWB	PT-3	
LEVEL 03	340K	CORRIDOR	RF-1	WN-1	DWB	PT-1	GWB	PT-3	
LEVEL 03	341	COUNS. ROOM	LVT-1	WN-1	EXIST / GWB	PT-1	ACT-3 / GWB	PT-3	
LEVEL 03	342	COUNS. ROOM	LVT-1	WN-1	EXIST / GWB	PT-1	ACT-3 / GWB	PT-3	
LEVEL 03	343	COUNS. ROOM	LVT-1	WN-1	EXIST / GWB	PT-1	ACT-3 / GWB	PT-3	
LEVEL 03	344	SUB-WAITING AREA	RF-1	WN-1	EXIST / GWB	PT-1	GWB	PT-3	
LEVEL 03	345	COUNS. ROOM	LVT-1	WN-1	EXIST / GWB	PT-1	ACT-3 / GWB	PT-3	
LEVEL 03	346	COUNS. ROOM	LVT-1	WN-1	EXIST / GWB	PT-1	ACT-3 / GWB	PT-3	
LEVEL 03	347	COUNS. ROOM	LVT-1	WN-1	EXIST / GWB	PT-1	ACT-3 / GWB	PT-3	
LEVEL 03	348	COUNS. ROOM	LVT-1	WN-1	EXIST / GWB	PT-1	ACT-3 / GWB	PT-3	
LEVEL 03	349	COUNS. ROOM	LVT-1	WN-1	EXIST / GWB	PT-1	ACT-3 / GWB	PT-3	
LEVEL 03	350	COUNS. ROOM	LVT-1	WN-1	EXIST / GWB	PT-1	ACT-3 / GWB	PT-3	
LEVEL 03	351	COUNS. ROOM	LVT-1	WN-1	EXIST / GWB	PT-1	ACT-3 / GWB	PT-3	
LEVEL 03	352	SUB-WAITING AREA	RF-1	WN-1	EXIST / GWB	PT-1	GWB	PT-3	
LEVEL 03	353	COUNS. ROOM	LVT-1	WN-1	EXIST / GWB	PT-1	ACT-3 / GWB	PT-3	
LEVEL 03	354	COUNS. ROOM	LVT-1	WN-1	EXIST / GWB	PT-1	ACT-3 / GWB	PT-3	
LEVEL 03	355	CNMP CARE/SMOODING	LVT-1	WN-1	EXIST / GWB	PT-1	ACT-3 / GWB	PT-3	
LEVEL 03	356	COUNS. ROOM	LVT-1	WN-1	EXIST / GWB	PT-1	ACT-3 / GWB	PT-3	
LEVEL 03	357	SUB-WAITING AREA	RF-1	WN-1	DWB	PT-1	GWB	PT-3	
LEVEL 03	357K	EXIT CORRIDOR	RF-1	WN-1	EXIST / GWB	PT-1	GWB	PT-3	
LEVEL 03	357S	STAIRS	PCT-1	WN-1	DWB	PT-1 / PCT-1	GWB	PT-3	
LEVEL 03	357V	ELEV ACCESS	RF-1	WN-1	DWB	PT-1 / PCT-4	GWB	PT-3	
LEVEL 03	358	WC	RF-1	INTEGRAL COVE	DWB	PT-1 / CT-1	GWB	PT-3	
LEVEL 03	360	WAITING AREA	RF-1	WN-1	EXIST / GWB	PT-1 / PCT-4	GWB	PT-3	
LEVEL 03	360V	LOBBY	PCT-2	EXIST / WN-1	EXIST / GWB	PT-1	EXIST / GWB	PT-3	
LEVEL 03	360V	ELEVATOR ACCESS	RF-1	WN-1	EXIST / GWB	PT-1	GWB	PT-3	
LEVEL 03	363	RECEPTION	RF-1	WN-1	DWB	PT-1	ACT-3	-	
LEVEL 03	364	BF EXAM RM.	RF-2	WN-1	EXIST / GWB	PT-1	ACT-3	-	
LEVEL 03	365	CENTRAL SUPPLY	RF-2	WN-1	DWB	PT-1	ACT-3	-	
LEVEL 03	365K	STAFF ACCESS	RF-1	WN-1	EXIST / GWB	PT-1	ACT-3	-	
LEVEL 03	368	EXAM ROOM	WN-1	WN-1	EXIST / GWB	PT-1	ACT-3	-	
LEVEL 03	367	EXAM ROOM	RF-2	WN-1	DWB	PT-1 / PCT-5	ACT-3	-	
LEVEL 03	368	EXAM ROOM	RF-2	WN-1	EXIST / GWB	PT-1	ACT-3	-	
LEVEL 03	369	AUTOCLAVE/SOILED	RF-2	WN-1	DWB	PT-1 / PCT-5	ACT-3	-	
LEVEL 03	370	EXAM RM. / ISOLATION	RF-2	WN-1	EXIST / GWB	PT-1	ACT-3	-	
LEVEL 03	371	WC/SAMPLES	RF-2	INTEGRAL COVE	DWB	PT-1 / CT-1	GWB	PT-3	
LEVEL 03	372	ELEC.	RF-1	WN-1	DWB	PT-1	GWB	PT-3	

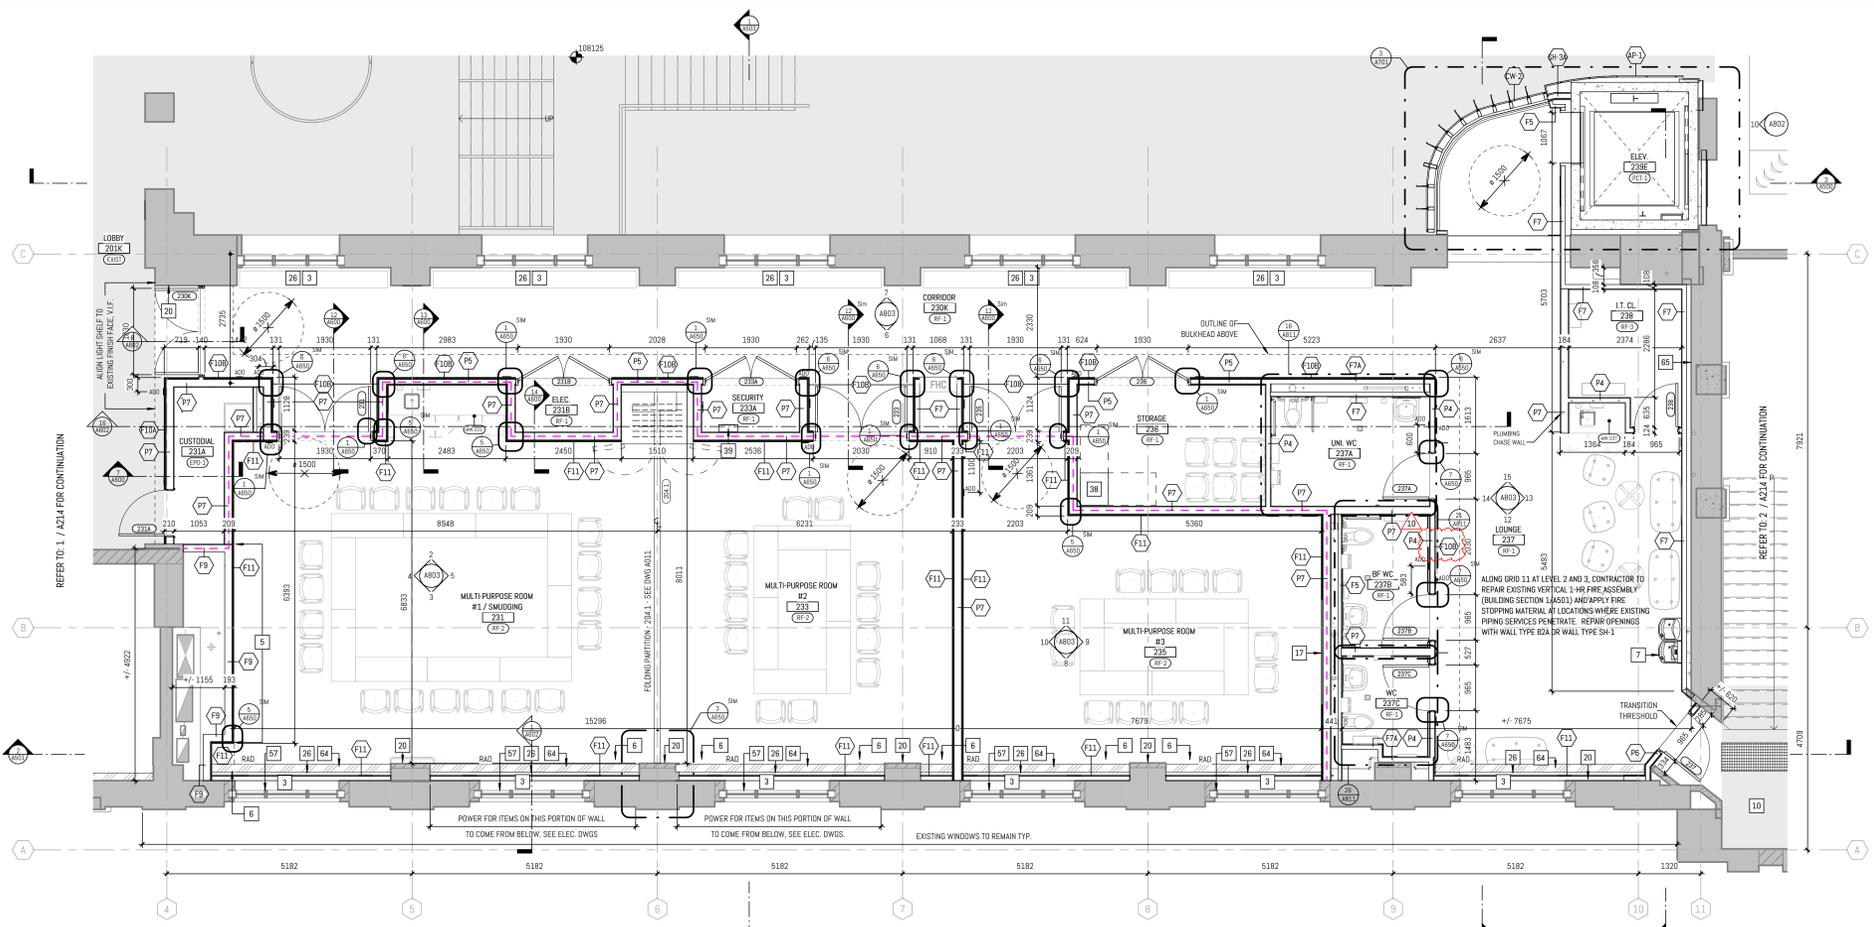

3 LEVEL 02 - EAST - ENLARGED PLAN - UPPER (+249.0MM AFFL)  
1:50

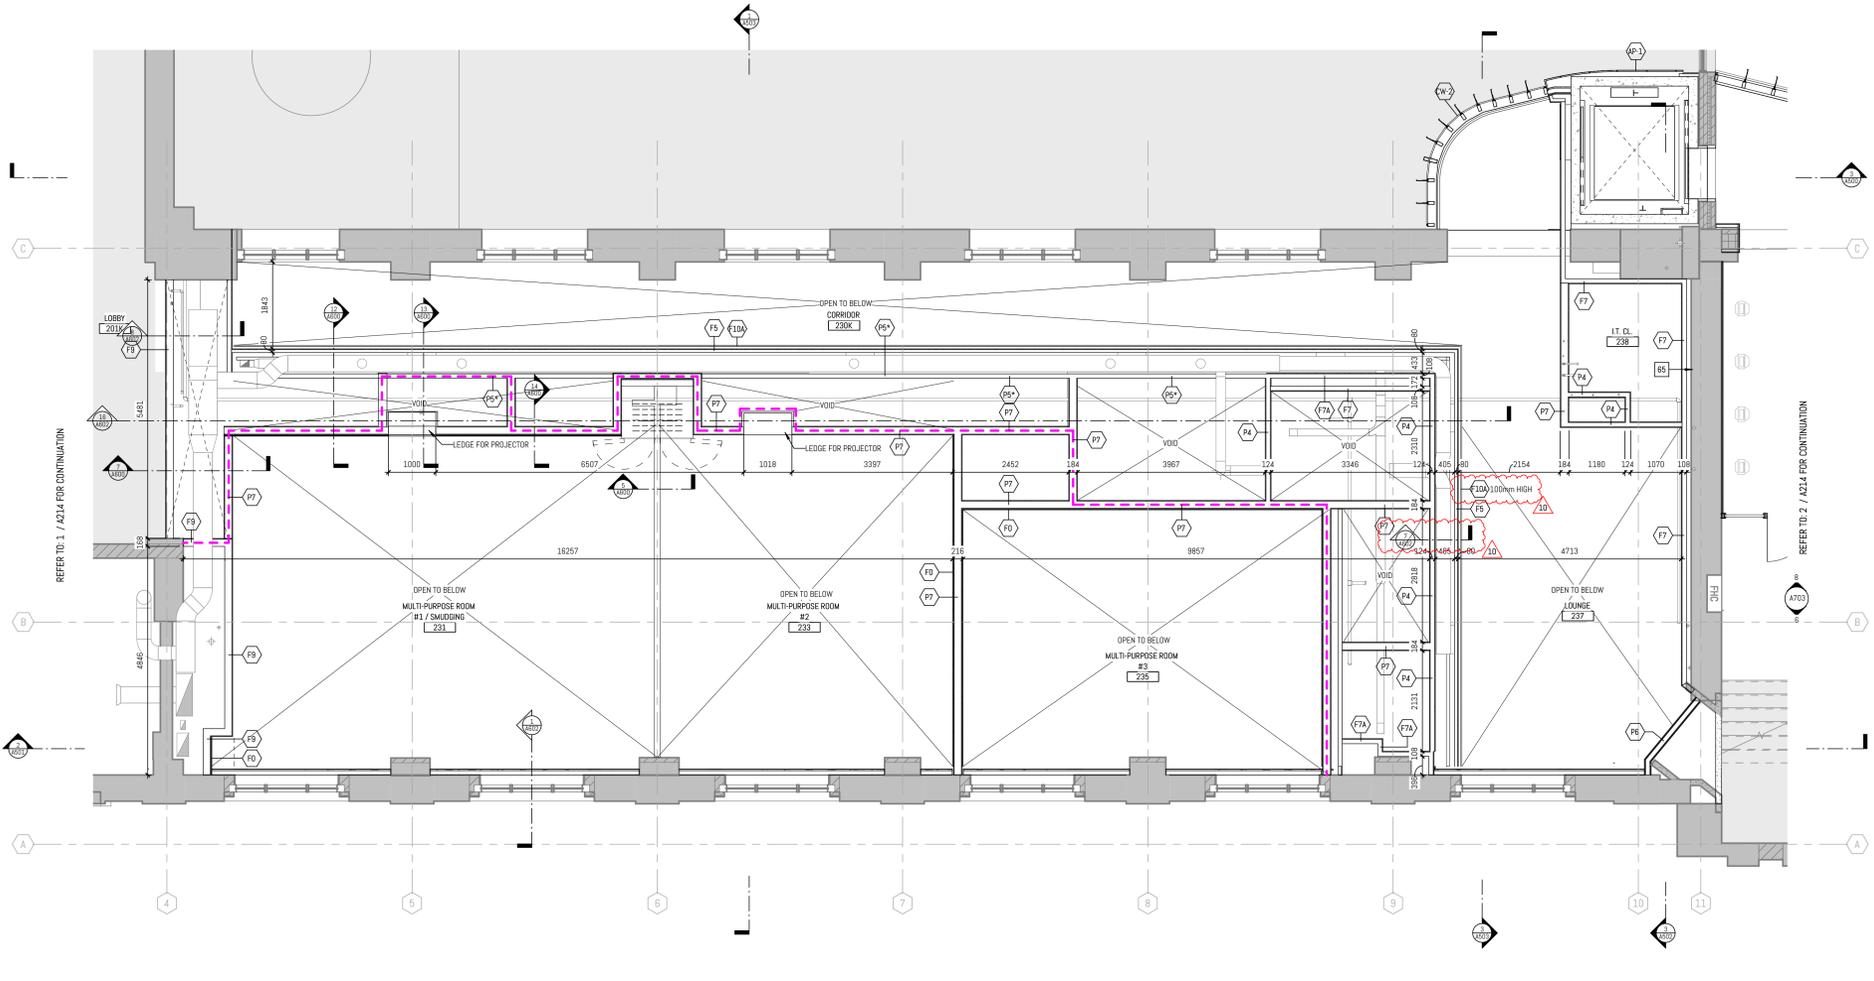

2 LEVEL 02 - EAST - ENLARGED PLAN - UPPER (+249.0MM AFFL)  
1:50

NEW WORK - ENLARGED PLAN NOTES

NOTE	DESCRIPTION
1	PROVIDE NEW FLOORING AND BASE THROUGHOUT ROOM OR TO EXTEND SHOWN ON PLAN TO MATCH EXISTING
2	WHEELCHAIR AND MOBILITY SCOOTER WAITING SPACES DESIGNATED CLEAR SPACE TO BE NO LESS THAN 760mm (30") BY 1370mm (54")
3	REMOVE ALL EXISTING FILM. REPAINT EXISTING WOOD DOOR AND WINDOW FRAMES, SILLS AND CASING
4	NEW SLAB INFILL. REFER TO STRUCTURAL
5	2-HR FIRE RATED ACCESS DOOR FOR MECH. COORDINATE LOCATION WITH MECH ON SITE. SEE INT. ELEVATIONS. SEE MECH.
6	305MM x 305MM RECESSED ACCESS DOOR TO RECEIVE WP-1. COORDINATE LOCATION WITH MECH ON SITE. SEE INT. ELEVATIONS FOR LOCATION. SEE MECH.
7	DRINKING FOUNTAIN. SEE MECH.
8	NEW RADIATOR COVER ON EXISTING RADIANT FIN TUBE. COMPLETE WITH COVERS AND TRIMS TO ENCLOSE ALL PIPING AND EXTEND WALL TO WALL (WHERE APPLICABLE).
9	PAIN EXISTING GWB WALLS, CEILING & BULKHEAD THROUGHOUT ROOM OR TO EXTEND SHOWN ON PLAN. PROTECT AND MAINTAIN EXISTING GOLD CAPITALS.
10	EXISTING TRAVERTINE LANDING & STAIRS TO BE CLEANED & SEALED. REPLACE NON-SLIP STRIPS. PAINT EXISTING METAL GUARDRAILS & HANDRAILS. REFINISH EXISTING WOOD HANDRAILS AS PER SPECIFICATIONS.
11	PROVIDE NEW WALL BASE TO MATCH EXISTING ON NEW WALLS FOR FULL LENGTH OF WALL OR WHERE DAMAGED BY DEMOLITION WORK
12	INSTALL NEW WINDOW IN EXISTING WINDOW OPENING. REFER TO DEMO PLANS FOR REMOVAL OF EXISTING INFILL
13	INSTALL NEW WINDOW IN EXISTING DOOR OPENING. PROVIDE NEW STINE SILL TO MATCH EXISTING SILLS. INFILL WITH 1900MM CMU AND RECLAIMED BRICK MASONRY ABOVE AND BELOW WINDOW TO MATCH EXISTING DOOR. INCLUDING THE RECESSED PANEL PATTERN.
14	NEW RADIATOR WITH INTEGRATED COVER. COMPLETE WITH COVERS AND TRIMS TO ENCLOSE ALL PIPING AND EXTEND WALL TO WALL (WHERE APPLICABLE). REFER TO 7/4802.
15	INSTALL NEW WINDOW IN EXISTING MASONRY WALL. WINDOW SIZE SHOWN FOR INTENT ONLY. SIZE AND LOCATE WINDOW TO SUIT EXISTING BRICK/TILE EXTERIOR WALL FINISH PATTERN AS INDICATED ON EXTERIOR ELEVATIONS. REFER TO STRUCTURAL FOR LIFT DETAILS.
16	REPLACE CARPET TO MATCH EXISTING.
17	REFER TO 17/4802
18	PATCH AND REPAIR OPENING IN BRICK MASONRY AROUND NEW BEAM ANCHORS. SEE STRUCT. RE-USE EXISTING BRICKS
19	INTEGRATE NEW INTERIOR FINISHES WITH EXIST. COLUMN FINISHES PATCH AND MAKE GOOD AS REQ'D (TYP)
20	BRICK IN EXISTING WINDOW OPENINGS WITH COLOR-MATCHING SALVAGED BRICK FROM DEMO PHASE.
21	EXISTING WINDOW OPENING TO BE INFILLED WITH MASONRY. EXISTING GLAZING TO BE COVERED WITH GRAFIC FILM (SPEC AND COLOUR TBD)
22	2HR FRR GLAZING SYSTEM
23	NEW PCT FLOOR FINISH. REFER TO ROOM FINISH SCHEDULE
24	PROVIDE NEW WALL BASE TO MATCH EXISTING PERIMETER WALL BASE TRIM
25	NEW STAINLESS STEEL HANDRAIL. 38 DIA.
26	SS. BOLLARD SEE DETAIL 1/3007
27	NEW GARBAGE BIN LOCATION
28	EXISTING THREE BICYCLE RINGS TO REMAIN
29	REINSTATE FLOOR FINISH TO MATCH EXISTING.
30	SUPPLY AND INSTALL NYL GRAPHIC. OWNER TO PROVIDE DIGITAL FILE.
31	ACCESSIBLE COUNTER
32	SUPPLY AND INSTALL FLOOR MOUNTED MOP SINK WITH WALL MOUNTED MOP HOLDERS AND SHELVING.
33	AV RACK. REFER TO ELEC. AND AV DOCUMENTATION.
34	ELEC. PANELS. REFER TO ELEC. DOCUMENTATION
35	SUPPLY AND INSTALL PLYWOOD SUBSTRATE.
36	SUPPLY AND INSTALL 2-HR FIRE RATED ROLLER SHUTTER. SHUTTER CASSETTE TO BE CONCEALED IN CEILING WITH RECESSED ACCESS DOORS AS REQUIRED
37	NEW HANDRAIL
38	NEW GUARD TO BE ENGINEERED BY CONTRACTOR.
39	EXISTING SPRINKLER PROTECTED GLAZING.
40	MAKE GOOD EXISTING ROOF SYSTEM
41	EXISTING RADIATORS ABOVE. REFER TO MECHANICAL DOCUMENTATION FOR PIPING WORKS
42	SUPPLY AND INSTALL 1 LAYER OF 19mm FIRE RETARDANT PLWOOD (FR17) FASTENED TO THE TOP FLANGE OF THE C-JOISTS
43	NEW STEEL STAIR GUARD - HANDRAIL. ENGINEERED BY CONTRACTOR
44	TYPICAL COMMENT (GROUND FLOOR): SUPPLY AND INSTALL 19MM GWB PATCHING (ONFILL) TO ALL PERIMETER WALL SURFACES WHERE EXISTING OPENINGS (HOLES) ARE OBSERVED LOCATED SOUTH OF GRID 11 UP TO THE 300MM AFF TO ACCOMMODATE A NEW PAINT FINISH.
45	CLEAN EXISTING MASONRY COLUMN. REPAIR, REPOINT AND SUPPLY AND APPLY SEALER - TYPICAL FOR MASONRY COLUMNS
46	PREPARE (SAND AND PRIME) AND REPAIR EXISTING RADIATOR COVERS
47	SUPPLY AND INSTALL MANUAL ROLLER SHADES (INSIDE MOUNT) WITH FIRE FINISHED ALUMINUM FASCIA (COLOUR: WHITE) AND STAINLESS STEEL BALL CHAIN AND KEEPER. CONTRACTOR TO SITE MEASURE EXISTING WINDOW OPENING.
48	SUPPLY AND INSTALL 19MM GWB AT THE BASE OF THE EXISTING WALL TO CLOSE GAP, AND TO ACCOMMODATE NEW PAINT FINISH AND WALL BASE.
49	SUPPLY AND INSTALL MOTORIZED BLACKOUT ROLLER SHADES WITH PRE-FINISHED ALUMINUM FASCIA (COLOUR: WHITE) CONTRACTOR TO SITE MEASURE EXISTING WINDOW OPENING. INTERIOR BLIND CONTROL WITH AV SYSTEMS
50	TYPICAL NOTE FOR 2ND & 3RD LEVELS: MAKE GOOD ALL PERIMETER WALL SURFACES NORTH OF GRID 11 UP TO 2750MM A.F.F. TO ACCOMMODATE A NEW PAINT FINISH. THE SCOPE INCLUDING PATCHING (ONFILL GWB) IF REQUIRED.
51	TYPICAL NOTE FOR 2ND & 3RD LEVELS: MAKE GOOD ALL PERIMETER WALL SURFACES SOUTH OF GRID 11 UP TO THE UNDERSIDE OF THE EXISTING CEILING TO ACCOMMODATE A NEW PAINT FINISH. THE SCOPE INCLUDING PATCHING (ONFILL GWB) IF REQUIRED.
52	ALIGN INSIDE SURFACE OF NEW INFILL WALL ASSEMBLY WITH EXISTING WALL ASSEMBLY ABOVE. CONTRACTOR TO VERIFY DIMENSIONS OF INFILL ASSEMBLY AT SITE FOLLOWING ADAPTMENT WORKS BY OTHERS.
53	EXISTING ROOF LADDERS WITH SAFETY CAGE
54	NEW 4X10' FLOATING GLASS WHITEBOARD
55	NEW RADIATOR/FIN TUBE CONCEALED BEHIND FINISHES.
56	ALIGN GRID 11 AT LEVELS 2 AND 3. CONTRACTOR TO REPAIR EXISTING 3HR FIRE RATED ASSEMBLY (REF. BUILDING SECTION 1/A501) AND APPLY FIRESTOPPING MATERIAL AT LOCATIONS WHERE EXISTING PENETRATION SERVICE PENETRATES (REPAIR OPENINGS WITH WALL TYPE B24 OR WALL TYPE SH-1)
57	SEPARATE PRICE NO. 1: TO SUPPLY AND INSTALL A WATER BASED AIR/LIQUID MOISTURE BARRIER TO THE INSIDE FACE OF THE EXISTING LEVEL 3 EXTERIOR WALL ALONG GRID 14 BETWEEN GRIDS C AND K. CAR SHIELD LMP BY W. R. MEADOWS OF CANADA.
58	ALTERNATIVE PRICE NO. 1: IN LIEU OF THE REMOVAL OF DECOMMISSIONED ELEVATOR AND ASSOCIATED WORKS AS INDICATED IN THE DRAWINGS AND SPECIFIED HEREIN, PROVIDE ONLY DECOMMISSIONING OF THE ELEVATOR (CUT MOST ROPES, & PUT CAB INTO THE PIT, SEAL DOORS, HAVE TSSA DECOMMISSION) AS SPECIFIED HEREIN, INCLUDING ANY ASSOCIATED WORK SHALL BE INCLUDED
59	APPLY FIRESTOPPING TO EXISTING PENETRATIONS TO ENSURE COMPLIANT FIRE SEPARATION



GRID 11 L2 REPAIR AREAS (CONTRACTOR TO V.I.F.)  
1:25

EQUIPMENT TYPE SCHEDULE


EQ #	EXIST. EQ DESCRIPTION	TYPE COMMENT	Supply	Install
EQ-01	PATIENT EXAM BED		UOFF	CONTRACTOR
EQ-02	WALL MOUNTED INTEGRATED EQUIPMENT	SYSTEM INCLUDES: ORPHALMOSCOPE, OTOSCOPES, THERMOMETRY, BLOOD PRESSURE, WALL ANEROID & KLEINSPIC DISPENSER	UOFF	CONTRACTOR
EQ-03	EXAM LIGHTS		UOFF	CONTRACTOR
EQ-06	SPECIMEN FRIDGE		UOFF	CONTRACTOR
EQ-07	PRINTER		UOFF	CONTRACTOR
EQ-08	KIOSK FLOOR STAND FOR IPAD		UOFF	CONTRACTOR
EQ-09	STAINLESS STEEL SPECIMEN PASS-THRU CABINET - 12x12		CONTRACTOR	CONTRACTOR

GENERAL NOTES: NEW WORK

- A. MAKE GOOD ALL EXISTING WALL SURFACES DAMAGED DURING REMOVALS AND CONSTRUCTION
- B. NEW FLOOR FINISHES. REFER TO FINISH SCHEDULE
- C. NEW DOOR & DOOR FRAME. REFER TO DOOR SCHEDULES
- D. PAINT ALL EXISTING DOORS AND DOOR FRAMES
- E. PROVIDE FIRESTOPPING TO ALL NEW FLOOR SERVICE PENETRATIONS. REFER TO MECH AND ELEC DWGS FOR LOCATIONS OF PENETRATIONS
- F. PROTECT ALL EXISTING FINISHES: LANDING, STAIRS, HANDRAILS & GUARDRAILS DURING CONSTRUCTION
- G. CLEAN AND PAINT EXISTING PIPE & MECH. DUCTS AS REQUIRED
- H. THIS DRAWING IS TO BE READ IN CONJUNCTION WITH THE MECHANICAL & ELECTRICAL DRAWINGS
- I. WHERE DISSIMILAR COMPONENTS SUCH AS PUSH BUTTON AND KEY SWITCH ARE INTO FIRE RATED ASSEMBLIES. ENSURE CONTINUITY OF FIRE SEPARATIONS BY BOLTING IN ELEMENTS WITH GYPSUM BOARD AND FRAMING TO SUIT AUTHORITIES JURISDICTION
- J. CONTRACTOR TO PATCH, REPAIR AND MAKE GOOD ALL AREAS DISTURBED BY THE OPERATION OF THE WORK AND DISTURBED BY THE WORK OF OTHER TRADES (MECH, ELEC, AV, B ETC.) MATERIALS AND FINISHES TO MATCH EXISTING UNLESS NOTED OTHERWISE
- K. FILL NEW FLOOR OPENINGS WITH NON SHRINK GROUT. REFER TO MECH AND ELEC DWGS
- L. NEW BR/WALL PARTITIONS AND EXISTING PARTITIONS WITHIN PROJECT C/W NEW BASE. NEW BASE TO BE ONE PIECE ON EACH SEGMENT OF WALL. BOTH SIDES OF THE WALL. WALL TO SIT DIRECTLY ON FLOOR. REFER TO FINISH SCHEDULE
- M. PAINT WALLS AND BULKHEADS IN AND CORRIDORS WITHIN PROJECT SCOPE. REFER TO FINISH SCHEDULE

FLOOR PLAN LEGEND & SYMBOLS

	BLAZING TYPE TAG		NEW NOTE REFERENCE TAG
	WALL TYPE TAG		N/C PRIMARY SCOPE OF WORK
	WALL TYPE TAG (TO BE V.F. BY CONTRACTOR)		SCOPE OF WORK
	SPOT ELEVATION (PROPOSED FLOOR ELEVATION DATUM)		SHELL SPACE - FIT OUT BY OTHERS
	SPOT ELEVATION (EXISTING FLOOR ELEVATION DATUM)		MAKE GOOD EXISTING FLOOR
	EXISTING WALL TO REMAIN		EXIST. UNEXCAVATED SPACE
	NEW PARTITION		DOOR TAG
	NEW OR EXISTING RATED WALL TO BE MAINTAINED		SPECIALTY EQUIPMENT TAG
			REPAIR SCOPE TAG (REFER TO A212A)

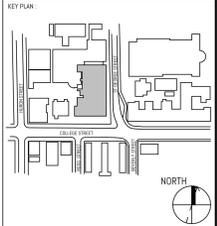

REVISION

NO.	DATE	DESCRIPTION
1	10/20/2024	CLIENT REVIEW
2	10/20/2024	CLIENT REVIEW
3	11/01/2024	PROGRESS ISSUE
4	11/15/2024	BUILDING PERMIT
5	12/12/2024	FIRE REVIEW
6	01/29/2025	FIRE REVIEW
7	03/14/2025	ISSUE FOR BID
8	03/24/2025	BID ADOPTION #2
9	05/09/2025	BID ADOPTION #5




UNIVERSITY OF TORONTO  
HEALTH & WELLNESS CENTRE  
AT KOFFLER RENOVATION


214 College Street, Toronto, ON M5T 3A1

ENLARGED 2ND FLOOR PLAN

PROJECT NUMBER:  
23-011 (P143-19-100)  
DRAWING SCALE:  
1:50  
DRAWN BY:  
NE  
CHECKED BY:  
AF  
DATE:  
2025-01-31  
SHEET NO:  
A213

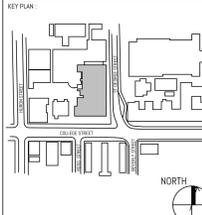

REVISION	
NO.	DESCRIPTION
1	CLIENT REVIEW
2	CLIENT REVIEW
3	CLIENT REVIEW
4	PROPOSED ISSUANCE
5	BUILDING PERMIT
6	PER REVIEW
7	ISSUED FOR BID
8	ISSUED FOR BID
9	BID ADDENDUM #1
10	BID ADDENDUM #2
11	BID ADDENDUM #3
12	BID ADDENDUM #4
13	BID ADDENDUM #5

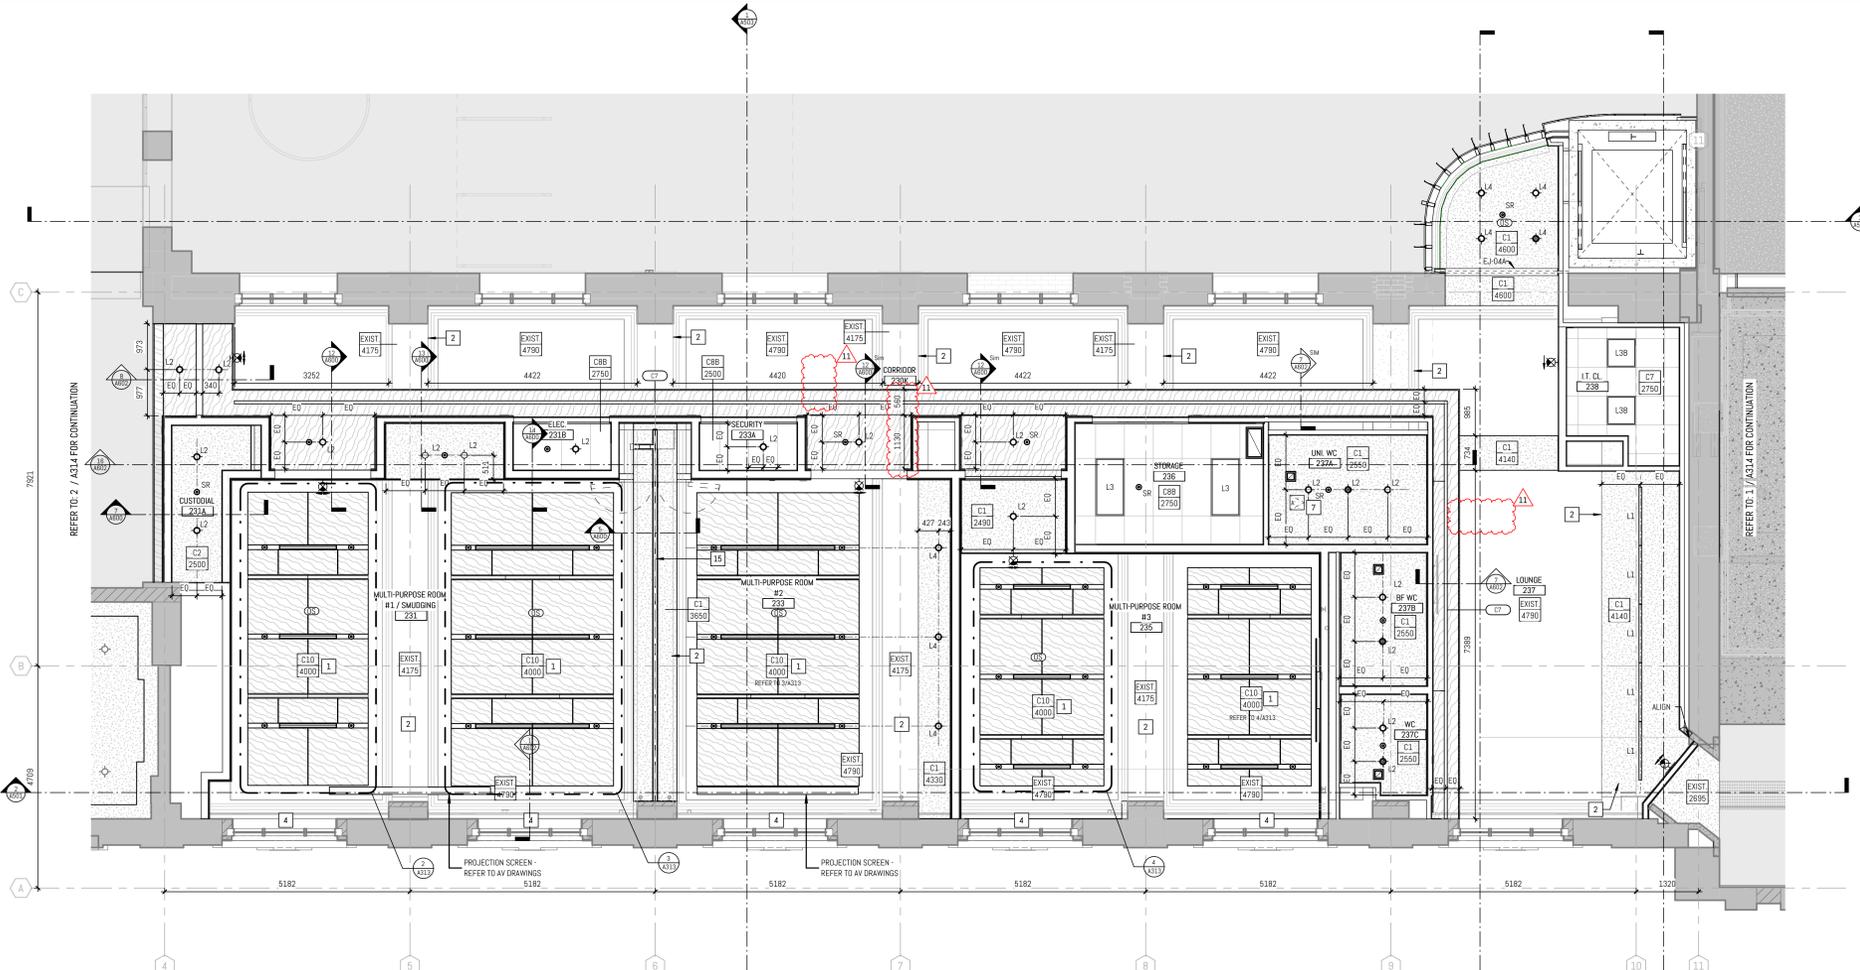


1 2ND FLOOR ENLARGED REFLECTED CEILING PLAN - EAST  
A3113 1:50 REF: 21-A009

NEW WORK - ENLARGED RCP NOTES	
NOTE	DESCRIPTION
1	ACOUSTIC WOOD PANEL CEILING - REFER TO DETAILS.
2	PATCH AND REPAIR EXISTING PLASTER BEAM AND MOULDING. PAINT TO MATCH EXISTING.
3	PROVIDE NEW MANUAL ROLLER SHADES.
4	PROVIDE NEW MOTORIZED ROLLER SHADES. REFER TO ELECTRICAL.
5	7A-305mm x 305mm, 7B-457mm x 457mm RECESSED ACCESS DOOR TO RECEIVE GWB. COORDINATE LOCATION WITH MECHANICAL ON SITE.
6	7A-305mm x 305mm, 7B-457mm x 457mm RECESSED ACCESS DOOR TO RECEIVE GWB. COORDINATE LOCATION WITH MECHANICAL ON SITE.
7	480mm x 480mm FIRE-RATED ACCESS DOOR. COORDINATE LOCATION WITH MECHANICAL ON SITE.
8	GENERAL NOTE (ALL FLOORS): EXISTING GWB AND PLASTER CEILING, BULKHEADS AND PLASTER FINISHED BEAMS TO RECEIVE NEW PAINT FINISH. REFER TO FINISHES SCHEDULE.
9	GENERAL NOTE (3RD FLOOR): APPLY NEW PAINT FINISH TO ALL EXPOSED ROOF STRUCTURE. REFER TO FINISHES SCHEDULE.
10	SEE NOTE B EXCEPT FINISHES TO MATCH EXISTING.
11	PATCH, REPAIR AND MAKE GOOD ALL AREAS DISTURBED BY THE OPERATION OF THE WORK TO RECEIVE PAINT TO MATCH EXISTING.
12	CAMERA OVER ISLAND, CEILING MOUNTED. ALIGN WITH BOTTOM OF RANGE HOOD. REFER TO ELECTRICAL AND AV.
13	TRACK, TEMPERED ALUMINUM OR STEEL TRACK SUPPORTED BY THREADED RODS. TO BE ENGINEERED BY CONTRACTOR.
14	TYPE 1 RECIRCULATING HOOD COMPLETE WITH INTEGRAL FIRE SUPPRESSION SYSTEM. ALIGN EAST SIDE OF EXHAUST TO EDGE OF MILLWORK. REFER TO MECHANICAL DRAWINGS.
15	REINSTATE GWB CEILING FINISH AND ASSOCIATED FIXTURES TO MATCH EXISTING UPON COMPLETION OF STRUCTURAL WORK. REFER TO STRUCTURAL.
16	GENERAL NOTE FOR GROUND FLOOR AND 2ND LEVEL RCP: SUPPLY AND INSTALL NEW FIRE SPRAY SYSTEM TO THE UNDERSIDE OF EXISTING SLAB AND SUPPORTING STRUCTURE - CEILING TYPE EX-F1 (SOUTH OF GRID 11) AND CEILING TYPE EX-F2 (NORTH OF GRID 11).
17	GENERAL NOTE FOR THE THIRD LEVEL RCP (NORTH OF GRID 12): SUPPLY AND INSTALL NEW PAINT FINISH TO THE STEEL ROOF STRUCTURE AND GYPSUM SHEATHING BOARD.
18	SUPPLY AND INSTALL FIRE RATED ROLLER SHUTTER. REFER TO STRUCTURE AND ELECTRICAL.
19	EXISTING SKYLIGHT.
20	MAKE GOOD EXISTING GWB CEILING AND APPLY NEW PAINT FINISH.
21	STUDENT SUCCESS (RM 150) GENERAL NOTE: CORNICE AND CEILING AREAS UNDER REPAIR TO RECEIVE NEW PAINT FINISH TO MATCH EXISTING.
22	STAR 11 GENERAL NOTE: EXISTING CEILING, UNDERSIDE OF STAR LANDINGS AND STEP RUNS, BULKHEADS AND CORNICES TO RECEIVE NEW PAINT FINISH. REFER TO FINISHES SCHEDULE.


GENERAL NOTES - NEW WORK

- A. MAKE GOOD ALL EXISTING WALL SURFACES DAMAGED DURING REMOVALS AND CONSTRUCTION.
- B. NEW FLOOR FINISHES. REFER TO FINISH SCHEDULE.
- C. NEW DOOR & DOOR FRAME. REFER TO DOOR SCHEDULES.
- D. PAINT ALL EXISTING DOORS AND DOOR FRAMES.
- E. PROVIDE FIRESTOPPING TO ALL NEW FLOOR SERVICE PENETRATIONS. REFER TO MECH AND ELEC DWGS FOR LOCATIONS OF PENETRATIONS.
- F. PROTECT ALL EXISTING FINISHES, LANDINGS, STAIRS, HANDRAILS & GUARDRAILS DURING CONSTRUCTION.
- G. CLEAN AND PAINT EXISTING PIPE & MECH. DUCTS AS REQUIRED.
- H. THIS DRAWING IS TO BE READ IN CONJUNCTION WITH THE MECHANICAL & ELECTRICAL DRAWINGS.
- I. WHERE DISSIMILAR COMPONENTS SUCH AS PUSH BUTTON AND KEY SWITCH ARE INTO FIRE RATED ASSEMBLIES, ENSURE CONTINUITY OF FIRE SEPARATIONS BY BONDING ELEMENTS WITH GYPSUM BOARD AND FRAMING TO SUIT AUTHORITIES JURISDICTION.
- J. CONTRACTOR TO PATCH, REPAIR AND MAKE GOOD ALL AREAS DISTURBED BY THE OPERATION OF THE WORK AND DISTURBED BY THE WORK OF OTHER TRADES (MECH, ELEC, AV, ETC.) MATERIALS AND FINISHES TO MATCH EXISTING UNLESS NOTED OTHERWISE.
- K. FILL NEW FLOOR OPENINGS WITH NON SHRINK GROUT. REFER TO MECH AND ELEC DWGS.
- L. NEW DRYWALL PARTITIONS AND EXISTING PARTITIONS WITHIN PROJECT C/W NEW BASE. NEW BASE TO BE ONE PRICE ON EACH SEGMENT OF WALL, BOTH SIDES OF THE WALL. WALL TO SIT DIRECTLY ON FLOOR. REFER TO FINISH SCHEDULE.
- M. PAINT WALLS AND BULKHEADS IN AND CORRIDORS WITHIN PROJECT SCOPE. REFER TO FINISH SCHEDULE.


RCP LEGEND & SYMBOLS			
	CEILING MATERIAL TYPE		DIFFUSERS. SEE MECH. DWGS
	CEILING HEIGHT		GRILLES. SEE MECH. DWGS
	NEW ACT GRID		OCCUPANCY SENSOR. SEE ELEC. DWGS
	NEW GWB CEILING		RECESSED LOUDSPEAKERS. SEE ELEC. & AV.
	SPRINKLER HEAD. SEE MECH. DWGS.		RECESSED SOUND MASKING SPEAKER. SEE ELEC. & AV.
	PTLOUHT FIXTURES. SEE ELEC. DWGS.		N1:C PRIMARY SCOPE OF WORK
	PENDANT LIGHT FIXTURES. SEE ELEC. DWGS.		SCOPE OF WORK
	LINEAR LIGHT FIXTURES. SEE ELEC. DWGS.		EMERGENCY
	WALL MOUNTED EXIT SIGN		1HR RATED BULKHEAD
	CEILING MOUNTED EXIT SIGN		ACCESS PANEL

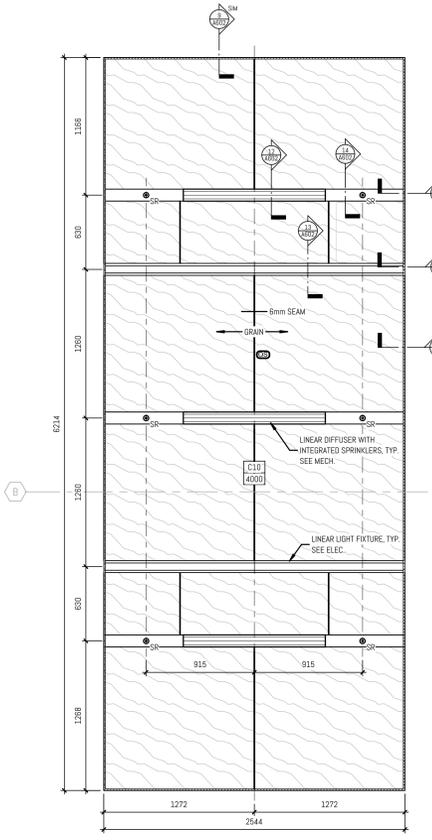

2 MULTI-PURPOSE ROOM #1 / SMUDDING - ENLARGED RCP  
A3113 1:20 REF: 21-A313

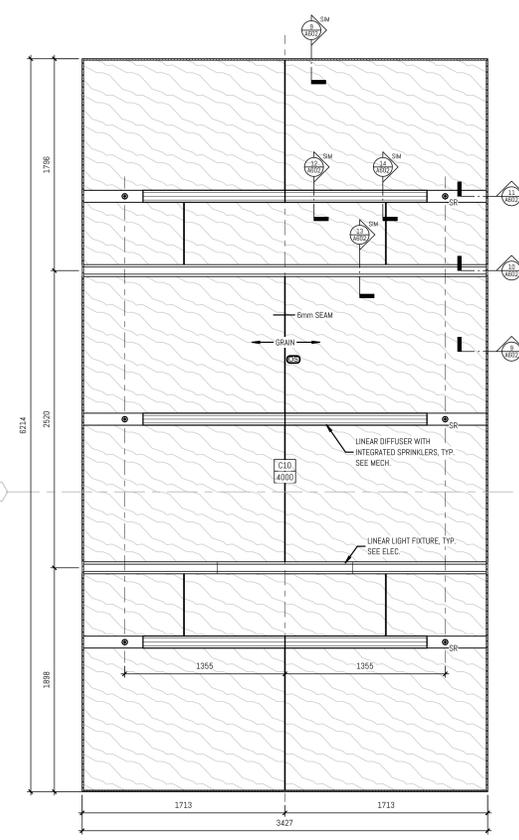

3 MULTI-PURPOSE ROOM #1/2 - ENLARGED RCP  
A3113 1:20 REF: 21-A313

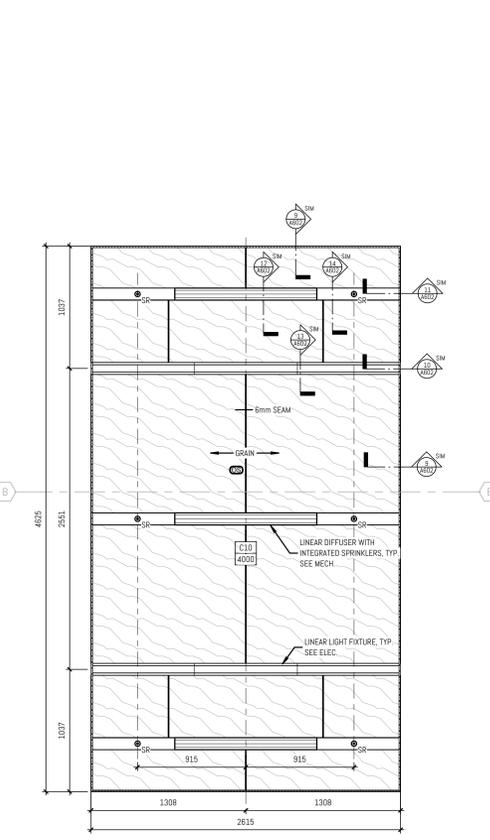

4 2ND FLOOR ENLARGED REFLECTED CEILING PLAN - EAST - ENLARGED RCP  
A3113 1:20 REF: 21-A313

**ENFORM**  
architects  
ENFORM architects inc.  
1304 Bloor Street East, Suite 3020  
Toronto, Ontario, Canada M4M 1B7  
Tel: 416-597-7523  
www.enformarchitects.com



UNIVERSITY OF TORONTO  
HEALTH & WELLNESS CENTRE  
AT KOFFLER RENOVATION

214 College Street, Toronto,  
ON M5T 3A1.

SHEET CONTENTS:  
ENLARGED RCP - LEVEL 02






PROJECT NUMBER:  
23-011 (P143-19-100)

DRAWING SCALE:  
1:50

DRAWN BY: NE  
CHECKED BY: MF  
DATE: 2025-01-31

SHEET NO:  
A313

REVISION	
NO.	DESCRIPTION
1	ISSUED FOR PERMITS
2	ISSUED FOR PERMITS
3	ISSUED FOR PERMITS
4	ISSUED FOR PERMITS
5	ISSUED FOR PERMITS

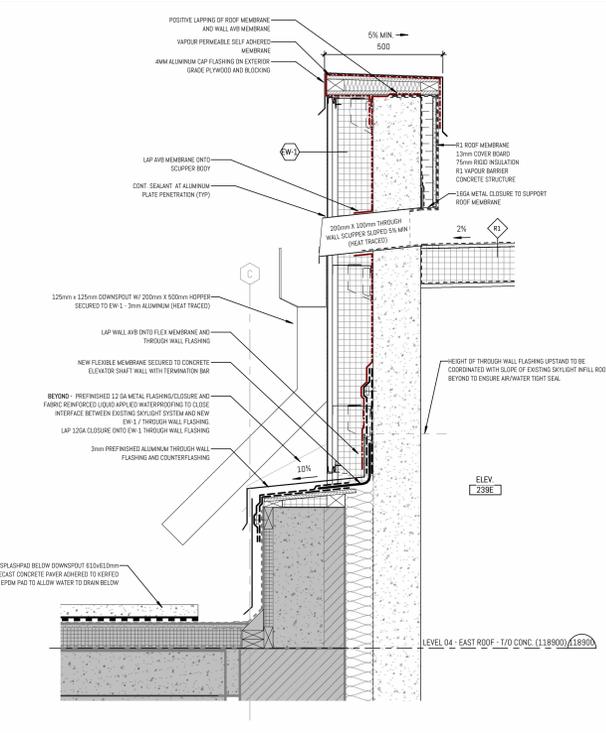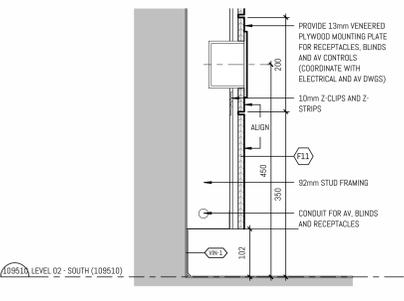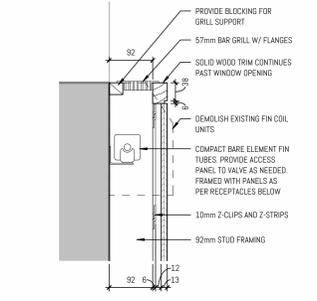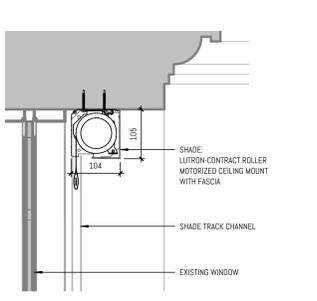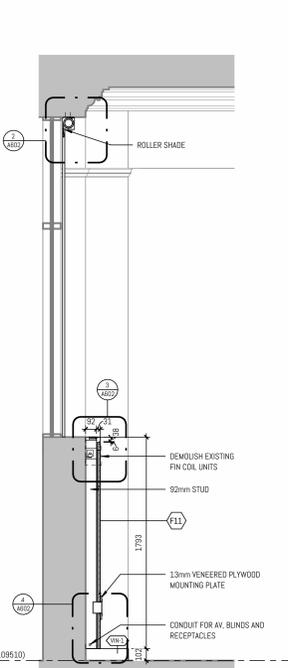



1 INTERIOR SECTION - LEVEL 2 M.P. ROOM EAST WINDOW  
1:20 Ref: 27.4213

2 SECTION DETAIL - LEVEL 02 MP ROOM - ROLLER SHADE @ WINDOW HEAD  
1:5 Ref: 17.4802

3 SECTION DETAIL - LEVEL 02 MP ROOM - RADIATOR @ WINDOW SILL  
1:5 Ref: 17.4802








4 SECTION DETAIL - LEVEL 02 MP ROOM - TYP. DEVICE MOUNTING  
1:5 Ref: 17.4802

5 SECTION DETAIL - ELEVATOR ROOF TO EXISTING 1306 ROOF (LOOKING SOUTH)  
1:10 Ref: 107.4701

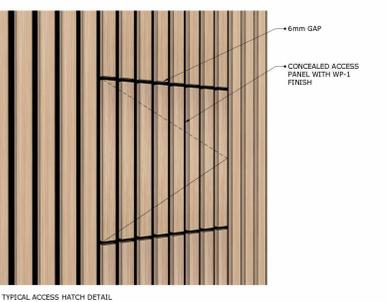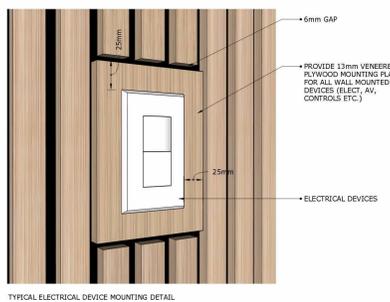

6 RIBB SYSTEM DETAILS  
1:5 Ref: 17.4802

7 TYPICAL ACCESS HATCH DETAIL  
1:5 Ref: 17.4802

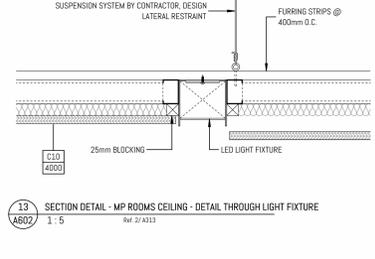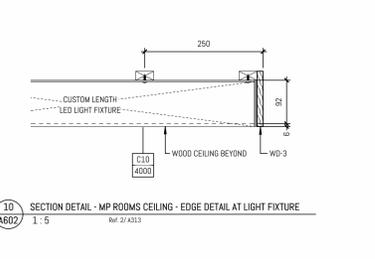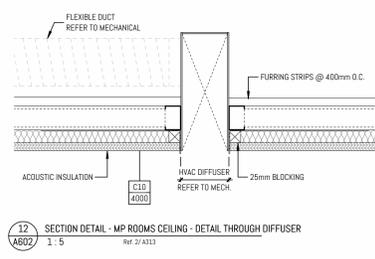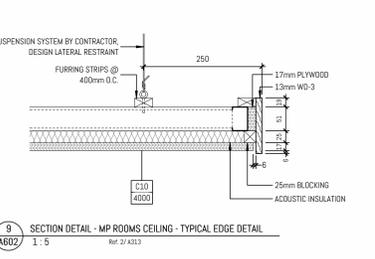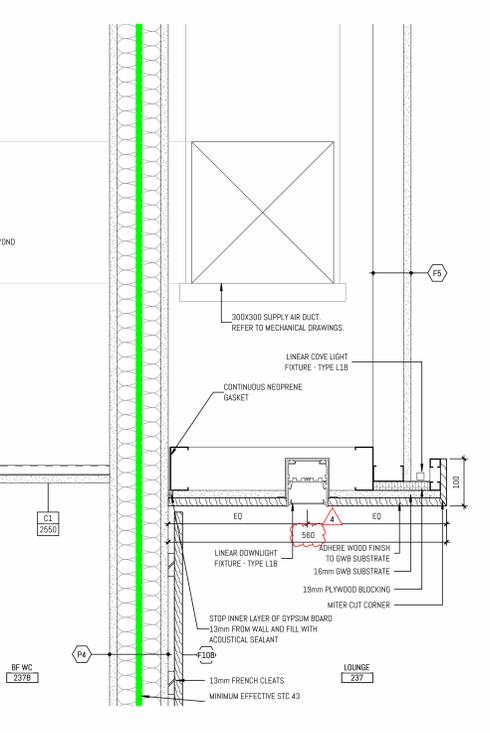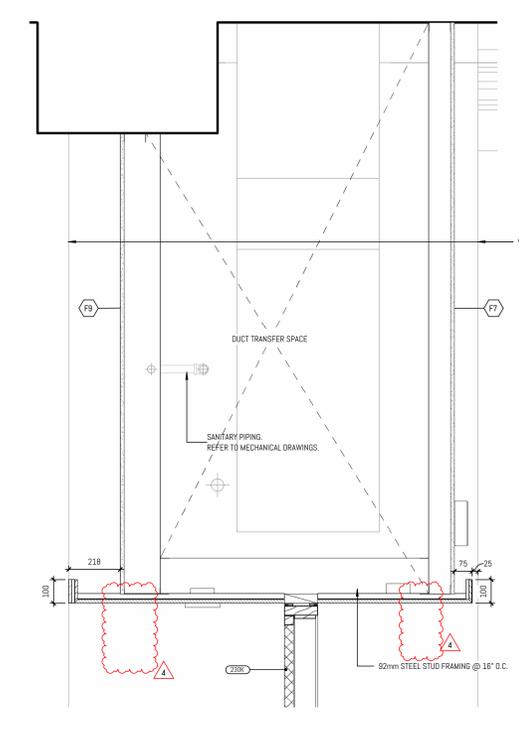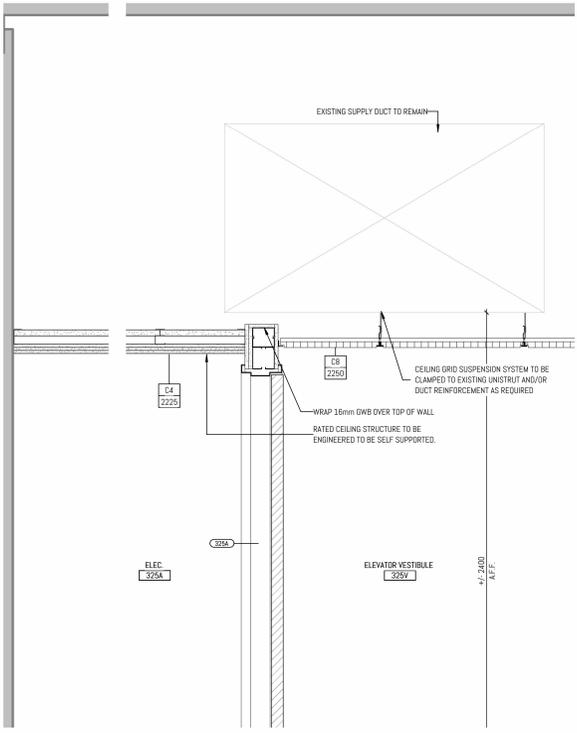

15 SECTION DETAIL - LEVEL 03 - DUCT TRANSFER SPACE OUTSIDE RM. 325 & 327  
1:10 Ref: 27.4213

8 SECTION DETAIL - LEVEL 02 - DUCT TRANSFER SPACE OUTSIDE MULTIPURPOSE RM  
1:10 Ref: 27.4213

7 SECTION DETAIL - LEVEL 02 - BULKHEAD OUTSIDE MULTIPURPOSE RM  
1:5 Ref: 27.4213

9 SECTION DETAIL - MP ROOMS CEILING - TYPICAL EDGE DETAIL  
1:5 Ref: 27.4213


12 SECTION DETAIL - MP ROOMS CEILING - DETAIL THROUGH DIFFUSER  
1:5 Ref: 27.4213

10 SECTION DETAIL - MP ROOMS CEILING - EDGE DETAIL AT LIGHT FIXTURE  
1:5 Ref: 27.4213

13 SECTION DETAIL - MP ROOMS CEILING - DETAIL THROUGH LIGHT FIXTURE  
1:5 Ref: 27.4213

11 SECTION DETAIL - MP ROOMS CEILING - EDGE DETAIL AT CONCEALED SPRINKLER  
1:5 Ref: 27.4213

14 SECTION DETAIL - MP ROOMS CEILING - DETAIL THROUGH DIFFUSER1  
1:5 Ref: 27.4213

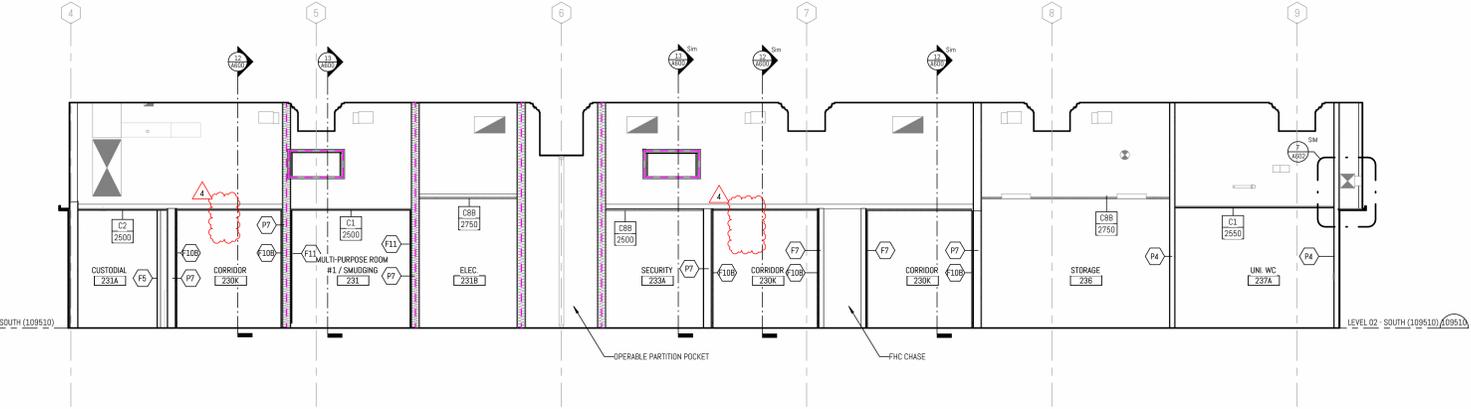

16 PARTIAL SECTION DETAIL - LEVEL 02 - CROSS SECTION THRU SERVICE BULKHEAD  
1:50 Ref: 27.4213



IMAGE 1 - EXISTING CONDITIONS - LEVEL 03 (PROPOSED RM 325A/327)

IMAGE 2 - EXISTING CONDITIONS - LEVEL 03 (PROPOSED RM 325B)

**ENFORM**  
architects  
ENFORM architects inc.  
1234 Bloor Street East, Suite 3000  
Toronto, Ontario, Canada M4W 2R7  
Tel: 416-597-7523  
www.enformarchitect.com

UNIVERSITY OF  
TORONTO

PROJECT  
UNIVERSITY OF TORONTO  
HEALTH & WELLNESS CENTRE  
AT KOFFLER RENOVATION

214 College Street, Toronto,  
ON M5T 3A1




























SHEET CONTENTS  
SECTION DETAILS

PROJECT NUMBER  
23-011 (P143-19-100)

DRAWING SCALE  
As indicated

DRAWN BY: DD  
CHECKED BY: AF  
DATE: 2025-01-31

SHEET NO.  
A602

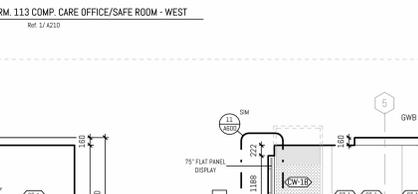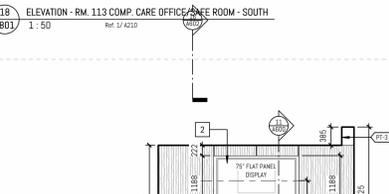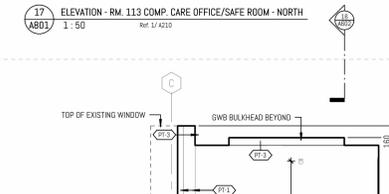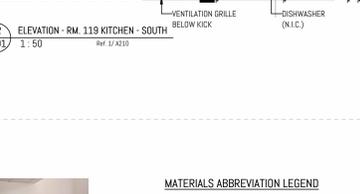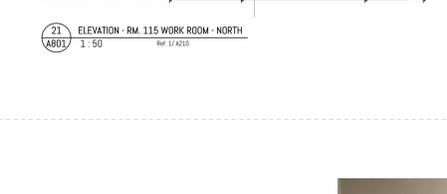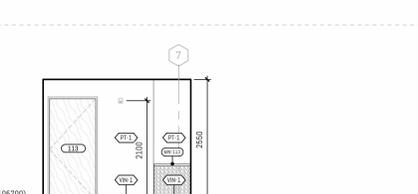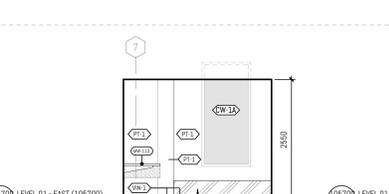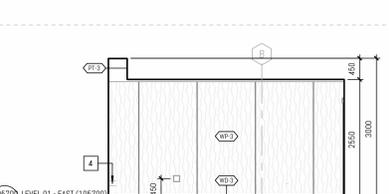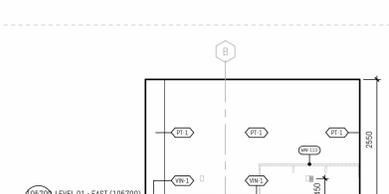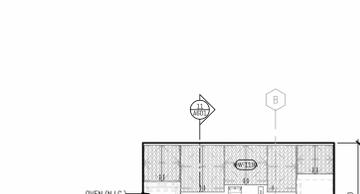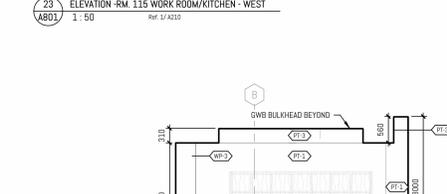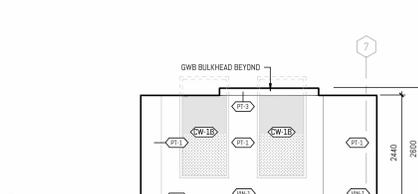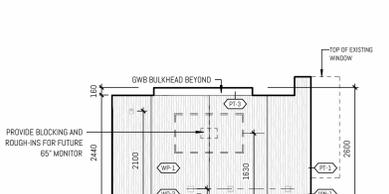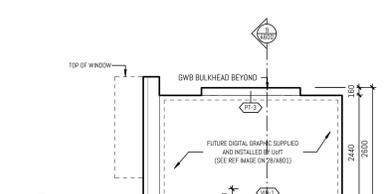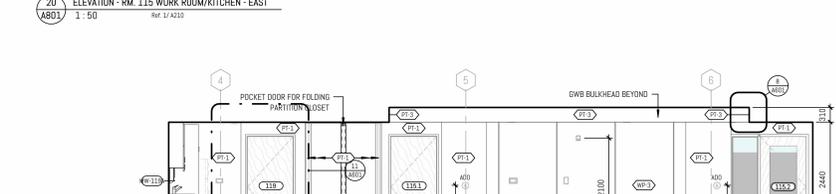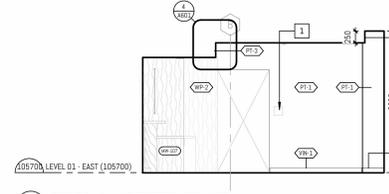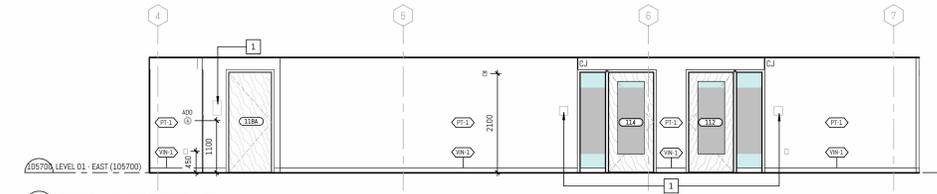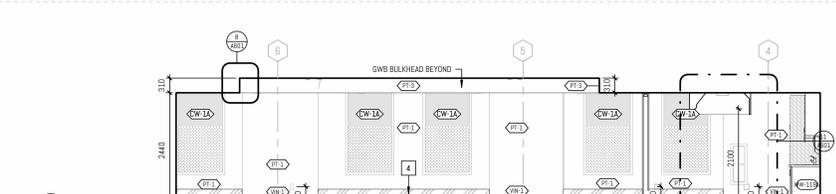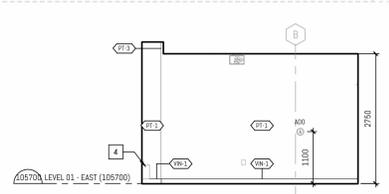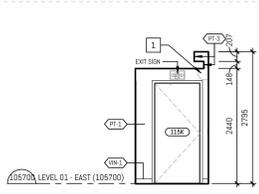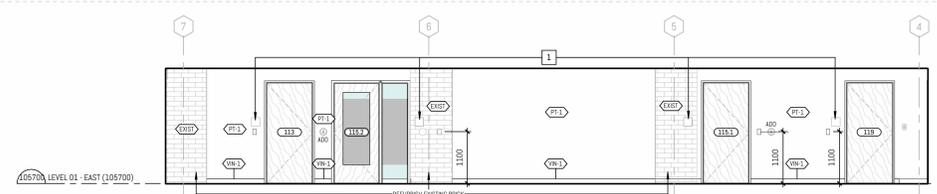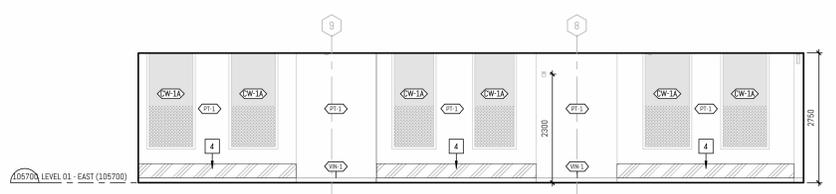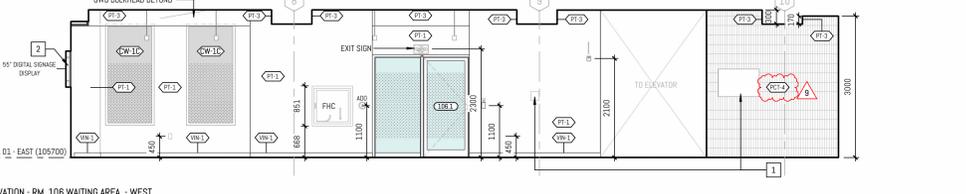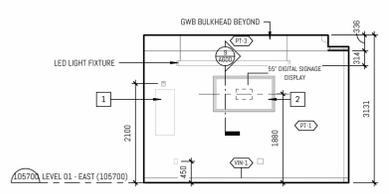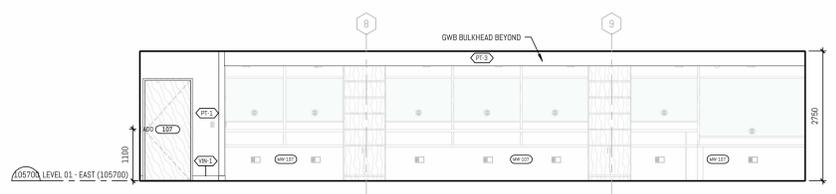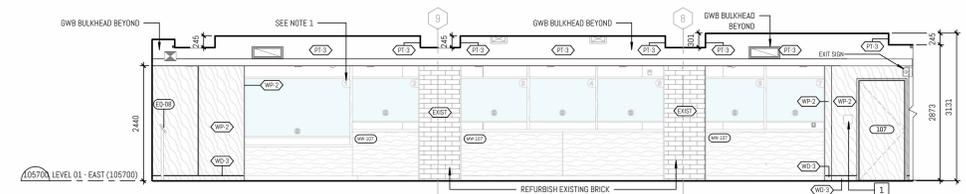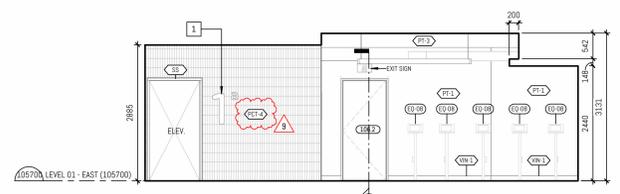

28 MEDIUM M.P. RM. 112 - VINYL WALL GRAPHIC

**MATERIALS ABBREVIATION LEGEND**

ACT	ACOUSTIC CEILING TILE
BPG	BACK-PAINTED GLASS
CK	CORK
CP	CEILING PANEL
CT	CERAMIC TILE
EPF	EPoxy FLOOR FINISH
FB	FABRICS
FG	FIRE RATED GLASS
FILM	GLAZING SURFACE FILM
GWB	Gypsum WALLBOARD
HPC	HIGH PERFORMANCE COATING
LVT	LUXURY VINYL FLOORING
MEL	MELAMINE
MIR	MIRROR
MDF	MEDIUM DENSITY FIBREBOARD
MFL	METAL FINISHES
PLY	FIRE RATED PLYWOOD
PCT	PORCELAIN TILE
PC	PRECAST CONCRETE
PLAM	PLASTIC LAMINATE
PNT	PAINT
RF	RESILIENT SHEET FLOORING
SS	STAINLESS STEEL
SMA	SOLID SURFACE MATERIAL
STL	STEEL
STO	NATURAL STONE
TGL	TEMPERED GLASS
TRAV	TRAVERTINE TILE
VIN	VINYL WALL BASE
WB	DRY STACK WHITEBOARD
WD	SOLID WOOD
WP	WALL PANEL
WV	WOOD VENEER

REFER TO SPECIFICATIONS FOR MATERIAL INFORMATION

**INTERIOR ELEVATION NOTES**

NOTE	DESCRIPTION
1	SIGNAGE BY OTHERS, BLOCKING SUPPORT (WHERE REQUIRED), SUPPLY, AND INSTALL BY CONTRACTOR. SEE SIGNAGE AND WAYFINDING DWGS.
2	DISPLAY BY OTHERS, BLOCKING SUPPORT, SUPPLY, AND INSTALL BY CONTRACTOR. SEE EX DWGS.
3	NEW RADIATOR COVER ON EXISTING RADIANT FIN TUBE. COMPLETE WITH COVERS AND TRIMS TO ENCLOSE ALL PIPING AND EXTEND WALL TO WALL (WHERE APPLICABLE).
4	NEW RADIATOR WITH INTEGRATED COVER. COMPLETE WITH COVERS AND TRIMS TO ENCLOSE ALL PIPING AND EXTEND WALL TO WALL (WHERE APPLICABLE). REFER TO 7/4802.
5	PREPARE (SAND AND PRIME) AND REPAINT EXISTING RADIATOR COVER.
6	NEW RADIATOR/FIN TUBE CONCEALED BEHIND FINISHES.

**EQUIPMENT TYPE SCHEDULE**

EQ #	EXIST EQ DESCRIPTION	TYPE COMMENT	Supply	Install
EQ-01	PATIENT EXAM BED		U/RT	CONTRACTOR
EQ-02	WALL MOUNTED INTEGRATED EQUIPMENT	SYSTEM INCLUDES: OPHTHALMOSCOPE, OTOSCOPIES, THERMOMETRY, BLOOD PRESSURE, WALL ANEROID & KLEINSPERZ DISPENSER	U/RT	CONTRACTOR
EQ-03	EXAM LIGHTS		U/RT	CONTRACTOR
EQ-08	SPECIMEN FRIDGE		U/RT	CONTRACTOR
EQ-07	PRINTER		U/RT	CONTRACTOR
EQ-08	KITCHEN FLOOR STAND FOR IPAD		U/RT	CONTRACTOR
EQ-09	STAINLESS STEEL SPECIMEN PASS THRU CABINET - 12x12		CONTRACTOR	CONTRACTOR

**REVISION**

NO.	DATE	DESCRIPTION
1	08/20/2024	CLIENT REVIEW
2	09/20/2024	CLIENT REVIEW
3	10/04/2024	CLIENT REVIEW
4	11/01/2024	PROGRESS ISSUEANCE
5	11/15/2024	BUILDING PERMIT
6	12/10/2024	PER REVIEW
7	01/28/2025	PER REVIEW
8	01/17/2025	ISSUED FOR BID
9	03/26/2025	BID ASSESSMENT

**ENFORM architects**  
 ENFORM architects Inc.  
 1234 Bloor Street, Suite 3000  
 Toronto, Ontario, Canada M5S 2B7  
 Tel: 416-597-7523  
 www.enformarchitect.com



**UNIVERSITY OF TORONTO**  
 HEALTH & WELLNESS CENTRE  
 AT KOFFLER RENOVATION

214 College Street, Toronto, ON M5T 3A1.

SHEET CONTENTS:  
 INTERIOR ELEVATIONS AND DETAILS - LEVEL 01

PROJECT NUMBER:  
 23-011 (P143-19-100)

DRAWING SCALE:  
 As indicated

DRAWN BY: NE  
 CHECKED BY: JAF  
 DATE: 2025-01-31

## BID ADDENDUM

---

PROJECT NAME: HEALTH AND WELLNESS CENTRE RENOVATION AT KOFFLER

---

COMPANY: ENFORM ARCHITECTS

---

ATTENTION: Alan Fraser

---

PROJECT NO.: 21590.003.E.001

DATE: 2025-03-28

---

BID ADDENDUM NO.: #05

ISSUED BY: Wun Yan Chow

---

The following amendments are hereby made as part of the Contract Documents. The following revisions and/or additions shall be made to contract documents and the cost shall be included in the Tender Price.

---

### 1.0 DRAWINGS

#### 1.1 Refer to E024 RISER DIAGRAM (included herein)

- 1.1.1 Provide additional requirement to connect lighting control system to fire alarm system such that upon fire alarm activation, all lighting to be brought to full brightness.
- 1.1.2 Clarified specification for wall occupancy sensor.

#### 1.2 Refer to E401-A LEVEL 01 – LIGHTING CONTROL PLAN (included herein)

- 1.2.1 Removed ALC/LCM from service rooms (elec/IT). Typ. of 2.
- 1.2.2 Revised 125, 126A LCM to ALC.

#### 1.3 Refer to E402-A LEVEL 02 – LIGHTING CONTROL PLAN (included herein)

- 1.3.1 Removed ALC/LCM from service rooms (elec/IT). Typ. of 3.
- 1.3.2 Revised #230K, #240 LCM to ALC.
- 1.3.3 Provide one new dimmer in #280, #245K,
- 1.3.4 Clarified zoning throughout.

#### 1.4 Refer to E403-A LEVEL 03 – LIGHTING CONTROL PLAN (included herein)

- 1.4.1 Removed ALC/LCM from service rooms (elec/IT). Typ. of 5.
- 1.4.2 Revise toggle switch to OS in 399C




- 1.4.3 Clarified control type in #398, #399A.
- 1.4.4 Provide LCM and dimmer for L2 lighting outside #369.
- 1.4.5 Provide LCM for L9 lighting in #397K.
- 1.4.6 Revised LCM to ALC in #360.
- 1.4.7 Provide OS in #363, #365, #367, #369.
- 1.4.8 Clarified zoning throughout.

## **2.0 CLARIFICATION**


- 2.1.1 Coordination

END OF ELECTRICAL BID ADDENDUM

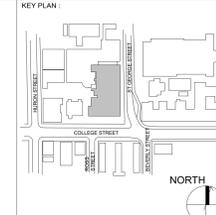

REVISION		
NO.	DATE	DESCRIPTION
1	2024-05-04	ISSUED FOR SO
2	2024-11-15	PERMIT
3	2024-12-24	ISSUED FOR F&S REVIEW
4	2024-12-23	ISSUED FOR F&S REVIEW
5	2025-01-24	ISSUED FOR F&S REVIEW
6	2025-01-21	ISSUED FOR BID
10	2025-03-25	BID ADDENDUM #04
11	2025-03-28	BID ADDENDUM #05

LIGHTING CONTROL DEVICE SCHEDULE		
TYPE	DESCRIPTION	MANUFACTURER/CATALOGUE NO.
OS A	24V DUAL TECH LOW VOLTAGE OCCUPANCY SENSOR	WATTSTOPPER DT-305 CW ENCELIUM SENSOR INTERFACE MODULE
OS	ENCELIUM WIRED OCCUPANCY SENSOR	5656-EN-SCPH-1505-G82
OS HB	ENCELIUM WIRED HIGH BAY OCCUPANCY SENSOR	5657-EN-SCPH-HB-G82
D	ENCELIUM 3 SCENE WALL STATION	ENCELIUM EN-WS-SC3-G82-WH1
D D2	ENCELIUM 5 SCENE WALL STATION	ENCELIUM EN-WS-SC5-G82-WH1
D D3	ENCELIUM WALL DIMMER	ENCELIUM EN-WS-4B-G82-WH1
D D4	ENCELIUM WALL SWITCH (ON/OFF ONLY)	ENCELIUM EN-WS-2B-G82-WH1
D D5	ENCELIUM TOUCHSCREEN	ENCELIUM KX4
OS	WALL MOUNTED OCCUPANCY SENSOR	WATTSTOPPER DW-100-24-W-CW ENCELIUM SENSOR INTERFACE MODULE (EN-M-G82-A) (EN-ECU-G82-PD) (EXTEND)
WM	WIRED MANAGER	
ALC	AREA LIGHTING CONTROLLER	ENCELIUM EN-ALC-1R10V-G82-BK
LCM	LIGHTING CONTROL MODULE	ENCELIUM EN-ILCM-1R10V-G82-BK

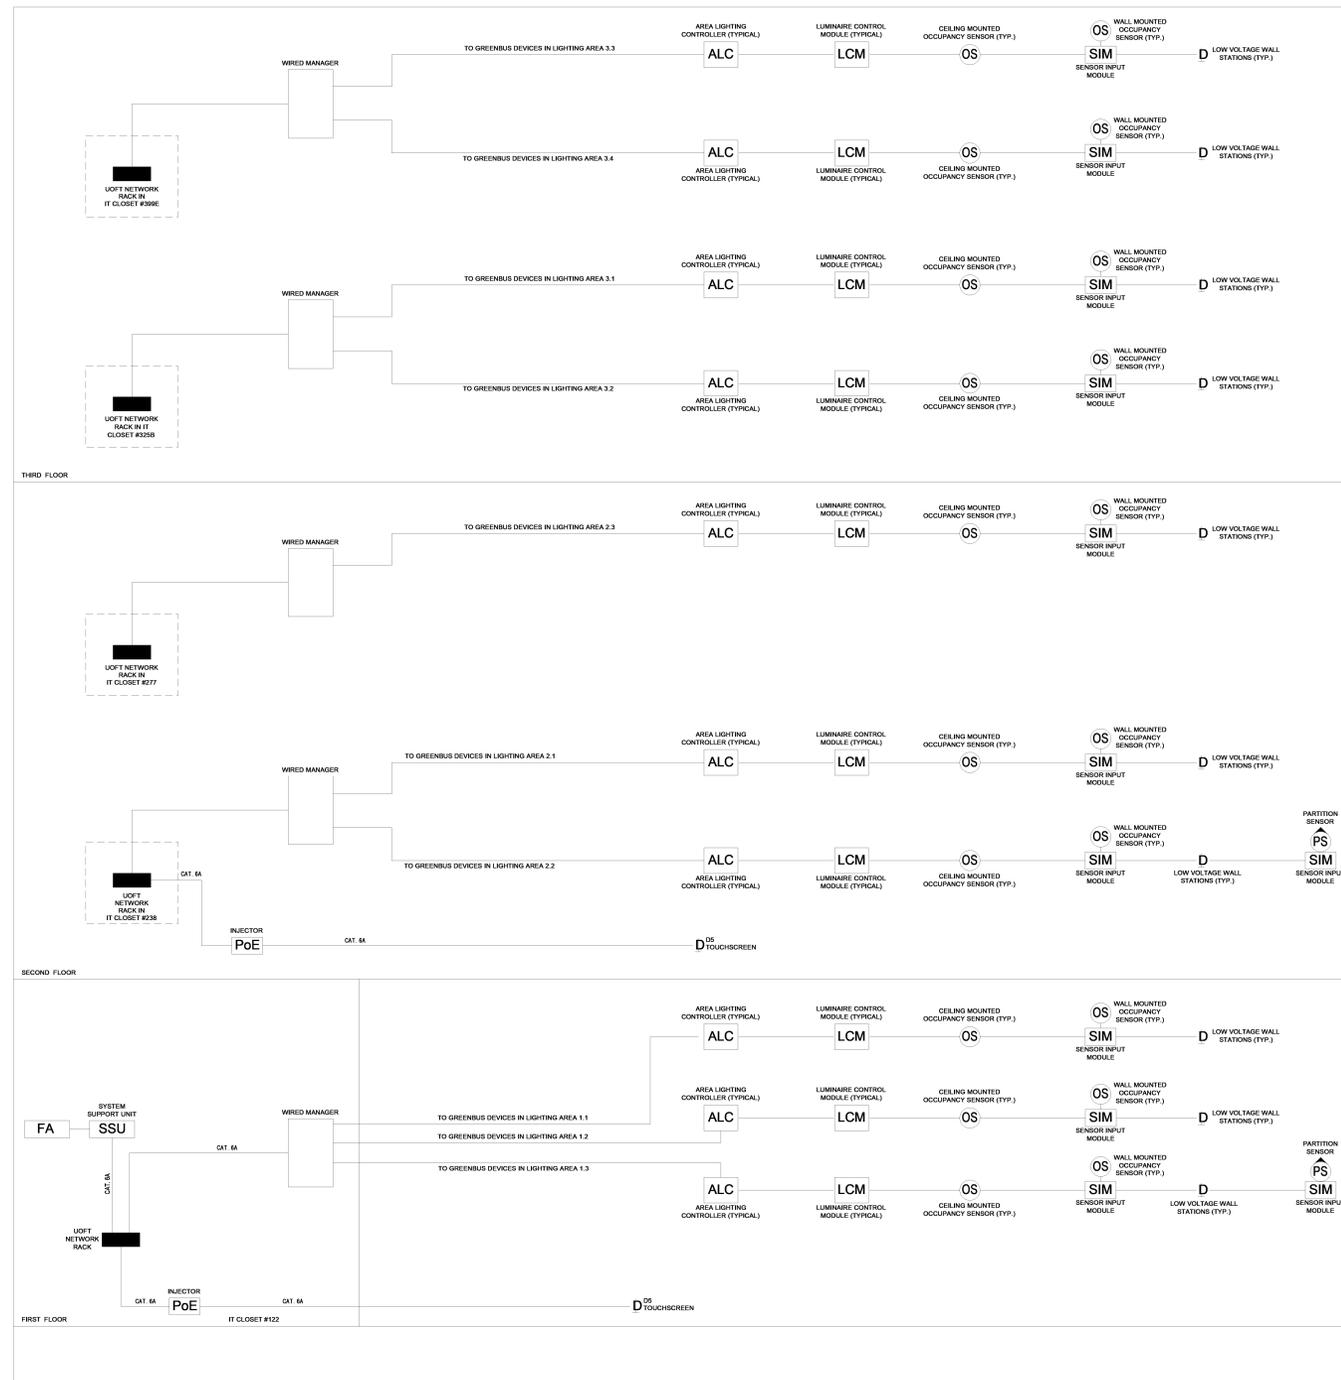

**GENERAL NOTE:**

- ENCELIUM LIGHTING CONTROL SYSTEM IS A LONG LEAD ITEM. THE EXPECTED DELIVERY TIME CAN VARY BETWEEN 3 TO 8 MONTHS. CONTRACTOR IS ADVISED TO REVIEW THE DRAWINGS AND PLACE PURCHASE ORDER AS SOON AS POSSIBLE AFTER AWARDSING THE CONTRACT IN ORDER TO AVOID ANY DELAYS TO PROJECT SCHEDULE.
- REFER TO ELECTRICAL SPECIFICATION AND ALLOW FOR ADDITIONAL VISITS OF LIGHTING CONTROLS SPECIALIST AS REQUIRED. INCLUDE ALL ASSOCIATED COST IN TENDER PRICE AS REQUIRED.

**LIGHTING CONTROL NOTES:**

- EXACT LOCATION OF DEVICES TO BE CONFIRMED ON SITE.
- PROVIDE ENGRAVING KEY FOR ALL WALL STATIONS, AS REQUIRED.
- DEVICES IN EACH ROOM SHALL OPERATE WITH OPEN TOPOLOGY AND CAN BE REARRANGED.
- PROVIDE STAINLESS STEEL COVER PLATE FOR WALL STATIONS.
- ALL CONTROL DEVICES TO BE INSTALLED WITHIN BACKBOXES AS REQUIRED.
- ALL LOW VOLTAGE AND CONTROL WIRING SHALL BE INSTALLED INSIDE IMT CONDUIT.
- CONTRACTOR MUST ADHERE TO ENCELIUM DRAWINGS. ANY MODIFICATIONS TO ENCELIUM DRAWINGS REQUIRE FACTORY APPROVAL.
- SENSORS MUST BE INSTALLED AS PER INDUSTRY STANDARD. REFER TO MANUFACTURER INSTRUCTION SHEET INCLUDED WITH SENSOR HARDWARE. ALL SENSORS MUST BE MOUNTED AT LEAST 6 FEET AWAY FROM AIR VENTS & HEAT EXCHANGERS.
- UNLESS OTHERWISE NOTED, ALL SENSORS WILL OPERATE AUTO ON, AUTO OFF WITH A TIMEOUT OF 11 MINUTES.
- UNLESS OTHERWISE NOTED, ALL ENCELIUM WIRED MANAGERS SHOULD BE CONNECTED TO NORMAL POWER.
- COORDINATE WITH ENCELIUM TECHNICIAN TO ASSIGN SWITCHES TO THE RESPECTIVE FIXTURE GROUPING, AS INDICATED ON LIGHTING ZONE LAYOUT.
- ENCELIUM WIRED MANAGER (M) SYSTEM SUPPORT UNIT (SSU) AND WIRELESS MANAGER (WM) IS TO BE CONNECTED TO F&S NETWORK. ONE IP ADDRESS PER DEVICE MUST BE PROVIDED TO ENCELIUM PRIOR TO SYSTEM START UP.
- NETWORK RISES MUST NOT EXCEED 100M (328 FT.). ANY MODIFICATIONS TO ENCELIUM DRAWINGS REQUIRE FACTORY APPROVAL.
- REFER TO THE ENCELIUM CONTRACTORS INSTALLATION GUIDE FOR SYSTEM INFORMATION, CUT SHEETS, AND WIRING DIAGRAMS.
- SYSTEM NEEDS TO BE TESTED PRIOR TO REQUESTING SYSTEM STARTUP SERVICES. PLEASE REFER TO ENCELIUM CONTRACTOR MANUAL FOR TESTING PROCEDURE USING GREENBUS II TESTER AND/or E84 INSTALLATION MODE.
- END USER NETWORK ACCESS TO THE ENCELIUM SERVER (SSU) MUST BE ARRANGED PRIOR TO SYSTEM TRAINING.
- ENCELIUM PHASED CUT DIMMING MODULE (PCDM) HAS A MAXIMUM OUTPUT RATING OF 120 VAC, 400W, 3.8A MAX.
- USE MINIMUM 3/4" CONDUIT FOR GREENBUS CABLEING.
- ALLOW FOR THE COST TO PROVIDE POE INJECTORS AS REQUIRED.
- ALLOW FOR SYSTEM INTEGRATION TO EXISTING ENCELIUM SERVER (INCLUDING BUT NOT LIMITED TO SIMANC SET UP, DATA COLLECTION, ETC).
- DIMMING WIRING SHALL BE PROVIDED IF FIXTURE COMES WITH DIMMABLE DRIVER.
- REFER TO LIGHTING CONTROL PLANS E401-A, 402-A, 403-A FOR DEVICE TYPES/KEY.
- LIGHTING CONTROL SYSTEM SHALL BE CONNECTED TO FIRE ALARM SYSTEM SUCH THAT UPON FIRE ALARM ACTIVATION, LIGHTING CONTROL SYSTEM SHALL INITIATE AN EMERGENCY SCENARIO TO BRING ALL LIGHTS TO FULL BRIGHTNESS. ONCE FIRE ALARM EVENT IS RESOLVED, LIGHTING LEVELS SHALL RETURN TO THE PREVIOUS STATE.

**PARTITION SENSORS NOTES:**

- THE PARTITION SENSOR MUST PROVIDE A HIGH SIGNAL WHEN AT CLOSED STATE AND THE ROOMS SHOULD ACTIVATE SEPARATELY.
- THE PARTITION SENSOR MUST PROVIDE A LOW SIGNAL WHEN AT OPEN STATE AND THE ROOMS SHOULD ACTIVATE COMBINED.



SEAL:



PROJECT:  
**HEALTH AND WELLNESS CENTRE RENOVATION AT KOFFLER**

214 COLLEGE ST.  
TORONTO, ON M5T 3A1

SHEET CONTENTS:  
**RISER DIAGRAM**

PROJECT NUMBER:  
**21590.003**

DRAWING SCALE:  
**1 : 100**

DRAWN BY:	CHECKED BY:	DATE:
Author	Checker	Issue Date

SHEET NO: **E024** REV: **11**





AREA	ROOM #	OCCUPANCY SENSOR (INSTALLING)	ON/OFF	LOCAL CONTROL (SWITCH, WALL STATION, DIMMER)	NOTES
RESTROOMS/STORAGE		WALL	AUTO ON/AUTO OFF		
RESTROOMS		CEILING	AUTO ON/AUTO OFF		LIGHTING ON EM CCT
ELECTRICAL CLOSET/ROOMS				TOGGLE SWITCH	LIGHTING ON EM CCT
IT CLOSET				TOGGLE SWITCH	LIGHTING ON EM CCT
LOUNGE	237	CEILING	AUTO ON/AUTO OFF	3 SCENE WALL STATION	DM TO SOL DURING 12H HOURS BASED ON OCCUPANCY. TURN OFF DURING 'OFF' HOURS
CONSULTING/EXAM ROOMS		CEILING	MANUAL ON, AUTO OFF	DIMMER (L1, D1) DIMMER (L2, D1) SWITCH (L1, D1)	OCCUPANCY SENSOR TO CONTROL ALL LIGHTS IN ROOM. NOT ALL ROOMS HAVE ALL LIGHTING TYPES.
ELEVATOR ACCESS	1	CEILING	AUTO ON/AUTO OFF		DM TO SOL BASED ON OCCUPANCY
MULTIPURPOSE ROOM (BY WINDOW)	231	CEILING	MANUAL ON, AUTO OFF	TOUCH SCREEN	WHEN ROOM SENSOR IS IN LOW STATE, TOUCH SCREENS WILL DISPLAY SAFE OPTIONS. WINDOW ZONES WILL OPERATE TOGETHER. INTERIOR ZONES WILL OPERATE TOGETHER. OCCUPANCY SENSORS WILL CONTROL BOTH ZONES.
MULTIPURPOSE ROOM (BY WINDOW)	233	CEILING	MANUAL ON, AUTO OFF	TOUCH SCREEN	
MULTIPURPOSE ROOM (BY WINDOW)	235	CEILING	MANUAL ON, AUTO OFF	TOUCH SCREEN	
MULTIPURPOSE ROOMS	235	CEILING	MANUAL ON, AUTO OFF	TOUCH SCREEN	
LOBBY	240K	CEILING	AUTO ON/AUTO OFF		DM TO SOL DURING 12H HOURS BASED ON OCCUPANCY. TURN OFF DURING 'OFF' HOURS
MEETING ROOM (BY WINDOW)	253	CEILING	MANUAL ON, AUTO OFF	3 SCENE WALL STATION	DAYLIGHT HARVESTING ZONE
WAITING AREA	240			DIMMER	
PUBLIC CORRIDOR (SOUTH)	254K	CEILING	AUTO ON/AUTO OFF		
PUBLIC CORRIDOR (NORTH)	254K	CEILING	AUTO ON/AUTO OFF		


STAFF CORRIDOR	277K		AUTO ON/AUTO OFF		DIMMER
STAFF LOUNGE/ANTHENTHETTE	280	CEILING			
STAFF LOUNGE/ANTHENTHETTE	280	WALL	MANUAL ON/AUTO OFF	WALL SWITCH	UNDER CABINET LIGHT
RECEPTION	242	CEILING	MANUAL ON, AUTO OFF	3 SCENE WALL STATION	

NOTE:  
 1. UNLESS NOTED OTHERWISE, ALL SENSORS TO BE SET TO 20 MINUTE OFF DELAY.  
 2. MULTIPLE SENSORS CONTROLS BY CEILING SENSORS SHALL BE ON/OFF TOGETHER WITH LOCAL CONTROL (AS SHOWN).  
 3. PROVIDE SHUNT TRIP RELAY AS REQUIRED FOR ROOMS WITH TOGGLE SWITCH CONTROLS AND EM LIGHTING CIRCUIT.

DEFAULT SCENE WALL STATION LEVELS

SCENE	LEVEL
1	100
2	75
3	50
4	25
5	0

LEVELS TO BE CONFIRMED WITH ELECTRICAL SYSTEM COMMENSURATE WITH THE PROJECT.

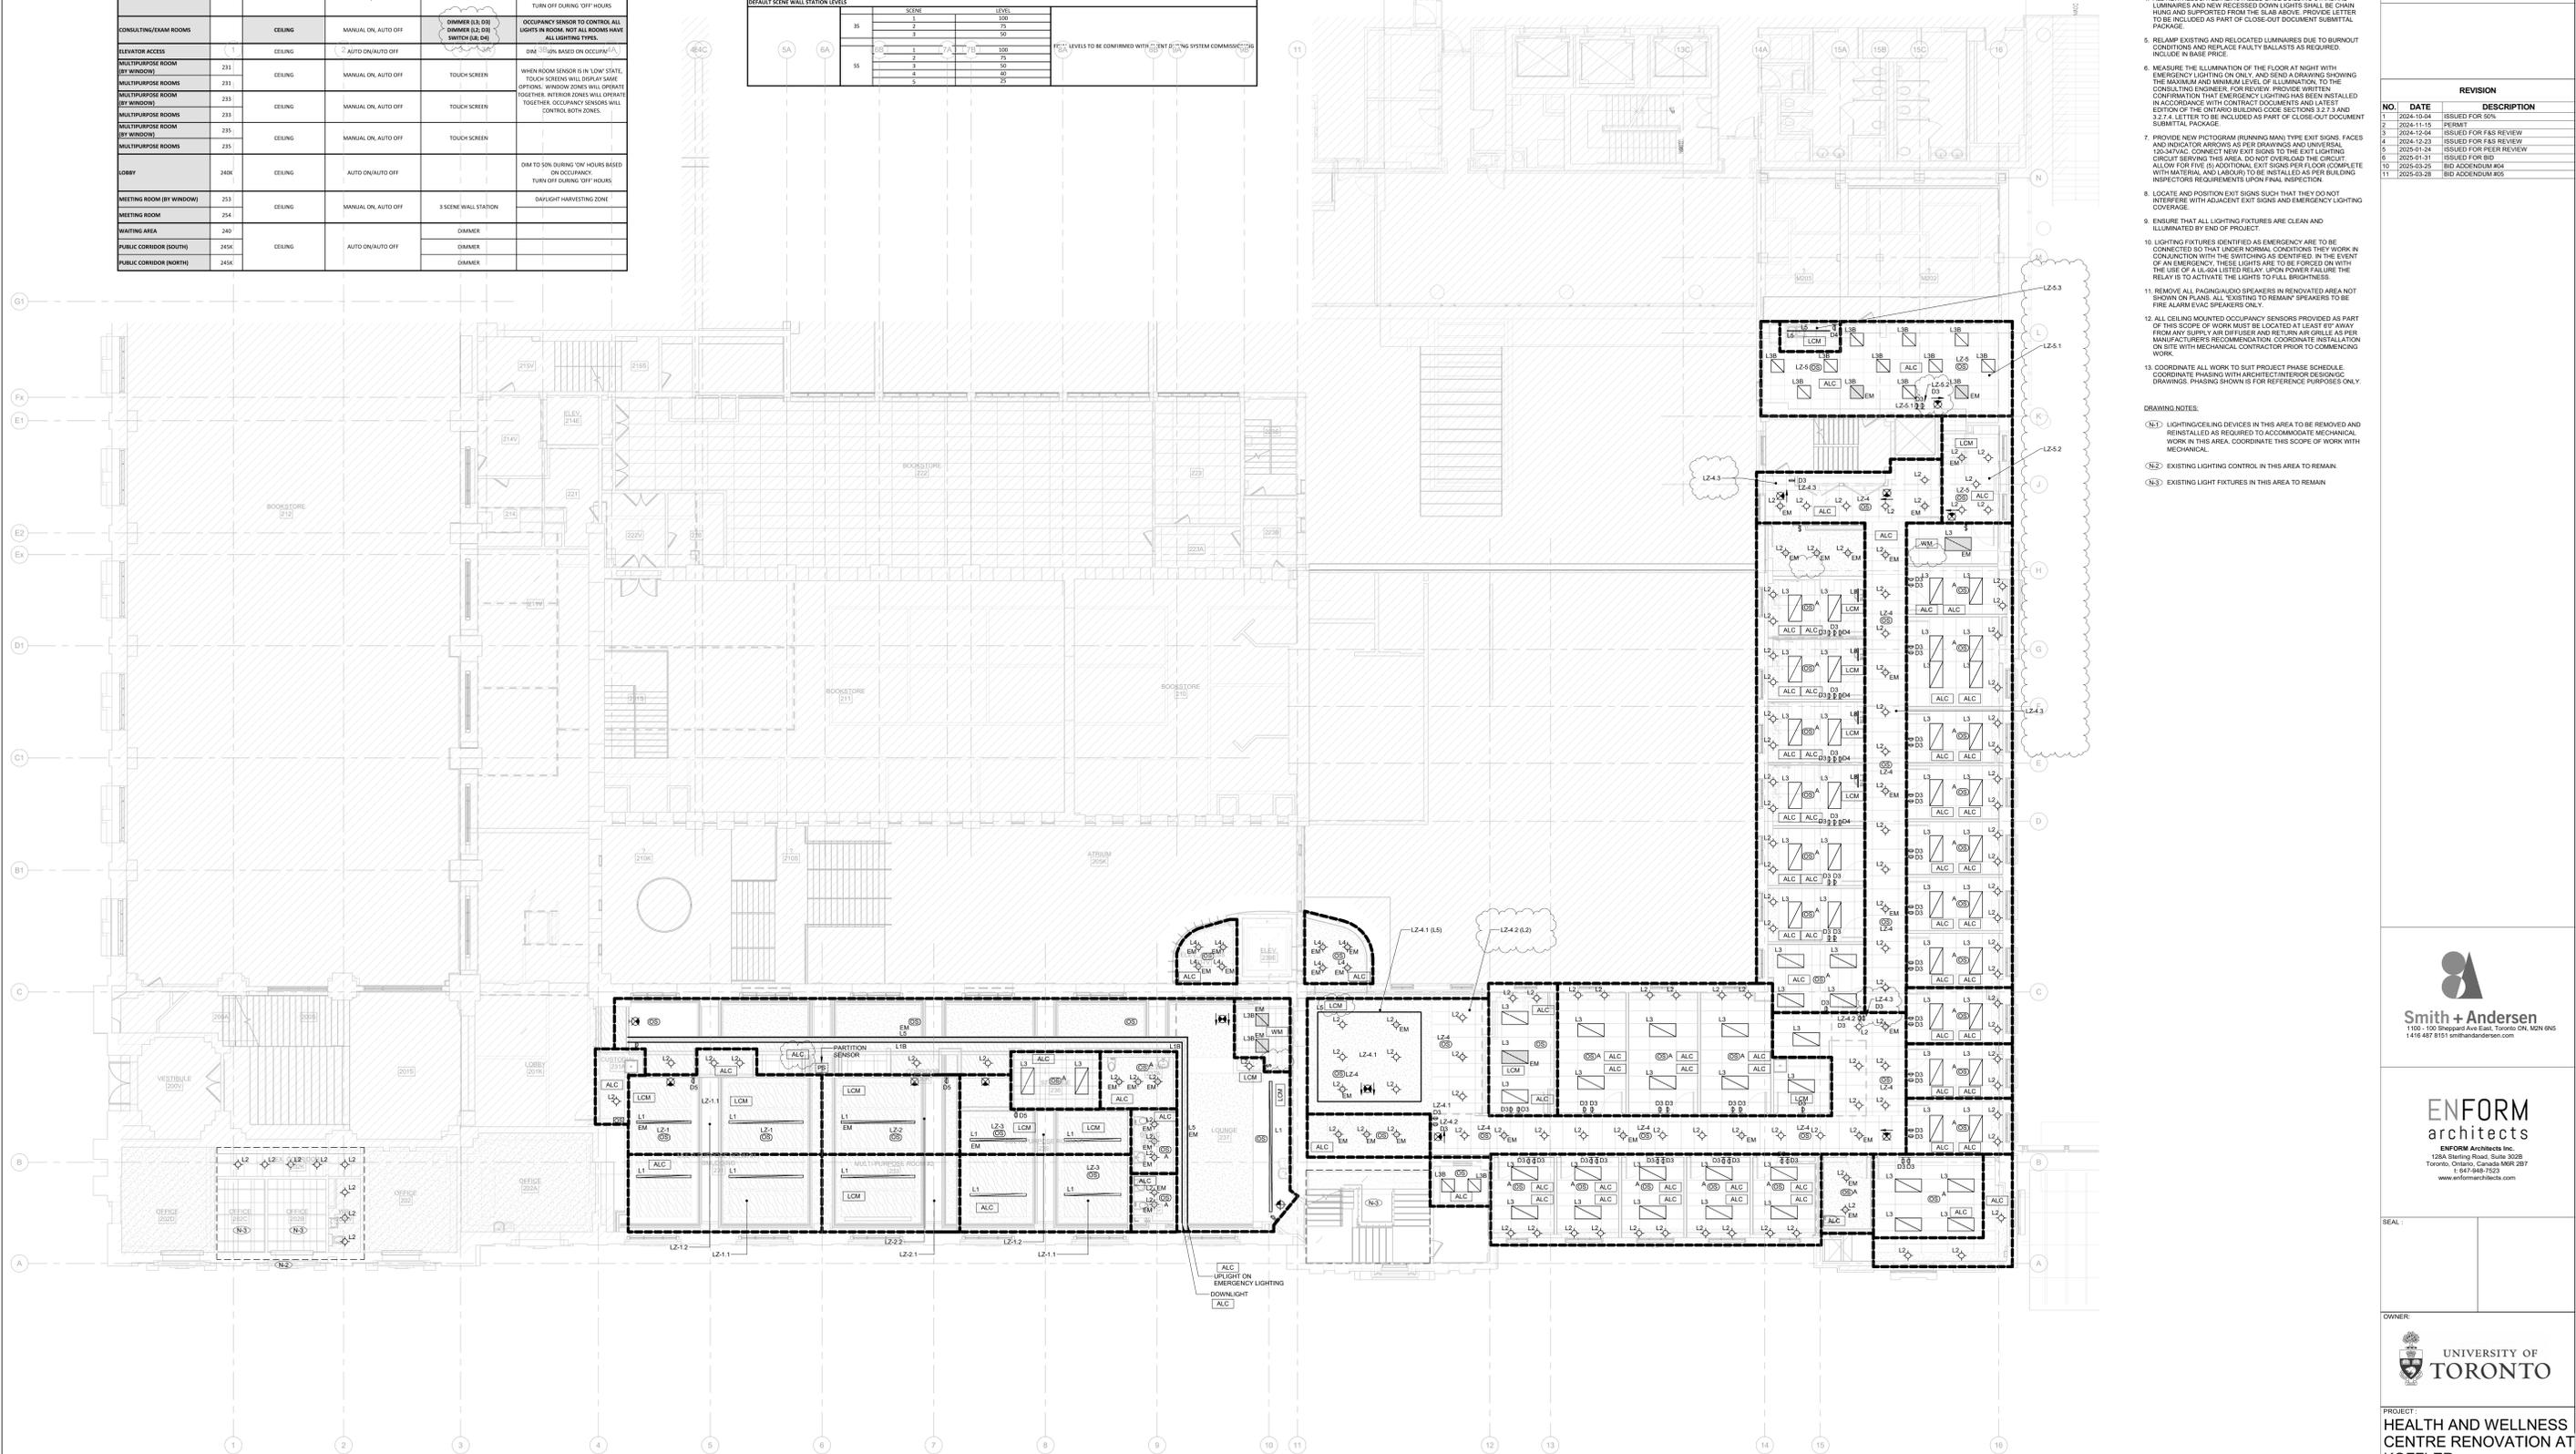

- GENERAL NOTES:
- THESE DRAWINGS SHALL BE READ IN CONJUNCTION WITH INTERIOR DESIGNER/ARCHITECT'S DRAWINGS FOR DIMENSIONS, HEIGHTS, CONSTRUCTION DETAILING, FINISHES AND COLOURS.
  - CIRCUITING IN PART IS DIAGRAMMATIC INTENDED TO SHOW GENERAL CIRCUIT ARRANGEMENT AND PANEL DESIGNATION.
  - PROVIDE EMT CONDUIT IN AREAS WITH EXPOSED CEILING. BX CABLE IS NOT ACCESSIBLE UNLESS OTHERWISE NOTED. BX CABLES MAY BE USED FOR FINAL CONNECTIONS TO LIGHTING FIXTURES OR EQUIPMENT WITH A MAXIMUM HORIZONTAL RUN LENGTH OF 3 FEET. 1 METER PAINT CONDUITS TO MATCH ARCHITECTURAL FINISHES. MOUNT EXIT SIGNS, OCCUPANCY SENSORS, EXIT SIGNS, CAMERAS, WAPS AND ALL OTHER CEILING MOUNTED DEVICES WITH A MAXIMUM HORIZONTAL RUN LENGTH OF 3 FEET. 1 METER PAINT CONDUITS TO MATCH ARCHITECTURAL FINISHES. COORDINATE SAME PLANE AS SUSPENDED LIGHTING FIXTURES. COORDINATE CEILING AND WALL DEVICES WITH INTERIOR DESIGNER DRAWINGS.
  - ALL NEW/RELOCATED/REINSTALLED BASE BUILDING STANDARD LUMINAIRES AND NEW RECESSED DOWN LIGHTS SHALL BE CHAIN HUNG AND SUPPORTED FROM THE SLAB ABOVE. PROVIDE LETTER TO BE INCLUDED AS PART OF CLOSE-OUT DOCUMENT SUBMITTAL PACKAGE.
  - RELAP EXISTING AND RELOCATED LUMINAIRES DUE TO BURNOUT CONDITIONS AND REPLACE FAULTY BALLASTS AS REQUIRED. INCLUDE IN BASE PRICE.
  - MEASURE THE ILLUMINATION OF THE FLOOR AT NIGHT WITH EMERGENCY LIGHTING ON ONLY. AND SEND A DRAWING SHOWING THE MAXIMUM AND MINIMUM LEVEL OF ILLUMINATION. TO THE CONSULTING ENGINEER FOR REVIEW. PROVIDE WRITTEN CONFIRMATION THAT EMERGENCY LIGHTING HAS BEEN INSTALLED IN ACCORDANCE WITH CONTRACT DOCUMENTS AND LATEST EDITION OF THE ONTARIO BUILDING CODE SECTIONS 3.2.7.3 AND 3.2.7.4. LETTER TO BE INCLUDED AS PART OF CLOSE-OUT DOCUMENT SUBMITTAL PACKAGE.
  - PROVIDE NEW PICTOGRAM (RUNNING MAN) TYPE EXIT SIGNS, FACES AND INDICATOR ARROWS AS PER DRAWINGS AND UNIVERSAL 120-VA/AC. CONNECT NEW EXIT SIGNS TO THE EXIT LIGHTING CIRCUIT SERVING THIS AREA. DON'T OVERLOAD THE CIRCUIT. ALLOW FOR FIVE (5) ADDITIONAL EXIT SIGNS PER FLOOR (CONCRETE WITH MATERIAL AND LABOUR) TO BE INSTALLED AS PER BUILDING INSPECTORS REQUIREMENTS UPON FINAL INSPECTION.
  - LOCATE AND POSITION EXIT SIGNS SUCH THAT THEY DO NOT INTERFERE WITH ADJACENT EXIT SIGNS AND EMERGENCY LIGHTING COVERAGE.
  - ENSURE THAT ALL LIGHTING FIXTURES ARE CLEAN AND ILLUMINATED BY END OF PROJECT.
  - LIGHTING FIXTURES IDENTIFIED AS EMERGENCY ARE TO BE CONNECTED SO THAT UNDER NORMAL CONDITIONS THEY WORK IN CONJUNCTION WITH THE SWITCHING AS IDENTIFIED. IN THE EVENT OF AN EMERGENCY, THESE LIGHTS ARE TO BE FORCED ON WITH THE USE OF A UL-924 LISTED RELAY. UPON POWER FAILURE THE RELAY IS TO ACTIVATE THE LIGHTS TO FULL BRIGHTNESS.
  - REMOVE ALL PAGING/AUDIO SPEAKERS IN RENOVATED AREA NOT SHOWN ON PLANS. ALL 'EXISTING TO REMAIN' SPEAKERS TO BE FIRE ALARM EVAC SPEAKERS ONLY.
  - ALL CEILING MOUNTED OCCUPANCY SENSORS PROVIDED AS PART OF THIS SCOPE OF WORK MUST BE LOCATED AT LEAST 10" AWAY FROM ANY SUPPLY AIR DIFFUSERS AND RETURN AIR GRILLES AS PER MANUFACTURER'S RECOMMENDATION. COORDINATE INSTALLATION ON SITE WITH MECHANICAL CONTRACTOR PRIOR TO COMMENCING WORK.
  - COORDINATE ALL WORK TO SUIT PROJECT PHASE SCHEDULE. COORDINATE PHASING WITH ARCHITECT/INTERIOR DESIGNER DRAWINGS. PHASING SHOWN IS FOR REFERENCE PURPOSES ONLY.
- DRAWING NOTES:
- (L1) LIGHTING FIXTURES TO BE REMOVED AND REINSTALLED AS REQUIRED TO ACCOMMODATE MECHANICAL WORK IN THIS AREA. COORDINATE THE SCOPE OF WORK WITH MECHANICAL.
  - (L2) EXISTING LIGHTING CONTROL IN THIS AREA TO REMAIN.
  - (L3) EXISTING LIGHT FIXTURES IN THIS AREA TO REMAIN.

REVISION		
NO.	DATE	DESCRIPTION
1	2024-05-04	ISSUED FOR 50%
2	2024-11-15	PERMIT
3	2024-12-04	ISSUED FOR I&S REVIEW
4	2024-12-23	ISSUED FOR I&S REVIEW
5	2025-01-24	ISSUED FOR I&S REVIEW
6	2025-01-31	ISSUED FOR BID
7	2025-03-25	BID ADDENDUM #04
11	2025-03-28	BID ADDENDUM #05

**Smith + Andersen**  
 1100 - 100 Sheppard Ave East, Toronto ON, M2N 6N9  
 416-467-8105 smith+andersen.com

**ENFORM architects**  
 ENFORM Architects Inc.  
 1204 Bloor Street West, Suite 302B  
 Toronto, Ontario, Canada M5R 2B7  
 416-598-7523  
 www.enformarchitects.com

OWNER:  
 UNIVERSITY OF TORONTO

PROJECT:  
 HEALTH AND WELLNESS CENTRE RENOVATION AT KOFFLER

214 COLLEGE ST.  
 TORONTO, ON M5T 3A1


SHEET CONTENTS:  
**LEVEL 02 - LIGHTING CONTROL PLAN**

PROJECT NUMBER:  
**21590.003**

DRAWING SCALE:  
**1 : 100**

DRAWN BY: \_\_\_\_\_ CHECKED BY: \_\_\_\_\_ DATE: \_\_\_\_\_  
 AUTHOR: \_\_\_\_\_ CHECKER: \_\_\_\_\_ ISSUE DATE: \_\_\_\_\_

SHEET NO. **E402-A** REV. **11**

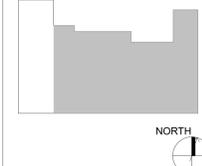

AREA	ROOM #	OCCUPANCY SENSOR	ON/OFF	LOCAL CONTROL	NOTES
CUSTOMER ROOMS/STORAGE		WALL	AUTO ON/AUTO OFF	[SWITCH WALL STATION, DIMMER]	
WASHROOMS		CEILING	AUTO ON/AUTO OFF		LIGHTING ON EM CCT
BE WASHROOM & SHOWER	395A			TOGGLE SWITCH	LIGHTING ON EM CCT
ELECTRICAL CLOSET/ROOMS				TOGGLE SWITCH	LIGHTING ON EM CCT
IT CLOSET				TOGGLE SWITCH	LIGHTING ON EM CCT
LOBBY	360V	CEILING	AUTO ON/AUTO OFF		DM TO SON BASED ON OCCUPANCY
CONSULTING/EXAM ROOMS		CEILING	MANUAL ON/AUTO OFF	DIMMER (L3, D3) DIMMER (L3, D3) SWITCH (L3, D4)	OCCUPANCY SENSOR TO CONTROL ALL LIGHTS IN ROOM. NOT ALL ROOMS HAVE ALL LIGHTING TYPES.
ELEVATOR ACCESS		CEILING	AUTO ON/AUTO OFF		DM TO SON BASED ON OCCUPANCY
ELEVATOR VESTIBULE	325V	CEILING	[SWITCH ON/AUTO OFF]	[3] [3A]	DM TO SON BASED ON OCCUPANCY
STAFF CORRIDOR	320K			DIMMER	
LOUNGE	307	CEILING	AUTO ON/AUTO OFF	DIMMER	DM TO SON BASED ON OCCUPANCY
PUBLIC CORRIDOR	355K			DIMMER	
CORRIDOR	348K			DIMMER	
CORRIDOR	344, 352	CEILING	AUTO ON/AUTO OFF		DM TO SON BASED ON OCCUPANCY
SUB-WAITING AREA	362			DIMMER	
WAITING AREA	373N	CEILING	AUTO ON/AUTO OFF	DIMMER	DM TO SON BASED ON OCCUPANCY
WAITING AREA	360			DIMMER	
CORRIDOR	370K	CEILING	AUTO ON/AUTO OFF	DIMMER	DM TO SON BASED ON OCCUPANCY
VACCINE SEATING AREA	377			DIMMER	
CORRIDOR	397K			DIMMER	
MEETING/LUNCH	398	WALL	MANUAL ON/AUTO OFF	PANELS	AUTOMATIC TO SON

LOCKERS	399	[FIXTURES TO BE ON/OFF TOGETHER]	MANUAL ON/AUTO OFF	WALL SWITCH	UNDER CABINET LIGHT
MEETING/LUNCH (A FIXTURE)	398				


SCENE	LEVEL
1	100
2	75
3	50
4	25
5	0

FINAL LEVELS TO BE CONFIRMED WITH CLIENT DURING SYSTEM COMMISSIONING

- GENERAL NOTES:**
- THESE DRAWINGS SHALL BE READ IN CONJUNCTION WITH INTERIOR DESIGNER/ARCHITECT'S DRAWINGS FOR DIMENSIONS, HEIGHTS, CONSTRUCTION DETAILING, FINISHES AND COLOURS.
  - CIRCUITING IN PART IS DIAGRAMMATIC INTENDED TO SHOW GENERAL CIRCUIT ARRANGEMENT AND PANEL DESIGNATION.
  - PROVIDE EMT CONDUIT IN AREAS WITH EXPOSED CEILING. BX CABLEING IS NOT ACCEPTABLE UNLESS OTHERWISE NOTED. BX CABLES MAY BE USED FOR FINAL CONNECTIONS TO LIGHTING FIXTURES OR EQUIPMENT WITH A MAXIMUM HORIZONTAL RUN LENGTH OF 3 FEET / 1 METER. PAINT CONDUITS TO MATCH ARCHITECTURAL FINISHES. PROVIDE EMT SCHEDULE 40 OCCUPANCY SENSORS, EXIT SIGNS, CAMERA, WAPS AND ALL OTHER CEILING MOUNTED DEVICES WITHIN 100MM OF CEILING. PROVIDE LETTERS TO BE INCLUDED AS PART OF CLOSE-OUT DOCUMENT SUBMITTAL PACKAGE.
  - ALL NEW/RELOCATED/REINSTALLED BASE BUILDING STANDARD LUMINAIRES AND NEW RECESSED DOWN LIGHTS SHALL BE CHAIN HUNG AND SUPPORTED FROM THE SLAB ABOVE. PROVIDE LETTERS TO BE INCLUDED AS PART OF CLOSE-OUT DOCUMENT SUBMITTAL PACKAGE.
  - RELAMP EXISTING AND RELOCATED LUMINAIRES DUE TO BURNOUT CONDITIONS AND REPLACE FAULTY BALLASTS AS REQUIRED. INCLUDE IN BASE PRICE.
  - MEASURE THE ILLUMINATION OF THE FLOOR AT NIGHT WITH EMERGENCY LIGHTING ON ONLY. AND SEND A DRAWING SHOWING THE MAXIMUM AND MINIMUM LEVEL OF ILLUMINATION. TO THE CONSULTING ENGINEER FOR REVIEW. PROVIDE WRITTEN CONFIRMATION THAT EMERGENCY LIGHTING HAS BEEN INSTALLED IN ACCORDANCE WITH CONTRACT DOCUMENTS AND LATEST EDITION OF THE ONTARIO BUILDING CODE SECTIONS 3.2.7.3 AND 3.2.7.4. LETTERS TO BE INCLUDED AS PART OF CLOSE-OUT DOCUMENT SUBMITTAL PACKAGE.
  - PROVIDE NEW PICTOGRAM (RUNNING MAN) TYPE EXIT SIGNS, FACES AND INDICATOR ARROWS AS PER DRAWINGS AND UNIVERSAL 120-347/AC. CONNECT NEW EXIT SIGNS TO THE EXIT LIGHTING CIRCUIT SERVING THIS AREA. DO NOT OVERLOAD THE CIRCUIT. ALLOW FOR FIVE (5) ADDITIONAL EXIT SIGNS PER FLOOR (COMPREHENSIVE WITH MATERIAL) AND INDICATORS TO BE INSTALLED AS PER BUILDING INSPECTORS REQUIREMENTS UPON FINAL INSPECTION.
  - LOCATE AND POSITION EXIT SIGNS SUCH THAT THEY DO NOT INTERFERE WITH ADJACENT EXIT SIGNS AND EMERGENCY LIGHTING COVERAGE.
  - ENSURE THAT ALL LIGHTING FIXTURES ARE CLEAN AND ILLUMINATED BY END OF PROJECT.
  - LIGHTING FIXTURES IDENTIFIED AS EMERGENCY ARE TO BE CONNECTED SO THAT UNDER NORMAL CONDITIONS THEY WORK IN CONJUNCTION WITH THE SWITCHING AS IDENTIFIED. IN THE EVENT OF AN EMERGENCY, THESE LIGHTS ARE TO BE FORCED ON WITH THE USE OF A UL-924 LISTED RELAY. UPON POWER FAILURE THE RELAY IS TO ACTIVATE THE LIGHTS TO FULL BRIGHTNESS.
  - REMOVE ALL PAGING/AUDIO SPEAKERS IN RENOVATED AREA NOT SHOWN ON PLANS. ALL "EXISTING TO REMAIN" SPEAKERS TO BE FIRE ALARM EVAC SPEAKERS ONLY.
  - ALL CEILING MOUNTED OCCUPANCY SENSORS PROVIDED AS PART OF THIS SCOPE OF WORK MUST BE LOCATED AT LEAST 10" AWAY FROM ANY SUPPLY AIR DIFFUSER AND RETURN AIR GRILLE AS PER MANUFACTURER'S RECOMMENDATION. COORDINATE INSTALLATION ON SITE WITH MECHANICAL CONTRACTOR PRIOR TO COMMENCING WORK.
  - COORDINATE ALL WORK TO SUIT PROJECT PHASE SCHEDULE. COORDINATE PHASING WITH ARCHITECT/INTERIOR DESIGNER DRAWINGS. PHASING SHOWN IS FOR REFERENCE PURPOSES ONLY.

**DRAWING NOTES:**

[Hatched Area] WALLS SHOWN IN THIS HATCHED AREA ARE FOR REFERENCE ONLY. SPACE WILL BE IN SHELL CONDITION.

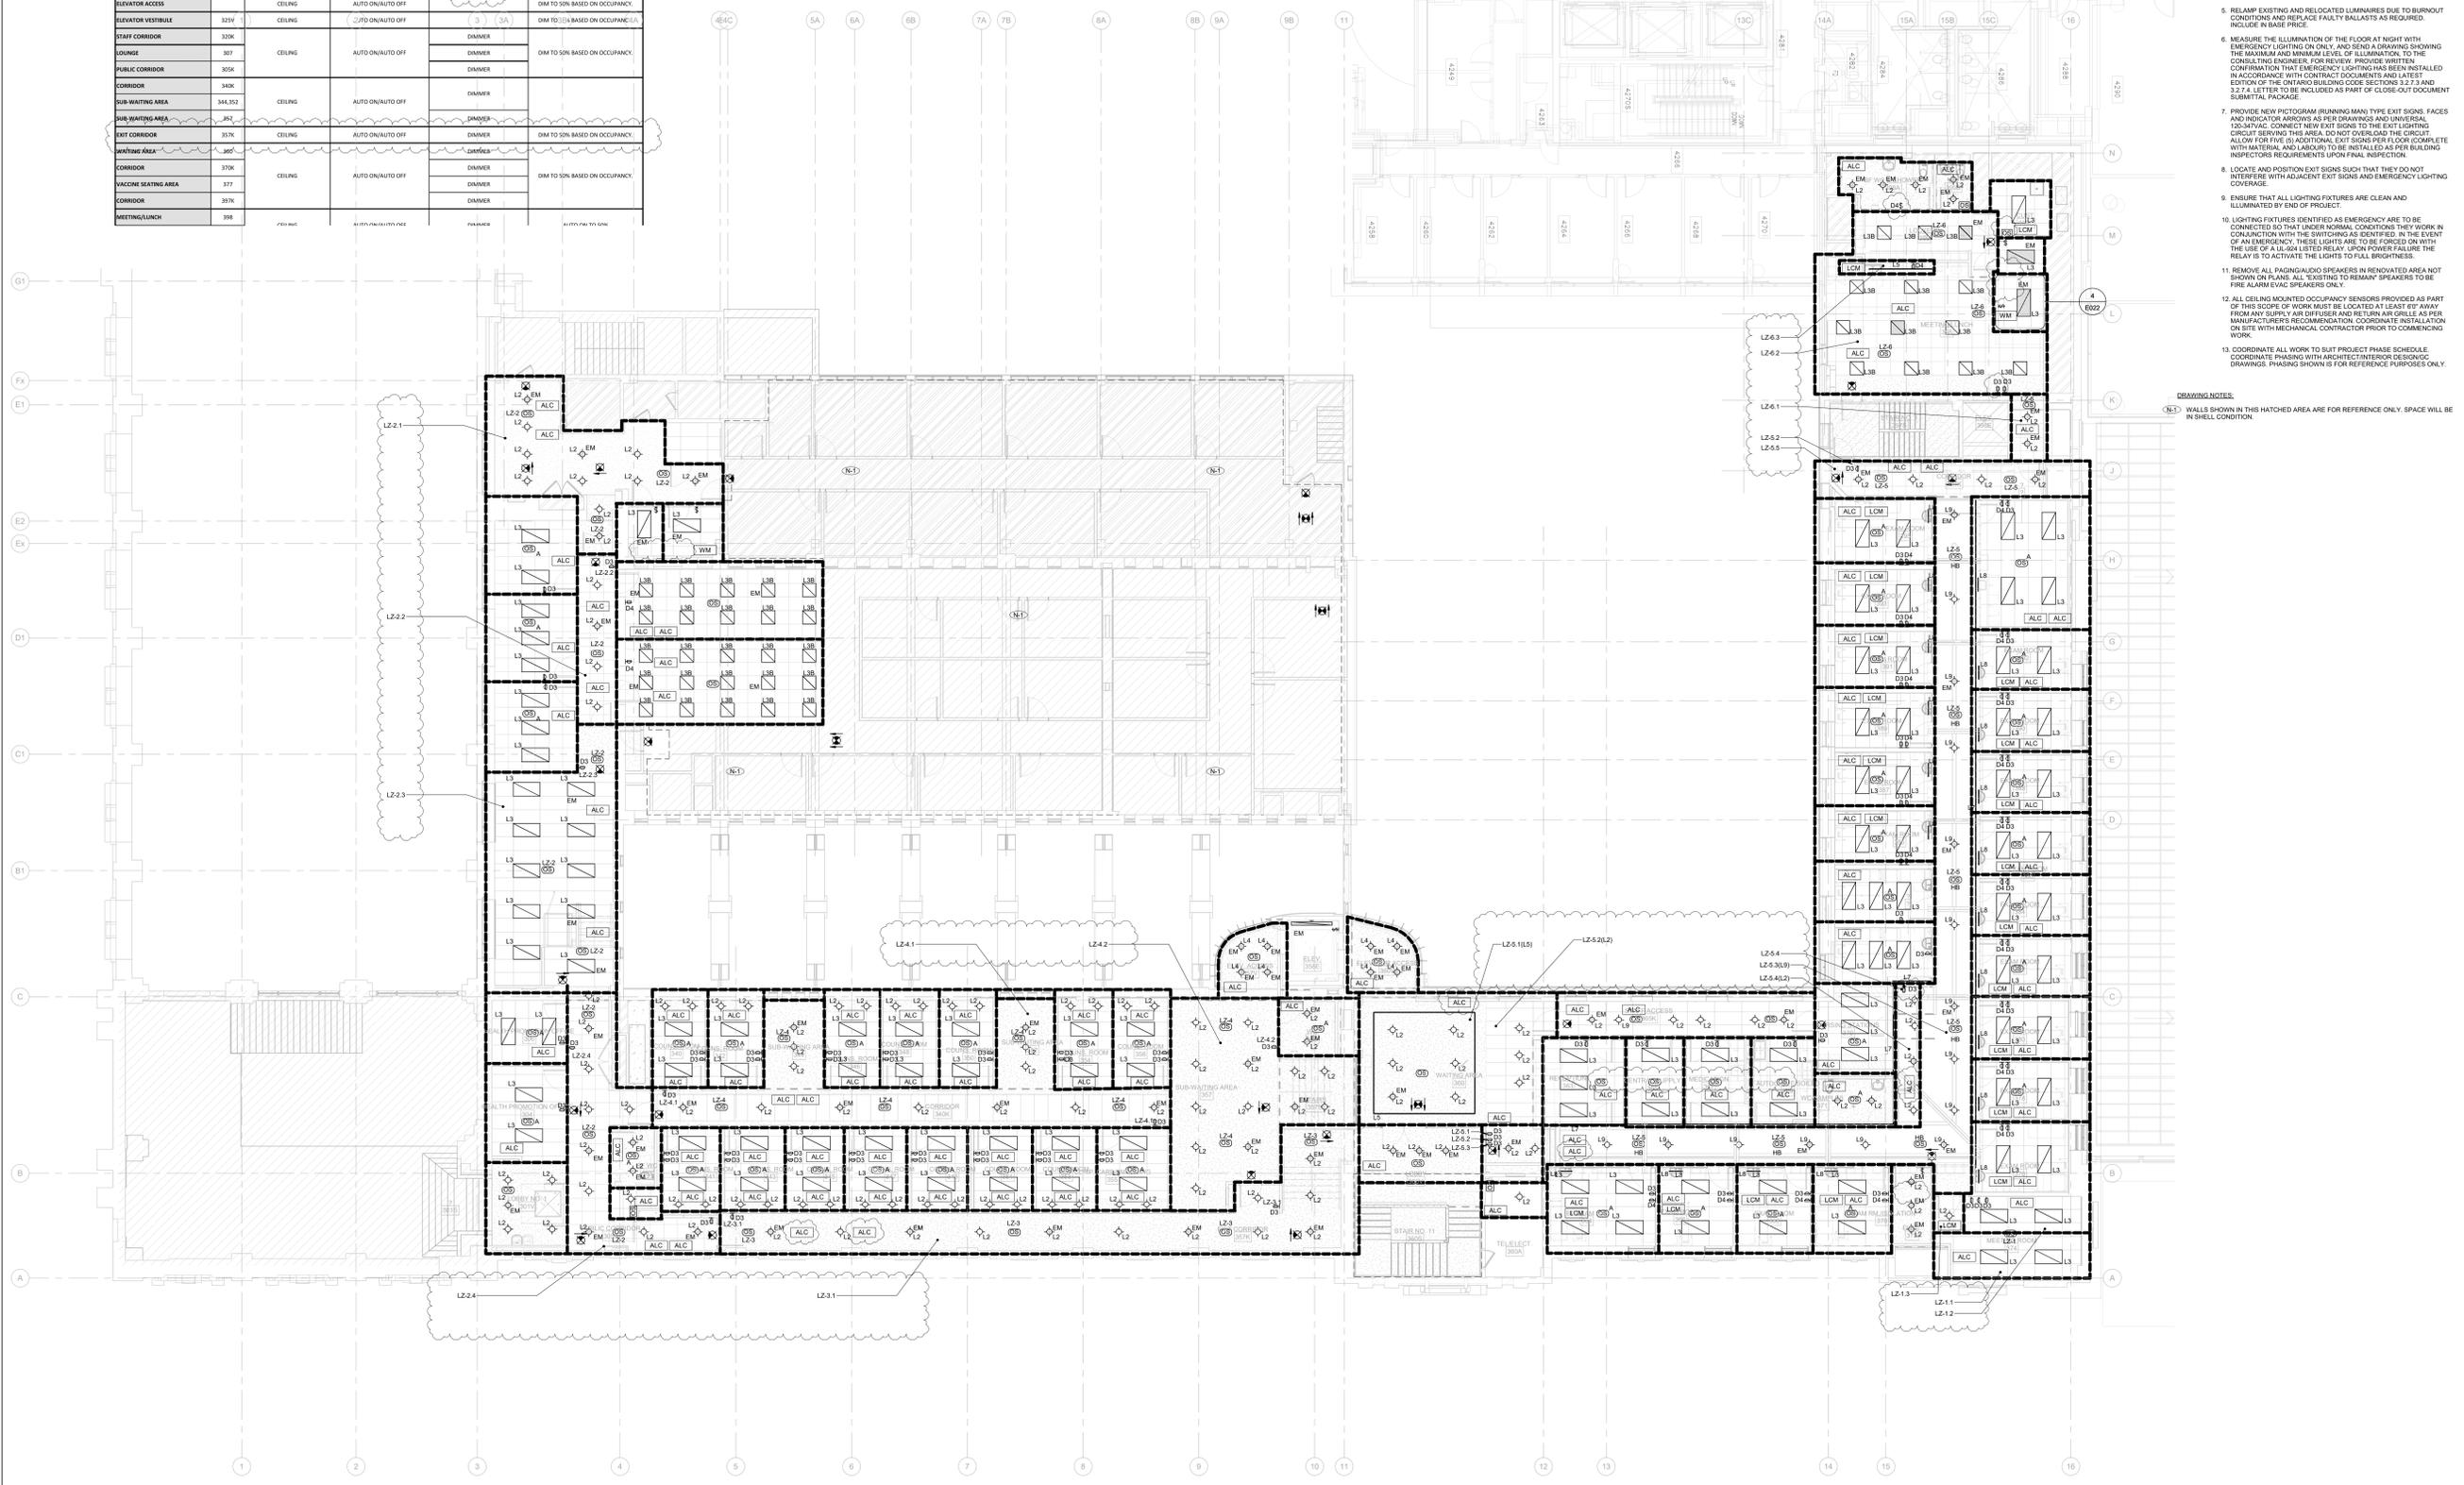

**REVISION**

NO.	DATE	DESCRIPTION
1	2024-05-04	ISSUED FOR SOI
2	2024-11-15	PERMIT
3	2024-12-04	ISSUED FOR I&S REVIEW
4	2024-12-23	ISSUED FOR I&S REVIEW
5	2025-01-24	ISSUED FOR PERM REVIEW
6	2025-01-31	ISSUED FOR BID
7	2025-03-21	BID ADDENDUM #03
8	2025-03-25	BID ADDENDUM #04
9	2025-03-28	BID ADDENDUM #05



SEAL:



PROJECT: HEALTH AND WELLNESS CENTRE RENOVATION AT KOFFLER

214 COLLEGE ST. TORONTO, ON M5T 3A1

SHEET CONTENTS: LEVEL 03 - LIGHTING CONTROL PLAN

PROJECT NUMBER: 21590.003  
DRAWING SCALE: 1 : 100

DRAWN BY: [Blank] CHECKED BY: [Blank] DATE: [Blank]  
AUTHOR: [Blank] CHECKER: [Blank] ISSUE DATE: [Blank]

SHEET NO: E403-A REV: 11

## ADDENDUM

---

PROJECT NAME: Health And Wellness Centre Renovation at Koffler

---

COMPANY: Enform

---

ATTENTION: Alan Fraser

---

PROJECT NO.: 21590.003.D.001

DATE: 2025-03-28

---

ADDENDUM NO.: ADD-D-05

ISSUED BY: Joshua Blizzard

---

The following amendments are hereby made as part of the Contract Documents. The following revisions and/or additions shall be made to contract documents and the cost shall be included in the Tender Price.

---

### 1.0 DRAWINGS

#### 1.1 Refer to Drawing TC-0.2 – Communications Telecom Rooms Details (**included herein**)

1.1.1 Replace entire drawing with one attached.

1.1.2 Revise cabling requirements on backboard, clarify PDU connections.

#### 1.2 Refer to Drawing TC-0.3 – Communications Riser Diagram (**included herein**)

1.2.1 Replace entire drawing with one attached.

1.2.2 Clarify where F&S cables terminate on L1 Mezzanine.

#### 1.3 Refer to Drawing TC-B1.1 – Basement Level Communications Layout (**included herein**)

1.3.1 Attached for reference only.
















#### 1.4 Refer to Drawing TC-1.2 – 1<sup>st</sup> Floor Wireless Access Point Plan (**included herein**)

1.4.1 Attached for reference only.

#### 1.5 Refer to Drawing TC-2.2 – 2<sup>nd</sup> Floor Wireless Access Points Plan (**included herein**)

1.5.1 Attached for reference only.

END OF TELECOMMUNICATIONS ADDENDUM

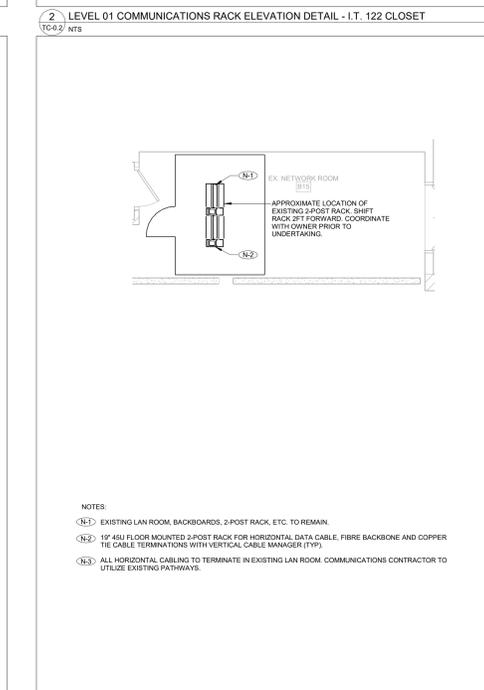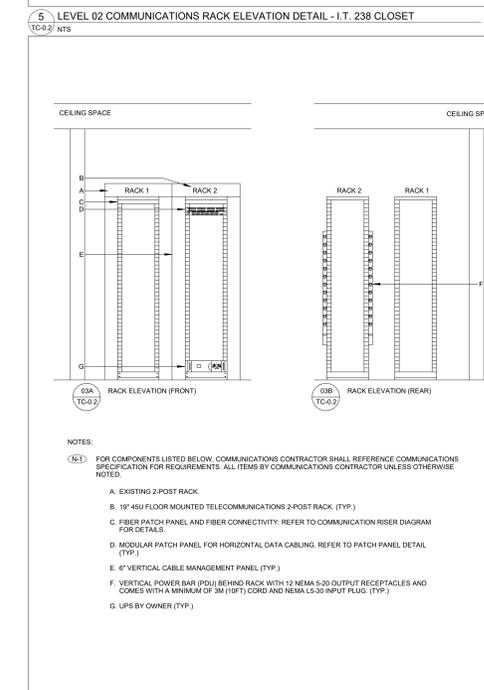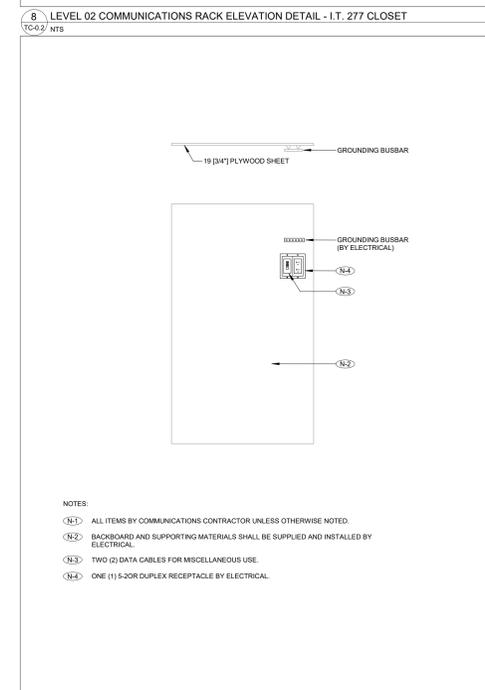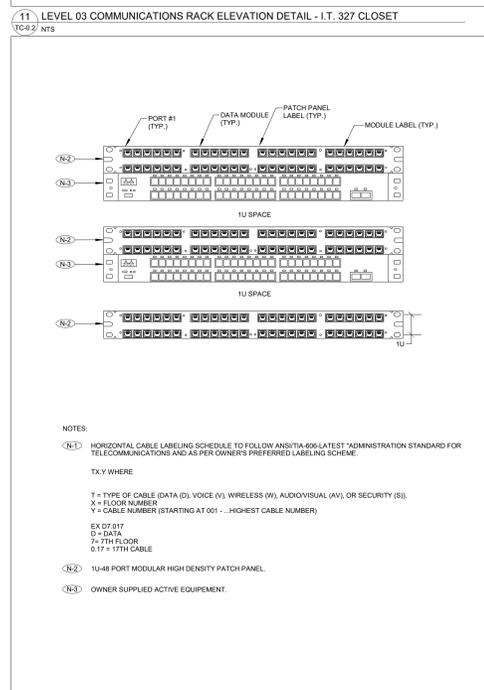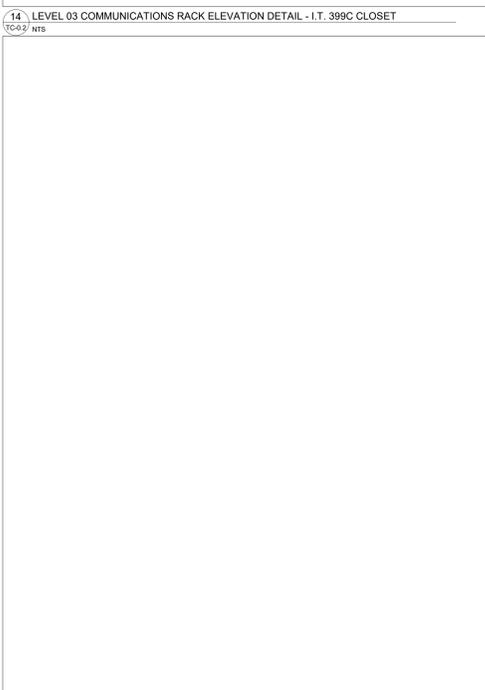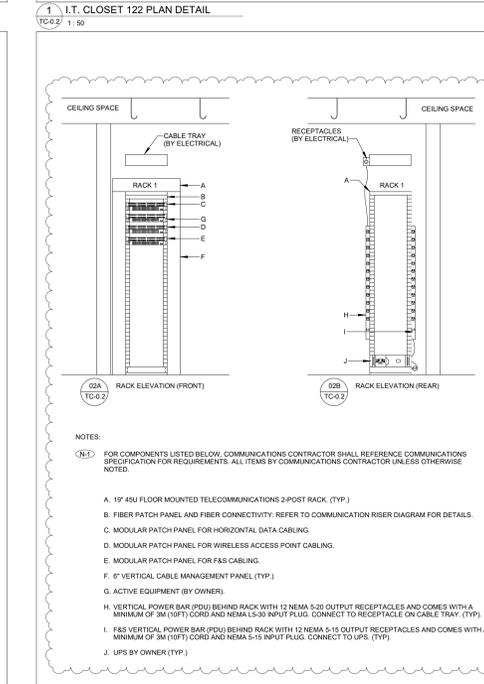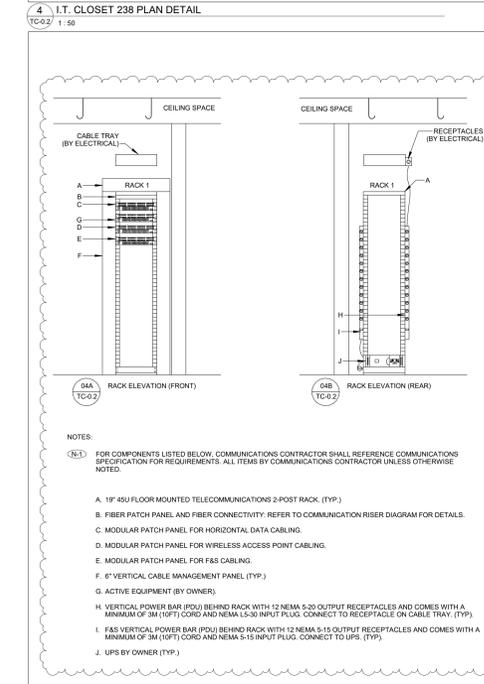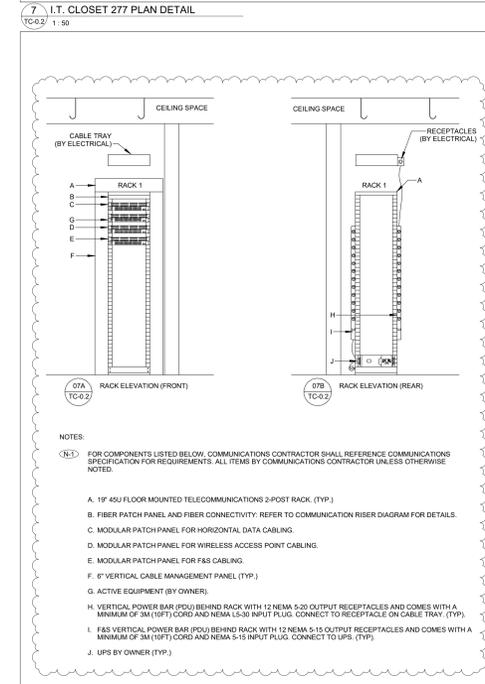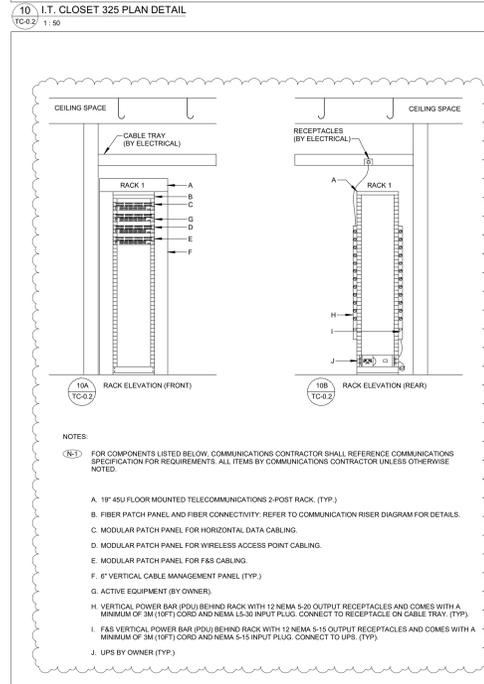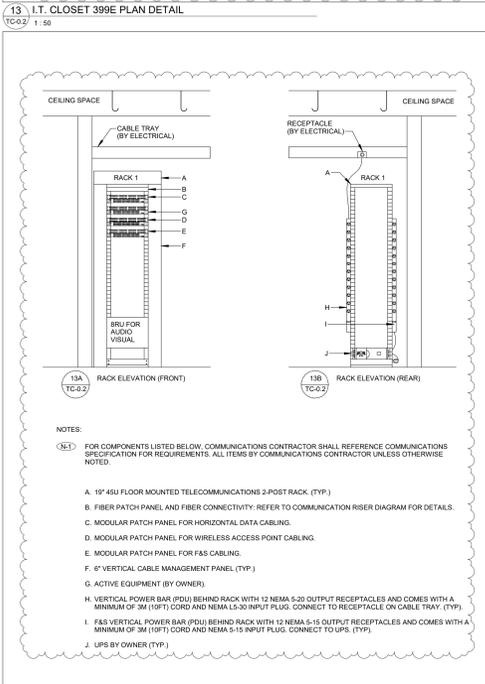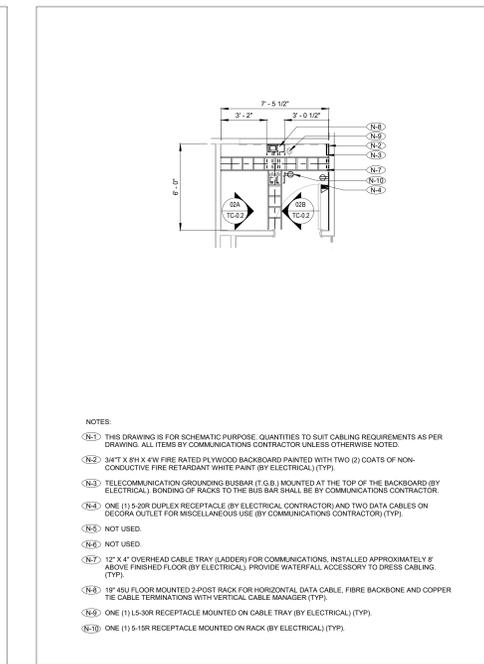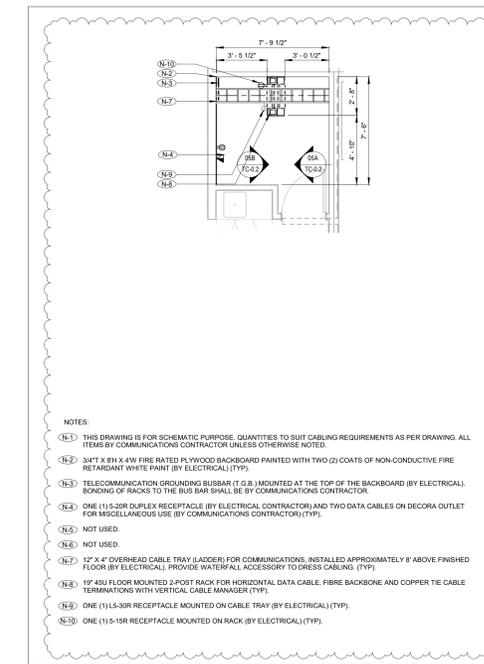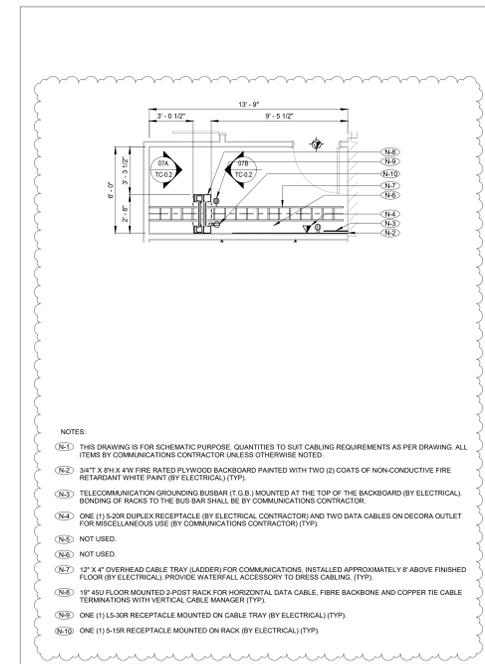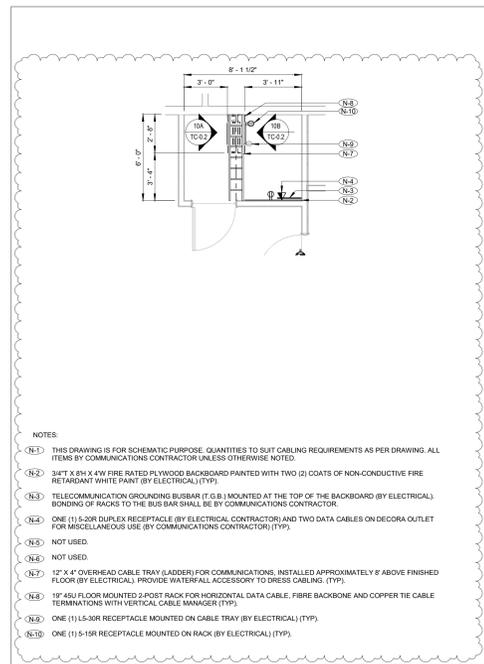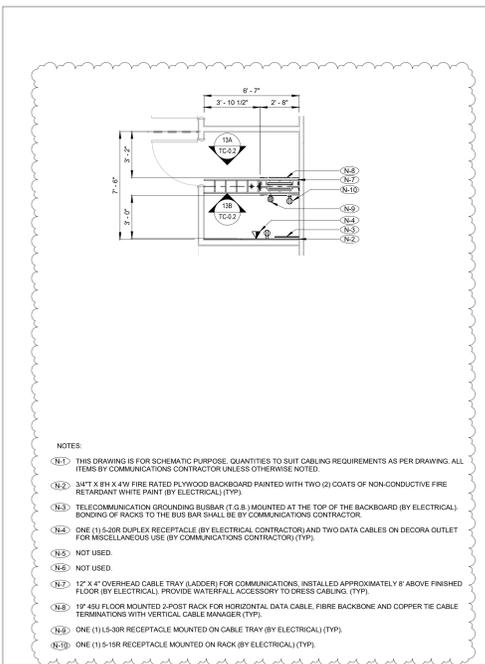

KEY PLAN:

REVISION		
NO.	DATE	DESCRIPTION
1	2024-10-04	ISSUED FOR 50%
2	2024-12-04	ISSUED FOR FAS REVIEW
3	2025-01-31	ISSUED FOR BID
4	2025-03-21	BID ADDENDUM #03
5	2025-03-25	BID ADDENDUM #04
6	2025-03-28	BID ADDENDUM #05

PROJECT:  
HEALTH AND WELLNESS CENTRE RENOVATION AT KOFFLER

214 COLLEGE ST.  
TORONTO, ON M5T 3A1

SHEET CONTENTS:  
COMMUNICATIONS TELECOM ROOMS DETAILS

PROJECT NUMBER:  
21590.003

DRAWING SCALE:  
As indicated


DRAWN BY: [ ] CHECKED BY: [ ] DATE: [ ]  
AUTHOR: [ ] CHECKER: [ ] ISSUE DATE: [ ]

SHEET NO:  
TC-0.2


11

Smith + Andersen  
1100 - 100 Sheppard Ave East, Toronto, ON, M2N 6R9  
416-467-8103 | smith@smithandandersen.com

ENFORM architects  
ENFORM Architects Inc.  
1284 Blooring Road, Suite 302B  
Toronto, Ontario, Canada M8R 2B7  
1-867-648-7523  
www.enformarchitects.com

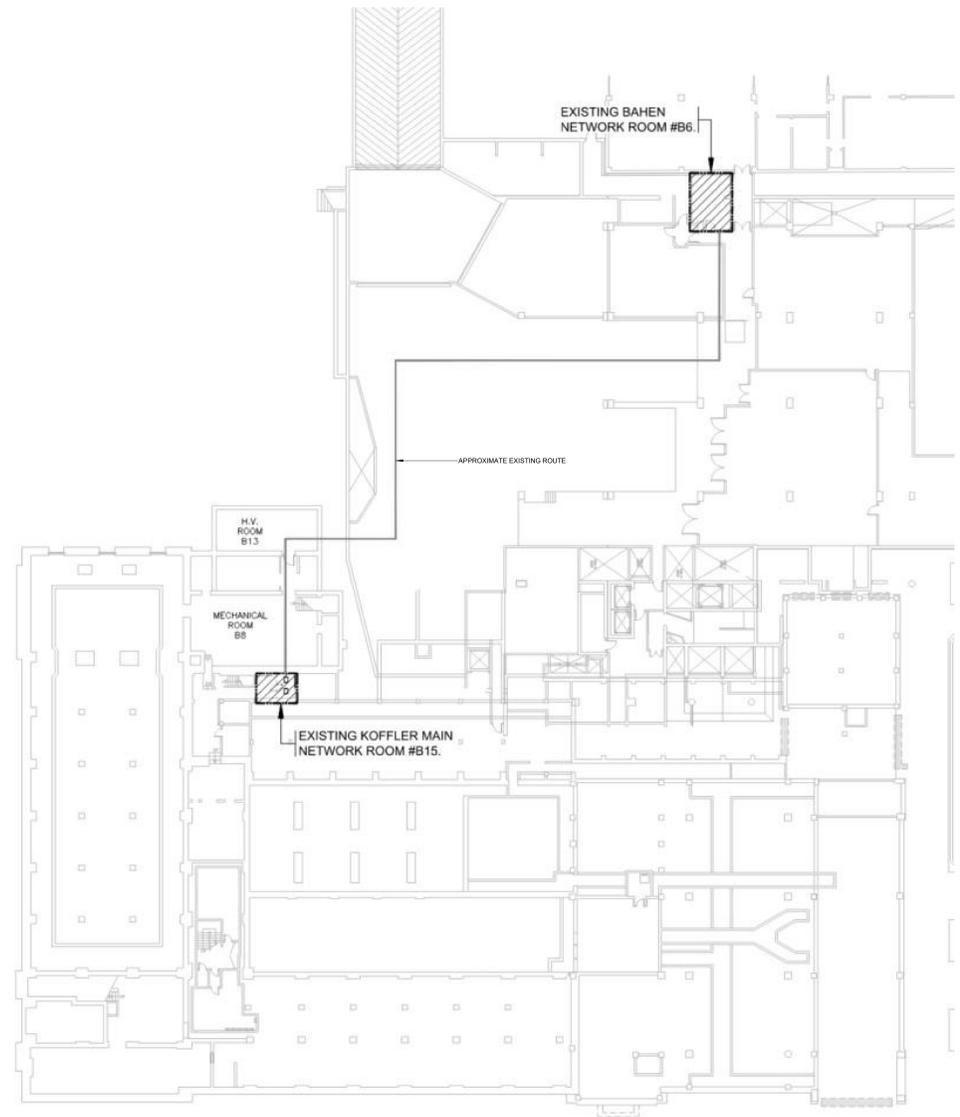

2 COMMUNICATIONS BASEMENT LEVEL KEYPLAN  
TC-9.3 NTS

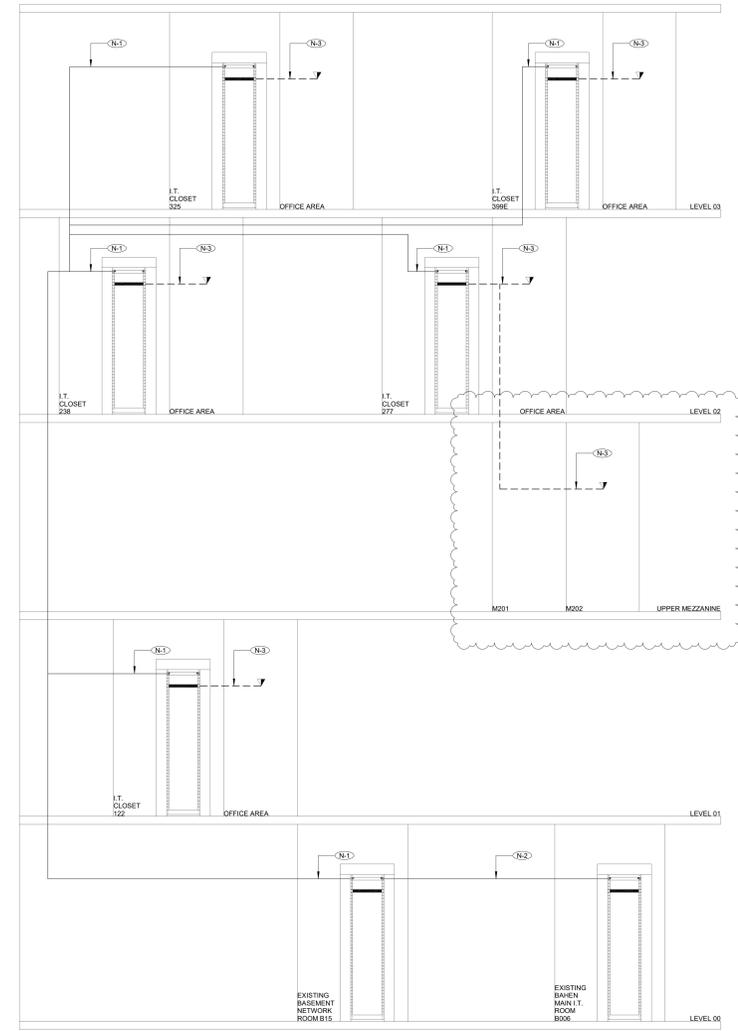


GENERAL NOTES

1. RISER IS DIAGRAMMATIC ONLY. FOR COMPONENTS LISTED BELOW REFERENCE COMMUNICATIONS SPECIFICATION FOR REQUIREMENTS.
2. ALL ITEMS BY COMMUNICATIONS CONTRACTOR UNLESS OTHERWISE NOTED.
3. PROVIDE ADEQUATE FIRE STOPPING AS REQUIRED.

NOTES

- (N1) PROVIDE ONE (1) 24-STRAND SINGLEMODE, OS2, OMFP FIBER BACKBONE CABLE WITH LC CONNECTORS FROM EXISTING BASEMENT LAN ROOM TO EACH TELECOM ROOM (TYP).
- (N2) PROVIDE ONE (1) ARMORED 48-STRAND SINGLEMODE, OS2, OMFP FIBER BACKBONE CABLE WITH LC CONNECTORS FROM EXISTING BAHEN MAIN I.T. ROOM BOO TO EXISTING BASEMENT NETWORK ROOM #B15. ALLOW FOR 300 FT OF FIBER.
- (N3) HORIZONTAL CABLING TO OFFICE AREA BY COMMUNICATIONS CONTRACTOR.

1 COMMUNICATIONS RISER DIAGRAM  
TC-9.3 NTS

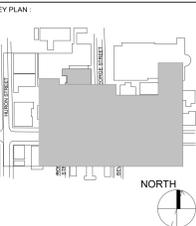

REVISION	
NO.	DESCRIPTION
1	2024-10-04 ISSUED FOR BIDDING
2	2024-12-04 ISSUED FOR F&S REVIEW
3	2025-01-31 ISSUED FOR BIDDING
10	2025-03-25 BID ADDENDUM #04
11	2025-03-28 BID ADDENDUM #05



SEAL:



PROJECT:  
**HEALTH AND WELLNESS CENTRE RENOVATION AT KOFFLER**

214 COLLEGE ST.  
TORONTO, ON M5T 3A1



SHEET CONTENTS:  
**COMMUNICATIONS RISER DIAGRAM**

PROJECT NUMBER:  
**21590.003**

DRAWING SCALE:  
**NTS**

DRAWN BY: [ ] CHECKED BY: [ ] DATE: [ ]  
AUTHOR: [ ] CHECKER: [ ] ISSUE DATE: [ ]

SHEET NO: **TC-0.3** REV: **11**

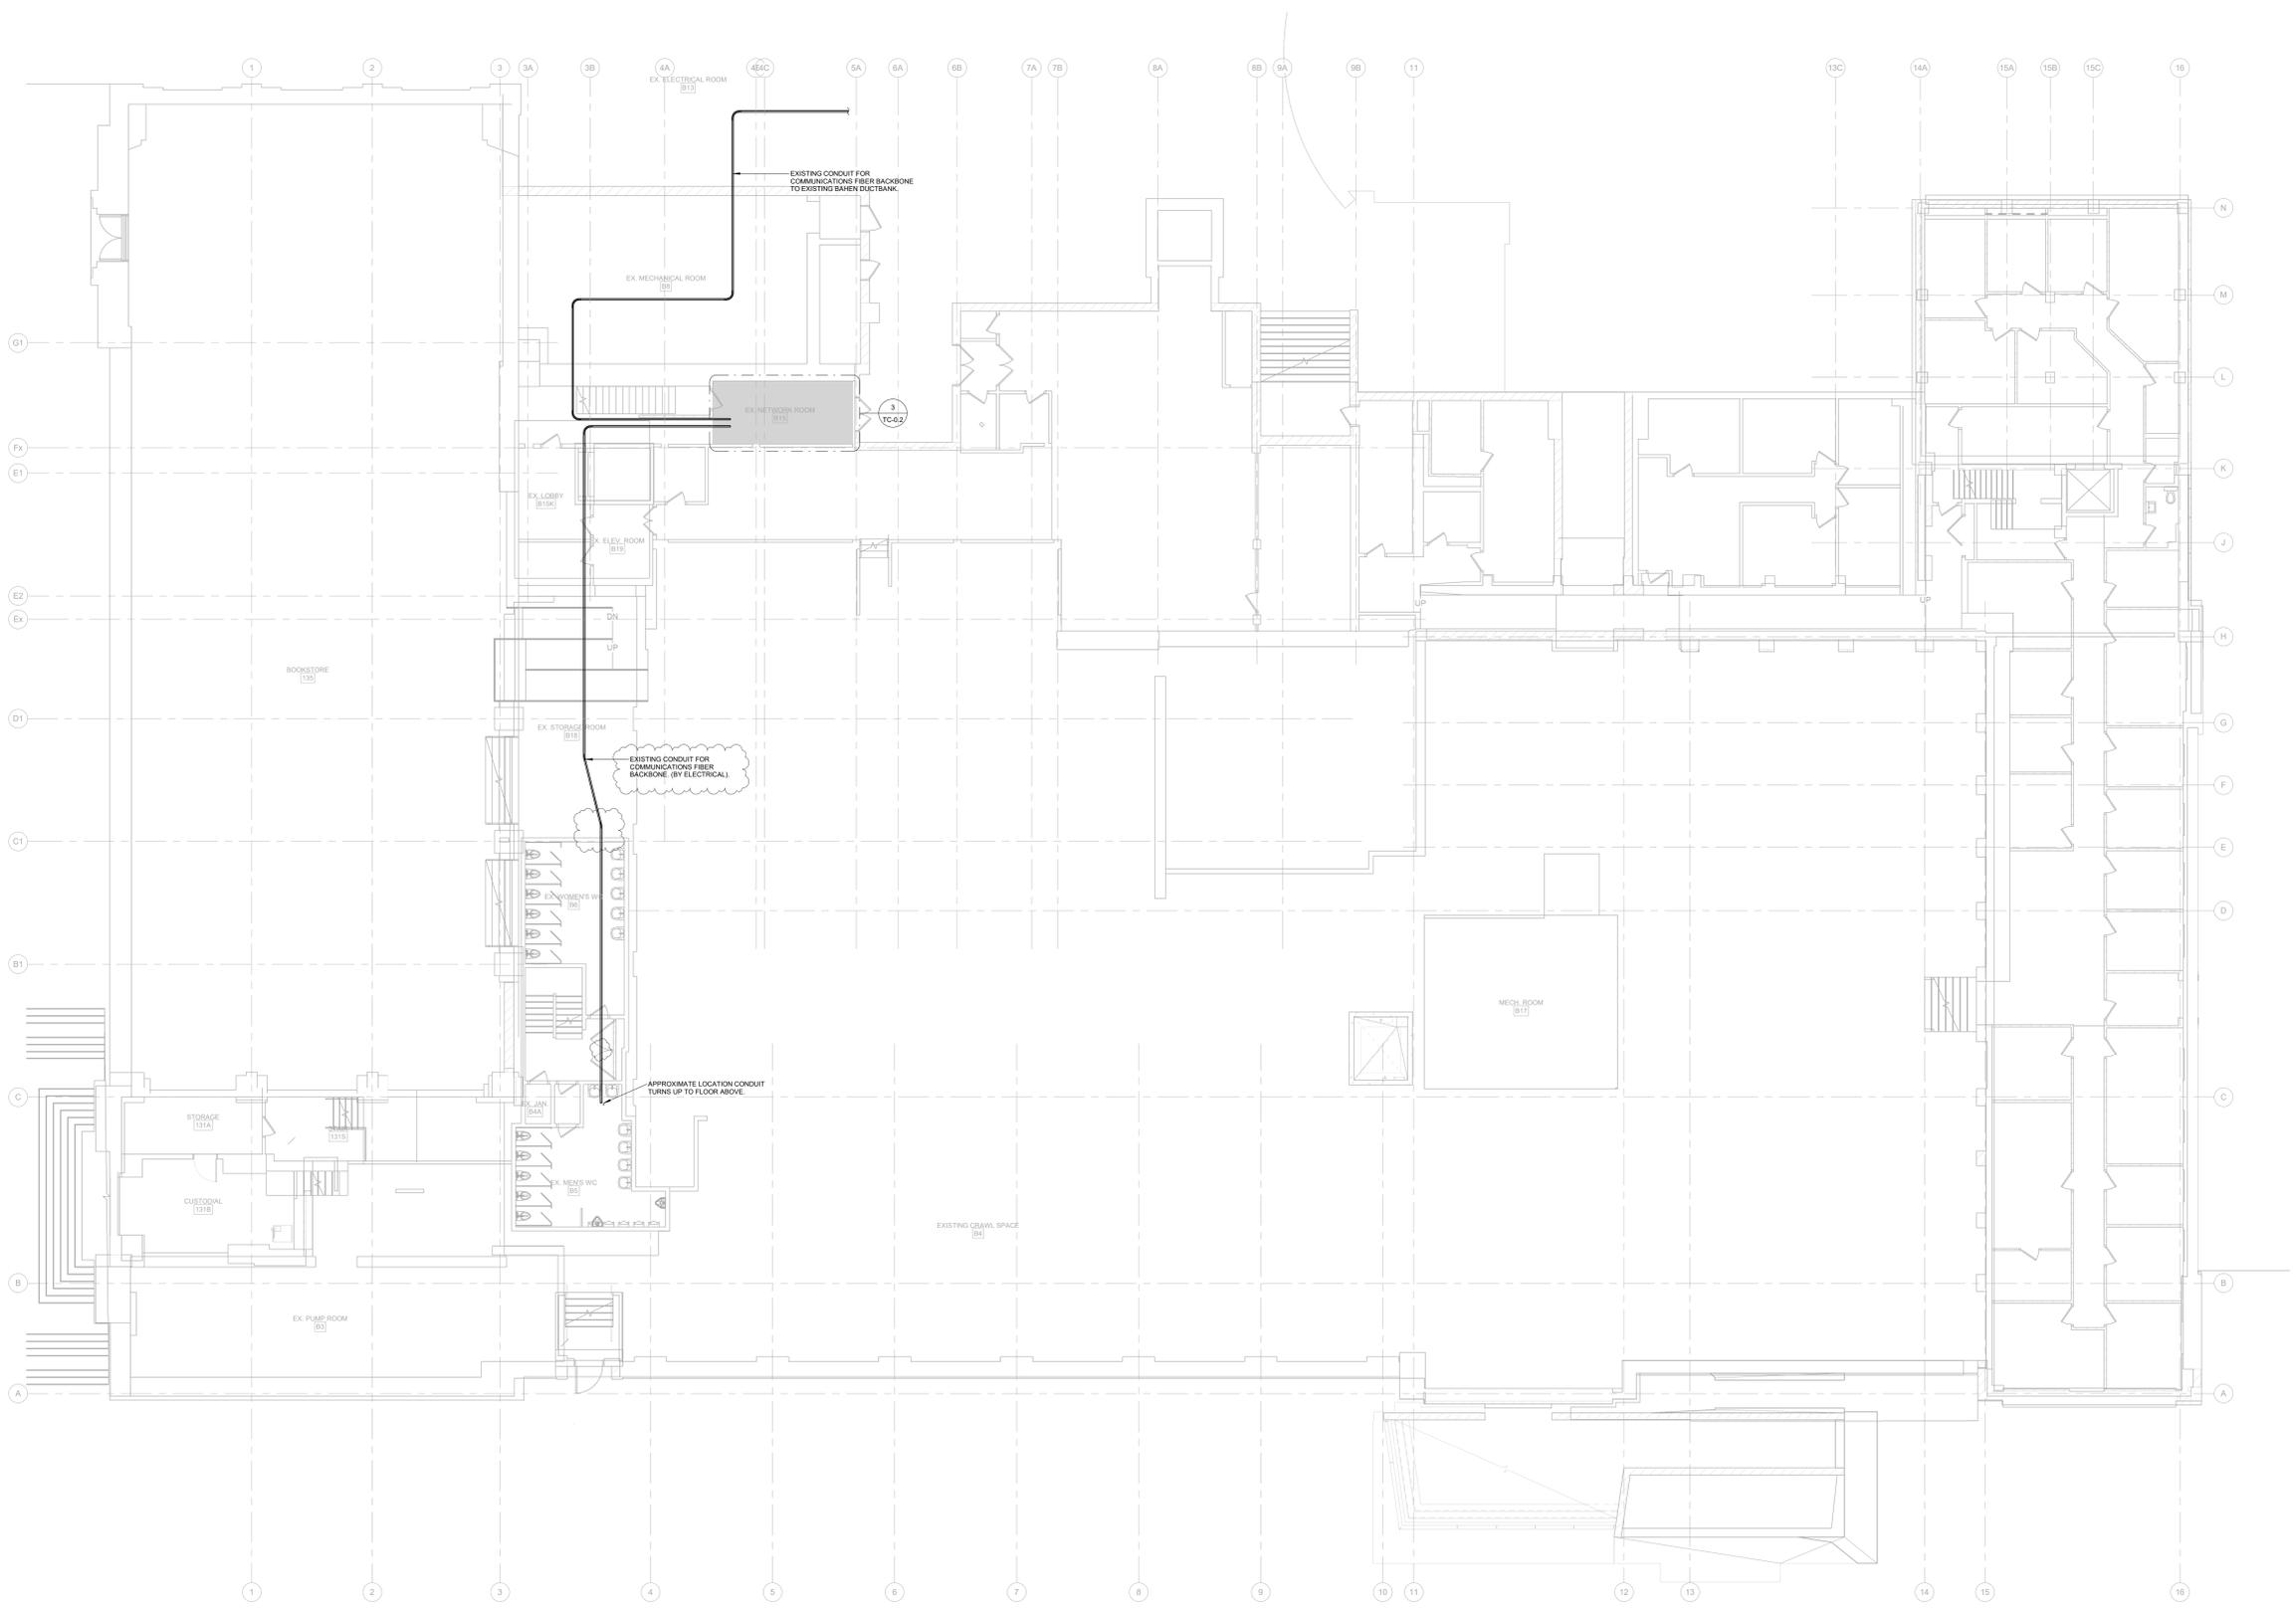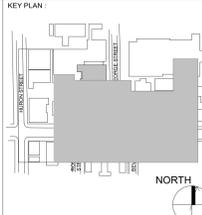

REVISION		
NO.	DATE	DESCRIPTION
1	2024-10-04	ISSUED FOR BIDDING
2	2024-12-04	ISSUED FOR F&S REVIEW
3	2025-01-31	ISSUED FOR BID
10	2025-03-25	BID ADDENDUM #04
11	2025-03-28	BID ADDENDUM #05



SEAL:



PROJECT:  
HEALTH AND WELLNESS  
CENTRE RENOVATION AT  
KOFFLER

214 COLLEGE ST.  
TORONTO, ON M5T 3A1


SHEET CONTENTS:  
**LEVEL 00 COMMUNICATIONS  
LAYOUT**

PROJECT NUMBER:  
**21590.003**

DRAWING SCALE:  
**1 : 100**


DRAWN BY: CHECKED BY: DATE:  
Author Checker Issue Date

SHEET NO. **TC-B1.1** REV: **11**

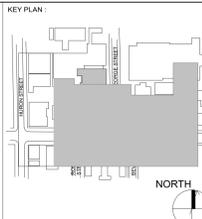

- GENERAL NOTES**
1. INSTALL OWNER SUPPLIED WIRELESS ACCESS POINTS. COORDINATE WITH OWNER FOR WAP PICK UP FROM: UNIVERSITY OF TORONTO 415, 4 BANCROFT AVENUE, ROOM 103. USE CABLE LABELS NOTED ON PLAN.
  2. ALL CONDUITS ARE PROVIDED BY ELECTRICAL CONTRACTOR. CONDUIT ROUTES SHOWN ARE DIAGNOSTIC. ELECTRICAL CONTRACTOR TO VERIFY ROUTE ON SITE. MAKING ADJUSTMENTS AS NEEDED. ELECTRICAL CONTRACTOR TO PROVIDE PULL BOXES IN SECTIONS OF CONDUIT THAT ARE:
    - 2.1. 50M (150FT) OR LONGER.
    - 2.2. CONTAIN MORE THAN TWO 90 DEGREE BENDS. OR
    - 2.3. CONTAIN A REVERSE BEND.
  3. ADEQUATE PULL BOX SIZE SHALL BE DETERMINED BASED ON TABLE BELOW:

CONDUIT TRADE SIZE mm (IN)	MINIMUM SPACE REQUIREMENTS IN PULL BOXES HAVING ONE CONDUIT EACH IN OPPOSITE END OF THE BOX	WIDTH mm (IN)	LENGTH mm (IN)	DEPTH mm (IN)	WIDTH INCREASE PER ADDITIONAL CONDUIT mm (IN)
27 (1.07)		102 (4.07)	406 (16.0)	75 (3.0)	53 (2.07)
30 (1.25)		150 (6.0)	510 (20.0)	75 (3.0)	75 (3.0)
41 (1.61)		200 (8.0)	688 (27.0)	102 (4.0)	102 (4.0)
53 (2.07)		250 (10.0)	900 (35.0)	102 (4.0)	125 (5.0)
63 (2.5)		258 (10.2)	1067 (42.0)	125 (5.0)	150 (6.0)
75 (3.0)		300 (12.0)	1220 (48.0)	125 (5.0)	150 (6.0)
93 (3.6)		300 (12.0)	1370 (54.0)	150 (6.0)	150 (6.0)
102 (4.0)		375 (15.0)	1625 (64.0)	200 (8.0)	200 (8.0)

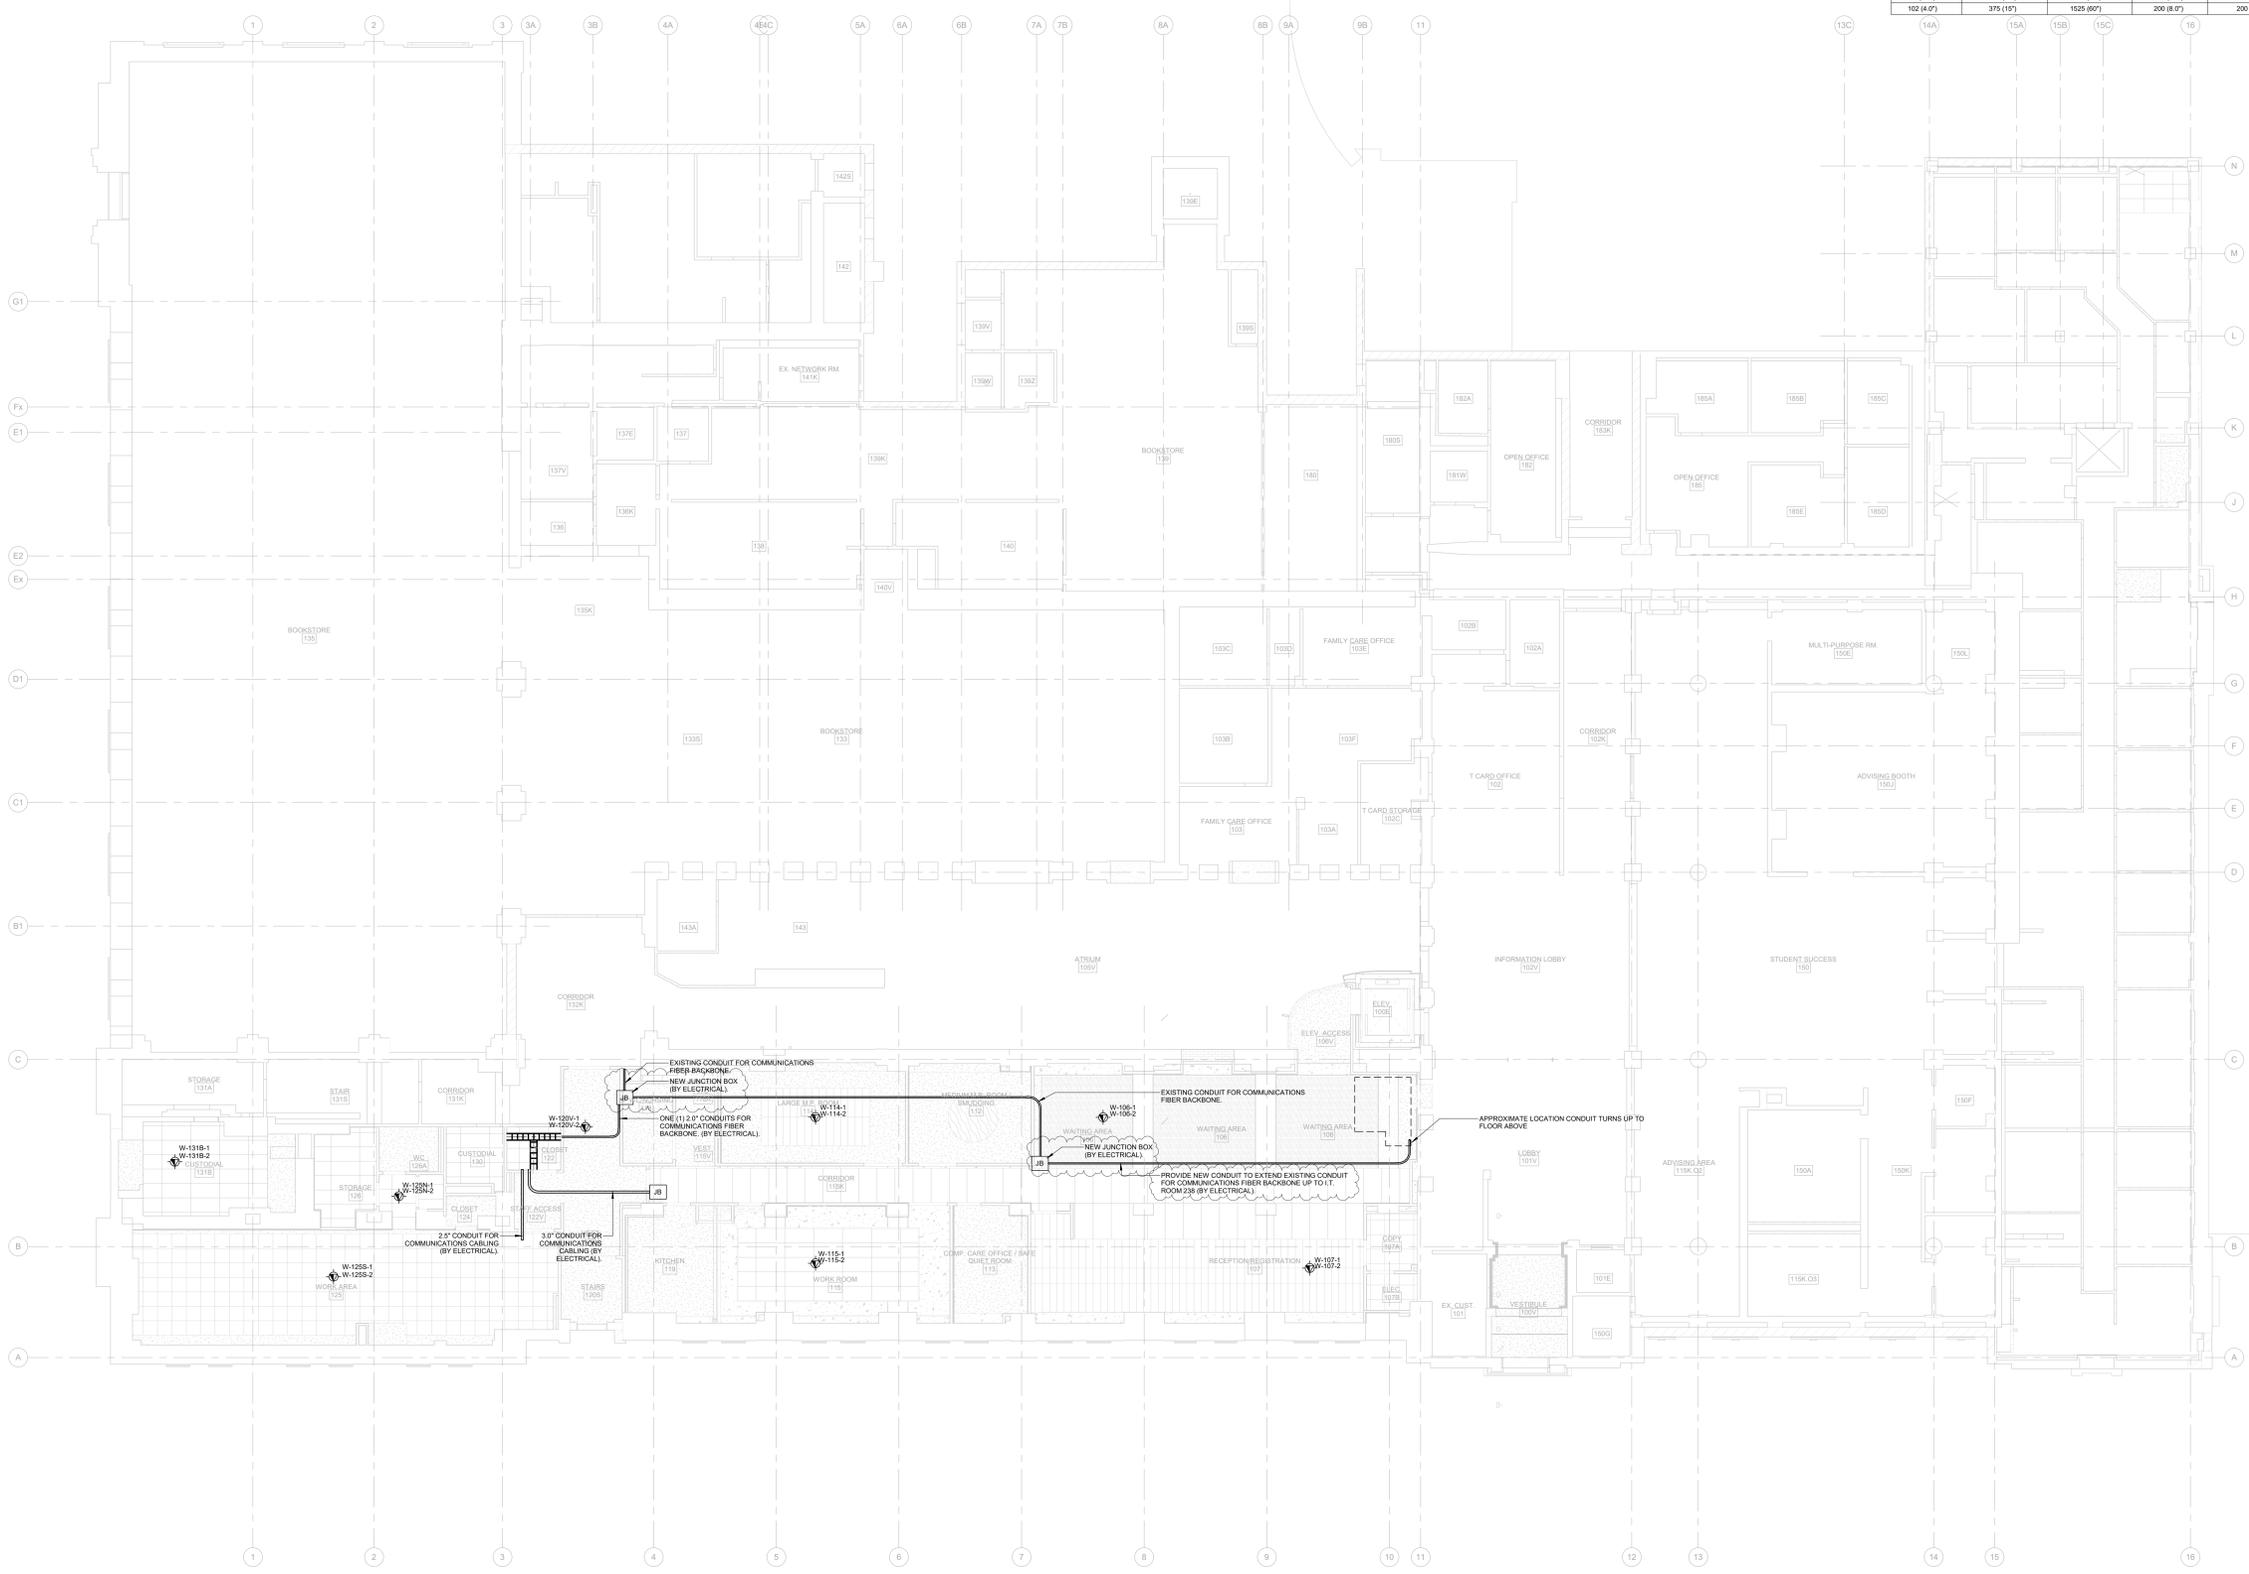

**REVISION**

NO.	DATE	DESCRIPTION
1	2024-10-04	ISSUED FOR BIDDING
2	2024-12-04	ISSUED FOR FAS REVIEW
3	2025-01-31	ISSUED FOR BID
10	2025-03-25	BID ADDENDUM #04
11	2025-03-28	BID ADDENDUM #05



SEAL:



PROJECT:  
**HEALTH AND WELLNESS CENTRE RENOVATION AT KOFFLER**

214 COLLEGE ST.  
TORONTO, ON M5T 3A1


SHEET CONTENTS:  
**LEVEL 01 WIRELESS ACCESS POINT PLAN**

PROJECT NUMBER:  
**21590.003**

DRAWING SCALE:  
**1 : 100**


DRAWN BY: [ ] CHECKED BY: [ ] DATE: [ ]  
Author: [ ] Checker: [ ] Issue Date: [ ]

SHEET NO: **TC-1.2** REV: **11**

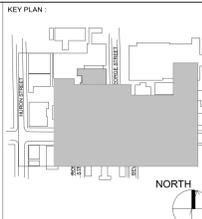

- DRAWING NOTES:**
- (N1) COMMUNICATIONS CABLES LOCATED FROM THE DIVIDING LINE TO THE DIRECTION OF THE ARROW ARE TO BE TERMINATED AT I.T. CLOSET 235.
  - (N2) COMMUNICATIONS CABLES LOCATED FROM THE DIVIDING LINE TO THE DIRECTION OF THE ARROW ARE TO BE TERMINATED AT I.T. ROOM 277.
  - (N3) CONDUITS FOR COMMUNICATIONS ROUGH-INS TERMINATE AT NEAREST JUNCTION BOX.
  - (N4) 0.75" CONDUIT FOR WIRELESS ACCESS POINT TERMINATED ON A JUNCTION BOX TO CONDUIT SPINE (BY ELECTRICAL).
- GENERAL NOTES:**
1. INSTALL OWNER SUPPLIED WIRELESS ACCESS POINTS. COORDINATE WITH OWNER FOR WAP PICK UP FROM: UNIVERSITY OF TORONTO 115.4 BANKROFT AVENUE, ROOM 103. USE CABLE LABELS NOTED ON PLAN.
  2. ALL CONDUITS ARE PROVIDED BY ELECTRICAL CONTRACTOR. CONDUIT ROUTES SHOWN ARE DIAGRAMMATIC. ELECTRICAL CONTRACTOR TO VERIFY ROUTE ON SITE. MAKING ADJUSTMENTS AS NEEDED. ELECTRICAL CONTRACTOR TO PROVIDE PULL BOXES IN SECTIONS OF CONDUIT THAT ARE:
    - 2.1. 50M (160FT) OR LONGER.
    - 2.2. CONTAIN MORE THAN TWO 90 DEGREE BENDS. OR
    - 2.3. CONTAIN A REVERSE BEND.
  3. ADEQUATE PULL BOX SIZE SHALL BE DETERMINED BASED ON TABLE BELOW:

MINIMUM SPACE REQUIREMENTS IN PULL BOXES HAVING ONE CONDUIT EACH IN OPPOSITE END OF THE BOX	CONDUIT TRADE SIZE mm (IN)	WIDTH mm (IN)	LENGTH mm (IN)	DEPTH mm (IN)	WIDTH INCREASE PER ADDITIONAL CONDUIT mm (IN)
27 (1.07)	102 (4.07)	406 (16.0)	75 (3.0)	53 (2.07)	53 (2.07)
35 (1.38)	150 (6.0)	610 (24.0)	75 (3.0)	75 (3.0)	75 (3.0)
41 (1.61)	200 (8.0)	688 (27.1)	102 (4.0)	102 (4.0)	102 (4.0)
53 (2.07)	250 (10.0)	900 (35.4)	102 (4.0)	125 (5.0)	125 (5.0)
63 (2.5)	258 (10.1)	1067 (42.0)	125 (5.0)	150 (6.0)	150 (6.0)
75 (3.0)	300 (12.0)	1220 (48.0)	125 (5.0)	150 (6.0)	150 (6.0)
91 (3.5)	300 (12.0)	1370 (54.0)	150 (6.0)	150 (6.0)	150 (6.0)
102 (4.0)	375 (15.0)	1625 (64.0)	200 (8.0)	200 (8.0)	200 (8.0)

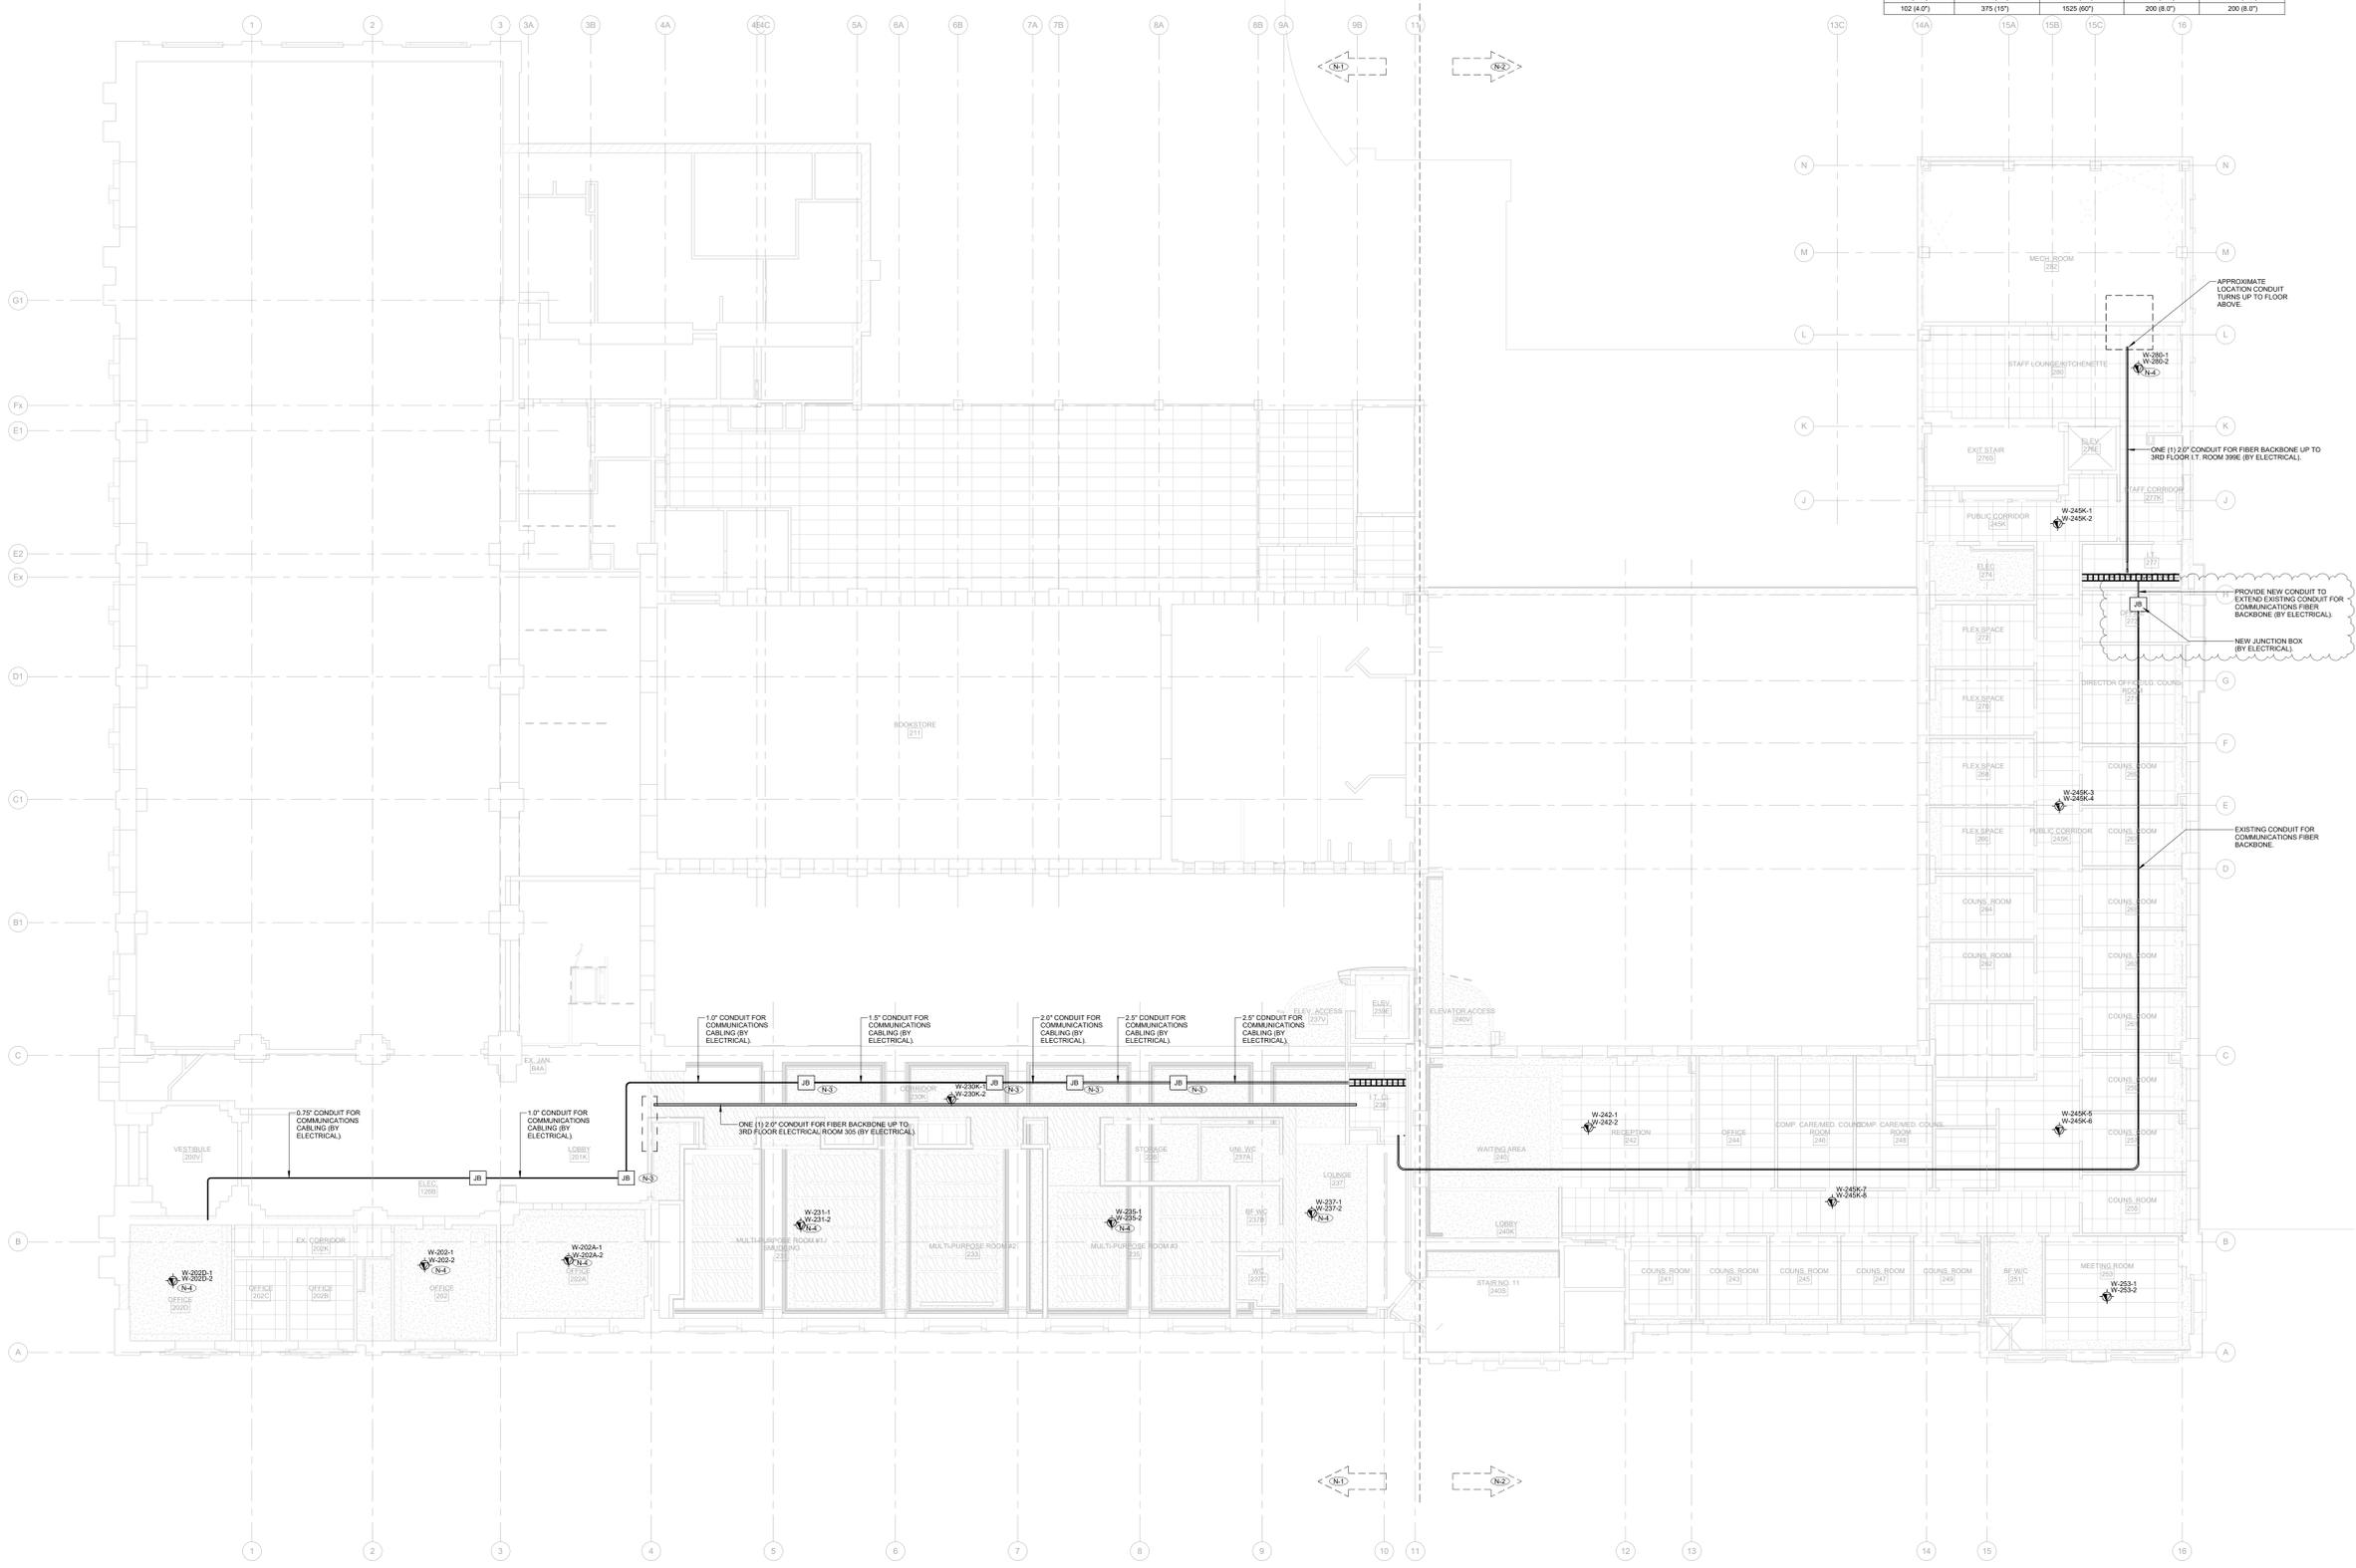

**REVISION**

NO.	DATE	DESCRIPTION
1	2024-10-04	ISSUED FOR BIDDING
2	2024-12-04	ISSUED FOR FAS REVIEW
3	2025-01-31	ISSUED FOR BID
10	2025-03-25	BID ADDENDUM #04
11	2025-03-28	BID ADDENDUM #05



PROJECT:  
**HEALTH AND WELLNESS CENTRE RENOVATION AT KOFFLER**

214 COLLEGE ST.  
TORONTO, ON M5T 3A1

SHEET CONTENTS:  
**LEVEL 02 WIRELESS ACCESS POINT PLAN**

PROJECT NUMBER:  
**21590.003**

DRAWING SCALE:  
**1 : 100**

DRAWN BY:	CHECKED BY:	DATE:
Author	Checker	Issue Date

SHEET NO:  
**TC-2.2**

## ADDENDUM

---

PROJECT NAME: HEALTH & WELLNESS CENTER RENOVATION AT KOFFLER

---

COMPANY: ENFORM

---

ATTENTION: Alan Fraser

---

PROJECT NO.: 21590.003.ESS.003

DATE: 2025-03-28

---

ADDENDUM NO.: 05

ISSUED BY: Joy Abdelaal

---

The following amendments are hereby made as part of the Contract Documents. The following revisions and/or additions shall be made to contract documents and the cost shall be included in the Tender Price.

---

### 1.0 FIRE ALARM & SECURITY DRAWINGS

#### 1.1 Refer to E501 LEVEL 01 - FIRE ALARM & SECURITY PLAN (included herein)

1.1.1 Wireless node added near storage 131A.

1.1.2 Power supply relocated within IT Closet 122.

#### 1.2 Refer to E502 LEVEL 02 - FIRE ALARM & SECURITY PLAN (included herein)

1.2.1 Power supply relocated within IT Room 277.


#### 1.3 Refer to E503 LEVEL 03 - FIRE ALARM & SECURITY PLAN (included herein)

1.3.1 Power supply relocated within IT Room 325B.

### 2.0 CLARIFICATION

2.1.1 The updates indicating the locations of the locks power supplies within IT rooms/closets.

END OF ELECTRONIC SAFETY AND SECURITY ADDENDUM

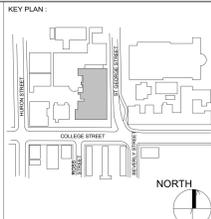


- SECURITY NOTES:**
- (S-1) PANIC BUTTONS SHALL BE CONNECTED TO THE NEAREST VIDEO SURVEILLANCE CAMERA. EXACT MOUNTING LOCATIONS OF THE PANIC BUTTONS AND THE PANIC RESET BUTTONS SHALL BE COORDINATED WITH THE CLIENT AND ARCHITECT PRIOR TO INSTALLATION. SECURITY CONTRACTOR SHALL ENSURE THAT THE UNDERDECK MOUNTED PANIC BUTTONS ARE ADEQUATELY DIFFERENTIATED VIA MOUNTING ORIENTATION & LOCATION, MAKE/MODEL AND COLOUR OF BUTTON FROM THE UNDERDECK MOUNTED PANIC RESET BUTTONS SUCH THAT THERE IS NO AMBIGUITY BETWEEN THE FUNCTIONS. IN ADDITION, THE PANIC BUTTON SHALL BE LABELED.
  - (S-2) ALIBIE ANNUNCIATORS SHALL BE PROGRAMMED TO TRIGGER WHEN DOOR IS OPENED WITHOUT A VALID CREDENTIAL BEING PRESENTED AT THE CARD READER, AND WHEN DOOR IS HELD OPEN. COORDINATE WITH THE CLIENT REGARDING PROGRAMMING SPECIFICS.
  - (S-3) CAMERA HEADS SHALL BE POSITIONED TO CAPTURE DOORS 115K, 124 V, 125 AND 124S.
  - (S-4) CAMERA HEADS SHALL BE POSITIONED TO CAPTURE WAITING AREA 106 INCLUDING DOOR 106 AND CORRIDOR 115K. ARROWS INDICATE APPROXIMATE DIRECTION OF HEADS. COORDINATE CAMERA VIEWS WITH THE CLIENT.
  - (S-5) DEVICES CONNECTED TO HONEYWELL ACCESS CONTROL SYSTEM.
  - (S-6) DEVICES CONNECTED TO SALTO ACCESS CONTROL SYSTEM.

- ELECTRONIC SAFETY AND SECURITY GENERAL NOTES:**
1. THIS DRAWING SHALL BE READ IN CONJUNCTION WITH THE PROJECT RELATED DOOR HARDWARE SCHEDULE AS WELL AS THE PROJECT RELATED ARCHITECTURAL, ELECTRICAL AND MECHANICAL DRAWINGS.
  2. ALL ITEMS SHOWN ARE BY THE SECURITY CONTRACTOR UNLESS OTHERWISE NOTED.
  3. LOCATIONS OF DEVICES SHOWN ARE APPROXIMATE. COORDINATE THE EXACT LOCATION OF EACH DEVICE ON SITE WITH OTHER TRADES.
  4. COORDINATE THE INSTALLATION AND INTERFACING WITH ALL ELECTRIFIED LOCKS AND DOOR CONTACTS WITH THE DOOR HARDWARE CONTRACTOR.
  5. COORDINATE THE INSTALLATION AND INTERFACING WITH ALL POWER CIRCUITS WITH THE ELECTRICAL CONTRACTOR.
  6. COORDINATE EXACT MOUNTING HEIGHTS AND LOCATIONS OF CCTV CAMERAS ON SITE WITH ELECTRICAL CONTRACTOR. PROVIDE ALL MOUNTING BRACKETS TO ENSURE THAT ALL OBSTRUCTIONS ARE AVOIDED AND CLEAR VIEW OF TARGET AREAS IS ATTAINED.
  7. ALL CABLES SHALL BE HOME RUN IN CONDUITS. CABLE SPLICES SHALL NOT BE ACCEPTABLE. WHERE CABLES ARE GROUPED AND INSTALLED IN A SINGLE CONDUIT THE CONDUIT SHALL BE SIZED TO MAXIMUM 40% FULL.
  8. REVIEW ALL PROJECT RELATED ARCHITECTURAL, MECHANICAL, ELECTRICAL, COMMUNICATIONS AND AV DRAWINGS AND SPECIFICATIONS. ENGINEER AND COORDINATE ALL OVERLAPPING WORK WITH SECURITY SYSTEMS TO AVOID COLLISIONS AND CONFLICTS OF DEVICES.
  9. DEVICES SHALL NOT BE INSTALLED IN WALL AREAS THAT ARE DESIGNATED TO HAVE MARKER BOARD FABRIC PANELS OR ACCESS CREDENTIALS UNLESS INDICATED SPECIFICALLY ON AN ELEVATED DRAWING.
  10. DEVICES SHALL NOT BE INSTALLED ABOVE ANY FURNITURE AND SHALL BE LOCATED WHERE THERE IS ADEQUATE ACCESS FOR USE UNLESS INDICATED SPECIFICALLY ON AN ELEVATED DRAWING.
  11. INFORM THE ENGINEER'S REPRESENTATIVE AND GC OF ALL DEVICE AND FURNITURE CONFLICTS PRIOR TO INSTALLATION. OBTAIN RESOLUTION TO DEVICE AND FURNITURE CONFLICTS FROM THE ENGINEER'S REPRESENTATIVE PRIOR TO INSTALLATION.
  12. REFER TO POWER AND SYSTEMS DRAWINGS FOR AUTOMATIC DOOR OPERATOR LOCATIONS. SECURITY CONTRACTOR SHALL COORDINATE SECURITY ACCESS CONTROL WITH ADD DOORS.

- FIRE ALARM GENERAL NOTES:**
1. NEW SMOKE DETECTOR SHALL BE CONNECTED TO THE EXISTING BASE BUILDING ELEVATOR RECALL SYSTEM AND SHALL BE TIED INTO THE FIRE ALARM CONTROL PANEL. UPON ACTUATION OF A FIRE ALARM CONDITION ON THIS FLOOR THE FIRE ALARM PANEL SHALL SEND A RELAY TO THE ELEVATOR CONTROL PANEL FOR ELEVATOR AUTOMATIC RECALL SUCH THAT THE ELEVATOR RETURNS TO AN ALTERNATE FLOOR. PROVIDE ALL REQUIRED AUXILIARY CONTACTS AND RELAYS AT THE ELEVATOR CONTROL PANEL AND FIRE ALARM PANEL. ELECTRICAL CONTRACTOR TO COORDINATE ON SITE WITH LANDLORD AND ELEVATOR VENDOR FOR ALL REQUIREMENTS AND LOCATION OF EQUIPMENT. PROVIDE ALL REQUIRED FIRE ALARM VERIFICATION. ALL WORK TO COMPLY WITH CSA 844 LATEST EDITION TO THE SATISFACTION OF TSSA AND LOCAL AUTHORITIES HAVING JURISDICTION.
  2. CONFIRM ELECTRICAL REQUIREMENTS AND EXACT LOCATION OF ALL MECHANICAL EQUIPMENT WITH MECHANICAL DRAWINGS AND CONTRACTOR PRIOR TO ROUGH-INS.
  3. ROUTE ALL CONDUIT SYSTEMS AROUND DUCT WORK, BEAMS AND PIPING AS REQUIRED TO ACCOMMODATE LAYOUT SHOWN. REFER TO MECHANICAL DRAWINGS AND ARCHITECTURAL DRAWINGS FOR ADDITIONAL DETAILS.
  4. COORDINATE ALL WORK TO SUIT PROJECT PHASE SCHEDULE. COORDINATE PHASING WITH ARCHITECT/INTERIOR DESIGN/CONTRACTOR PHASING IF SHOWN IS FOR REFERENCE PURPOSES ONLY.

- DRAWING NOTES:**
- (S-7) THE KITCHEN HOOD FIRE SUPPRESSION SYSTEM TO BASE BUILDING FIRE ALARM SYSTEM AS SEPARATE ZONE. ALLOW FOR UPDATING OF FIRE ALARM ZONE SCHEDULE.
  - (S-8) REFER TO POWER AND SYSTEMS DRAWINGS FOR AUTOMATIC DOOR OPERATOR LOCATIONS. SECURITY CONTRACTOR SHALL COORDINATE SECURITY ACCESS CONTROL WITH ADD DOORS.


REVISION		
NO.	DATE	DESCRIPTION
1	2024-10-04	ISSUED FOR DOI
2	2024-11-15	PERMIT
3	2024-12-04	ISSUED FOR PERMITS REVIEW
4	2024-12-23	ISSUED FOR FAS REVIEW
5	2025-01-24	ISSUED FOR PEER REVIEW
6	2025-01-31	ISSUED FOR BID
9	2025-03-21	BID ADDENDUM #03
11	2025-03-28	BID ADDENDUM #05

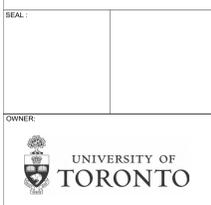

PROJECT: HEALTH AND WELLNESS CENTRE RENOVATION AT KOFFLER

214 COLLEGE ST. TORONTO, ON M5T 3A1  
 SHEET CONTENTS:  
**LEVEL 01 - FIRE ALARM & SECURITY PLAN**

PROJECT NUMBER: <b>21590.003</b>	DRAWING SCALE: <b>1 : 100</b>
DRAWN BY: Author	CHECKED BY: Checker
SHEET NO.: <b>E501</b>	DATE: Issue Date

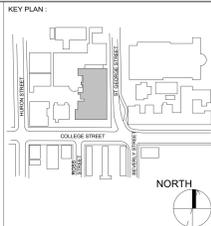

REVISION		
NO.	DATE	DESCRIPTION
1	2024-10-01	ISSUED FOR BID
2	2024-11-15	PERMIT
3	2024-12-04	ISSUED FOR PERMITS REVIEW
4	2024-12-23	ISSUED FOR FAS REVIEW
5	2025-01-24	ISSUED FOR PEER REVIEW
6	2025-01-31	ISSUED FOR BID
9	2025-03-21	BID ADDENDUM #03
11	2025-03-28	BID ADDENDUM #05



- SECURITY NOTES:**
- (S1) DEVICES CONNECTED TO HONEYWELL ACCESS CONTROL SYSTEM.
  - (S2) DEVICES CONNECTED TO SALTO ACCESS CONTROL SYSTEM.
- ELECTRONIC SAFETY AND SECURITY GENERAL NOTES:**
1. THIS DRAWING SHALL BE READ IN CONJUNCTION WITH THE PROJECT RELATED DOOR HARDWARE SCHEDULE AS WELL AS THE PROJECT RELATED ARCHITECTURAL, ELECTRICAL AND MECHANICAL DRAWINGS.
  2. ALL ITEMS SHOWN ARE BY THE SECURITY CONTRACTOR UNLESS OTHERWISE NOTED.
  3. LOCATIONS OF DEVICES SHOWN ARE APPROXIMATE. COORDINATE THE EXACT LOCATION OF EACH DEVICE ON SITE WITH OTHER TRADES.
  4. COORDINATE THE INSTALLATION AND INTERFACING WITH ALL ELECTRIFIED LOCKS AND DOOR CONTACTS WITH THE DOOR HARDWARE CONTRACTOR.
  5. COORDINATE THE INSTALLATION AND INTERFACING WITH ALL POWER CIRCUITS WITH THE ELECTRICAL CONTRACTOR.
  6. COORDINATE EXACT MOUNTING HEIGHTS AND LOCATIONS OF CCTV CAMERAS ON SITE WITH ELECTRICAL CONTRACTOR. PROVIDE ALL MOUNTING BRACKETS TO ENSURE THAT ALL OBSTRUCTIONS ARE AVOIDED AND CLEAR VIEW OF TARGET AREAS IS ATTAINED.
  7. ALL CABLES SHALL BE HOME RUN IN CONDUITS. CABLE SPLICES SHALL NOT BE ACCEPTABLE. WHERE CABLES ARE GROUPED AND INSTALLED IN A SINGLE CONDUIT THE CONDUIT SHALL BE SIZED TO MAXIMUM 40% FILL.
  8. REVIEW ALL PROJECT RELATED ARCHITECTURAL, MECHANICAL, ELECTRICAL, COMMUNICATIONS AND AV DRAWINGS AND SPECIFICATIONS. DESIGN AND COORDINATE ALL OVERLAPPING WORK WITH SECURITY SYSTEMS TO AVOID COLLISIONS AND CONFLICTS OF DEVICES.
  9. DEVICES SHALL NOT BE INSTALLED IN WALL AREAS THAT ARE DESIGNATED TO HAVE MARKER BOARD, FABRIC PANELS OR ACCENT FINISH/DETAIL UNLESS INDICATED SPECIFICALLY ON AN ELEVATED DRAWING.
  10. DEVICES SHALL NOT BE INSTALLED ABOVE ANY FURNITURE AND SHALL BE LOCATED WHERE THERE IS ADEQUATE ACCESS FOR USE UNLESS INDICATED SPECIFICALLY ON AN ELEVATED DRAWING.
  11. INFORM THE ENGINEER'S REPRESENTATIVE AND GC OF ALL DEVICE AND FURNITURE CONFLICTS PRIOR TO INSTALLATION. OBTAIN RESOLUTION TO DEVICE AND FURNITURE CONFLICTS FROM THE ENGINEER'S REPRESENTATIVE PRIOR TO INSTALLATION.
- FIRE ALARM GENERAL NOTES:**
1. NEW SMOKE DETECTOR SHALL BE CONNECTED TO THE EXISTING BASE BUILDING ELEVATOR RECALL SYSTEM AND SHALL BE TIED INTO THE FIRE ALARM CONTROL PANEL. UPON ACTUATION OF A FIRE ALARM CONDITION ON THIS FLOOR THE FIRE ALARM PANEL SHALL SEND A RELAY TO THE ELEVATOR CONTROL PANEL FOR ELEVATOR AUTOMATIC RECALL SUCH THAT THE ELEVATOR RETURNS TO AN ALTERNATE FLOOR. PROVIDE ALL REQUIRED AUXILIARY CONTACTS AND RELAYS AT THE ELEVATOR CONTROL PANEL AND FIRE ALARM PANEL. ELECTRICAL CONTRACTOR TO COORDINATE ON SITE WITH LANDLORD AND ELEVATOR VENDOR FOR ALL REQUIREMENTS AND LOCATION OF EQUIPMENT. PROVIDE ALL REQUIRED FIRE ALARM VERIFICATION. ALL WORK TO COMPLY WITH CSA B44 LATEST EDITION TO THE SATISFACTION OF TSSA AND LOCAL AUTHORITIES HAVING JURISDICTION.
  2. CONFIRM ELECTRICAL REQUIREMENTS AND EXACT LOCATION OF ALL MECHANICAL EQUIPMENT WITH MECHANICAL DRAWINGS AND CONTRACTOR PRIOR TO ROUGH-INS.
  3. ROUTE ALL CONDUIT SYSTEMS AROUND DUCT WORK, BEAMS AND PIPING AS REQUIRED TO ACCOMMODATE LAYOUT SHOWN. REFER TO MECHANICAL DRAWINGS AND ARCHITECTURAL DRAWINGS FOR ADDITIONAL DETAILS.
  4. COORDINATE ALL WORK TO SUIT PROJECT PHASE SCHEDULE. COORDINATE PHASING WITH ARCHITECT/INTERIOR DESIGN/MECHANICAL DRAWINGS. PHASING IF SHOWN IS FOR REFERENCE PURPOSES ONLY.

**DRAWING NOTES:**

- (S1) REFER TO POWER AND SYSTEMS DRAWINGS FOR AUTOMATIC DOOR OPERATOR LOCATIONS. SECURITY CONTRACTOR SHALL COORDINATE SECURITY ACCESS CONTROL WITH ADOORS.
- (S2) RELOCATE EXISTING SUPERVISORY VALVE AND FLOW SWITCH FOR SPRINKLER ZONE CONTROL. CABINET TO NEW LOCATION SHOWN. COORDINATE FINAL LOCATION WITH MECHANICAL.



**PROJECT:**  
HEALTH AND WELLNESS CENTRE RENOVATION AT KOFFLER

214 COLLEGE ST.  
TORONTO, ON M5T 3A1


**SHEET CONTENTS:**  
LEVEL 02 - FIRE ALARM & SECURITY PLAN

**PROJECT NUMBER:**  
21590.003


**DRAWING SCALE:**  
1 : 100

**DRAWN BY:** Author  
**CHECKED BY:** Checker  
**DATE:** Issue Date

**SHEET NO.:** E502 **REV:** 11

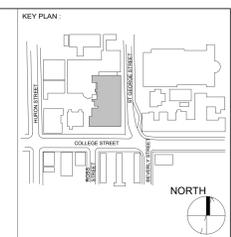

REVISION		
NO.	DATE	DESCRIPTION
1	2024-10-01	ISSUED FOR BID
2	2024-11-15	PERMIT
3	2024-12-04	ISSUED FOR PERMITS REVIEW
4	2024-12-23	ISSUED FOR PERMITS REVIEW
5	2025-01-24	ISSUED FOR PERMITS REVIEW
6	2025-01-31	ISSUED FOR BID
9	2025-03-21	BID ADDENDUM #03
11	2025-03-28	BID ADDENDUM #05

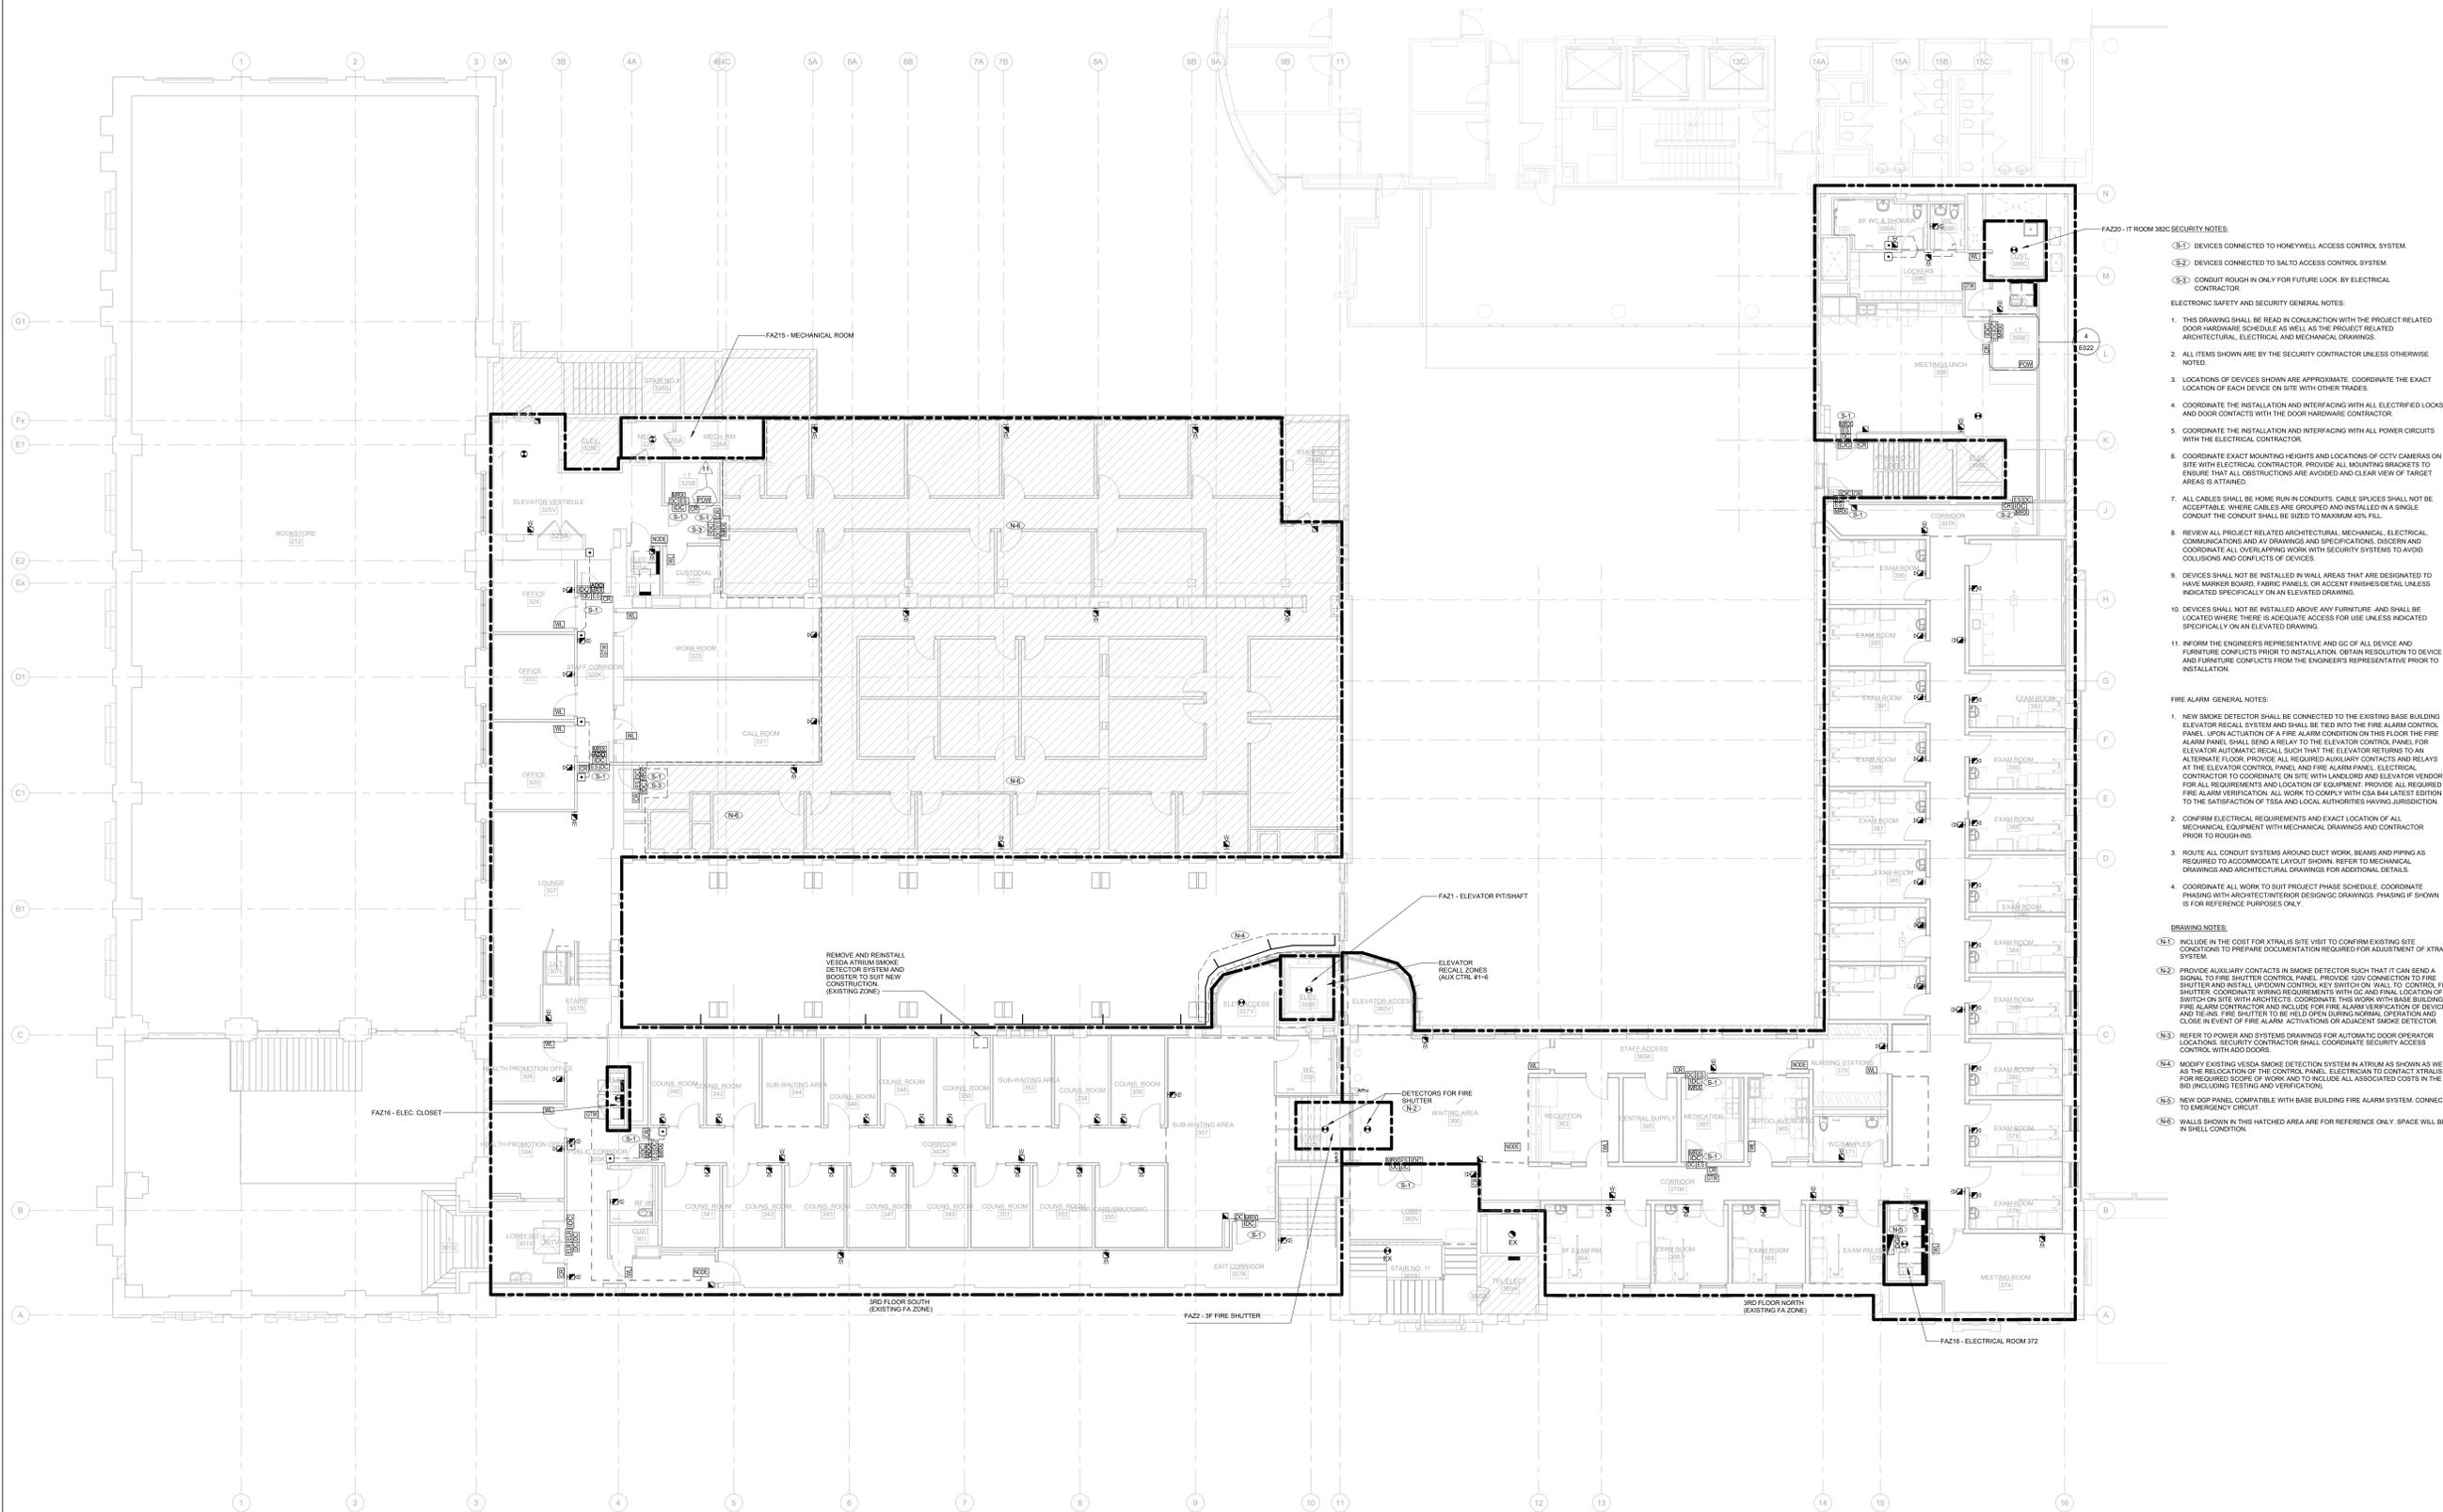

- FAZ20 - IT ROOM 303 SECURITY NOTES:**
- (S-1) DEVICES CONNECTED TO HONEYWELL ACCESS CONTROL SYSTEM.
  - (S-2) DEVICES CONNECTED TO SALTO ACCESS CONTROL SYSTEM.
  - (S-3) CONDUIT ROUGH IN ONLY FOR FUTURE LOCK BY ELECTRICAL CONTRACTOR.
- ELECTRONIC SAFETY AND SECURITY GENERAL NOTES:**
1. THIS DRAWING SHALL BE READ IN CONJUNCTION WITH THE PROJECT RELATED DOOR HARDWARE SCHEDULE AS WELL AS THE PROJECT RELATED ARCHITECTURAL, ELECTRICAL AND MECHANICAL DRAWINGS.
  2. ALL ITEMS SHOWN ARE BY THE SECURITY CONTRACTOR UNLESS OTHERWISE NOTED.
  3. LOCATIONS OF DEVICES SHOWN ARE APPROXIMATE. COORDINATE THE EXACT LOCATION OF EACH DEVICE ON SITE WITH OTHER TRADES.
  4. COORDINATE THE INSTALLATION AND INTERFACING WITH ALL ELECTRIFIED LOCKS AND DOOR CONTACTS WITH THE DOOR HARDWARE CONTRACTOR.
  5. COORDINATE THE INSTALLATION AND INTERFACING WITH ALL POWER CIRCUITS WITH THE ELECTRICAL CONTRACTOR.
  6. COORDINATE EXACT MOUNTING HEIGHTS AND LOCATIONS OF CCTV CAMERAS ON SITE WITH ELECTRICAL CONTRACTOR. PROVIDE ALL MOUNTING BRACKETS TO ENSURE THAT ALL OBSTRUCTIONS ARE AVOIDED AND CLEAR VIEW OF TARGET AREAS IS ATTAINED.
  7. ALL CABLES SHALL BE HOME RUN IN CONDUITS. CABLE SPLICES SHALL NOT BE ACCEPTABLE. WHERE CABLES ARE GROUPED AND INSTALLED IN A SINGLE CONDUIT THE CONDUIT SHALL BE SIZED TO MAXIMUM 40% FILL.
  8. REVIEW ALL PROJECT RELATED ARCHITECTURAL, MECHANICAL, ELECTRICAL, COMMUNICATIONS AND AV DRAWINGS AND SPECIFICATIONS. ENGINEER AND COORDINATE ALL OVERLAPPING WORK WITH SECURITY SYSTEMS TO AVOID COLLISIONS AND CONFLICTS OF DEVICES.
  9. DEVICES SHALL NOT BE INSTALLED IN WALL AREAS THAT ARE DESIGNATED TO HAVE MARKER BOARD FABRIC PANELS OR ACCENT FINISHES UNLESS INDICATED SPECIFICALLY ON AN ELEVATED DRAWING.
  10. DEVICES SHALL NOT BE INSTALLED ABOVE ANY FURNITURE AND SHALL BE LOCATED WHERE THERE IS ADEQUATE ACCESS FOR USE UNLESS INDICATED SPECIFICALLY ON AN ELEVATED DRAWING.
  11. INFORM THE ENGINEER'S REPRESENTATIVE AND GC OF ALL DEVICE AND FURNITURE CONFLICTS PRIOR TO INSTALLATION. OBTAIN RESOLUTION TO DEVICE AND FURNITURE CONFLICTS FROM THE ENGINEER'S REPRESENTATIVE PRIOR TO INSTALLATION.
- FIRE ALARM GENERAL NOTES:**
1. NEW SMOKE DETECTOR SHALL BE CONNECTED TO THE EXISTING BASE BUILDING ELEVATOR RECALL SYSTEM AND SHALL BE TIED INTO THE FIRE ALARM CONTROL PANEL. UPON ACTUATION OF A FIRE ALARM CONDITION ON THIS FLOOR THE FIRE ALARM PANEL SHALL SEND A RELAY TO THE ELEVATOR CONTROL PANEL FOR ELEVATOR AUTOMATIC RECALL SUCH THAT THE ELEVATOR RETURNS TO AN ALTERNATE FLOOR. PROVIDE ALL REQUIRED AUXILIARY CONTACTS AND RELAYS AT THE ELEVATOR CONTROL PANEL AND FIRE ALARM PANEL. ELECTRICAL CONTRACTOR TO COORDINATE ON SITE WITH LANDLORD AND ELEVATOR VENDOR FOR ALL REQUIREMENTS AND LOCATION OF EQUIPMENT. PROVIDE ALL REQUIRED FIRE ALARM VERIFICATION. ALL WORK TO COMPLY WITH CSA B44 LATEST EDITION TO THE SATISFACTION OF TSSA AND LOCAL AUTHORITIES HAVING JURISDICTION.
  2. CONFIRM ELECTRICAL REQUIREMENTS AND EXACT LOCATION OF ALL MECHANICAL EQUIPMENT WITH MECHANICAL DRAWINGS AND CONTRACTOR PRIOR TO ROUGH-INS.
  3. ROUTE ALL CONDUIT SYSTEMS AROUND DUCT WORK, BEAMS AND PIPING AS REQUIRED TO ACCOMMODATE LAYOUT SHOWN. REFER TO MECHANICAL DRAWINGS AND ARCHITECTURAL DRAWINGS FOR ADDITIONAL DETAILS.
  4. COORDINATE ALL WORK TO SUIT PROJECT PHASE SCHEDULE. COORDINATE PHASING WITH ARCHITECT/INTERIOR DESIGN/CGC DRAWINGS. PHASING IF SHOWN IS FOR REFERENCE PURPOSES ONLY.
- DRAWING NOTES:**
- (N-1) INCLUDE IN THE COST FOR XTALIS SITE VISIT TO CONFIRM EXISTING SITE CONDITIONS TO PREPARE DOCUMENTATION REQUIRED FOR ADJUSTMENT OF XTALIS SYSTEM.
  - (N-2) PROVIDE AUXILIARY CONTACTS IN SMOKE DETECTOR SUCH THAT IT CAN SEND A SIGNAL TO FIRE SHUTTER CONTROL PANEL. PROVIDE 120V CONNECTION TO FIRE SHUTTER AND INSTALL UPDOWN CONTROL KEY SWITCH ON WALL TO CONTROL FIRE SHUTTER. COORDINATE WIRING REQUIREMENTS WITH GC AND FINAL LOCATION OF SWITCH ON SITE WITH ARCHITECTS. COORDINATE THIS WORK WITH BASE BUILDING FIRE ALARM CONTRACTOR AND INCLUDE FOR FIRE ALARM VERIFICATION OF DEVICES AND TIE-INS. FIRE SHUTTER TO BE HELD OPEN DURING NORMAL OPERATION AND CLOSE IN EVENT OF FIRE ALARM ACTIVATIONS OR ADJACENT SMOKE DETECTOR.
  - (N-3) REFER TO POWER AND SYSTEMS DRAWINGS FOR AUTOMATIC DOOR OPERATOR LOCATION. SECURITY CONTRACTOR SHALL COORDINATE SECURITY ACCESS CONTROL WITH ADO DOORS.
  - (N-4) MODIFY EXISTING VESDA SMOKE DETECTION SYSTEM IN ATRIUM AS SHOWN AS WELL AS THE RELOCATION OF THE CONTROL PANEL. ELECTRICAL TO CONTACT XTALIS FOR REQUIRED SCOPE OF WORK AND TO INCLUDE ALL ASSOCIATED COSTS IN THE BID INCLUDING TESTING AND VERIFICATION.
  - (N-5) NEW DOP PANEL COMPATIBLE WITH BASE BUILDING FIRE ALARM SYSTEM. CONNECT TO EMERGENCY CIRCUIT.
  - (N-6) WALLS SHOWN IN THE HATCHED AREA ARE FOR REFERENCE ONLY. SPACE WILL BE IN SHELL CONDITION.

**Smith + Andersen**  
 1100 - 109 Sheppard Ave East, Toronto ON M2N 0N9  
 T 416-467-8151 | smithandandersen.com

**ENFORM architects**  
 ENFORM Architects Inc.  
 1284 Denison Street, Suite 302B  
 Toronto, Ontario, Canada M5R 2B7  
 T 416-593-7923  
 www.enformarchitects.com

UNIVERSITY OF TORONTO

PROJECT: HEALTH AND WELLNESS CENTRE RENOVATION AT KOFFLER

214 COLLEGE ST.  
 TORONTO, ON M5T 3A1

SHEET CONTENTS:  
**LEVEL 03 - FIRE ALARM & SECURITY PLAN**

PROJECT NUMBER:  
**21590.003**

DRAWING SCALE:  
**1 : 100**

DRAWN BY: Author  
 CHECKED BY: Checker  
 DATE: Issue Date

SHEET NO.: **E503**