

Addendum No: 5

McMaster University
Department of Facility Services
Design and Construction
1280 Main Street West
Hamilton, ON
L8S 4M3

Tel: 905 525 9140 Fax: 905 572 6990 Project: **RFQ-1202-2025**

Project Name: University Hall HVAC Upgrade

Project Number: 20020136 Date: September 4, 2025

Page: 1

This addendum forms a part of the RFQ documents and will be incorporated into the Contract Documents, as applicable. This addendum changes and shall govern over the referenced sections of the original RFQ documents or any previously issued addenda. Acknowledge receipt of this addendum on the quotation form. Failure to acknowledge receipt of addenda on the quotation form shall result in disqualification.

SECTION 1 – REQUEST FOR INFORMATION

Question 1:

Does each damper requires its own circuit?

Answer 1:

No, FSDs will share common circuit. Refer to MCW Addendum 03 for additional details.

Question 2:

Does each damper require its own circuit?

Answer 2:

No, FSDs will share common circuit. Refer to MCW Addendum 03 for additional details.

Question 3:

As per addendum 3, Please confirm the pipe freezing works at Basement Level, Level 1, Level 2, Level 3, and Attic Space are required to be performed during after-hours as pipe freezing work is obtrusive to surrounding occupants.

Answer 3:

If the pipe freezing work is obtrusive to surrounding occupants, it should be performed after hours.

Question 4:

As per addendum 3, Please confirm all the HVAC and Plumbing works at Basement Level, Level 1, Level 2, Level 3, and Attic Space are required to be performed during after-hours as the Classrooms and Offices are expected to be occupied between 7:00a.m. and 3:00p.m.

Answer 4:

Per the Space Availability Schedule included in Addendum No1 there are significant weeks of access being provided at the basement and attic levels in particular. Availability is also highlighted when classes are not in session. Please refer to the schedule for your coordination of the work.

Project: University Hall HVAC Upgrade

RFQ No.: RFQ-1202-2025

Page: 2 of 25



Question 5:

As per MCW Addendum 03, there is a previously provided schedule indicating localized restrictions for specific areas of work and also indicating the open blocks of time when full access to the building will be available in the tender document. Unfortunately we didn't find that schedule provided with the IFT package. Please provide the schedule.

Answer 5:

Refer to Addendum No.1 for the supplementary schedules.

Question 6:

Please confirm the crane lifting can be performed during the regular working hours.

Answer 6:

Care will need to be taken in coordination of all work to address noise and safety concerns when operating large equipment in and around an occupied building site. There are significant blocks of weeks in the proposed schedule when classes are not in session. The successful bidder will need to schedule the work to suit the site restrictions as presented.

Question 7:

Fire alarm spec says Mircom a bunch of times, but Mircom is saying they aren't in McMaster. Please clarify?

Answer 7:

Existing fire alarm system is Simplex-4100EX.

Question 8:

Please confirm if we need a 3rd party fire alarm verification in addition to standard manufacturers verification inspection.

Answer 8:

Yes, third-party verification is required. Refer to Electrical Specifications Section $26\ 70\ 01-3.07$ for more details.

Question 9:

Confirm if Power system protection coordination/Arc flash/short circuit studies are required.

Answer 9:

No, this is not required.

Project: University Hall HVAC Upgrade

RFQ No.: RFQ-1202-2025

Page: 3 of 25



Question 10:

Confirm integrated life safety test is required?

Answer 10:

Yes, the contractor shall participate in the integrated systems testing per the requirements of CAN/ULC-S1001-11, Integrated Systems Testing of Fire Protection and Life Safety Systems. Commissioning scope will be further clarified in MCW Addendum 03.

Question 11:

Are there any Seismic requirements for electrical installation?

Answer 11:

Yes, seismic restraint is required for this project.

Question 12:

Confirm Power shutdown and tie-in of electrical distribution can be completed from 3pm to 10pm shift?

Answer 12:

Utility shutdown procedures as noted in the RFQ and needs to be afterhours or within down time schedule provided.

Question 13:

Provide drawing scale for MCW electrical drawings.

Answer 13:

Scale has been reflected on drawings in MCW Addendum 03. Please note that all drawings are for diagrammatic purposes only and should not be scaled. Final sizes and locations of all equipment with respect to building features and one another are the responsibility of the installing contractor.

Question 14:

Note#1 E2.01: Confirm if new stem is required only for R/R lights.

Answer 14:

Not required. Existing suspension kits shall be reused for all R/R light fixtures.

Question 15:

Note#1 E2.01: Confirm if new stem is required for existing to remain lights.

Answer 15:

Not required.

Project: University Hall HVAC Upgrade

RFQ No.: RFQ-1202-2025

Page: 4 of 25



Question 16:

Provide 120V power source for EF-1 and EF-2. Drawing doesn't show where is it fed from?

Answer 16:

Not a part of this scope.

Question 17:

Provide fire alarm riser diagram showing number of new zones and tie-in points.

Answer 17:

Extend existing fire alarm circuit to accommodate the new devices to suit. All newly installed devices shall be aligned with the existing fire alarm zoning for each floor at the site.

Question 18:

Confirm if all FSD in one floor can be on the same fire alarm zone.

Answer 18:

Extend existing fire alarm circuit to accommodate the new devices to suit. All newly installed devices shall be aligned with the existing fire alarm zoning for each floor at the site.

Question 19:

Are we picking up fire alarm circuits locally available in the respective floor?

Answer 19:

Extend existing fire alarm circuit to accommodate the new devices to suit. All newly installed devices shall be aligned with the existing fire alarm zoning for each floor at the site.

Question 20:

Do we need to pull new fire alarm circuits from FACP?

Answer 20:

No.

Question 21:

Confirm if all fire alarm wiring needs to be Class-A.

Answer 21:

Based on the existing drawings, the existing initiation zone wiring is connected as "Addressable Class-B" circuit.

Project: University Hall HVAC Upgrade

RFQ No.: RFQ-1202-2025

Page: 5 of 25



Question 22:

E2-01: Confirm if new stem replacement is still required in basement. Note#1 is not deleted even though corridor lights are now existing to remain.

Answer 22:

Not required.

Question 23:

Confirm light stem replacement is not required for existing to remain lights.

Answer 23:

Not required.

Question 24:

Provide specifications for the new light stem required.

Answer 24:

Not required.

Question 25:

E2-02 shows two new exist lights in corridor near "room 180". Are they new? Please elaborate scope.

Answer 25:

Exit lights were shown for reference, which will be removed from the drawings in the upcoming MCW Addendum 03.

Question 26:

Confirm if loose disconnects for mechanical equipment needs to be supplied and installed by electrical.

Answer 26:

ERV-1 is provided with factory-installed disconnect. Provide other disconnects/toggle switches for all other Mechanical equipment to suit.

Question 27:

Confirm location of riser shaft for the building where feeders from lower floors can reach devices on floors above.

Answer 27:

Proposed route for feeder(s) from the lower floors to reach the upper floor / attic are a part of MCW Addendum 03.

Project: University Hall HVAC Upgrade

RFQ No.: RFQ-1202-2025

Page: 6 of 25



SECTION 2 – RFQ AMENDMENTS

MCW Addendum No. 03

- -2025-09-04 ADD-03 Narrative
- -Specification Section 26 05 03 Electrical Systems Commissioning
- -2025-09-04-MCMASTER UNIVERSITY HALL MDWG ISSUED FOR ADD-03
- -2025-09-04-MCMASTER UNIVERSITY HALL EDWG ISSUED FOR ADD-03 End of Addendum 5



Addendum

Date: September 4, 2025

Queen's Quay Terminal 207 Queen's Quay West, Suite 615 Toronto, Ontario M5J 1A7 Phone 416-598-2920 Fax 416-598-5394

www.mcw.com

Project Name: McMaster University – University Hall Ventilation Upgrade

Client: McMaster University

Project #: 22227B

To: +VG Architects

ADD #: 03

Attention: Ed Shuck

From: Tareq Nassar

ADD #: 03

Page #: 1 of 2

+ Attachment

Distribution: David MacKeracher – MCW <u>DMacKeracher@mcw.com</u>

Jawwad Ahmed – MCW
Peera Butrsingkorn – MCW

Kevin Church – +VG

Palamed@mcw.com
Peera@mcw.com
KChurch@plusvg.com

In accordance with the drawings and specifications, provide in the tender all costs required to complete the work including items as listed below.

Title: Mech/Elec Addendum 03

Reason for Change: Revisions to capture additional addendum questions

Specifications:

Section #	Revisions
26 05 03	Added section for Electrical Systems Commissioning to outline commissioning requirements.

Mechanical Drawings:

Drawing #	Revisions
M2.1	Added note to include for temporary removal and reinstallation of surface mounted devices to accommodate modifications to shafts.
M2.2	Added note to include for temporary removal and reinstallation of surface mounted devices to accommodate modifications to shafts.
M2.3	Added note to include for temporary removal and reinstallation of surface mounted devices to accommodate modifications to shafts.

Electrical Drawings:

Drawing #	Revisions
E0-01	Added general notes for the existing Fire Alarm System on site.
E2-01	 Removed note - 1 related to mounting kits for light fixtures. Updated notes - 5 & 6 to clarify wiring intent for new Fire Alarm devices.
E2-02	 Removed note - 1 related to mounting kits for light fixtures. Added note - 5 to rework the existing surface mounted raceway for Room-107. Added notes - 8 & 9 to clarify wiring intent for new Fire Alarm devices.



Project Name: McMaster University – University Hall Ventilation Upgrade

Client: McMaster University

Project #: 22227B

ADD #: 03 Page #: 2 of 2

+ Attachment

Electrical Drawings:

Drawing #	Revisions
E2-03	 Removed note - 1 related to mounting kits for light fixtures. Added note - 5 to rework the existing surface mounted raceway for Room-207. Added notes - 8 & 9 to clarify wiring intent for new Fire Alarm devices.
E2-04	 Removed note - 1 related to mounting kits for light fixtures. Added note - 5 to rework the existing surface mounted raceway for Room-309. Added notes - 8 & 9 to clarify wiring intent for new Fire Alarm devices.
E2-05	 Added notes - 3 & 4 to clarify wiring intent for new Fire Alarm devices. Added note - 5 to propose a route for the new attic splitter feeder fed from basement.

End of ADD # 03

CONTENTS

PART 1 -	GENERAL

- 1.01 REFERENCES
- 1.02 SCOPE OF WORK
- 1.03 COORDINATION
- 1.04 QUALITY ASSURANCE

PART 2 - PRODUCTS

2.01 NIL

PART 3 - EXECUTION

- 3.01 DESIGN AND PERFORMANCE REQUIREMENTS
- 3.02 RECORD DOCUMENTATION
- 3.03 START-UP
- 3.04 TROUBLESHOOTING
- 3.05 OPERATIONAL TESTING
- 3.06 DEMONSTRATION AND TRAINING
- 3.07 OPERATING AND MAINTENANCE MANUALS
- 3.08 "AS-CONSTRUCTED" DRAWINGS
- 3.09 COMPLETION
- 3.10 COMMISSIONING TESTS
- 3.11 POST OCCUPANCY EVALUATION
- 3.16 CABLES, LOW-VOLTAGE, 600-VOLT MAXIMUM
- 3.18 DEMONSTRATION AND TRAINING



PART 1 - GENERAL

1.01 REFERENCES

.1 Comply with Section 26 05 00, Electrical General Requirements and all documents referred to therein.

1.02 SCOPE OF WORK

- .1 The Electrical Consultant is not acting as Commissioning Agent or Commissioning Authority and is not responsibility for developing Commissioning Plans, manage and administer the commissioning process.
- .2 A Cash Allowance has been identified for the retention of a Commissioning Agent to assist the contractor in developing a Commissioning Plan, manage and administer the commissioning process.
- .3 The Contractor shall provide all services, materials and labour required to fully Commission the Electrical Systems as specified herein.
- .4 The Contractor shall provide all services, materials and labour required to successfully complete Functional Performance Testing of the Electrical Systems as part of Commissioning the overall building systems as a holistic operation. Functional Performance Testing shall be as defined in CSA Z320.
- .5 The Contractor shall participate in the integrated systems testing per the requirements of CAN/ULC-S1001-11, Integrated Systems Testing of Fire Protection and Life Safety Systems.
- .6 Equipment Suppliers and Vendors are expected to support the Contractor complete Electrical Commissioning Specified in this Section. Support may come in the form of attendance on site to verify correct installation, performance, trouble shooting, training and final documentation at turnover. The Contractor shall ensure Equipment Suppliers and Vendors provide the support necessary for successful Electrical Commissioning.

1.03 COORDINATION

.1 Appoint a single person as Commissioning Coordinator who shall be responsible for advancing the commissioning activities of the Electrical Division.

1.04 QUALITY ASSURANCE

- .1 The following Standards shall be used to guide the commissioning process:
 - .1 CSA Z320-11 (R2016) Building Commissioning
 - .2 CAN/ULC-S1001-11 Integrated Systems Testing of Fire Protection and Life Safety Systems
 - .3 CAN/ULC-S537-13 Standard For Verification of Fire Alarm Systems
 - .4 CSA C282-15 Emergency Electrical Power Supply For Buildings
- .2 Hold and attend regular meetings during the commissioning process. Prepare detailed progress reports to coincide with regular commissioning meetings.
- .3 In addition to all tests listed under this section, the Electrical Division shall complete its own tests and any additional tests required by the Owner or the Commissioning Agent of Authority having jurisdiction over the work to ensure the equipment operates as intended.

PART 2 - PRODUCTS

2.01 NIL

PART 3 - EXECUTION

3.01 DESIGN AND PERFORMANCE REQUIREMENTS

- .1 Provide a schedule with regular updates for the completion of Electrical Division equipment and systems.
- .2 Six (6) weeks prior to the target Substantial Performance date, submit a detailed and comprehensive installation completion/ start-up/ testing schedule. Update the schedule and resubmit for review, on a bi-weekly basis, during the course of Commissioning. Provide regular revisions and updates to the schedule to suit the updated construction schedule. This schedule shall include, but is not limited to the following items:
 - .1 Low voltage distribution panels
 - .2 Low voltage branch circuit panels
 - .3 Low voltage cables
 - .4 Grounding & bonding
 - .5 Interior lighting & control
 - .6 Fire alarm system
 - .7 Fire alarm system interface & control
 - .8 Mechanical service electrical connections
 - .9 Start-up of various equipment and systems
 - .10 Operational testing of system components
 - .11 Performance testing of equipment and systems
 - .12 Acceptance testing of equipment installations and systems by Authorities Having Jurisdiction ("AHJs") and the Owner's insurance company
 - .13 Troubleshooting
 - .14 Calibration of controls and point checkout
 - .15 Control software setup and checkout
 - .16 Submittal of completed equipment and system checkout sheets
 - .17 Demonstration of systems and equipment
 - .18 Maintenance manual preparation and submittal
 - .19 Operator training program
 - .20 Record documentation submittal

3.02 RECORD DOCUMENTATION

- .1 Prepare record documentation for each equipment installation covering:
 - .1 Equipment identification and supplier
 - .2 Shop Drawing submittal, review, production release, and delivery dates
 - .3 Dates for completion of all work required to prepare for equipment installation
 - .4 Dates for equipment installation, supplier prestart checkout and system availability for start-
 - Dates for equipment start-up, performance testing, proposal for temporary use, acceptance testing, demonstration, turnover and warranty start/finish
 - .6 List all specialist personnel and equipment required for the test and ensure that these are available by the test date.

- .7 Provide documentation of the commissioning process for inclusion into the maintenance manuals. These are to include checkout sheets, equipment data sheets, start-up certificates from suppliers involved in start-up, documentation concerning demonstration to the Owner. Include all records and result sheets from commissioning tests.
- .8 Maintain a log of key operating parameters, problems encountered, solutions employed and verification of effectiveness of solutions. Include log in maintenance manuals.

3.03 START-UP

- .1 Coordinate and supervise the start-up of the various pieces of equipment and systems. Utilize the start-up services of the manufacturer's representative. Ensure that the equipment is operating in a satisfactory manner. Check the following items:
 - .1 Initial site energization
 - .2 Voltage measurements
 - .3 Phase rotation
 - .4 Thermographic survey/report
 - .5 Load balance
 - .6 Temperature measurements and liquid sampling for transformers where applicable
 - .7 Visual inspections post energization
- .2 Prior to the equipment start-up, arrange to have the Manufacturer of all major equipment inspect the installation to ensure their equipment has been installed in accordance with their recommendations.
- .3 Functional testing is intended to begin upon successful completion of start-up. Functional testing may proceed prior to the completion of systems or sub-systems at the discretion of the Owner and the Owner's Commissioning Consultant. Beginning system functional testing prior to full completion does not relieve the Electrical Division from fully completing the system, including all start-up checklists.

3.04 TROUBLESHOOTING

- .1 Resolve inter-Division coordination problems.
- .2 Where problems become apparent during the commissioning process, identify and resolve these problems. The basic functions of troubleshooting include:
 - .1 Identify and define the problems
 - .2 Determine and evaluate the causes
 - .3 Determine the time available to resolve the problem
 - .4 Involve the designing authority in the review of the problem and proposed resolution
 - .5 Coordinate remedial action with the appropriate parties
 - .6 Evaluate the effectiveness of the remedial action
 - .7 Record the problem, cause, remedial action and result

3.05 OPERATIONAL TESTING

- .1 Test the operation of the individual components and systems. Go through each step of the sequence of operation and verify that each component operates correctly. Direct and ensure that all trades involved make the required changes and adjustments to effect the proper operation of all components and systems. Meet commissioning test requirements.
- .2 Document the operation and testing.
- .3 Ensure operational tests are completed for all seasons and modes of operation.

.4 For any systems and assemblies where some testing has been deferred, coordinate seasonal commissioning for those systems that have been functionally tested and handed over in seasons where retesting and commissioning will be required during the opposite season.

3.06 DEMONSTRATION AND TRAINING

- .1 Demonstrate to the operating staff the proper operation of all Electrical equipment and systems. Demonstrations shall occur only after the operation and testing has been successfully completed. Ensure that all affected Electrical Division Trade Contractor(s) and equipment suppliers participate in the demonstrations as required.
- .2 Thoroughly instruct the operating staff in the safe and efficient operation and maintenance of all systems and equipment.
- .3 Provide designated operating personnel with comprehensive orientation and training in the understanding of the systems and the operation and maintenance of each piece of Electrical equipment including, but not limited to, pumps, boilers, chillers, heat rejection equipment, air conditioning units, air handling units, fans, terminal units, controls and water treatment systems, fuel systems and other Electrical systems.
- .4 Training shall normally start with classroom sessions followed by hands-on training on each piece of equipment, which shall illustrate the various modes of operation, including start-up, shutdown, fire/smoke alarm, power failure, and other similar modes of operation.
- .5 During any demonstration, should the system fail to perform in accordance with the requirements of the O&M manual or sequence of operations, the system will be repaired or adjusted as necessary and the demonstration repeated.
- .6 The appropriate trade or manufacturer's representative shall provide the instructions on each major piece of equipment. This person may be the start-up technician for the piece of equipment, the installing contractor or manufacturer's representative.
- .7 Practical building operating expertise as well as in-depth knowledge of all modes of operation of the specific piece of equipment is required. More than one party may be required to execute the training.
- .8 The training sessions shall follow the outline in the Table of Contents of the operation and maintenance manual and illustrate whenever possible the use of the O&M manuals for reference.
- .9 Training shall include:
 - .1 Use of the printed installation, operation and maintenance instruction material included in the O&M manuals.
 - .2 A review of the written O&M instructions emphasizing safe and proper operating requirements, preventative maintenance, special tools needed and spare parts inventory suggestions. The training shall include start-up, operation in all modes possible, shutdown, seasonal changeover and any emergency procedures.
 - .3 Discussion of relevant health and safety issues and concerns.
 - .4 Discussion of warranties and guarantees.
 - .5 Common troubleshooting problems and solutions.
 - .6 Explanatory information included in the O&M manuals and the location of all plans and manuals in the facility.
 - .7 Discussion of any peculiarities of equipment installation or operation.
 - .8 Classroom sessions shall include the use of overhead projections, slides, video/audio-taped material as might be appropriate.

- .9 Hands-on training shall include start-up, operation in all modes possible, including manual, shut-down and any emergency procedures and preventative maintenance for all pieces of equipment.
- .10 The Electrical contractor shall fully explain and demonstrate the operation, function and overrides of any local packaged controls, not controlled by the central control system.
- .11 During any demonstration or hands-on training, should the system fail to perform in accordance with the requirements of the O&M manual or sequence of operations, the system will be repaired or adjusted as necessary and the demonstration repeated.

3.07 OPERATING AND MAINTENANCE MANUALS

.1 Ensure that O&M Manuals are complete in accordance with the requirements of Section 26 05 00.

3.08 "AS-CONSTRUCTED" DRAWINGS

.1 Ensure that Electrical Trade(s) "As-constructed" drawings have been produced and that they accurately reflect the completed Electrical systems.

3.09 COMPLETION

- .1 Confirm completion of all Electrical Work, including, but not limited to:
 - .1 Removal of all debris from inside Electrical systems and equipment.
 - .2 Compliance with manufacturer's written instructions.
 - .3 Removal of all temporary protection and covers.
 - .4 Record all settings of devices, equipment and systems.

3.10 COMMISSIONING TESTS

- .1 Factory tests/verification documents
- .2 Field electrical tests
- .3 Field test values
- .4 Operation of control circuits
- .5 Operation of trip circuits
- .6 Safety interlocks and operations
- .7 Demonstrate access to all junction boxes per code for servicing.
- .8 Verify the operation of all Electrical equipment.
- .9 Verify that interfacing to the work of other Divisions results in complete and operational systems.

3.11 POST OCCUPANCY EVALUATION

- .1 The post-occupancy evaluation period shall run for one full year following occupancy of the facility. The Commissioning Coordinator shall meet regularly with the operating staff throughout this period to review the operation of all Electrical systems and equipment. The Commissioning Coordinator shall provide written advice regarding guestions and concerns raised by the operating staff.
- .2 Resolutions of operational problems shall, where appropriate, be used to modify the Operation and Maintenance Instructions for the equipment and systems involved.

.3 Identify areas that may come under warranty and conduct a review of condition and operation. Seek remedy under warranty for any outstanding issues and problems before end of warranty period.

3.12 CABLES, LOW-VOLTAGE, 600-VOLT MAXIMUM

- .1 Visual and Mechanical Inspection
 - .1 Inspect compression-applied connectors for correct cable match and indentation.

.2 Electrical Tests

- .1 Perform an insulation-resistance test on each conductor with respect to ground and adjacent conductors. The applied potential shall be 500 volts dc for 300-volt rated cable and 1000 volts dc for 600-volt rated cable. The test duration shall be one minute.
- .2 Verify uniform resistance of parallel conductors.

.3 Test Values


- .1 Test Values Electrical
 - .1 Insulation-resistance values should be comparable to similar circuits but not less than two megohms.
 - .2 Deviations in resistance between parallel conductors shall be investigated.

3.13 DEMONSTRATION AND TRAINING

- Demonstrate to the operating staff the proper operation of all Electrical equipment and systems. Demonstrations shall occur only after the operation and testing has been successfully completed. Ensure that all affected Electrical Division Trade Contractor(s) and equipment suppliers participate in the demonstrations as required.
- .2 Thoroughly instruct the operating staff in the safe and efficient operation and maintenance of all systems and equipment.
- .3 Provide designated operating personnel with comprehensive orientation and training in the understanding of the systems and the operation and maintenance of each piece of Electrical equipment.
- .4 Training shall normally start with classroom sessions followed by hands-on training on each piece of equipment, which shall illustrate the various modes of operation, including start-up, shutdown, fire/smoke alarm, power failure, and other similar modes of operation.
- During any demonstration, should the system fail to perform in accordance with the requirements of the O&M manual or sequence of operations, the system will be repaired or adjusted as necessary and the demonstration repeated.
- .6 The appropriate trade or manufacturer's representative shall provide the instructions on each major piece of equipment. This person may be the start-up technician for the piece of equipment, the installing contractor or manufacturer's representative.
- .7 Practical building operating expertise as well as in-depth knowledge of all modes of operation of the specific piece of equipment is required. More than one party may be required to execute the training.
- .8 Training shall include:
 - .1 Use of the printed installation, operation and maintenance instruction material included in the O&M manuals.

- .2 A review of the written O&M instructions emphasizing safe and proper operating requirements, preventative maintenance, special tools needed and spare parts inventory suggestions. The training shall include start-up, operation in all modes possible, shutdown, seasonal changeover and any emergency procedures.
- .3 Discussion of relevant health and safety issues and concerns.
- .4 Discussion of warranties and guarantees.
- .5 Common troubleshooting problems and solutions.
- .6 Explanatory information included in the O&M manuals and the location of all plans and manuals in the facility.
- .7 Discussion of any peculiarities of equipment installation or operation.
- .8 Classroom sessions shall include the use of overhead projections, slides, video/audio-taped material as might be appropriate.
- .9 Hands-on training shall include start-up, operation in all modes possible, including manual, shut-down and any emergency procedures and preventative maintenance for all pieces of equipment.
- .10 The Electrical contractor shall fully explain and demonstrate the operation, function and overrides of any local packaged controls, not controlled by the central control system.

END OF SECTION 26 05 03

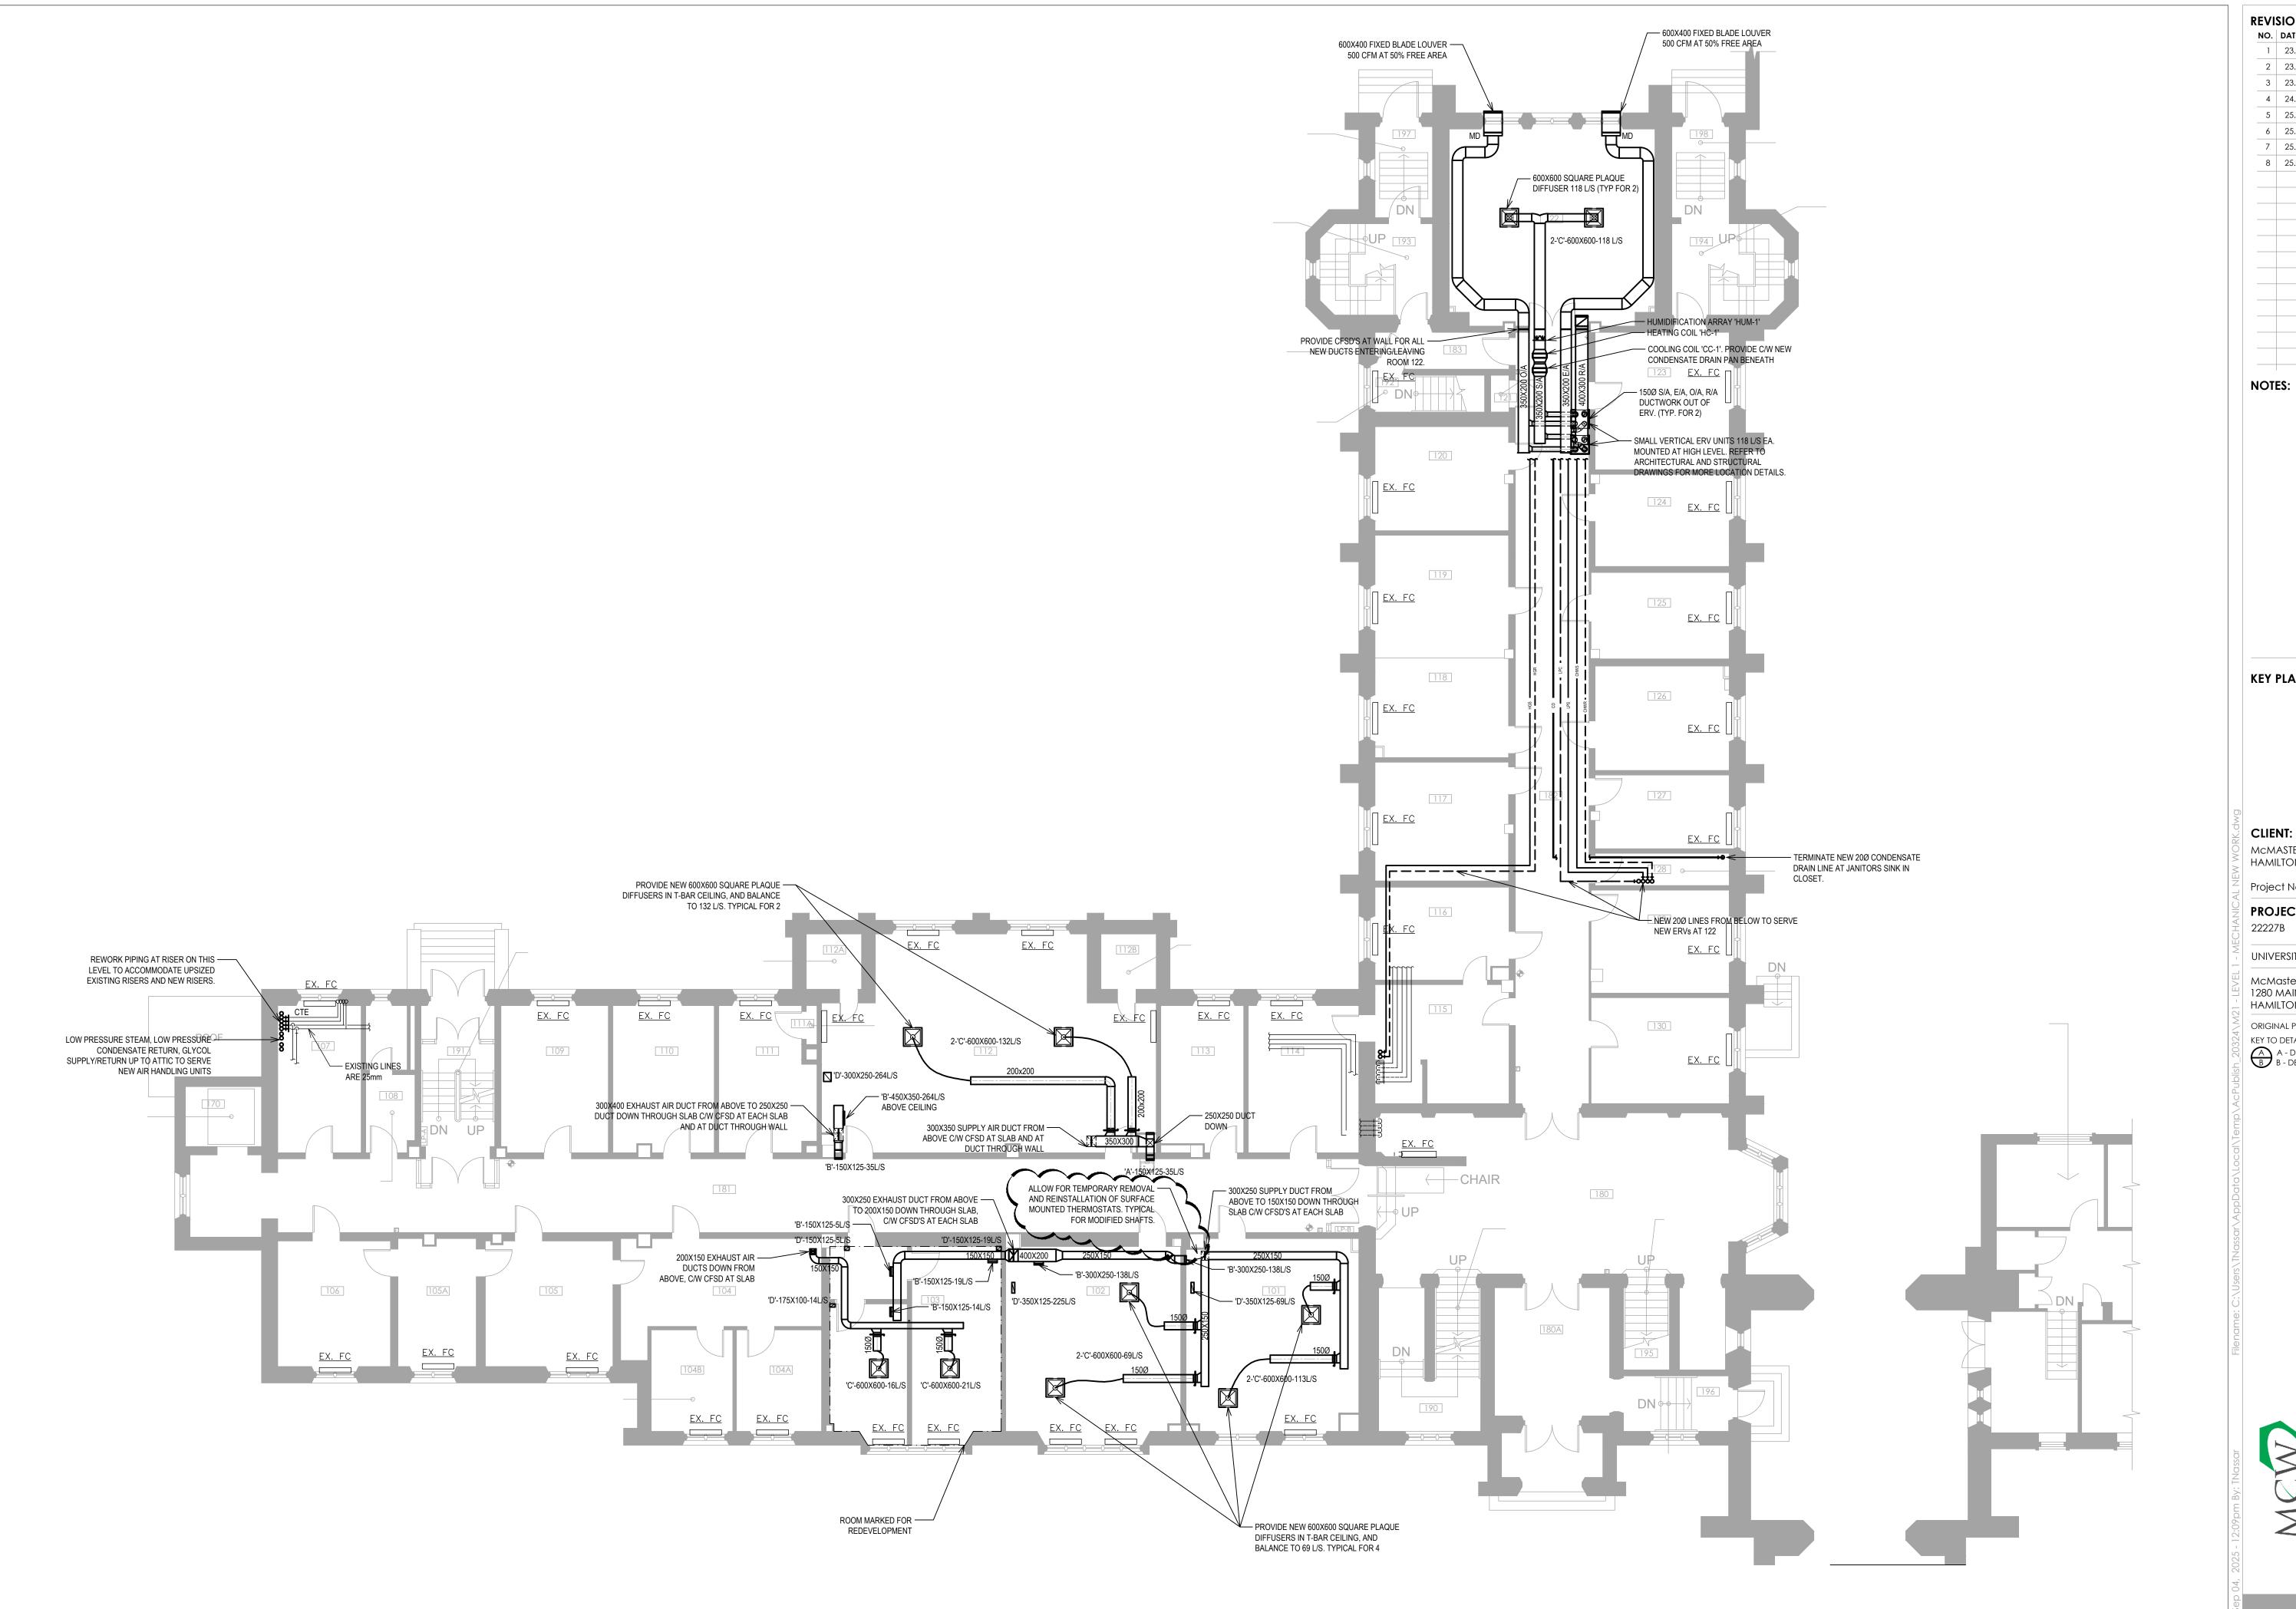

REVISIONS NO. DATE PARTICULAR 1 23.01.25 ISSUED FOR COORDINATION REVIEW 2 23.03.08 ISSUED FOR 50% DD REVIEW 3 23.04.24 ISSUED FOR 90% DD REVIEW 4 24.04.10 ISSUED FOR PRE-TENDER REVIEW 5 25.07.04 ISSUED FOR PERMIT 6 25.08.05 ISSUED FOR TENDER 7 25.08.22 ISSUED FOR ADDENDUM 01 8 25.09.04 ISSUED FOR ADDENDUM 03 NOTES:

KEY PLAN:



HAMILTON, ONTARIO Project No. 22227B

PROJECT:

22227B


UNIVERSITY HALL VENTILATION UPGRADE

McMaster University Campus 1280 MAIN ST. W. HAMILTON, ON L8S 4K1

ORIGINAL PAGE SIZE ARCH D - 24" x 36" KEY TO DETAIL LOCATION:


A - DETAIL NO. B - DETAIL NO. ORIGIN



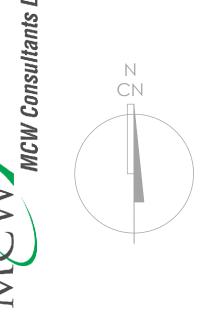

M2.1


DRAWN BY: TN CHECKED BY: TN

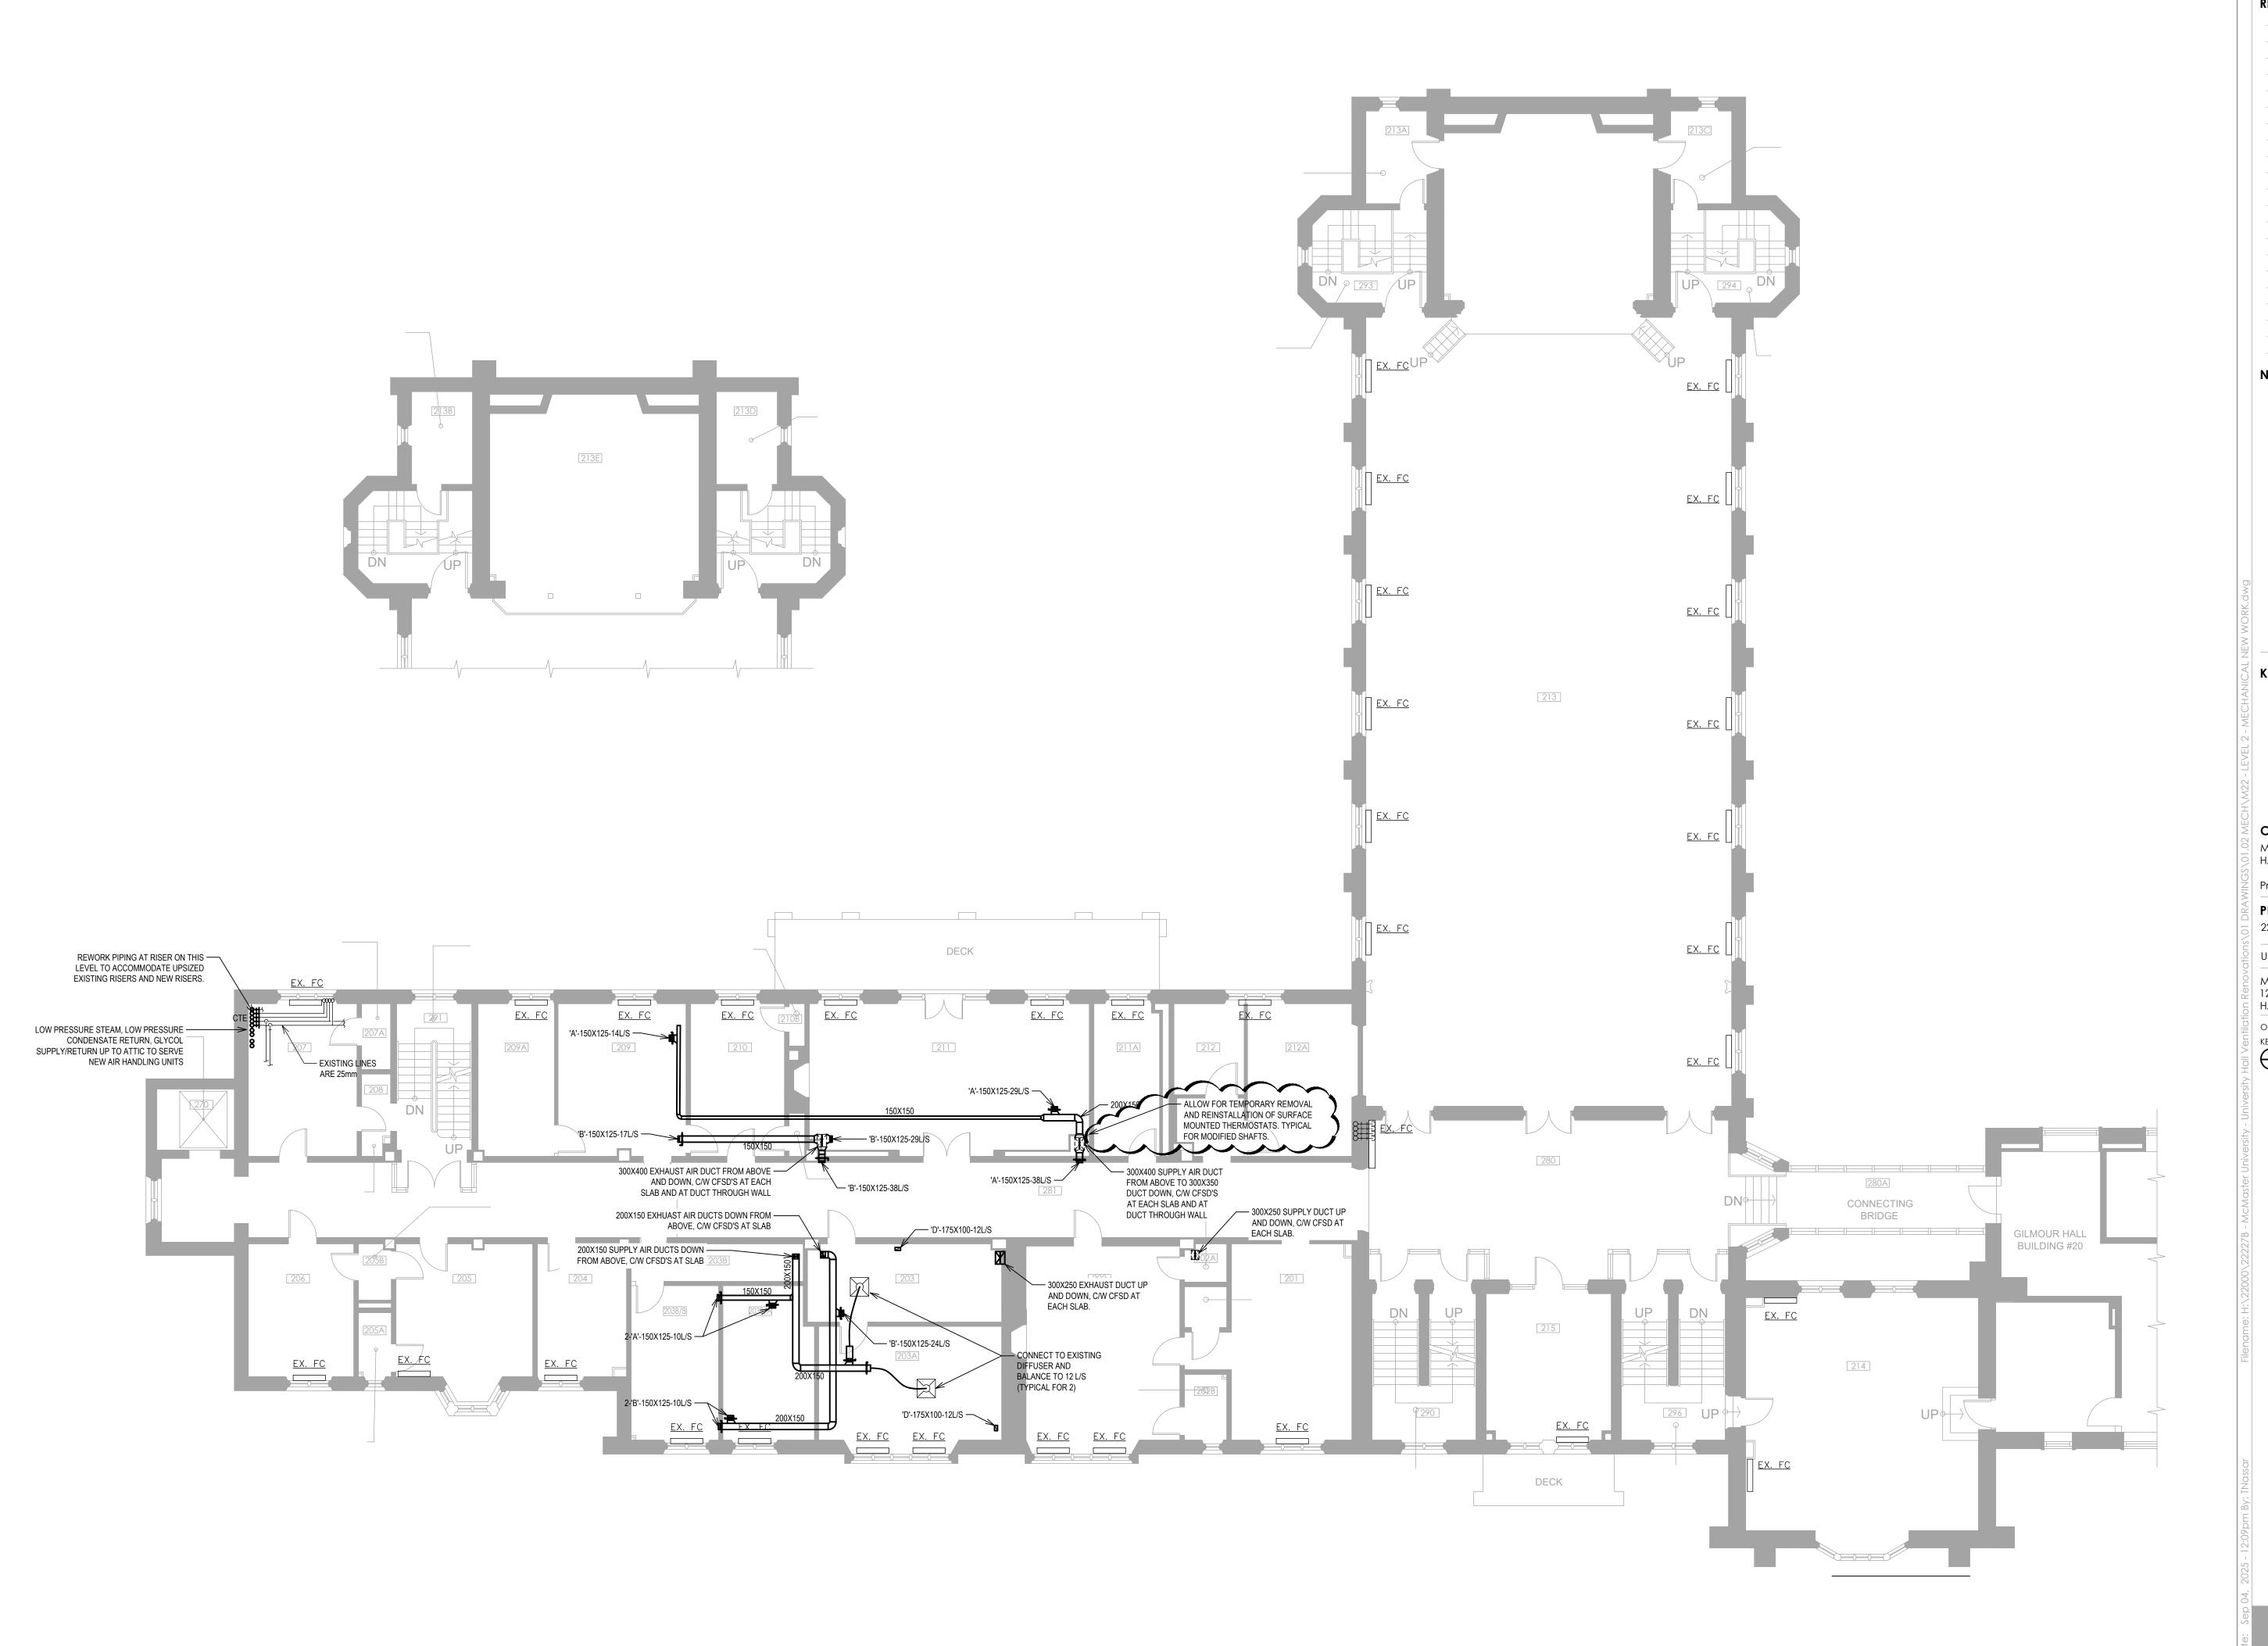




, , , _ , _

DRAWN BY: TN CHECKED BY: TN

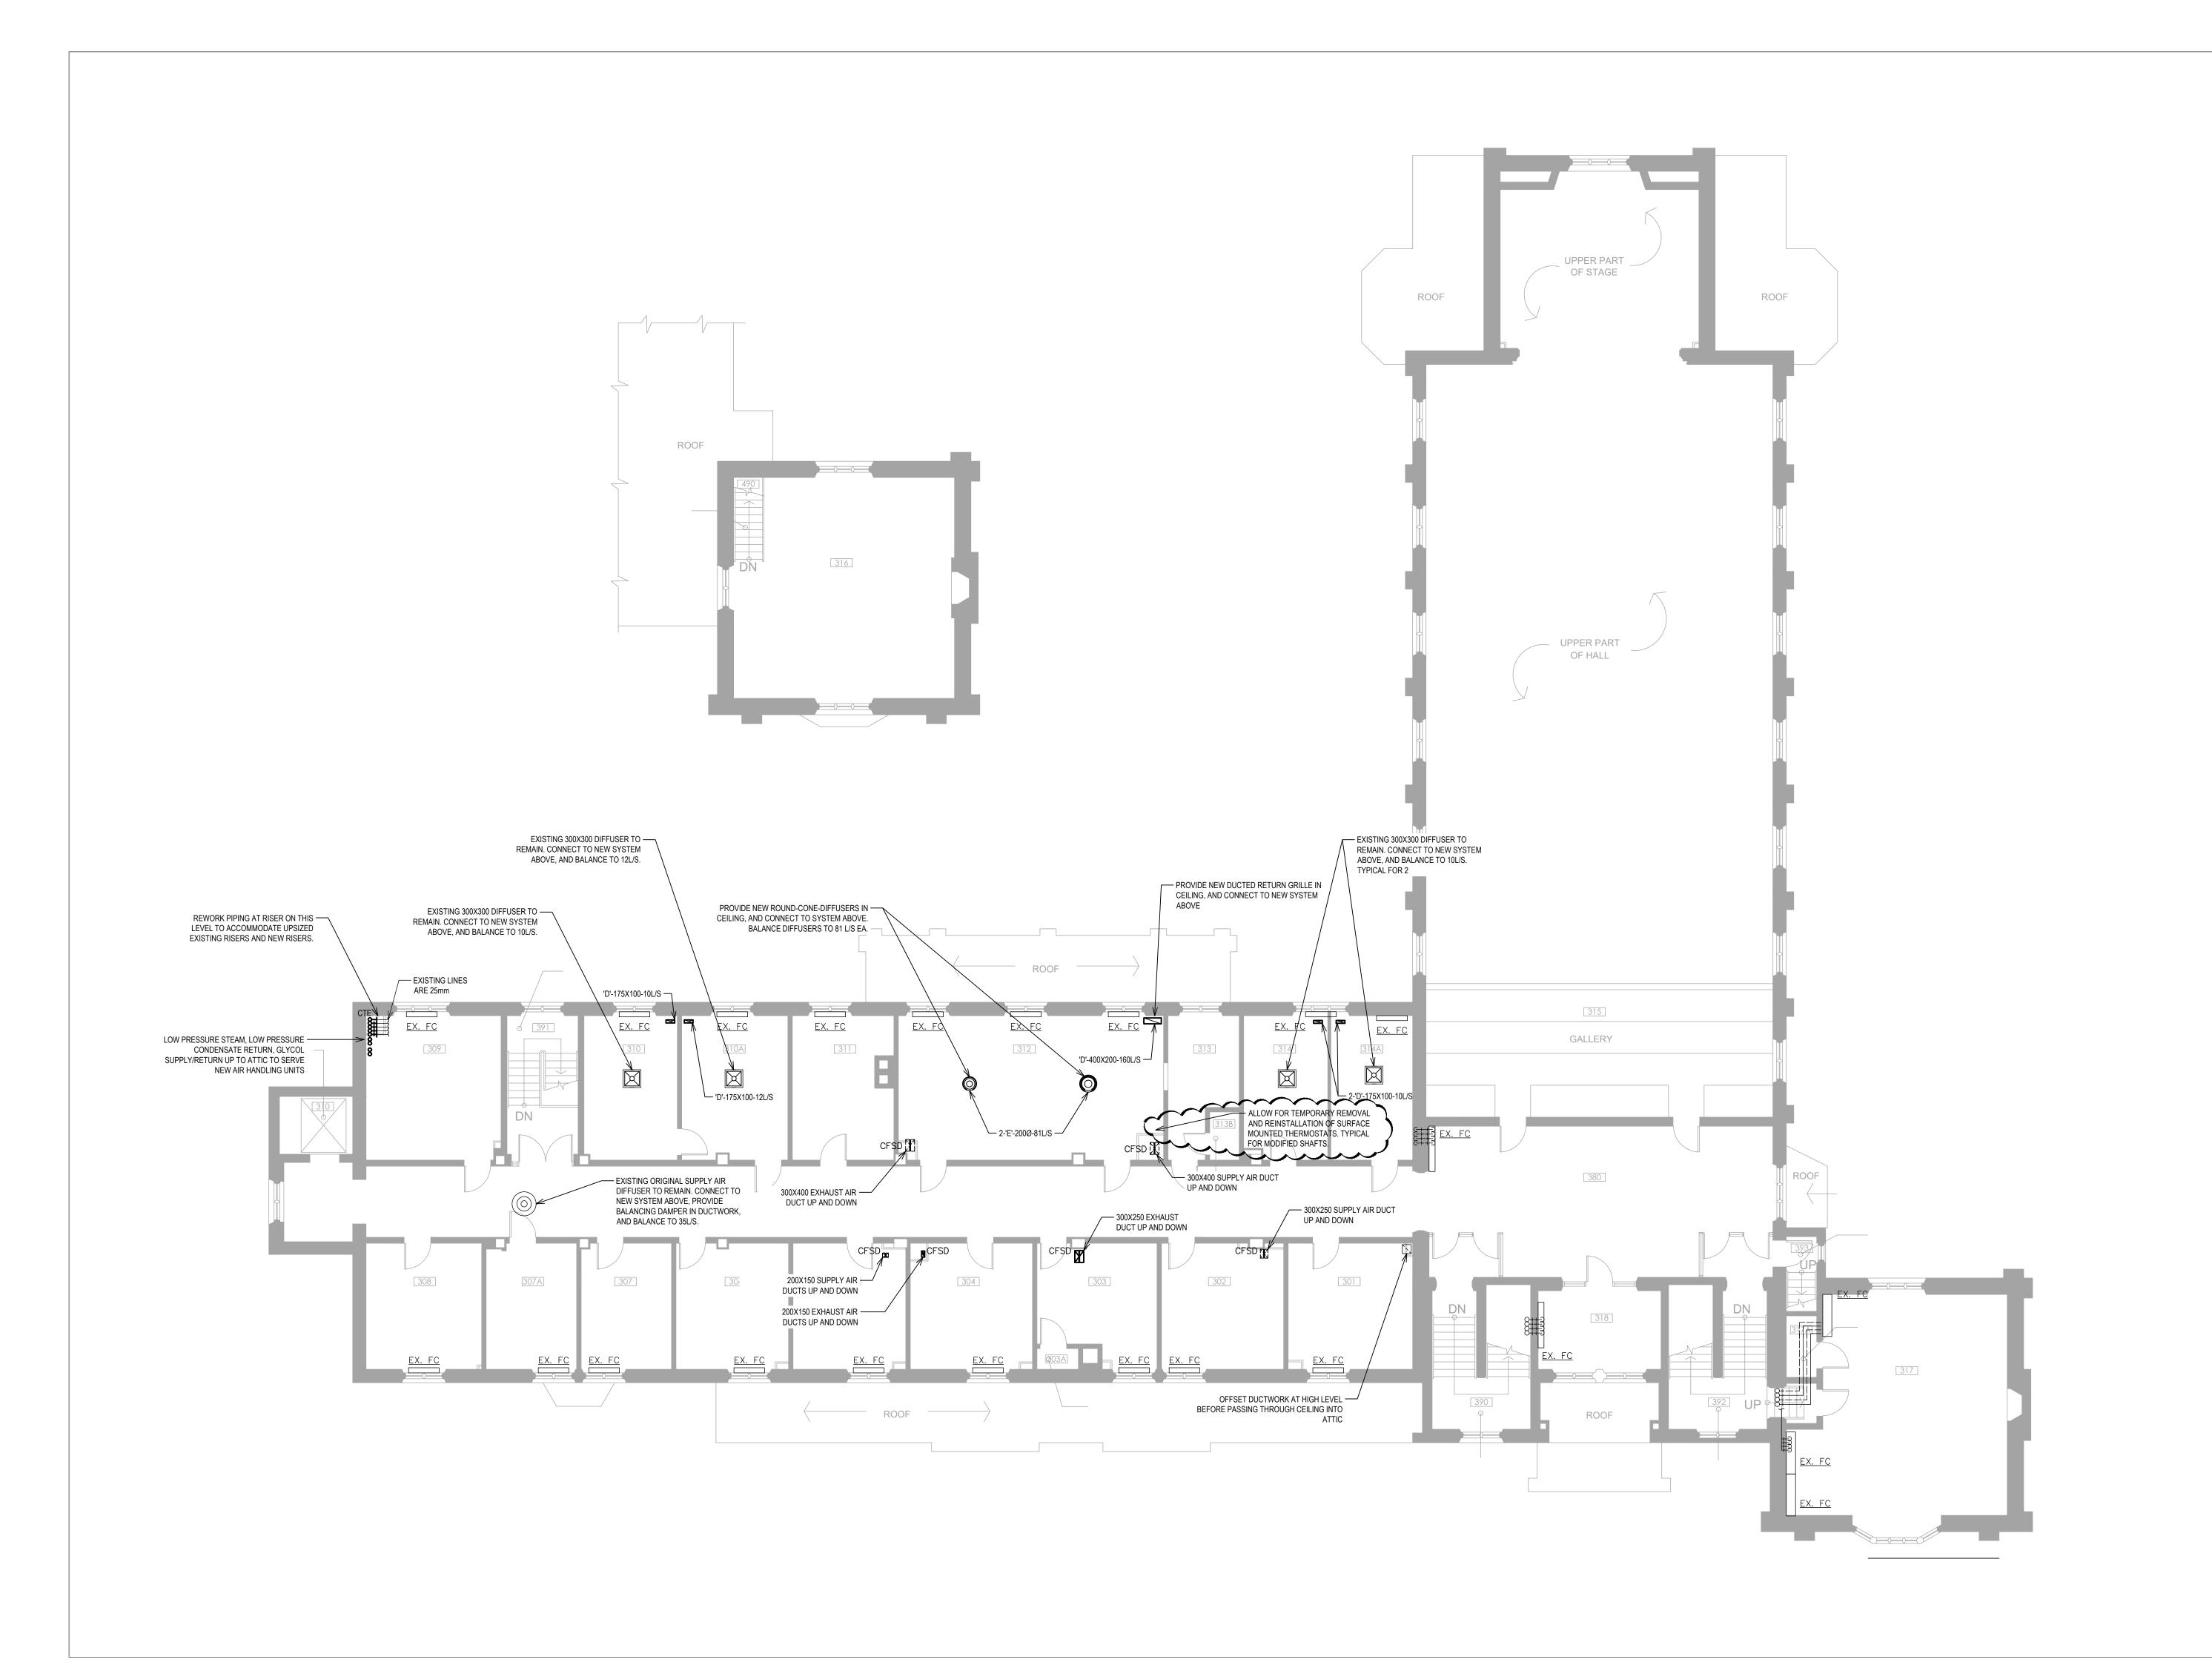

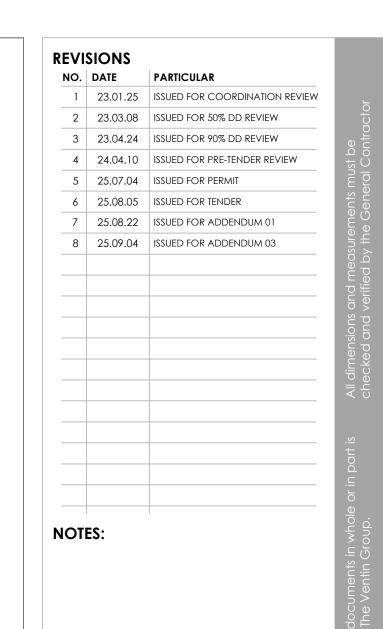

KEY PLAN:



McMaSTER UNIVERSITY HAMILTON, ONTARIO

CLIENT:

Project No. 22227B

PROJECT: 22227B

UNIVERSITY HALL VENTILATION UPGRADE

McMaster University Campus 1280 MAIN ST. W.

HAMILTON, ON L8S 4K1
ORIGINAL PAGE SIZE ARCH D - 24" x 36"

KEY TO DETAIL LOCATION:

A - DETAIL NO.
B - DETAIL NO. ORIGIN

B B - DETAIL NO. O

V MCW Consultants 1 td

MCW Consultani

LEVLE 3 - MECHANICAL NEW WORK

M2.3

DRAWN BY: TN CHECKED BY: TN

LINEAR LUMINAIRE - RECESSED HATCHING DENOTES EMERGENCY / NIGHT LIGHTING (TYP.)

LINEAR LUMINAIRE - SURFACE MOUNTED

LINEAR LUMINAIRE - SUSPENDED

STRIP LUMINAIRE - CEILING MOUNTED

STRIP LUMINAIRE - WALL MOUNTED CEILING MOUNTED LUMINAIRE: NORMAL / NIGHT LIGHTING

WALL MOUNTED LUMINAIRE: NORMAL / NIGHT LIGHTING

POLE MOUNTED LUMINAIRE

DOUBLE SURFACE MOUNTED EMERGENCY LIGHTING - REMOTE HEADS CEILING MOUNTED EMERGENCY LIGHTING REMOTE HEAD

EMERGENCY LIGHTING BATTERY UNIT C/W DUPLEX RECEPTACLE AND DOUBLE BB# REMOTE HEADS. EXIT LIGHTING: SHADED AREAS DENOTE DIRECTION OF FACE OF EXIT SIGN.

DIRECTIONAL ARROWS AS INDICATED.

WALL MOUNTED DOUBLE FACED EXIT LIGHT WALL MOUNTED SINGLE FACED EXIT LIGHT

CEILING MOUNTED DOUBLE FACED EXIT LIGHT

CEILING MOUNTED SINGLE FACED EXIT LIGHT

SECURITY AND ACCESS SYSTEMS

CP SECURITY SYSTEM CONTROL PANEL

KP KEY PAD

CR CARD READER

IR INFRARED READER EB REQUEST TO EXIT BUTTON

EM EGRESS MOTION DETECTOR

DC DOOR CONTACT PC PATIO DOOR CONTACT

WC WINDOW CONTACT

OD OVERHEAD DOOR CONTACT PL POWER LOCK

ES ELECTRIC STRIKE

AA AUDIBLE ALARM

GD GLASS BREAK DETECTOR

AUTOMATIC DOOR OPENER

CLOSED CIRCUIT CAMERA:

MD MOTION DETECTOR

'B' - DENOTES BOX ENCLOSURE 'E' - DENOTES ELEVATOR CORNER MOUNT 'P' - DENOTES PEDESTAL MOUNT 'PTZ' - DENOTES PAN TILT ZOOM 'W' - WEDGE ENCLOSURE

M SECURITY SYSTEM MONITOR

ML MAGLOCK DEVICE \$ MAGLOCK RESET SWITCH

KS KEY SWITCH

CB CODE BLUE SPEAKER PHONE CODE BLUE INTEGRATED UNIT C/W ACCESSORIES, POLE OR PEDESTAL

ALARM SOUNDER

PA PANIC ALARM BUTTON

NURSE CALL SYSTEM BM BED MONITOR

CS CANCEL STATION

CB CODE BLUE STATION DD DOME LIGHT

DLZ DOME LIGHT, ZONE

DC DOMELESS CONTROLLER

DOMELESS CONTROLLER WITH AUDIO DOC DOMELESS DUTY CONTROLLER

DS DUTY STATION

ES EMERGENCY STATION

KP KEY PASS STATION

MC MASTER CONSOLE PATIENT STATION, SINGLE

PATIENT STATION, DOUBLE

PULL CORD STATION RS REGISTRATION STATION

SA STAFF ASSIST STATION

ST STAFF TERMINAL

-CP- CONTROL PANEL, RECESS

CP CONTROL PANEL, SURFACE

-AP- ANNUNCIATOR PANEL, RECESS

ANNUNCIATOR PANEL, SURFACE

LIGHTING CONTROL

\$\$\$ ONE, TWO, THREE AND FOUR GANG SINGLE POLE TOGGLE SWITCHES

4-WAY SWITCH

K KEY OPERATED LIGHT SWITCH

TOGGLE SWITCH C/W RED PILOT LIGHT

DOOR LIGHT SWITCH

SWITCH MOUNTED OCCUPANCY SENSOR

FAN CONTROL SWITCH VARIABLE SPEED FAN CONTROL SWITCH

MANUAL TIMER SWITCH

DIMMER SWITCH

TC PROGRAMMABLE TIME CLOCK ©S CEILING MOUNTED OCCUPANCY SENSOR

PE PHOTO ELECTRIC CONTROL

(LV) LOW VOLTAGE RELAY

LOW VOLTAGE RELAY PANEL LOW VOLTAGE CONTROL STATION

LVM LOW VOLTAGE CONTROL SYSTEM MASTER STATION

GENERAL POWER

15A, SINGLE RECEPTACLE

USB 15A, DUPLEX RECEPTACLE / WITH USB

15A, QUAD RECEPTACLE

(5-20R) T-SLOT DUPLEX RECEPTACLE 15A, SINGLE RECEPTACLE - ABOVE COUNTER

15A, DUPLEX RECEPTACLE / WITH USB - ABOVE COUNTER

15A, QUAD RECEPTACLE - ABOVE COUNTER

15A, SINGLE INSULATED/ISOLATED GROUND RECEPTACLE

15A, SINGLE INSULATED/ISOLATED GROUND RECEPTACLE - ABOVE COUNTER 15A, DUPLEX INSULATED/ISOLATED GROUND RECEPTACLE

15A, DUPLEX INSULATED/ISOLATED GROUND RECEPTACLE - ABOVE COUNTER

(5-20R) T-SLOT DUPLEX INSULATED/ISOLATED GROUND RECEPTACLE (5-20R) T-SLOT DUPLEX INSULATED/ISOLATED GROUND RECEPTACLE - ABOVE

120/208V/1Ø/30 AMP DRYER OUTLET

120/208V/1Ø/40 AMP RANGE OUTLET

SINGLE SPECIAL RECEPTACLE - AMPACITY AND TYPE AS INDICATED

15A, SPLIT WIRED DUPLEX RECEPTACLE - STANDARD

15A, SPLIT WIRED DUPLEX RECEPTACLE - STANDARD - ABOVE COUNTER

15A, HALF SWITCHED DUPLEX RECEPTACLE (CONTROLLED BY SWITCH)

15A, HALF SWITCHED DUPLEX RECEPTACLE (CONTROLLED BY SWITCH) -

15A, DUPLEX RECEPTACLE C/W GROUND FAULT CIRCUIT INTERRUPTER

15A, DUPLEX RECEPTACLE C/W GROUND FAULT CIRCUIT INTERRUPTER -(5-20R) T-SLOT DUPLEX RECEPTACLE C/W GROUND FAULT CIRCUIT

15A, SINGLE RECEPTACLE - FLUSH FLOOR MOUNTED

15A, U-GROUND DUPLEX RECEPTACLE - FLUSH FLOOR MOUNTED

(5-20R) T-SLOT DUPLEX RECEPTACLE - FLUSH FLOOR MOUNTED 15A, SINGLE INSULATED/ISOLATED GROUND RECEPTACLE - FLUSH FLOOR

15A, DUPLEX INSULATED/ISOLATED GROUND RECEPTACLE - FLUSH FLOOR (5-20R) T-SLOT DUPLEX INSULATED/ISOLATED GROUND RECEPTACLE - FLUSH

15A, SPLIT WIRED DUPLEX RECEPTACLE - FLUSH FLOOR MOUNTED 15A, DUPLEX RECEPTACLE C/W GROUND FAULT CIRCUIT INTERRUPTER -

(5-20R) T-SLOT DUPLEX RECEPTACLE C/W GROUND FAULT CIRCUIT INTERRUPTER - FLUSH FLOOR MOUNTED 15A, SINGLE RECEPTACLE - FLUSH CEILING MOUNTED

15A, DUPLEX RECEPTACLE - FLUSH CEILING MOUNTED

(5-20R) T-SLOT U-GROUND DUPLEX RECEPTACLE - FLUSH CEILING MOUNTED 15A, SINGLE INSULATED/ISOLATED GROUND RECEPTACLE - FLUSH CEILING

15A, DUPLEX INSULATED/ISOLATED GROUND RECEPTACLE - FLUSH CEILING (5-20R) T-SLOT DUPLEX INSULATED/ISOLATED GROUND RECEPTACLE - FLUSH

15A, SPLIT WIRED DUPLEX RECEPTACLE - FLUSH CEILING MOUNTED 15A, DUPLEX RECEPTACLE C/W GROUND FAULT CIRCUIT INTERRUPTER -

(5-20R) T-SLOT DUPLEX RECEPTACLE C/W GROUND FAULT CIRCUIT INTERRUPTER - FLUSH CEILING MOUNTED

FLUSH CEILING MOUNTED

FIRE ALARM SYSTEM

PULL STATION

FLUSH MOUNTED BELL

FLUSH MOUNTED HORN - 'HS' DENOTES HORN STROBE COMBINATION

DOUBLE HORN - CEILING OR WALL MOUNTED

SUITE ISOLATOR MODULE STROBE - CEILING MOUNTED

STROBE - WALL MOUNTED

S FLUSH MOUNTED SPEAKER - CEILING MOUNTED FLUSH MOUNTED SPEAKER - WALL MOUNTED

SURFACE MOUNTED SPEAKER - CEILING MOUNTED

FIREMEN HANDSET

FIRE ALARM SYSTEM SPEAKER SILENCE SWITCH

SURFACE MOUNTED SPEAKER - WALL MOUNTED

AUTOMATIC COMBINATION FIXED TEMPERATURE/RATE OF RISE HEAT DETECTOR - CEILING MOUNTED AUTOMATIC COMBINATION FIXED TEMPERATURE/RATE OF RISE HEAT

DETECTOR - WALL MOUNTED AUTOMATIC FIXED TEMPERATURE HEAT DETECTOR - CEILING MOUNTED

AUTOMATIC FIXED TEMPERATURE HEAT DETECTOR - WALL MOUNTED

SMOKE DETECTOR - CEILING MOUNTED WITH STROBE

SMOKE DETECTOR - WALL MOUNTED

SMOKE DETECTOR - CEILING MOUNTED

SMOKE DETECTOR - WALL MOUNTED WITH STROBE

DUCT TYPE SMOKE DETECTOR WITH REMOTE ANNUNCIATION SINGLE STATION SMOKE ALARM C/W RED INDICATION LIGHT - CEILING

SINGLE STATION SMOKE ALARM C/W RED INDICATION LIGHT - WALL MOUNTED SINGLE STATION SMOKE ALARM / CO DETECTOR C/W RED INDICATION LIGHT -

SINGLE STATION SMOKE ALARM / CO DETECTOR C/W RED INDICATION LIGHT -WALL MOUNTED

CEILING MOUNTED

CARBON MONOXIDE DETECTOR - CEILING MOUNTED CARBON MONOXIDE DETECTOR - WALL MOUNTED

WIRED BY ELECTRICAL. SPRINKLER SYSTEM OR STANDPIPE SUPERVISED VALVE BY MECHANICAL AND WIRED BY ELECTRICAL.

SOLENOID VALVE BY MECHANICAL AND WIRED BY ELECTRICAL.

SPRINKLER SYSTEM FLOW OR PRESSURE SWITCH BY MECHANICAL AND

MOTORIZED DAMPER BY MECHANICAL AND WIRED BY ELECTRICAL

RECESS MOUNTED FIRE ALARM CONTROL PANEL SURFACE MOUNTED - FIRE ALARM CONTROL PANEL

RECESS MOUNTED - FIRE ALARM ANNUNCIATOR PANEL SURFACE MOUNTED - FIRE ALARM ANNUNCIATOR PANEL

F ME RECESS MOUNTED - CENTRAL MONITORING AND EVACUATION FACILITIES

FME
SURFACE MOUNTED - CENTRAL MONITORING AND EVACUATION FACILITIES END OF LINE RESISTOR

REMOTE TROUBLE SIGNAL

CABINET UNIT HEATER, TYPE 'CUH1' AS INDICATED RECESS MOUNTED - ELECTRIC FORCE FLOW HEATER, TYPE 'FFH1' AS

ELECTRIC UNIT HEATER, TYPE 'UH1' AS INDICATED

AREA OF SNOW MELTING CABLE - TYPE '01' AS INDICATED

001 HEAT TRACING CABLE AROUND VERTICAL PIPE - TYPE AS INDICATED

ELECTRIC HEATING

ELECTRIC BASEBOARD HEATER, TYPE 'BBH1' AS INDICATED

ARCHITECTURAL DRAFT BARRIER HEATER, TYPE 'DBH1' AS INDICATED KSH1

ELECTRIC KICKSPACE HEATER, TYPE 'KSH1' AS INDICATED

ELECTRIC DROP-IN HEATER, TYPE 'DIH1' AS INDICATED

SURFACE MOUNTED - ELECTRIC FORCE FLOW HEATER, TYPE 'FFH1' AS INDICATED

001 HEAT TRACING CABLE AROUND HORIZONTAL PIPE - TYPE AS INDICATED

EQUIPMENT CONNECTIONS AND CONTROLS

DIRECT CONNECTION - 120 OR 208V AS INDICATED

DIRECT CONNECTION - 347 OR 600V AS INDICATED

DIRECT CONNECTION C/W UNFUSED DISCONNECT SWITCH - 120 OR 208V AS DIRECT CONNECTION - 347 OR 600V C/W UNFUSED DISCONNECT SWITCH AS

DIRECT CONNECTION - 120 OR 208V C/W FUSED DISCONNECT SWITCH AS INDICATED

DIRECT CONNECTION - 347 OR 600V C/W FUSED DISCONNECT SWITCH AS INDICATED) ________ MODULAR FURNITURE WHIP CONNECTION \cdot 'C' - DENOTES CEILING \cdot 'F C F W DENOTES FLOOR · 'W' - DENOTES WALL

MOTOR CONNECTION AS INDICATED MOTOR CONNECTION C/W UNFUSED DISCONNECT SWITCH

MOTOR CONNECTION C/W FUSED DISCONNECT SWITCH

MOTOR CONNECTION C/W LOOSE STARTER

UNFUSED DISCONNECT SWITCH FUSED DISCONNECT SWITCH

MOTOR STARTER AS INDICATED

H HAIR DRYER

HD HAND DRYER C CONTACTOR - SIZE AND NUMBER OF POLES AS INDICATED

T LINE VOLTAGE THERMOSTAT PROVIDED AND WIRED BY ELECTRICAL

LINE VOLTAGE THERMOSTAT PROVIDED BY MECHANICAL AND WIRED BY CARBON MONOXIDE DETECTOR SUPPLIED AND INSTALLED BY MECHANICAL. ROUGH-IN BY ELECTRICAL

MASTER CLOCK CONTROL PANEL - CEILING MOUNTED

MASTER CLOCK CONTROL PANEL - WALL MOUNTED

CLOCK HANGER OUTLET C/W CLOCK - WALL MOUNTED CLOCK HANGER OUTLET C/W CLOCK - CEILING MOUNTED

CLOCK HANGER OUTLET ONLY - WALL MOUNTED CLOCK HANGER OUTLET ONLY - CEILING MOUNTED

POWER ACTIVATED DOOR EXIT BUTTON SUPPLIED BY DOOR HARDWARE SUPPLIER, WIRED BY ELECTRICAL RECESS MOUNTED - CARBON MONOXIDE CONTROL PANEL

SURFACE MOUNTED - CARBON MONOXIDE CONTROL PANEL

RECESS MOUNTED ELECTRICAL PANEL SURFACE MOUNTED ELECTRICAL PANEL

POWER DISTRIBUTION POWER TRANSFORMER

POWER TRANSFORMER C/W ELECTROSTATIC SHIELD

— INCOMING POWER INTERRUPTER SWITCH

CURRENT CONTROL TRANSFORMER

→ DISCONNECT SWITCH MOLDED CASE CIRCUIT BREAKER

→ → DRAW OUT AIR CIRCUIT BREAKER

<-
✓
FIXED AIR CIRCUIT BREAKER

—□□ FUSE

INCOMING POWER INTERRUPTER SWITCH M KW/HR METER

DM DIGITAL METERING SYSTEM BUS DUCT

MISCELLANEOUS

AUTOMATIC TRANSFER SWITCH - 'IBP'-DENOTES ISOLATION BYPASS SWITCH

S EMERGENCY GENERATOR

IN ∨ EMERGENCY LIGHTING INVERTER UPS UNINTERRUPTABLE POWER SUPPLY

(J) JUNCTION BOX JUNCTION BOX ON WALL

INDICATES EXISTING DEVICE TO REMAIN

INDICATES EXISTING DEVICE TO BE MOVED

INDICATES EXISTING DEVICE IN RELOCATED POSITION

INDICATES EXISTING DEVICE TO BE DEMOLISHED

INDICATES CONDUIT

GENERAL NOTES:

MOUNTING HEIGHT OF ALL EQUIPMENT/DEVICES SHOWN IN SYMBOL LEGEND ABOVE SHALL BE MEASURED WITH

. PROVIDE LOCKABLE ENCLOSURES WITH COMMON KEY ON ALL STARTERS AND DISCONNECT SWITCHES LOCATED IN PUBLIC AREAS. KEYS SHALL BE HANDED OVER TO OWNER AT END OF PROJECT. 4. THE EXISTING INITIATION ZONE WIRING IS CONNECTED AS "ADDRESSABLE CLASS-B" CIRCUIT. EXTEND EXISTING FIRE ALARM CIRCUIT TO ACCOMMODATE THE NEW DEVICES TO

5. ALL NEWLY INSTALLED FIRE ALARM DEVICES SHALL BE IN LINE WITH THE EXISTING FIRE ALARM ZONING FOR EACH 6. MAKE & MODEL OF EXISTING FIRE ALARM SYSTEM: SIMPLEX-4001EX

COMMUNICATIONS

COMBINATION MULTI-FUNCTION COMMUNICATION OUTLET - WALL MOUNTED COMBINATION MULTI-FUNCTION COMMUNICATION OUTLET - WALL MOUNTED ABOVE COLINTER

ABOVE COUNTER TV TELEVISION OUTLET - WALL MOUNTED

TELEVISION OUTLET - WALL MOUNTED ABOVE COUNTER

TELEVISION OUTLET - FLUSH CEILING MOUNTED TELEPHONE OUTLET - WALL MOUNTED

TELEPHONE OUTLET - FLUSH CEILING MOUNTED PAY TELEPHONE OUTLET

TELEPHONE OUTLET - FLUSH FLOOR MOUNTED

TELEPHONE OUTLET - WALL MOUNTED ABOVE COUNTER

TERMINAL POINT OF TELEPHONE ZONE CIRCUIT ON CEILING SLAB C/W 2" (53mm) CONDUIT BACK TO TELEPHONE BACKBOARD

© COMMUNICATION LINE TERMINAL BOX

DATA OUTLET - WALL MOUNTED DATA OUTLET - WALL ABOVE COUNTER

DATA OUTLET - FLUSH CEILING MOUNTED

DATA OUTLET - FLUSH FLOOR MOUNTED COMBINATION VOICE/DATA OUTLET - WALL MOUNTED

COMBINATION VOICE/DATA OUTLET - WALL ABOVE COUNTER COMBINATION VOICE/DATA OUTLET - FLUSH CEILING MOUNTED

COMBINATION VOICE/DATA OUTLET - FLUSH FLOOR MOUNTED CC COMMUNICATIONS CABINET, TYPE AS INDICATED

COMMUNICATIONS DROP IDENTIFICATION SIGNAL PUSHBUTTON

SIGNAL BELL C/W TRANSFORMER

INTERCOM MASTER STATION INTERCOM STATION

FLUSH MOUNTED AUXILIARY SOUND SYSTEM SPEAKER - WALL MOUNTED (SP) FLUSH MOUNTED AUXILIARY SOUND SYSTEM SPEAKER - CEILING MOUNTED

SP SURFACE MOUNTED AUXILIARY SOUND SYSTEM SPEAKER - WALL MOUNTED

SP SURFACE MOUNTED AUXILIARY SOUND SYSTEM SPEAKER - CEILING MOUNTED M MICROPHONE JACK

V VOLUME CONTROL SWITCH

P PROJECTION SOUND JACK

SOUND BRIDGING JACK AMP AMPLIFIER

PA CONSOLE OR RACK C/W TERMINAL BOX

PUBLIC ADDRESS SPEAKER, TYPE AS INDICATED

BRANCH CIRCUITING LEGEND 2EP1-3- '3' - DENOTES CIRCUIT NUMBER

'P1' - DENOTES LOCATION OF PANEL (P1 LEVEL)

_____ '2' - DENOTES 120/208V OR '6' - DENOTES 347/600V

L 'E' - DENOTES EMERGENCY PANEL



MINIMUM CONDUIT SIZE SHALL BE 21 mm UNLESS NOTED

RESPECT TO THE CENTER OF THE RELATED EQUIPMENT/DEVICE.

ABBREVIATIONS DRAWING LIST AMPERES E0-01 ELECTRICAL LEGEND, DRAWING LIST AND GENERAL NOTES N.T.S. MOUNTED ABOVE CEILING E2-01 BASEMENT - ELECTRICAL SCOPE OF WORK
E2-02 LEVEL 1 - ELECTRICAL SCOPE OF WORK
E2-03 LEVEL 2 - ELECTRICAL SCOPE OF WORK
E2-04 LEVEL 3 - ELECTRICAL SCOPE OF WORK ARC FAULT CIRCUIT INTERRUPTER E2-04 LEVEL 3 - ELECTRICAL SCOPE OF WORK ABOVE FINISHED FLOOR E2-05 ATTIC - ELECTRICAL NEW WORK ABOVE FINISHED GRADE E3-01 ELECTRICAL SINGLE LINE AND DETAILS AS SHOWN BELOW FINISHED CEILING BELOW FINISHED GRADE BASEBOARD HEATER BREAKER BATTERY UNIT CONDUCTOR CENTRAL DISTRIBUTION PANEL CEILING FAN COFFEE MACHINE CHILDPROOF

> CEILING MOUNTED COMBINATION MAGNETIC

CONDUIT

DELETE DIRECT BURIED

EXISTING

EMPTY CONDUIT

EXHAUST FAN

FIRE ALARM

FOOT CANDLE

FORCE FLOW

FAX MACHINE

GARBURATOR

GROUND WIRE HORIZONTAL

HORSEPOWER

INTERLOCK

ISOLATED GROUND

KILO VOLT-AMPERES KILOWATTS

LIGHTING PANEL

LOW VOLTAGE

LOW VOLTAGE RELAY

MOTOR CONTROL CENTRE

MULTI-FUNCTION COPIER

METERING CENTRE

MULTI CONDUCTOR

MAIN DISTRIBUTION

MICROWAVE

MOISTURE PROOF

EXISTING TO BE MOVED

MOUNTED IN MILLWORK

NORMALLY CLOSED

NOT IN CONTRACT

NORMALLY OPEN

PUBLIC ADDRESS

PP POWER PANEL

REMOVE AND REINSTAL

RECEPTACLE PANEL

SEPARATE CIRCUIT

SELECTOR SWITCH

SWITCHBOARD

UNDER COUNTER

VENDING MACHINE

WALL MOUNTED

WATER COOLER

WIRE GUARD

WET LOCATION

WATER TIGHT

WATERPROOF

EXPLOSION PROOF

WEATHERPROOF

TELEPHONE

TYPICAL

VOLT

QUAD PLEX

REMOVE

POWER DISTRIBUTION UNIT

PUMP (WHEN USED WITH MOTOR SYMBOL)

NOT TO SCALE

NIGHT LIGHT

LOCK-ON TYPE BREAKER

FRIDGE

FLOOR MOUNTED

ELECTRIC HEATER

FLUSH FLOOR MOUNTED

FAN COIL (WHEN USED WITH MOTOR SYMBOL)

DEVICE MOUNTED IN RAISED FLOOR SPACE

GROUND FAULT CIRCUIT INTERRUPTER

COPY MACHINE

MOUNTED IN CRAWLSPACE

COMPUTER TERMINAL PRINTER

DOMESTIC HOT WATER HEATER

DISTRIBUTION PANE DUST TIGHT

COMBINATION MAGNETIC, FULL VOLTAGE NON-REVERSABLE

CUSTOMER SERVICE TERMINATION ENCLOSURE

COMBINATION MAGNETIC, REDUCED VOLTAGE NON-REVERSABLE

DOMESTIC HOT WATER TANK DIV. 15 PROVIDED BY DIVISION 15

CM FVNR

CM RVNR

CNDT

CSTE

FORMAL ISSUES

NOTES:

REVISIONS

NO. DATE PARTICULAR

1 23.01.25 ISSUED FOR COORDINATION REVIEW

2 | 23.03.08 | ISSUED FOR 50% DD REVIEW 3 23.04.24 ISSUED FOR 90% DD REVIEW 4 24.04.10 ISSUED FOR PRE-TENDER REVIEW

5 25.07.04 ISSUED FOR PERMIT

6 25.08.05 ISSUED FOR TENDER

7 25.09.04 ISSUED FOR ADDENDUM 03

KEY PLAN:


McMaster University Campus 1280 MAIN ST. W. HAMILTON, ON L8S 4K1

ORIGINAL PAGE SIZE ARCH D - 24" x 36" KEY TO DETAIL LOCATION: A - DETAIL NO. B B - DETAIL NO. ORIGIN


DRAWN BY: CD

MCMASTER UNIVERSITY HAMILTON, ONTARIO Project No. 22227B PROJECT: UNIVERSITY HALL VENTILATION UPGRADE

CHECKED BY: CD

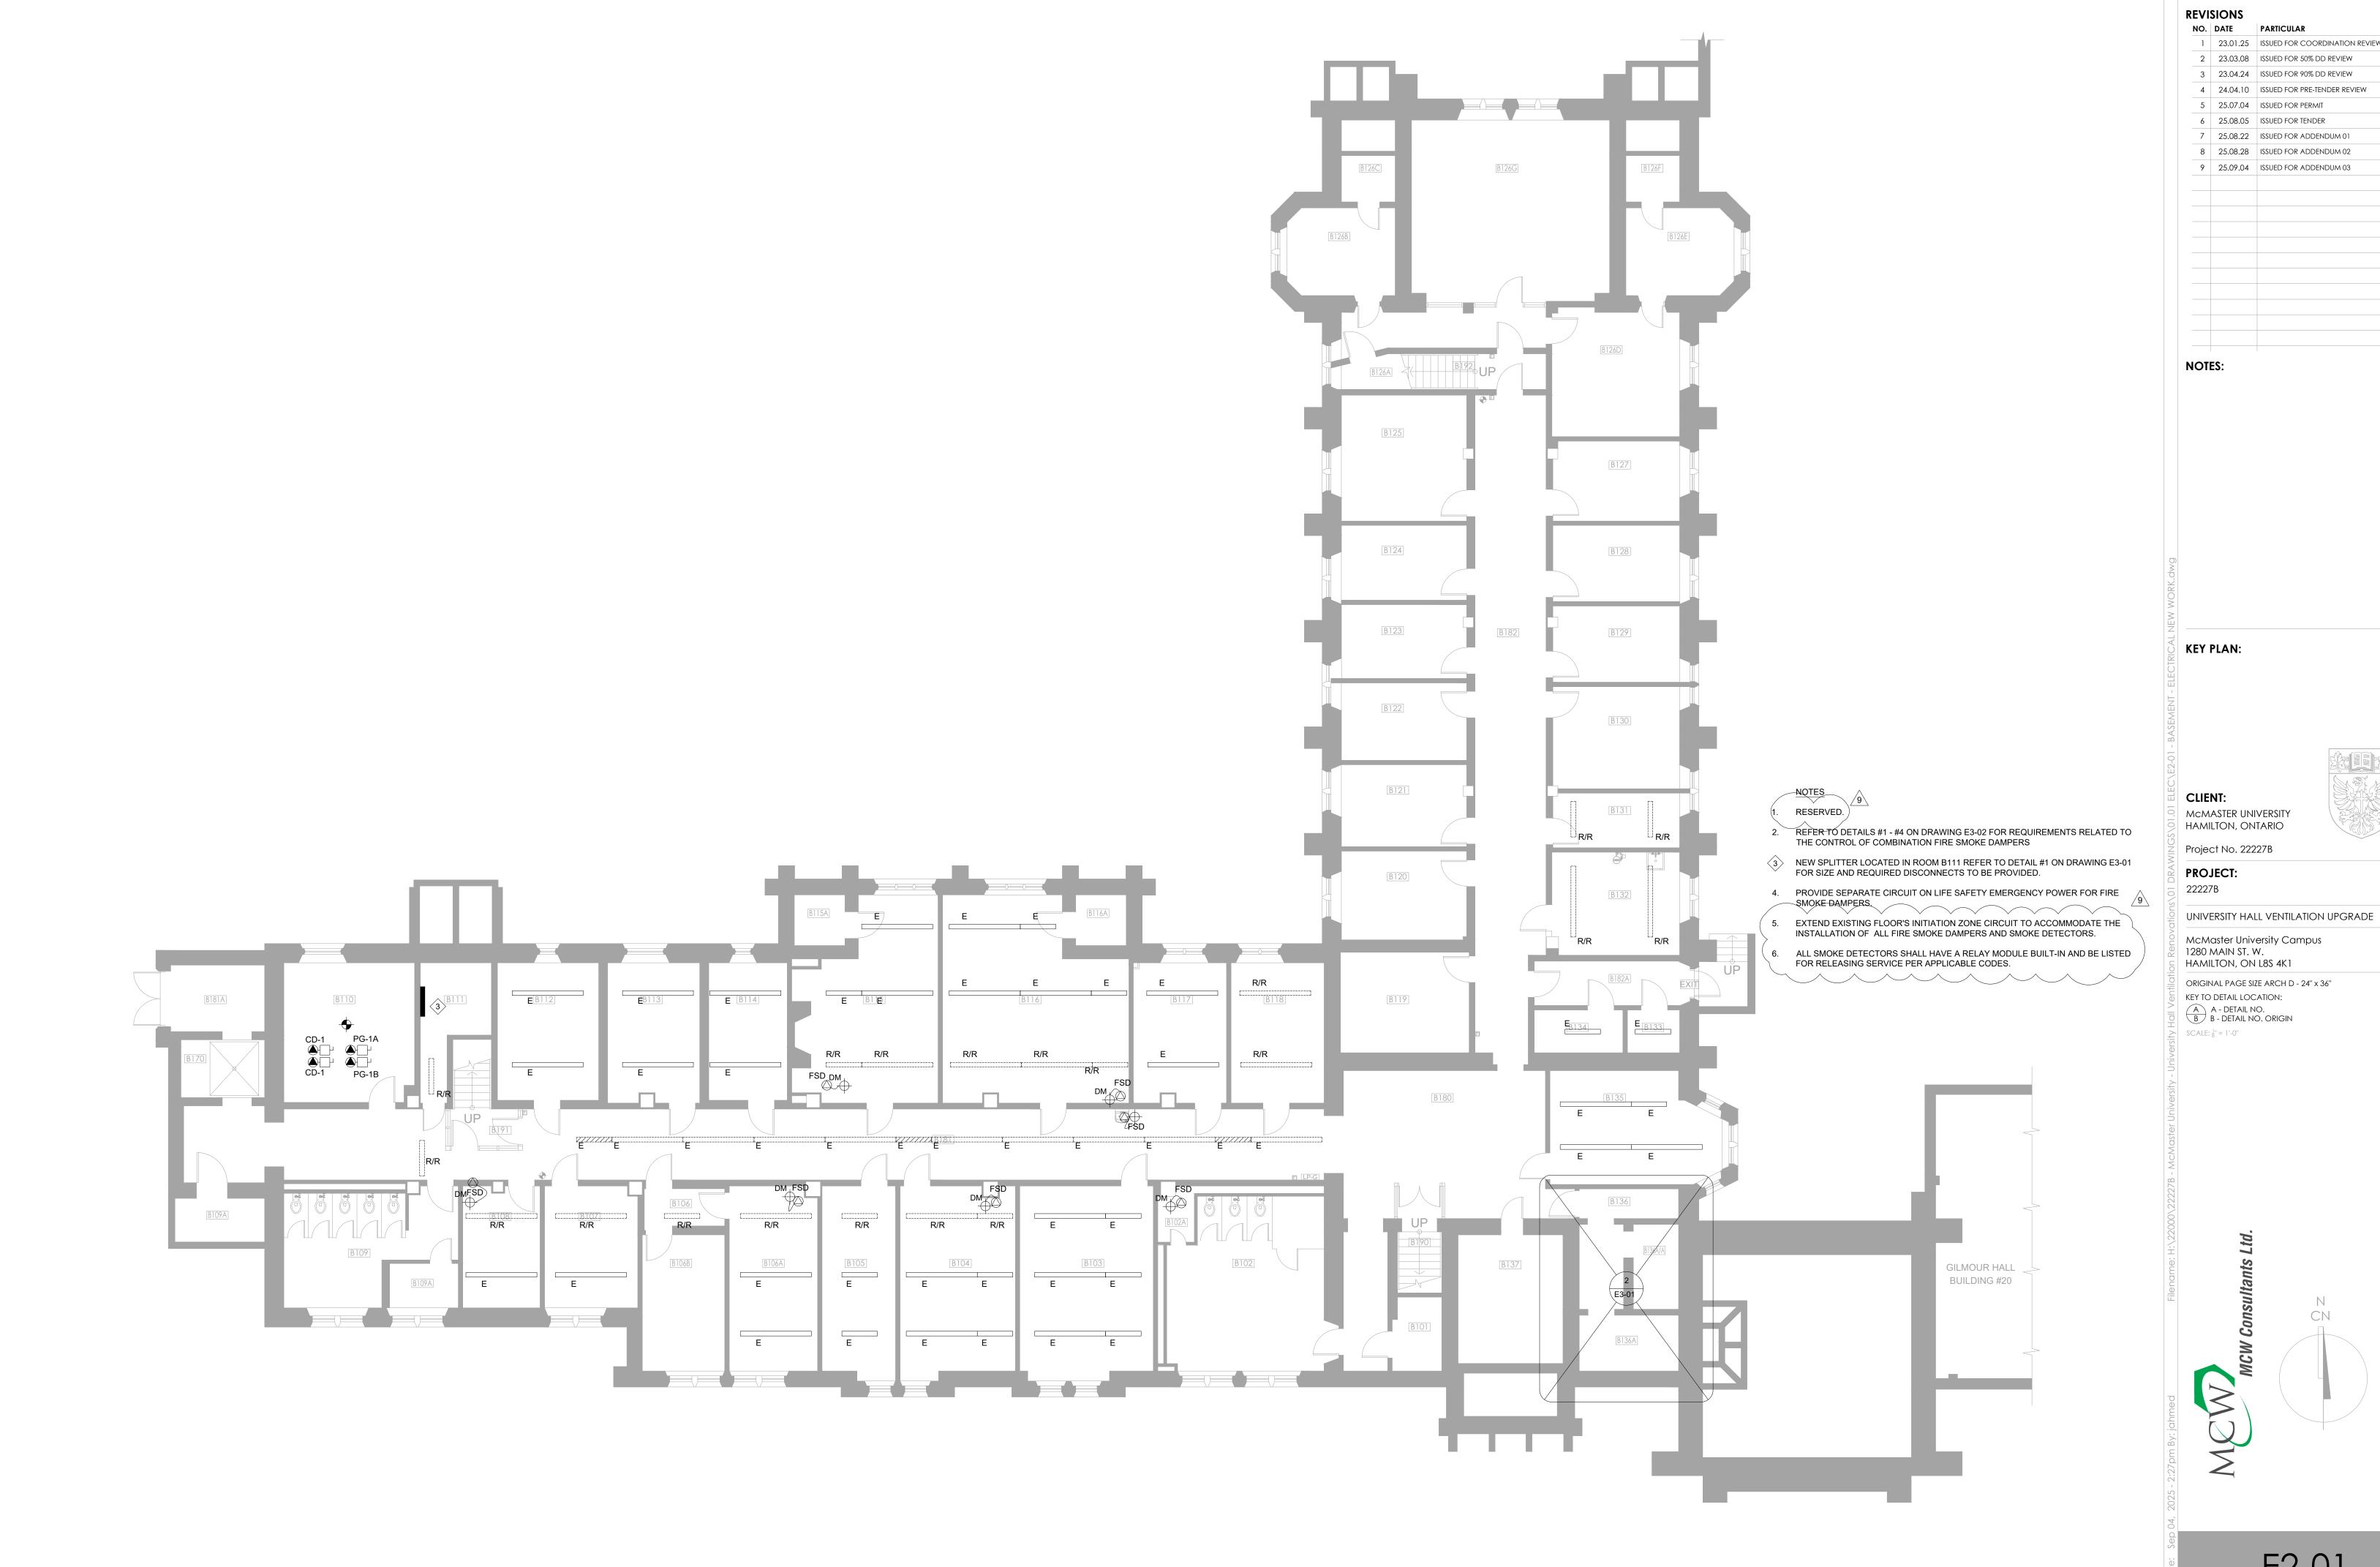

1 23.01.25 ISSUED FOR COORDINATION REVIEW 2 23.03.08 ISSUED FOR 50% DD REVIEW 3 23.04.24 ISSUED FOR 90% DD REVIEW 4 24.04.10 ISSUED FOR PRE-TENDER REVIEW

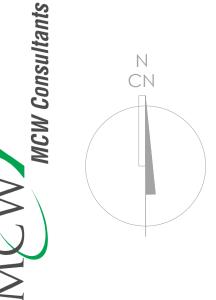


E2-01

DRAWN BY: CD

CHECKED BY: CD

BASEMENT - ELECTRICAL SCOPE OF WORK

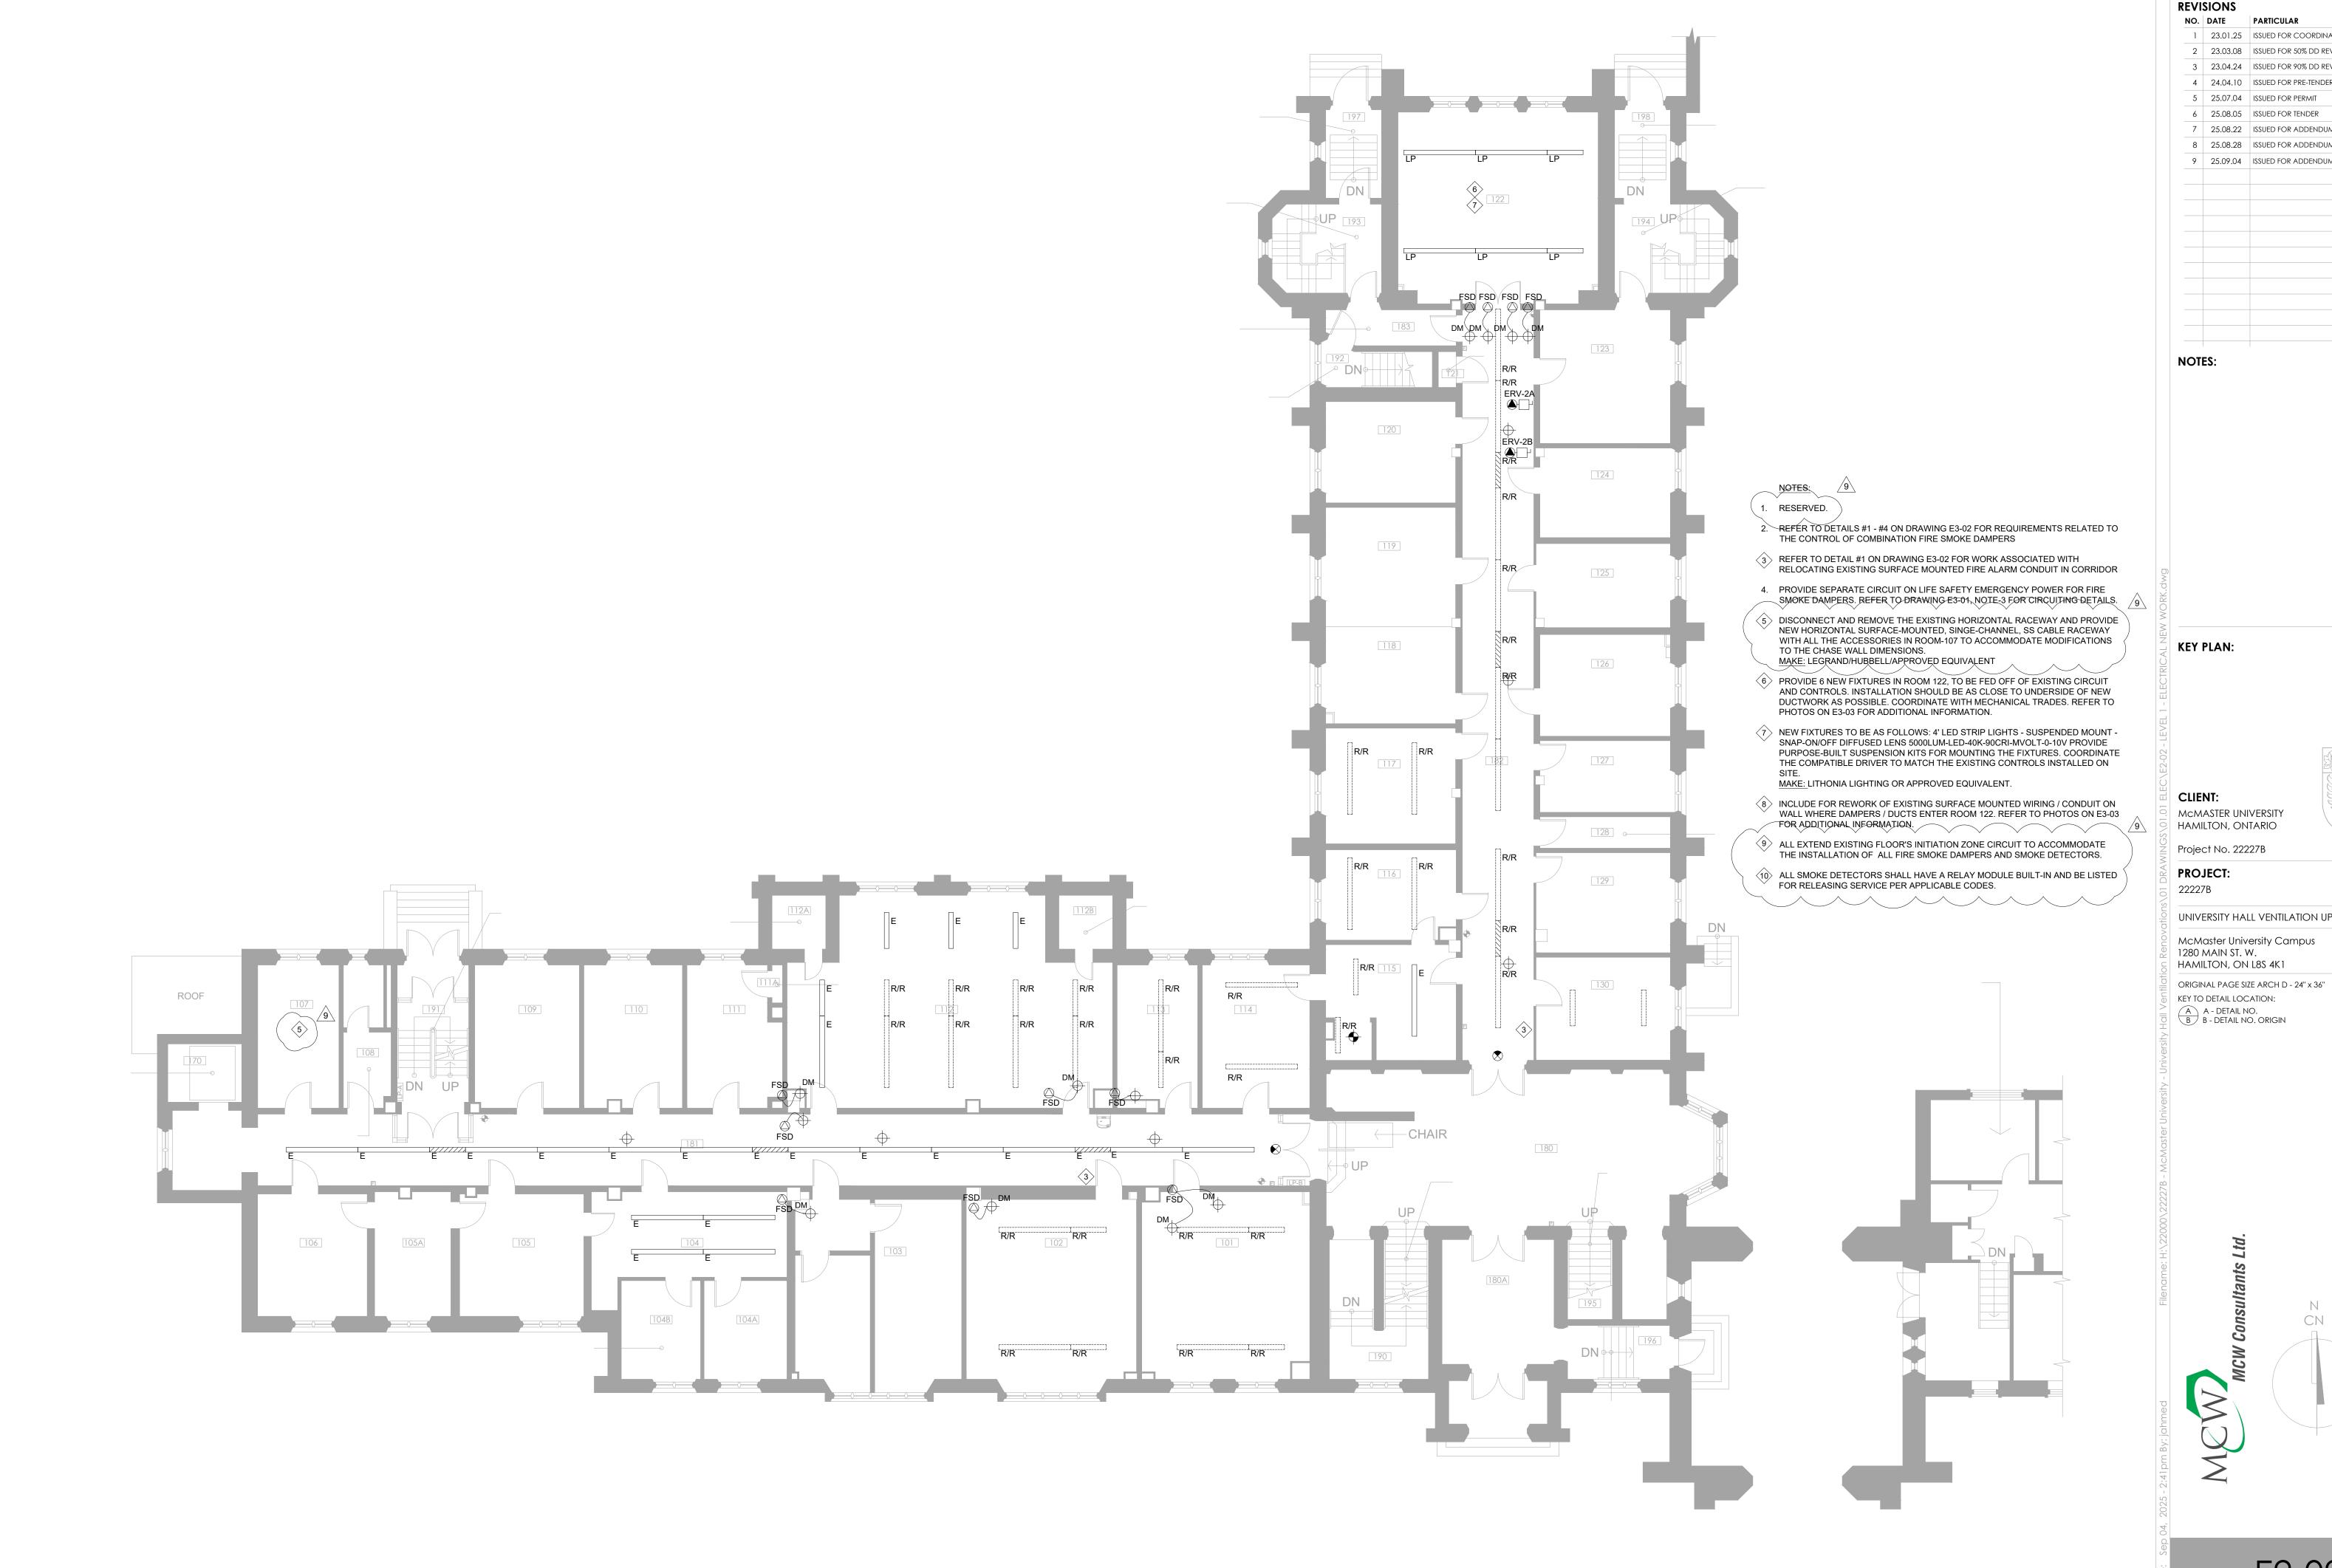

NO. DATE PARTICULAR 2 23.03.08 ISSUED FOR 50% DD REVIEW 3 23.04.24 ISSUED FOR 90% DD REVIEW

1 23.01.25 ISSUED FOR COORDINATION REVIEW 4 24.04.10 ISSUED FOR PRE-TENDER REVIEW 5 25.07.04 ISSUED FOR PERMIT 6 25.08.05 ISSUED FOR TENDER 7 25.08.22 ISSUED FOR ADDENDUM 01 8 25.08.28 ISSUED FOR ADDENDUM 02 9 25.09.04 ISSUED FOR ADDENDUM 03



UNIVERSITY HALL VENTILATION UPGRADE

McMaster University Campus 1280 MAIN ST. W.

HAMILTON, ON L8S 4K1

KEY TO DETAIL LOCATION: A - DETAIL NO.
B - DETAIL NO. ORIGIN




DRAWN BY: CD

E2-02

CHECKED BY: CD

LEVEL 1 - ELECTRICAL SCOPE OF WORK

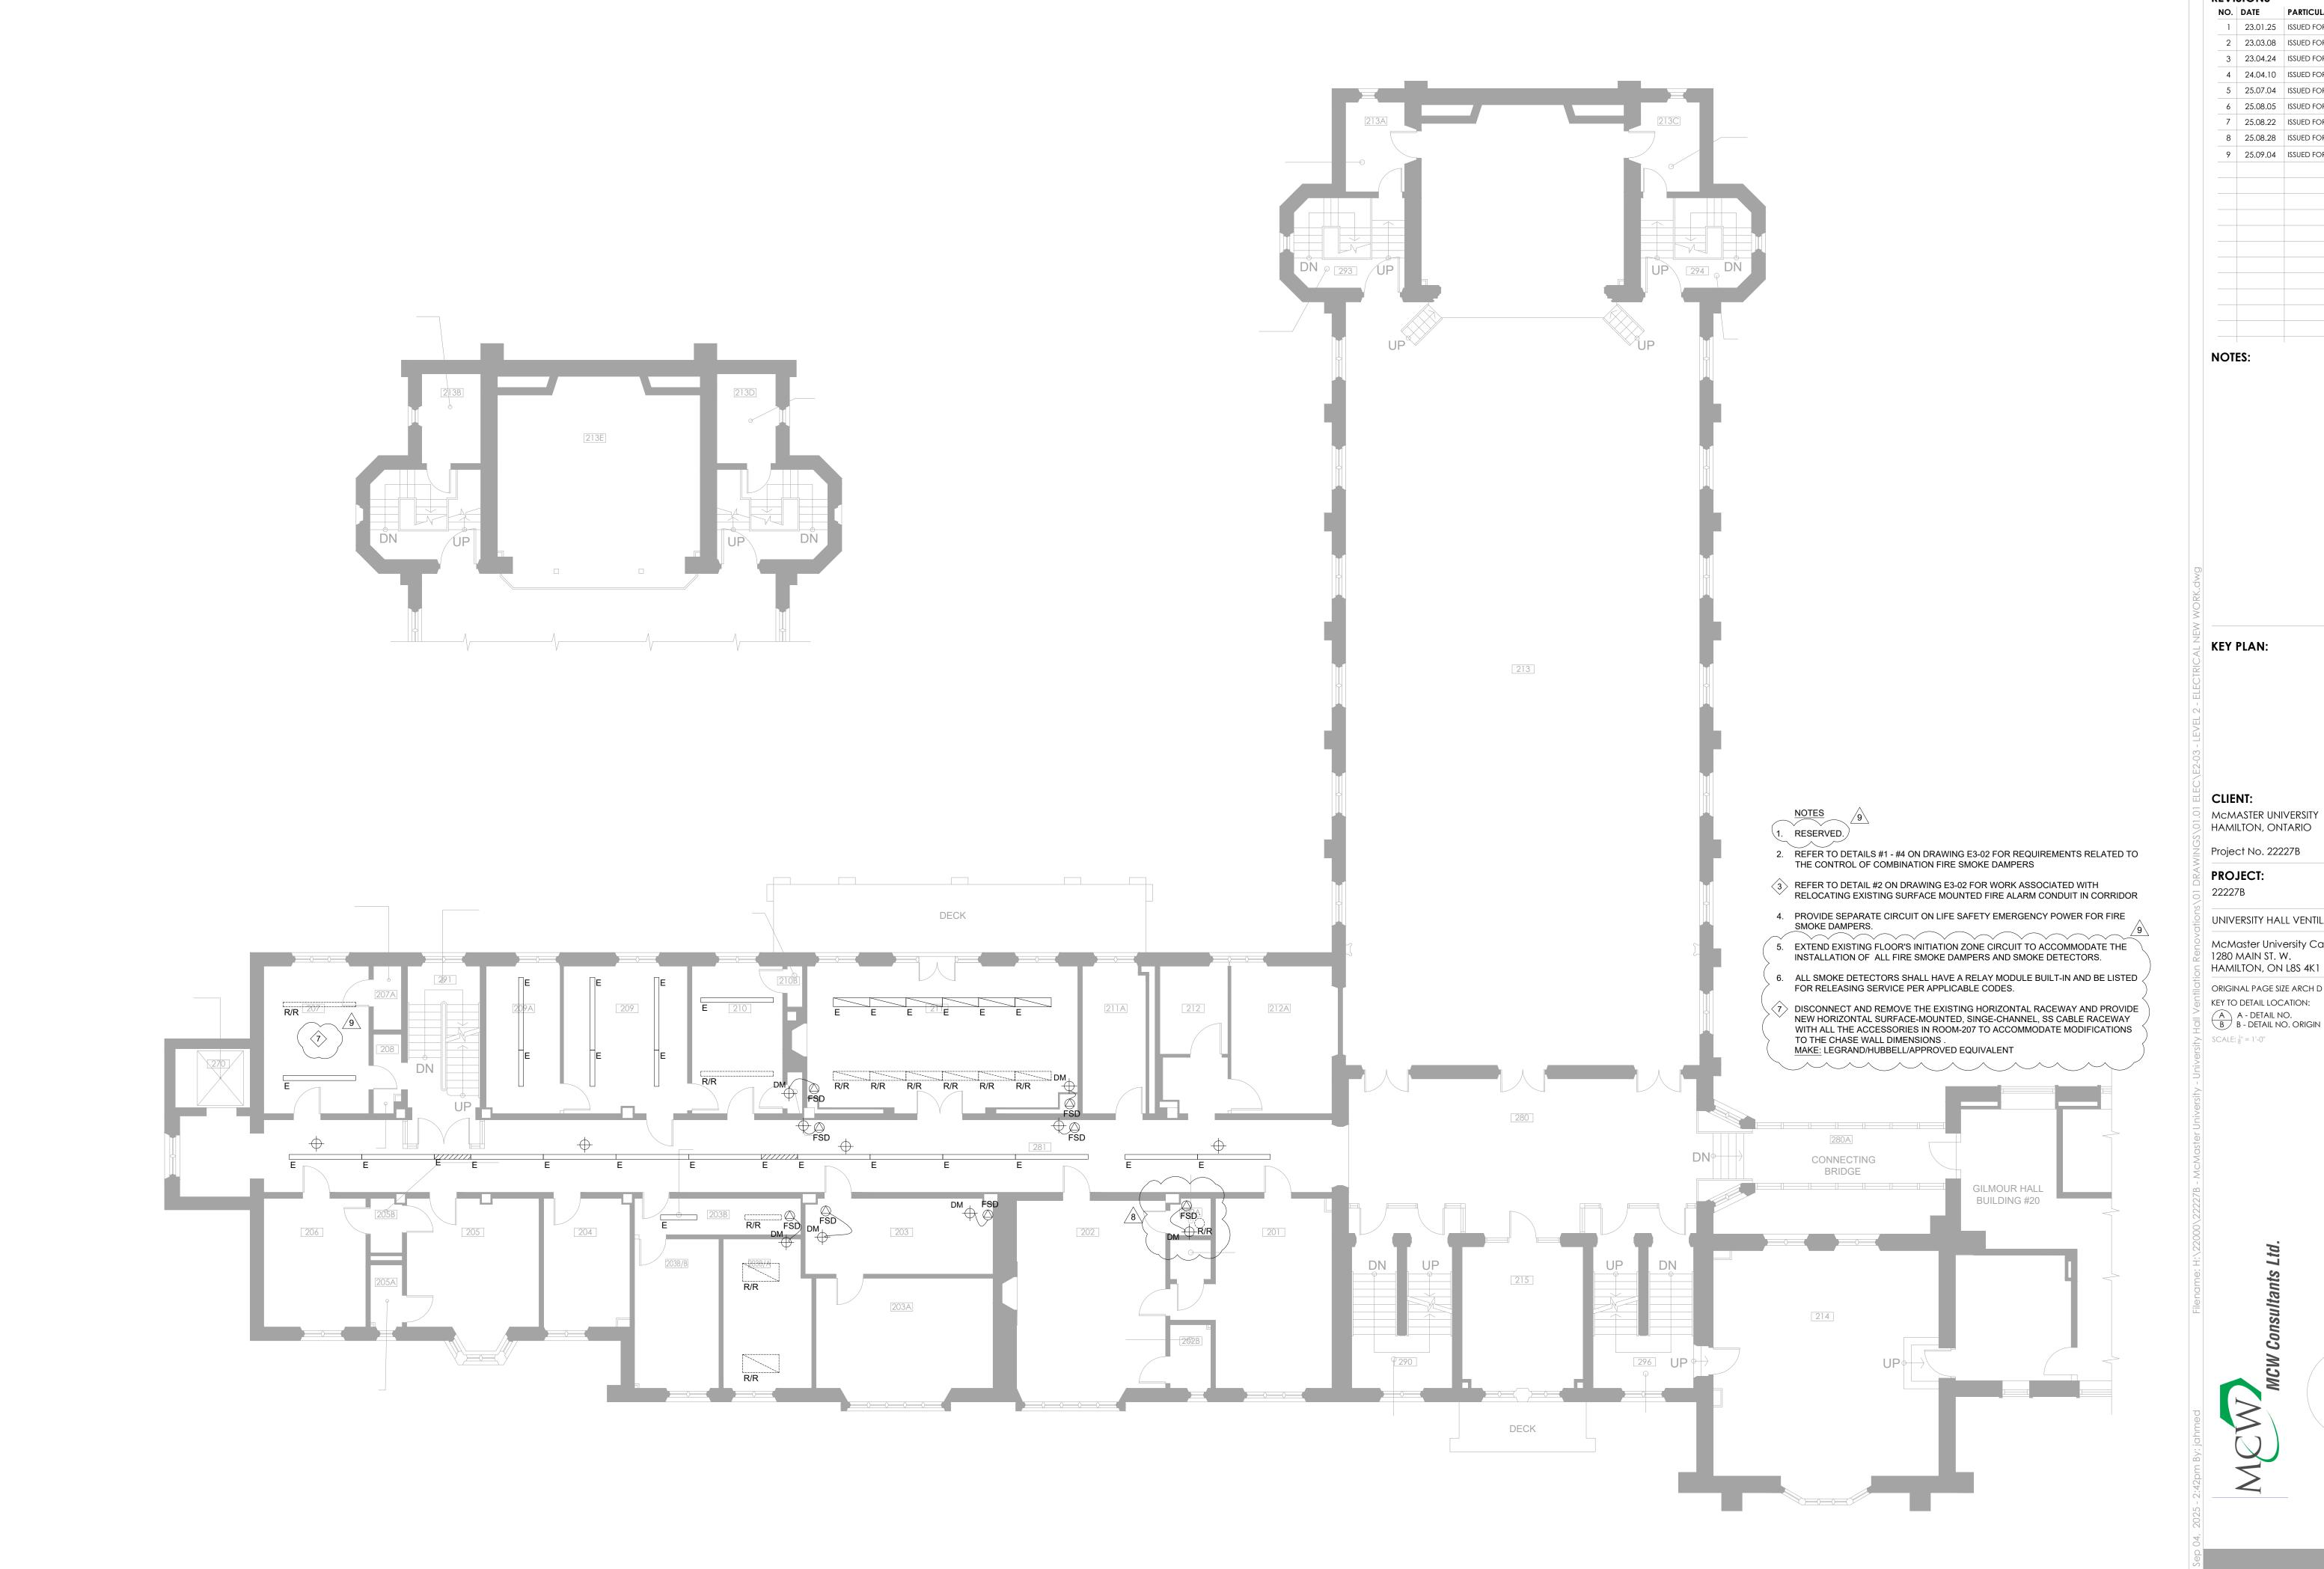

REVISIONS NO. DATE PARTICULAR 1 23.01.25 ISSUED FOR COORDINATION REVIEW 2 23.03.08 ISSUED FOR 50% DD REVIEW 3 23.04.24 ISSUED FOR 90% DD REVIEW 4 24.04.10 ISSUED FOR PRE-TENDER REVIEW 5 25.07.04 ISSUED FOR PERMIT 6 25.08.05 ISSUED FOR TENDER 7 25.08.22 ISSUED FOR ADDENDUM 01 8 25.08.28 ISSUED FOR ADDENDUM 02 9 25.09.04 ISSUED FOR ADDENDUM 03

Project No. 22227B

UNIVERSITY HALL VENTILATION UPGRADE

McMaster University Campus 1280 MAIN ST. W.

HAMILTON, ON L8S 4K1

ORIGINAL PAGE SIZE ARCH D - 24" x 36"

A - DETAIL NO. B - DETAIL NO. ORIGIN

SCALE: $\frac{1}{8}$ " = 1'-0"




E2-03

DRAWN BY: CD

CHECKED BY: CD

LEVEL 2 - ELECTRICAL SCOPE OF WORK

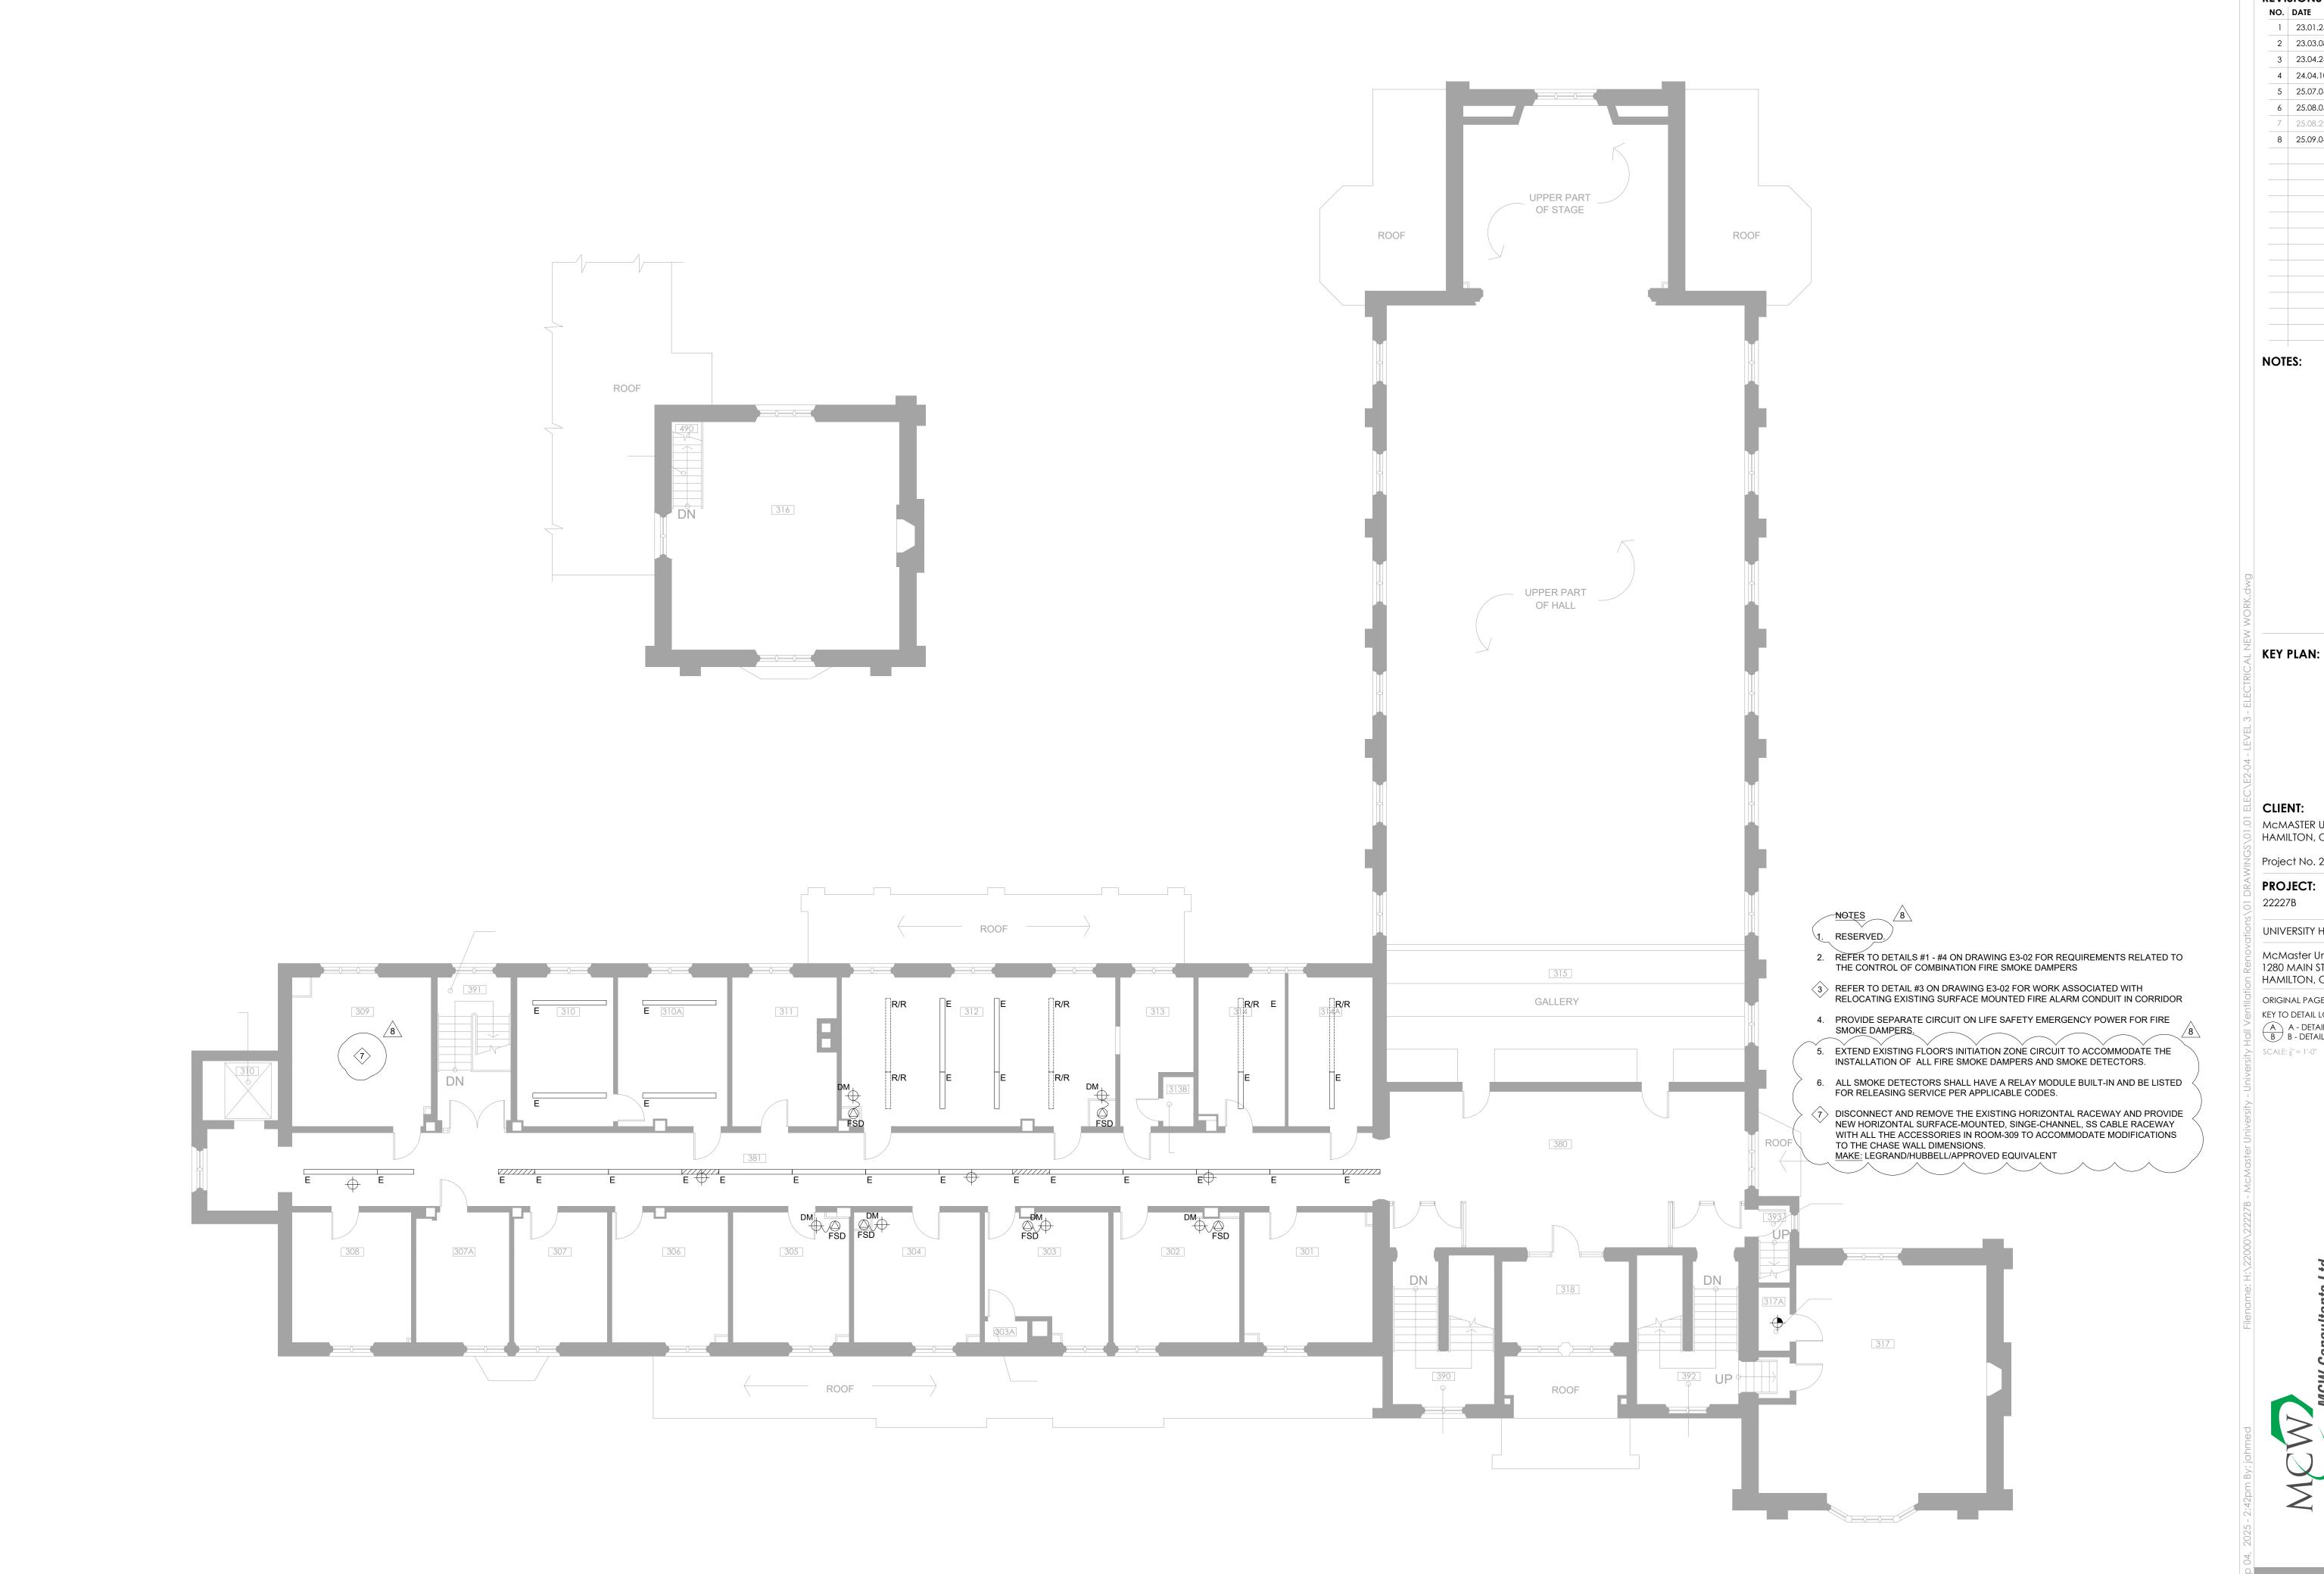

REVISIONS NO. DATE PARTICULAR 1 23.01.25 ISSUED FOR COORDINATION REVIEW 2 23.03.08 ISSUED FOR 50% DD REVIEW 3 23.04.24 ISSUED FOR 90% DD REVIEW 4 24.04.10 ISSUED FOR PRE-TENDER REVIEW 5 25.07.04 ISSUED FOR PERMIT 6 25.08.05 ISSUED FOR TENDER 7 | 25.08.22 | ISSUED FOR ADDENDUM 01 8 25.09.04 ISSUED FOR ADDENDUM 03

MCMASTER UNIVERSITY HAMILTON, ONTARIO

Project No. 22227B

PROJECT:

UNIVERSITY HALL VENTILATION UPGRADE

McMaster University Campus 1280 MAIN ST. W.

HAMILTON, ON L8S 4K1

ORIGINAL PAGE SIZE ARCH D - 24" x 36"

KEY TO DETAIL LOCATION:

A - DETAIL NO. B - DETAIL NO. ORIGIN


SCALE: $\frac{1}{8}$ " = 1'-0"

DRAWN BY: CD

LEVEL 3 - ELECTRICAL SCOPE OF WORK

E2-04

CHECKED BY: CD

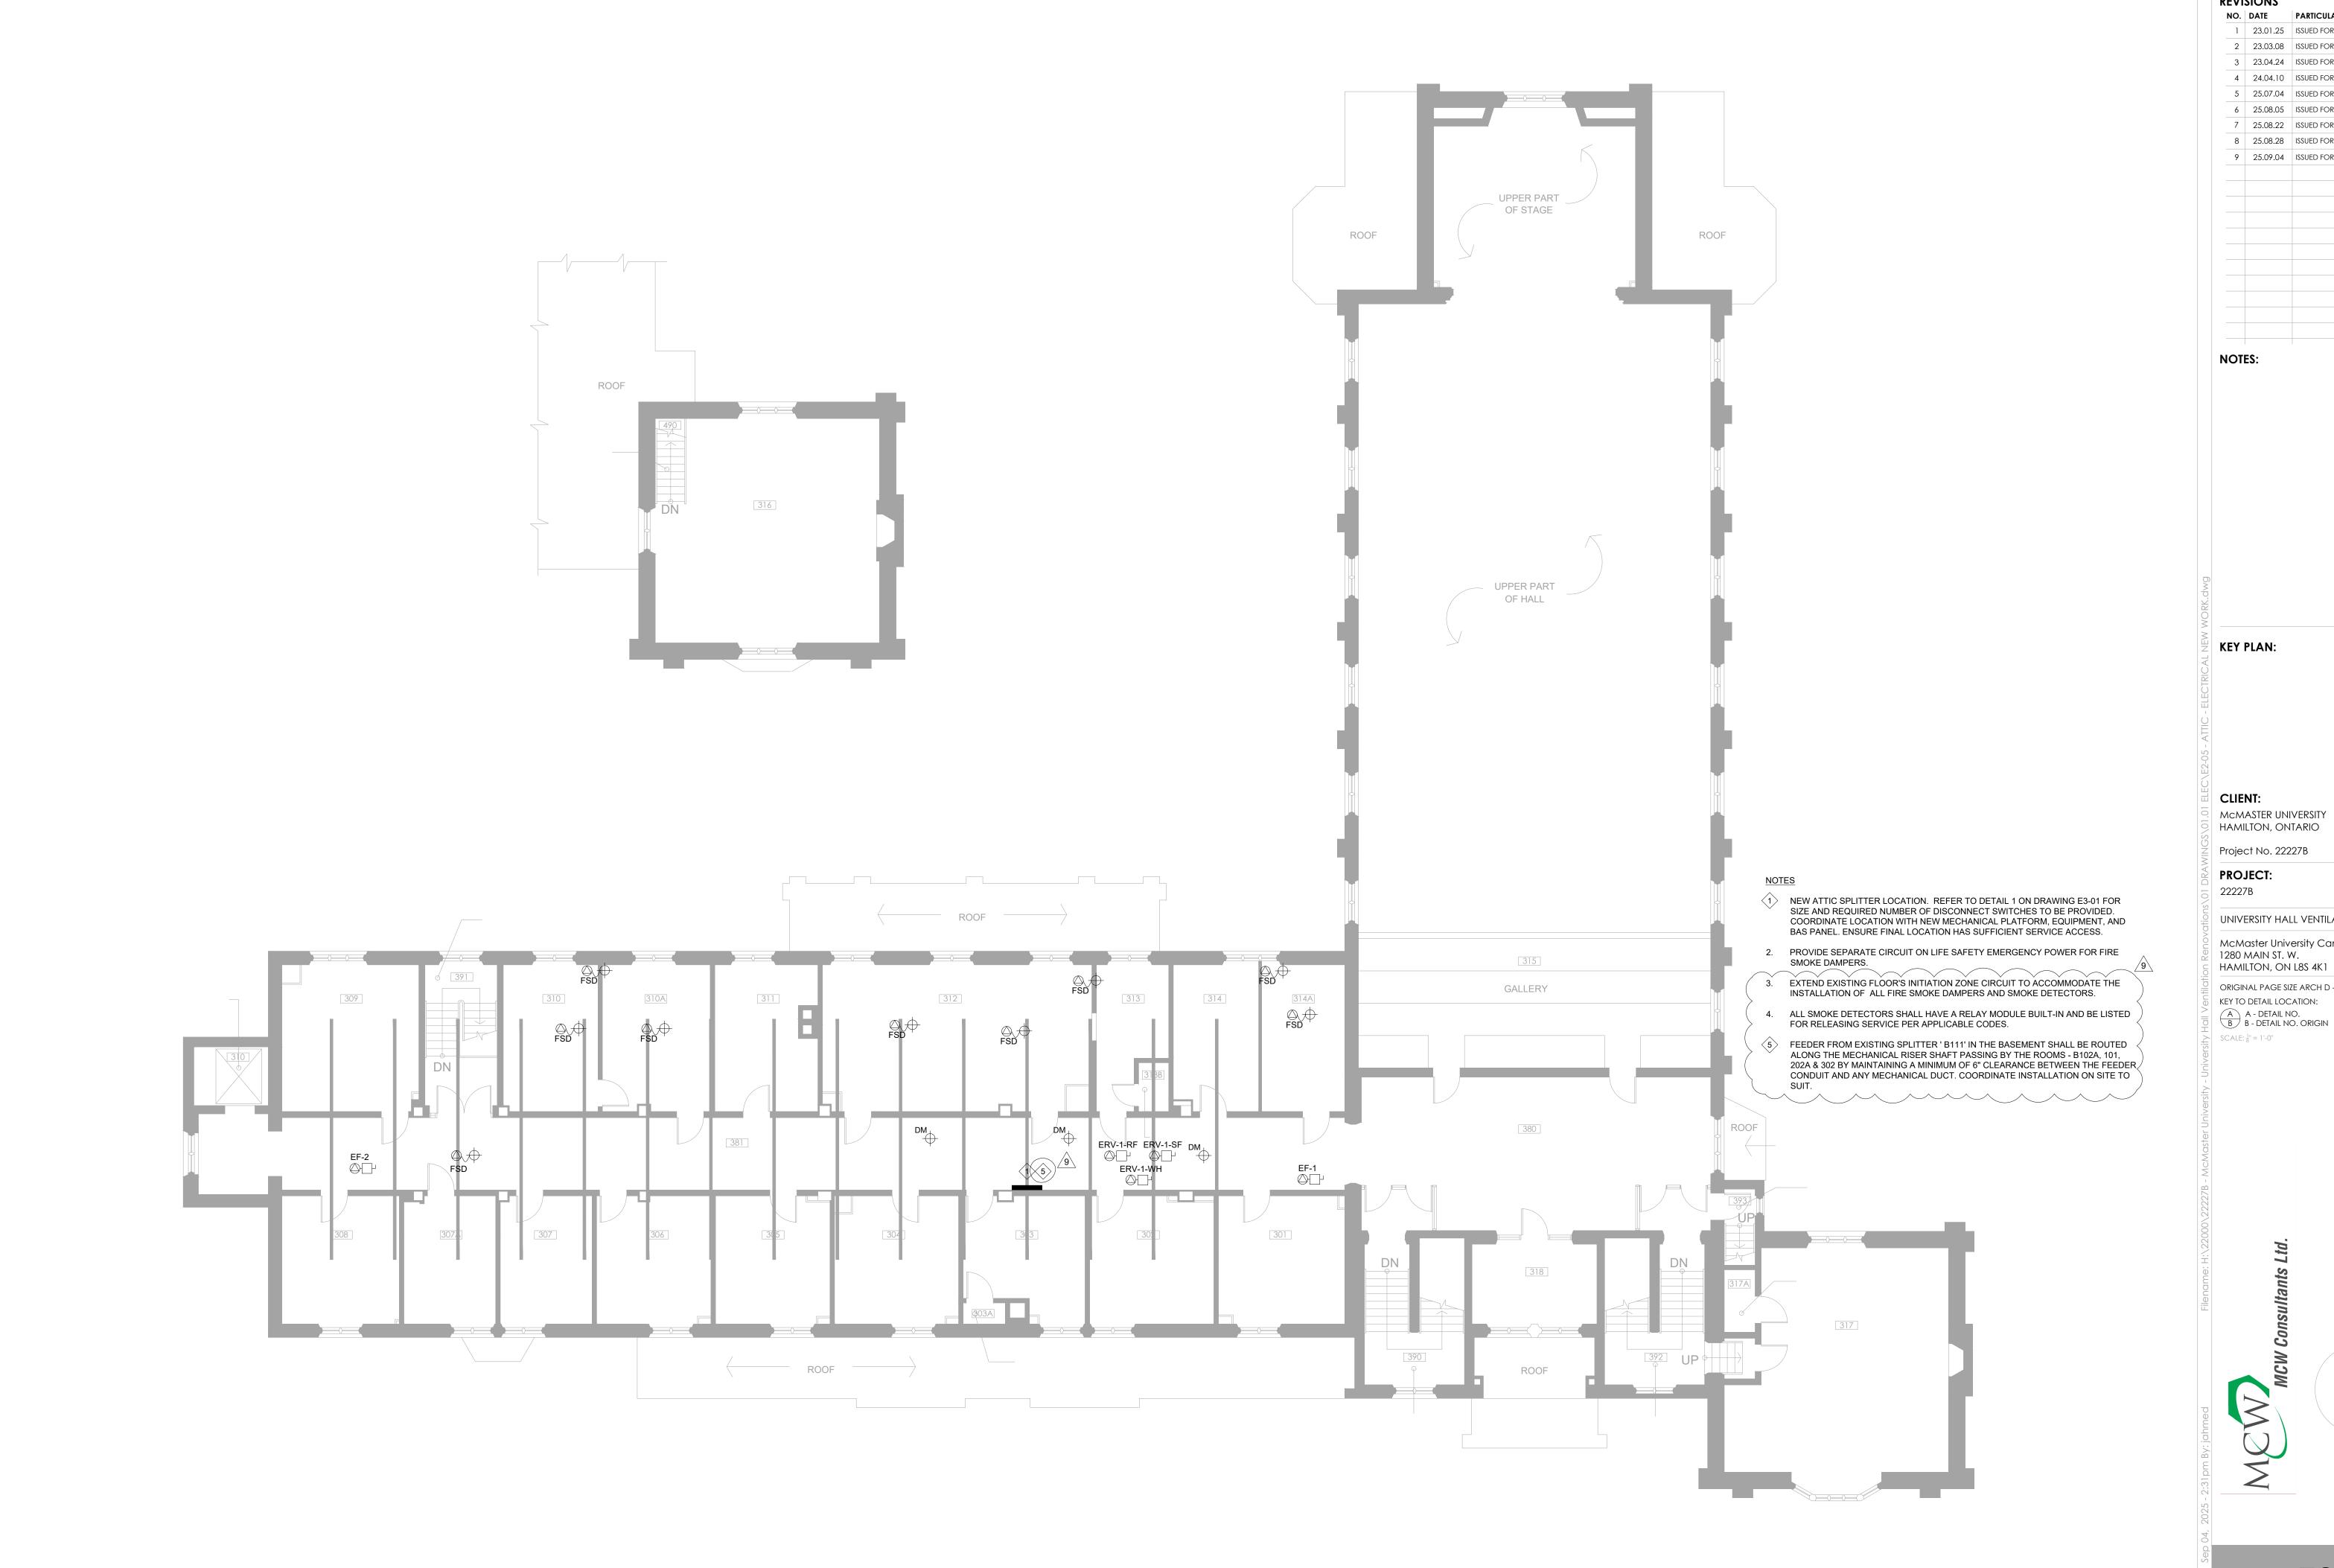

REVISIONS NO. DATE PARTICULAR 1 23.01.25 ISSUED FOR COORDINATION REVIEW 2 23.03.08 ISSUED FOR 50% DD REVIEW 3 23.04.24 ISSUED FOR 90% DD REVIEW 4 24.04.10 ISSUED FOR PRE-TENDER REVIEW 5 25.07.04 ISSUED FOR PERMIT 6 25.08.05 ISSUED FOR TENDER 7 25.08.22 ISSUED FOR ADDENDUM 01 8 25.08.28 ISSUED FOR ADDENDUM 02 9 25.09.04 ISSUED FOR ADDENDUM 03

UNIVERSITY HALL VENTILATION UPGRADE

McMaster University Campus

ORIGINAL PAGE SIZE ARCH D - 24" x 36" KEY TO DETAIL LOCATION:

A - DETAIL NO. B - DETAIL NO. ORIGIN

E2-05

DRAWN BY: CD

ATTIC - ELECTRICAL NEW WORK