
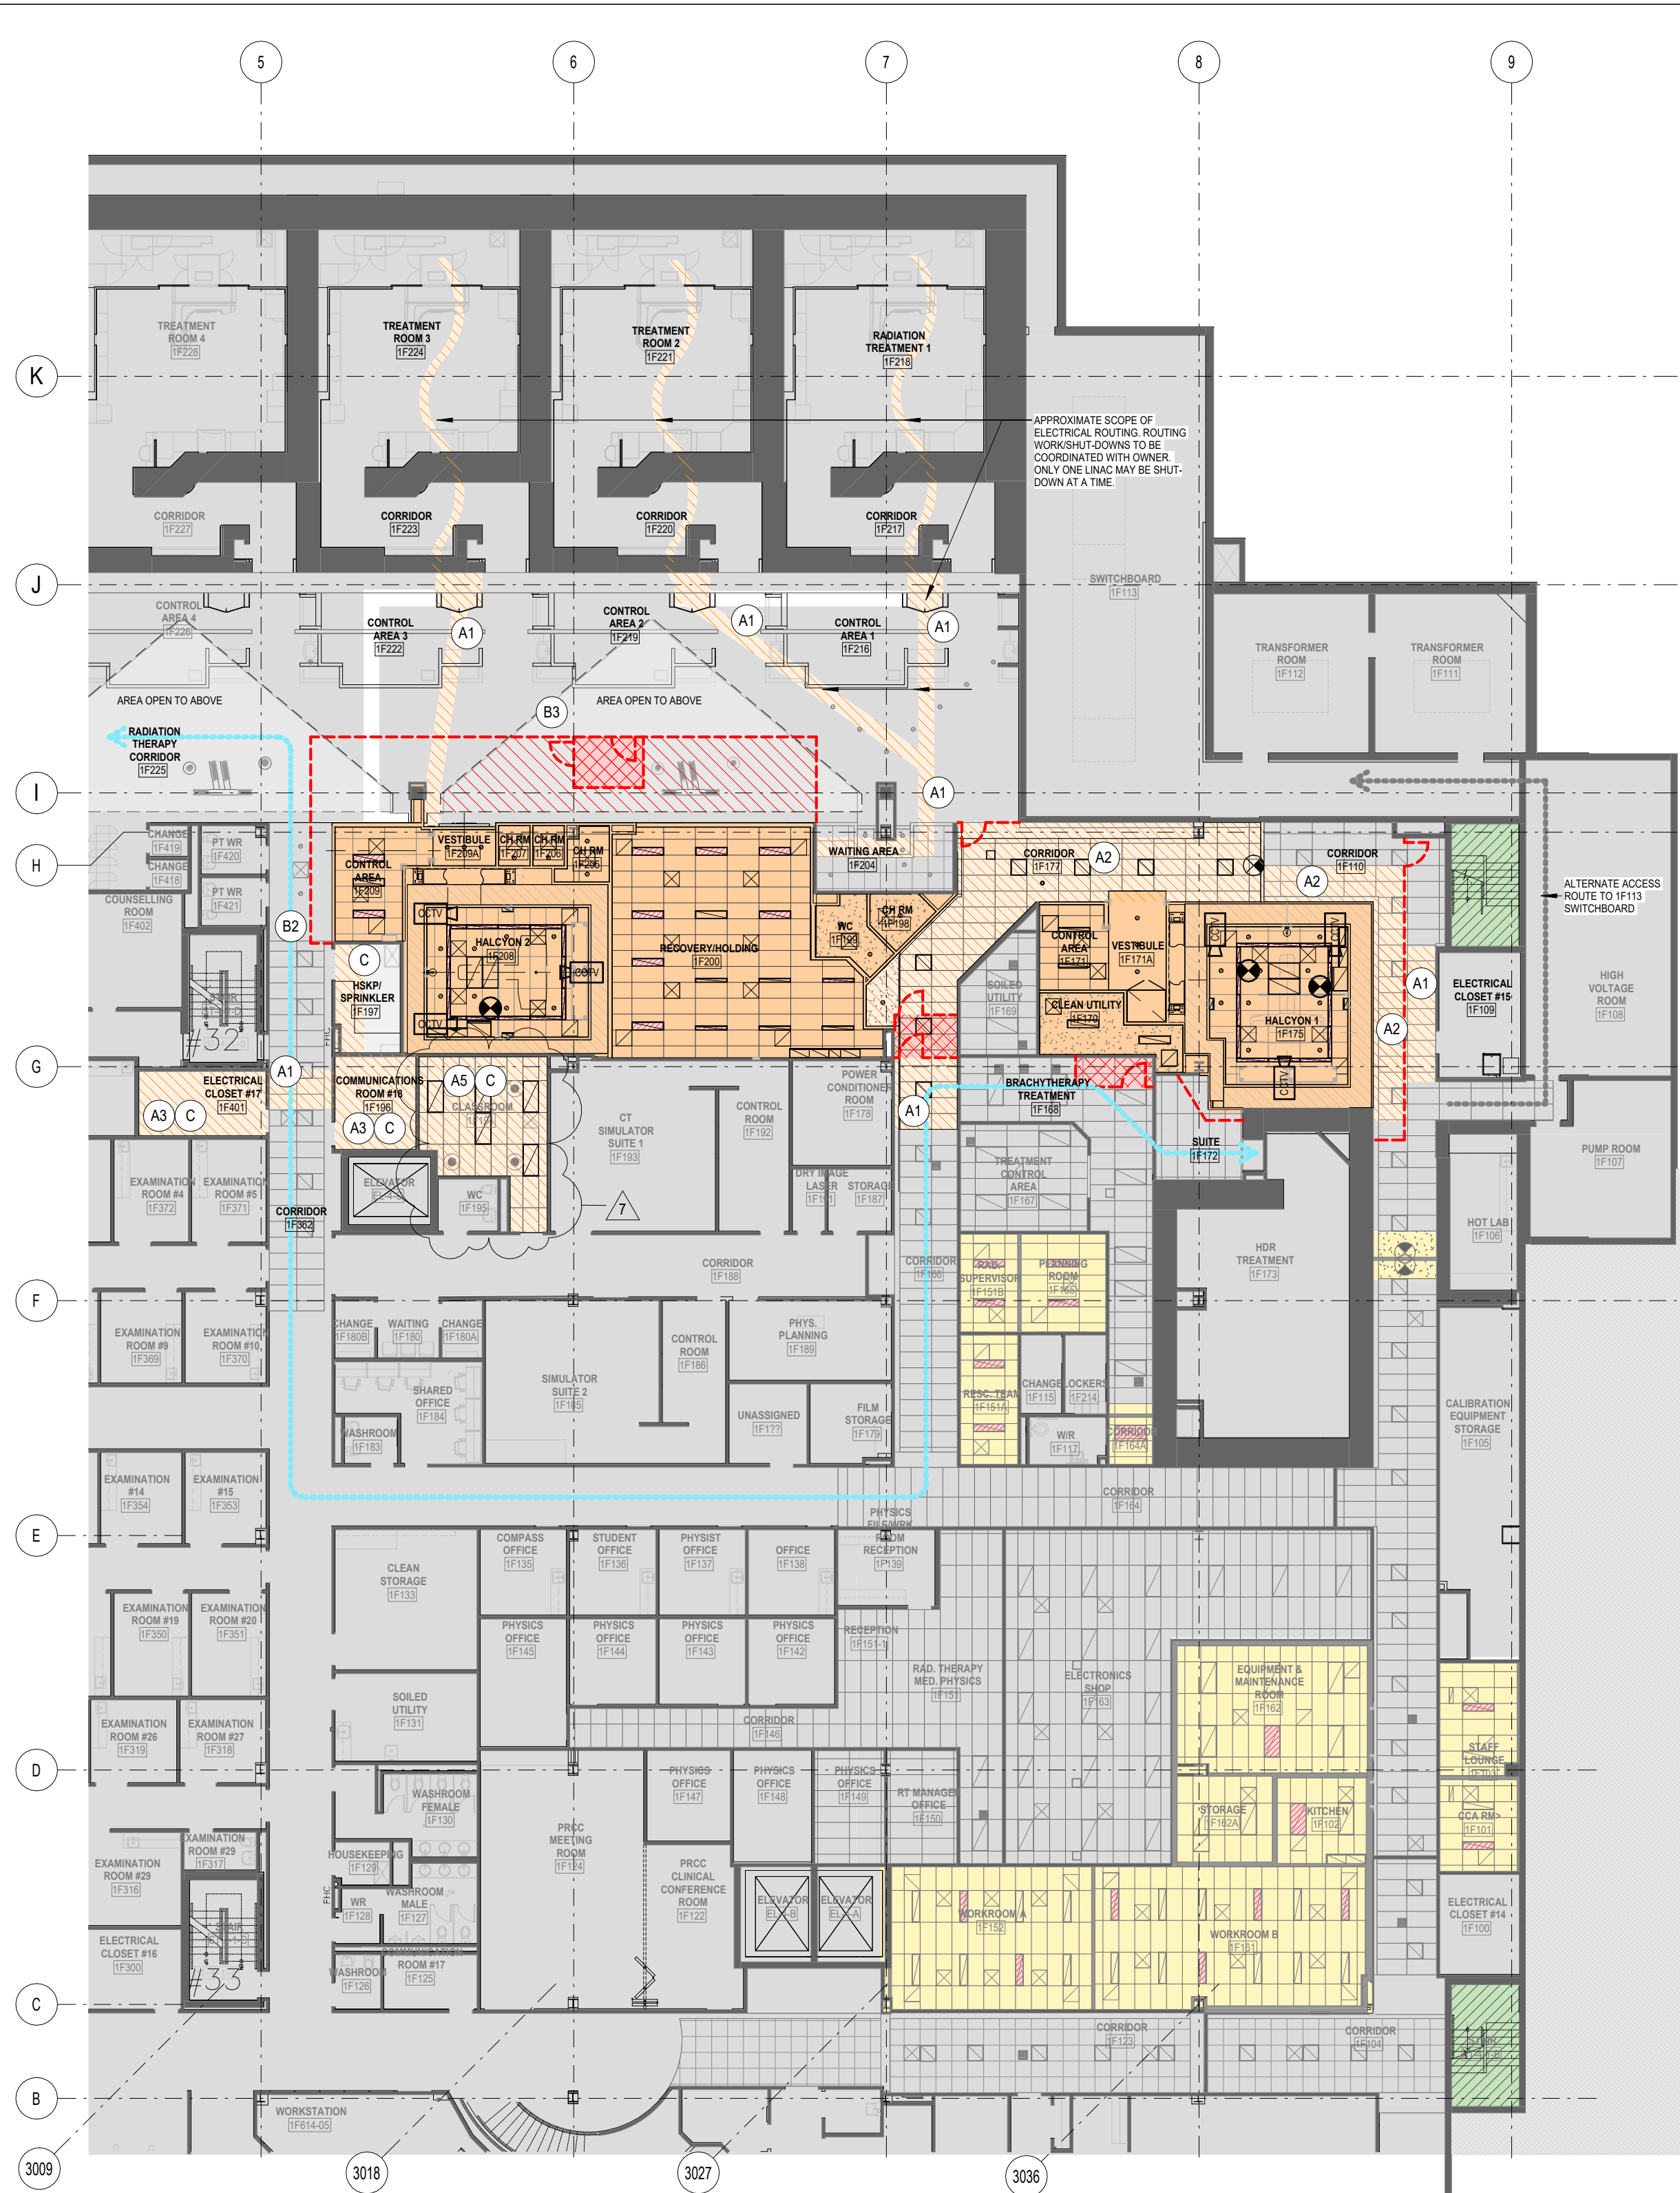


KEY PLAN

3 PROPOSED CONTRACTOR STAGING & TRAVEL ROUTES

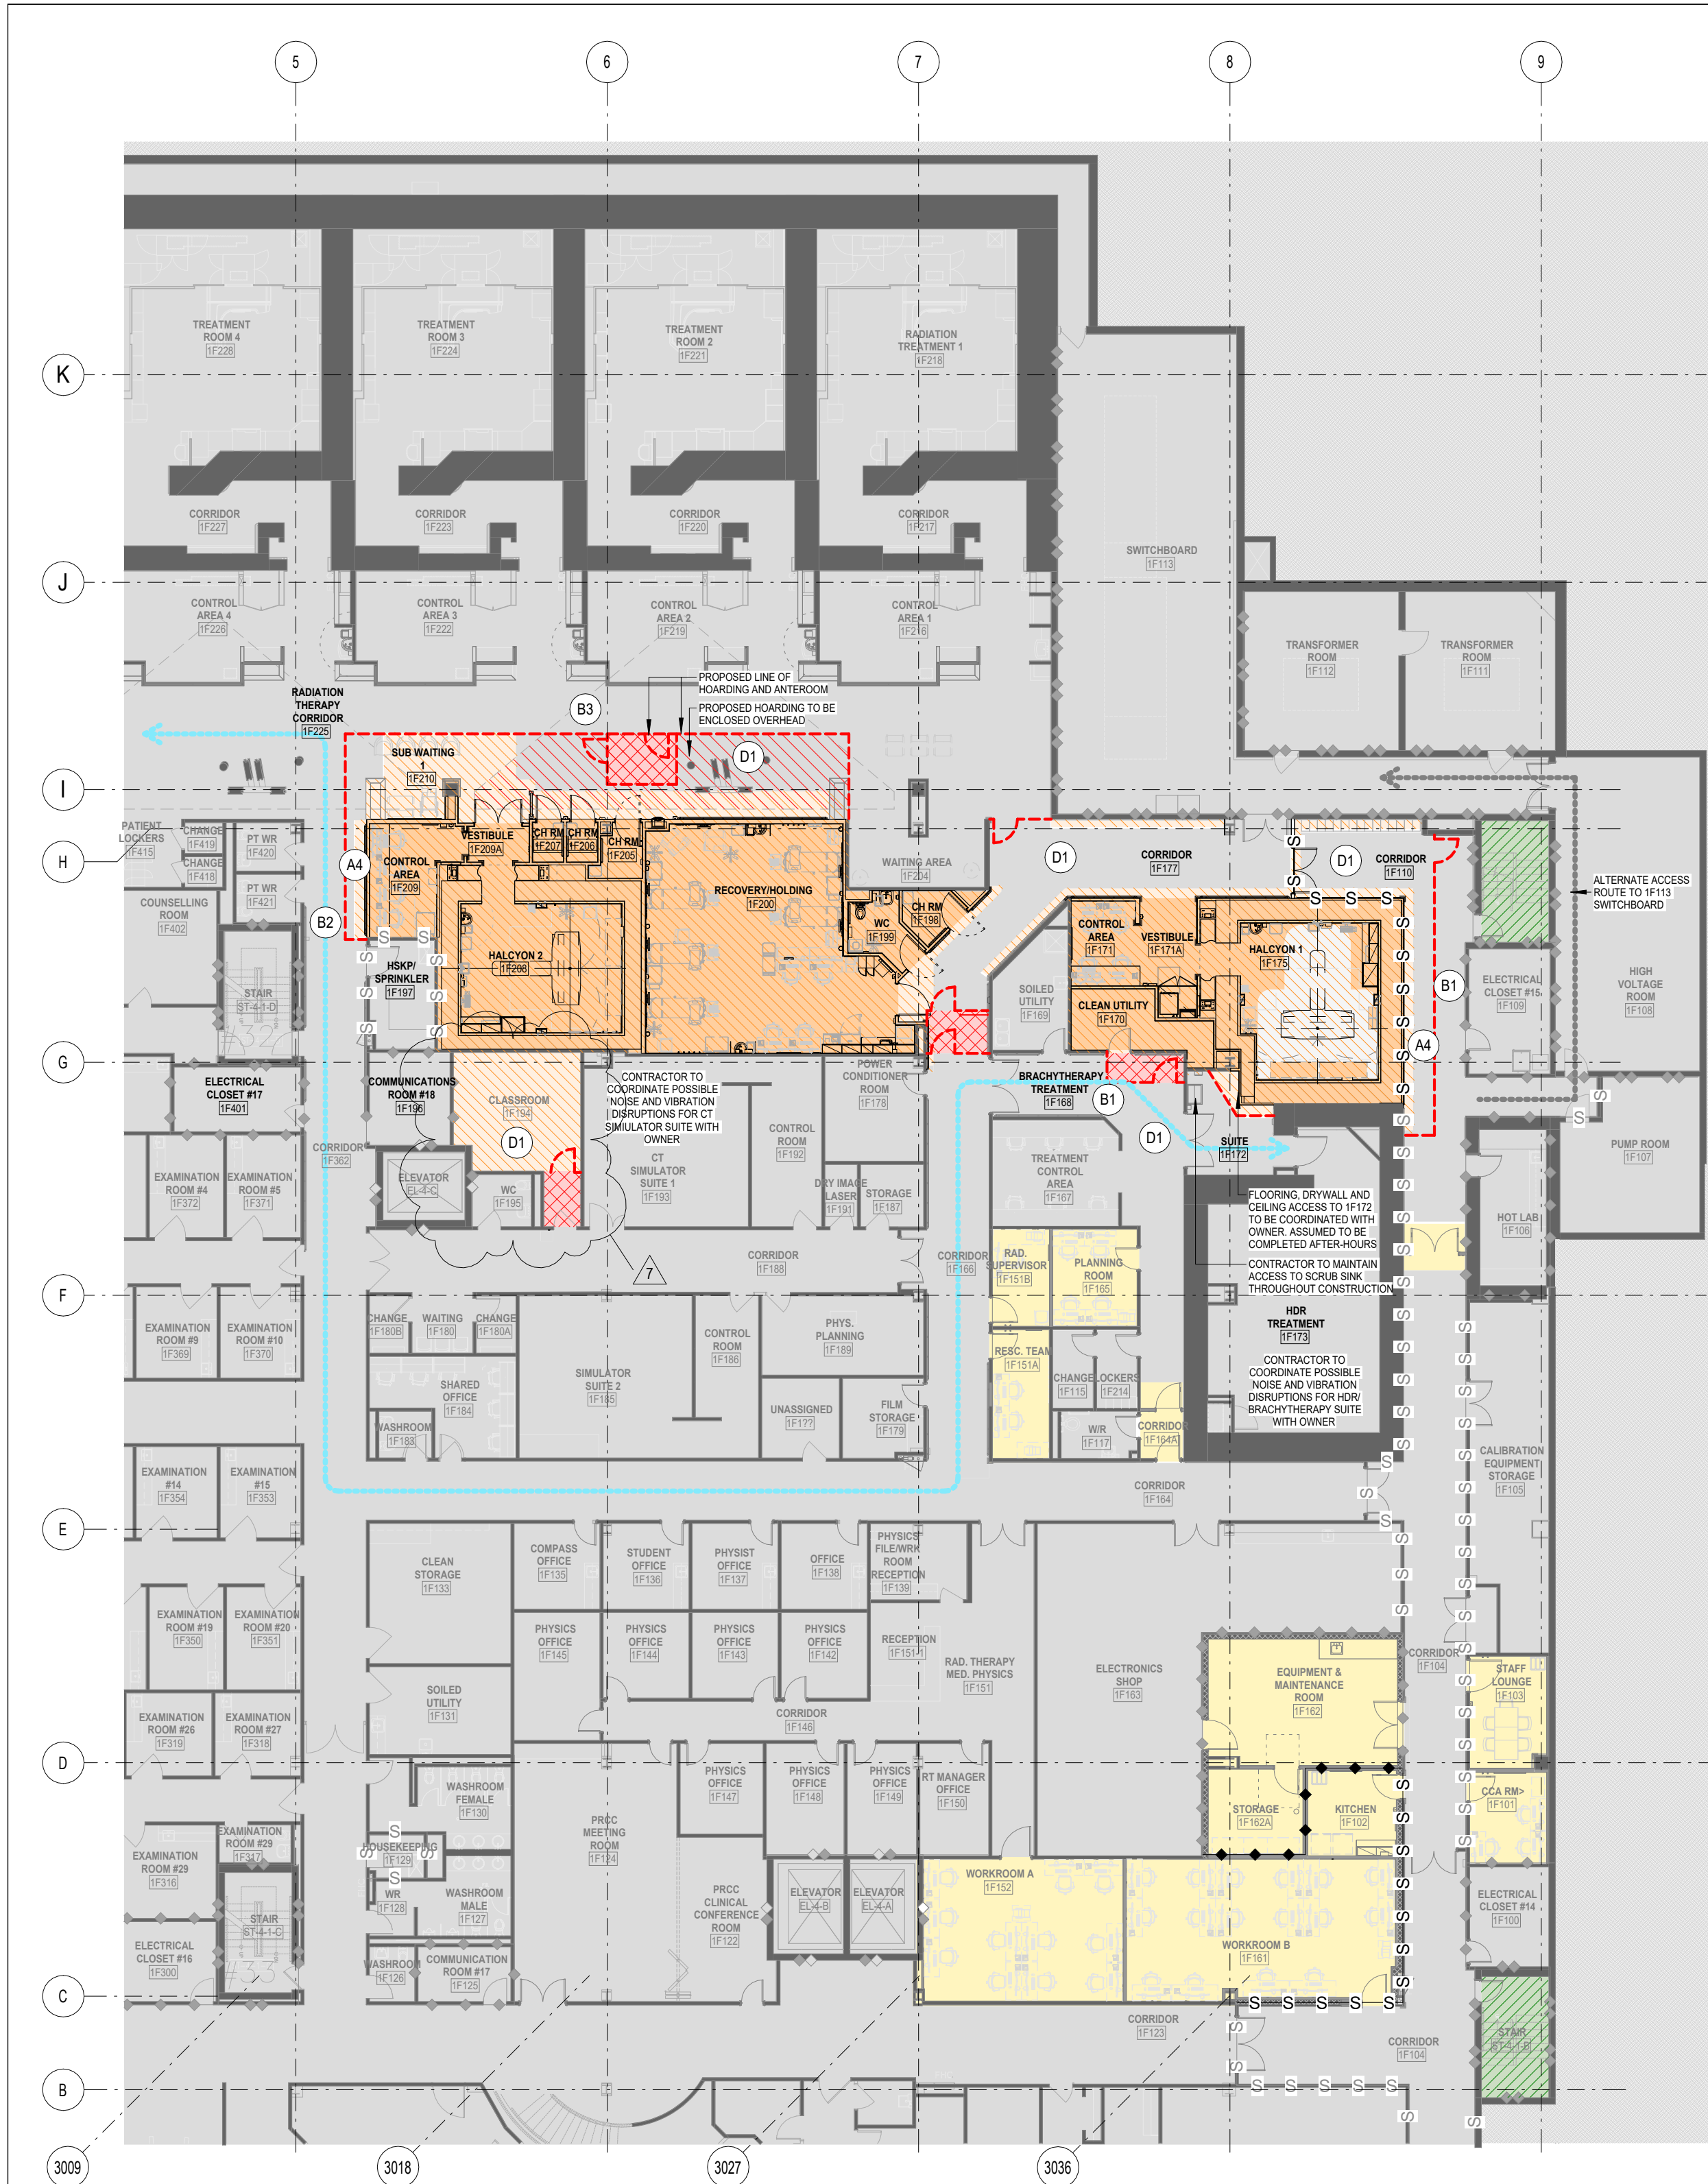

PHASING LEGEND

- AREA NOT IN CONTRACT
HATCH INDICATES AREA NOT INCLUDED IN SCOPE OF WORK
- PHASE 1
- PHASE 2
- PHASE 3

- LINE OF PROPOSED CONSTRUCTION
HOARDING
CONSTRUCT IN ACCORDANCE WITH CSA 317.13-17 AND OWNER IPAC REQUIREMENTS
- PROPOSED TEMPORARY HOARDING ANTE-ROOM. SITE VERIFY AND INSTALL NEW HARDWARE, HOARDING, MODIFICATIONS AS REQUIRED TO SUIT SCOPE, INCLUDING CEILING AND LIGHTS. TYPICAL. REMOVE AND DISPOSE UPON COMPLETION, PATCH AND MAKE GOOD ALL SURFACES UPON REMOVAL. TYPICAL. GO TO MAINTAIN SEALS, INSTALL NEW HOARDING MEASURES FOR PHASED WORK AND WALL/DOR REMOVALS AND FLASH/DOVE PATCH. ALL HOARDING PLANS TO BE APPROVED BY OWNER
- PROPOSED TEMPORARY HOARDING OVERHEAD ENCLOSURE. SITE VERIFY AND INSTALL AS REQUIRED TO SUIT SCOPE, TYPICAL

ALL HOARDING PLANS TO BE PREPARED BY CONTRACTOR AND APPROVED BY OWNER.

- PROPOSED CONTRACTOR ACCESS TO BE COORDINATED WITH OWNER.

- ACTIVE STRETCHER PATIENT ROUTE TO BE MAINTAINED DURING CONSTRUCTION. ANY DISRUPTIONS TO BE COORDINATED WITH OWNER.

EXISTING FIRE SEPARATION

- 0 HOUR / SMOKE BARRIER
- 45 MIN FIRE RATED ASSEMBLY
- 1 HOUR FIRE RATED ASSEMBLY
- 1.5 HOUR FIRE RATED ASSEMBLY
- 2 HOUR FIRE RATED ASSEMBLY

PROPOSED FIRE SEPARATION

- LINE OF 0 HOUR FIRE SEPARATION
- LINE OF 45 MIN. FIRE SEPARATION
- LINE OF 1 HOUR FIRE SEPARATION
- LINE OF 1.5 HOUR FIRE SEPARATION
- LINE OF 2 HOUR FIRE SEPARATION

- A1 APPROXIMATE AREA OF THE CEILING SCOPE FOR MECHANICAL/ELECTRICAL ROUTING WORK TO BE DONE DURING WEEKENDS. CEILING TO BE SEALED WITH FIRE-RATED PLASTIC HOARDING AT THE END OF EACH WORKING WEEKEND. PATCH & MAKE GOOD EXISTING CEILING AND FINISHES AS REQUIRED. (TYP)
- A2 APPROXIMATE AREA OF THE CEILING SCOPE FOR MECHANICAL/ELECTRICAL ROUTING. PATCH & MAKE GOOD EXISTING CEILING & FINISHES AS REQUIRED. (TYP)
- A3 APPROXIMATE AREA ELECTRICAL CONDUIT REROUTING SCOPE. ACCESS AND DISRUPTIONS TO BE COORDINATED WITH OWNER. PATCH & MAKE GOOD EXISTING FINISHES AS REQUIRED. (TYP)
- A4 APPROXIMATE AREA OF ARCHITECTURAL FINISHES SCOPE TO BE COMPLETED AFTER HOURS. ACCESS/DISRUPTIONS TO BE COORDINATED WITH OWNER.
- A5 CONTRACTOR TO DEMOLISH AND CAP MECHANICAL DUCTS AS OUTLINED IN MECHANICAL SCOPE AS EFFICIENTLY AS POSSIBLE AND EXISTING LIGHTS TO REMAIN AND TO BE RE-INSTALLED. SPRINKLER HEADS TO REMAIN IN PLACE. INSTALL A NEW CEILING GRID AND ACT, PAINT WALLS, AND RETURN CLASSROOM FOR CLIENT USE.

- B1 CONTRACTOR TO MAINTAIN ACCESS, MINIMUM 1200MM CLEAR WIDTH, OR AS AGREED WITH OWNER. CONTRACTOR TO PROVIDE ADDITIONAL TEMPORARY LIGHTING IN REMAINING CORRIDOR IF CONDITIONS REQUIRE.
- B2 CONTRACTOR TO MAINTAIN ACCESS, MINIMUM 1650MM CLEAR WIDTH, OR AS AGREED WITH OWNER. CONTRACTOR TO PROVIDE ADDITIONAL TEMPORARY LIGHTING IN REMAINING CORRIDOR IF CONDITIONS REQUIRE.
- B3 CONTRACTOR TO MAINTAIN ACCESS, MINIMUM 1650MM CLEAR WIDTH, OR AS AGREED WITH OWNER. CONTRACTOR TO PROVIDE ADDITIONAL TEMPORARY LIGHTING IN REMAINING CORRIDOR IF CONDITIONS REQUIRE.
- C ACCESS TO ROOM TO BE ARRANGED WITH OWNER. WORK ASSUMED TO BE AFTER-HOURS OR WEEKENDS.
- D1 EXISTING FLOORING TO REMAIN. CONTRACTOR TO PROTECT EXISTING FLOOR FINISH DURING CONSTRUCTION

CLIENT:

Trillium Health Partners
2200 Eglinton Avenue West
Mississauga, ON L5M 2N1
905 813 2200
thp.ca

CONSULTANT:


CUMULUS ARCHITECTS INC.
160 Pears Ave. - Suite 300
Toronto, ON M5R 3P8
416-539-0763
www.cumulusarch.com

SEAL:

This drawing, as an instrument of service, is the property of Cumulus Architects Inc. the copyright in the same being reserved to them. No reproduction is allowed without the permission of Cumulus Architects Inc. and when made must bear its name.

This drawing is not to be scaled. The contractor is to verify dimensions and data noted herein for conformity with the conditions on site and is responsible for reporting in writing any discrepancy to Cumulus Architects Inc. for adjustment.

Cumulus will not be liable for any claims or damages arising from the unauthorized use of this drawing or any portion thereof.

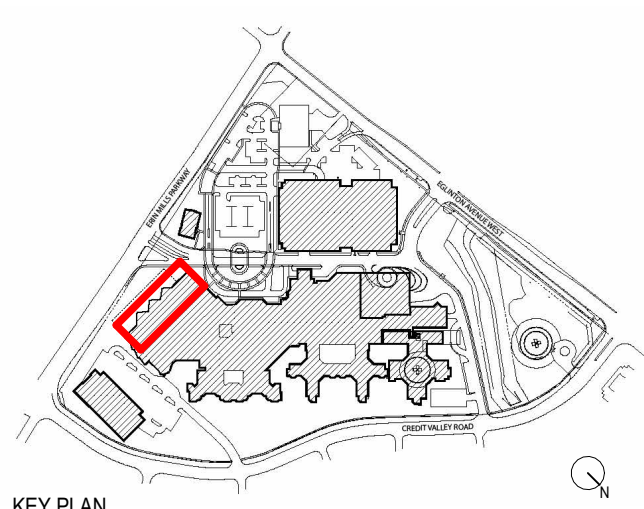

KEY PLAN

NO	DESCRIPTION	DATE
7	Issued for Addendum 1	2026/02/04
6	Issued for Tender	2025/12/16
5	Issued for Building Permit	2025/10/02
4	Issued For MOH 2.3 Resubmission	2025/06/20
2	Issued For MOH 2.3 Costing	2024/09/13
1	Issued For MOH 1.3/2.1/2.2	2023/10/18

SHEET REVISION

PROJECT:
Oncology Radiation Treatment Expansion
2200 Eglinton Ave W,
Mississauga, ON L5M 2N1


TITLE:
PHASE 2

PROJECT NO:
23010
CHECKED:
Checker

DRAWING NO:
A052



1 PHASING FLOOR PLAN - LEVEL 1 - PHASE 3
1:200

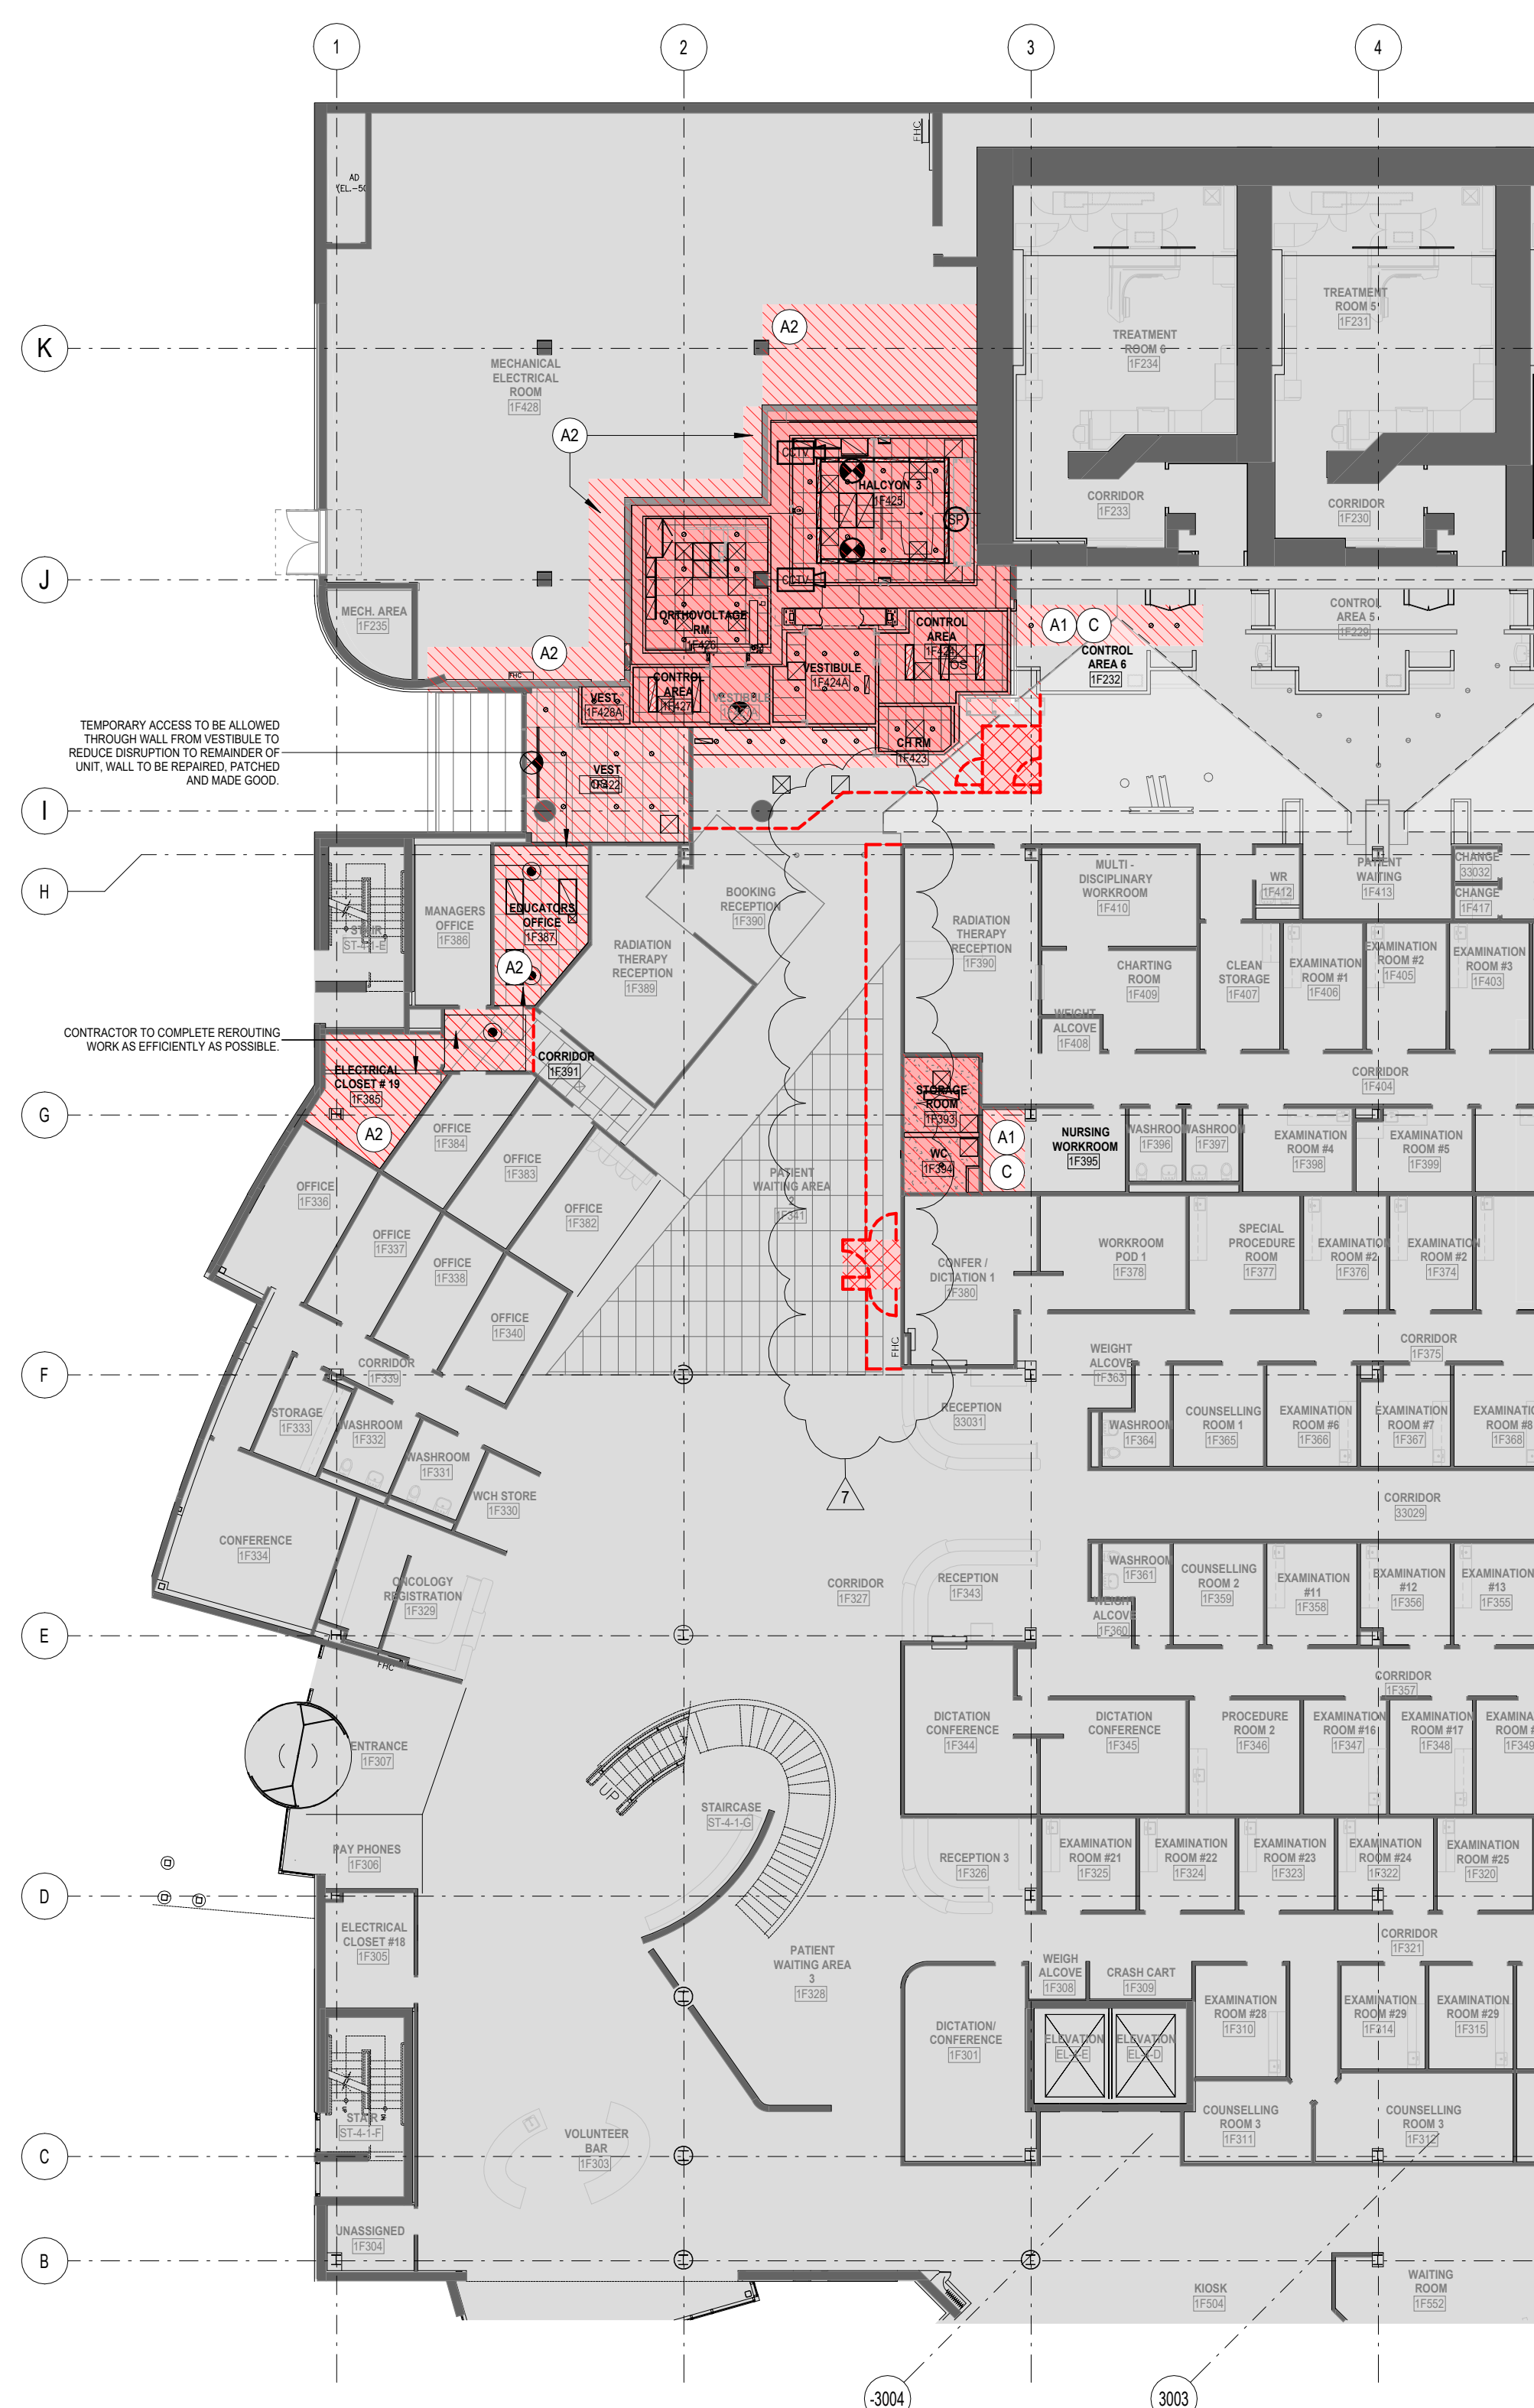

2 RCP - LEVEL 1 - PHASE 3
1:200

PHASING LEGEND

AREA NOT IN CONTRACT
HATCH INDICATES AREA NOT INCLUDED IN SCOPE OF WORK

PHASE 1

PHASE 2

PHASE 3

LINE OF PROPOSED CONSTRUCTION
HOARDING
CONSTRUCT IN ACCORDANCE WITH CSA 317.13-17 AND OWNER IPAC REQUIREMENTS

PROPOSED TEMPORARY HOARDING ANTE-ROOM. SITE VERIFY AND INSTALL NEW HARDWARE, HOARDING, MODIFICATIONS AS REQUIRED TO SUIT SCOPE, INCLUDING CEILING AND LIGHTS. TYPICAL. REMOVE AND DISPOSE UPON COMPLETION. PATCH AND MAKE GOOD ALL SURFACES UPON REMOVAL. TYPICAL. GO TO MAINTAIN SEALS, INSTALL NEW HOARDING MEASURES FOR PHASED WORK AND WALL/DOOR REMOVALS AND FLASHDOVE PATCH. ALL HOARDING PLANS TO BE APPROVED BY OWNER.

PROPOSED TEMPORARY HOARDING OVERHEAD ENCLOSURE. SITE VERIFY AND INSTALL AS REQUIRED TO SUIT SCOPE, TYPICAL.

ALL HOARDING PLANS TO BE PREPARED BY CONTRACTOR AND APPROVED BY OWNER.

PROPOSED CONTRACTOR ACCESS TO BE COORDINATED WITH OWNER.

ACTIVE STRETCHER PATIENT ROUTE TO BE MAINTAINED DURING CONSTRUCTION. ANY DISRUPTIONS TO BE COORDINATED WITH OWNER.

EXISTING FIRE SEPARATION

0 HOUR / SMOKE BARRIER
45 MIN FIRE RATED ASSEMBLY
1 HOUR FIRE RATED ASSEMBLY
1.5 HOUR FIRE RATED ASSEMBLY
2 HOUR FIRE RATED ASSEMBLY

PROPOSED FIRE SEPARATION

LINE OF 0 HOUR FIRE SEPARATION
LINE OF 45 MIN. FIRE SEPARATION
LINE OF 1 HOUR FIRE SEPARATION
LINE OF 1.5 HOUR FIRE SEPARATION
LINE OF 2 HOUR FIRE SEPARATION

- A1 APPROXIMATE AREA OF THE CEILING SCOPE FOR MECHANICAL/ELECTRICAL ROUTING WORK TO BE DONE DURING WEEKENDS. CEILING TO BE SEALED WITH FIRE-RATED PLASTIC HOARDING AT THE END OF EACH WORKING WEEKEND. PATCH & MAKE GOOD EXISTING CEILING AND FINISHES AS REQUIRED. (TYP)
- A2 APPROXIMATE AREA OF THE CEILING SCOPE FOR MECHANICAL/ELECTRICAL ROUTING. PATCH & MAKE GOOD EXISTING CEILING & FINISHES AS REQUIRED. (TYP)
- A3 APPROXIMATE AREA ELECTRICAL CONDUIT REROUTING SCOPE, ACCESS AND DISRUPTIONS TO BE COORDINATED WITH OWNER. PATCH & MAKE GOOD EXISTING FINISHES AS REQUIRED. (TYP)
- A4 APPROXIMATE AREA OF ARCHITECTURAL/FINISHES SCOPE TO BE COMPLETED AFTER HOURS. ACCESS/DISRUPTIONS TO BE COORDINATED WITH OWNER.
- A5 CONTRACTOR TO DEMOLISH AND CAP MECHANICAL DUCTS AS OUTLINED IN MECHANICAL SCOPE AS EFFICIENTLY AS POSSIBLE AND EXISTING LIGHTS TO REMAIN AND TO BE RE-INSTALLED. SPRINKLER HEADS TO REMAIN IN PLACE. INSTALL A NEW CEILING GRID AND ACT, PAINT WALLS, AND RETURN CLASSROOM FOR CLIENT USE.
- B1 CONTRACTOR TO MAINTAIN ACCESS. MINIMUM 1200MM CLEAR WIDTH. OR AS AGREED WITH OWNER. CONTRACTOR TO PROVIDE ADDITIONAL TEMPORARY LIGHTING IN REMAINING CORRIDOR IF CONDITIONS REQUIRE.
- B2 CONTRACTOR TO MAINTAIN ACCESS. MINIMUM 1650MM CLEAR WIDTH. OR AS AGREED WITH OWNER. CONTRACTOR TO PROVIDE ADDITIONAL TEMPORARY LIGHTING IN REMAINING CORRIDOR IF CONDITIONS REQUIRE.
- B3 CONTRACTOR TO MAINTAIN ACCESS. MINIMUM 1850MM CLEAR WIDTH. OR AS AGREED WITH OWNER. CONTRACTOR TO PROVIDE ADDITIONAL TEMPORARY LIGHTING IN REMAINING CORRIDOR IF CONDITIONS REQUIRE.
- C ACCESS TO ROOM TO BE ARRANGED WITH OWNER. WORK ASSUMED TO BE AFTER-HOURS OR WEEKENDS.
- D1 EXISTING FLOORING TO REMAIN. CONTRACTOR TO PROTECT EXISTING FLOOR FINISH DURING CONSTRUCTION

CLIENT:

Trillium Health Partners

2200 Eglinton Avenue West
Mississauga, ON L5M 2N1
905 813 2200
thp.ca

CONSULTANT:

CUMULUS ARCHITECTS INC.


160 Pears Ave. - Suite 300
Toronto, ON M5R 3P8
416-539-0763
www.cumulusarch.com

SEAL:

This drawing, as an instrument of service, is the property of Cumulus Architects Inc. the copyright in the same being reserved to them. No reproduction is allowed without the permission of Cumulus Architects Inc. and when made must bear its name.

This drawing is not to be scaled. The contractor is to verify dimensions and data noted herein for conformity with the conditions on site and is responsible for reporting in writing any discrepancy to Cumulus Architects Inc. for adjustment.

Cumulus will not be liable for any claims or damages arising from the unauthorized use of this drawing or any portion thereof.

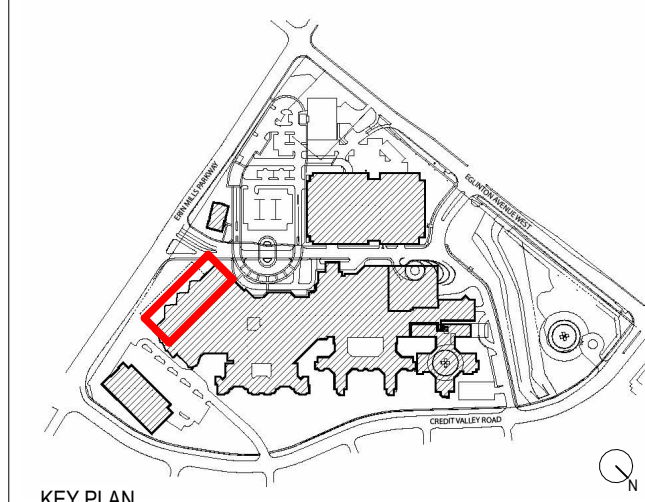

KEY PLAN

NO	DESCRIPTION	DATE
7	Issued for Addendum 1	2026/02/04
6	Issued for Tender	2025/12/16
5	Issued for Building Permit	2025/12/02
4	Issued For MOH 2.3 Resubmission	2025/06/20
2	Issued For MOH 2.3 Costing	2024/09/13
1	Issued For MOH 1.3/2.1/2.2	2023/10/18

SHEET REVISION


PROJECT:
Oncology Radiation Treatment Expansion
2200 Eglinton Ave W,
Mississauga, ON L5M 2N1

TITLE:
PHASE 3

PROJECT NO:
23010
CHECKED:
Checker

DRAWING NO:

A053

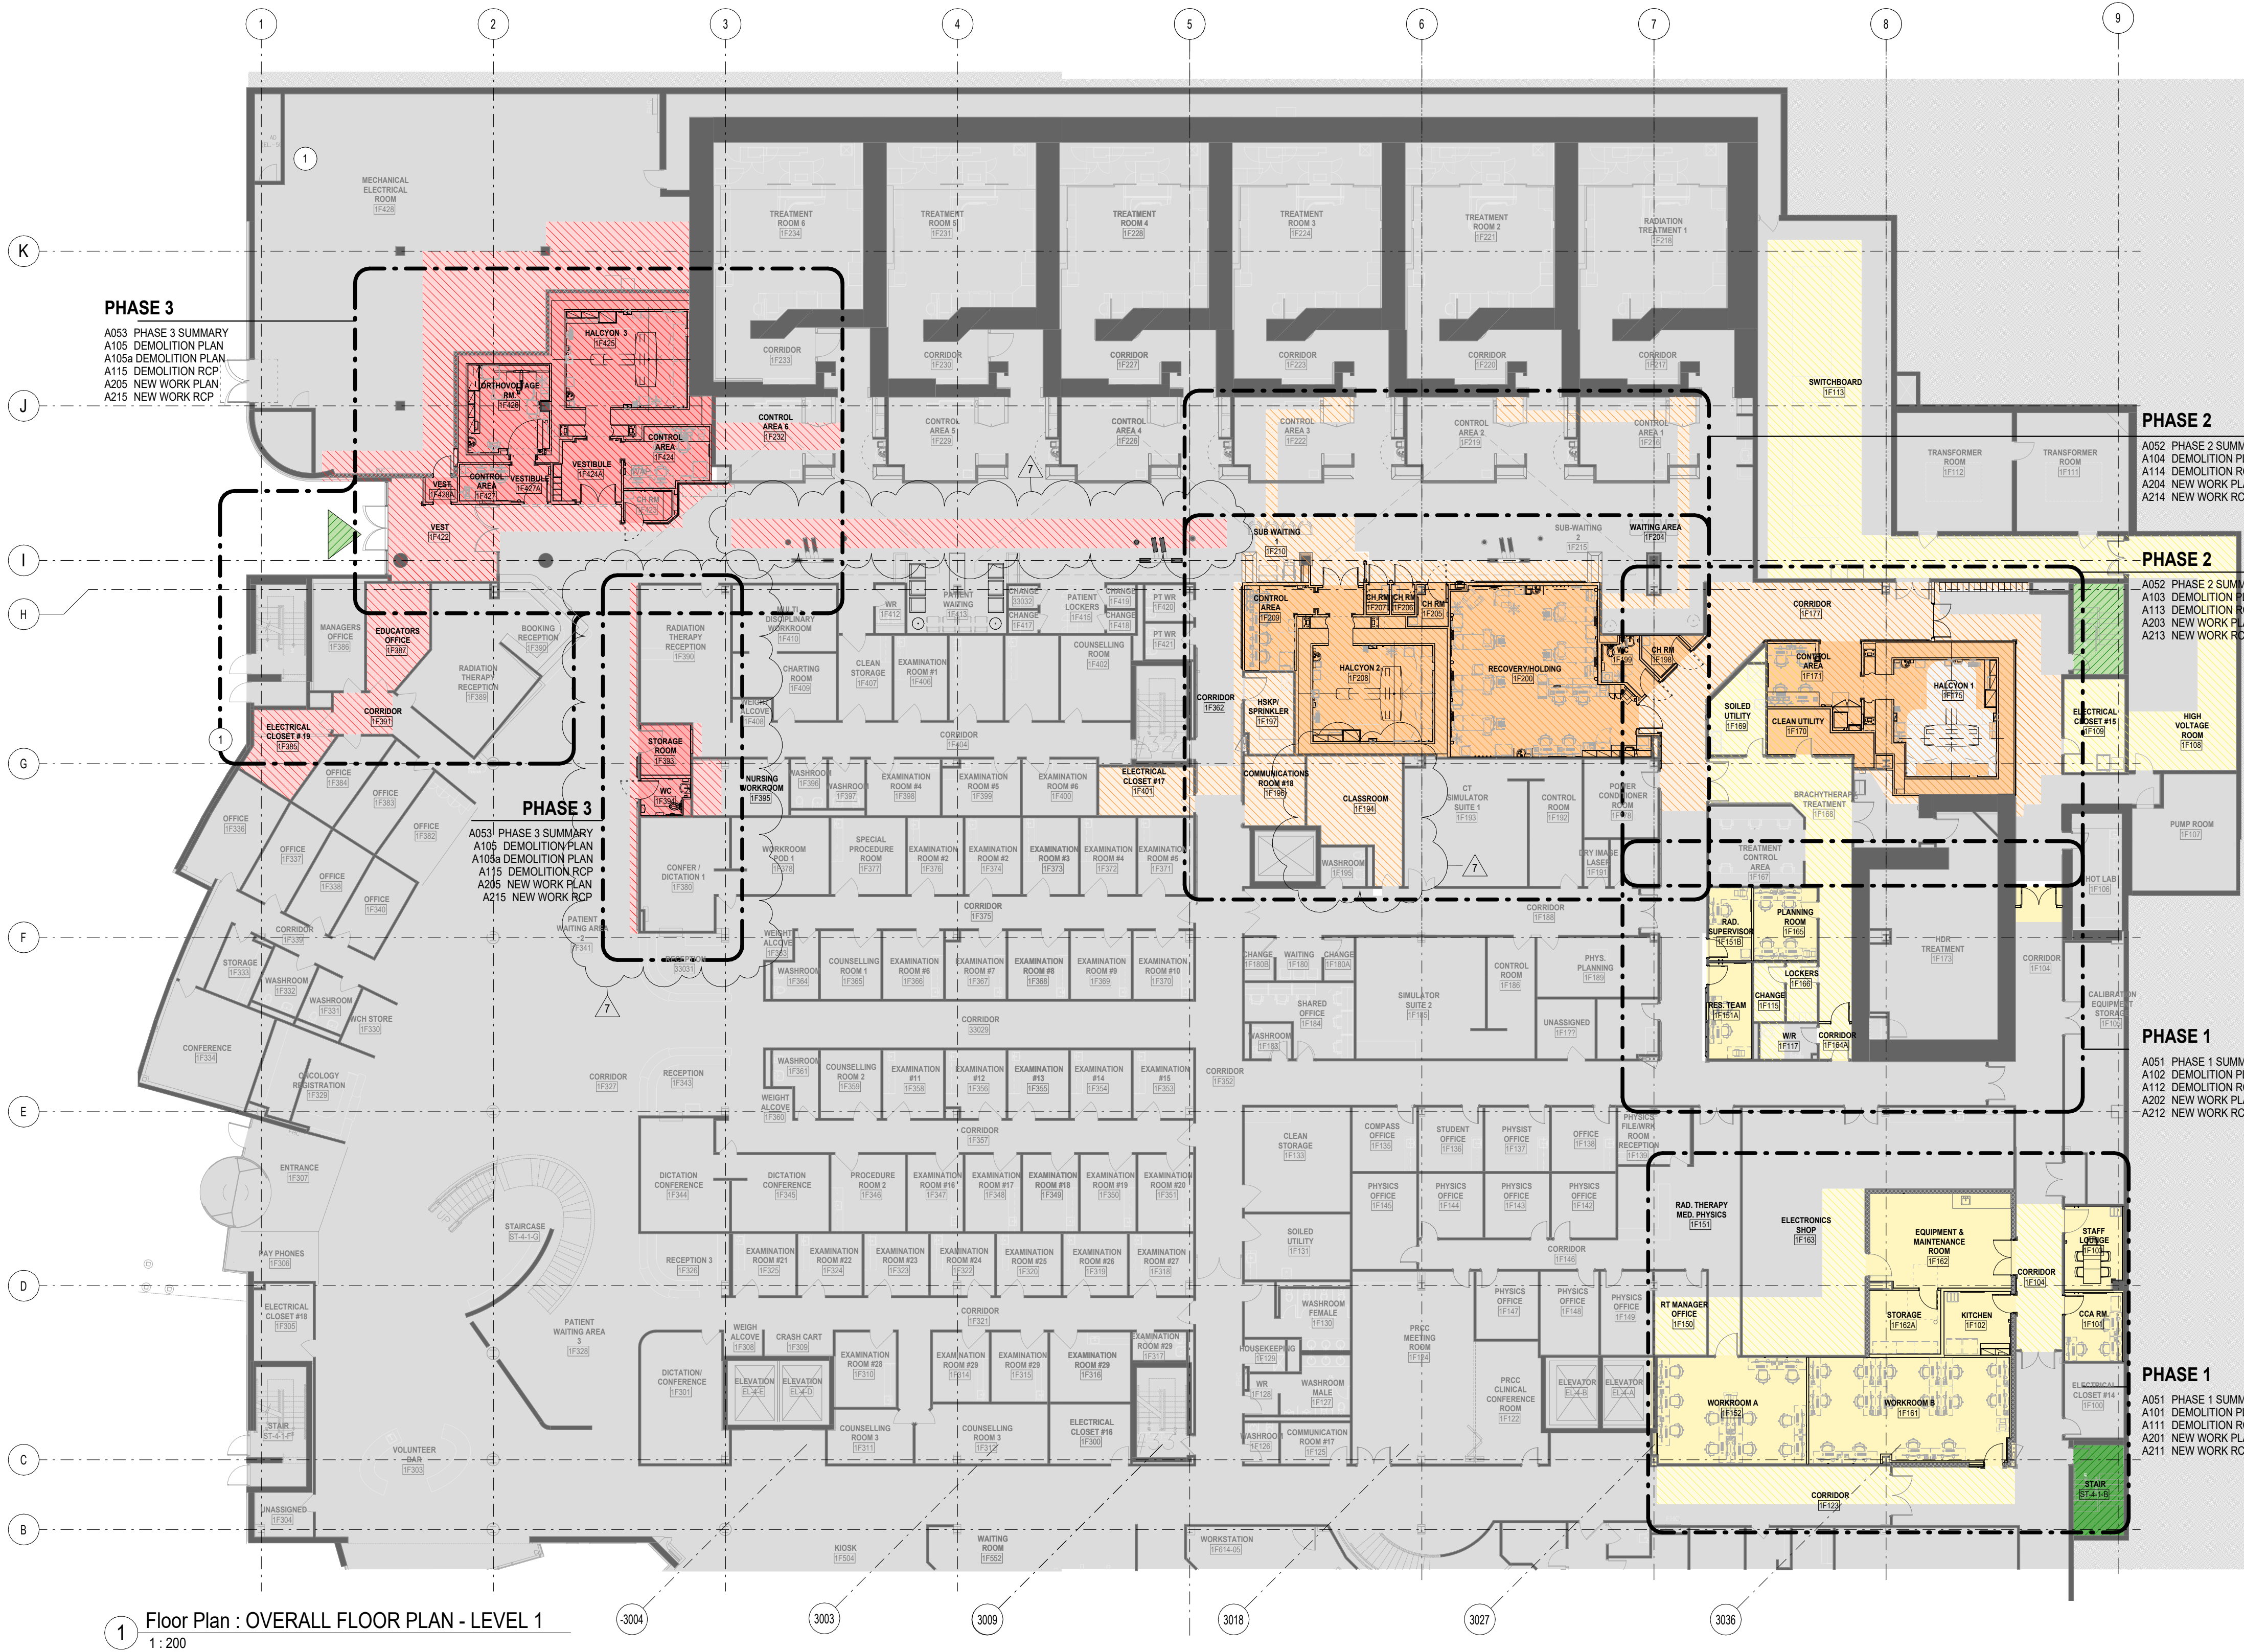

1 Floor Plan : OVERALL FLOOR PLAN - LEVEL 1
1 : 200

PHASING LEGEND

AREA NOT IN CONTRACT
HATCH INDICATES AREA NOT INCLUDED IN SCOPE OF WORK

PHASE 1

PHASE 2

PHASE 3

LINE OF PROPOSED CONSTRUCTION
HOARDING
CONSTRUCT IN ACCORDANCE WITH CSA 317.13-17 AND OWNER IPAC REQUIREMENTS

PROPOSED TEMPORARY HOARDING ANTE-ROOM. SITE VERIFY AND INSTALL NEW HARDWARE, HOARDING, MODIFICATIONS AS REQUIRED TO SUIT SCOPE, INCLUDING CEILING AND LIGHTS. TYPICAL. REMOVE AND DISPOSE UPON COMPLETION, PATCH AND MAKE GOOD ALL SURFACES UPON REMOVAL. TYPICAL. GO TO MAINTAIN SEALS, INSTALL NEW HOARDING MEASURES FOR PHASED WORK AND WALL/DOR REMOVALS AND FLASHDOVE PATCH. ALL HOARDING PLANS TO BE APPROVED BY OWNER.

PROPOSED TEMPORARY HOARDING OVERHEAD ENCLOSURE. SITE VERIFY AND INSTALL AS REQUIRED TO SUIT SCOPE, TYPICAL.

ALL HOARDING PLANS TO BE PREPARED BY CONTRACTOR AND APPROVED BY OWNER.

PROPOSED CONTRACTOR ACCESS TO BE COORDINATED WITH OWNER.

CLIENT:
Trillium Health Partners
2200 Eglinton Avenue West
Mississauga, ON L5M 2N1
905 813 2200
thp.ca


CONSULTANT:
CUMULUS ARCHITECTS INC.
160 Pears Ave. - Suite 300
Toronto, ON M5R 3P8
416-539-0763
www.cumulusarch.com

SEAL:

This drawing, as an instrument of service, is the property of Cumulus Architects Inc. the copyright in the same being reserved to them. No reproduction is allowed without the permission of Cumulus Architects Inc. and when made must bear its name.

This drawing is not to be scaled. The contractor is to verify dimensions and data noted herein for conformity with the conditions on site and is responsible for reporting in writing any discrepancy to Cumulus Architects Inc. for adjustment.

Cumulus will not be liable for any claims or damages arising from the unauthorized use of this drawing or any portion thereof.

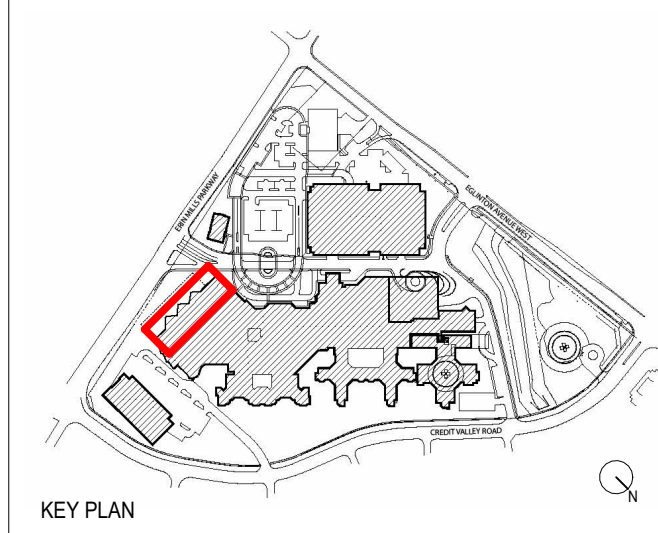

SHEET REVISION		
NO	DESCRIPTION	DATE
7	Issued for Addendum 1	2026/02/04
6	Issued for Tender	2025/12/16
5	Issued for Building Permit	2025/12/02
4	Issued For MOH 2.3 Resubmission	2025/06/20
2	Issued For MOH 2.3 Costing	2024/09/13
1	Issued For MOH 1.3/2.1/2.2	2023/10/18


PROJECT:
Oncology Radiation Treatment Expansion
2200 Eglinton Ave W,
Mississauga, ON L5M 2N1

TITLE:
PHASING DIAGRAM NEW CONSTRUCTION

PROJECT NO:
23010

CHECKED:
Checker

DRAWING NO:
A054

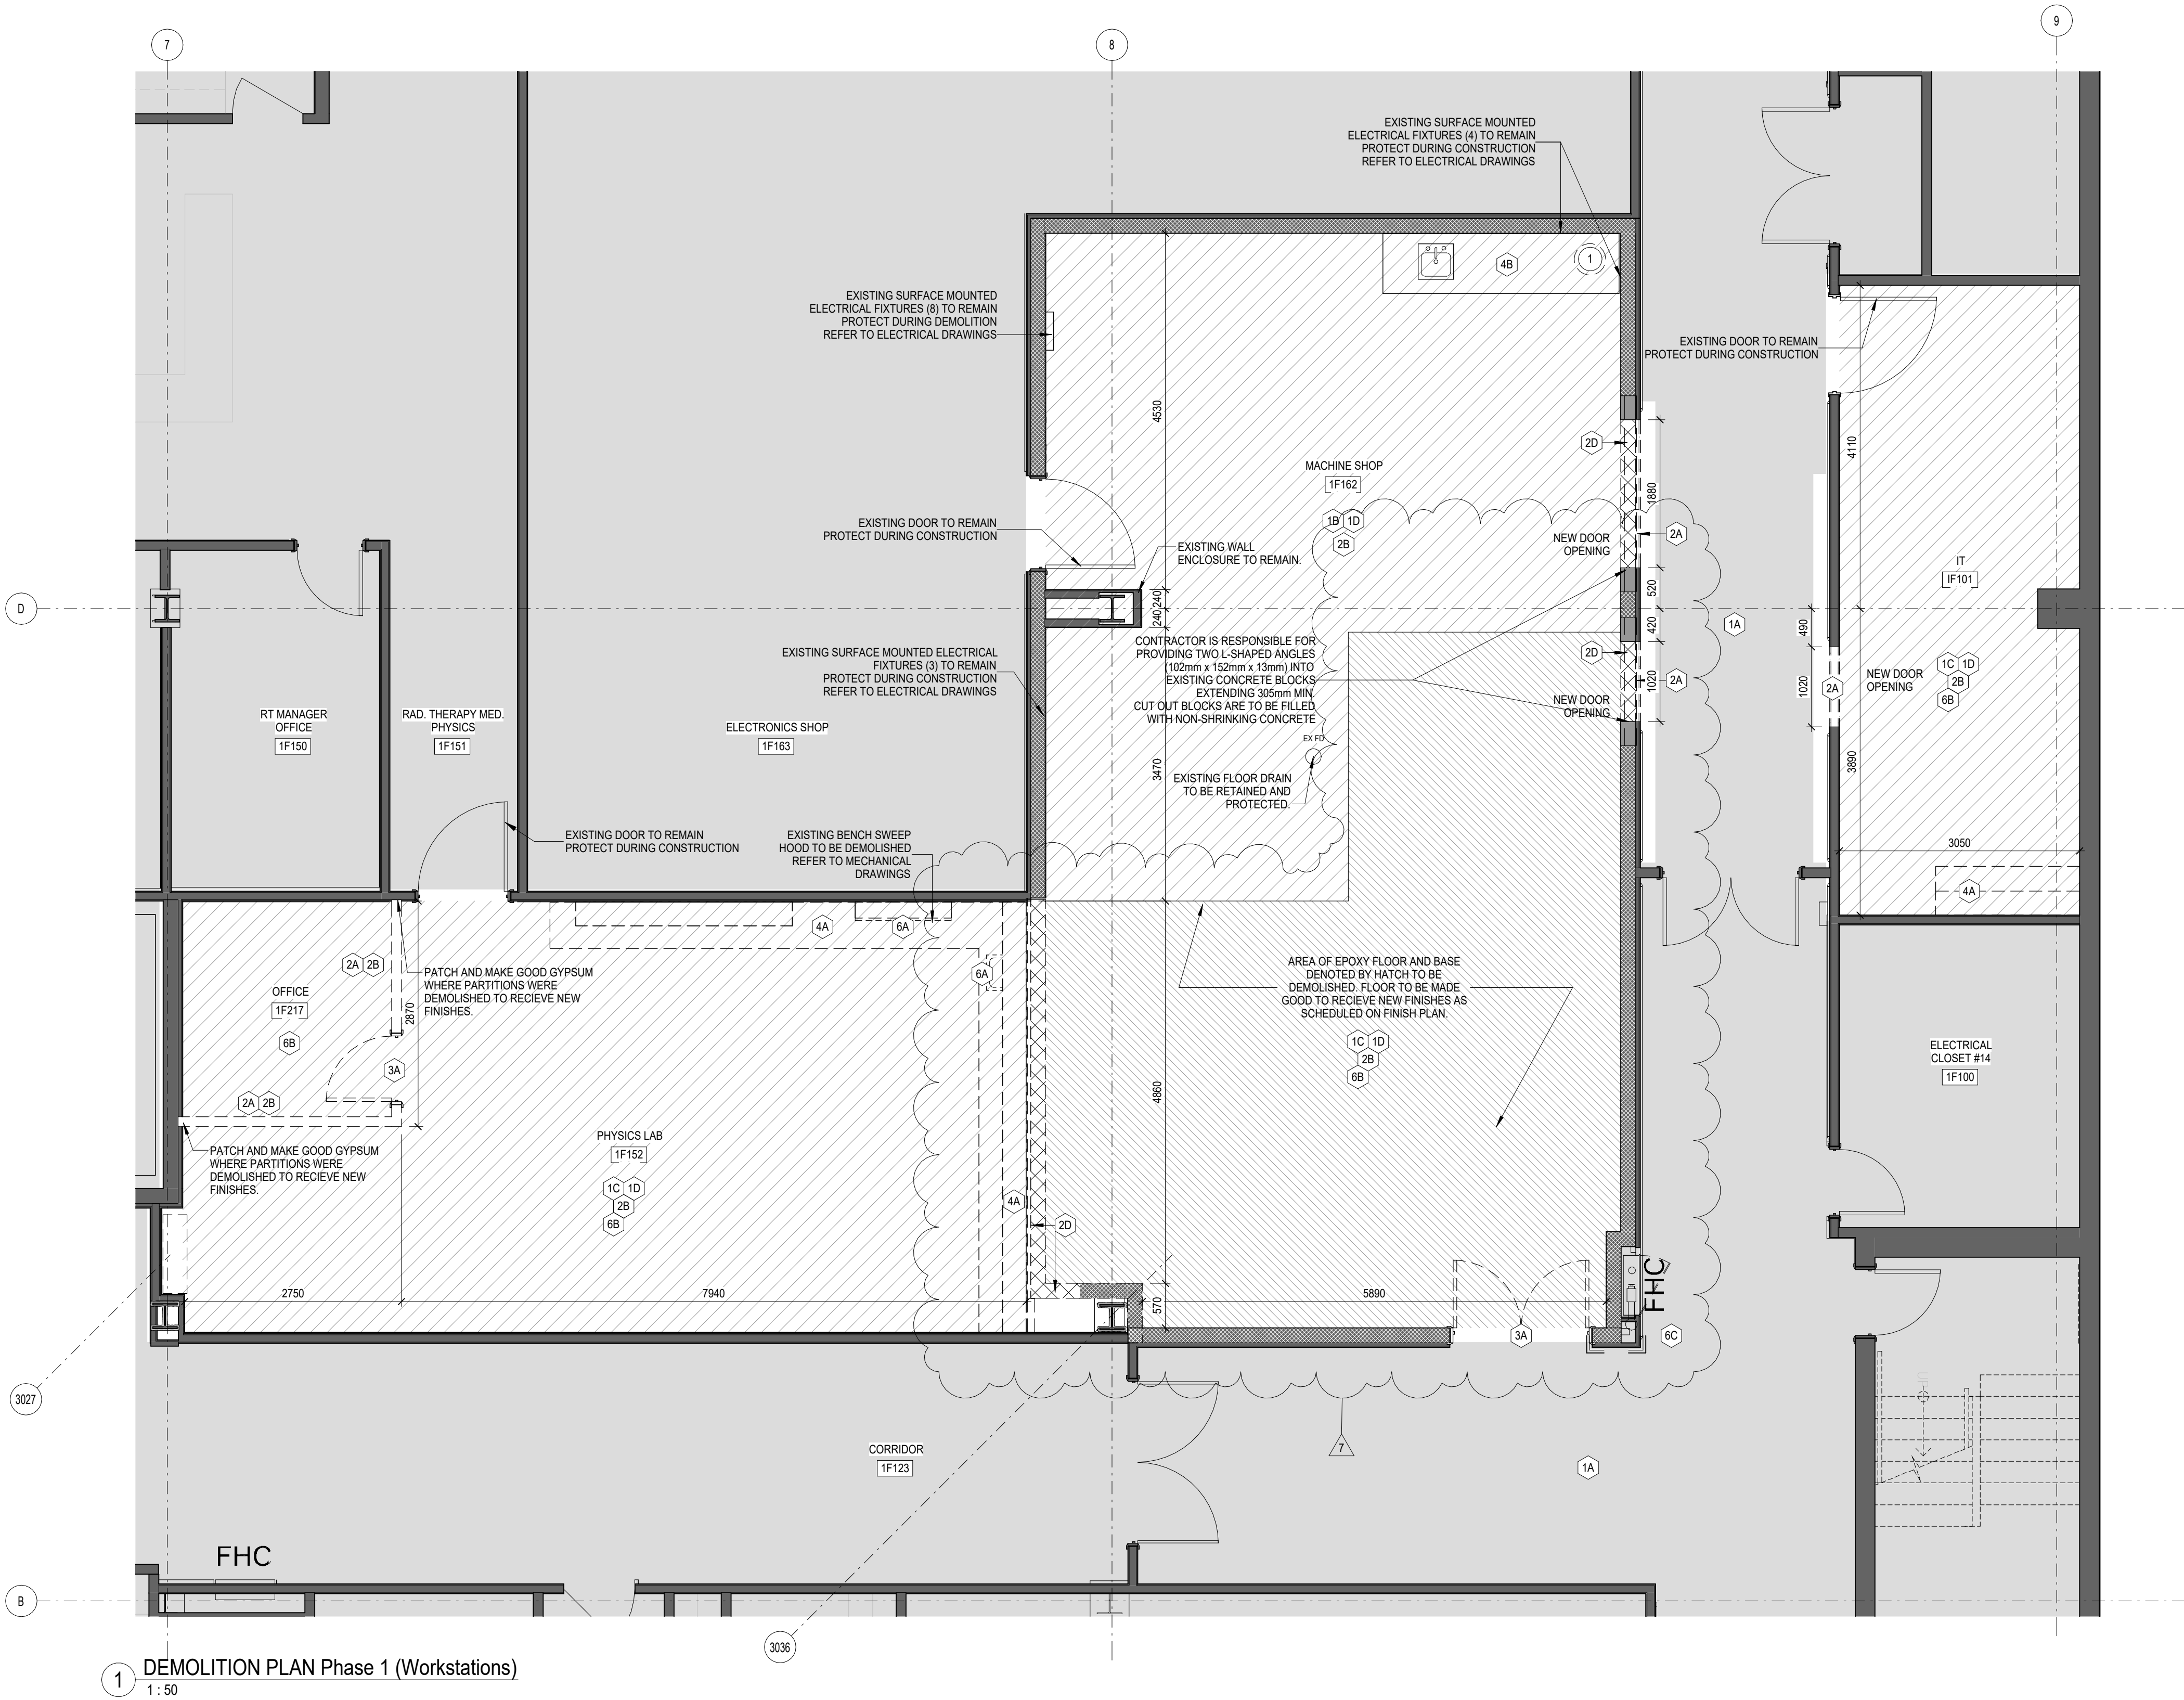

1 DEMOLITION PLAN Phase 1 (Workstations)
1:50

LEGEND - DEMOLITION PLAN

- NOT IN CONTRACT / NOT IN SCOPE AREA
- EXISTING CONSTRUCTION TO REMAIN
- EXISTING CONSTRUCTION TO BE REMOVED
- TRENCH CUT INTO EXISTING CONCRETE SURFACE BED, REFER TO MECHANICAL & STRUCTURAL FOR DETAILS
- EXISTING FLOOR SLAB TO BE REMOVED
REFER TO STRUCTURAL FOR DETAILS

F&E OWNER TO ARRANGE FOR REMOVAL OF ALL EXISTING FURNITURE, FITTINGS AND EQUIPMENT FROM PHASED WORK AREAS PRIOR TO START OF CONSTRUCTION.
TEMPORARY HOARDING TO BE PROVIDED AS SHOWN IN PHASING PLANS

1 COORDINATE WITH MECHANICAL DIVISION AND REMOVE EXISTING DUST EXTRACTOR DUCTS, FIXTURES AND CONTROLS. COORDINATE WITH MECHANICAL DIVISION FOR SHUT OFF, TERMINATION AND CAPPING OFF OF EXISTING DUCTWORK AS REQUIRED.

FLOORS

- 1A MAINTAIN INTEGRITY OF EXISTING CORRIDOR AND EXITS. CORRIDOR SHALL BE FREE OF CONSTRUCTION MATERIAL AND/OR DEBRIS. EXISTING FLOORING TO REMAIN IN THIS AREA AS NOTED ON PLAN. PROVIDE LOCKING HARDWARE FOR ALL DOORS ENTERING INTO THE CONSTRUCTION AREA FROM EXISTING CORRIDOR. COORDINATE WITH OWNER TO PROVIDE CONSTRUCTION CORE LOCKSET FOR HOARDING ACCESS. PROVIDE DUST SEAL ON ALL DOORS BORDERING WORK AREA WHEN PERFORMING WORK IN CORRIDOR. ANY WORK PERFORMED IN THE CORRIDOR SHALL BE DONE AFTER HOURS AND IN COORDINATION WITH THE HOSPITAL. ALL WORK SHALL BE PERFORMED IN CONFORMANCE WITH INFECTIONS PREVENTION AND CONTROL GUIDELINES (E.G. THE USE OF SUBMARINES) TYP.
- 1B EXISTING FLOORING TO REMAIN. CONTRACTOR SHALL FIRST PUT DOWN 6ML SHEETS OF POLYETHYLENE COMPLETE WITH TAPED SEAMS UNDER T&G PLYWOOD PROTECTION ON BOARD (ALSO WITH TAPED SEAMS) AS REQUIRED IN THIS AREA TO PREVENT EXISTING FLOOR FINISH FROM BEING DAMAGED DURING THE CONSTRUCTION PERIOD. ANY DAMAGED FLOOR FINISH (BASE INCLUDED) DUE TO WORK UNDER THIS CONTRACT SHALL BE MADE GOOD TO MATCH EXISTING TO THE COMPLETE SATISFACTION AND AT NO EXPENSE OF THE OWNER. NO SMALL RANDOM CUT AND PATCH REPAIR WILL BE CONSIDERED ACCEPTABLE. MAKE STRAIGHT AND CLEAN CUT BETWEEN FLOOR FINISH TO REMAIN AND FLOOR FINISH TO BE REPAIRED. MAKE TRANSITION AT DOOR THRESHOLD WHERE POSSIBLE TYP.
- 1C EXISTING FLOOR FINISH (E.G. VCT, CARPET, CERAMIC TILE, SHEET VINYL, AND EPOXY CAW FLASH COVE AND RUBBER AND OTHER BASES ETC.) TO BE REMOVED. SCRAPE AND PREPARE SUBSTRATE AS REQUIRED TO OBTAIN SMOOTH AND LEVEL SURFACE READY TO RECEIVE NEW FLOOR FINISHES AS AND WHERE SPECIFIED. CLEAN AND LEVEL EXISTING CONCRETE SUBSTRATE, INCLUDING ANY IRREGULARITIES AND PHYSICAL RESIDUE, AND FILL DEPRESSIONS AND CRACKS WITH FLOOR LEVELING COMPOUND. REMOVE ANY EXISTING MATERIAL, ADHESIVES, OIL OR DUST THAT MAY BE DETRIMENTAL TO THE BONDING OF THE NEW FLOORING. TELEGRAPHING OF SUBSTRATE THROUGH TO NEW FLOORING IS NOT PERMITTED. USE SELF-LEVELING MORTAR IN AREAS THAT NEED TO BE BUILT UP TO MATCH EXISTING FLOOR LEVELS. CONTRACTOR TO ENSURE FLOOR IS TRUE AND LEVEL TO MEET THE REQUIREMENTS OF THE NEW WORK. MAKE GOOD FLOOR SUBSTRATES WHERE EXISTING PARTITIONS HAVE BEEN DEMOLISHED TYP.

- 1D REDUNDANT FLOOR BOXES, RACEWAYS, SERVICES, DRAINS, SLEEVES/OPENINGS THROUGH EXISTING CONCRETE FLOOR SLAB SHALL BE FILLED WITH NEW CONCRETE TO OBTAIN A STRUCTURALLY SOUND, SMOOTH AND LEVEL SURFACE TO RECEIVE NEW FLOOR FINISH TYPICAL. MAKE REPAIRS AS REQUIRED. MAINTAIN REQUIRED FIRE-RESISTANCE RATINGS OF FLOOR SLABS.
- 1E SEE STRUCTURAL DRAWINGS FOR DETAILS AND GENERAL NOTES RELATED TO AS-BUILT CONC. SLAB REMOVAL AND CUTTING.

WALLS

- 2A REMOVE AND DISPOSE OF EXISTING GYPSUM BOARD AND METAL STUD FRAMED PARTITIONS COMPLETE WITH ASSOCIATED WALL BASE, HANDRAILS/BUMPERS AND CORNER GUARDS, WHERE INDICATED BY DASHED LINES. REMOVE ALL REDUNDANT MECHANICAL AND ELECTRICAL SERVICES IN CONFORMANCE WITH GOVERNING CODES AND AUTHORITIES. REFER TO AND COORDINATE WITH MECHANICAL AND ELECTRICAL DIVISION SCOPE OF WORK. MAKE GOOD ALL AFFECTED SURFACES AS REQUIRED TO MATCH EXISTING, OR TO LEAVE READY TO RECEIVE NEW FINISHES TYP.
- 2B REMOVE AND DISPOSE OF EXISTING INTERIOR WALL ACCESSORIES (I.E. CORNER GUARDS, WALL BUMPERS ETC.) AND MAKE GOOD ALL AFFECTED SURFACES AS REQUIRED TO MATCH EXISTING, OR TO LEAVE READY TO RECEIVE NEW FINISHES TYP. ALL FLOOR BASE FINISHES TO REMAIN IN AREAS WHERE EXISTING FLOORING IS MAINTAINED.
- 2C REMOVE AND DISPOSE OF EXISTING WALL FINISHES TO EXPOSE FRAMING BEHIND. AT LOCATIONS OF STRUCTURAL CONCRETE OR CONCRETE MASONRY UNIT SUBSTRATES, ALSO REMOVE METAL STUD FRAMING / BLOCKING TO EXPOSE THE STRUCTURAL ELEMENTS TO REMAIN. MAKE GOOD ALL EXISTING SUBSTRATES TO REMAIN READY TO RECEIVE NEW FINISHES.
- 2D REMOVE AND DISPOSE OF EXISTING CONCRETE BLOCK PARTITION / INFILL INCLUDING ALL ASSOCIATED FINISHES.

N.B.: REMOVE AND RETAIN AND / OR DISPOSE OF EXISTING WALL-MOUNTED EQUIPMENT, FITMENTS AND DEVICES, INCLUDING ALL RELATED ATTACHMENTS, MOUNTINGS, ETC. WHERE LOCATION ON CONSTRUCTION SCHEDULED FOR REMOVAL. COORDINATE WITH OWNER THE EXTENT OF ITEMS TO BE RETAINED.

DOORS

- 3A REMOVE AND DISPOSE OF EXISTING DOOR, FRAME AND HARDWARE WHERE INDICATED BY DASHED LINES. ELECTRICAL TRADE TO DISCONNECT POWER FOR DOORS WITH ELECTRIFIED CONTROLS/HARDWARE. COORDINATE WITH ELECTRICAL AND REFER TO ELECTRICAL DRAWINGS FOR FULL EXTENT OF WORK TYP.
- 3B REMOVE AND REINSTALL DOOR

MILLWORK/CASEWORK

- 4A REMOVE AND DISPOSE OF EXISTING MILLWORK COMPLETE WITH PLUMBING AND ELECTRICAL FIXTURES AND ALL RELATED FITMENTS WHERE INDICATED BY DASHED LINES. CAP OFF ALL SERVICES IN ACCORDANCE WITH MECHANICAL AND ELECTRICAL SCOPE OF WORK. PLUMBING SERVICES TO BE CAPPED AS FAR BACK TO THE MAIN AS POSSIBLE TO ELIMINATE DEAD LEGS. MAKE GOOD ALL AFFECTED SURFACES AS REQUIRED TO LEAVE READY FOR INSTALLATION OF NEW WORK. REFER TO AND COORDINATE WITH MECHANICAL AND ELECTRICAL DIVISIONS TYP.
- 4B MILLWORK TO REMAIN. COVER AND PROTECT MILLWORK DURING DEMOLITION AND CONSTRUCTION

MECHANICAL & ELECTRICAL

- 6A COORDINATE WITH MECHANICAL DIVISION AND REMOVE PLUMBING FIXTURES, FAUCETS AND CONTROLS, FLOOR DRAINS, VENTS AND CONTROLS, AND MEDICAL GASES, WHERE INDICATED. COORDINATE WITH MECHANICAL DIVISION FOR SHUT-OFF, TERMINATION, REMOVAL, AND CAPPING OFF OF EXISTING DUCTWORK, PLUMBING, FIXTURES AND ACCESSORIES AS REQUIRED TO ACCOMMODATE THE DEMOLITION AND NEW WORK. TERMINATE AND CAP OFF SERVICES IN CONFORMANCE WITH MECHANICAL SCOPE OF WORK AND IN CONFORMANCE WITH ALL GOVERNING CODES AND AUTHORITIES. COORDINATE WITH MECHANICAL DIVISION FOR FULL EXTENT OF ELECTRICAL DEMOLITION WORK REQUIRED. FILL AND FIRESTOP REDUNDANT CORE/SLEEVE OPENINGS IN FIRE-RATED ASSEMBLIES TYP.
- 6B COORDINATE WITH ELECTRICAL DIVISION FOR THE SHUT-OFF, TERMINATION, REMOVAL AND CAPPING OFF OF EXISTING ELECTRICAL CONTROLS, SWITCHES AND SERVICES AS REQUIRED TO ACCOMMODATE THE DEMOLITION AND NEW WORK. TERMINATE AND CAP OFF SERVICES IN CONFORMANCE WITH ELECTRICAL SCOPE OF WORK AND IN CONFORMANCE WITH ALL GOVERNING CODES AND AUTHORITIES. COORDINATE WITH ELECTRICAL DIVISION FOR FULL EXTENT OF ELECTRICAL DEMOLITION WORK REQUIRED. FILL AND FIRESTOP REDUNDANT CORE/SLEEVE OPENINGS IN FIRE-RATED ASSEMBLIES TYP.
- 6C EXISTING FIRE HOSE CABINET AND ASSOCIATED PIPING TO BE RETAINED IN PLACE AND LEFT OPERATIONAL. AT FIRE HOSE CABINETS TO REMAIN, SHUT-OFF VALVES SHALL BE IDENTIFIED AND PROVIDED WITH LOCK-OUT BYPASS IN ORDER TO MITIGATE RISK OF FLOOD DAMAGE DURING CONSTRUCTION. REFER TO AND COORDINATE WITH MECHANICAL DIVISION FOR FULL SCOPE OF WORK.
- 6D REMOVE AND DISPOSE OF EXISTING MEDICAL GAS SERVICE CONSOLE AND ASSOCIATED PIPING. REFER TO MECHANICAL FOR FULL SCOPE OF WORK.
- 6E EXISTING ELECTRICAL PANELS AND/OR FIRE ALARM PANELS TO BE RETAINED IN PLACE AND LEFT OPERATIONAL. REFER TO ELECTRICAL DIVISION FOR FULL SCOPE OF WORK.
- 6F EXISTING FIRE HOSE CABINET AND ASSOCIATED PIPING TO BE DEMOLISHED. SHUT OFF VALVES SHALL BE IDENTIFIED AND PROVIDED WITH LOCK-OUT BYPASS IN ORDER TO MITIGATE RISK OF FLOOD DAMAGE DURING CONSTRUCTION. REFER TO AND COORDINATE WITH MECHANICAL DIVISION FOR FULL SCOPE OF WORK.

GENERAL NOTES:

- 1. ALL SPRINKLERS TO BE MODIFIED TO SUIT NEW SCOPE. SPRINKLER HEADS TO BE TURNED UP FOR SHIELD SPACE. REFER TO MECHANICAL DWGS FOR FULL EXTENT OF WORK.
- 2. ALL NOTES APPLY TO HATCHED GENERAL DEMOLITION AREA, UNLESS OTHERWISE NOTED.
- 3. CEILING DEMOLITION AREA MUST BE COORDINATED WITH EXISTING AND FUTURE MEP WORKS.
- 4. CONTRACTOR TO BE RESPONSIBLE FOR THE DISPOSAL OF ALL MATERIALS REMOVED FROM DEMOLITION. ALL DISPOSALS TO COMPLY WITH LOCAL MUNICIPALITY / AUTHORITY REGULATIONS.
- 5. ALL DIMENSIONS OF WALLS SHOWN IN PLANS TO BE DEMOLISHED ARE DETERMINED FROM EXISTING DRAWINGS PROVIDED BY CLIENT. ANY DISCREPANCIES BETWEEN AS-BUILT SITE CONDITIONS AND DEMOLITION PLANS SHOULD BE BROUGHT TO ARCHITECT / MECHANICAL / ELECTRICAL / SPRINKLER DESIGNER'S ATTENTION PRIOR TO PROCEEDING WITH WORK.
- 6. SEE MEP DEMOLITION PLAN DRAWINGS AND SCANNING REPORTS FOR MEP AS-BUILTS UNDER THE CONC. SLAB REMOVAL AREA.
- 7. FLOOR TO FLOOR HEIGHT IS APPROX. 4870mm

CLIENT:

Trillium Health Partners
2200 Eglinton Avenue West
Mississauga, ON, L5M 2N1
905 813 2200
thp.ca

CONSULTANT:


CUMULUS ARCHITECTS INC.
160 Pears Ave. - Suite 300
Toronto, ON M5R 3P8
416-539-0763
www.cumulusarch.com

SEAL:

This drawing, as an instrument of service, is the property of Cumulus Architects Inc. the copyright in the same being reserved to them. No reproduction is allowed without the permission of Cumulus Architects Inc. and when made must bear its name.

This drawing is not to be scaled. The contractor is to verify dimensions and data noted herein for conformity with the conditions on site and is responsible for reporting in writing any discrepancy to Cumulus Architects Inc. for adjustment.

Cumulus will not be liable for any claims or damages arising from the unauthorized use of this drawing or any portion thereof.

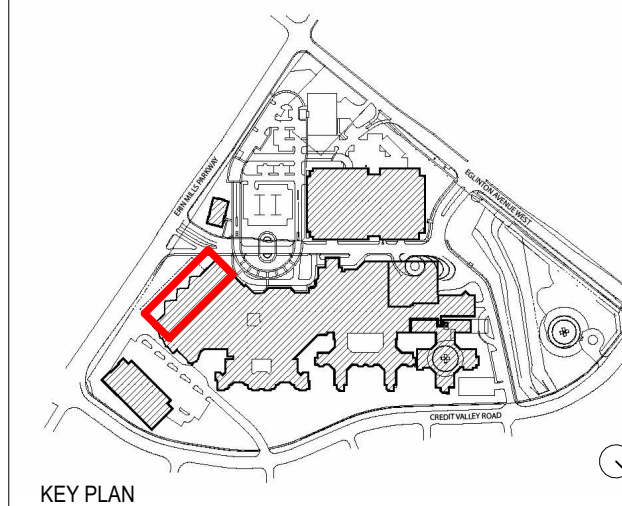

KEY PLAN


NO	DESCRIPTION	DATE
7	Issued for Addendum 1	2026/02/04
6	Issued for Tender	2025/12/16
5	Issued for Building Permit	2025/12/02
4	Issued For MOH 2.3 Resubmission	2025/06/20
2	Issued For MOH 2.3 Costing	2024/09/13
NO	DESCRIPTION	DATE

PROJECT:
Oncology Radiation Treatment Expansion
2200 Eglinton Ave W,
Mississauga, ON L5M 2N1

TITLE:
**DEMOLITION PLAN
PHASE 1**

PROJECT NO:
23010
CHECKED:
Checker

DRAWING NO:
A101

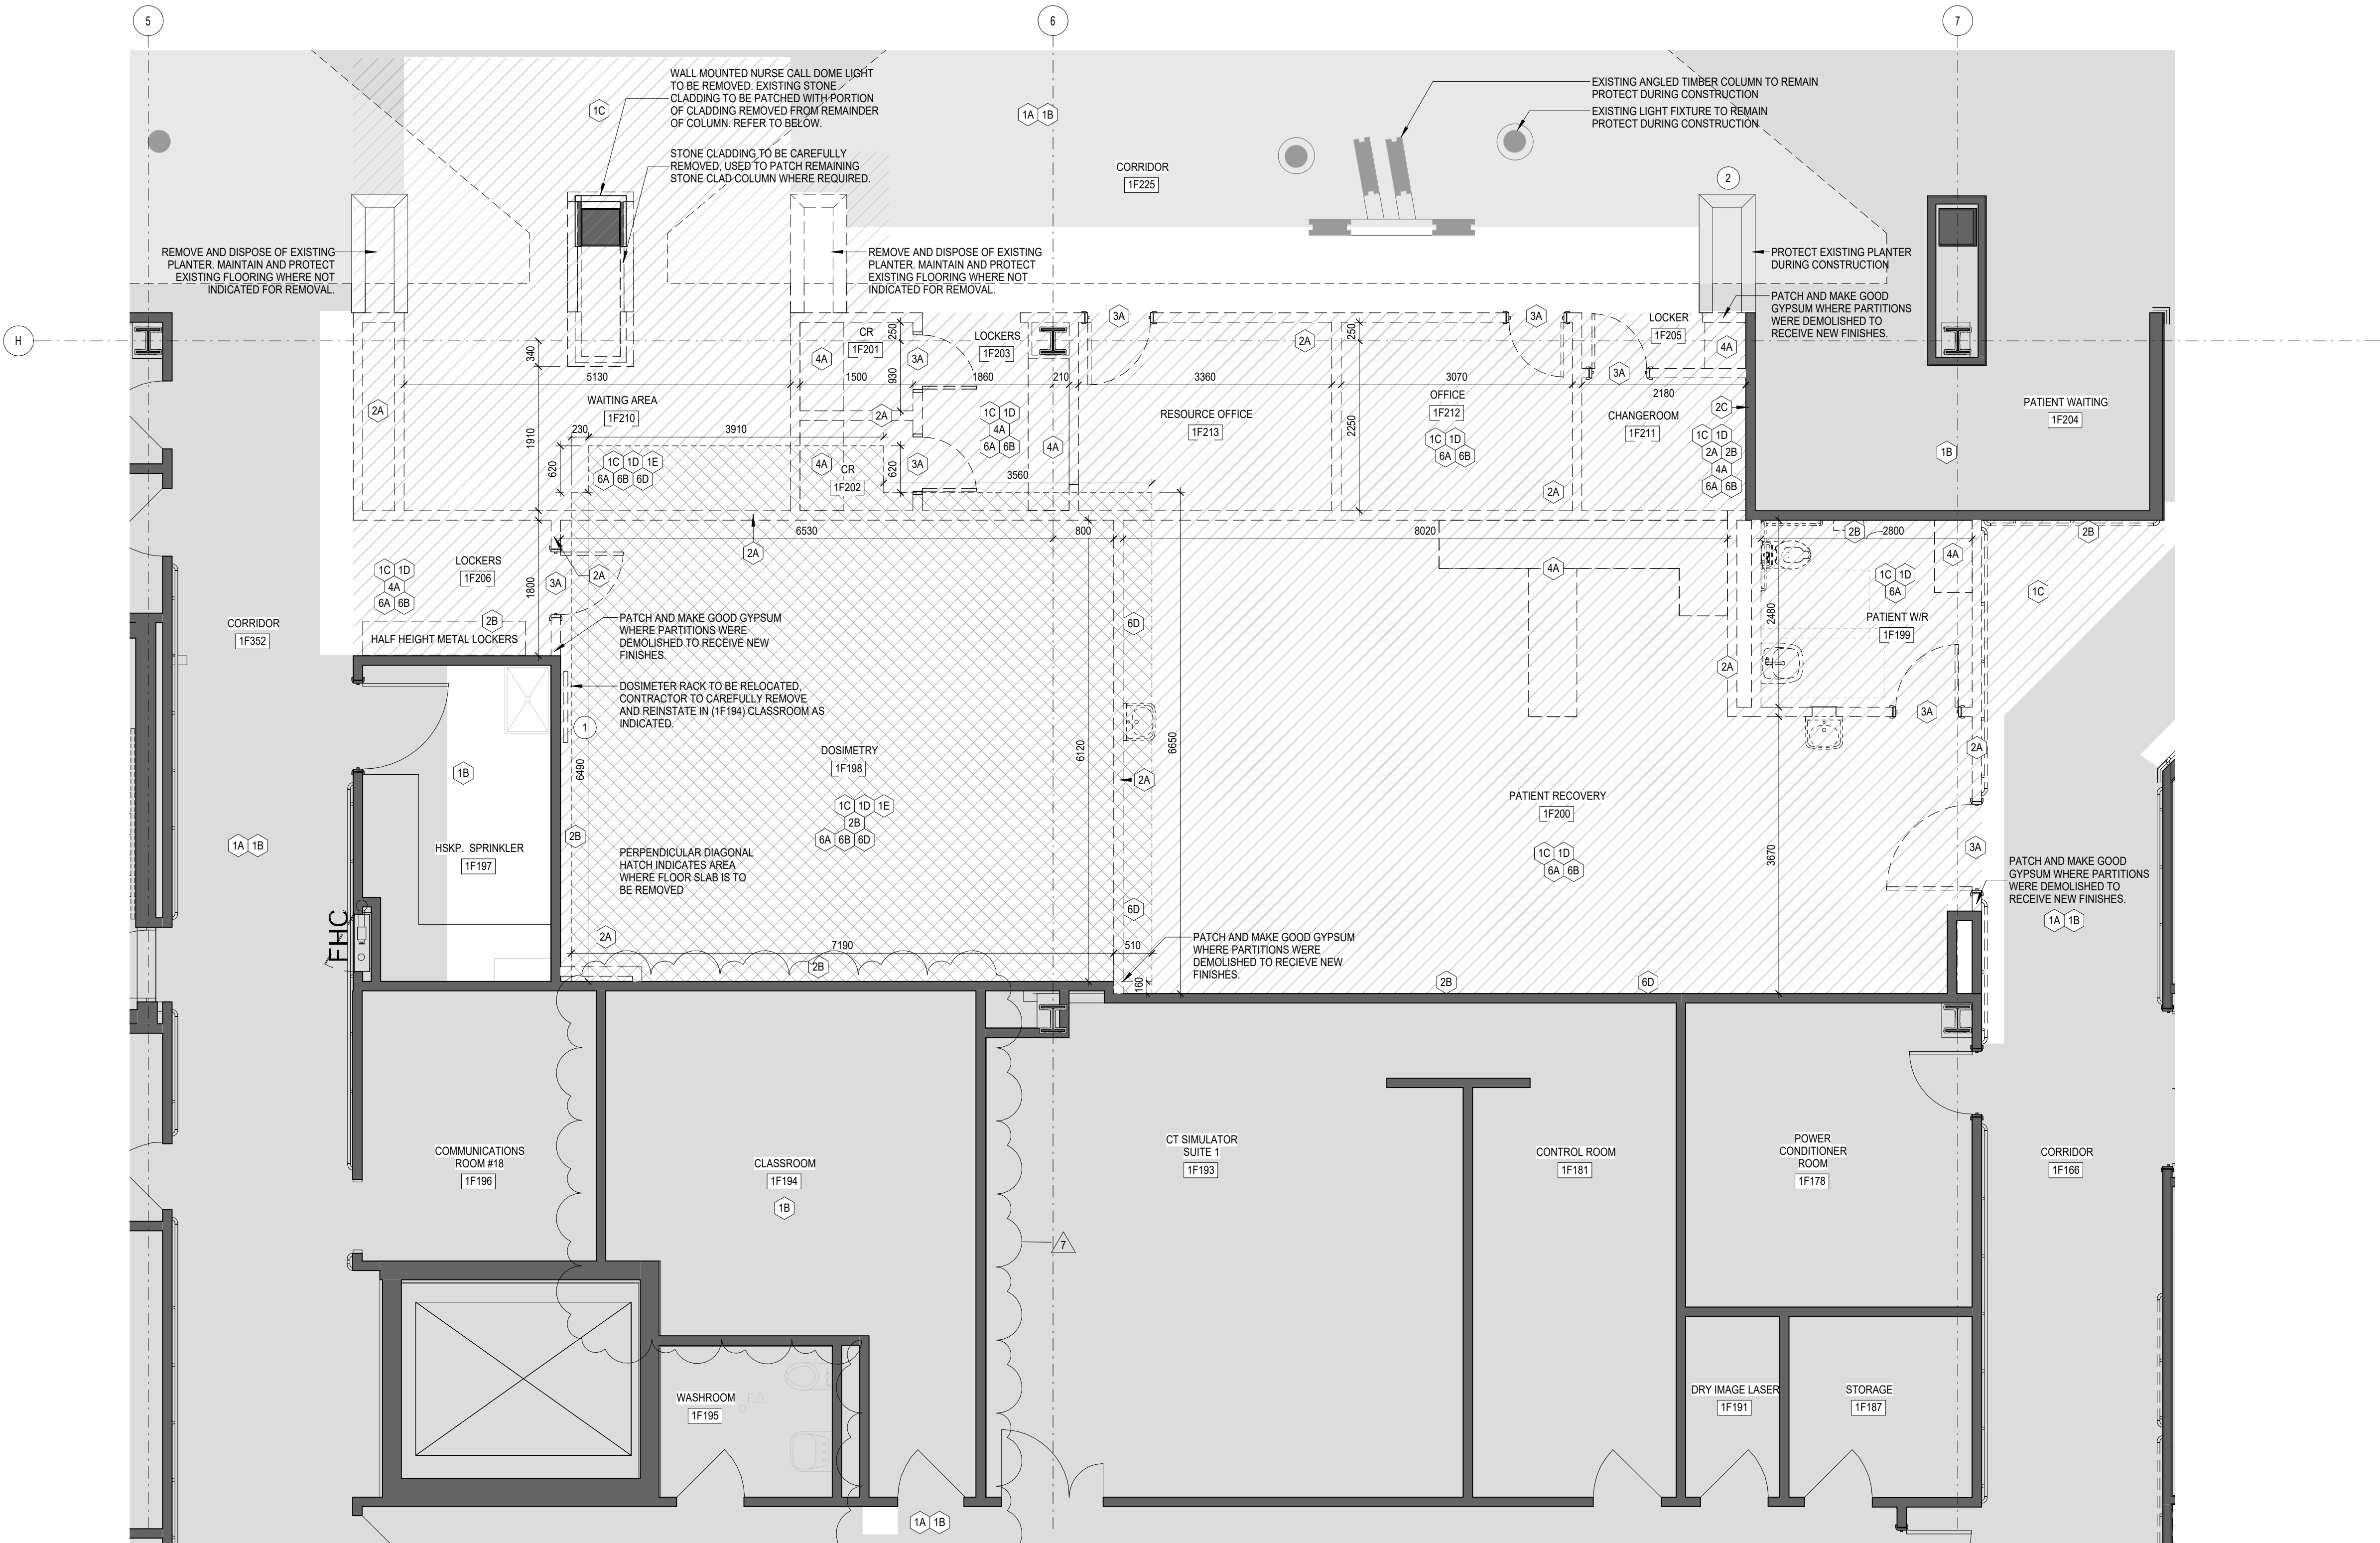

1 DEMOLITION PLAN Phase 2 (Halcyon 2)
1:50

LEGEND - DEMOLITION PLAN

- NOT IN CONTRACT / NOT IN SCOPE AREA
- EXISTING CONSTRUCTION TO REMAIN
- EXISTING CONSTRUCTION TO BE REMOVED
- TRENCH CUT INTO EXISTING CONCRETE SURFACE BED, REFER TO MECHANICAL & STRUCTURAL FOR DETAILS
- EXISTING FLOOR SLAB TO BE REMOVED
REFER TO STRUCTURAL FOR DETAILS

FE&E OWNER TO ARRANGE FOR REMOVAL OF ALL EXISTING FURNITURE, FITTINGS AND EQUIPMENT FROM PHASED WORK AREAS PRIOR TO START OF CONSTRUCTION.
TEMPORARY HOARDING TO BE PROVIDED AS SHOWN IN PHASING PLANS

- 1 REMOVE EXISTING DOSIMETER RACK AND REINSTALL ON WALL INSIDE DOOR WAY OF 1F194 CLASSROOM
- 2 PROTECT EXISTING PLANTER DURING DEMOLITION

FLOORS

- 1A MAINTAIN INTEGRITY OF EXISTING CORRIDOR AND EXITS. CORRIDOR SHALL BE FREE OF CONSTRUCTION MATERIAL AND/OR DEBRIS. EXISTING FLOORING TO REMAIN IN THIS AREA AS NOTED ON PLAN. PROVIDE LOCKING HARDWARE FOR ALL DOORS ENTERING INTO THE CONSTRUCTION AREA FROM EXISTING CORRIDOR. COORDINATE WITH OWNER TO PROVIDE CONSTRUCTION CORE LOCKSET FOR HOARDING ACCESS. PROVIDE DUST SEAL ON ALL DOORS BORDERING WORK AREA WHEN PERFORMING WORK IN CORRIDOR. ANY WORK PERFORMED IN THE CORRIDOR SHALL BE DONE AFTER HOURS AND IN COORDINATION WITH THE HOSPITAL. ALL WORK SHALL BE PERFORMED IN CONFORMANCE WITH INFECTIONS PREVENTION AND CONTROL GUIDELINES (E.G. THE USE OF SUBMARINES) TYP.
- 1B EXISTING FLOORING TO REMAIN. CONTRACTOR SHALL FIRST PUT DOWN 9MM SHEETS OF POLYETHYLENE COMPLETE WITH TAPED SEAMS UNDER T&G PLYWOOD PROTECTION BOARD (ALSO WITH TAPED SEAMS) AS REQUIRED IN THIS AREA TO PREVENT EXISTING FLOOR FINISH FROM BEING DAMAGED DURING THE CONSTRUCTION PERIOD. ANY DAMAGED FLOOR FINISH (BASE INCLUDED) DUE TO WORK UNDER THIS CONTRACT SHALL BE MADE GOOD TO MATCH EXISTING TO THE COMPLETE SATISFACTION AND AT NO EXPENSE OF THE OWNER. NO SMALL RANDOM CUT AND PATCH REPAIR WILL BE CONSIDERED ACCEPTABLE. MAKE STRAIGHT AND CLEAN CUT BETWEEN FLOOR FINISH TO REMAIN AND FLOOR FINISH TO BE REPAIRED. MAKE TRANSITION AT DOOR THRESHOLD WHERE POSSIBLE TYP.
- 1C EXISTING FLOOR FINISH (E.G. VCT, CARPET, CERAMIC TILE, SHEET VINYL AND EPOXY CAW FLASH COVE AND RUBBER AND OTHER BASES ETC.) TO BE REMOVED. SCRAPE AND PREPARE SUBSTRATE AS REQUIRED TO OBTAIN SMOOTH AND LEVEL SURFACE READY TO RECEIVE NEW FLOOR FINISHES AS AND WHERE SPECIFIED. CLEAN AND LEVEL EXISTING CONCRETE SUBSTRATE, INCLUDING ANY IRREGULARITIES AND PHYSICAL RESIDUE, AND FILL DEPRESSIONS AND CRACKS WITH FLOOR LEVELING COMPOUND. REMOVE ANY EXISTING MATERIAL, ADHESIVES, OIL OR DUST THAT MAY BE DETRIMENTAL TO THE BONDING OF THE NEW FLOORING. TELEGRAPHING OF SUBSTRATE THROUGH TO NEW FLOORING IS NOT PERMITTED. USE SELF-LEVELING MORTAR IN AREAS THAT NEED TO BE BUILT UP TO MATCH EXISTING FLOOR LEVELS. CONTRACTOR TO ENSURE FLOOR IS TRUE AND LEVEL TO MEET THE REQUIREMENTS OF THE NEW WORK. MAKE GOOD FLOOR SUBSTRATES WHERE EXISTING PARTITIONS HAVE BEEN DEMOLISHED TYP.

- 1D REDUNDANT FLOOR BOXES, RACEWAYS, SERVICES, DRAINS, SLEEVES/OPENINGS THROUGH EXISTING CONCRETE FLOOR SLAB SHALL BE FILLED WITH NEW CONCRETE TO OBTAIN A STRUCTURALLY SOUND, SMOOTH AND LEVEL SURFACE TO RECEIVE NEW FLOOR FINISH TYPICAL. MAKE REPAIRS AS REQUIRED. MAINTAIN REQUIRED FIRE-RESISTANCE RATINGS OF FLOOR SLABS.
- 1E SEE STRUCTURAL DRAWINGS FOR DETAILS AND GENERAL NOTES RELATED TO AS-BUILT CONC. SLAB REMOVAL AND CUTTING.

WALLS

- 2A REMOVE AND DISPOSE OF EXISTING GYPSUM BOARD AND METAL STUD FRAMED PARTITIONS COMPLETE WITH ASSOCIATED WALL BASE, HANDRAILS/BUMPERS AND CORNER GUARDS, WHERE INDICATED BY DASHED LINES. REMOVE ALL REDUNDANT MECHANICAL AND ELECTRICAL SERVICES IN CONFORMANCE WITH GOVERNING CODES AND AUTHORITIES. REFER TO AND COORDINATE WITH MECHANICAL AND ELECTRICAL DIVISION SCOPE OF WORK. MAKE GOOD ALL AFFECTED SURFACES AS REQUIRED TO MATCH EXISTING, OR TO LEAVE READY TO RECEIVE NEW FINISHES TYP.
- 2B REMOVE AND DISPOSE OF EXISTING INTERIOR WALL ACCESSORIES (I.E. CORNER GUARDS, WALL BUMPERS ETC.) AND MAKE GOOD ALL AFFECTED SURFACES AS REQUIRED TO MATCH EXISTING, OR TO LEAVE READY TO RECEIVE NEW FINISHES TYP.
- 2C REMOVE AND DISPOSE OF EXISTING WALL FINISHES TO EXPOSE FRAMING BEHIND. AT LOCATIONS OF STRUCTURAL CONCRETE OR CONCRETE MASONRY UNIT SUBSTRATES, ALSO REMOVE METAL STUD FRAMING / BLOCKING TO EXPOSE THE STRUCTURAL ELEMENTS TO REMAIN. MAKE GOOD ALL EXISTING SUBSTRATES TO REMAIN READY TO RECEIVE NEW FINISHES.
- 2D REMOVE AND DISPOSE OF EXISTING CONCRETE BLOCK PARTITION / INFILL INCLUDING ALL ASSOCIATED FINISHES.

N.B. REMOVE AND RETAIN AND / OR DISPOSE OF EXISTING WALL-MOUNTED EQUIPMENT, FITTINGS AND DEVICES, INCLUDING ALL RELATED ATTACHMENTS, MOUNTINGS, ETC. WHERE LOCATION ON CONSTRUCTION SCHEDULED FOR REMOVAL. COORDINATE WITH OWNER THE EXTENT OF ITEMS TO BE RETAINED.

DOORS

- 3A REMOVE AND DISPOSE OF EXISTING DOOR, FRAME AND HARDWARE WHERE INDICATED BY DASHED LINES. ELECTRICAL TRADE TO DISCONNECT POWER FOR DOORS WITH ELECTRIFIED CONTROLS/HARDWARE. COORDINATE WITH ELECTRICAL AND REFER TO ELECTRICAL DRAWINGS FOR FULL EXTENT OF WORK TYP.
- 3B REMOVE AND REINSTALL DOOR

MILLWORK/CASEWORK

- 4A REMOVE AND DISPOSE OF EXISTING MILLWORK COMPLETE WITH PLUMBING AND ELECTRICAL FIXTURES AND ALL RELATED FITMENTS WHERE INDICATED BY DASHED LINES. CAP OFF ALL SERVICES IN ACCORDANCE WITH MECHANICAL AND ELECTRICAL SCOPE OF WORK. PLUMBING SERVICES TO BE CAPPED AS FAR BACK TO THE MAIN AS POSSIBLE TO ELIMINATE DEAD LEGS. MAKE GOOD ALL AFFECTED SURFACES AS REQUIRED TO LEAVE READY FOR INSTALLATION OF NEW WORK. REFER TO AND COORDINATE WITH MECHANICAL AND ELECTRICAL DIVISIONS TYP.
- 4B MILLWORK TO REMAIN. COVER AND PROTECT MILLWORK DURING DEMOLITION AND CONSTRUCTION

MECHANICAL & ELECTRICAL

- 6A COORDINATE WITH MECHANICAL DIVISION AND REMOVE PLUMBING FIXTURES, FAUCETS AND CONTROLS, FLOOR DRAINS, VENTS AND CONTROLS, AND MEDICAL GASES, WHERE INDICATED. COORDINATE WITH MECHANICAL DIVISION FOR SHUT-OFF, TERMINATION, REMOVAL, AND CAPPING OFF OF EXISTING DUCTWORK, PLUMBING, FIXTURES AND ACCESSORIES AS REQUIRED TO ACCOMMODATE THE DEMOLITION AND NEW WORK. TERMINATE AND CAP OFF SERVICES IN CONFORMANCE WITH MECHANICAL SCOPE OF WORK AND IN CONFORMANCE WITH ALL GOVERNING CODES AND AUTHORITIES. COORDINATE WITH MECHANICAL DIVISION FOR FULL EXTENT OF ELECTRICAL DEMOLITION WORK REQUIRED. FILL AND FIRESTOP REDUNDANT CORE/SLEEVE OPENINGS IN FIRE-RATED ASSEMBLIES TYP.
- 6B COORDINATE WITH ELECTRICAL DIVISION FOR THE SHUT-OFF, TERMINATION, REMOVAL AND CAPPING OFF OF EXISTING ELECTRICAL CONTROLS, SWITCHES AND SERVICES AS REQUIRED TO ACCOMMODATE THE DEMOLITION AND NEW WORK. TERMINATE AND CAP OFF SERVICES IN CONFORMANCE WITH ELECTRICAL SCOPE OF WORK AND IN CONFORMANCE WITH ALL GOVERNING CODES AND AUTHORITIES. COORDINATE WITH ELECTRICAL DIVISION FOR FULL EXTENT OF ELECTRICAL DEMOLITION WORK REQUIRED. FILL AND FIRESTOP REDUNDANT CORE/SLEEVE OPENINGS IN FIRE-RATED ASSEMBLIES TYP.
- 6C EXISTING FIRE HOSE CABINET AND ASSOCIATED PIPING TO BE RETAINED IN PLACE AND LEFT OPERATIONAL. AT FIRE HOSE CABINETS TO REMAIN, SHUT-OFF VALVES SHALL BE IDENTIFIED AND PROVIDED WITH LOCK-OUT BYPASS IN ORDER TO MITIGATE RISK OF FLOOD DAMAGE DURING CONSTRUCTION. REFER TO AND COORDINATE WITH MECHANICAL DIVISION FOR FULL SCOPE OF WORK.
- 6D REMOVE AND DISPOSE OF EXISTING MEDICAL GAS SERVICE CONSOLE AND ASSOCIATED PIPING. REFER TO MECHANICAL FOR FULL SCOPE OF WORK.
- 6E EXISTING ELECTRICAL PANELS AND/OR FIRE ALARM PANELS TO BE RETAINED IN PLACE AND LEFT OPERATIONAL. REFER TO ELECTRICAL DIVISION FOR FULL SCOPE OF WORK.
- 6F EXISTING FIRE HOSE CABINET AND ASSOCIATED PIPING TO BE DEMOLISHED. SHUT OFF VALVES SHALL BE IDENTIFIED AND PROVIDED WITH LOCK-OUT BYPASS IN ORDER TO MITIGATE RISK OF FLOOD DAMAGE DURING CONSTRUCTION. REFER TO AND COORDINATE WITH MECHANICAL DIVISION FOR FULL SCOPE OF WORK.

GENERAL NOTES:

- 1. ALL SPRINKLERS TO BE MODIFIED TO SUIT NEW SCOPE. SPRINKLER HEADS TO BE TURNED UP FOR SHELL SPACE. REFER TO MECHANICAL DWGS FOR FULL EXTENT OF WORK.
- 2. ALL NOTES APPLY TO HATCHED GENERAL DEMOLITION AREA, UNLESS OTHERWISE NOTED.
- 3. CEILING DEMOLITION AREA MUST BE COORDINATED WITH EXISTING AND FUTURE MEP WORKS.
- 4. CONTRACTOR TO BE RESPONSIBLE FOR THE DISPOSAL OF ALL MATERIALS REMOVED FROM DEMOLITION. ALL DISPOSALS TO COMPLY WITH LOCAL MUNICIPALITY / AUTHORITY REGULATIONS.
- 5. ALL DIMENSIONS OF WALLS SHOWN IN PLANS TO BE DEMOLISHED ARE DETERMINED FROM EXISTING DRAWINGS PROVIDED BY CLIENT. ANY DISCREPANCIES BETWEEN AS-BUILT SITE CONDITIONS AND DEMOLITION PLANS SHOULD BE BROUGHT TO ARCHITECT / MECHANICAL / ELECTRICAL / SPRINKLER DESIGNER'S ATTENTION PRIOR TO PROCEEDING WITH WORK.
- 6. SEE MEP DEMOLITION PLAN DRAWINGS AND SCANNING REPORTS FOR MEP AS-BUILTS UNDER THE CONC. SLAB REMOVAL AREA.
- 7. FLOOR TO FLOOR HEIGHT IS APPROX. 4870mm

CLIENT:



2200 Eglinton Avenue West
Mississauga, ON L5M 2N1
905 813 2200
thp.ca

CONSULTANT:




160 Pears Ave. - Suite 300
Toronto, ON M5R 3P8
416-539-0763
www.cumulusarch.com

SEAL:

This drawing, as an instrument of service, is the property of Cumulus Architects Inc. the copyright in the same being reserved to them. No reproduction is allowed without the permission of Cumulus Architects Inc. and when made must bear its name.

This drawing is not to be scaled. The contractor is to verify dimensions and data noted herein for conformity with the conditions on site and is responsible for reporting in writing any discrepancy to Cumulus Architects Inc. for adjustment.

Cumulus will not be liable for any claims or damages arising from the unauthorized use of this drawing or any portion thereof.

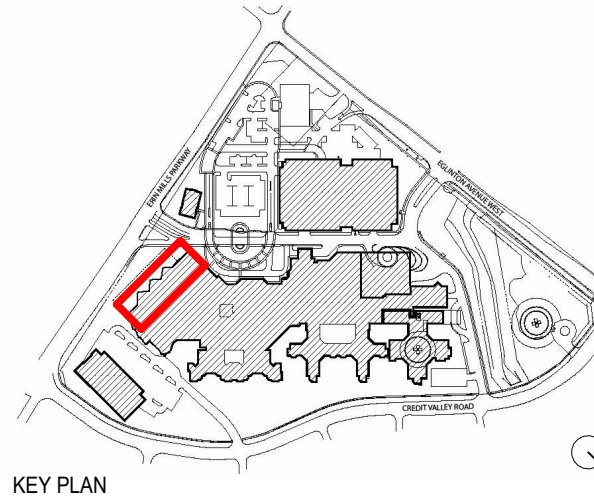

KEY PLAN


NO	DESCRIPTION	DATE
7	Issued for Addendum 1	2026/02/04
6	Issued for Tender	2025/12/16
5	Issued for Building Permit	2025/12/02
4	Issued For MOH 2.3 Resubmission	2025/06/20
2	Issued For MOH 2.3 Costing	2024/09/13
NO		

PROJECT:
Oncology Radiation Treatment Expansion
2200 Eglinton Ave W,
Mississauga, ON L5M 2N1

TITLE:
DEMOLITION
PLAN PHASE 2

PROJECT NO:
23010
CHECKED:
Checker

DRAWING NO:
A104

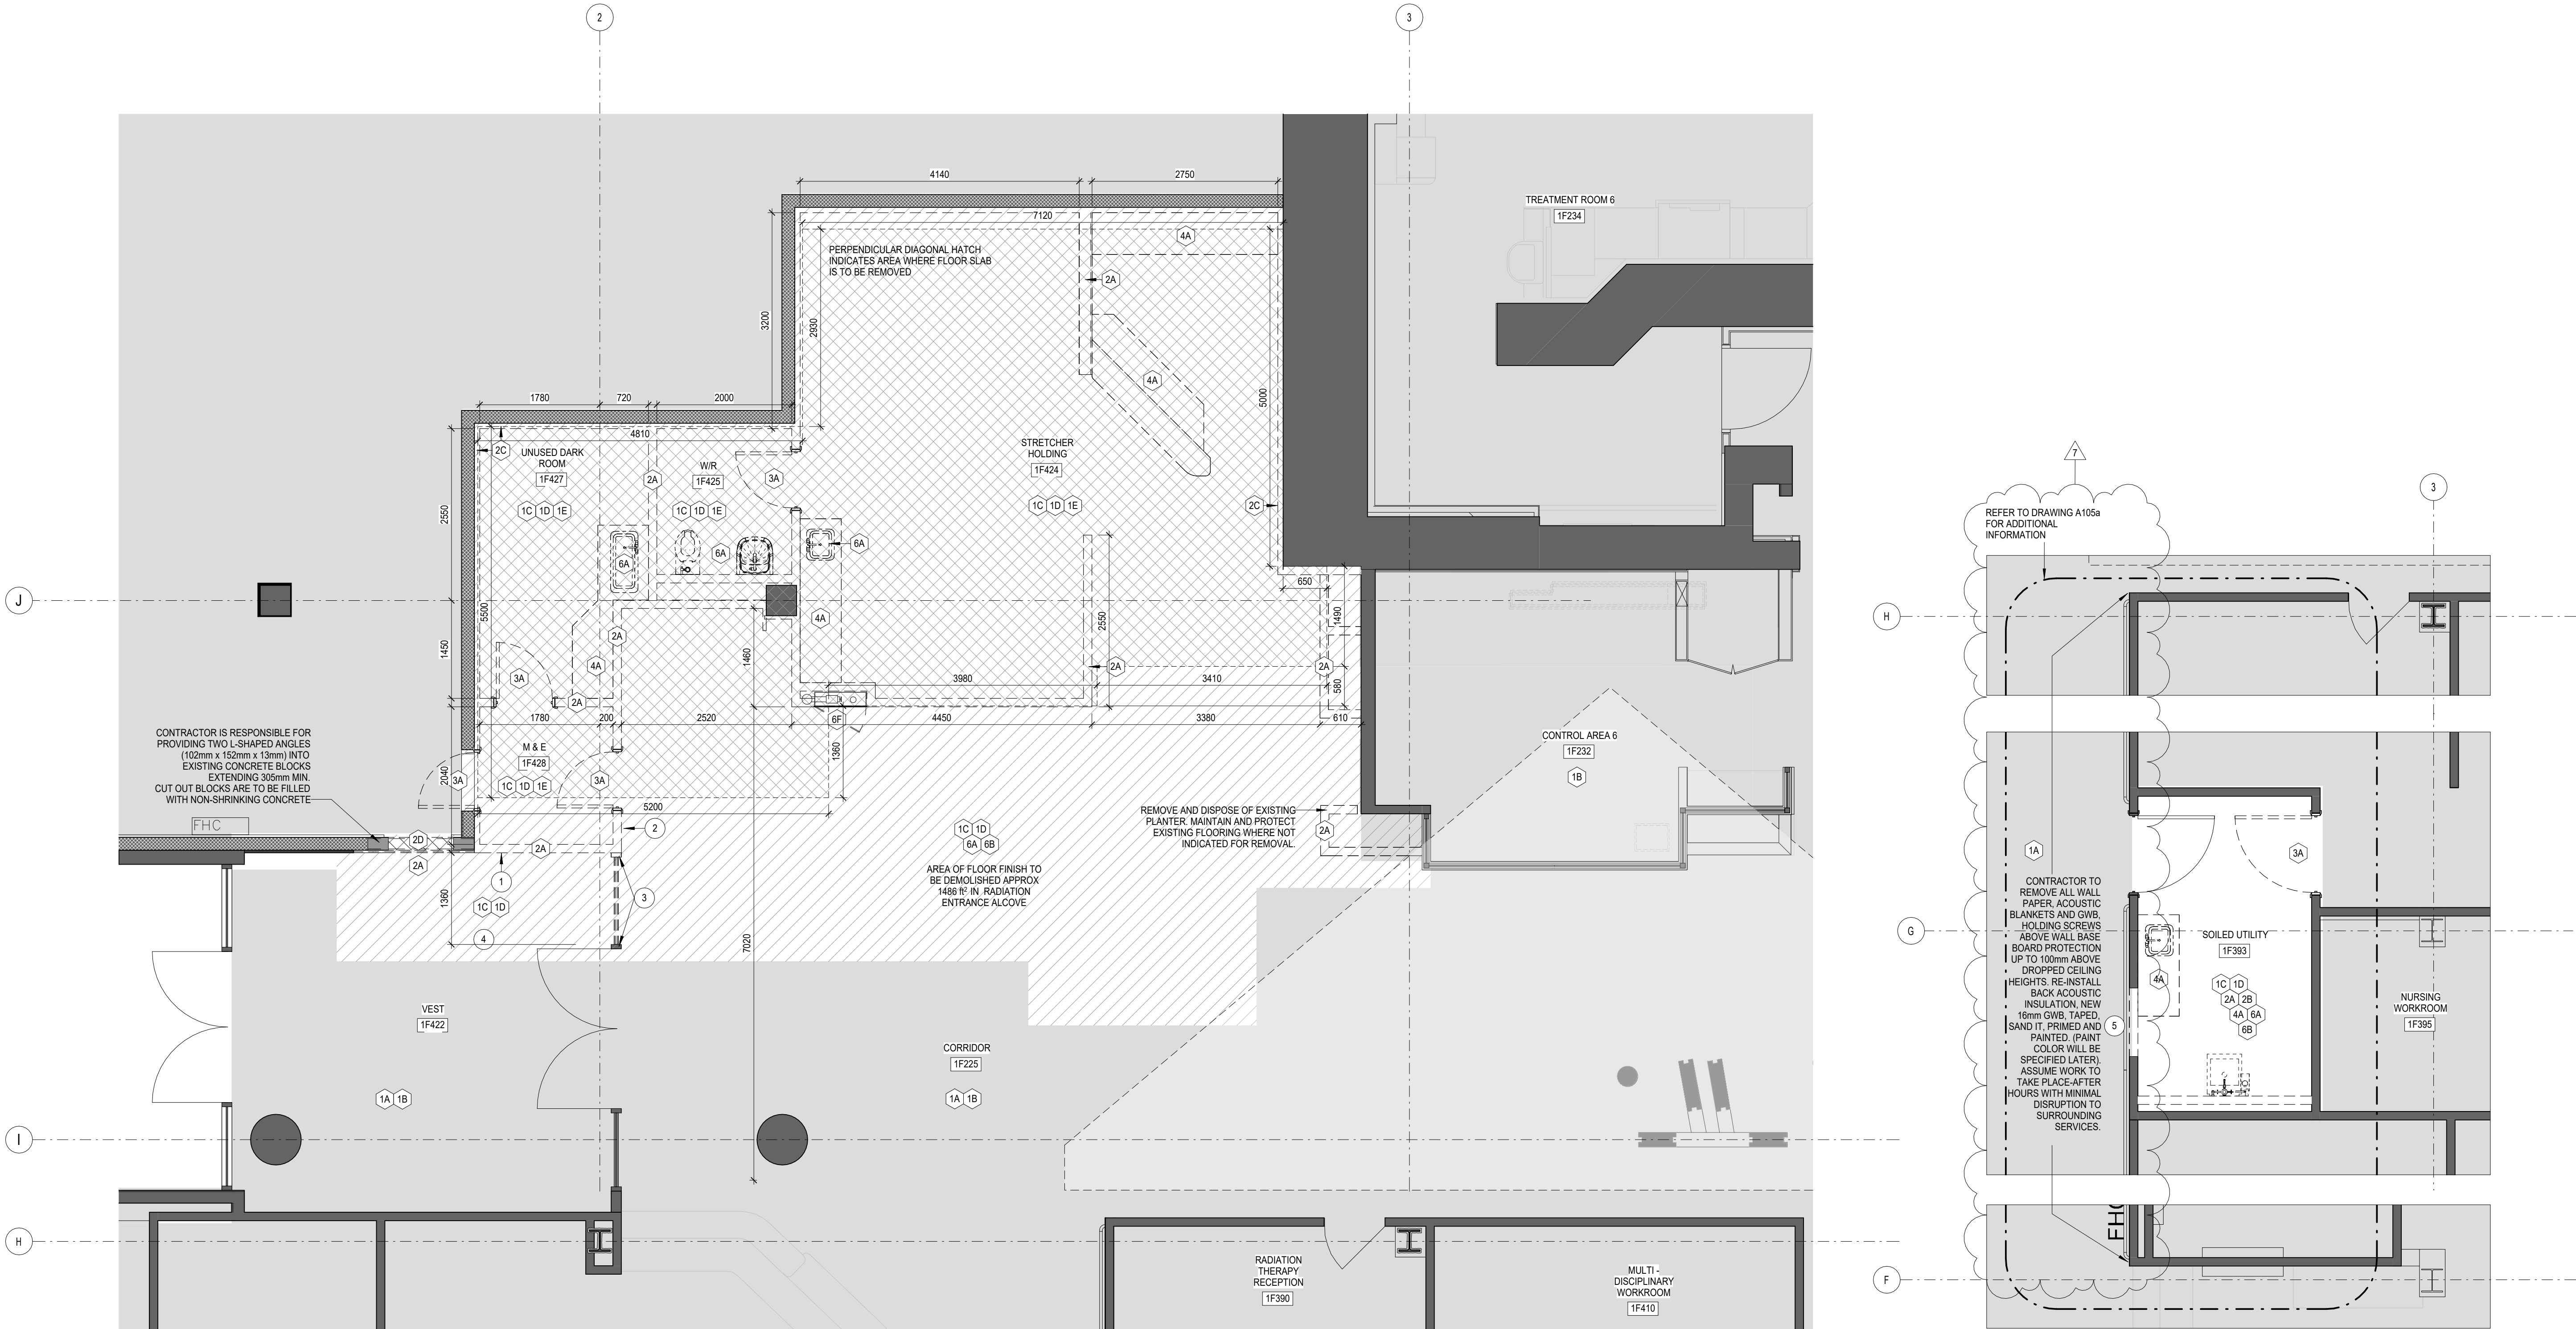

1 DEMOLITION PLAN Phase 3 (Halcyon 3)
1 : 50

2 DEMOLITION PLAN Phase 3 (Storage & WC)
1 : 50

LEGEND - DEMOLITION PLAN

	NOT IN CONTRACT / NOT IN SCOPE AREA
	EXISTING CONSTRUCTION TO REMAIN
	EXISTING CONSTRUCTION TO BE REMOVED
	TRENCH CUT INTO EXISTING CONCRETE SURFACE BED, REFER TO MECHANICAL & STRUCTURAL FOR DETAILS
	EXISTING FLOOR SLAB TO BE REMOVED, REFER TO STRUCTURAL FOR DETAILS

FE&E

- OWNER TO ARRANGE FOR REMOVAL OF ALL EXISTING FURNITURE, FITTINGS AND EQUIPMENT FROM PHASED WORK AREAS PRIOR TO START OF CONSTRUCTION.
- TEMPORARY HOARDING TO BE PROVIDED AS SHOWN IN PHASING PLANS**
- REMOVE & RETAIN EXISTING ADD BUTTON & CARD READER. RELOCATE AS NOTED IN NEW WORK. REFER ALSO TO ELECTRICAL DRAWINGS.
 - REMOVE & RETAIN EXISTING ADD BUTTON. RELOCATE AS NOTED IN NEW WORK. REFER ALSO TO ELECTRICAL DRAWINGS.
 - CAREFULLY REMOVE FRAME AND GLASS. DOOR FRAME AND DOOR TRANSOM TO REMAIN. REFER TO NEW WORK FOR FINAL CONFIGURATION.
 - ENSURE THAT CARPET IS ONLY REMOVED WHERE REQUIRED FOR NEW CONSTRUCTION. CARPET TO REMAIN IN FINAL CONFIGURATION OF VESTIBULE.
 - PROTECT EXISTING LOBBY WALL FINISHES AS MUCH AS POSSIBLE. EXISTING WALL COVERING IS NO LONGER AVAILABLE.

FLOORS

- MAINTAIN INTEGRITY OF EXISTING CORRIDOR AND EXITS. CORRIDOR SHALL BE FREE OF MOUNTED EQUIPMENT, FITTINGS AND DEVICES, INCLUDING ALL RELATED ATTACHMENTS, MOUNTINGS, ETC. WHERE LOCATION ON CONSTRUCTION AREA FROM EXISTING CORRIDOR. COORDINATE WITH OWNER TO PROVIDE CONSTRUCTION CORE LOCKSET FOR HOARDING ACCESS. PROVIDE DUST SEAL ON ALL DOORS BORDERING WORK AREA WHEN PERFORMING WORK IN CORRIDOR. ANY WORK PERFORMED IN THE CORRIDOR SHALL BE DONE AFTER HOURS AND IN COORDINATION WITH THE HOSPITAL. ALL WORK SHALL BE PERFORMED IN CONFORMANCE WITH INFECTIONS PREVENTION AND CONTROL GUIDELINES (E.G. THE USE OF SUBMARINES) TYP.
- EXISTING FLOORING TO REMAIN. CONTRACTOR SHALL FIRST PUT DOWN 6MM SHEETS OF POLYETHYLENE COMPLETE WITH TAPED SEAMS UNDER T&G PLYWOOD PROTECTION BOARD (ALSO WITH TAPED SEAMS) AS REQUIRED IN THIS AREA TO PREVENT EXISTING FLOOR FINISH FROM BEING DAMAGED DURING THE CONSTRUCTION PERIOD. ANY DAMAGED FLOOR FINISH (BASE INCLUDED) DUE TO WORK UNDER THIS CONTRACT SHALL BE MADE GOOD TO MATCH EXISTING TO THE COMPLETE SATISFACTION AND AT NO EXPENSE OF THE OWNER. NO SMALL RANDOM CUT AND PATCH REPAIR WILL BE CONSIDERED ACCEPTABLE. MAKE STRAIGHT AND CLEAN CUT BETWEEN FLOOR FINISH TO REMAIN AND FLOOR FINISH TO BE REPAIRED. MAKE TRANSITION AT DOOR THRESHOLD WHERE POSSIBLE TYP.
- EXISTING FLOOR FINISH (E.G. VCT, CARPET, CERAMIC TILE, SHEET VINYL, AND EPOXY CAW FLASH COVE AND RUBBER AND OTHER BASES ETC.) TO BE REMOVED. SCRAPE AND PREPARE SUBSTRATE AS REQUIRED TO OBTAIN SMOOTH AND LEVEL SURFACE READY TO RECEIVE NEW FLOOR FINISHES AS AND WHERE SPECIFIED. CLEAN AND LEVEL EXISTING CONCRETE SUBSTRATE, INCLUDING ANY IRREGULARITIES AND PHYSICAL RESIDUE, AND FILL DEPRESSIONS AND CRACKS WITH FLOOR LEVELING COMPOUND. REMOVE ANY EXISTING MATERIAL, ADHESIVES, OIL OR DUST THAT MAY BE DETRIMENTAL TO THE BONDING OF THE NEW FLOORING. TELEGRAPHING OF SUBSTRATE THROUGH TO NEW FLOORING IS NOT PERMITTED. USE SELF-LEVELING MORTAR IN AREAS THAT NEED TO BE BUILT UP TO MATCH EXISTING FLOOR LEVELS. CONTRACTOR TO ENSURE FLOOR IS TRUE AND LEVEL TO MEET THE REQUIREMENTS OF THE NEW WORK. MAKE GOOD FLOOR SUBSTRATES WHERE EXISTING PARTITIONS HAVE BEEN DEMOLISHED TYP.

WALLS

- REDUNDANT FLOOR BOXES, RACEWAYS, SERVICES, DRAINS, SLEEVES/OPENINGS THROUGH EXISTING CONCRETE FLOOR SLAB SHALL BE FILLED WITH NEW CONCRETE TO OBTAIN A STRUCTURALLY SOUND, SMOOTH AND LEVEL SURFACE TO RECEIVE NEW FLOOR FINISH TYPICAL. MAKE REPAIRS AS REQUIRED MAINTAIN REQUIRED FIRE-RESISTANCE RATINGS OF FLOOR SLABS.
- SEE STRUCTURAL DRAWINGS FOR DETAILS AND GENERAL NOTES RELATED TO AS-BUILT CONC. SLAB REMOVAL AND CUTTING.
- REMOVE AND DISPOSE OF EXISTING GYPSUM BOARD AND METAL STUD FRAMED PARTITIONS COMPLETE WITH ASSOCIATED WALL BASE, HANDRAILS/BUMPERS AND CORNER GUARDS, WHERE INDICATED BY DASHED LINES. REMOVE ALL REDUNDANT MECHANICAL AND ELECTRICAL SERVICES IN CONFORMANCE WITH GOVERNING CODES AND AUTHORITIES. REFER TO AND COORDINATE WITH MECHANICAL AND ELECTRICAL DIVISION SCOPE OF WORK. MAKE GOOD ALL AFFECTED SURFACES AS REQUIRED TO MATCH EXISTING, OR TO LEAVE READY TO RECEIVE NEW FINISHES TYP.
- REMOVE AND DISPOSE OF EXISTING INTERIOR WALL ACCESSORIES (I.E. CORNER GUARDS, WALL BUMPERS ETC.) AND MAKE GOOD ALL AFFECTED SURFACES AS REQUIRED TO MATCH EXISTING, OR TO LEAVE READY TO RECEIVE NEW FINISHES TYP.
- REMOVE AND DISPOSE OF EXISTING WALL FINISHES TO EXPOSE FRAMING BEHIND. AT LOCATIONS OF STRUCTURAL CONCRETE OR CONCRETE MASONRY UNIT SUBSTRATES, ALSO REMOVE METAL STUD FRAMING / BLOCKING TO EXPOSE THE STRUCTURAL ELEMENTS TO REMAIN. MAKE GOOD ALL EXISTING SUBSTRATES TO REMAIN READY TO RECEIVE NEW FINISHES.
- REMOVE AND DISPOSE OF EXISTING CONCRETE BLOCK PARTITION / INFILL INCLUDING ALL ASSOCIATED FINISHES.

N.B. REMOVE AND RETAIN AND / OR DISPOSE OF EXISTING WALL-MOUNTED EQUIPMENT, FITTINGS AND DEVICES, INCLUDING ALL RELATED ATTACHMENTS, MOUNTINGS, ETC. WHERE LOCATION ON CONSTRUCTION SCHEDULED FOR REMOVAL. COORDINATE WITH OWNER THE EXTENT OF ITEMS TO BE RETAINED.

DOORS

- REMOVE AND DISPOSE OF EXISTING DOOR, FRAME AND HARDWARE WHERE INDICATED BY DASHED LINES. ELECTRICAL TRADE TO DISCONNECT POWER FOR DOORS WITH ELECTRIFIED CONTROLS/HARDWARE. COORDINATE WITH ELECTRICAL AND REFER TO ELECTRICAL DRAWINGS FOR FULL EXTENT OF WORK TYP.
- REMOVE AND REINSTALL DOOR

MILLWORK/CASEWORK

- REMOVE AND DISPOSE OF EXISTING MILLWORK COMPLETE WITH PLUMBING AND ELECTRICAL FIXTURES AND ALL RELATED FITMENTS WHERE INDICATED BY DASHED LINES. CAP OFF ALL SERVICES IN ACCORDANCE WITH MECHANICAL AND ELECTRICAL SCOPE OF WORK. PLUMBING SERVICES TO BE CAPPED AS FAR BACK TO THE MAIN AS POSSIBLE TO ELIMINATE DEAD LEGS. MAKE GOOD ALL AFFECTED SURFACES AS REQUIRED TO LEAVE READY FOR INSTALLATION OF NEW WORK. REFER TO AND COORDINATE WITH MECHANICAL AND ELECTRICAL DIVISIONS TYP.
- MILLWORK TO REMAIN. COVER AND PROTECT MILLWORK DURING DEMOLITION AND CONSTRUCTION

MECHANICAL & ELECTRICAL

- COORDINATE WITH MECHANICAL DIVISION AND REMOVE PLUMBING FIXTURES, FAUCETS AND CONTROLS, FLOOR DRAINS, VENTS AND CONTROLS, AND MEDICAL GASES, WHERE INDICATED. COORDINATE WITH MECHANICAL DIVISION FOR SHUT-OFF, TERMINATION, REMOVAL AND CAPPING OFF OF EXISTING DUCTWORK, PLUMBING, FIXTURES AND ACCESSORIES AS REQUIRED TO ACCOMMODATE THE DEMOLITION AND NEW WORK. TERMINATE AND CAP OFF SERVICES IN CONFORMANCE WITH MECHANICAL SCOPE OF WORK AND IN CONFORMANCE WITH ALL GOVERNING CODES AND AUTHORITIES. COORDINATE WITH MECHANICAL DIVISION FOR FULL EXTENT OF ELECTRICAL DEMOLITION WORK REQUIRED. FILL AND FIRESTOP REDUNDANT CORE/SLEEVE OPENINGS IN FIRE-RATED ASSEMBLIES TYP.
- COORDINATE WITH ELECTRICAL DIVISION FOR THE SHUT-OFF, TERMINATION, REMOVAL AND CAPPING OFF OF EXISTING ELECTRICAL CONTROLS, SWITCHES AND SERVICES AS REQUIRED TO ACCOMMODATE THE DEMOLITION AND NEW WORK. TERMINATE AND CAP OFF SERVICES IN CONFORMANCE WITH ELECTRICAL SCOPE OF WORK AND IN CONFORMANCE WITH ALL GOVERNING CODES AND AUTHORITIES. COORDINATE WITH ELECTRICAL DIVISION FOR FULL EXTENT OF ELECTRICAL DEMOLITION WORK REQUIRED. FILL AND FIRESTOP REDUNDANT CORE/SLEEVE OPENINGS IN FIRE-RATED ASSEMBLIES TYP.
- EXISTING FIRE HOSE CABINET AND ASSOCIATED PIPING TO BE RETAINED IN PLACE AND LEFT OPERATIONAL. AT FIRE HOSE CABINETS TO REMAIN, SHUT-OFF VALVES SHALL BE IDENTIFIED AND PROVIDED WITH LOCK-OUT BYPASS IN ORDER TO MITIGATE RISK OF FLOOD DAMAGE DURING CONSTRUCTION. REFER TO AND COORDINATE WITH MECHANICAL DIVISION FOR FULL SCOPE OF WORK.
- REMOVE AND DISPOSE OF EXISTING MEDICAL GAS SERVICE CONSOLE AND ASSOCIATED PIPING. REFER TO MECHANICAL FOR FULL SCOPE OF WORK.
- EXISTING ELECTRICAL PANELS AND/OR FIRE ALARM PANELS TO BE RETAINED IN PLACE AND LEFT OPERATIONAL. REFER TO ELECTRICAL DIVISION FOR FULL SCOPE OF WORK.
- EXISTING FIRE HOSE CABINET AND ASSOCIATED PIPING TO BE DEMOLISHED. SHUT OFF VALVES SHALL BE IDENTIFIED AND PROVIDED WITH LOCK-OUT BYPASS IN ORDER TO MITIGATE RISK OF FLOOD DAMAGE DURING CONSTRUCTION. REFER TO AND COORDINATE WITH MECHANICAL DIVISION FOR FULL SCOPE OF WORK.

GENERAL NOTES:

- ALL SPRINKLERS TO BE MODIFIED TO SUIT NEW SCOPE. SPRINKLER HEADS TO BE TURNED UP FOR SHELL SPACE. REFER TO MECHANICAL DWGS FOR FULL EXTENT OF WORK.
- ALL NOTES APPLY TO HATCHED GENERAL DEMOLITION AREA, UNLESS OTHERWISE NOTED.
- CEILING DEMOLITION AREA MUST BE COORDINATED WITH EXISTING AND FUTURE MEP WORKS.
- CONTRACTOR TO BE RESPONSIBLE FOR THE DISPOSAL OF ALL MATERIALS REMOVED FROM DEMOLITION. ALL DISPOSALS TO COMPLY WITH LOCAL MUNICIPALITY / AUTHORITY REGULATIONS.
- ALL DIMENSIONS OF WALLS SHOWN IN PLANS TO BE DEMOLISHED ARE DETERMINED FROM EXISTING DRAWINGS PROVIDED BY CLIENT. ANY DISCREPANCIES BETWEEN AS-BUILT SITE CONDITIONS AND DEMOLITION PLANS SHOULD BE BROUGHT TO ARCHITECT / MECHANICAL / ELECTRICAL / SPRINKLER DESIGNER'S ATTENTION PRIOR TO PROCEEDING WITH WORK.
- SEE MEP DEMOLITION PLAN DRAWINGS AND SCANNING REPORTS FOR MEP AS-BUILTS UNDER THE CONC. SLAB REMOVAL AREA.
- FLOOR TO FLOOR HEIGHT IS APPROX. 4600mm

CLIENT:



2200 Eglinton Avenue West
Mississauga, ON L5M 2N1
905 813 2200
thp.ca

CONSULTANT:




160 Pears Ave. - Suite 300
Toronto, ON M5R 3P8
416-539-0763
www.cumulusarch.com

SEAL:

This drawing, as an instrument of service, is the property of Cumulus Architects Inc. the copyright in the same being reserved to them. No reproduction is allowed without the permission of Cumulus Architects Inc. and when made must bear its name.

This drawing is not to be scaled. The contractor is to verify dimensions and data noted herein for conformity with the conditions on site and is responsible for reporting in writing any discrepancy to Cumulus Architects Inc. for adjustment.

Cumulus will not be liable for any claims or damages arising from the unauthorized use of this drawing or any portion thereof.

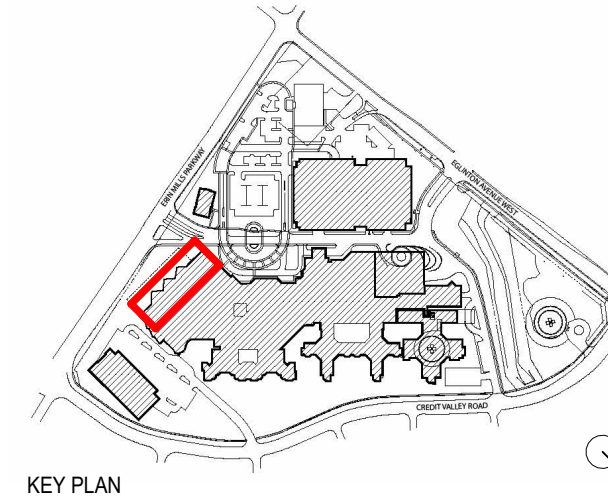

KEY PLAN

NO	DESCRIPTION	DATE
7	Issued for Addendum 1	2026/02/04
6	Issued for Tender	2025/12/16
5	Issued for Building Permit	2025/12/02
4	Issued For MOH 2.3 Resubmission	2025/06/20
2	Issued For MOH 2.3 Costing	2024/09/13
NO	DESCRIPTION	DATE


PROJECT:
Oncology Radiation Treatment Expansion
2200 Eglinton Ave W,
Mississauga, ON L5M 2N1

TITLE:
**DEMOLITION
PLAN PHASE 3**


PROJECT NO:
23010
CHECKED:
Checker

DRAWING NO:
A105

2 DEMOLITION PHASE 3 CORRIDOR NORTH ELEVATION
1:50

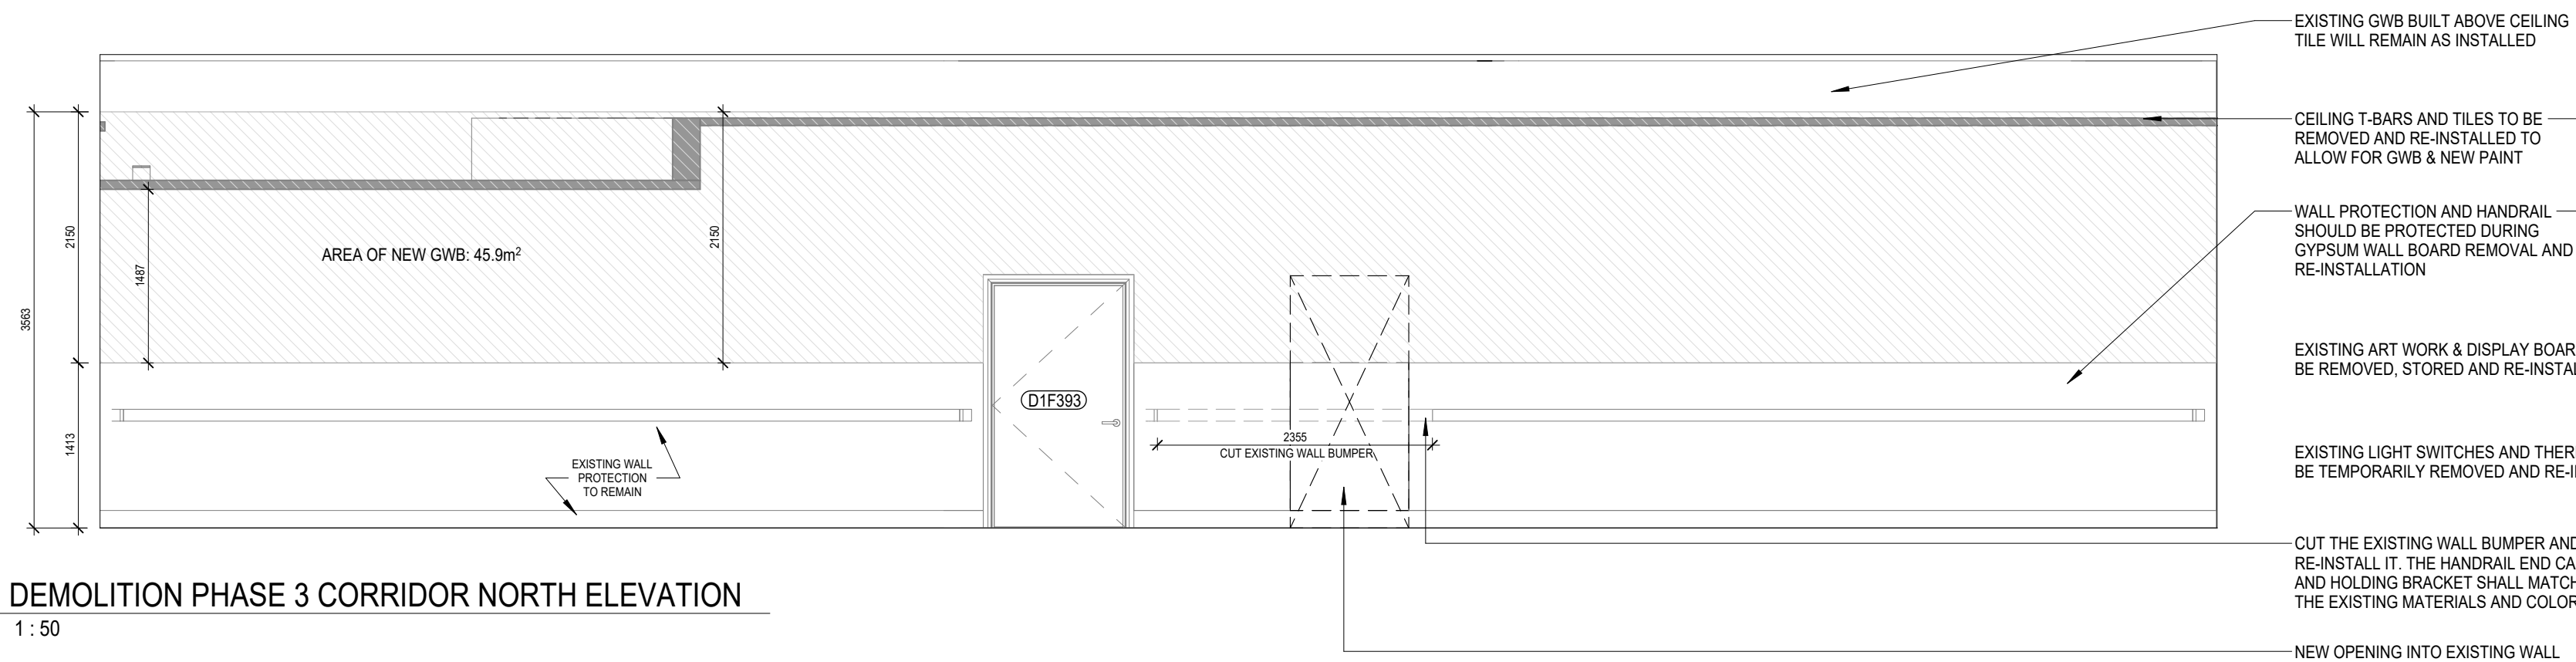

1 DEMOLITION PLAN PHASE 3 (Storage & WC)
1:50

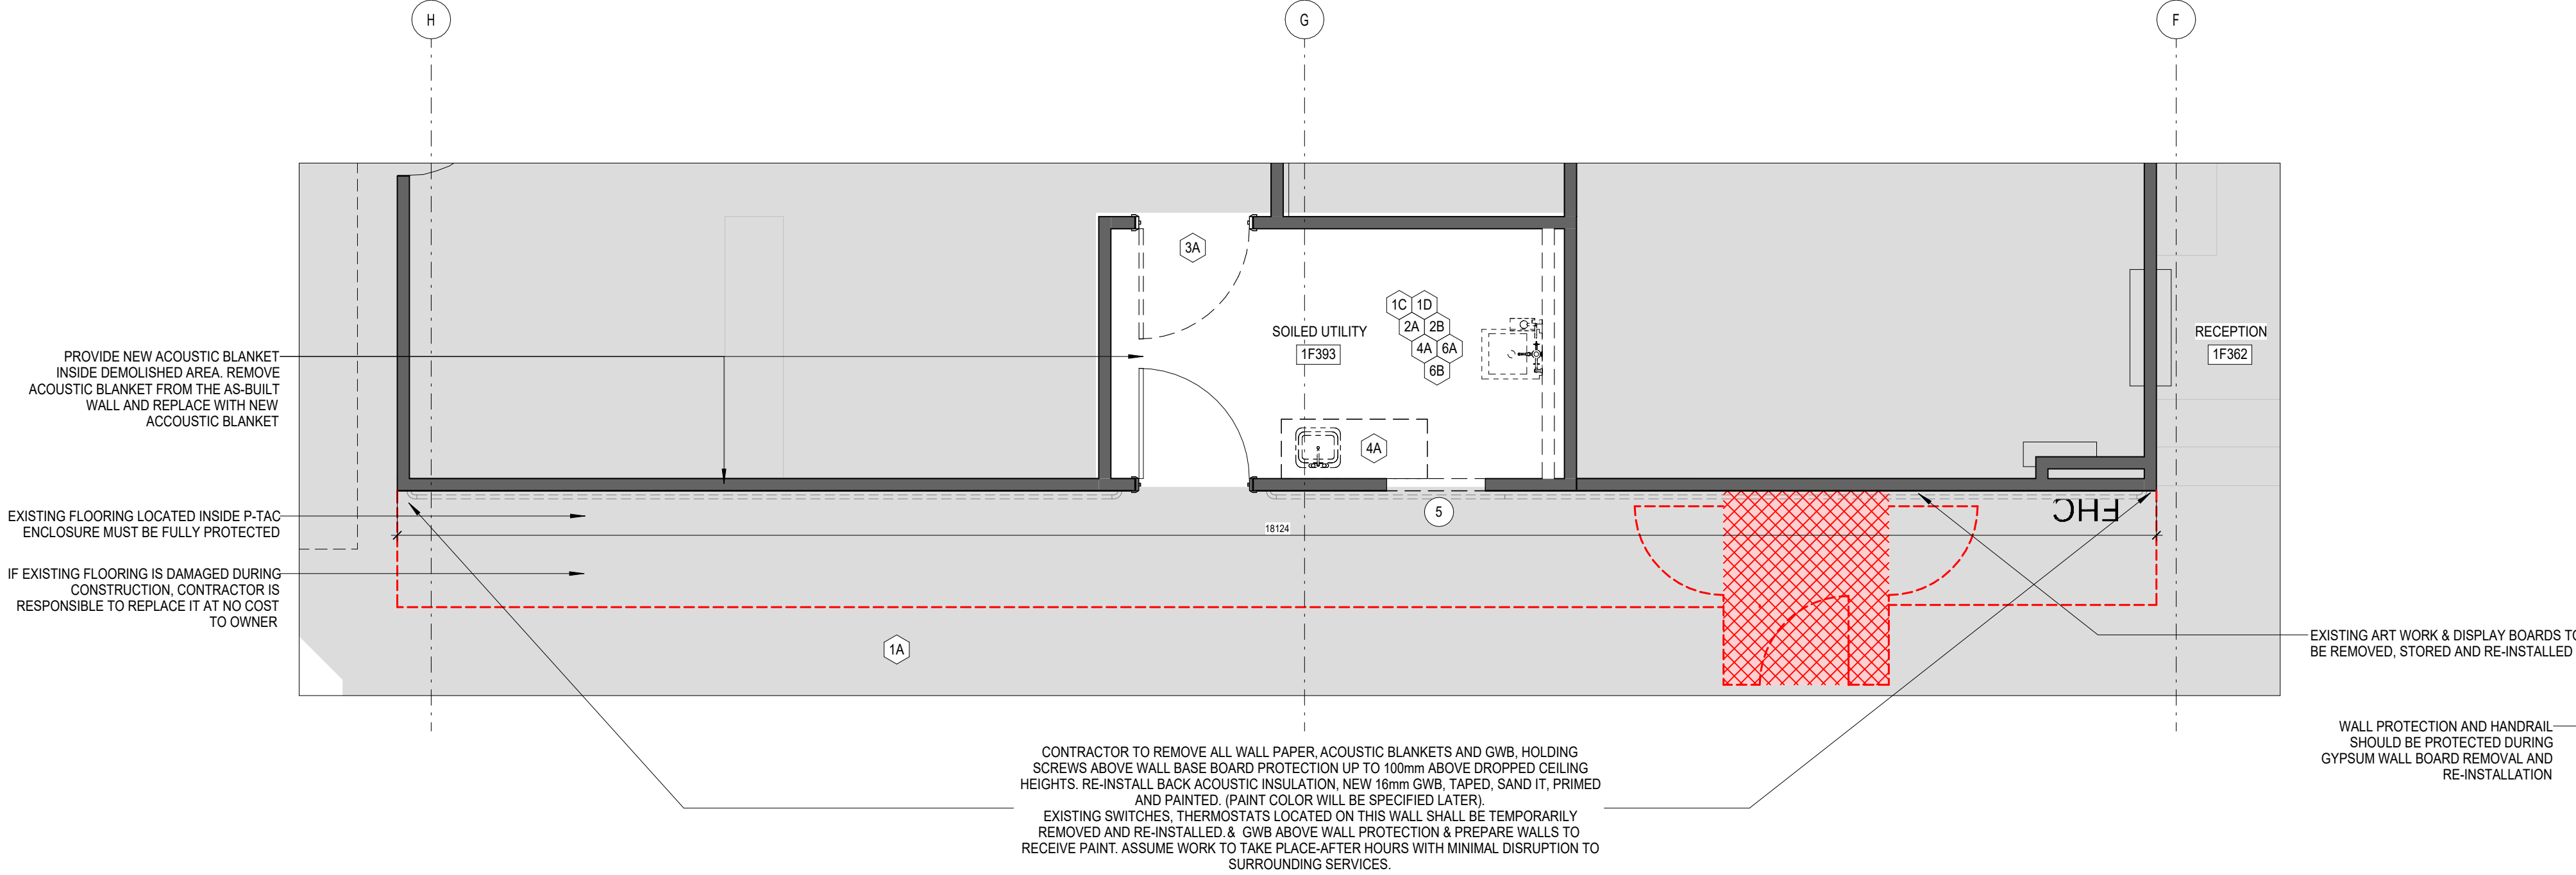

LEGEND - DEMOLITION PLAN

- NOT IN CONTRACT / NOT IN SCOPE AREA
- EXISTING CONSTRUCTION TO REMAIN
- EXISTING CONSTRUCTION TO BE REMOVED

- TRENCH CUT INTO EXISTING CONCRETE SURFACE BED, REFER TO MECHANICAL & STRUCTURAL FOR DETAILS
- EXISTING FLOOR SLAB TO BE REMOVED
- REFER TO STRUCTURAL FOR DETAILS

FE&E OWNER TO ARRANGE FOR REMOVAL OF ALL EXISTING FURNITURE, FITTINGS AND EQUIPMENT FROM PHASED WORK AREAS PRIOR TO START OF CONSTRUCTION. TEMPORARY HOARDING TO BE PROVIDED AS SHOWN IN PHASING PLANS

- REMOVE & RETAIN EXISTING ADO BUTTON & CARD READER. RELOCATE AS NOTED IN NEW WORK. REFER ALSO TO ELECTRICAL DRAWINGS.
- REMOVE & RETAIN EXISTING ADO BUTTON. RELOCATE AS NOTED IN NEW WORK. REFER ALSO TO ELECTRICAL DRAWINGS.
- CAREFULLY REMOVE FRAME AND GLASS. DOOR FRAME AND DOOR TRANSOM TO REMAIN. REFER TO NEW WORK FOR FINAL CONFIGURATION.
- ENSURE THAT CARPET IS ONLY REMOVED WHERE REQUIRED FOR NEW CONSTRUCTION. CARPET TO REMAIN IN FINAL CONFIGURATION OF VESTIBULE.
- PROTECT EXISTING LOBBY WALL FINISHES AS MUCH AS POSSIBLE. EXISTING WALL COVERING IS NO LONGER AVAILABLE.

FLOORS

- MAINTAIN INTEGRITY OF EXISTING CORRIDOR AND EXITS. CORRIDOR SHALL BE FREE OF CONSTRUCTION MATERIAL AND/OR DEBRIS. EXISTING FLOORING TO REMAIN IN THIS AREA AS NOTED ON PLAN. PROVIDE LOCKING HARDWARE FOR ALL DOORS ENTERING INTO THE CONSTRUCTION AREA FROM EXISTING CORRIDOR. COORDINATE WITH OWNER TO PROVIDE CONSTRUCTION CORE LOCKSET FOR HOARDING ACCESS. PROVIDE DUST SEAL ON ALL DOORS BORDERING WORK AREA WHEN PERFORMING WORK IN CORRIDOR. ANY WORK PERFORMED IN THE CORRIDOR SHALL BE DONE AFTER HOURS AND IN COORDINATION WITH THE HOSPITAL. ALL WORK SHALL BE PERFORMED IN CONFORMANCE WITH INFECTIONS PREVENTION AND CONTROL GUIDELINES (E.G. THE USE OF SUBMARINES) TYP.
- EXISTING FLOORING TO REMAIN. CONTRACTOR SHALL FIRST PUT DOWN 6MM SHEETS OF POLYETHYLENE COMPLETE WITH TAPED SEAMS UNDER T&G PLYWOOD PROTECTION BOARD (ALSO WITH TAPED SEAMS) AS REQUIRED IN THIS AREA TO PREVENT EXISTING FLOOR FINISH FROM BEING DAMAGED DURING THE CONSTRUCTION PERIOD. ANY DAMAGED FLOOR FINISH (BASE INCLUDED) DUE TO WORK UNDER THIS CONTRACT SHALL BE MADE GOOD TO MATCH EXISTING TO THE COMPLETE SATISFACTION AND AT NO EXPENSE OF THE OWNER. NO SMALL RANDOM CUT AND PATCH REPAIR WILL BE CONSIDERED ACCEPTABLE. MAKE STRAIGHT AND CLEAN CUT BETWEEN FLOOR FINISH TO REMAIN AND FLOOR FINISH TO BE REPAIRED. MAKE TRANSITION AT DOOR THRESHOLD WHERE POSSIBLE TYP.
- EXISTING FLOOR FINISH (E.G. VCT, CARPET, CERAMIC TILE, SHEET VINYL AND EPOXY CAW FLASH COVE AND RUBBER AND OTHER BASES ETC.) TO BE REMOVED. SCRAPE AND PREPARE SUBSTRATE AS REQUIRED TO OBTAIN SMOOTH AND LEVEL SURFACE READY TO RECEIVE NEW FLOOR FINISHES AS AND WHERE SPECIFIED. CLEAN AND LEVEL EXISTING CONCRETE SUBSTRATE, INCLUDING ANY IRREGULARITIES AND PHYSICAL RESIDUE, AND FILL DEPRESSIONS AND CRACKS WITH FLOOR LEVELING COMPOUND. REMOVE ANY EXISTING MATERIAL, ADHESIVES, OIL OR DUST THAT MAY BE DETRIMENTAL TO THE BONDING OF THE NEW FLOORING. TELEGRAPHING OF SUBSTRATE THROUGH TO NEW FLOORING IS NOT PERMITTED. USE SELF-LEVELING MORTAR IN AREAS THAT NEED TO BE BUILT UP TO MATCH EXISTING FLOOR LEVELS. CONTRACTOR TO ENSURE FLOOR IS TRUE AND LEVEL TO MEET THE REQUIREMENTS OF THE NEW WORK. MAKE GOOD FLOOR SUBSTRATES WHERE EXISTING PARTITIONS HAVE BEEN DEMOLISHED TYP.

- REDUNDANT FLOOR BOXES, RACEWAYS, SERVICES, DRAINS, SLEEVES/OPENINGS THROUGH EXISTING CONCRETE FLOOR SLAB SHALL BE FILLED WITH NEW CONCRETE TO OBTAIN A STRUCTURALLY SOUND, SMOOTH AND LEVEL SURFACE TO RECEIVE NEW FLOOR FINISHES. MAKE REPAIRS AS REQUIRED. MAINTAIN REQUIRED FIRE-RESISTANCE RATINGS OF FLOOR SLABS.
- SEE STRUCTURAL DRAWINGS FOR DETAILS AND GENERAL NOTES RELATED TO AS-BUILT CONC. SLAB REMOVAL AND CUTTING.

WALLS

- REMOVE AND DISPOSE OF EXISTING GYPSUM BOARD AND METAL STUD FRAMED PARTITIONS COMPLETE WITH ASSOCIATED WALL BASE, HANDRAILS/BUMPERS AND CORNER GUARDS, WHERE INDICATED BY DASHED LINES. REMOVE ALL REDUNDANT MECHANICAL AND ELECTRICAL SERVICES IN CONFORMANCE WITH GOVERNING CODES AND AUTHORITIES. REFER TO AND COORDINATE WITH MECHANICAL AND ELECTRICAL DIVISION SCOPE OF WORK. MAKE GOOD ALL AFFECTED SURFACES AS REQUIRED TO MATCH EXISTING, OR TO LEAVE READY TO RECEIVE NEW FINISHES TYP.
- REMOVE AND DISPOSE OF EXISTING INTERIOR WALL ACCESSORIES (I.E. CORNER GUARDS, WALL BUMBERS ETC.) AND MAKE GOOD ALL AFFECTED SURFACES AS REQUIRED TO MATCH EXISTING, OR TO LEAVE READY TO RECEIVE NEW FINISHES TYP. ALL FLOOR BASE FINISHES TO REMAIN IN AREAS WHERE EXISTING FLOORING IS MAINTAINED.
- REMOVE AND DISPOSE OF EXISTING WALL FINISHES TO EXPOSE FRAMING BEHIND. AT LOCATIONS OF STRUCTURAL CONCRETE OR CONCRETE MASONRY UNIT SUBSTRATES, ALSO REMOVE METAL STUD FRAMING / BLOCKING TO EXPOSE THE STRUCTURAL ELEMENTS TO REMAIN. MAKE GOOD ALL EXISTING SUBSTRATES TO REMAIN READY TO RECEIVE NEW FINISHES.
- REMOVE AND DISPOSE OF EXISTING CONCRETE BLOCK PARTITION / INFILL INCLUDING ALL ASSOCIATED FINISHES.

N.B. REMOVE AND RETAIN AND / OR DISPOSE OF EXISTING WALL-MOUNTED EQUIPMENT, FITTINGS AND DEVICES, INCLUDING ALL RELATED ATTACHMENTS, MOUNTINGS, ETC. WHERE LOCATION ON CONSTRUCTION SCHEDULED FOR REMOVAL. COORDINATE WITH OWNER THE EXTENT OF ITEMS TO BE RETAINED.

DOORS

- REMOVE AND DISPOSE OF EXISTING DOOR, FRAME AND HARDWARE WHERE INDICATED BY DASHED LINES. ELECTRICAL TRADE TO DISCONNECT POWER FOR DOORS WITH ELECTRIFIED CONTROLS/HARDWARE. COORDINATE WITH ELECTRICAL AND REFER TO ELECTRICAL DRAWINGS FOR FULL EXTENT OF WORK TYP.
- REMOVE AND REINSTALL DOOR

MILLWORK/CASEWORK

- REMOVE AND DISPOSE OF EXISTING MILLWORK COMPLETE WITH PLUMBING AND ELECTRICAL FIXTURES AND ALL RELATED FITMENTS WHERE INDICATED BY DASHED LINES. CAP OFF ALL SERVICES IN ACCORDANCE WITH MECHANICAL AND ELECTRICAL SCOPE OF WORK. PLUMBING SERVICES TO BE CAPPED AS FAR BACK TO THE MAIN AS POSSIBLE TO ELIMINATE DEAD LEGS. MAKE GOOD ALL AFFECTED SURFACES AS REQUIRED TO LEAVE READY FOR INSTALLATION OF NEW WORK. REFER TO AND COORDINATE WITH MECHANICAL AND ELECTRICAL DIVISIONS TYP.
- MILLWORK TO REMAIN. COVER AND PROTECT MILLWORK DURING DEMOLITION AND CONSTRUCTION

MECHANICAL & ELECTRICAL

- COORDINATE WITH MECHANICAL DIVISION AND REMOVE PLUMBING FIXTURES, FAUCETS AND CONTROLS, FLOOR DRAINS, VENTS AND CONTROLS, AND MEDICAL GASES, WHERE INDICATED. COORDINATE WITH MECHANICAL DIVISION FOR SHUT-OFF, TERMINATION, REMOVAL AND CAPPING OFF OF EXISTING DUCTWORK, PLUMBING, FIXTURES AND ACCESSORIES AS REQUIRED TO ACCOMMODATE THE DEMOLITION AND NEW WORK. TERMINATE AND CAP OFF SERVICES IN CONFORMANCE WITH MECHANICAL SCOPE OF WORK AND IN CONFORMANCE WITH ALL GOVERNING CODES AND AUTHORITIES. COORDINATE WITH MECHANICAL DIVISION FOR FULL EXTENT OF MECHANICAL DEMOLITION WORK REQUIRED. FILL AND FIRESTOP REDUNDANT CORE/SLEEVE OPENINGS IN FIRE-RATED ASSEMBLIES TYP.
- COORDINATE WITH ELECTRICAL DIVISION FOR THE SHUT-OFF, TERMINATION, REMOVAL AND CAPPING OFF OF EXISTING ELECTRICAL CONTROLS, SWITCHES AND SERVICES AS REQUIRED TO ACCOMMODATE THE DEMOLITION AND NEW WORK. TERMINATE AND CAP OFF SERVICES IN CONFORMANCE WITH ELECTRICAL SCOPE OF WORK AND IN CONFORMANCE WITH ALL GOVERNING CODES AND AUTHORITIES. COORDINATE WITH ELECTRICAL DIVISION FOR FULL EXTENT OF ELECTRICAL DEMOLITION WORK REQUIRED. FILL AND FIRESTOP REDUNDANT CORE/SLEEVE OPENINGS IN FIRE-RATED ASSEMBLIES TYP.
- EXISTING FIRE HOSE CABINET AND ASSOCIATED PIPING TO BE RETAINED IN PLACE AND LEFT OPERATIONAL. AT FIRE HOSE CABINETS TO REMAIN, SHUT-OFF VALVES SHALL BE IDENTIFIED AND PROVIDED WITH LOCK-OUT BYPASS IN ORDER TO MITIGATE RISK OF FLOOD DAMAGE DURING CONSTRUCTION. REFER TO AND COORDINATE WITH MECHANICAL DIVISION FOR FULL SCOPE OF WORK.
- REMOVE AND DISPOSE OF EXISTING MEDICAL GAS SERVICE CONSOLE AND ASSOCIATED PIPING. REFER TO MECHANICAL FOR FULL SCOPE OF WORK.
- EXISTING ELECTRICAL PANELS AND/OR FIRE ALARM PANELS TO BE RETAINED IN PLACE AND LEFT OPERATIONAL. REFER TO ELECTRICAL DIVISION FOR FULL SCOPE OF WORK.
- EXISTING FIRE HOSE CABINET AND ASSOCIATED PIPING TO BE DEMOLISHED. SHUT OFF VALVES SHALL BE IDENTIFIED AND PROVIDED WITH LOCK-OUT BYPASS IN ORDER TO MITIGATE RISK OF FLOOD DAMAGE DURING CONSTRUCTION. REFER TO AND COORDINATE WITH MECHANICAL DIVISION FOR FULL SCOPE OF WORK.

GENERAL NOTES:


- ALL SPRINKLERS TO BE MODIFIED TO SUIT NEW SCOPE. SPRINKLER HEADS TO BE TURNED UP FOR SHELL SPACE. REFER TO MECHANICAL DWGS FOR FULL EXTENT OF WORK.
- ALL NOTES APPLY TO HATCHED GENERAL DEMOLITION AREA, UNLESS OTHERWISE NOTED.
- CEILING DEMOLITION AREA MUST BE COORDINATED WITH EXISTING AND FUTURE MEP WORKS.
- CONTRACTOR TO BE RESPONSIBLE FOR THE DISPOSAL OF ALL MATERIALS REMOVED FROM DEMOLITION. ALL DISPOSALS TO COMPLY WITH LOCAL MUNICIPALITY / AUTHORITY REGULATIONS.
- ALL DIMENSIONS OF WALLS SHOWN IN PLANS TO BE DEMOLISHED ARE DETERMINED FROM EXISTING DRAWINGS PROVIDED BY CLIENT. ANY DISCREPANCIES BETWEEN AS-BUILT SITE CONDITIONS AND DEMOLITION PLANS SHOULD BE BROUGHT TO ARCHITECT / MECHANICAL / ELECTRICAL / SPRINKLER DESIGNER'S ATTENTION PRIOR TO PROCEEDING WITH WORK.
- SEE MEP DEMOLITION PLAN DRAWINGS AND SCANNING REPORTS FOR MEP AS-BUILTS UNDER THE CONC. SLAB REMOVAL AREA.
- FLOOR TO FLOOR HEIGHT IS APPROX. 4600mm

CLIENT:



2200 Eglinton Avenue West
Mississauga, ON L5M 2N1
905 813 2200
thp.ca

CONSULTANT:

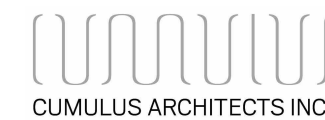


160 Pears Ave. - Suite 300
Toronto, ON M5R 3P8
416-539-0763
www.cumulusarch.com

SEAL:

This drawing, as an instrument of service, is the property of Cumulus Architects Inc. the copyright in the same being reserved to them. No reproduction is allowed without the permission of Cumulus Architects Inc. and when made must bear its name.

This drawing is not to be scaled. The contractor is to verify dimensions and data noted herein for conformity with the conditions on site and is responsible for reporting in writing any discrepancy to Cumulus Architects Inc. for adjustment.

Cumulus will not be liable for any claims or damages arising from the unauthorized use of this drawing or any portion thereof.

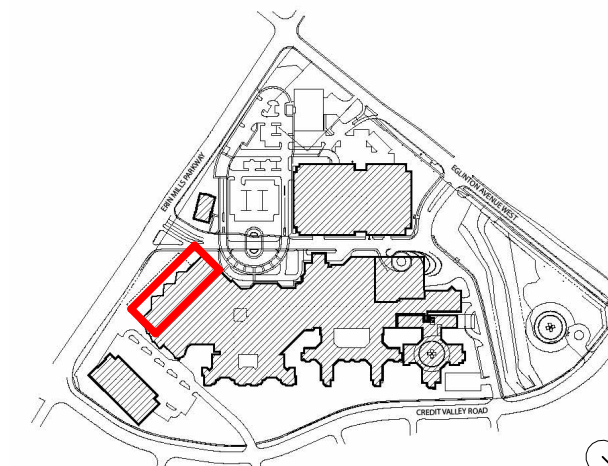

KEY PLAN

7	Issued for Addendum 1	2026/02/04
NO	DESCRIPTION	DATE
SHEET REVISION		


PROJECT:
Oncology Radiation Treatment Expansion
2200 Eglinton Ave W,
Mississauga, ON L5M 2N1

TITLE:
**DEMOLITION
PLAN PHASE 3**

PROJECT NO:
23010
CHECKED:
Checker

DRAWING NO:

A105a

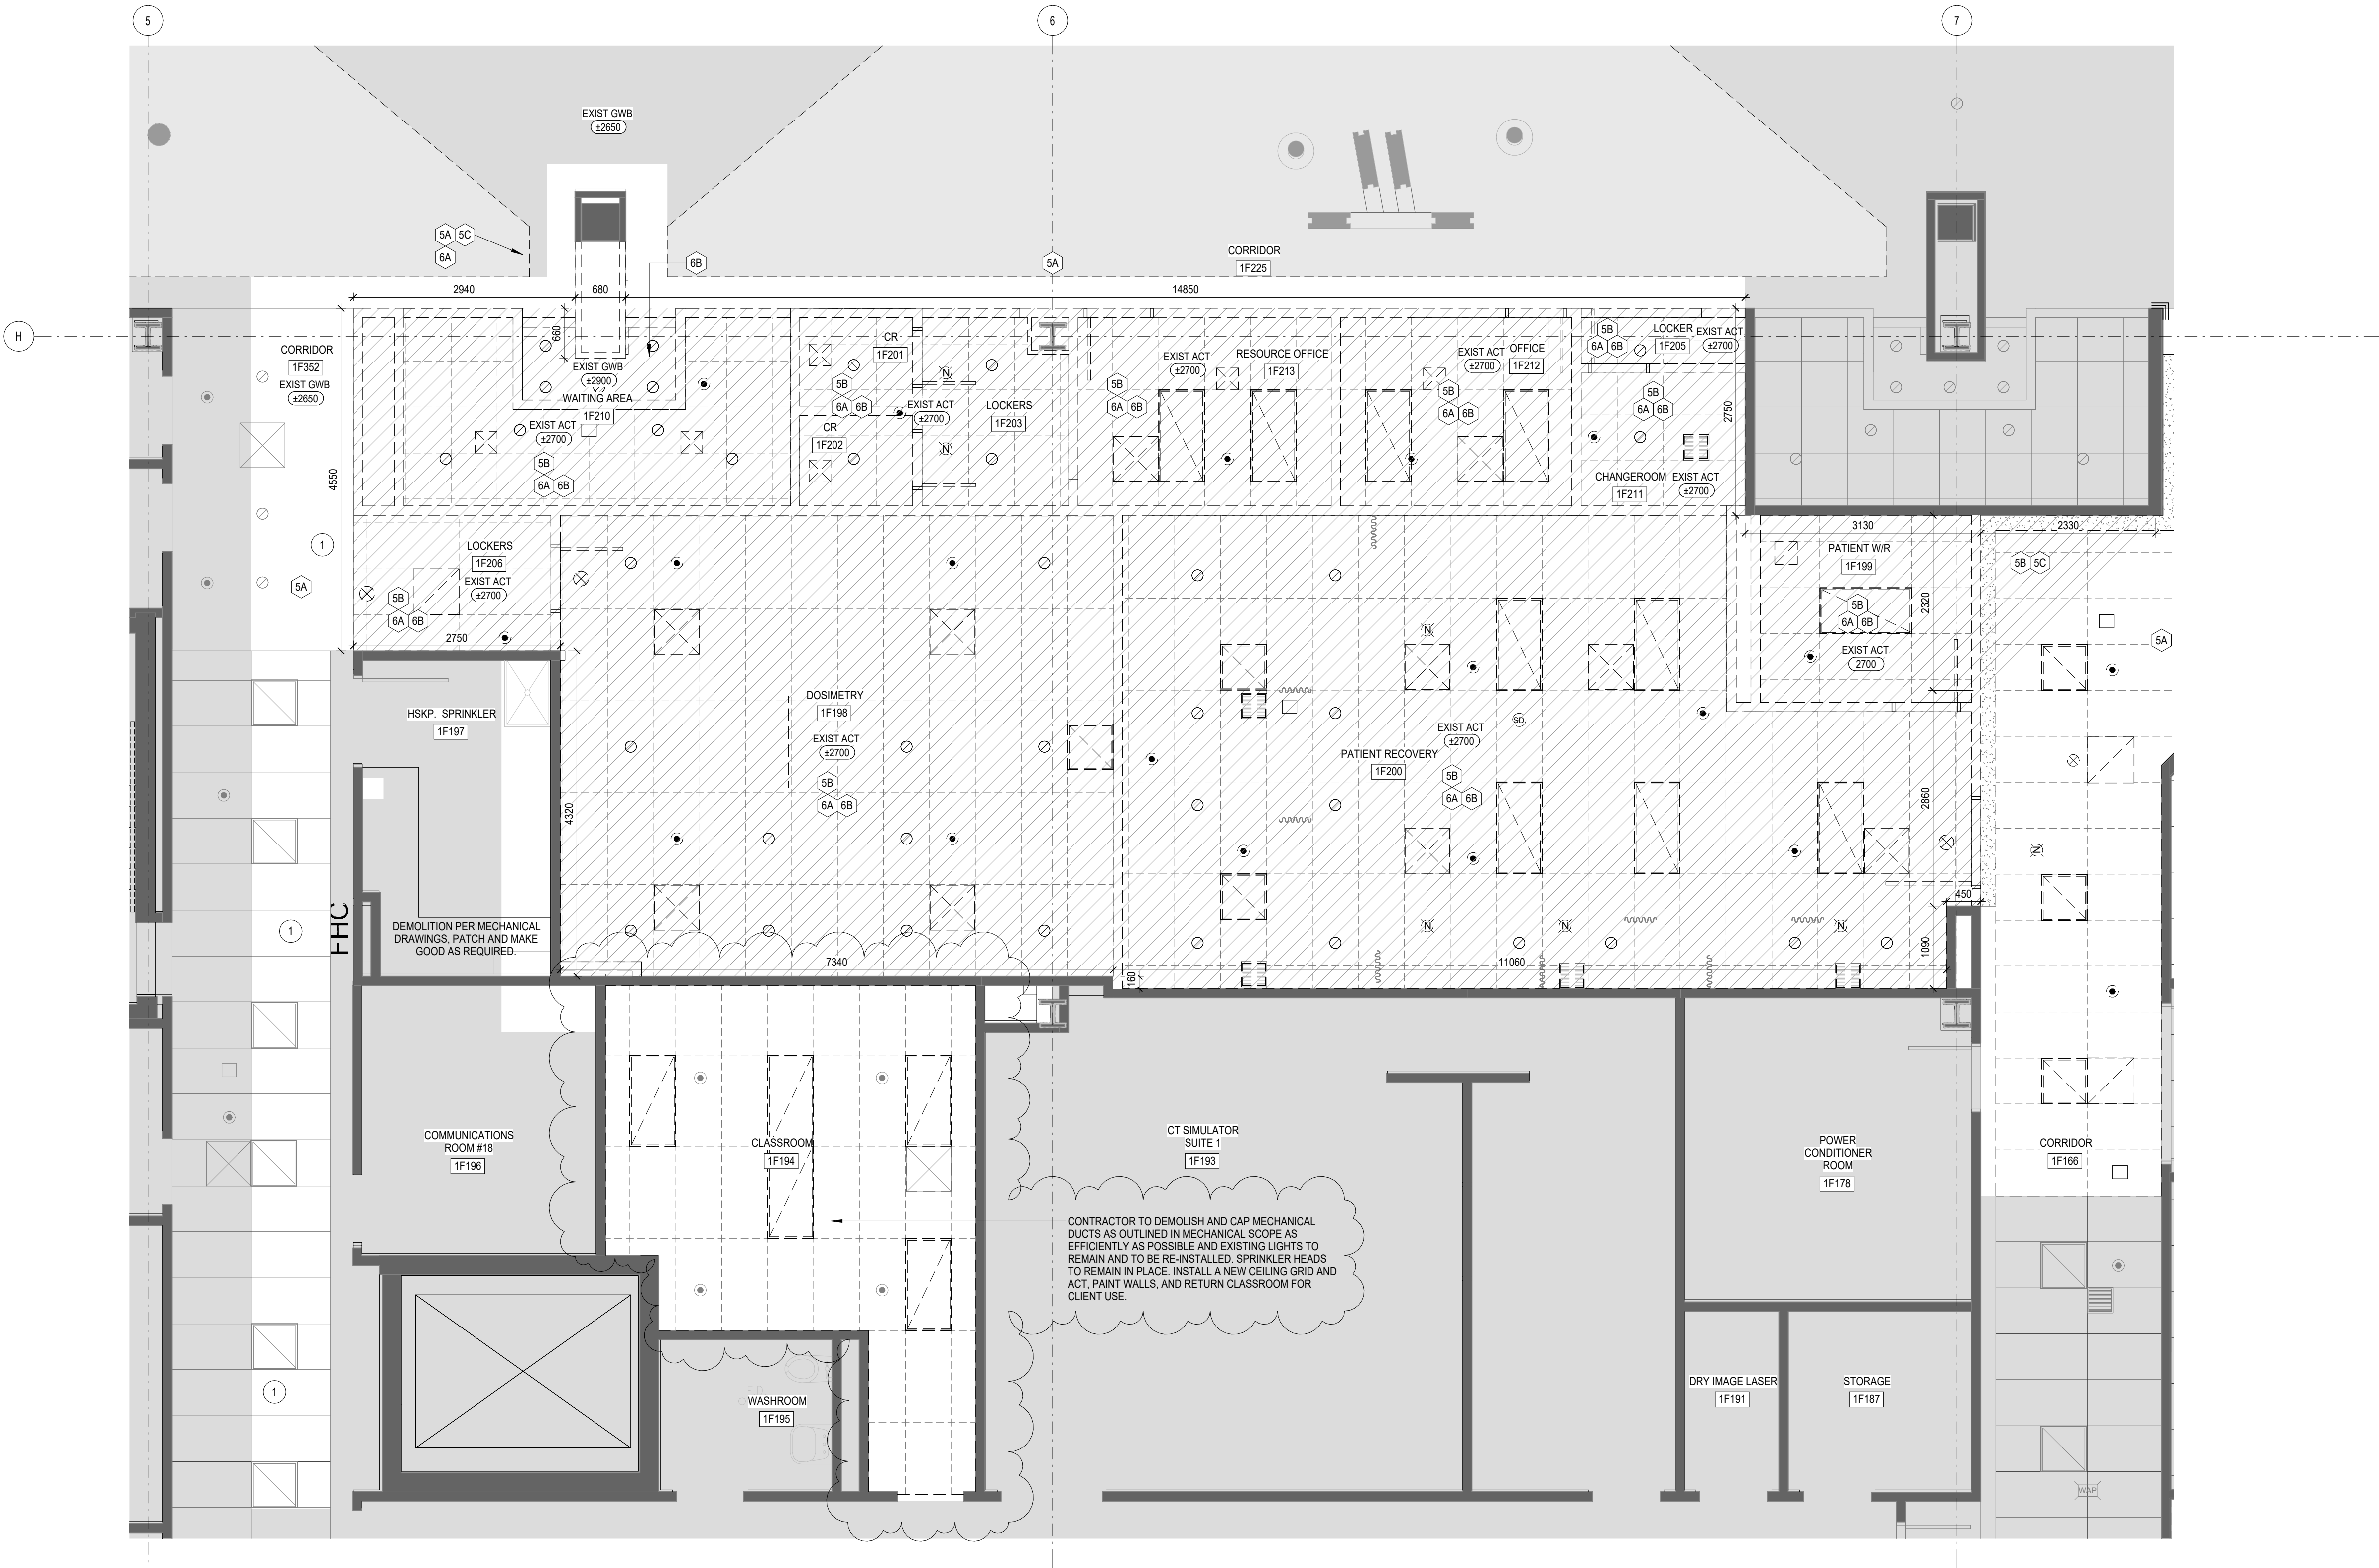

1 DEMOLITION RCP - (HALCYON 2)
1:50

LEGEND - DEMOLITION RCP

- NOT IN CONTRACT / NOT IN SCOPE AREA
- EXISTING CONSTRUCTION TO REMAIN
- EXISTING CONSTRUCTION TO BE REMOVED
- EXISTING CEILING FINISHES TO BE REMOVED, INCLUDING EXISTING DEVICES AND FIXTURES ON CEILING.

CEILING DEMOLITION AREA MUST BE COORDINATED WITH BOTH EXISTING AND FUTURE MEP WORKS.

- MECHANICAL SERVICE WORK ABOVE. PATCH AND MAKE GOOD EXISTING CEILINGS AS REQUIRED.

DEMOLITION PLAN - GENERAL NOTES:

READ ARCHITECTURAL DEMOLITION DRAWINGS IN CONJUNCTION WITH ELECTRICAL, MECHANICAL AND STRUCTURAL DEMOLITION DRAWINGS.

DRAWINGS MAY NOT REPRESENT EXISTING CONDITIONS IN ITS ENTIRETY. CONTRACTORS ARE RESPONSIBLE FOR SITE SURVEYING PRIOR TO CONSTRUCTION.

PRIOR TO DEMOLITION NOTIFY CONSULTANTS OF ANY DISCREPANCIES WITH THE DRAWINGS.

PRIOR TO DEMOLITION COORDINATE WITH OWNER HOURS OF OPERATION, MATERIAL AND WASTE HANDLING REQUIREMENTS AND MATERIAL TO BE REUSED.

PROTECT AREA OF WORK. EXISTING CONSTRUCTION TO REMAIN AND ADJACENT AREAS FROM DAMAGE.

COORDINATE WITH OWNER AND OBTAIN APPROVAL FOR SPECIAL DEMOLITION ACTIVITIES CAUSING DISTURBANCE TO OTHER OCCUPANTS AND SPACES OUTSIDE DEMOLITION AREA.

PROVIDE DUST BARRIER TO ALL AREAS AFFECTED BY THE DEMOLITION AND PROTECT AND MAINTAIN CORRIDORS AND ADJACENT CLINICAL AREAS DURING DEMOLITION.

REFER TO OWNER'S DESIGNATED SUBSTANCES REPORT FOR PRE-EXISTING DESIGNATED SUBSTANCES OBSERVED. NOTIFY CONSULTANT AND OWNER OF ANY DESIGNATED SUBSTANCES DISCOVERED DURING DEMOLITION.

CEILINGS

- CEILING WORK IN CORRIDORS OUTSIDE THE CONSTRUCTION HOARDED AREAS TO TAKE PLACE AFTER HOURS IN COORDINATION WITH OWNER.
- REMOVE AND DISPOSE OF EXISTING CEILING TILES AND T-BAR SUSPENSION GRIDS WHERE INDICATED BY DIAGONAL HATCH PATTERN. COORDINATE WITH MECHANICAL AND ELECTRICAL FOR FULL SCOPE OF REMOVALS. REMOVE ALL REDUNDANT HANGERS AND FRAMING TO MAKE FOR A CLEAN AND UNOBSTRUCTED WORK AREA READY FOR NEW WORK UNDER THIS CONTRACT.
- REMOVE AND DISPOSE OF EXISTING GYPSUM BOARD CEILING WHERE INDICATED BY DIAGONAL HATCH PATTERN. COORDINATE WITH MECHANICAL AND ELECTRICAL FOR FULL SCOPE OF REMOVALS. REMOVE ALL REDUNDANT HANGERS AND FRAMING TO MAKE FOR A CLEAN AND UNOBSTRUCTED WORK AREA READY FOR NEW WORK UNDER THIS CONTRACT.
- REMOVE AND DISPOSE OF EXISTING CEILING TILES. MAINTAIN AND PROTECT EXISTING T-BARS SUSPENSION AND TO RECEIVE FIXTURES & CEILING TILES.
- REMOVE ALL EXISTING DEVICES AND FIXTURES ON CEILINGS TO REMAIN. PREPARE CEILING TO RECEIVE NEW DEVICES AND FINISHES.
- REMOVE AND REINSTATE THE EXISTING CEILING TILES AND T-BAR SUSPENSION GRIDS. TO MAKE FOR AN UNOBSTRUCTED WORK AREA. COORDINATE WITH MECHANICAL AND ELECTRICAL FOR FULL SCOPE OF REMOVALS.

- CUT EXISTING GWB CEILINGS AS REQUIRED TO FACILITATE INSTALLATION OF ELECTRICAL OR MECHANICAL SERVICES AND REPAIR CEILINGS TO PRE-EXISTING CONDITIONS. COORDINATE WITH MECHANICAL AND ELECTRICAL FOR FULL SCOPE OF REMOVAL. CONTRACTORS CAN ADVISE LOCATIONS WHERE PATCH-WORK CAN BE MANAGED LOCALLY.
- REMOVE AND REINSTATE ALL EXISTING DEVICES AND FIXTURES ON CEILING. CONTRACTORS TO INFORM/ADVISE IF REINSTATING ANY FUTURE/ DEVICE IS NOT POSSIBLE. IT WILL BE REVIEWED ON DRAWING AND NEW LOCATION FOR SAME WILL BE PROVIDED.
- PROVIDE CUT-OUT IN BLOCK WALL ABOVE CEILING, FOR DUCT PENETRATION. COORDINATE WITH MECHANICAL FOR FULL SCOPE. REFER TO DETAIL-X ON SHEET AD110 FOR NEW DUCTWORK OPENING LAYOUT.
- REMOVE AND DISPOSE OF EXISTING LIGHT COVE WHERE INDICATED BY DIAGONAL HATCH. NEATLY CUT AND REMOVE REDUNDANT BRACKETS. MAKE GOOD FOR NEW WORK UNDER THIS CONTRACT.
- REMOVE AND DISPOSE OF EXISTING GYPSUM BOARD BULKHEAD WHERE INDICATED BY DASHED LINES. COORDINATE WITH MECHANICAL AND ELECTRICAL FOR FULL SCOPE OF REMOVALS. REMOVE ALL REDUNDANT HANGERS AND FRAMING TO MAKE FOR A CLEAN AND UNOBSTRUCTED WORK AREA READY FOR NEW WORK UNDER THIS CONTRACT.

MECHANICAL & ELECTRICAL

- COORDINATE WITH MECHANICAL DIVISION AND REMOVE PLUMBING FIXTURES, FAUCETS AND CONTROLS. FLOOR DRAINS, VENTS AND CONTROLS, AND MEDICAL GASES, WHERE INDICATED. COORDINATE WITH MECHANICAL DIVISION FOR SHUT-OFF, TERMINATION, REMOVAL AND CAPPING OFF OF EXISTING DUCTWORK, PLUMBING, FIXTURES AND ACCESSORIES AS REQUIRED TO ACCOMMODATE THE DEMOLITION AND NEW WORK. TERMINATE AND CAP OFF SERVICES IN CONFORMANCE WITH MECHANICAL SCOPE OF WORK AND IN CONFORMANCE WITH ALL GOVERNING CODES AND AUTHORITIES. COORDINATE WITH MECHANICAL DIVISION FOR FULL EXTENT OF MECHANICAL DEMOLITION WORK REQUIRED. FILL AND FIRESTOP REDUNDANT CORE/SLEEVE OPENINGS IN FIRE-RATED ASSEMBLIES TYP.
- COORDINATE WITH ELECTRICAL DIVISION FOR THE SHUT-OFF, TERMINATION, REMOVAL AND CAPPING OFF OF EXISTING ELECTRICAL CONTROLS, SWITCHES AND SERVICES AS REQUIRED TO ACCOMMODATE THE DEMOLITION AND NEW WORK. TERMINATE AND CAP OFF SERVICES IN CONFORMANCE WITH ELECTRICAL SCOPE OF WORK AND IN CONFORMANCE WITH ALL GOVERNING CODES AND AUTHORITIES. COORDINATE WITH ELECTRICAL DIVISION FOR FULL EXTENT OF ELECTRICAL DEMOLITION WORK REQUIRED. FILL AND FIRESTOP REDUNDANT CORE/SLEEVE OPENINGS IN FIRE-RATED ASSEMBLIES TYP.

LEGEND - RCP SYMBOLS

- LAY-IN ACT1 ACOUSTIC TILES IN T-BAR GRID SYSTEM. REFER TO FINISH SCHEDULE.
- GYPSUM BOARD ON METAL FRAMING AS REQUIRED AND SUSPENDED FROM STRUCTURE.
- FEATURE BLUE GYPSUM BOARD ON METAL FRAMING AS REQUIRED AND SUSPENDED FROM STRUCTURE. COLOUR TO BE P77. REFER TO FINISHES SCHEDULE.

NOTE: ALL ACCESSORIES ON FEATURE CEILING TO BE PAINTED P77 TO MATCH BLUE GYPSUM BOARD

CEILING FIXTURES/DEVICES LEGEND

NOTE: REFER TO M.E. DRAWINGS AND SPECIFICATIONS FOR DEVICES.

- LIGHTING**
 - CEILING MOUNTED LIGHT FIXTURES.

LIFE SAFETY + COMMUNICATION

- SPRINKLER**
 - OCCUPANCY SENSOR
 - CEILING MOUNTED SMOKE DETECTOR (REFER TO ELECTRICAL)
 - EMERGENCY VOICE COMMUNICATION SYSTEM (REFER TO ELECTRICAL)
 - CEILING MOUNTED WIRELESS ACCESS POINT (REFER TO ELECTRICAL)
 - CEILING MOUNTED EXIT LIGHT WITH DIRECTIONAL ARROW AS INDICATED (REFER TO ELECTRICAL)
- CCTV CAMERA (REFER TO ELECTRICAL)**
- NURSE CALL DOME LIGHT**
- HVAC**
 - SUPPLY AIR DIFFUSER.
 - RETURN AIR GRILLE.

CLIENT:

Trillium Health Partners

2200 Eglinton Avenue West
Mississauga, ON, L5M 2N1
905 813 2200
thp.ca

CONSULTANT:

CUMULUS ARCHITECTS INC.


160 Pears Ave. - Suite 300
Toronto, ON M5R 3P8
416-539-0763
www.cumulusarch.com

SEAL:

This drawing, as an instrument of service, is the property of Cumulus Architects Inc. the copyright in the same being reserved to them. No reproduction is allowed without the permission of Cumulus Architects Inc. and when made must bear its name.

This drawing is not to be scaled. The contractor is to verify dimensions and data noted herein for conformity with the conditions on site and is responsible for reporting in writing any discrepancy to Cumulus Architects Inc. for adjustment.

Cumulus will not be liable for any claims or damages arising from the unauthorized use of this drawing or any portion thereof.

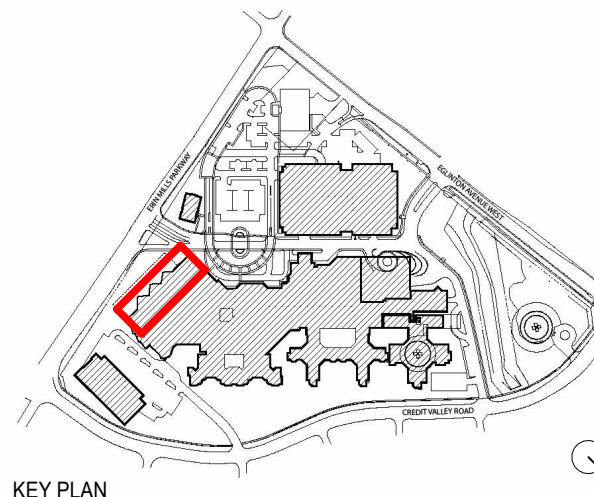

KEY PLAN

NO	DESCRIPTION	DATE
7	Issued for Addendum 1	2026/02/04
6	Issued for Tender	2025/12/16
5	Issued for Building Permit	2025/12/02
4	Issued For MOH 2.3 Resubmission	2025/06/20
2	Issued For MOH 2.3 Costing	2024/09/13

SHEET REVISION


PROJECT:
Oncology Radiation Treatment Expansion
2200 Eglinton Ave W,
Mississauga, ON L5M 2N1

TITLE:
DEMOLITION RCP
PHASE 2

PROJECT NO:
23010
CHECKED:
Checker

DRAWING NO:

A114

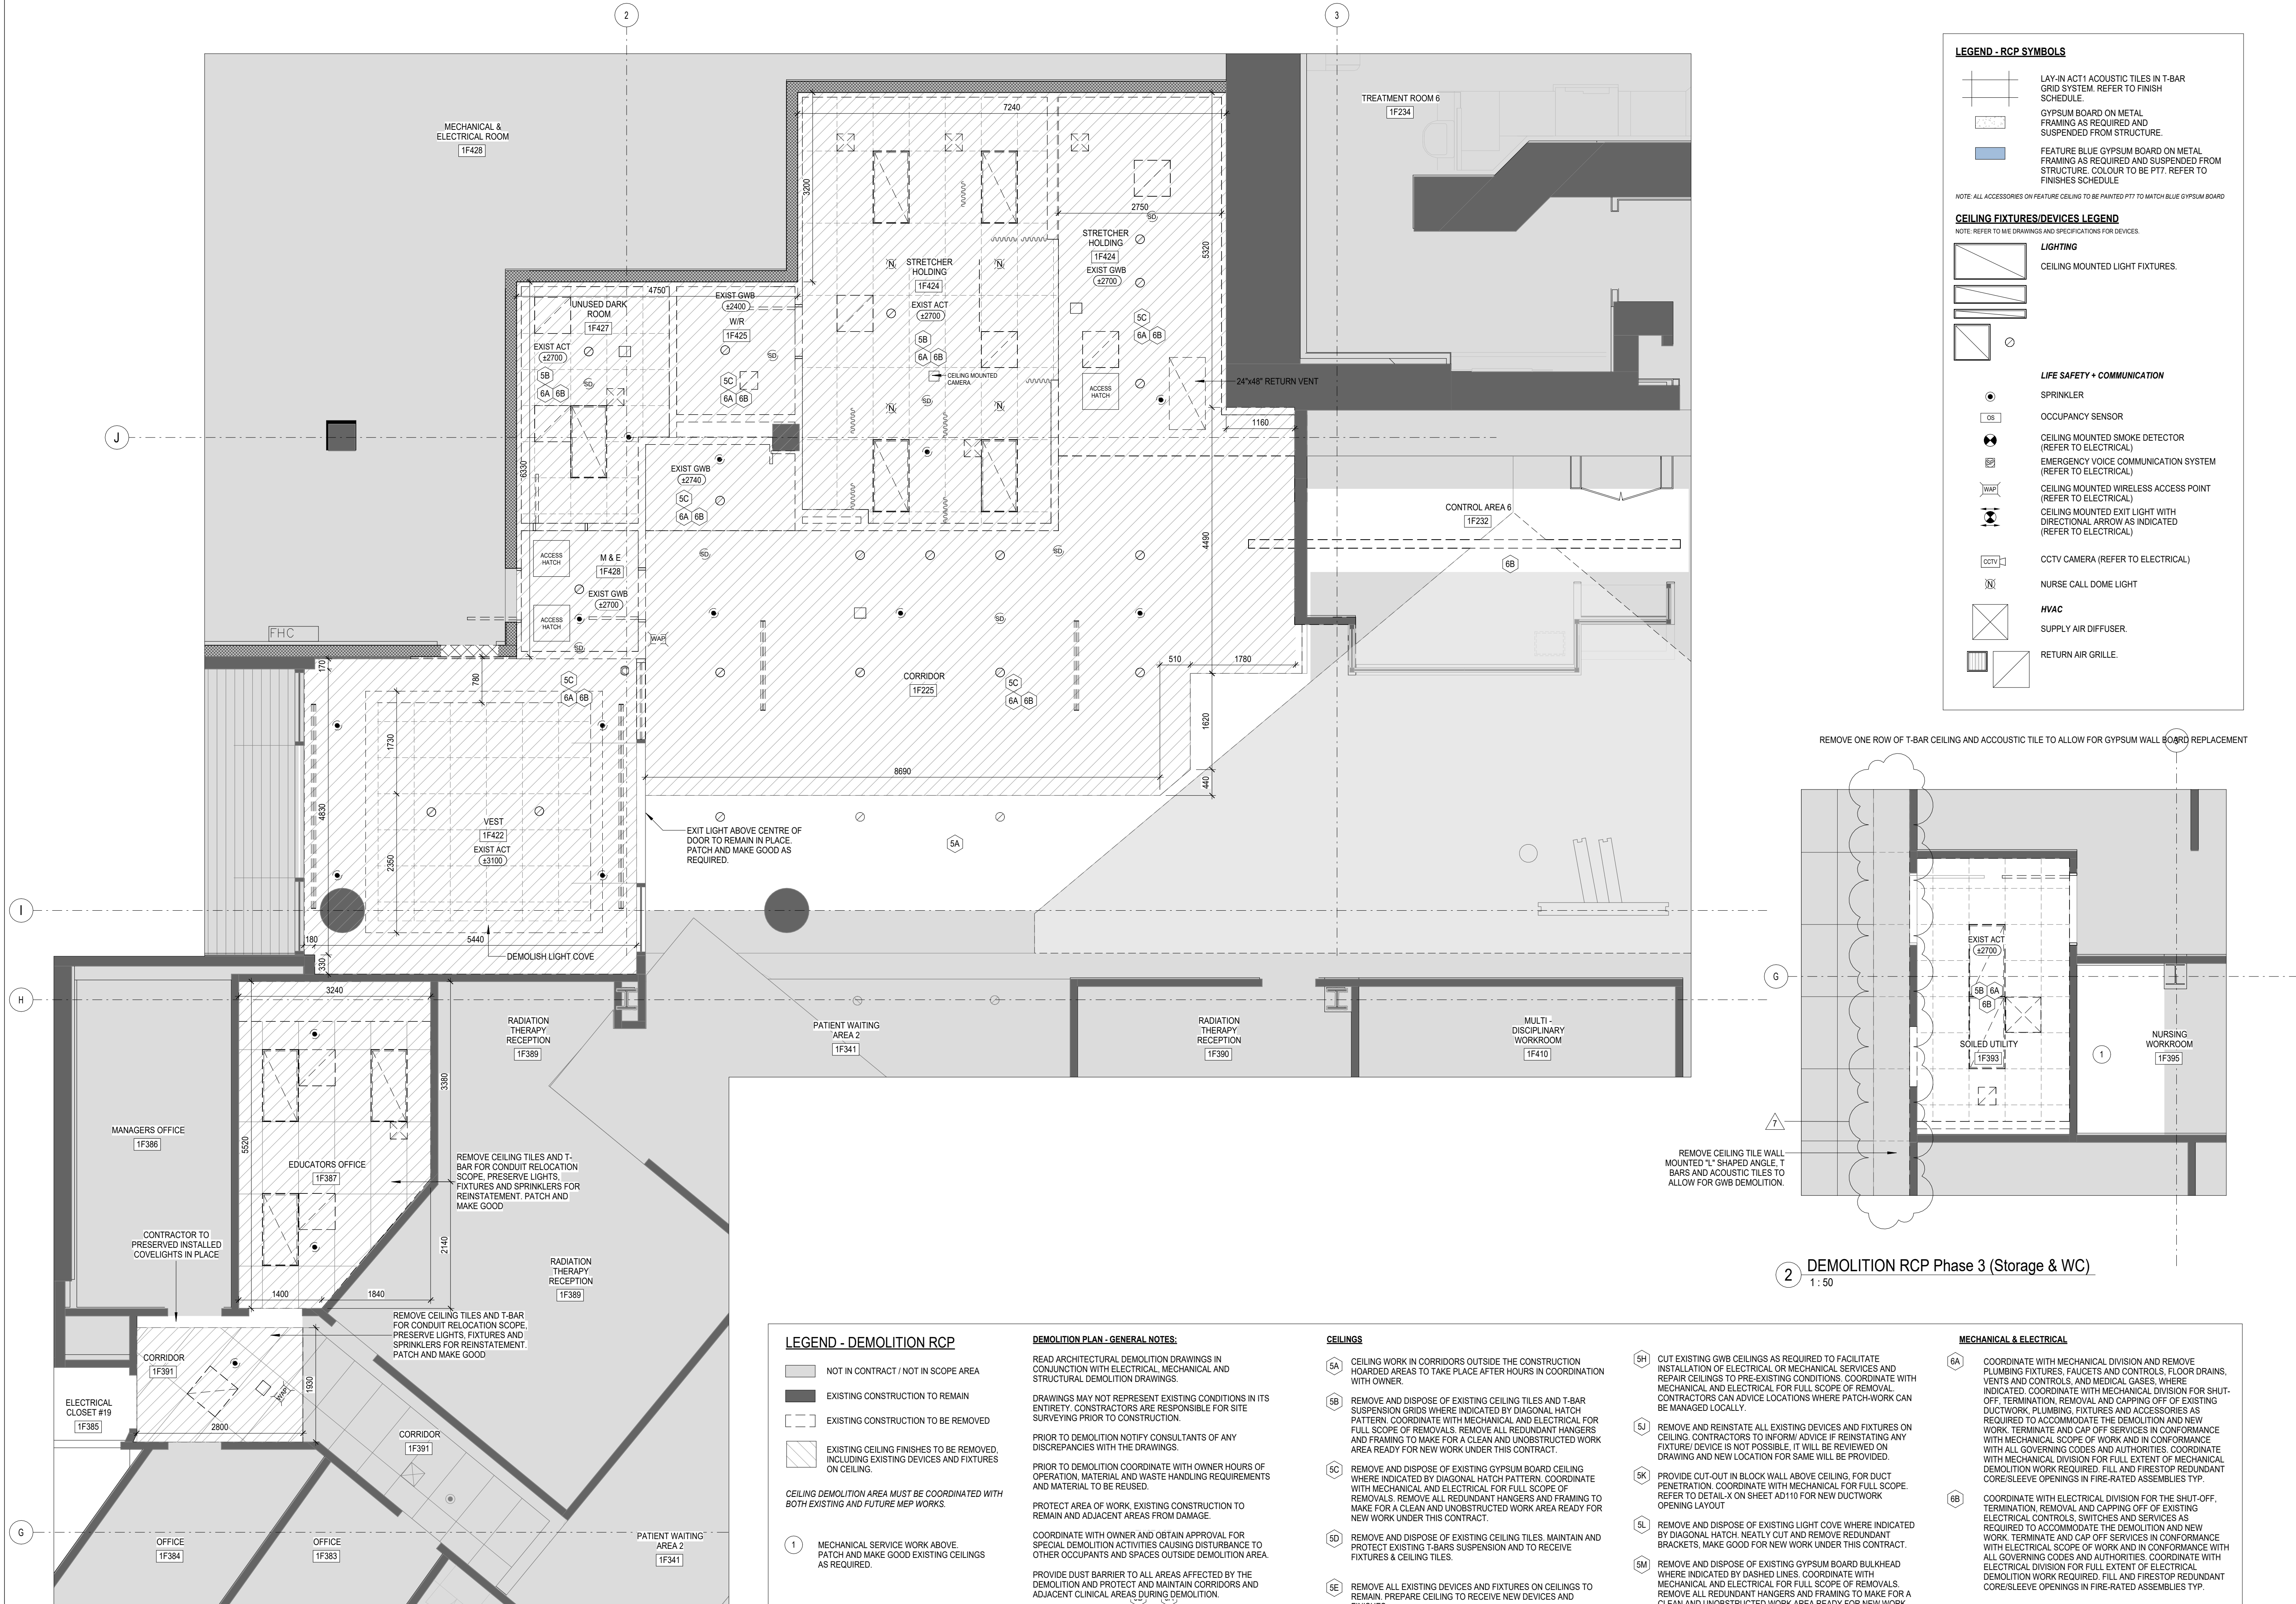

LEGEND - RCP SYMBOLS

LAY-IN ACT1 ACOUSTIC TILES IN T-BAR GRID SYSTEM. REFER TO FINISH SCHEDULE.

GYPSUM BOARD ON METAL FRAMING AS REQUIRED AND SUSPENDED FROM STRUCTURE.

FEATURE BLUE GYPSUM BOARD ON METAL FRAMING AS REQUIRED AND SUSPENDED FROM STRUCTURE. COLOUR TO BE P77. REFER TO FINISHES SCHEDULE

NOTE: ALL ACCESSORIES ON FEATURE CEILING TO BE PAINTED P77 TO MATCH BLUE GYPSUM BOARD

CEILING FIXTURES/DEVICES LEGEND

NOTE: REFER TO ME DRAWINGS AND SPECIFICATIONS FOR DEVICES.

LIGHTING

CEILING MOUNTED LIGHT FIXTURES.

LIFE SAFETY + COMMUNICATION

SPRINKLER

OCCUPANCY SENSOR

CEILING MOUNTED SMOKE DETECTOR (REFER TO ELECTRICAL)

EMERGENCY VOICE COMMUNICATION SYSTEM (REFER TO ELECTRICAL)

CEILING MOUNTED WIRELESS ACCESS POINT (REFER TO ELECTRICAL)

CEILING MOUNTED EXIT LIGHT WITH DIRECTIONAL ARROW AS INDICATED (REFER TO ELECTRICAL)

CCTV CAMERA (REFER TO ELECTRICAL)


NURSE CALL DOME LIGHT

HVAC

SUPPLY AIR DIFFUSER.

RETURN AIR GRILLE.

REMOVE ONE ROW OF T-BAR CEILING AND ACOUSTIC TILE TO ALLOW FOR GYPSUM WALL BOARD REPLACEMENT

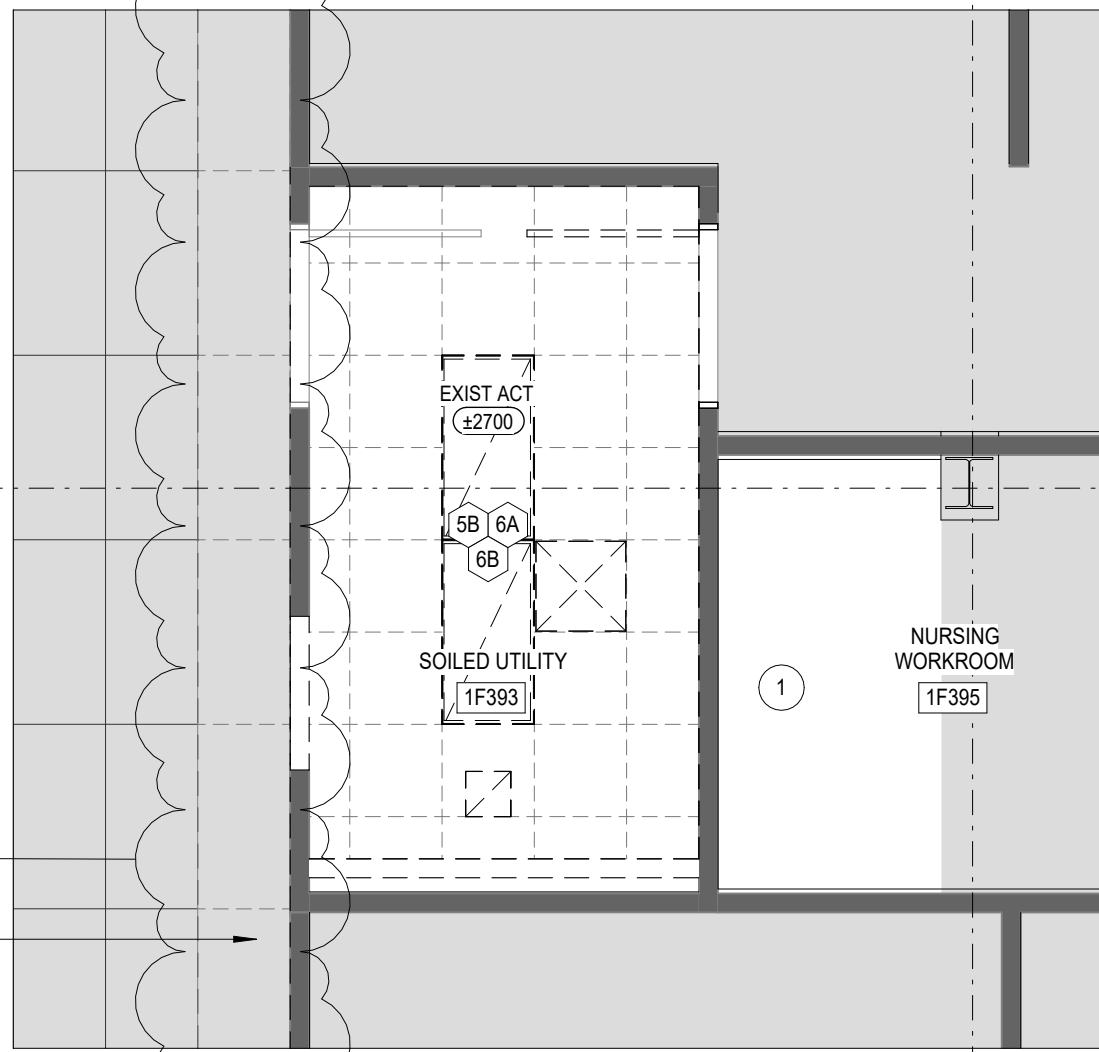

2 DEMOLITION RCP Phase 3 (Storage & WC) 1:50

LEGEND - DEMOLITION RCP

- NOT IN CONTRACT / NOT IN SCOPE AREA
- EXISTING CONSTRUCTION TO REMAIN
- EXISTING CONSTRUCTION TO BE REMOVED
- EXISTING CEILING FINISHES TO BE REMOVED, INCLUDING EXISTING DEVICES AND FIXTURES ON CEILING.

CEILING DEMOLITION AREA MUST BE COORDINATED WITH BOTH EXISTING AND FUTURE MEP WORKS.

- MECHANICAL SERVICE WORK ABOVE. PATCH AND MAKE GOOD EXISTING CEILINGS AS REQUIRED.

DEMOLITION PLAN - GENERAL NOTES:

READ ARCHITECTURAL DEMOLITION DRAWINGS IN CONJUNCTION WITH ELECTRICAL, MECHANICAL AND STRUCTURAL DEMOLITION DRAWINGS.

DRAWINGS MAY NOT REPRESENT EXISTING CONDITIONS IN ITS ENTIRETY. CONTRACTORS ARE RESPONSIBLE FOR SITE SURVEYING PRIOR TO CONSTRUCTION.

PRIOR TO DEMOLITION NOTIFY CONSULTANTS OF ANY DISCREPANCIES WITH THE DRAWINGS.

PRIOR TO DEMOLITION COORDINATE WITH OWNER HOURS OF OPERATION, MATERIAL AND WASTE HANDLING REQUIREMENTS AND MATERIAL TO BE REUSED.

PROTECT AREA OF WORK, EXISTING CONSTRUCTION TO REMAIN AND ADJACENT AREAS FROM DAMAGE.

COORDINATE WITH OWNER AND OBTAIN APPROVAL FOR SPECIAL DEMOLITION ACTIVITIES CAUSING DISTURBANCE TO OTHER OCCUPANTS AND SPACES OUTSIDE DEMOLITION AREA.

PROVIDE DUST BARRIER TO ALL AREAS AFFECTED BY THE DEMOLITION AND PROTECT AND MAINTAIN CORRIDORS AND ADJACENT CLINICAL AREAS DURING DEMOLITION.

REFER TO OWNER'S DESIGNATED SUBSTANCES REPORT FOR PRE-EXISTING DESIGNATED SUBSTANCES OBSERVED. NOTIFY CONSULTANT AND OWNER OF ANY DESIGNATED SUBSTANCES DISCOVERED DURING DEMOLITION.

CEILINGS

- CEILING WORK IN CORRIDORS OUTSIDE THE CONSTRUCTION HOARDED AREAS TO TAKE PLACE AFTER HOURS IN COORDINATION WITH OWNER.
- REMOVE AND DISPOSE OF EXISTING CEILING TILES AND T-BAR SUSPENSION GRIDS WHERE INDICATED BY DIAGONAL HATCH PATTERN. COORDINATE WITH MECHANICAL AND ELECTRICAL FOR FULL SCOPE OF REMOVALS. REMOVE ALL REDUNDANT HANGERS AND FRAMING TO MAKE FOR A CLEAN AND UNOBSTRUCTED WORK AREA READY FOR NEW WORK UNDER THIS CONTRACT.
- REMOVE AND DISPOSE OF EXISTING GYPSUM BOARD CEILING WHERE INDICATED BY DIAGONAL HATCH PATTERN. COORDINATE WITH MECHANICAL AND ELECTRICAL FOR FULL SCOPE OF REMOVALS. REMOVE ALL REDUNDANT HANGERS AND FRAMING TO MAKE FOR A CLEAN AND UNOBSTRUCTED WORK AREA READY FOR NEW WORK UNDER THIS CONTRACT.
- REMOVE AND DISPOSE OF EXISTING CEILING TILES. MAINTAIN AND PROTECT EXISTING T-BARS SUSPENSION AND TO RECEIVE FIXTURES & CEILING TILES.
- REMOVE ALL EXISTING DEVICES AND FIXTURES ON CEILINGS TO REMAIN. PREPARE CEILING TO RECEIVE NEW DEVICES AND FINISHES.
- REMOVE AND REINSTATE THE EXISTING CEILING TILES AND T-BAR SUSPENSION GRIDS. TO MAKE FOR AN UNOBSTRUCTED WORK AREA. COORDINATE WITH MECHANICAL AND ELECTRICAL FOR FULL SCOPE OF REMOVALS.

- CUT EXISTING GWB CEILINGS AS REQUIRED TO FACILITATE INSTALLATION OF ELECTRICAL OR MECHANICAL SERVICES AND REPAIR CEILINGS TO PRE-EXISTING CONDITIONS. COORDINATE WITH MECHANICAL AND ELECTRICAL FOR FULL SCOPE OF REMOVAL. CONTRACTORS CAN ADVISE LOCATIONS WHERE PATCH-WORK CAN BE MANAGED LOCALLY.
- REMOVE AND REINSTATE ALL EXISTING DEVICES AND FIXTURES ON CEILING. CONTRACTORS TO INFORM/ADVISE IF REINSTATING ANY FIXTURE/DEVICE IS NOT POSSIBLE. IT WILL BE REVIEWED ON DRAWING AND NEW LOCATION FOR SAME WILL BE PROVIDED.
- PROVIDE CUT-OUT IN BLOCK WALL ABOVE CEILING, FOR DUCT PENETRATION. COORDINATE WITH MECHANICAL FOR FULL SCOPE. REFER TO DETAIL-X ON SHEET AD110 FOR NEW DUCTWORK OPENING LAYOUT.
- REMOVE AND DISPOSE OF EXISTING LIGHT COVE WHERE INDICATED BY DIAGONAL HATCH. NEATLY CUT AND REMOVE REDUNDANT BRACKETS. MAKE GOOD FOR NEW WORK UNDER THIS CONTRACT.
- REMOVE AND DISPOSE OF EXISTING GYPSUM BOARD BULKHEAD WHERE INDICATED BY DASHED LINES. COORDINATE WITH MECHANICAL AND ELECTRICAL FOR FULL SCOPE OF REMOVALS. REMOVE ALL REDUNDANT HANGERS AND FRAMING TO MAKE FOR A CLEAN AND UNOBSTRUCTED WORK AREA READY FOR NEW WORK UNDER THIS CONTRACT.

MECHANICAL & ELECTRICAL

- COORDINATE WITH MECHANICAL DIVISION AND REMOVE PLUMBING FIXTURES, FAUCETS AND CONTROLS, FLOOR DRAINS, VENTS AND CONTROLS, AND MEDICAL GASES WHERE INDICATED. COORDINATE WITH MECHANICAL DIVISION FOR SHUT-OFF, TERMINATION, REMOVAL AND CAPPING OFF OF EXISTING DUCTWORK, PLUMBING, FIXTURES AND ACCESSORIES AS REQUIRED TO ACCOMMODATE THE DEMOLITION AND NEW WORK. TERMINATE AND CAP OFF SERVICES IN CONFORMANCE WITH MECHANICAL SCOPE OF WORK AND IN CONFORMANCE WITH ALL GOVERNING CODES AND AUTHORITIES. COORDINATE WITH MECHANICAL DIVISION FOR FULL EXTENT OF MECHANICAL DEMOLITION WORK REQUIRED. FILL AND FIRESTOP REDUNDANT CORE/SLEEVE OPENINGS IN FIRE-RATED ASSEMBLIES TYP.
- COORDINATE WITH ELECTRICAL DIVISION FOR THE SHUT-OFF, TERMINATION, REMOVAL AND CAPPING OFF OF EXISTING ELECTRICAL CONTROLS, SWITCHES AND SERVICES AS REQUIRED TO ACCOMMODATE THE DEMOLITION AND NEW WORK. TERMINATE AND CAP OFF SERVICES IN CONFORMANCE WITH ELECTRICAL SCOPE OF WORK AND IN CONFORMANCE WITH ALL GOVERNING CODES AND AUTHORITIES. COORDINATE WITH ELECTRICAL DIVISION FOR FULL EXTENT OF ELECTRICAL DEMOLITION WORK REQUIRED. FILL AND FIRESTOP REDUNDANT CORE/SLEEVE OPENINGS IN FIRE-RATED ASSEMBLIES TYP.

CLIENT:

Trillium Health Partners
2200 Eglinton Avenue West
Mississauga, ON, L5M 2N1
905 813 2200
thp.ca

CONSULTANT:


CUMULUS ARCHITECTS INC.
160 Pears Ave. - Suite 300
Toronto, ON M5R 3P8
416-539-0763
www.cumulusarch.com

SEAL:

This drawing, as an instrument of service, is the property of Cumulus Architects Inc. the copyright in the same being reserved to them. No reproduction is allowed without the permission of Cumulus Architects Inc. and when made must bear its name.

This drawing is not to be scaled. The contractor is to verify dimensions and data noted herein for conformity with the conditions on site and is responsible for reporting in writing any discrepancy to Cumulus Architects Inc. for adjustment.

Cumulus will not be liable for any claims or damages arising from the unauthorized use of this drawing or any portion thereof.

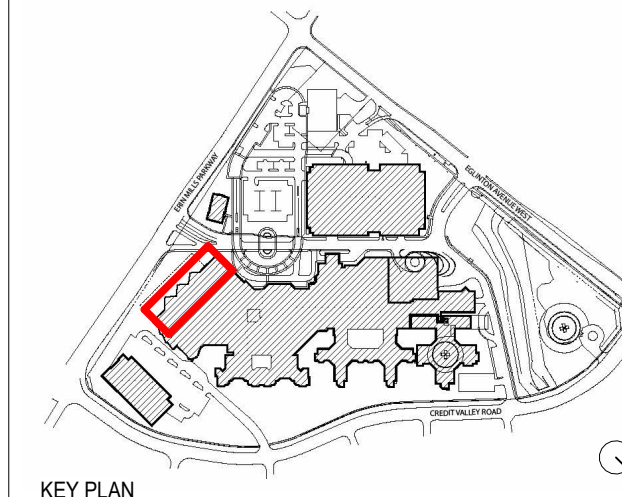

KEY PLAN

NO	DESCRIPTION	DATE
7	Issued for Addendum 1	2026/02/04
6	Issued for Tender	2025/12/16
5	Issued for Building Permit	2025/12/02
4	Issued For MOH 2.3 Resubmission	2025/06/20
2	Issued For MOH 2.3 Costing	2024/09/13

SHEET REVISION


PROJECT:
Oncology Radiation Treatment Expansion
2200 Eglinton Ave W,
Mississauga, ON L5M 2N1

TITLE:
**DEMOLITION RCP
PHASE 3**

PROJECT NO:
23010
CHECKED:
Checker

DRAWING NO:

A115

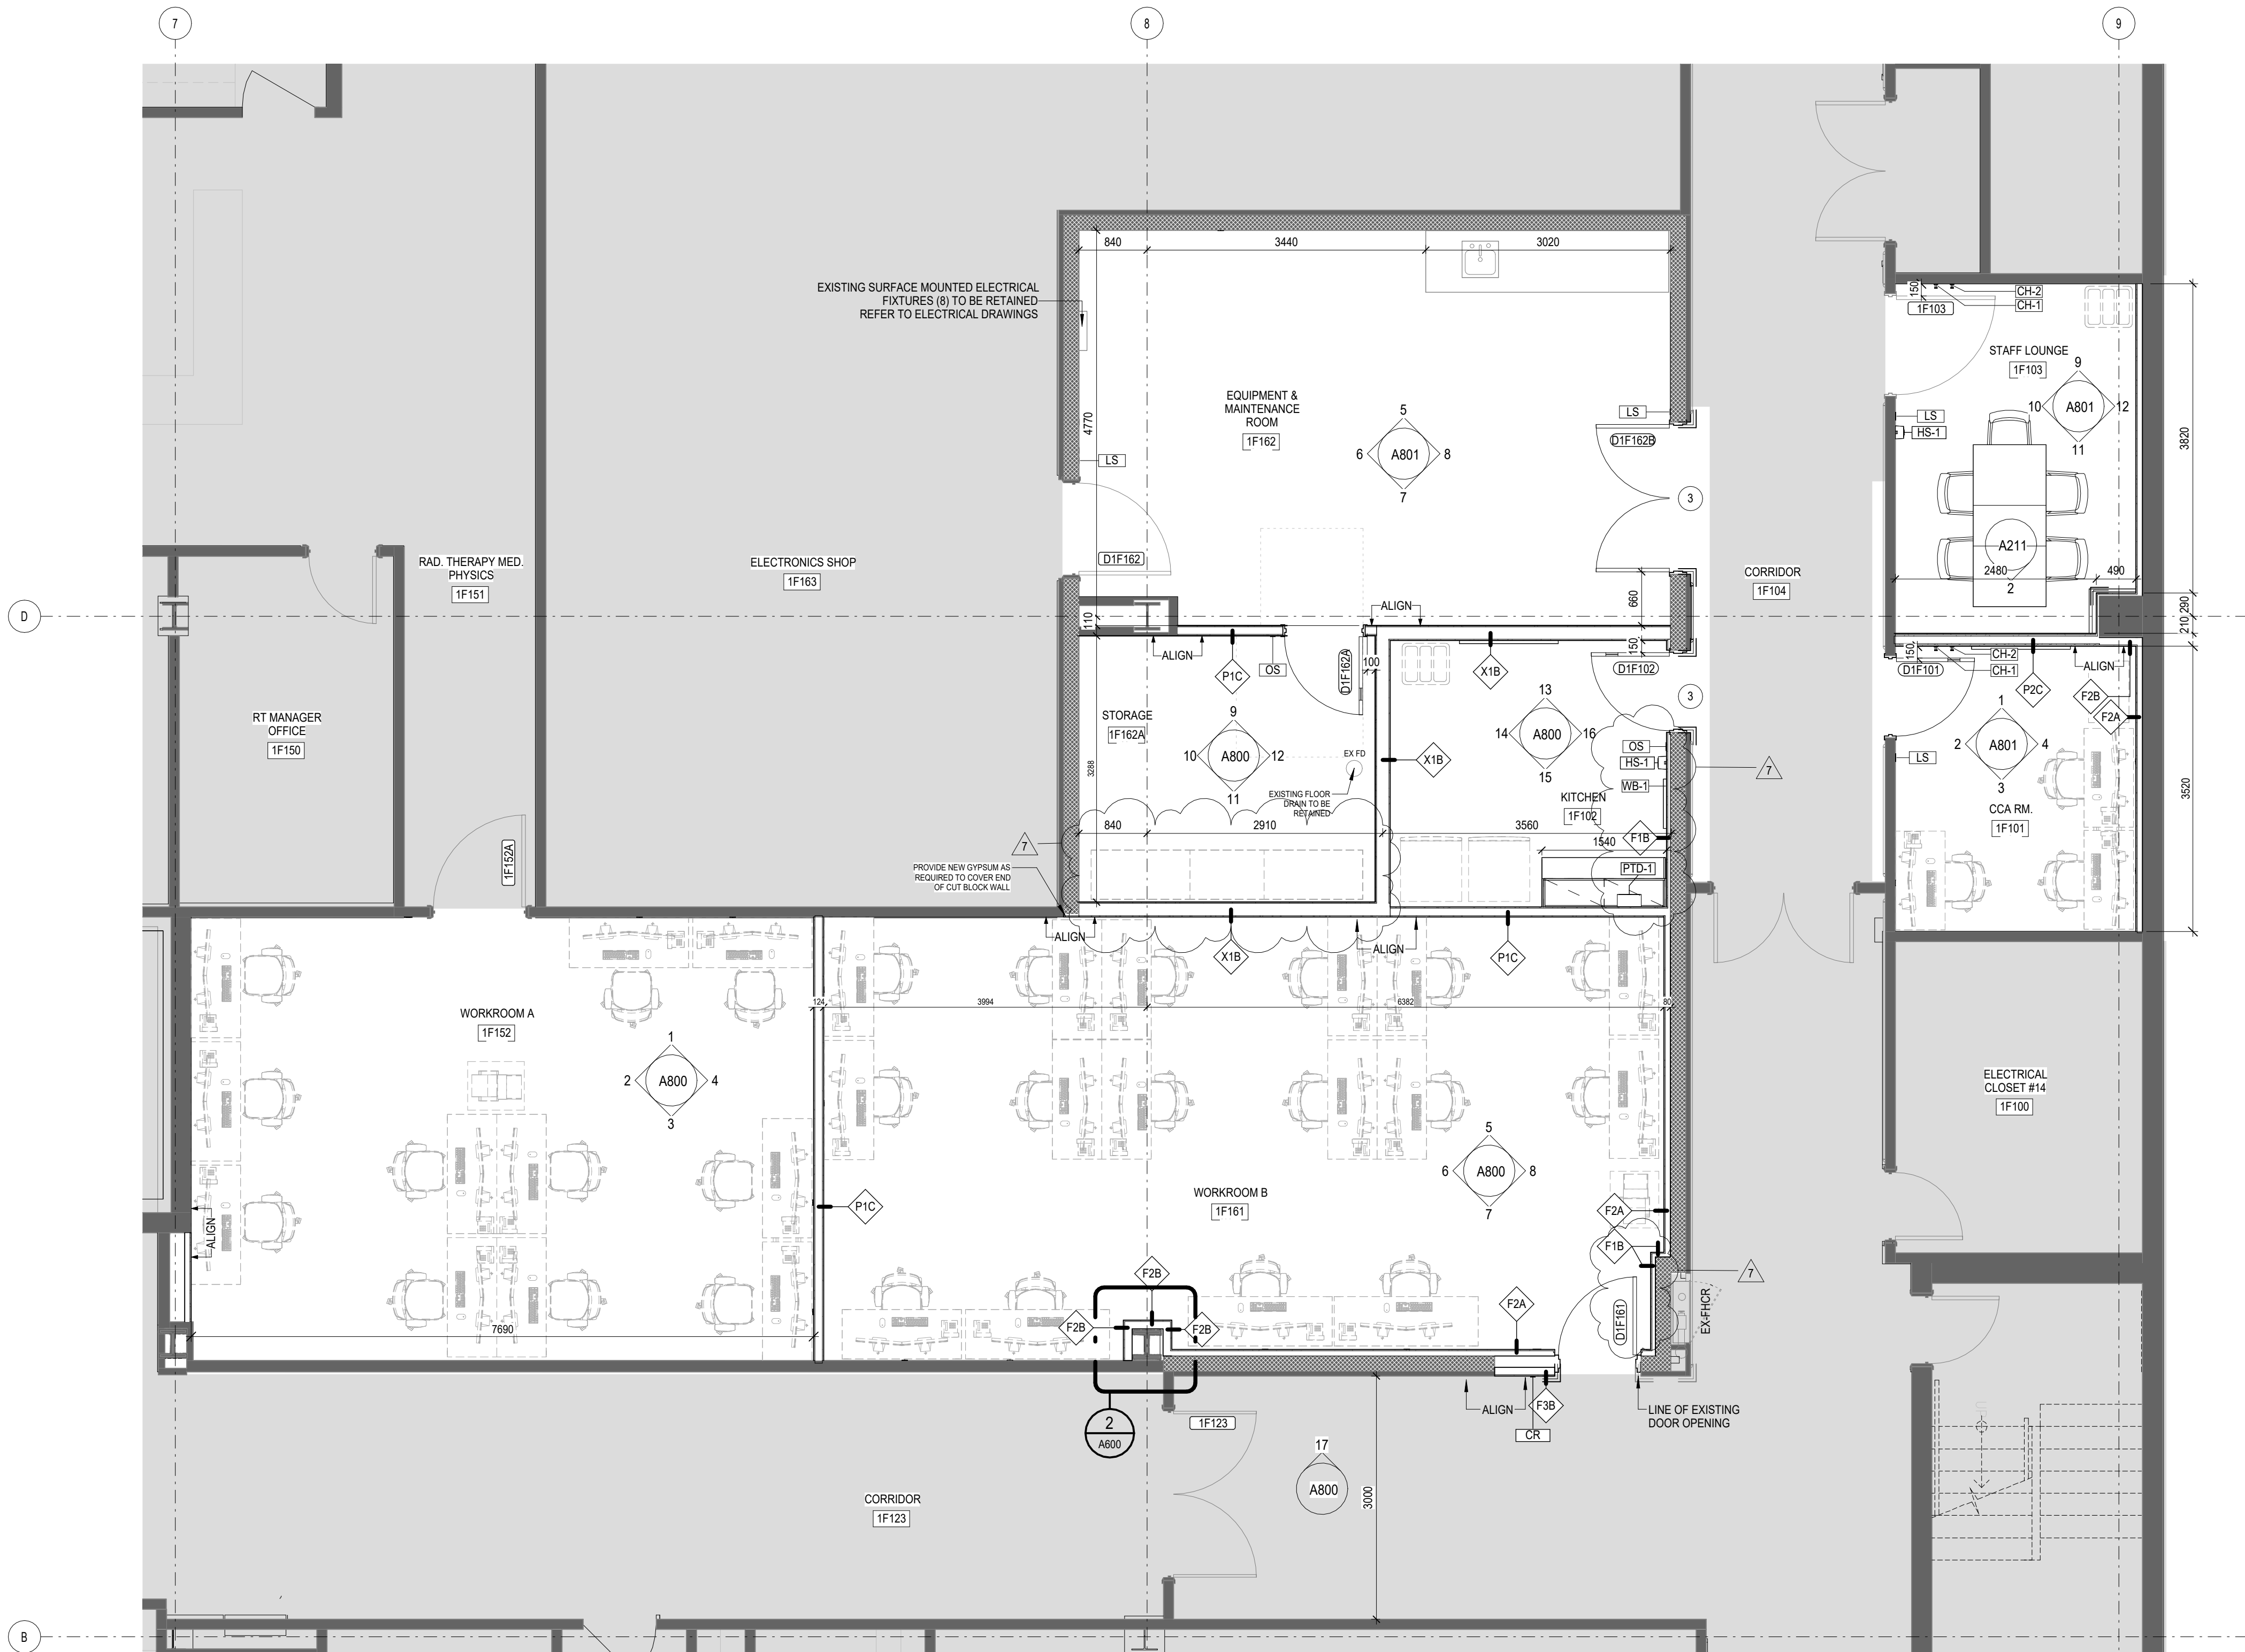

1 FLOOR PLAN - LEVEL 1 NORTH - Phase 1 (Workstations)
1:50

LEGEND - FLOOR PLAN

- NOT IN CONTRACT / NOT IN SCOPE AREA
- EXISTING CONSTRUCTION
- NEW CONSTRUCTION
- CONCRETE BLOCK SHIELDING. SEE SUB-TRADE SHOP DRAWINGS FOR CONSTRUCTION DETAILS.

GENERAL NOTES:

ARCHITECTURAL CONSTRUCTION PLANS INDICATE PARTITION LAYOUT, TYPES AND BUILT-IN FEATURES. IT IS THE RESPONSIBILITY OF THE CONTRACTOR TO ENSURE PROPER COORDINATION WITH DOORS, DEVICES, MILLWORK, FIXTURES, FINISHES, EQUIPMENT AND FURNITURE.

ALIGNMENTS ARE DIMENSIONED FROM FINISH FACE TO FINISH FACE, UNLESS OTHERWISE NOTED. ALLOW FOR THICKNESS OF FINISHES.

VERIFY DIMENSIONS NOTED AS "CLEAR", "HOLD", "MIN", "CRITICAL", OR "V.I.F." DURING LAYOUT OF WORK. NOTIFY ARCHITECT OF DISCREPANCIES OR CONFLICTS PRIOR TO EXECUTION OF WORK.

LAYOUT ALL PARTITION LOCATIONS ON THE STRUCTURAL SLAB FOR CONSULTANT REVIEW PRIOR TO CONSTRUCTION. ADVISE CONSULTANTS OF DISCREPANCIES WITH THE DIMENSIONED PLANS OR CONFLICTS WITH OTHER PARTS OF THE WORK. ADJUST LOCATIONS AS REQUIRED BASED ON REVIEW.

PARTITIONS ARE TO BE SECURED TO THE U/S OF STRUCTURE UNLESS OTHERWISE NOTED. REFER TO STRUCTURAL DRAWINGS FOR REINFORCING AND ANCHORING DETAILS FOR ALL MASONRY WALLS.

PATCH AND REPAIR EXISTING WALLS, FLOORS, COLUMNS AND SURFACES TO REMAIN AS REQUIRED TO LEAVE THEM SMOOTH, EVEN AND/OR LEVEL TO RECEIVE NEW FINISHES. STARTING OF WORK INDICATES INSTALLERS ACCEPTANCE OF SUBSTRATE.

PROVIDE SOLID FRT BLOCKING AS REQUIRED IN PARTITION WALLS TO SUPPORT SHELVING, HANGING ROOFS, MILLWORK, GRAB BARS, ACCESSORIES AND OTHER ITEMS THAT ARE PART OF THIS CONTRACT. REFER TO CONSULTANT PLANS AND SPECIFICATIONS TO COORDINATE LOCATION OF BLOCKING TO SUPPORT ALL WALL MOUNTED FURNISHINGS PROVIDED BY OTHERS.

EXPOSED EDGES OF GWB TO BE TRIMMED WITH D200 BEAD, AS REQUIRED OR AS OTHERWISE DETAILED TO MAKE A TRUE AND STRAIGHT EDGE.

PARTITIONS ARE TO BE FINISHED AS PER ROOM FINISH SCHEDULE AND SPECIFICATIONS.

CLIENT:

Trillium Health Partners
2200 Eglinton Avenue West
Mississauga, ON L5M 2N1
905 813 2200
thp.ca

CONSULTANT:


CUMULUS ARCHITECTS INC.
160 Pears Ave. - Suite 300
Toronto, ON M5R 3P8
416-539-0763
www.cumulusarch.com

SEAL:

This drawing, as an instrument of service, is the property of Cumulus Architects Inc. the copyright in the same being reserved to them. No reproduction is allowed without the permission of Cumulus Architects Inc. and when made must bear its name.

This drawing is not to be scaled. The contractor is to verify dimensions and data noted herein for conformity with the conditions on site and is responsible for reporting in writing any discrepancy to Cumulus Architects Inc. for adjustment.

Cumulus will not be liable for any claims or damages arising from the unauthorized use of this drawing or any portion thereof.

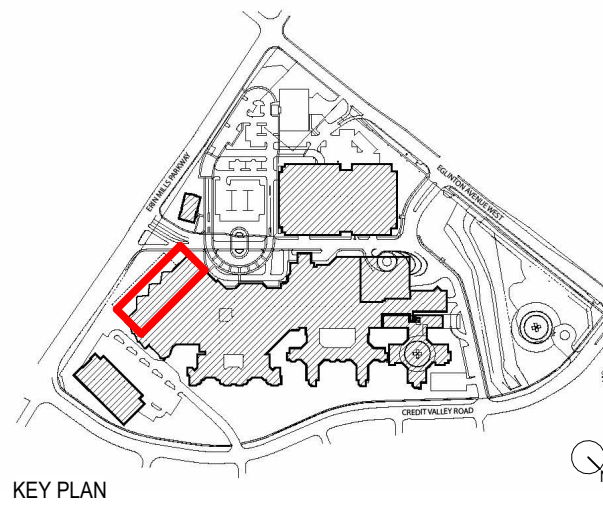

KEY PLAN

7	Issued for Addendum 1	2026/02/04
6	Issued for Tender	2025/12/16
5	Issued for Building Permit	2025/12/02
4	Issued For MOH 2.3 Resubmission	2025/06/20
2	Issued For MOH 2.3 Costing	2024/09/13
NO	DESCRIPTION	DATE

SHEET REVISION


PROJECT:
Oncology Radiation Treatment Expansion
2200 Eglinton Ave W,
Mississauga, ON L5M 2N1

TITLE:
FLOOR PLANS
PHASE 1

PROJECT NO:
23010
CHECKED:
Checker

DRAWING NO:

A201

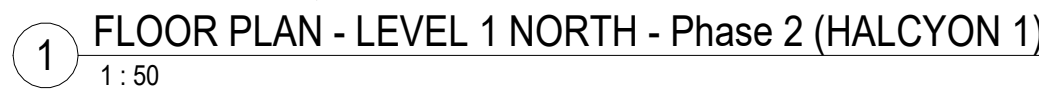


DRAWING NO: A203


SEAL:

This drawing, as an instrument of service, is the property of Cumulus Architects Inc., the copyright in the same being reserved to them. No reproduction is allowed without the permission of Cumulus Architects Inc. and when made must bear its name.


This drawing is not to be scaled. The contractor is to verify dimensions and data noted herein for conformity with the conditions on site and is responsible for reporting in writing any discrepancy to Cumulus Architects Inc. for adjustment.

Cumulus will not be liable for any claims or damages arising from the unauthorized use of this drawing or any portion thereof.

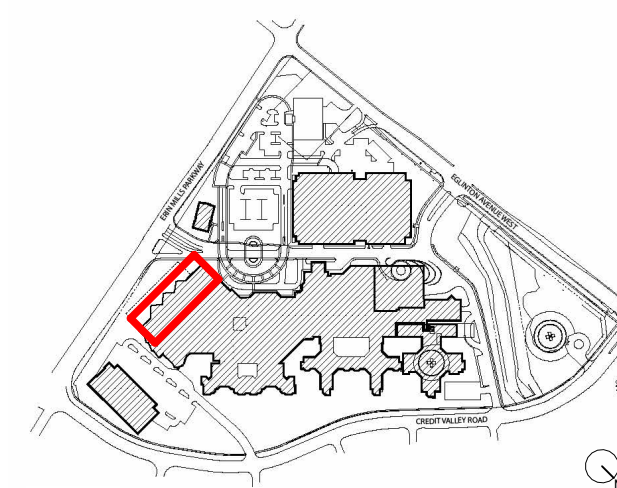

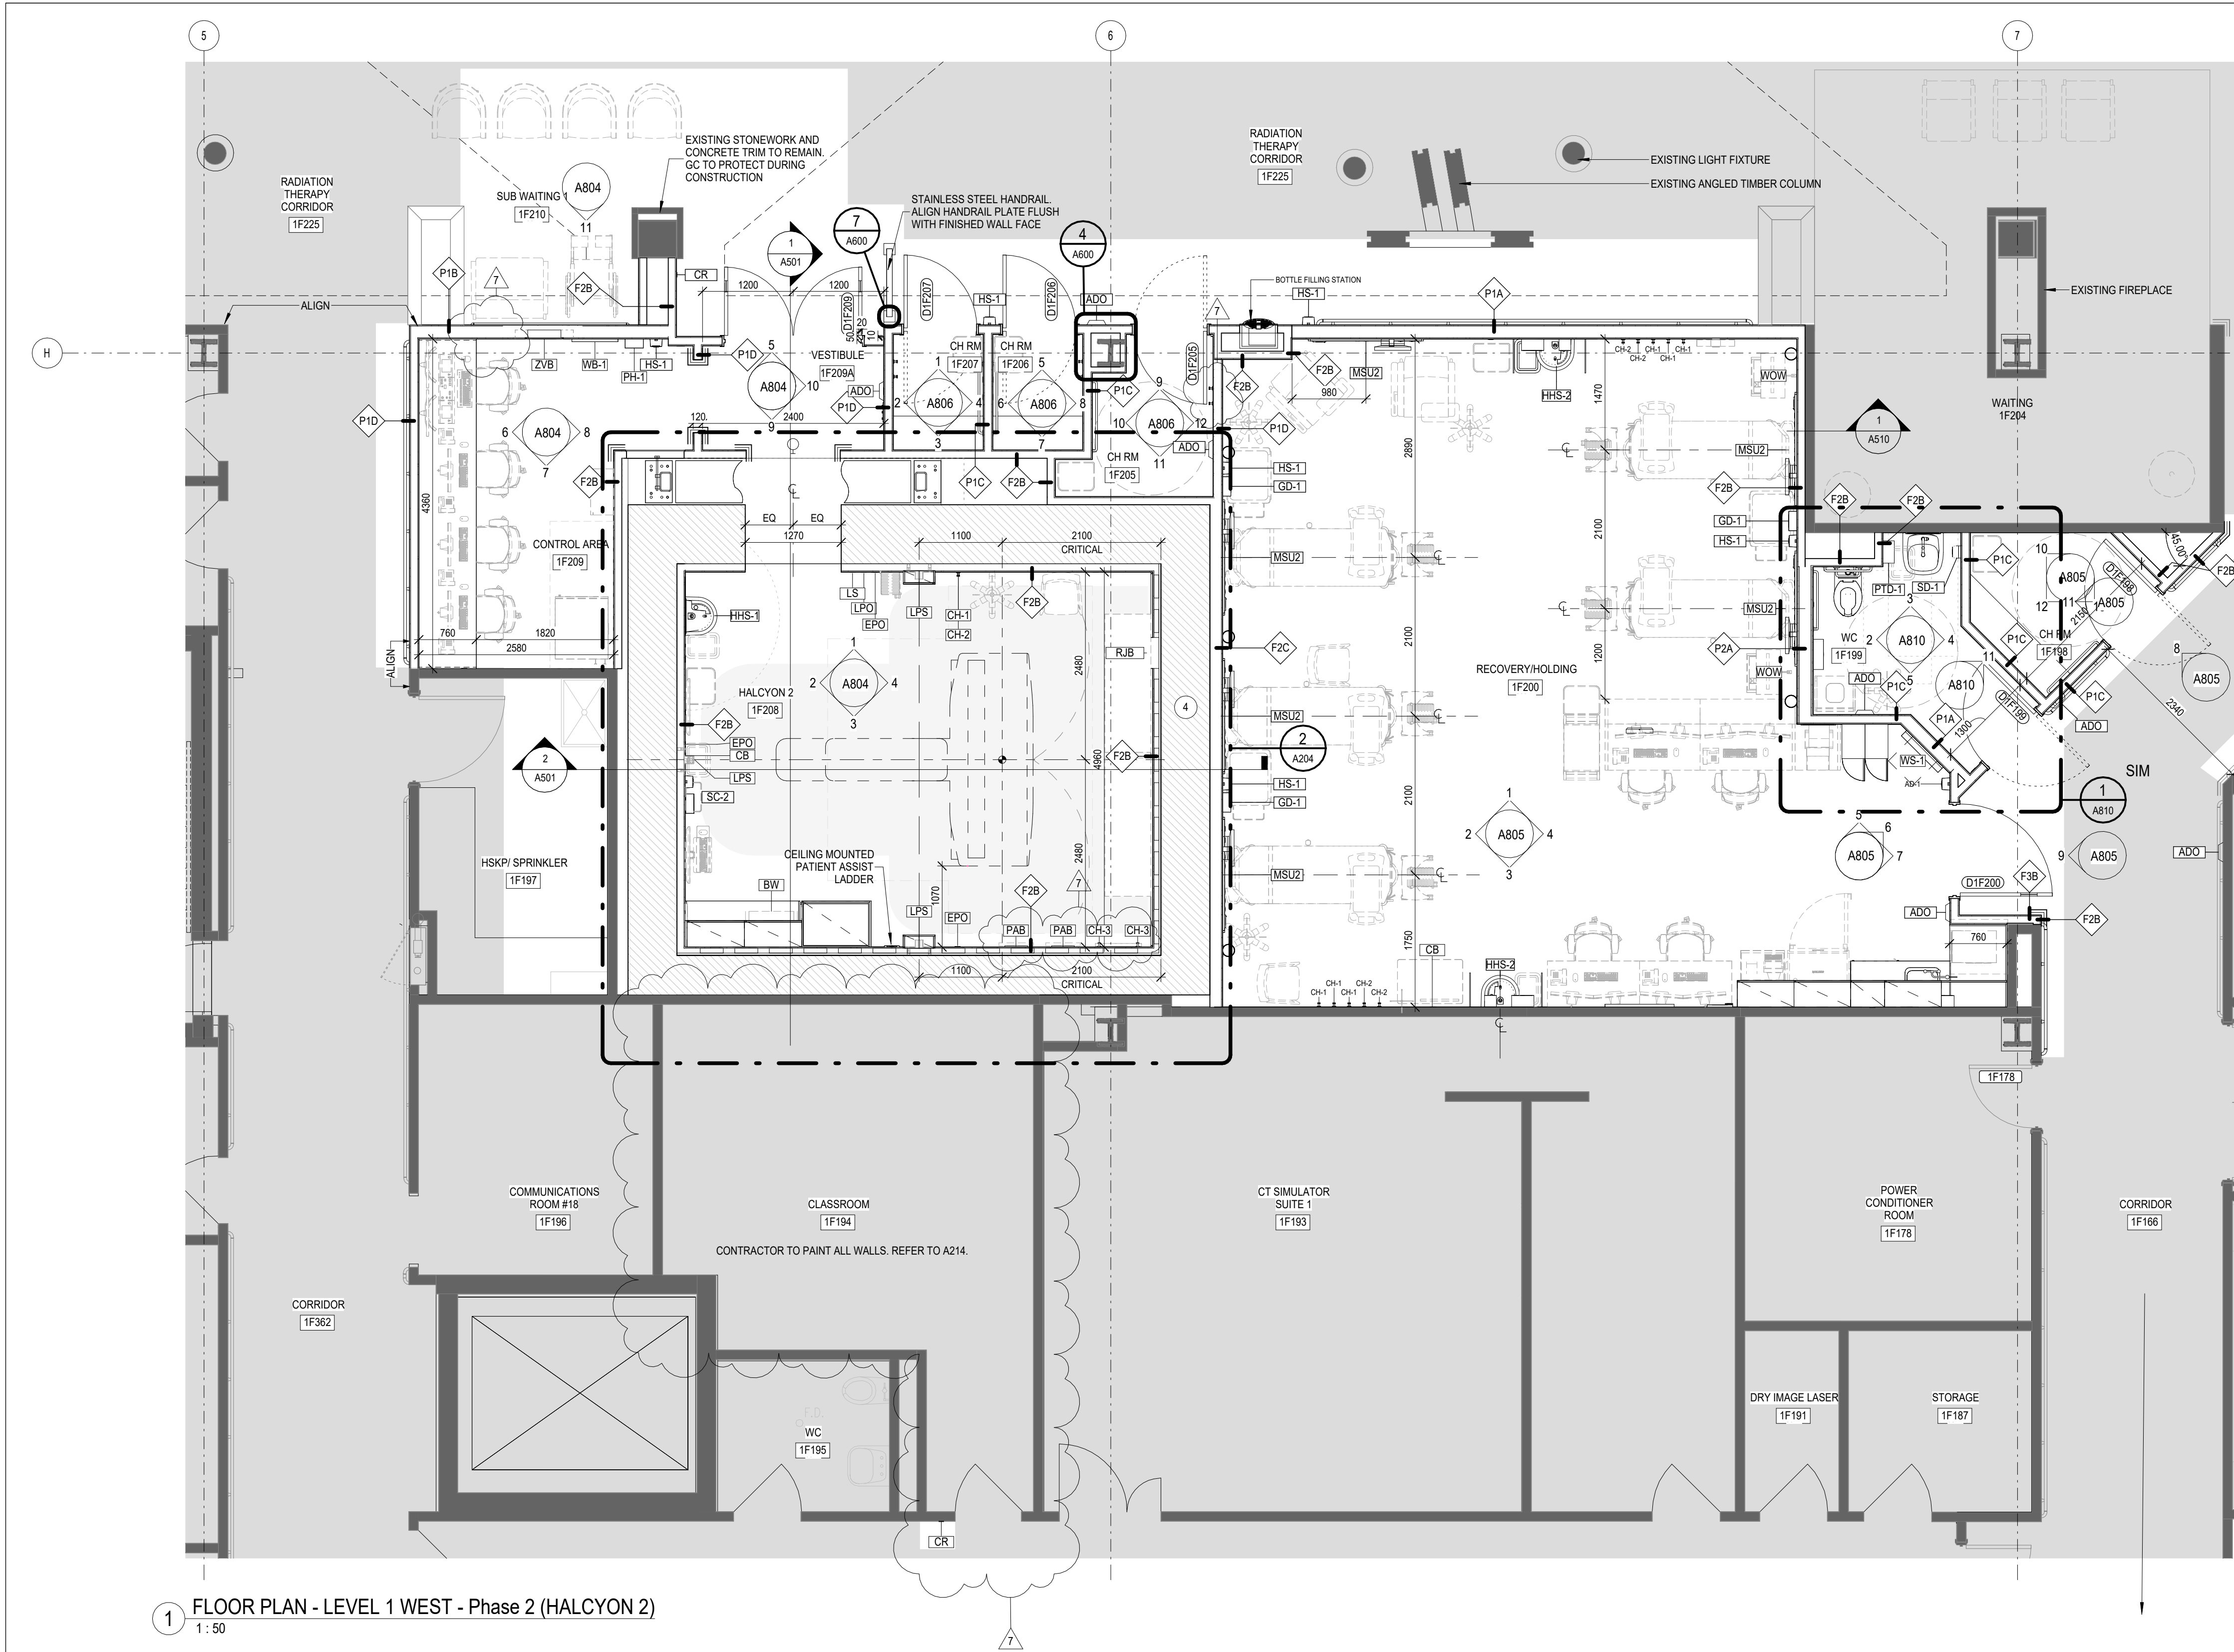

1 FLOOR PLAN - LEVEL 1 WEST - Phase 2 (HALCYON 2)
1 : 50

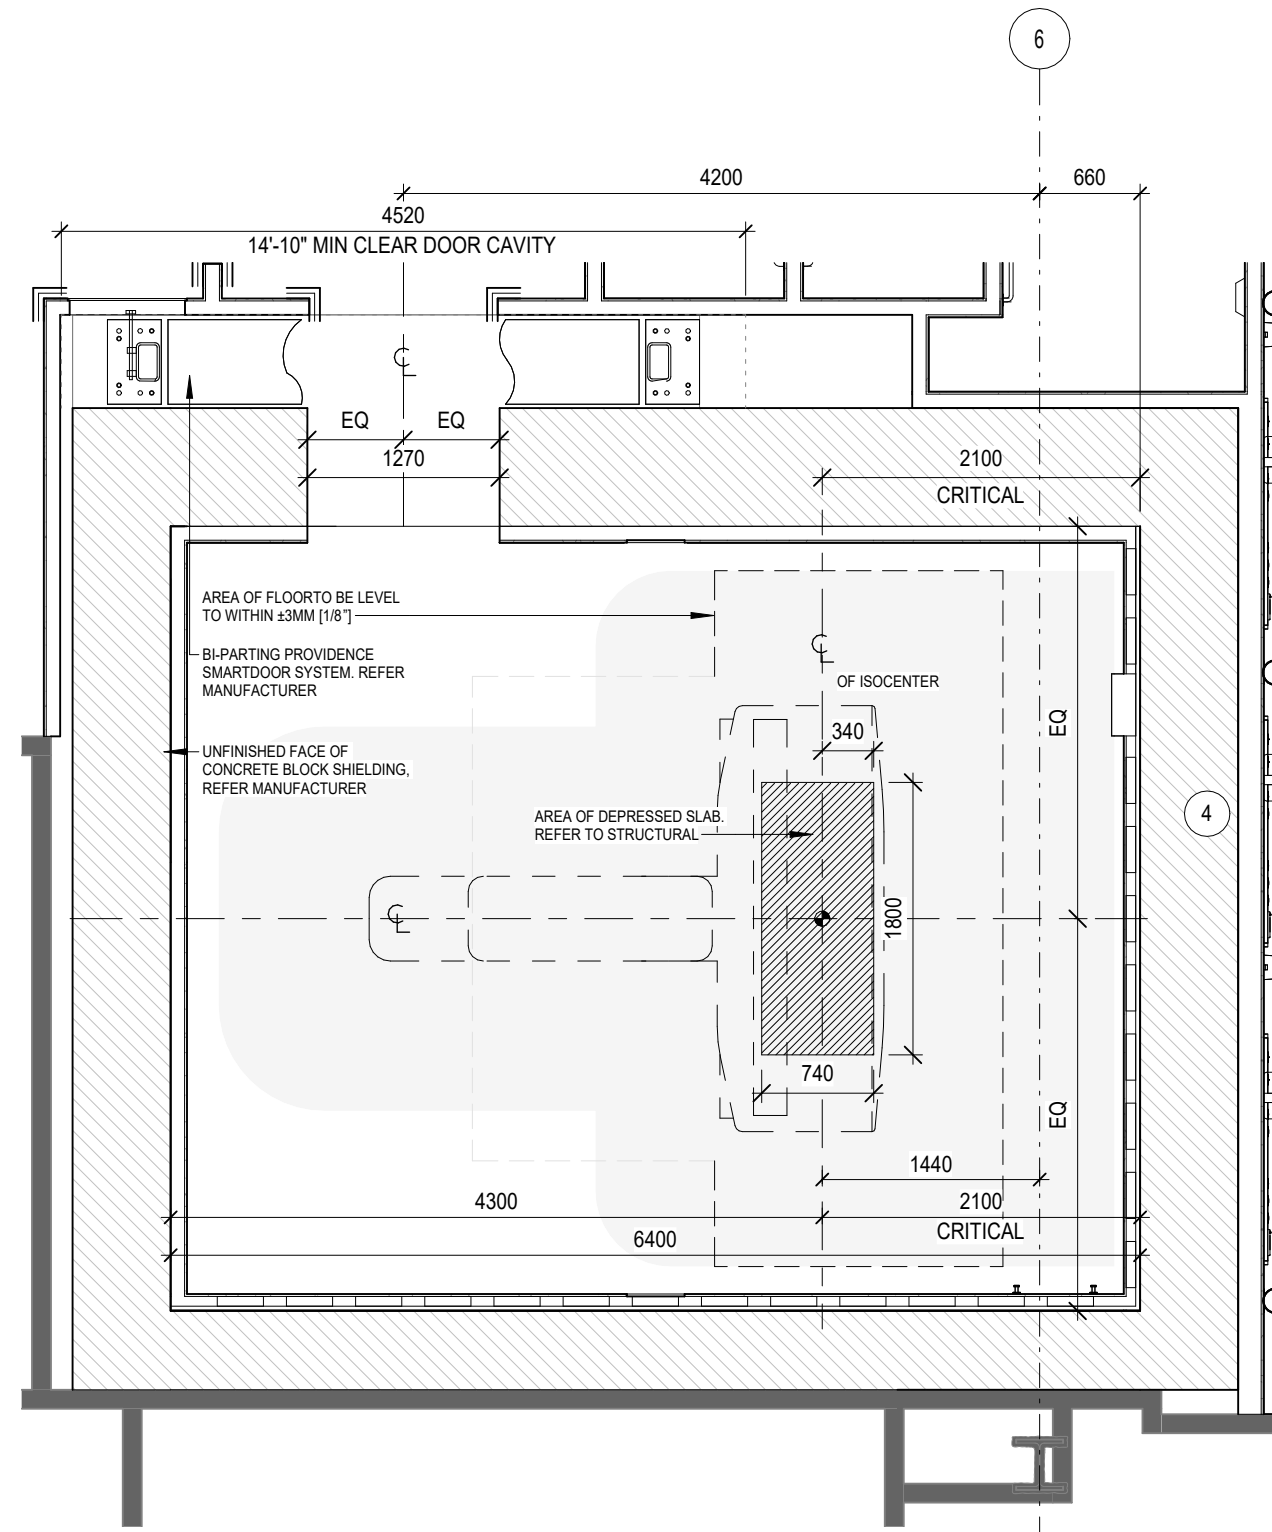

2 HALCYON 2 - SHIELDING LAYOUT & PIT DIAGRAM
1 : 50

LEGEND - FLOOR PLAN

- NOT IN CONTRACT / NOT IN SCOPE AREA
- EXISTING CONSTRUCTION
- NEW CONSTRUCTION
- CONCRETE BLOCK SHIELDING. SEE SUB-TRADE SHOP DRAWINGS FOR CONSTRUCTION DETAILS.

GENERAL NOTES:

ARCHITECTURAL CONSTRUCTION PLANS INDICATE PARTITION LAYOUT, TYPES AND BUILT-IN FEATURES. IT IS THE RESPONSIBILITY OF THE CONTRACTOR TO ENSURE PROPER COORDINATION WITH DOORS, DEVICES, MILLWORK, FIXTURES, FINISHES, EQUIPMENT AND FURNITURE.

ALIGNMENTS ARE DIMENSIONED FROM FINISH FACE TO FINISH FACE, UNLESS OTHERWISE NOTED. ALLOW FOR THICKNESS OF FINISHES.

VERIFY DIMENSIONS NOTED AS "CLEAR", "HOLD", "MIN", "CRITICAL", OR "V.I.F." DURING LAYOUT OF WORK. NOTIFY ARCHITECT OF DISCREPANCIES OR CONFLICTS PRIOR TO EXECUTION OF WORK.

LAYOUT ALL PARTITION LOCATIONS ON THE STRUCTURAL SLAB FOR CONSULTANT REVIEW PRIOR TO CONSTRUCTION. ADVISE CONSULTANTS OF DISCREPANCIES WITH THE DIMENSIONED PLANS OR CONFLICTS WITH OTHER PARTS OF THE WORK. ADJUST LOCATIONS AS REQUIRED BASED ON REVIEW.

PARTITIONS ARE TO BE SECURED TO THE U/S OF STRUCTURE UNLESS OTHERWISE NOTED. REFER TO STRUCTURAL DRAWINGS FOR REINFORCING AND ANCHORING DETAILS FOR ALL MASONRY WALLS.

PATCH AND REPAIR EXISTING WALLS, FLOORS, COLUMNS AND SURFACES TO REMAIN AS REQUIRED TO LEAVE THEM SMOOTH, EVEN AND/OR LEVEL TO RECEIVE NEW FINISHES. STARTING OF WORK INDICATES INSTALLERS ACCEPTANCE OF SUBSTRATE.

PROVIDE SOLID FRT BLOCKING AS REQUIRED IN PARTITION WALLS TO SUPPORT SHELVING, HANGING ROOFS, MILLWORK, GRAB BARS, ACCESSORIES AND OTHER ITEMS THAT ARE PART OF THIS CONTRACT. REFER TO CONSULTANT PLANS AND SPECIFICATIONS TO COORDINATE LOCATION OF BLOCKING TO SUPPORT ALL WALL MOUNTED FURNISHINGS PROVIDED BY OTHERS.

EXPOSED EDGES OF GWB TO BE TRIMMED WITH D2000 BEAD, AS REQUIRED OR AS OTHERWISE DETAILED TO MAKE A TRUE AND STRAIGHT EDGE.

PARTITIONS ARE TO BE FINISHED AS PER ROOM FINISH SCHEDULE AND SPECIFICATIONS.

- PATCH AND MAKE GOOD EXISTING WALL BUMPER AND ACROBYN WALL PROTECTION WHERE NEW DOORS ARE ADDED.
- PATCH AND MAKE GOOD EXISTING HANDRAIL WHERE NEW DOORS ARE ADDED.
- PROVIDE MASONRY OR STEEL LINTEL ABOVE NEW DOOR OPENING TO SUPPORT EXISTING CONCRETE BLOCK ABOVE. REFER TO STRUCTURAL FOR TYPICAL SIZING AND SUPPORT.
- HALCYON SHIELDING WAS BASED ON VERITAS DRAWINGS DATED JUNE 10, 2024. IF CHANGES TO VERITAS SHIELDING ARE REQUIRED, ARCHITECTS TO BE ADVISED PRIOR TO IMPLEMENTATION ON SITE.

CLIENT:

Trillium Health Partners
2200 Eglinton Avenue West
Mississauga, ON L5M 2N1
905 813 2200
thp.ca

CONSULTANT:


CUMULUS ARCHITECTS INC.
160 Pears Ave. - Suite 300
Toronto, ON M5R 3P8
416-539-0763
www.cumulusarch.com

SEAL:

This drawing, as an instrument of service, is the property of Cumulus Architects Inc. the copyright in the same being reserved to them. No reproduction is allowed without the permission of Cumulus Architects Inc. and when made must bear its name.

This drawing is not to be scaled. The contractor is to verify dimensions and data noted herein for conformity with the conditions on site and is responsible for reporting in writing any discrepancy to Cumulus Architects Inc. for adjustment.

Cumulus will not be liable for any claims or damages arising from the unauthorized use of this drawing or any portion thereof.

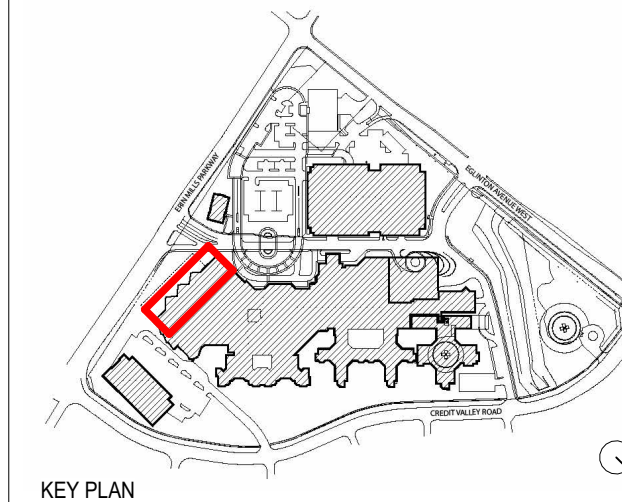

KEY PLAN

7	Issued for Addendum 1	2026/02/04
6	Issued for Tender	2025/12/16
5	Issued for Building Permit	2025/12/02
4	Issued For MOH 2.3 Resubmission	2025/06/20
2	Issued For MOH 2.3 Costing	2024/09/13
NO	DESCRIPTION	DATE

SHEET REVISION


PROJECT:
Oncology Radiation Treatment Expansion
2200 Eglinton Ave W,
Mississauga, ON L5M 2N1

TITLE:
FLOOR PLANS
PHASE 2


PROJECT NO:
23010
CHECKED:
Checker

DRAWING NO:


A204

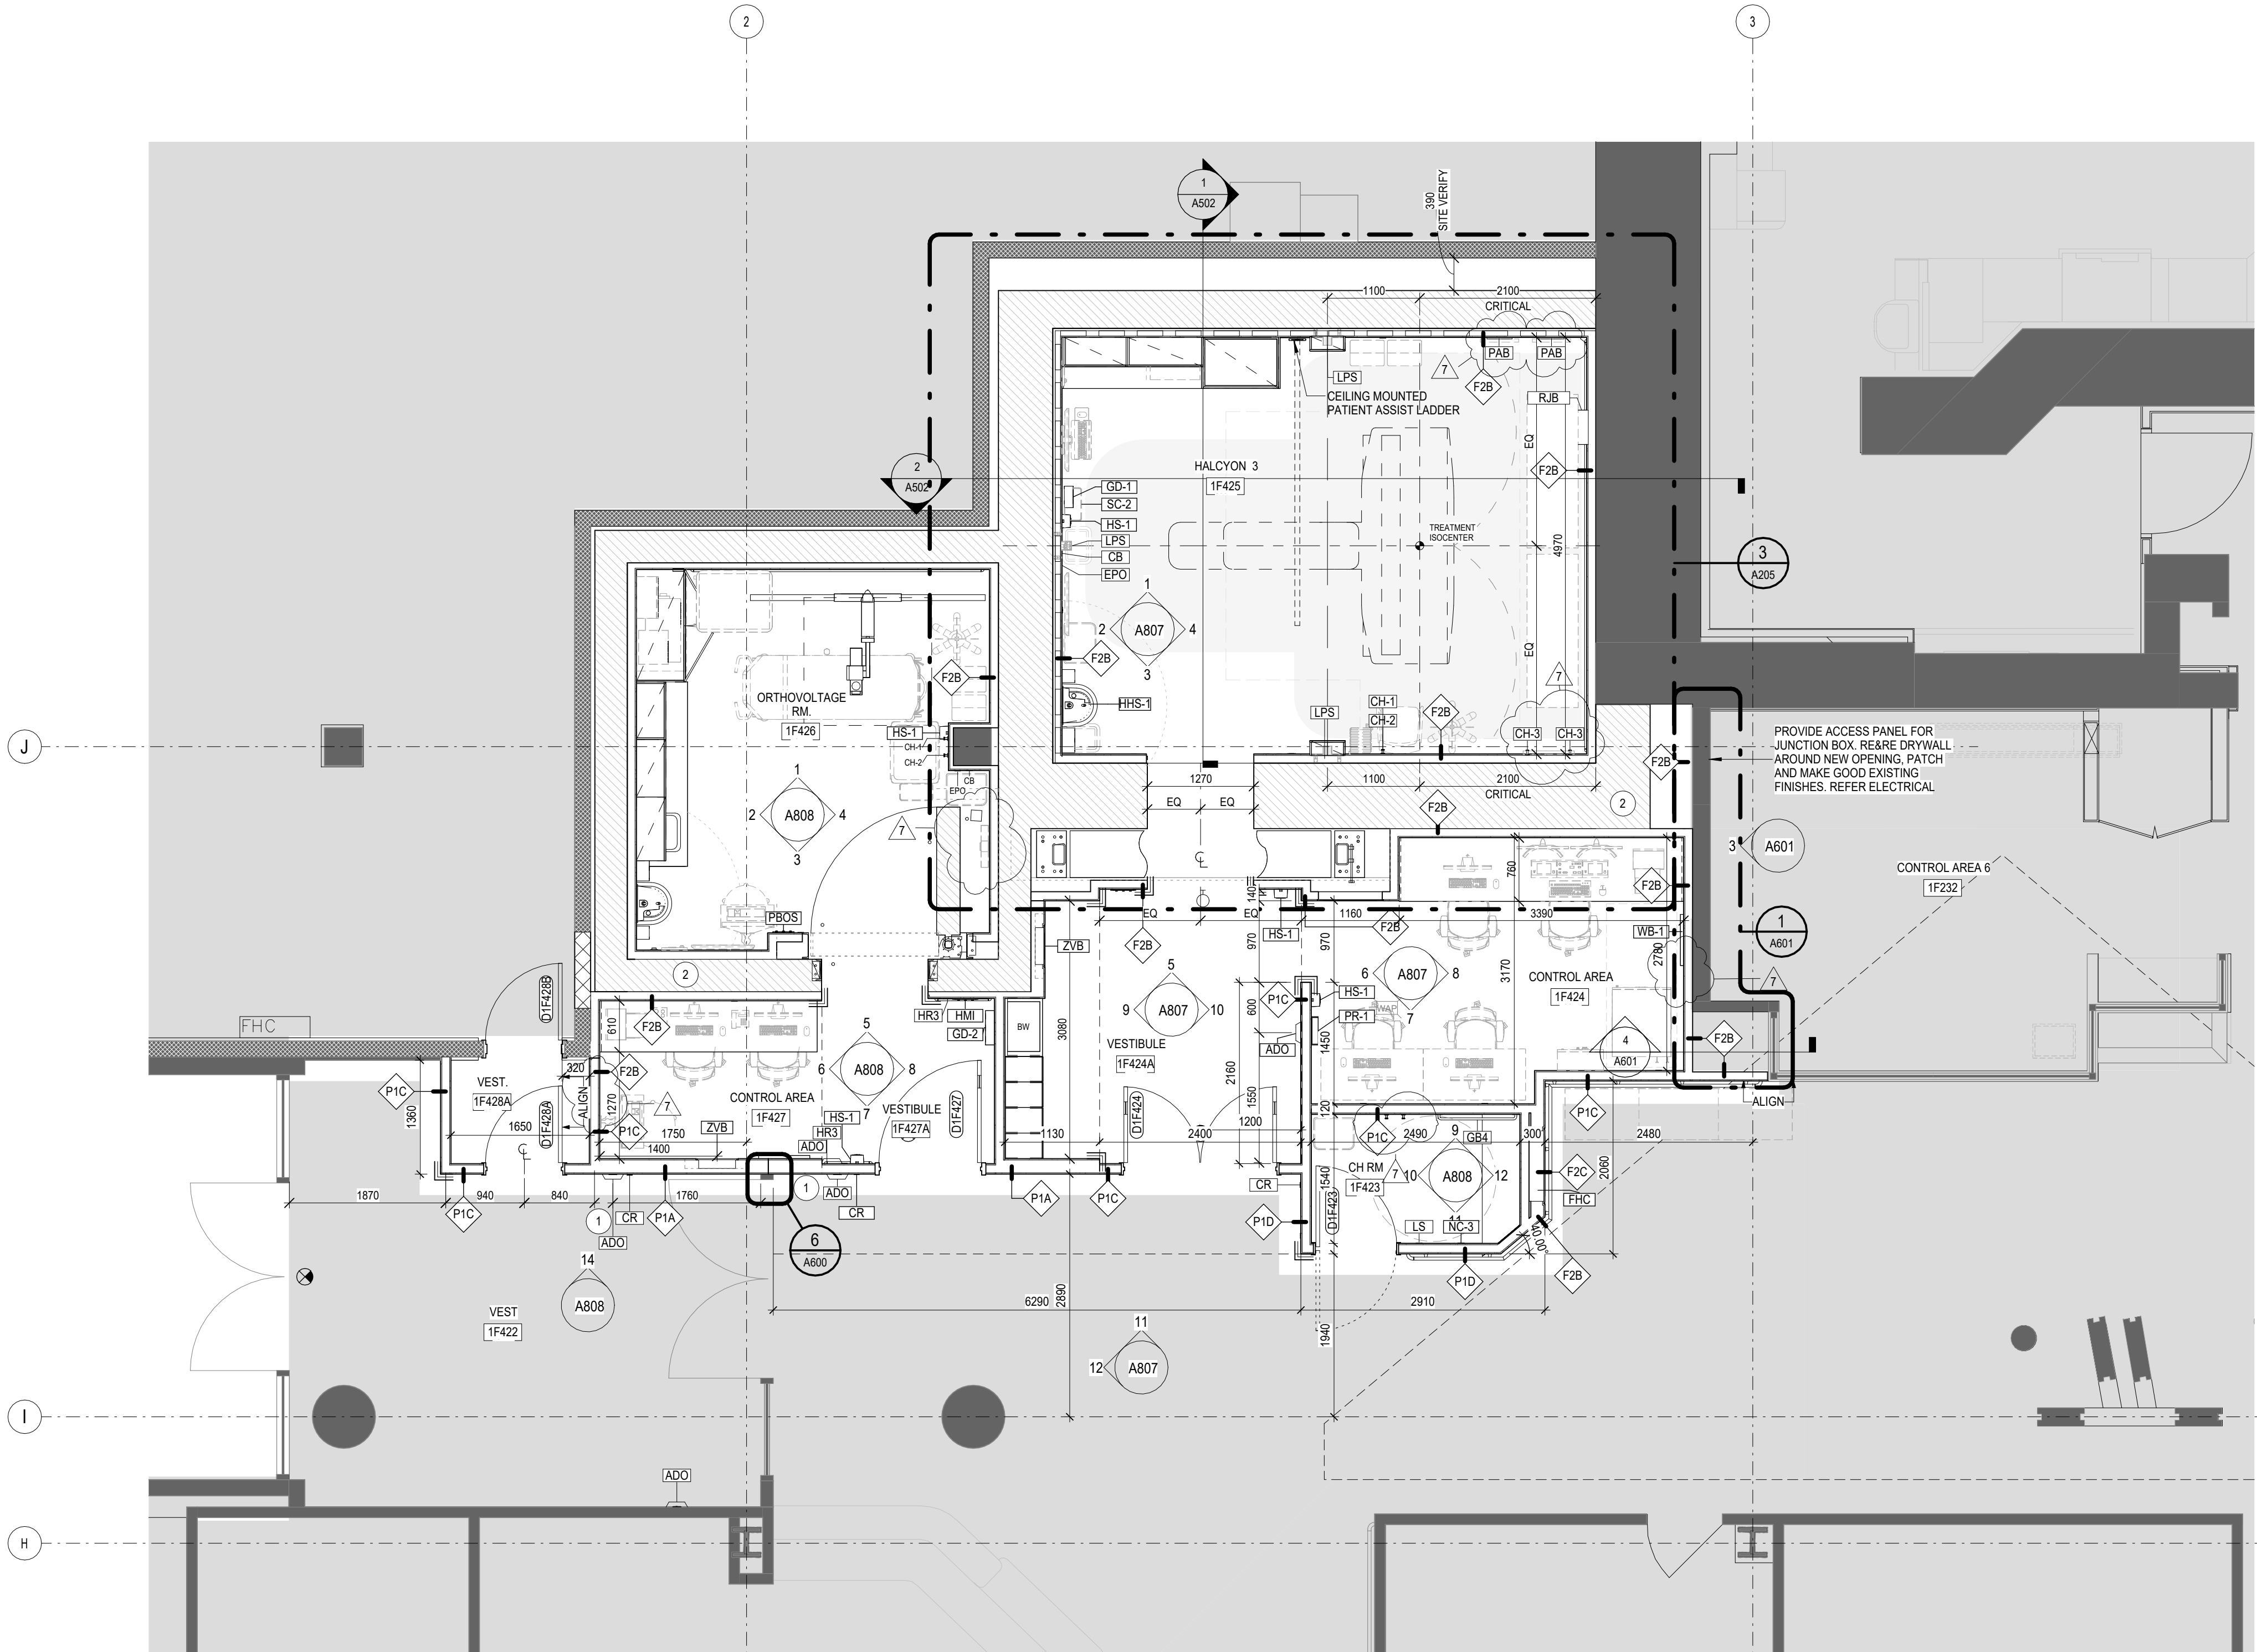

1 FLOOR PLAN - LEVEL 1 WEST - Phase 3 (HALCYON 3)
1:50

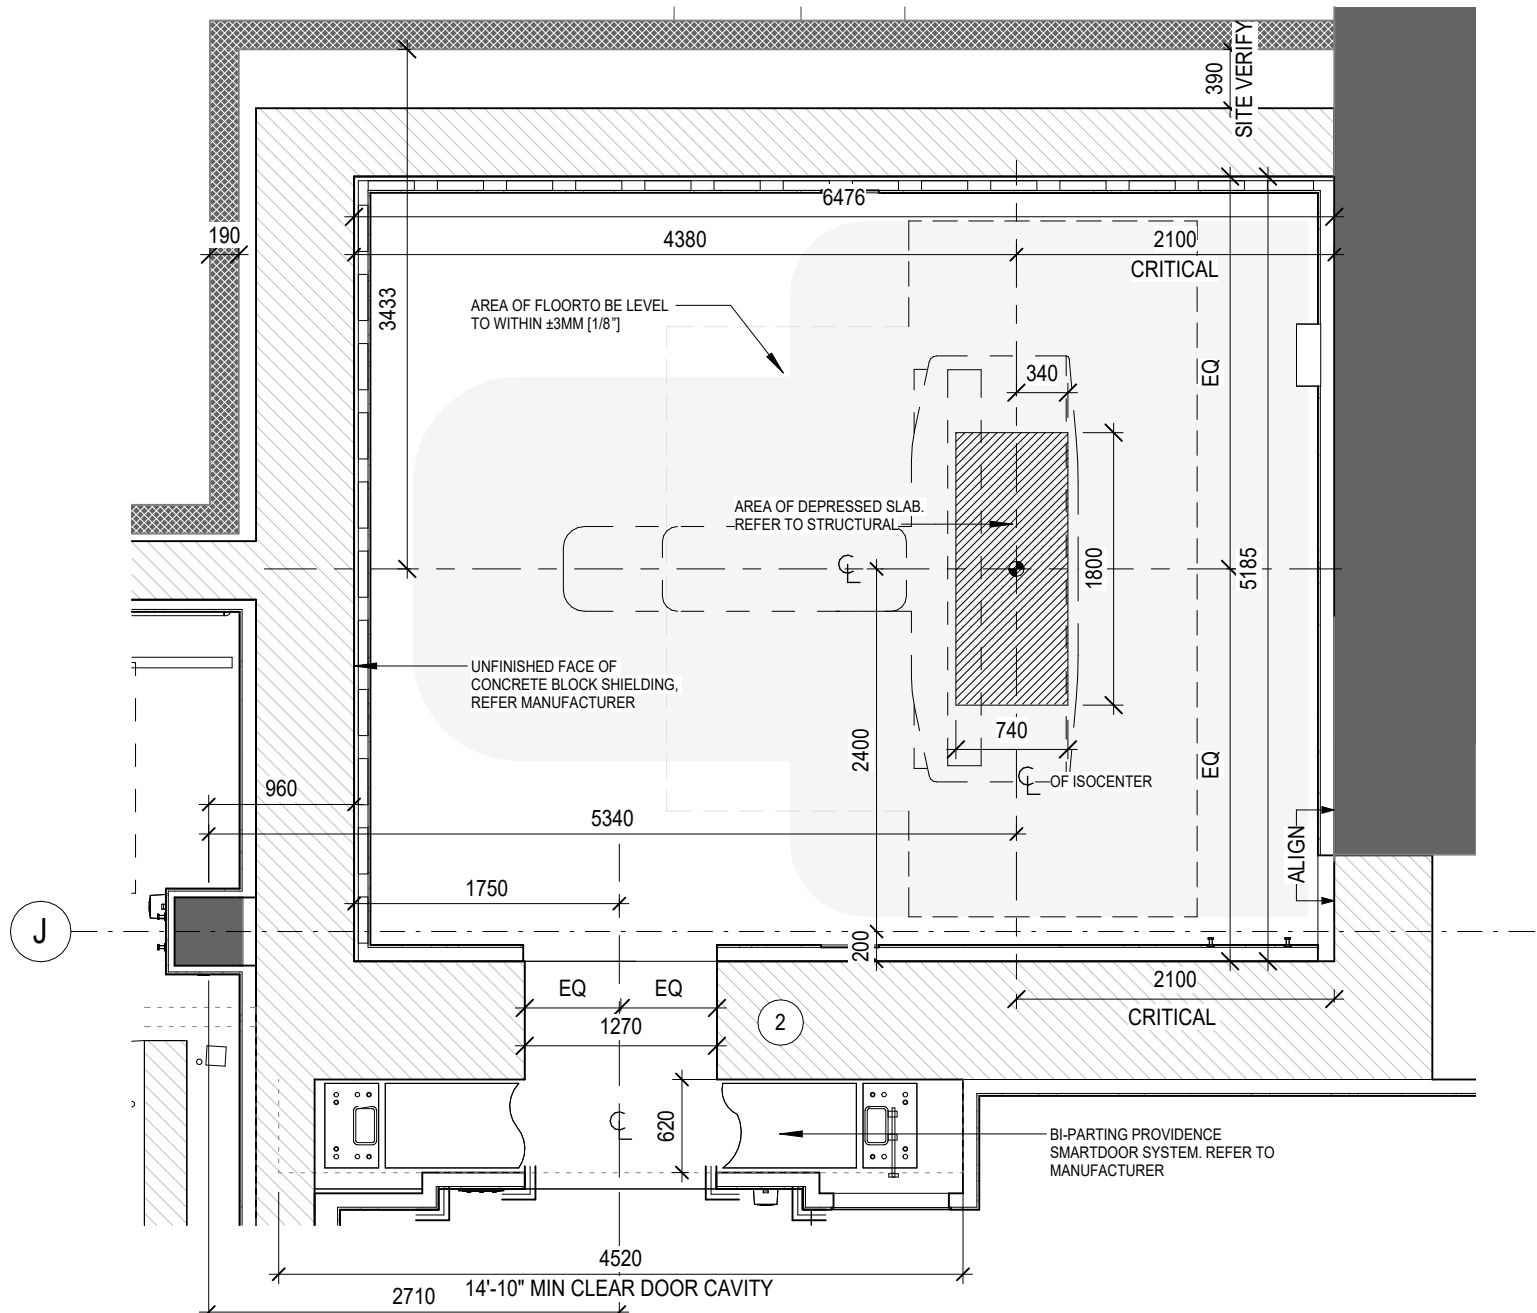

3 HALCYON 3 - SHIELDING LAYOUT & PIT DIAGRAM
1:50

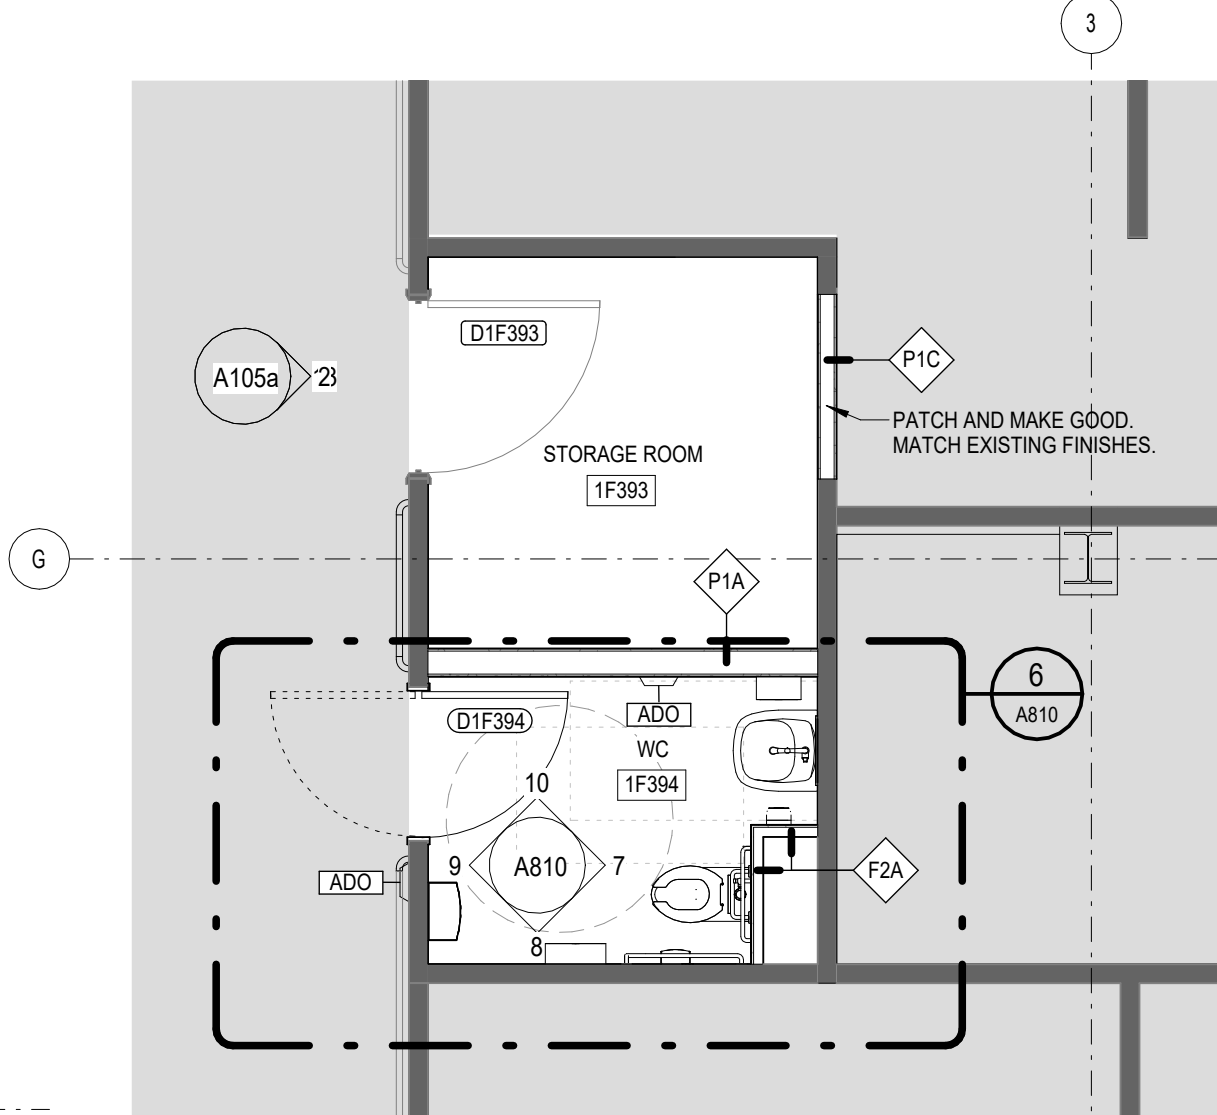

2 FLOOR PLAN - LEVEL 1 WEST - Phase 3 (Storage & WC)
1:50

LEGEND - FLOOR PLAN

- NOT IN CONTRACT / NOT IN SCOPE AREA
- EXISTING CONSTRUCTION
- NEW CONSTRUCTION
- CONCRETE BLOCK SHIELDING. SEE SUB-TRADE SHOP DRAWINGS FOR CONSTRUCTION DETAILS.

GENERAL NOTES:

ARCHITECTURAL CONSTRUCTION PLANS INDICATE PARTITION LAYOUT, TYPES AND BUILT-IN FEATURES. IT IS THE RESPONSIBILITY OF THE CONTRACTOR TO ENSURE PROPER COORDINATION WITH DOORS, DEVICES, MILLWORK, FIXTURES, FINISHES, EQUIPMENT AND FURNITURE.

ALIGNMENTS ARE DIMENSIONED FROM FINISH FACE TO FINISH FACE, UNLESS OTHERWISE NOTED. ALLOW FOR THICKNESS OF FINISHES.

VERIFY DIMENSIONS NOTED AS "CLEAR", "HOLD", "MIN", "CRITICAL", OR "V.I.F." DURING LAYOUT OF WORK. NOTIFY ARCHITECT OF DISCREPANCIES OR CONFLICTS PRIOR TO EXECUTION OF WORK.

LAYOUT ALL PARTITION LOCATIONS ON THE STRUCTURAL SLAB FOR CONSULTANT REVIEW PRIOR TO CONSTRUCTION. ADVISE CONSULTANTS OF DISCREPANCIES WITH THE DIMENSIONED PLANS OR CONFLICTS WITH OTHER PARTS OF THE WORK. ADJUST LOCATIONS AS REQUIRED BASED ON REVIEW.

PARTITIONS ARE TO BE SECURED TO THE U/S OF STRUCTURE UNLESS OTHERWISE NOTED. REFER TO STRUCTURAL DRAWINGS FOR REINFORCING AND ANCHORING DETAILS FOR ALL MASONRY WALLS.

PATCH AND REPAIR EXISTING WALLS, FLOORS, COLUMNS AND SURFACES TO REMAIN AS REQUIRED TO LEAVE THEM SMOOTH, EVEN AND/OR LEVEL TO RECEIVE NEW FINISHES. STARTING OF WORK INDICATES INSTALLERS ACCEPTANCE OF SUBSTRATE.

PROVIDE SOLID FRT BLOCKING AS REQUIRED IN PARTITION WALLS TO SUPPORT SHELVING, HANGING RODS, MILLWORK, GRAB BARS, ACCESSORIES AND OTHER ITEMS THAT ARE PART OF THIS CONTRACT. REFER TO CONSULTANT PLANS AND SPECIFICATIONS TO COORDINATE LOCATION OF BLOCKING TO SUPPORT ALL WALL MOUNTED FURNISHINGS PROVIDED BY OTHERS.

EXPOSED EDGES OF GWB TO BE TRIMMED WITH D200 BEAD, AS REQUIRED OR AS OTHERWISE DETAILED TO MAKE A TRUE AND STRAIGHT EDGE.

PARTITIONS ARE TO BE FINISHED AS PER ROOM FINISH SCHEDULE AND SPECIFICATIONS.

1 RELOCATED ADO BUTTON & CARD READER. REFER TO ELECTRICAL.

2 HALCYON SHIELDING WAS BASED ON VERITAS DRAWINGS DATED JUNE 10, 2024. IF CHANGES TO VERITAS SHIELDING ARE REQUIRED, ARCHITECTS TO BE ADVISED PRIOR TO IMPLEMENTATION ON SITE.

CLIENT:



2200 Eglinton Avenue West
Mississauga, ON L5M 2N1
905 813 2200
thp.ca

CONSULTANT:




160 Pears Ave. - Suite 300
Toronto, ON M5R 3P8
416-539-0763
www.cumulusarch.com

SEAL:

This drawing, as an instrument of service, is the property of Cumulus Architects Inc. the copyright in the same being reserved to them. No reproduction is allowed without the permission of Cumulus Architects Inc. and when made must bear its name.

This drawing is not to be scaled. The contractor is to verify dimensions and data noted herein for conformity with the conditions on site and is responsible for reporting in writing any discrepancy to Cumulus Architects Inc. for adjustment.

Cumulus will not be liable for any claims or damages arising from the unauthorized use of this drawing or any portion thereof.

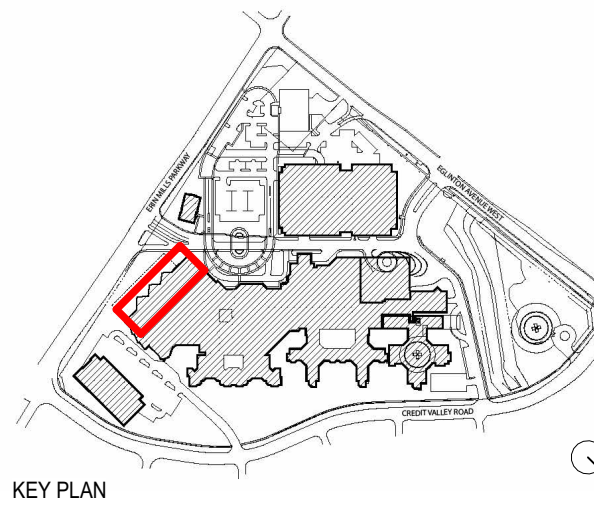

KEY PLAN

NO	DESCRIPTION	DATE
7	Issued for Addendum 1	2026/02/04
6	Issued for Tender	2025/12/16
5	Issued for Building Permit	2025/12/02
4	Issued For MOH 2.3 Resubmission	2025/06/20
2	Issued For MOH 2.3 Costing	2024/09/13

SHEET REVISION

PROJECT:

Oncology Radiation Treatment Expansion
2200 Eglinton Ave W,
Mississauga, ON L5M 2N1

TITLE:

FLOOR PLANS
PHASE 3

PROJECT NO:


23010

CHECKED:

Checker

DRAWING NO:

A205

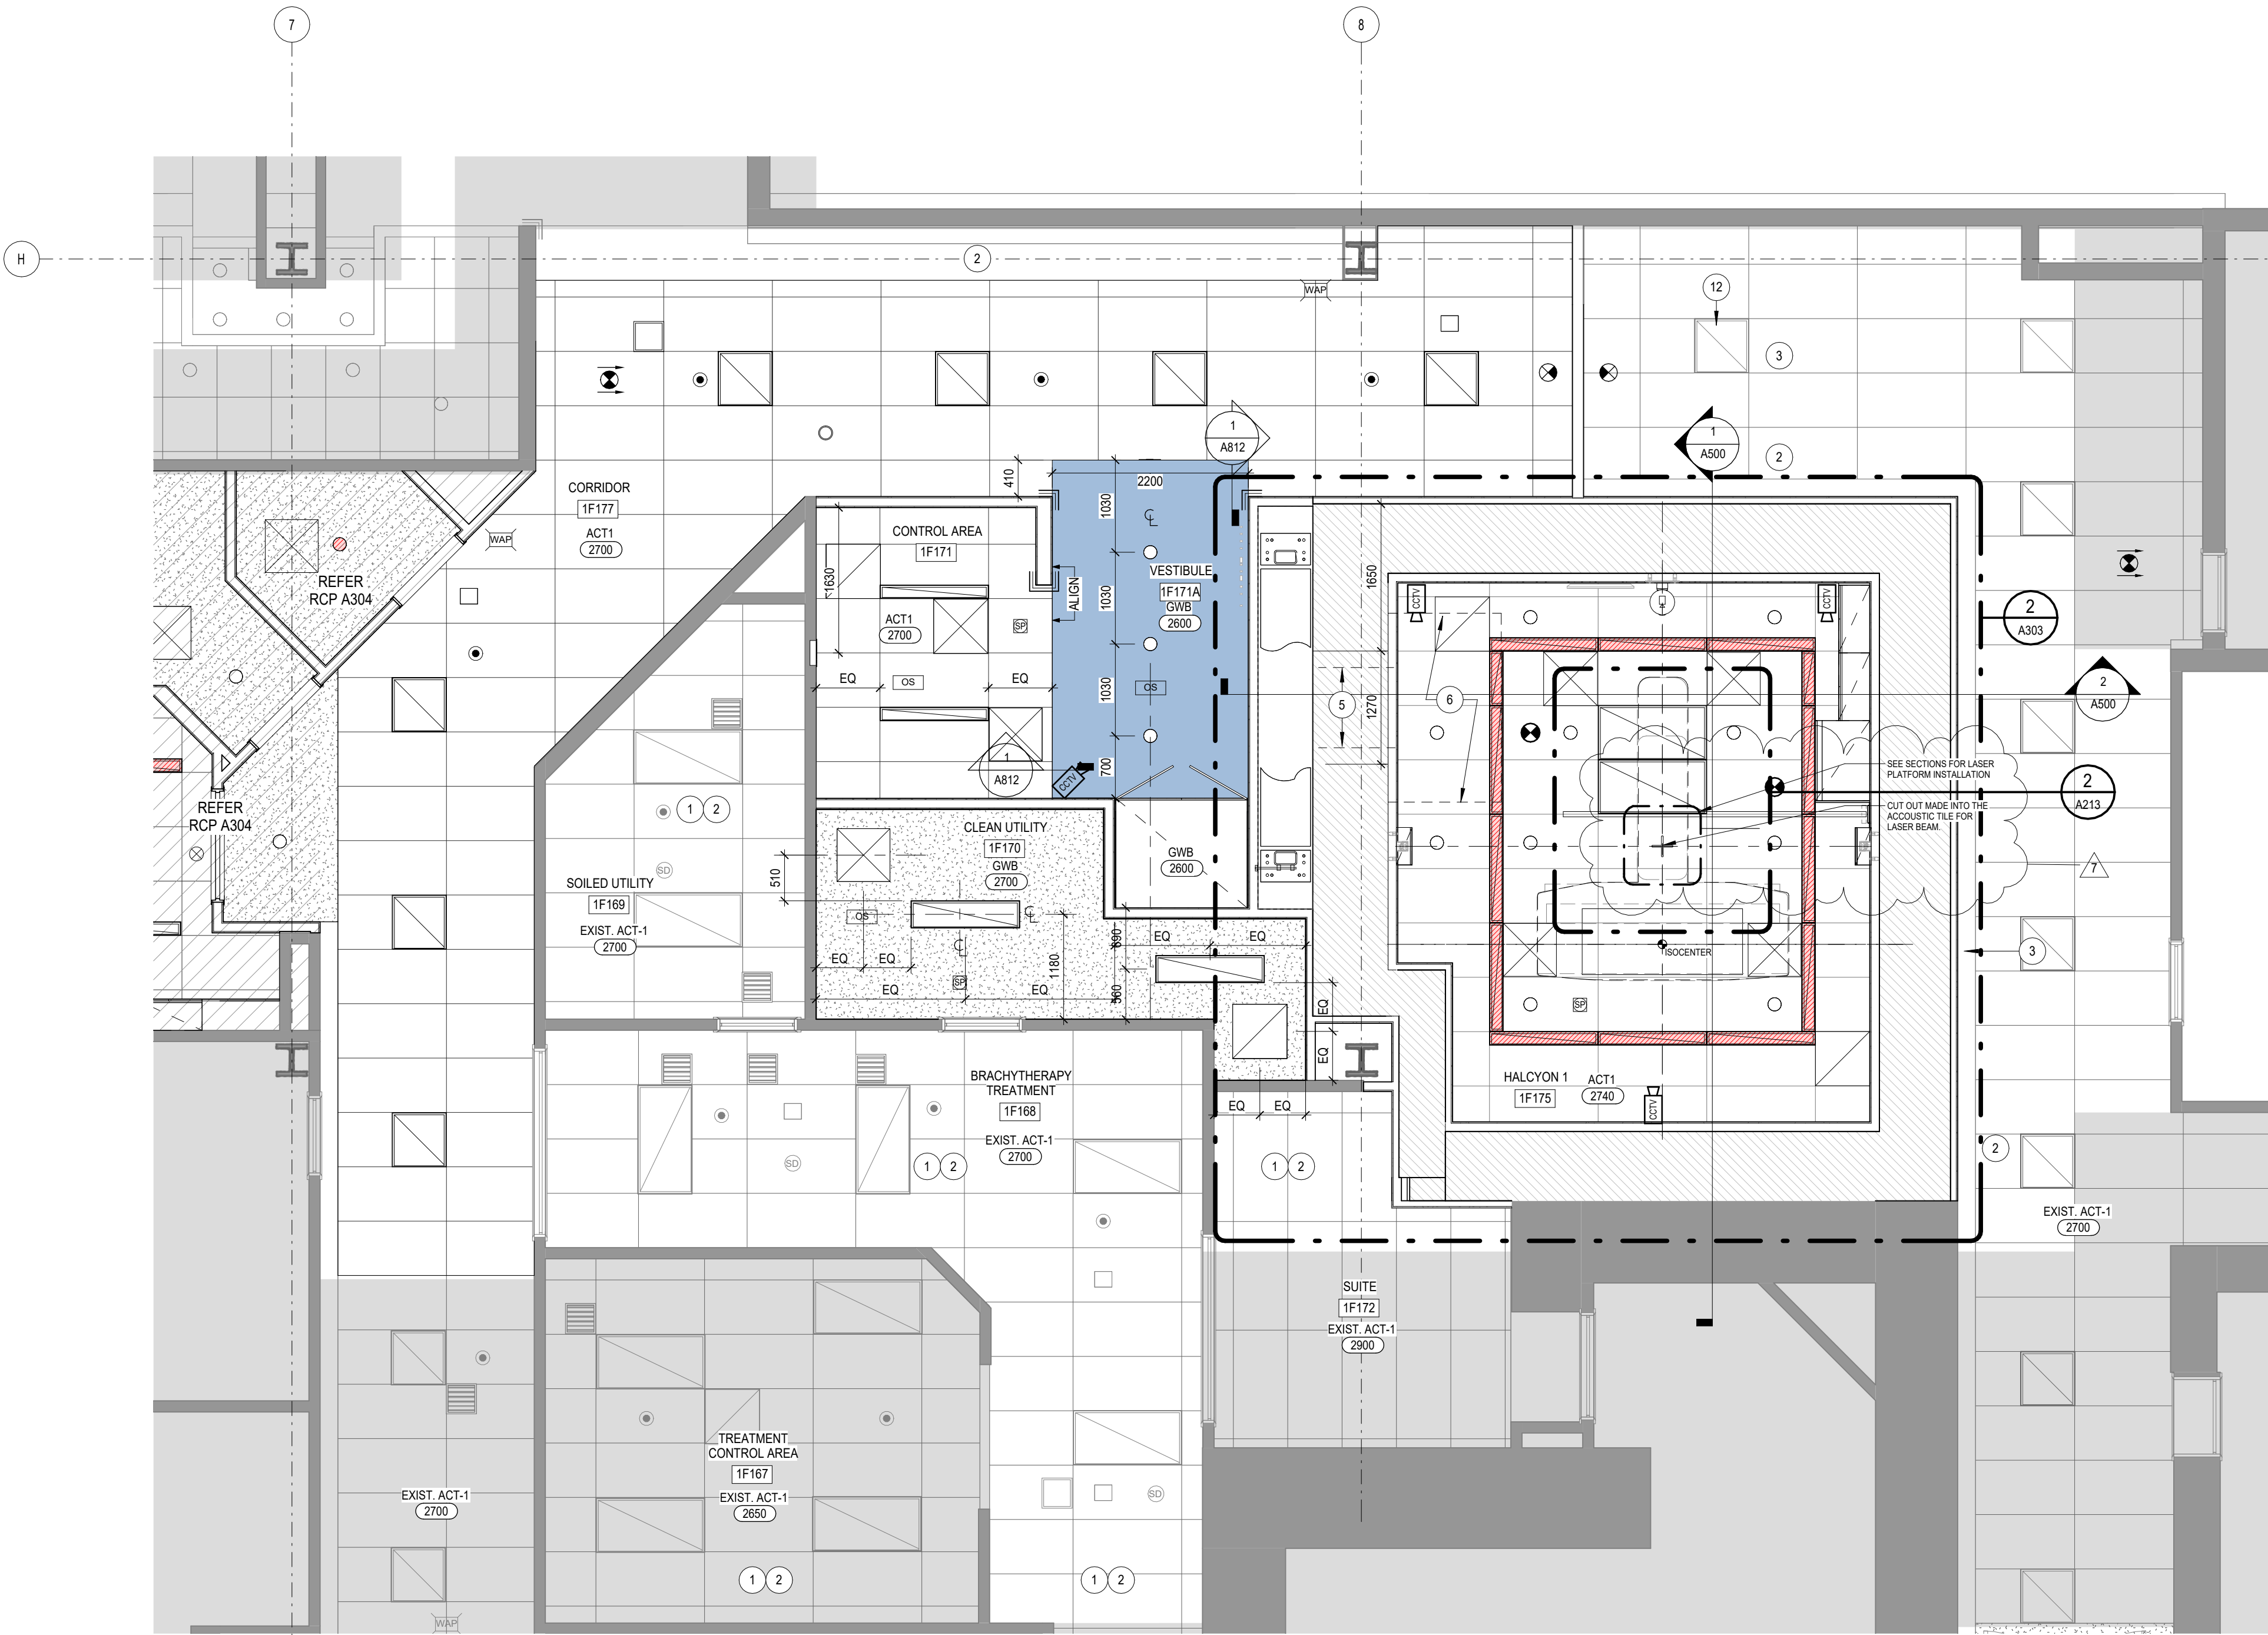

1 RCP - LEVEL 1 Phase 2 (Halcyon 1)
1:50

LEGEND - RCP SYMBOLS

LAY-IN ACT1 ACOUSTIC TILES IN T-BAR GRID SYSTEM. REFER TO FINISH SCHEDULE.

GYPSUM BOARD ON METAL FRAMING AS REQUIRED AND SUSPENDED FROM STRUCTURE.

FEATURE BLUE GYPSUM BOARD ON METAL FRAMING AS REQUIRED AND SUSPENDED FROM STRUCTURE. COLOUR TO BE P17. REFER TO FINISHES SCHEDULE.

NOTE: ALL ACCESSORIES ON FEATURE CEILING TO BE PAINTED P17 TO MATCH BLUE GYPSUM BOARD

CEILING FIXTURES/DEVICES LEGEND

NOTE: REFER TO ME DRAWINGS AND SPECIFICATIONS FOR DEVICES.

LIGHTING

CEILING MOUNTED LIGHT FIXTURES.

LIFE SAFETY + COMMUNICATION

SPRINKLER

OCCUPANCY SENSOR

CEILING MOUNTED SMOKE DETECTOR (REFER TO ELECTRICAL)

EMERGENCY VOICE COMMUNICATION SYSTEM

CEILING MOUNTED WIRELESS ACCESS POINT

CEILING MOUNTED EXIT LIGHT WITH DIRECTIONAL ARROW AS INDICATED (REFER TO ELECTRICAL)

CCTV CAMERA

NURSE CALL DOME LIGHT

HVAC

SUPPLY AIR DIFFUSER.

RETURN AIR GRILLE.

2 RCP - Halcyon 1 Ceiling Layout
1:50

LEGEND - RCP

NOT IN CONTRACT / NOT IN SCOPE AREA

EXISTING CONSTRUCTION

NEW CONSTRUCTION

EMERGENCY POWER TO LIGHTS (REFER TO ELEC.)

GENERAL NOTES:
THE REFLECTED CEILING PLAN AND ASSOCIATED ENLARGED CEILING PLANS SHOW LOCATION FOR CRITICAL CEILING COMPONENTS AND DEVICES. NOT ALL CEILING ELEMENTS OF ALL TRADES ARE SHOWN. REFER TO ELECTRICAL, MECHANICAL, COMMUNICATION, AV AND SECURITY DRAWINGS AS THEY APPLY FOR FULL SCOPE OF WORK AND QUANTITIES.

CONTRACTOR TO LAYOUT PIPING, DUCTWORK AND OTHER MAJOR ELEMENTS IN CEILING PLENUM SPACE AND COORDINATE FOR ADEQUATE CLEARANCES FOR RECESSED CEILING DEVICES TO MAINTAIN LAYOUT AS INDICATED IN THE REFLECTED CEILING PLANS. ADVISE CONSULTANTS OF DISCREPANCIES WITH THE DIMENSIONED PLANS OR CONFLICTS WITH OTHER PARTS OF THE WORK. ADJUST LOCATIONS AS REQUIRED BASED ON REVIEW.

FOR ALL ELECTRICAL ACCESSORIES AND COVERPLATES PROVIDE STANDARD WHITE COLOUR, UNLESS OTHERWISE NOTED. COORDINATE WITH ARCHITECT PRIOR TO PURCHASE AND INSTALLATION OF MATERIALS. NO BLANK PLATES ARE PERMITTED.

LOCATE UNDIMENSIONED SPRINKLER HEADS, SPEAKERS, LIGHT FIXTURES AND OTHER ITEMS IN THE CENTRE OF SUSPENDED ACOUSTIC CEILING TILES UNLESS OTHERWISE NOTED.

FINISH AND COLOUR OF ACCESS PANELS, HVAC DIFFUSERS, REGISTERS, LIGHT FIXTURES, CEILING TRIM, DRAPERY POCKETS, SPEAKER GRILLES AND OTHER CEILING MOUNTED DEVICES TO MATCH SCHEDULED CEILING COLOUR UNLESS OTHERWISE NOTED.

CUT EXISTING GWB CEILINGS AS REQUIRED TO FACILITATE INSTALLATION OF ELECTRICAL OR MECHANICAL SERVICES AND REPAIR CEILINGS TO PRE-EXISTING CONDITIONS. ALLOW FOR SUCH CEILING REPAIRS OF FLOOR LEVEL, BELOW, IF REQUIRED. SCOPE OF SUCH WORK FOR REPAIRS SHALL BE ESTABLISHED AT TIME OF BID AND INCLUDED IN BASE AMOUNT.

VERIFY WITH CONSULTANT THE INSTALLATION HEIGHT OF ALL SUSPENDED OR WALL-MOUNTED LIGHTING FIXTURES PRIOR TO INSTALLATION. WHERE POSSIBLE PROVIDE 'SLACK' SUSPENSION SYSTEM TO ALLOW FOR HEIGHT ADJUSTMENT UPON CONSULTANT REVIEW IN THE FIELD.

1

MECHANICAL SERVICE WORK ABOVE

2

PATCH & MAKE GOOD EXISTING CEILING AS REQUIRED (TYP)

3

LIGHT COVE TO BE MODIFIED AS REQUIRED AND REINSTATED IN PLACE. REFER TO DETAIL.

4

GWB BULKHEAD OVER MILLWORK. REFER TO DETAIL.

5

LINE OF SERVICE PENETRATION THROUGH SHIELDING

6

LINE OF PENETRATION SHIELDING BY MANUFACTURER. EXACT SIZE TBC. REFER TO DETAIL.

7

VIRTUAL SKYLIGHT LIGHT PANELS. REFER TO ELECTRICAL.

8

CONTRACTOR TO COORDINATE THE LOCATION OF ISOCENTER ON SITE AND LAYOUT CEILING ACCORDINGLY

9

ACCENT COLOURED LIGHTING REFER TO ELECTRICAL.

10

PATIENT ASSIST TRACK

11

RECESSED LASER POSITIONING SYSTEM BY OTHERS

12

EXISTING LIGHT TO BE REMOVED AND RE-CONNECTED TO EMERGENCY CIRCUIT FOR MAGLOCK REQUIREMENTS.

CLIENT:

Trillium Health Partners
2200 Eglinton Avenue West
Mississauga, ON, L5M 2N1
905 813 2200
thp.ca

CONSULTANT:

CUMULUS ARCHITECTS INC.
160 Pears Ave. - Suite 300
Toronto, ON M5R 3P8
416-539-0763
www.cumulusarch.com

SEAL:

This drawing, as an instrument of service, is the property of Cumulus Architects Inc. the copyright in the same being reserved to them. No reproduction is allowed without the permission of Cumulus Architects Inc. and when made must bear its name.

This drawing is not to be scaled. The contractor is to verify dimensions and data noted herein for conformity with the conditions on site and is responsible for reporting in writing any discrepancy to Cumulus Architects Inc. for adjustment.

Cumulus will not be liable for any claims or damages arising from the unauthorized use of this drawing or any portion thereof.

KEY PLAN

NO	DESCRIPTION	DATE
7	Issued for Addendum 1	2026/02/04
6	Issued for Tender	2025/12/16
5	Issued for Building Permit	2025/12/02
4	Issued For MOH 2.3 Resubmission	2025/06/20
2	Issued For MOH 2.3 Costing	2024/09/13


PROJECT:
Oncology Radiation Treatment Expansion
2200 Eglinton Ave W,
Mississauga, ON L5M 2N1

TITLE:
**REFLECTED CEILING PLAN
PHASE 2**

PROJECT NO:
23010
CHECKED:
Checker

DRAWING NO:

A303

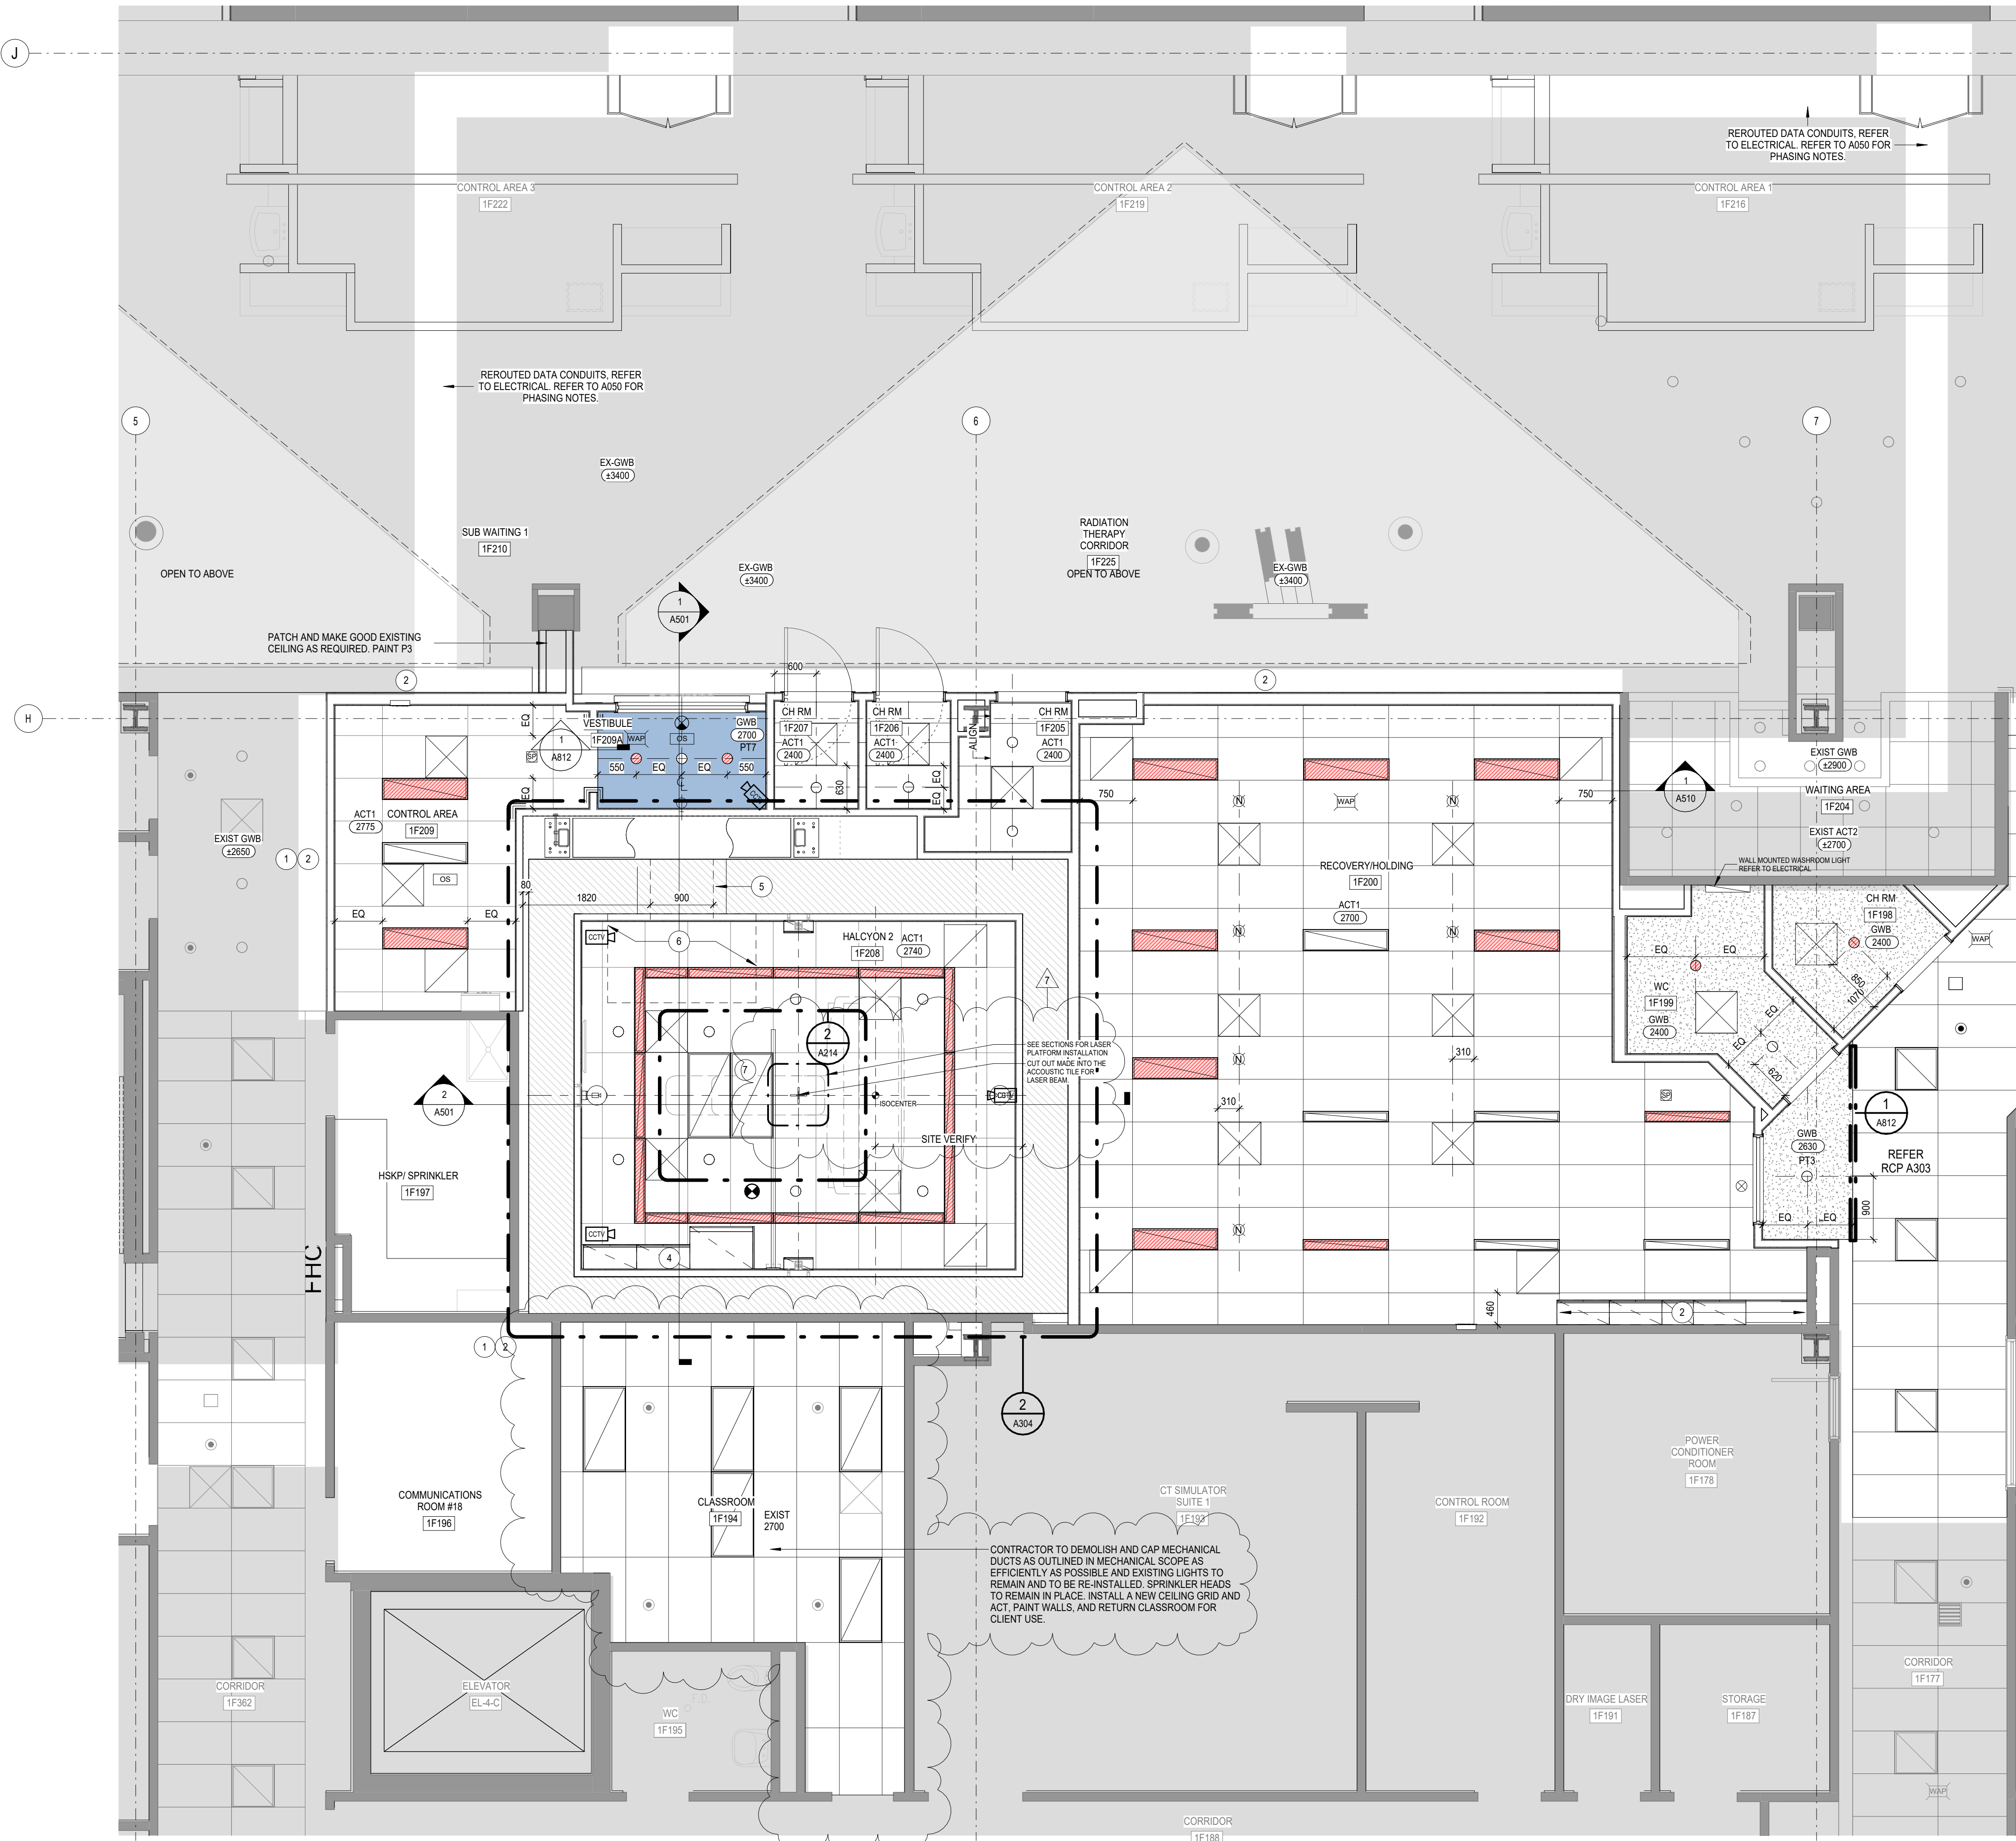

1 RCP - LEVEL 1 Phase 2 (Halcyon 2)
1:50


LEGEND - RCP SYMBOLS

- LAY-IN ACT1 ACOUSTIC TILES IN T-BAR GRID SYSTEM. REFER TO FINISH SCHEDULE.
- GYPSUM BOARD ON METAL FRAMING AS REQUIRED AND SUSPENDED FROM STRUCTURE.
- FEATURE BLUE GYPSUM BOARD ON METAL FRAMING AS REQUIRED AND SUSPENDED FROM STRUCTURE. COLOUR TO BE P77. REFER TO FINISHES SCHEDULE

CEILING FIXTURES/DEVICES LEGEND

NOTE: REFER TO M&E DRAWINGS AND SPECIFICATIONS FOR DEVICES.

- LIGHTING**
 - CEILING MOUNTED LIGHT FIXTURES.
- LIFE SAFETY + COMMUNICATION**
 - SPRINKLER
 - OCCUPANCY SENSOR
 - CEILING MOUNTED SMOKE DETECTOR (REFER TO ELECTRICAL)
 - EMERGENCY VOICE COMMUNICATION SYSTEM (REFER TO ELECTRICAL)
 - CEILING MOUNTED WIRELESS ACCESS POINT (REFER TO ELECTRICAL)
 - CEILING MOUNTED EXIT LIGHT WITH DIRECTIONAL ARROW AS INDICATED (REFER TO ELECTRICAL)
 - CCTV CAMERA (REFER TO ELECTRICAL)
 - NURSE CALL DOME LIGHT
 - HVAC**
 - SUPPLY AIR DIFFUSER.
 - RETURN AIR GRILLE.

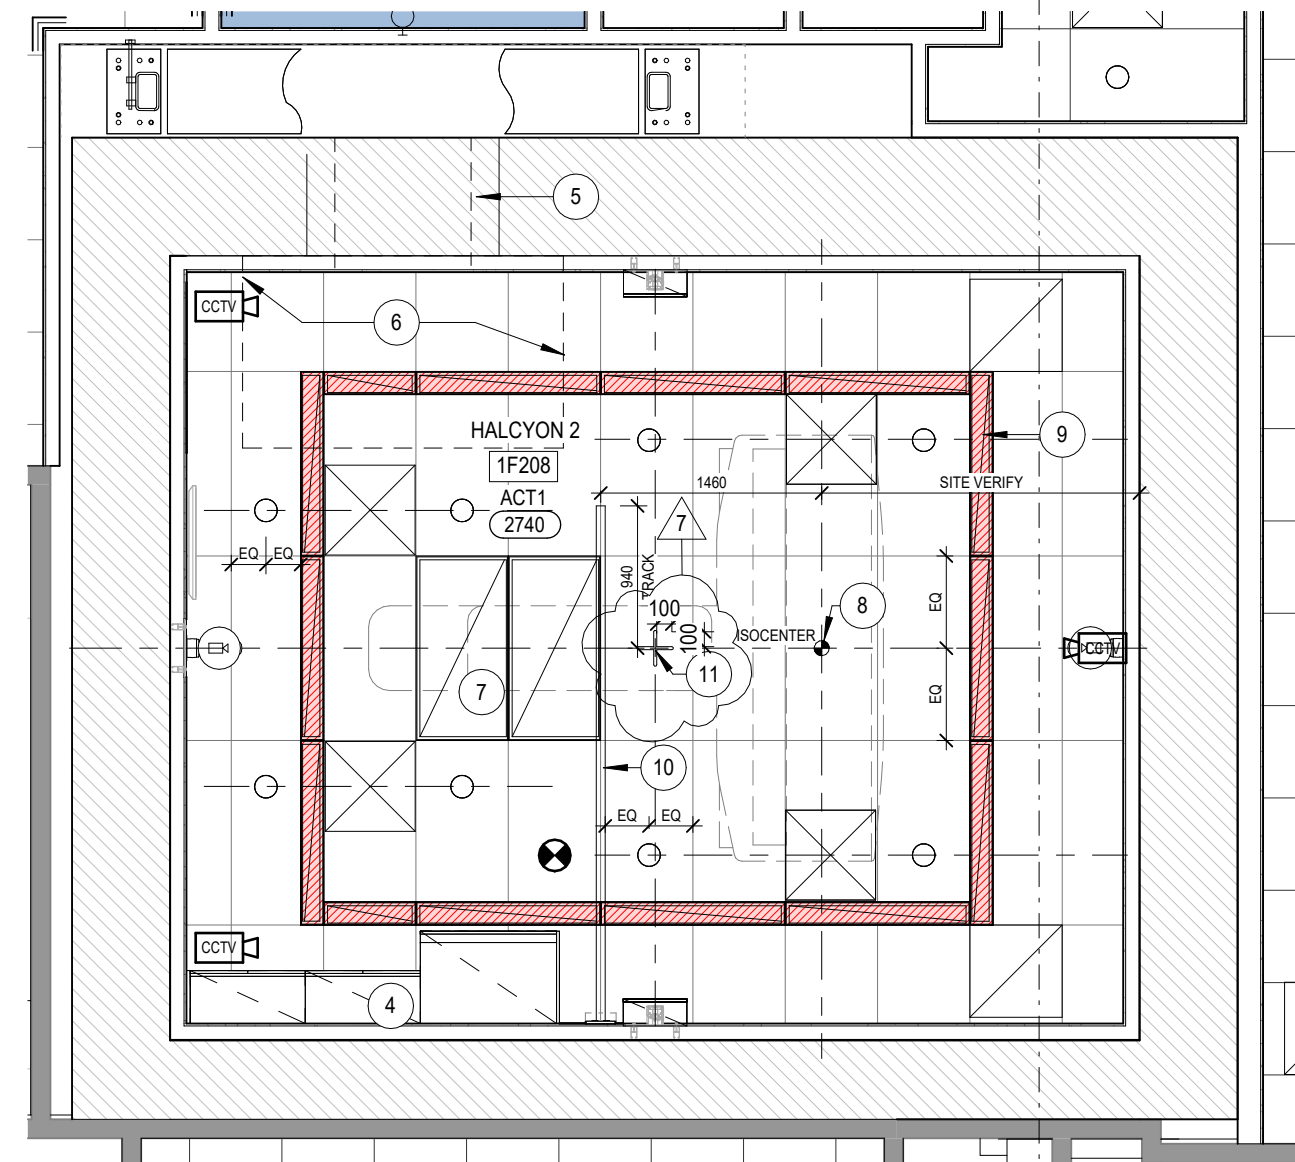

2 RCP - Halcyon 2 Ceiling Layout
1:50

LEGEND - RCP

- NOT IN CONTRACT / NOT IN SCOPE AREA
- EXISTING CONSTRUCTION
- NEW CONSTRUCTION
- EMERGENCY POWER TO LIGHTS (REFER TO ELEC.)

GENERAL NOTES:

- THE REFLECTED CEILING PLAN AND ASSOCIATED ENLARGED CEILING PLANS SHOW LOCATION FOR CRITICAL CEILING COMPONENTS AND DEVICES. NOT ALL CEILING ELEMENTS OF ALL TRADES ARE SHOWN. REFER TO ELECTRICAL, MECHANICAL, COMMUNICATION, AV AND SECURITY DRAWINGS AS THEY APPLY FOR FULL SCOPE OF WORK AND QUANTITIES.
- CONTRACTOR TO LAYOUT PIPING, DUCTWORK AND OTHER MAJOR ELEMENTS IN CEILING PLENUM SPACE AND COORDINATE FOR ADEQUATE CLEARANCES FOR RECESSED CEILING DEVICES TO MAINTAIN LAYOUT AS INDICATED IN THE REFLECTED CEILING PLANS. ADVISE CONSULTANTS OF DISCREPANCIES WITH THE DIMENSIONED PLANS OR CONFLICTS WITH OTHER PARTS OF THE WORK. ADJUST LOCATIONS AS REQUIRED BASED ON REVIEW.
- FOR ALL ELECTRICAL ACCESSORIES AND COVERPLATES PROVIDE STANDARD WHITE COLOUR, UNLESS OTHERWISE NOTED. COORDINATE WITH ARCHITECT PRIOR TO PURCHASE AND INSTALLATION OF MATERIALS. NO BLANK PLATES ARE PERMITTED.
- LOCATE UNDIMENSIONED SPRINKLER HEADS, SPEAKERS, LIGHT FIXTURES AND OTHER ITEMS IN THE CENTRE OF SUSPENDED ACOUSTIC CEILING TILES UNLESS OTHERWISE NOTED.
- FINISH AND COLOUR OF ACCESS PANELS, HVAC DIFFUSERS/REGISTERS, LIGHT FIXTURES, CEILING TRIM, DRAPERY POCKETS, SPEAKER GRILLES AND OTHER CEILING MOUNTED DEVICES TO MATCH SCHEDULED CEILING COLOUR UNLESS OTHERWISE NOTED.
- CUT EXISTING GWB CEILINGS AS REQUIRED TO FACILITATE INSTALLATION OF ELECTRICAL OR MECHANICAL SERVICES AND REPAIR CEILINGS TO PRE-EXISTING CONDITIONS. ALLOW FOR SUCH CEILING REPAIRS OF FLOOR LEVEL BELOW, IF REQUIRED. SCOPE OF SUCH WORK FOR REPAIRS SHALL BE ESTABLISHED AT TIME OF BID AND INCLUDED IN BASE AMOUNT.
- VERIFY WITH CONSULTANT THE INSTALLATION HEIGHT OF ALL SUSPENDED OR WALL-MOUNTED LIGHTING FIXTURES PRIOR TO INSTALLATION. WHERE POSSIBLE PROVIDE SLACK SUSPENSION SYSTEM TO ALLOW FOR HEIGHT ADJUSTMENT UPON CONSULTANT REVIEW IN THE FIELD.
- MECHANICAL SERVICE WORK ABOVE
- PATCH & MAKE GOOD EXISTING CEILING AS REQUIRED. (TYP)
- LIGHT COVE TO BE MODIFIED AS REQUIRED AND REINSTALLED IN PLACE.
- GWB BULKHEAD OVER MILLWORK, REFER TO DETAIL
- LINE OF SERVICE PENETRATION THROUGH SHIELDING
- LINE OF PENETRATION SHIELDING BY MANUFACTURER. EXACT SIZE TBC.
- VIRTUAL SKYLIGHT LIGHT PANELS, REFER TO ELECTRICAL
- CONTRACTOR TO COORDINATE THE LOCATION OF ISOCENTER ON SITE AND LAYOUT CEILING ACCORDINGLY
- ACCENT COLOURED LIGHTING REFER TO ELECTRICAL
- PATIENT ASSIST TRACK
- RECESSED LASER POSITIONING SYSTEM BY OTHERS

CLIENT:

Trillium Health Partners
2200 Eglinton Avenue West
Mississauga, ON L5M 2N1
905 813 2200
thp.ca

CONSULTANT:


CUMULUS ARCHITECTS INC.
160 Pears Ave. - Suite 300
Toronto, ON M5R 3P8
416-539-0763
www.cumulusarch.com

SEAL:

This drawing, as an instrument of service, is the property of Cumulus Architects Inc. the copyright in the same being reserved to them. No reproduction is allowed without the permission of Cumulus Architects Inc. and when made must bear its name.

This drawing is not to be scaled. The contractor is to verify dimensions and data noted herein for conformity with the conditions on site and is responsible for reporting in writing any discrepancy to Cumulus Architects Inc. for adjustment.

Cumulus will not be liable for any claims or damages arising from the unauthorized use of this drawing or any portion thereof.

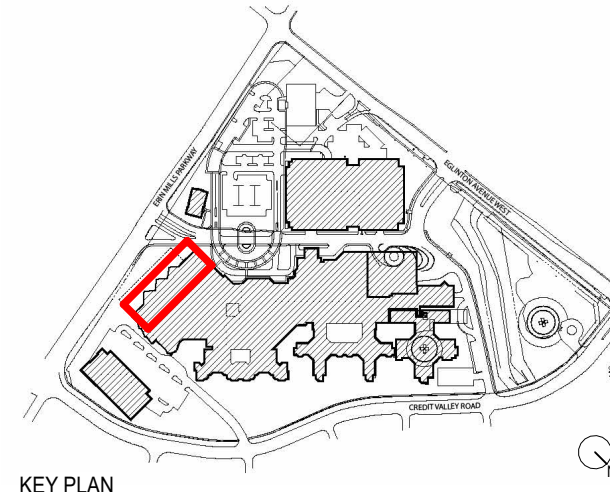

KEY PLAN

NO	DESCRIPTION	DATE
7	Issued for Addendum 1	2026/02/04
6	Issued for Tender	2025/12/16
5	Issued for Building Permit	2025/12/02
4	Issued For MOH 2.3 Resubmission	2025/06/20
2	Issued For MOH 2.3 Costing	2024/09/13

SHEET REVISION


PROJECT:
Oncology Radiation Treatment Expansion
2200 Eglinton Ave W,
Mississauga, ON L5M 2N1

TITLE:
**REFLECTED CEILING PLAN
PHASE 2**

PROJECT NO:
23010
CHECKED:
Checker

DRAWING NO:

A304

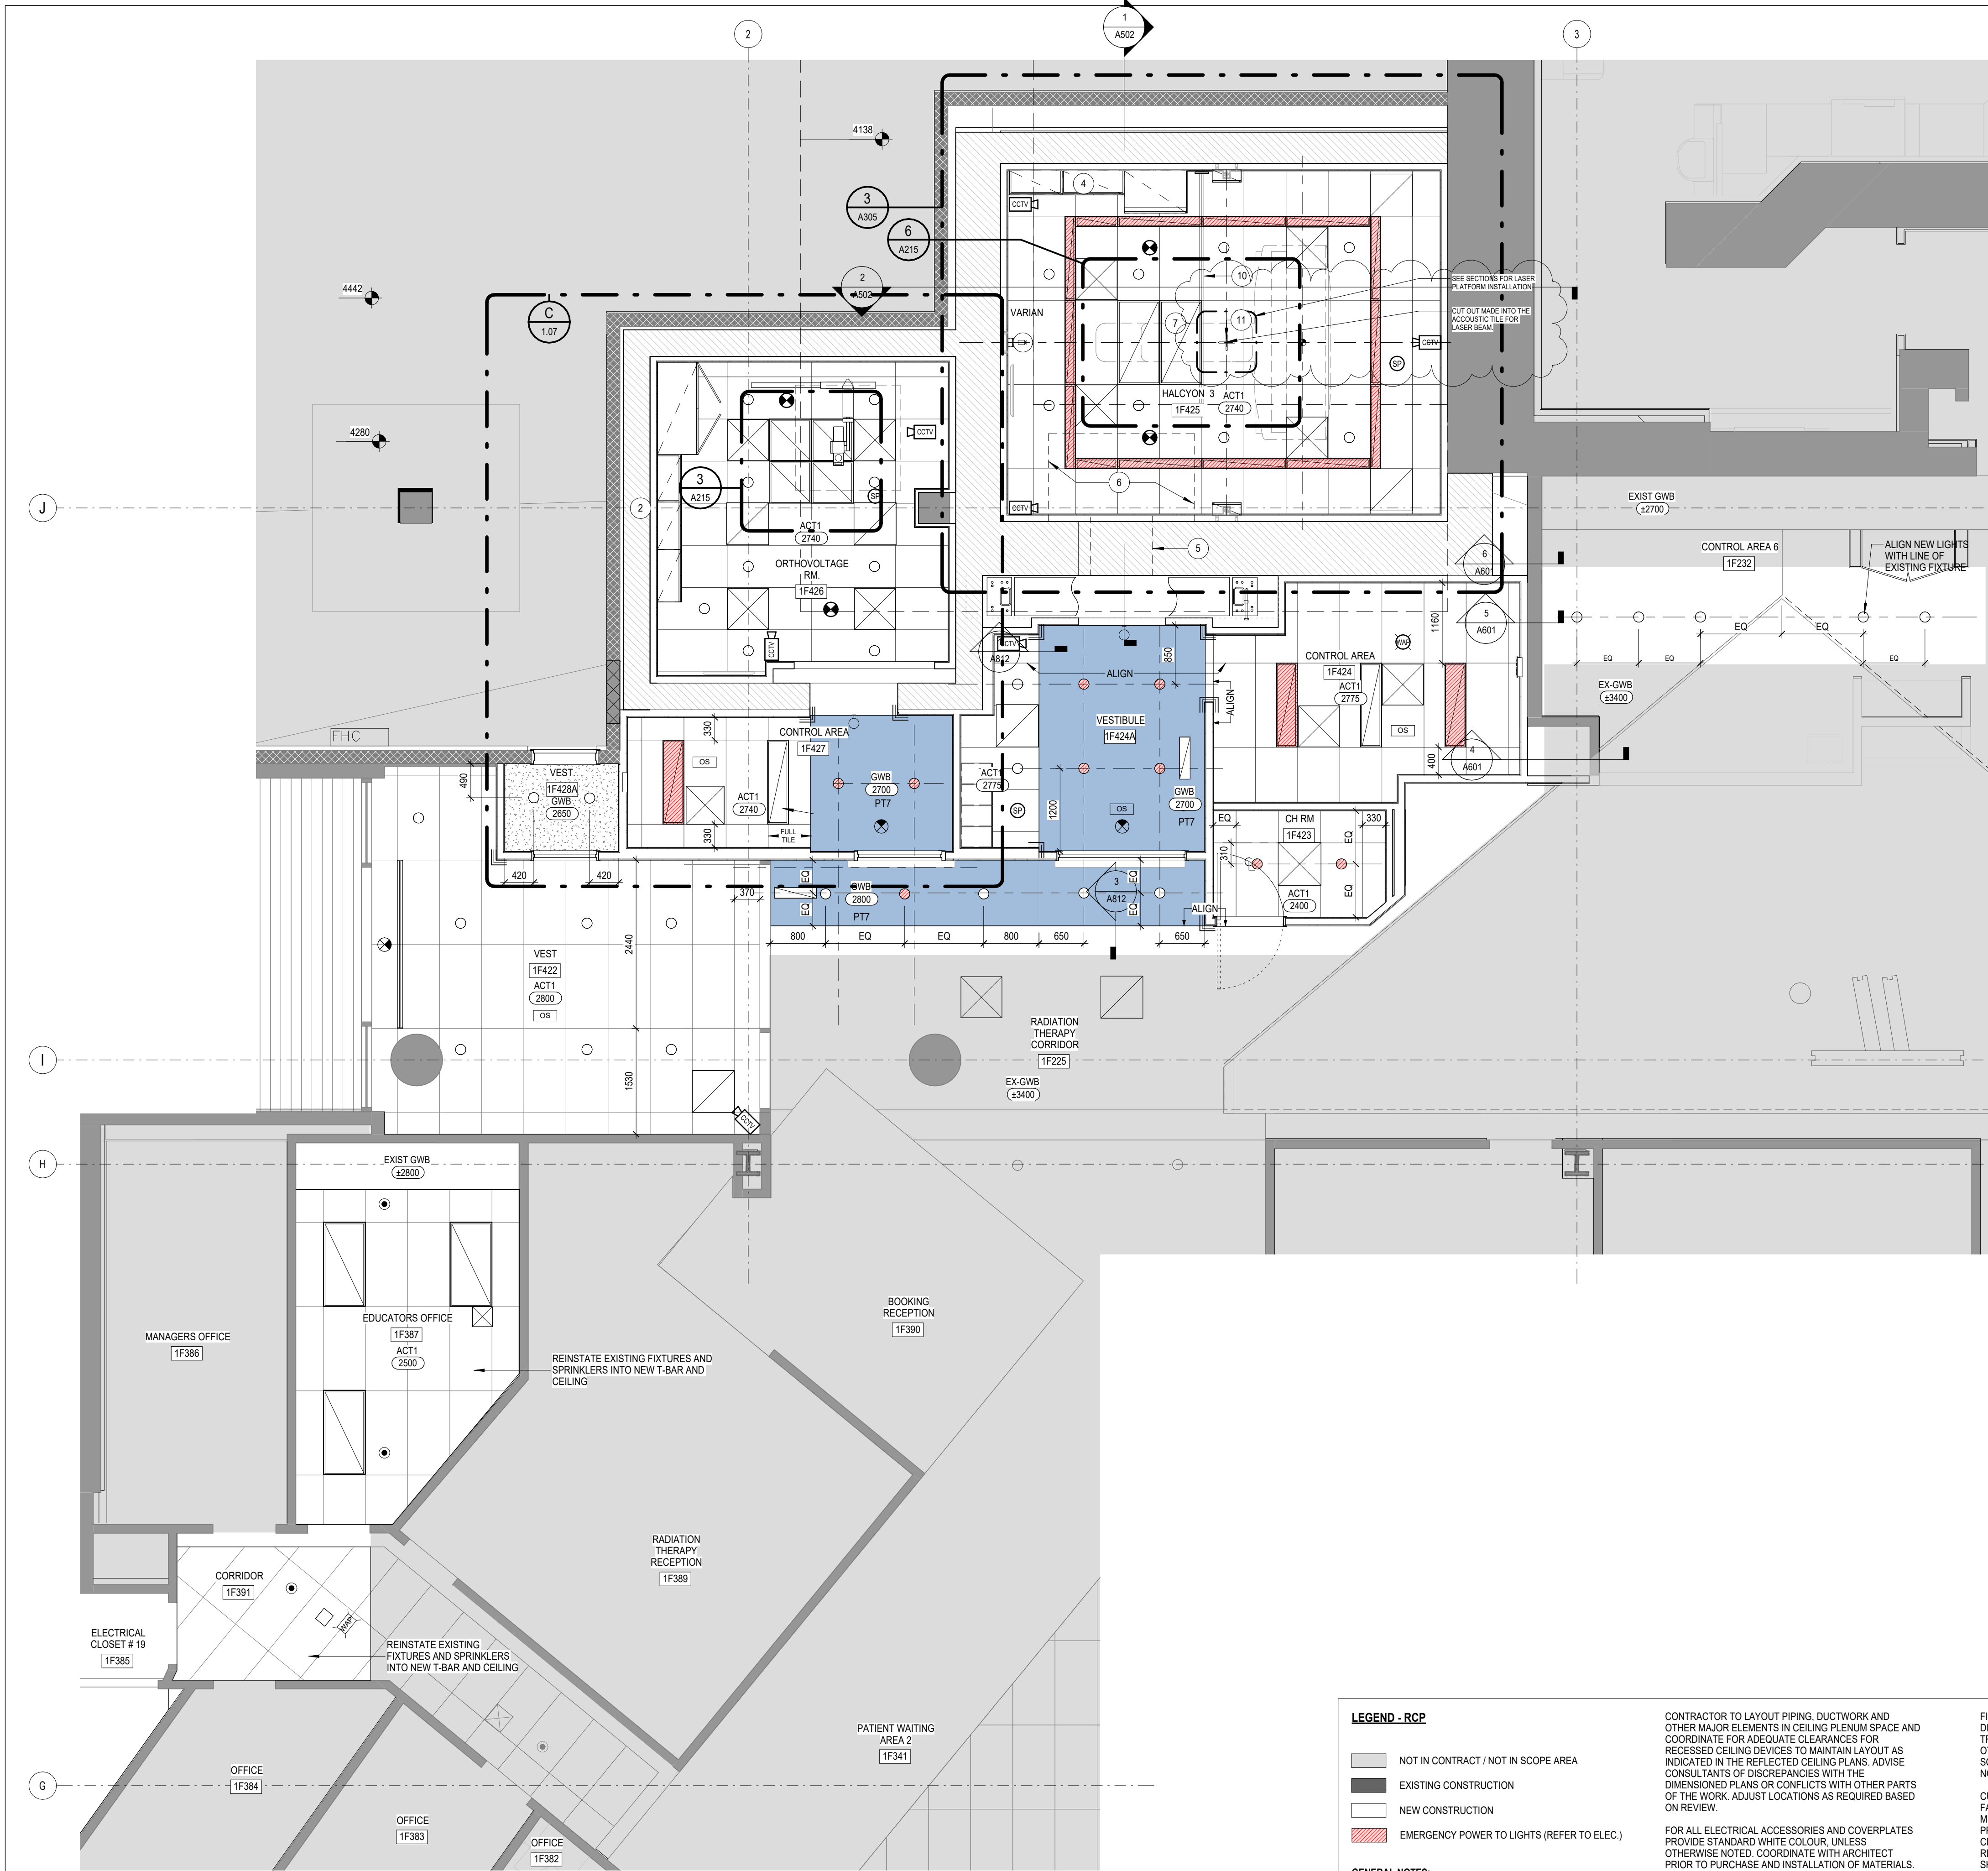

1 RCP - LEVEL 1 Phase 3 (Halcyon 3)
1:50

LEGEND - RCP SYMBOLS

LAY-IN ACT1 ACOUSTIC TILES IN T-BAR GRID SYSTEM. REFER TO FINISH SCHEDULE.

GYPSUM BOARD ON METAL FRAMING AS REQUIRED AND SUSPENDED FROM STRUCTURE.

FEATURE BLUE GYPSUM BOARD ON METAL FRAMING AS REQUIRED AND SUSPENDED FROM STRUCTURE. COLOUR TO BE PT7. REFER TO FINISHES SCHEDULE.

NOTE: ALL ACCESSORIES ON FEATURE CEILING TO BE PAINTED PT7 TO MATCH BLUE GYPSUM BOARD

CEILING FIXTURES/DEVICES LEGEND

NOTE: REFER TO ME DRAWINGS AND SPECIFICATIONS FOR DEVICES.

LIGHTING

CEILING MOUNTED LIGHT FIXTURES.

LIFE SAFETY + COMMUNICATION

SPRINKLER

OCCUPANCY SENSOR

CEILING MOUNTED SMOKE DETECTOR (REFER TO ELECTRICAL)

EMERGENCY VOICE COMMUNICATION SYSTEM

CEILING MOUNTED WIRELESS ACCESS POINT

CEILING MOUNTED EXIT LIGHT WITH DIRECTIONAL ARROW AS INDICATED (REFER TO ELECTRICAL)


CCTV CAMERA

NURSE CALL DOME LIGHT


HVAC

SUPPLY AIR DIFFUSER.

RETURN AIR GRILLE.

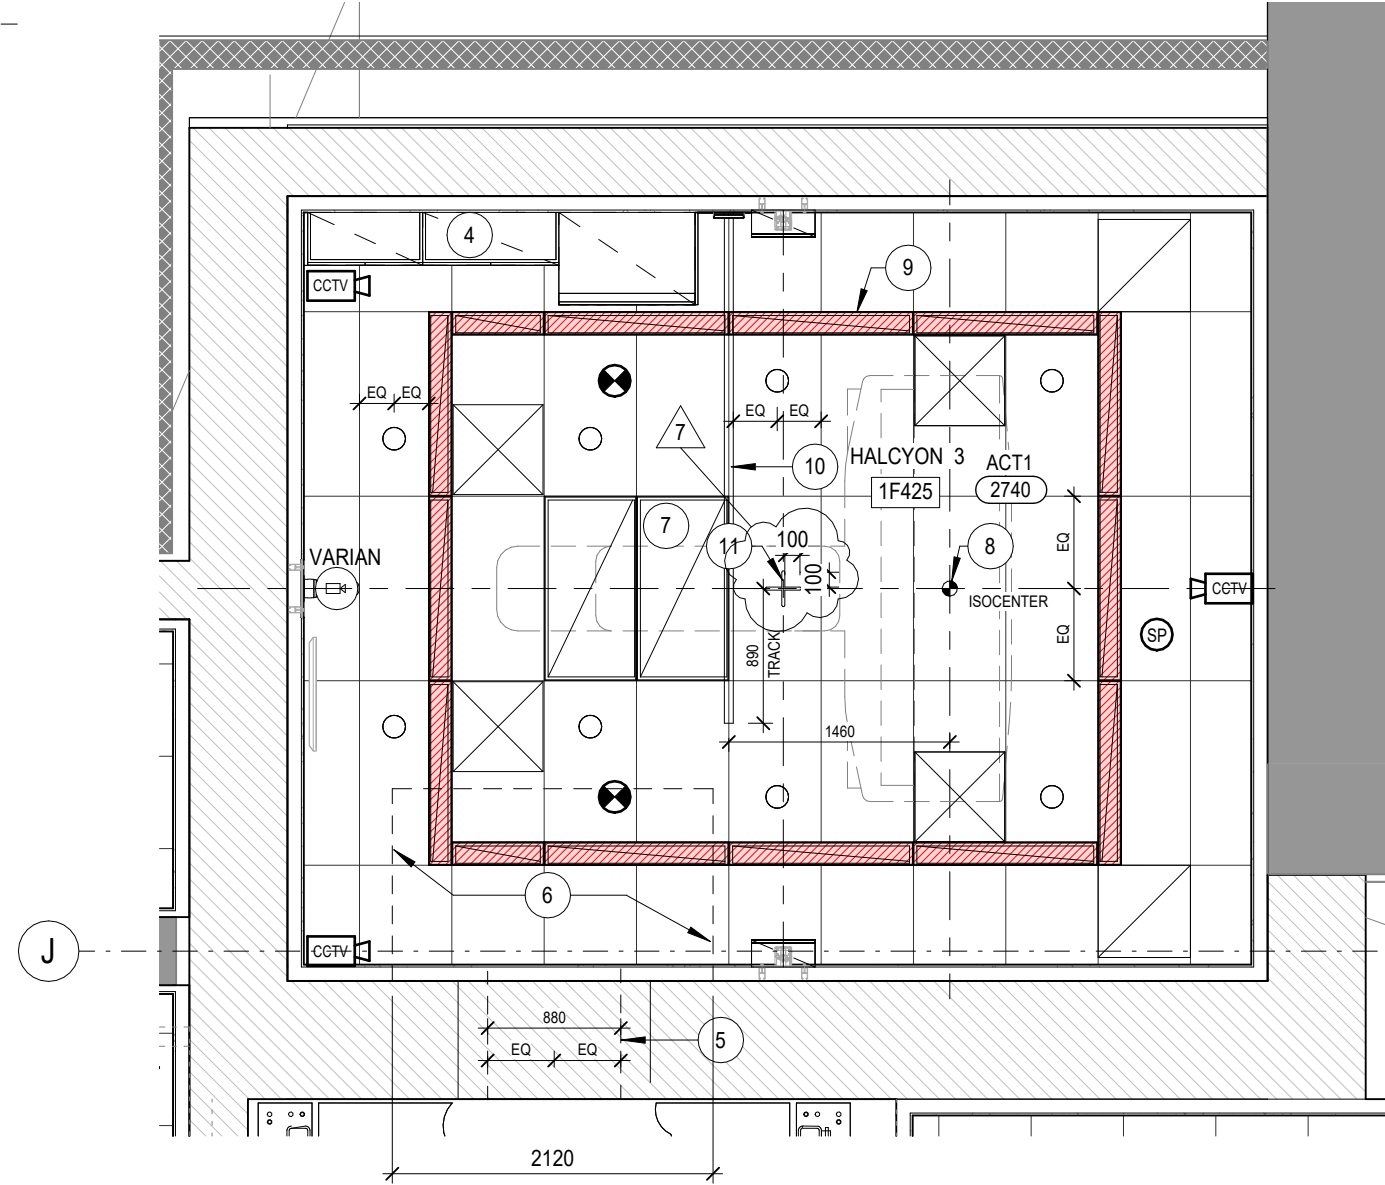

3 RCP - Halcyon 3 Ceiling Layout
1:50

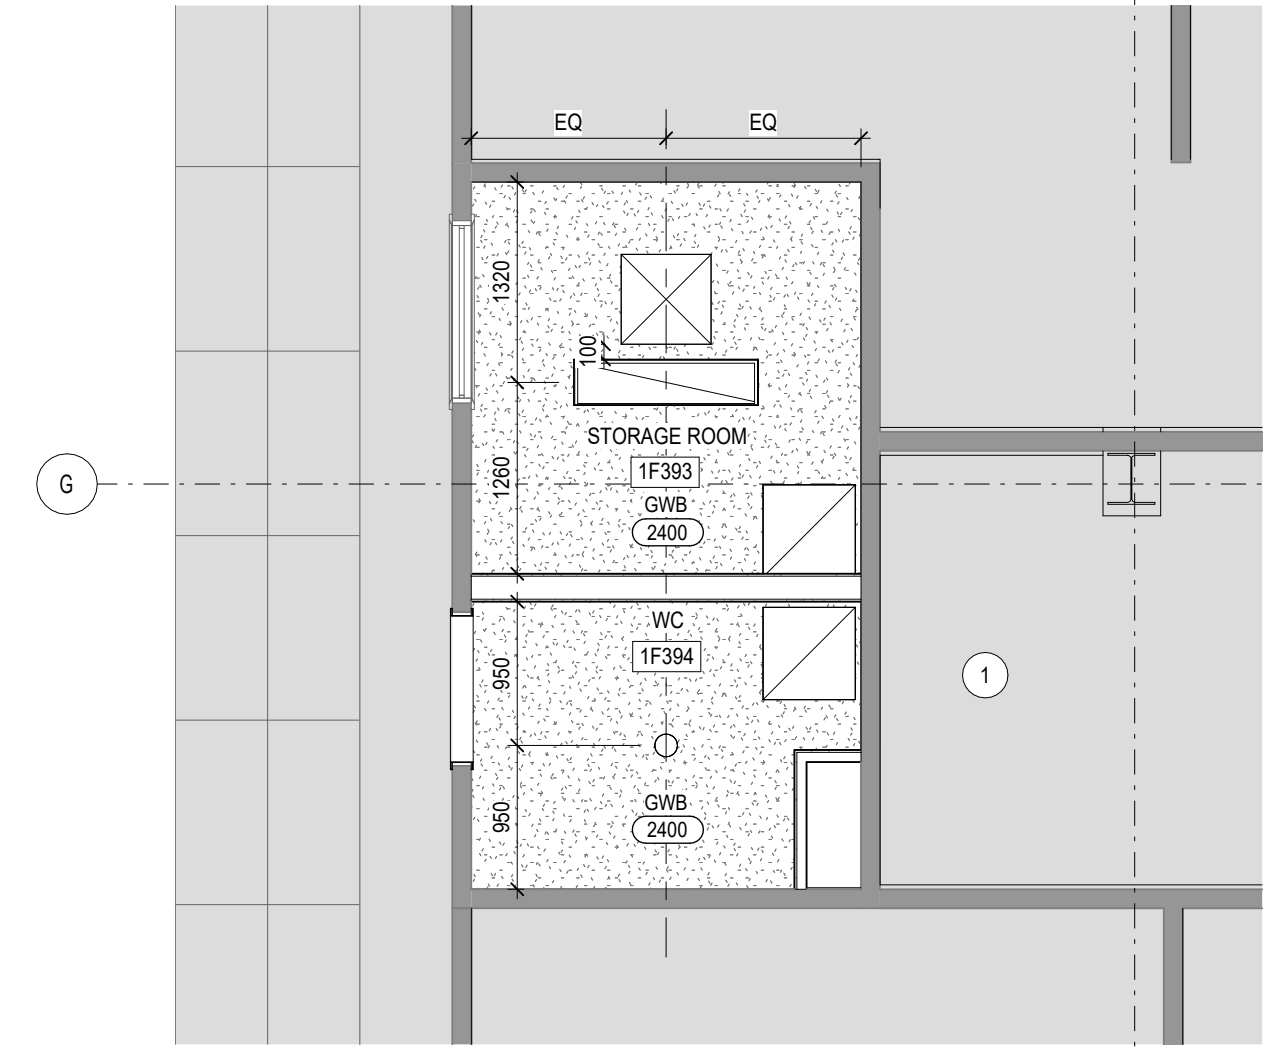

2 RCP LEVEL 1 Phase 3 (Storage & WC)
1:50

LEGEND - RCP

NOT IN CONTRACT / NOT IN SCOPE AREA

EXISTING CONSTRUCTION

NEW CONSTRUCTION

EMERGENCY POWER TO LIGHTS (REFER TO ELEC.)

GENERAL NOTES:

THE REFLECTED CEILING PLAN AND ASSOCIATED ENLARGED CEILING PLANS SHOW LOCATION FOR CRITICAL CEILING COMPONENTS AND DEVICES. NOT ALL CEILING ELEMENTS OF ALL TRADES ARE SHOWN. REFER TO ELECTRICAL, MECHANICAL, COMMUNICATION, AND SECURITY DRAWINGS AS THEY APPLY FOR FULL SCOPE OF WORK AND QUANTITIES.

CONTRACTOR TO LAYOUT PIPING, DUCTWORK AND OTHER MAJOR ELEMENTS IN CEILING PLENUM SPACE AND COORDINATE FOR ADEQUATE CLEARANCES FOR RECESSED CEILING DEVICES TO MAINTAIN LAYOUT AS INDICATED IN THE REFLECTED CEILING PLANS. ADVISE CONSULTANTS OF DISCREPANCIES WITH THE DIMENSIONED PLANS OR CONFLICTS WITH OTHER PARTS OF THE WORK. ADJUST LOCATIONS AS REQUIRED BASED ON REVIEW.

FOR ALL ELECTRICAL ACCESSORIES AND COVERPLATES PROVIDE STANDARD WHITE COLOUR, UNLESS OTHERWISE NOTED. COORDINATE WITH ARCHITECT PRIOR TO PURCHASE AND INSTALLATION OF MATERIALS. NO BLANK PLATES ARE PERMITTED.

LOCATE UNDIMENSIONED SPRINKLER HEADS, SPEAKERS, LIGHT FIXTURES AND OTHER ITEMS IN THE CENTRE OF SUSPENDED ACOUSTIC CEILING TILES UNLESS OTHERWISE NOTED.

FINISH AND COLOUR OF ACCESS PANELS, HVAC DIFFUSERS, REGISTERS, LIGHT FIXTURES, CEILING TRIM, DRAPERY POCKETS, SPEAKER GRILLES AND OTHER CEILING MOUNTED DEVICES TO MATCH SCHEDULED CEILING COLOUR UNLESS OTHERWISE NOTED.

CUT EXISTING GWB CEILINGS AS REQUIRED TO FACILITATE INSTALLATION OF ELECTRICAL OR MECHANICAL SERVICES AND REPAIR CEILINGS TO PRE-EXISTING CONDITIONS. ALLOW FOR SUCH CEILING REPAIRS OF FLOOR LEVEL, BELOW, IF REQUIRED. SCOPE OF SUCH WORK FOR REPAIRS SHALL BE ESTABLISHED AT TIME OF BID AND INCLUDED IN BASE AMOUNT.

VERIFY WITH CONSULTANT THE INSTALLATION HEIGHT OF ALL SUSPENDED OR WALL-MOUNTED LIGHTING FIXTURES PRIOR TO INSTALLATION, WHERE POSSIBLE PROVIDE 'SLACK' SUSPENSION SYSTEM TO ALLOW FOR HEIGHT ADJUSTMENT UPON CONSULTANT REVIEW IN THE FIELD.

- MECHANICAL SERVICE WORK ABOVE
- PATCH & MAKE GOOD EXISTING CEILING AS REQUIRED, (TYP)
- LIGHT COVE TO BE MODIFIED AS REQUIRED AND REINSTATED IN PLACE.
- GWB BULKHEAD OVER MILLWORK, REFER TO DETAIL
- LINE OF SERVICE PENETRATION THROUGH SHIELDING
- LINE OF PENETRATION SHIELDING BY MANUFACTURER. EXACT SIZE TBC.
- VIRTUAL SKYLIGHT LIGHT PANELS, REFER TO ELECTRICAL
- CONTRACTOR TO COORDINATE THE LOCATION OF ISOCENTER ON SITE AND LAYOUT CEILING ACCORDINGLY
- ACCENT COLOURED LIGHTING REFER TO ELECTRICAL
- PATIENT ASSIST TRACK
- RECESSED LASER POSITIONING SYSTEM BY OTHERS

CLIENT:

Trillium Health Partners

2200 Eglinton Avenue West
Mississauga, ON, L5M 2N1
905 813 2200
thp.ca

CONSULTANT:

CUMULUS ARCHITECTS INC.


160 Pears Ave. - Suite 300
Toronto, ON M5R 3P8
416-539-0763
www.cumulusarch.com

SEAL:

This drawing, as an instrument of service, is the property of Cumulus Architects Inc. the copyright in the same being reserved to them. No reproduction is allowed without the permission of Cumulus Architects Inc. and when made must bear its name.

This drawing is not to be scaled. The contractor is to verify dimensions and data noted herein for conformity with the conditions on site and is responsible for reporting in writing any discrepancy to Cumulus Architects Inc. for adjustment.

Cumulus will not be liable for any claims or damages arising from the unauthorized use of this drawing or any portion thereof.

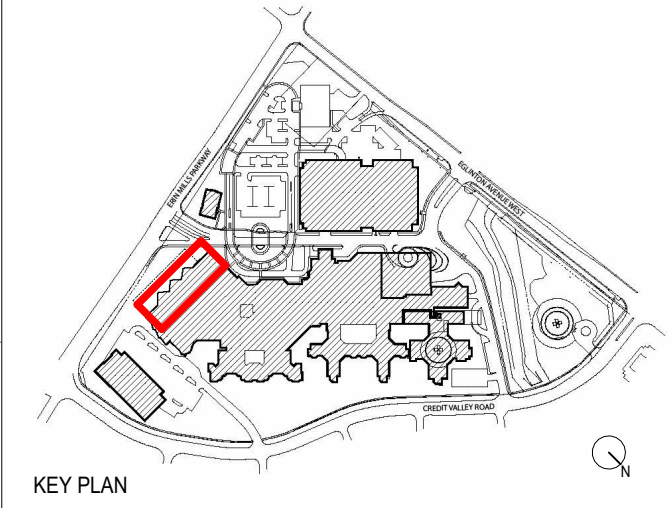

NO	DESCRIPTION	DATE
7	Issued for Addendum 1	2026/02/04
6	Issued for Tender	2025/12/16
5	Issued for Building Permit	2025/12/02
4	Issued For MOH 2.3 Resubmission	2025/06/20
2	Issued For MOH 2.3 Costing	2024/09/13
NO		

SHEET REVISION





PROJECT:
Oncology Radiation Treatment Expansion
2200 Eglinton Ave W,
Mississauga, ON L5M 2N1

TITLE:
**REFLECTED CEILING PLAN
PHASE 3**

PROJECT NO:
23010

CHECKED:
Checker

DRAWING NO:
A305

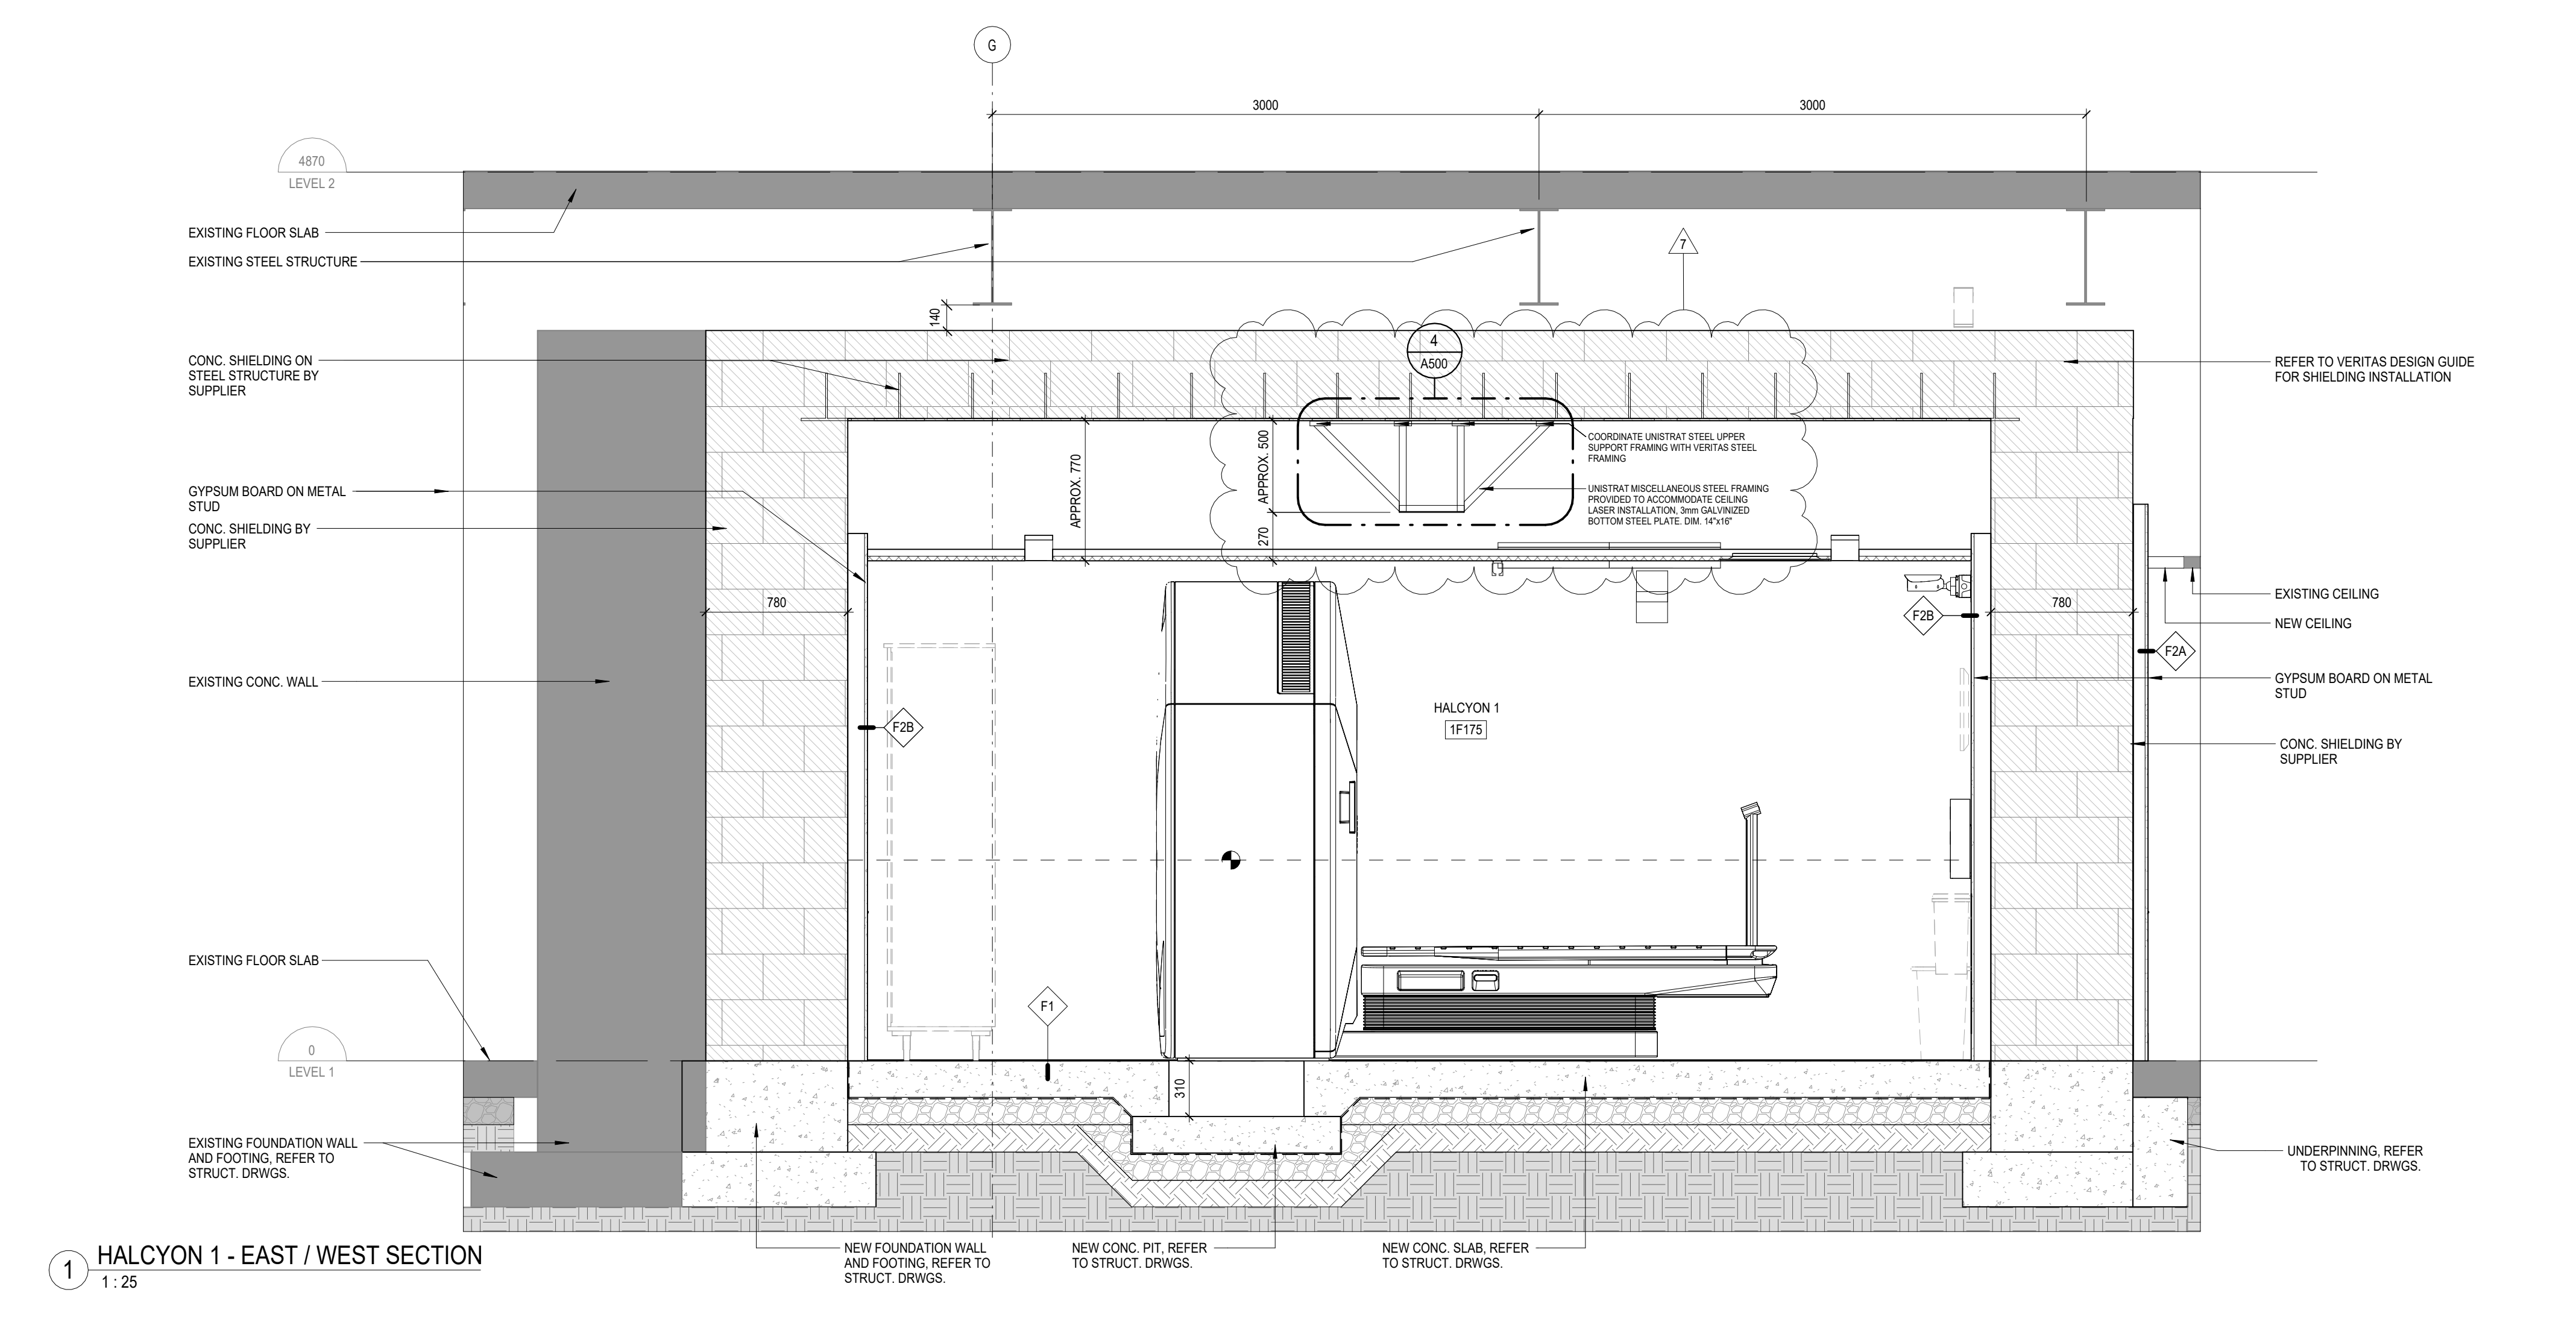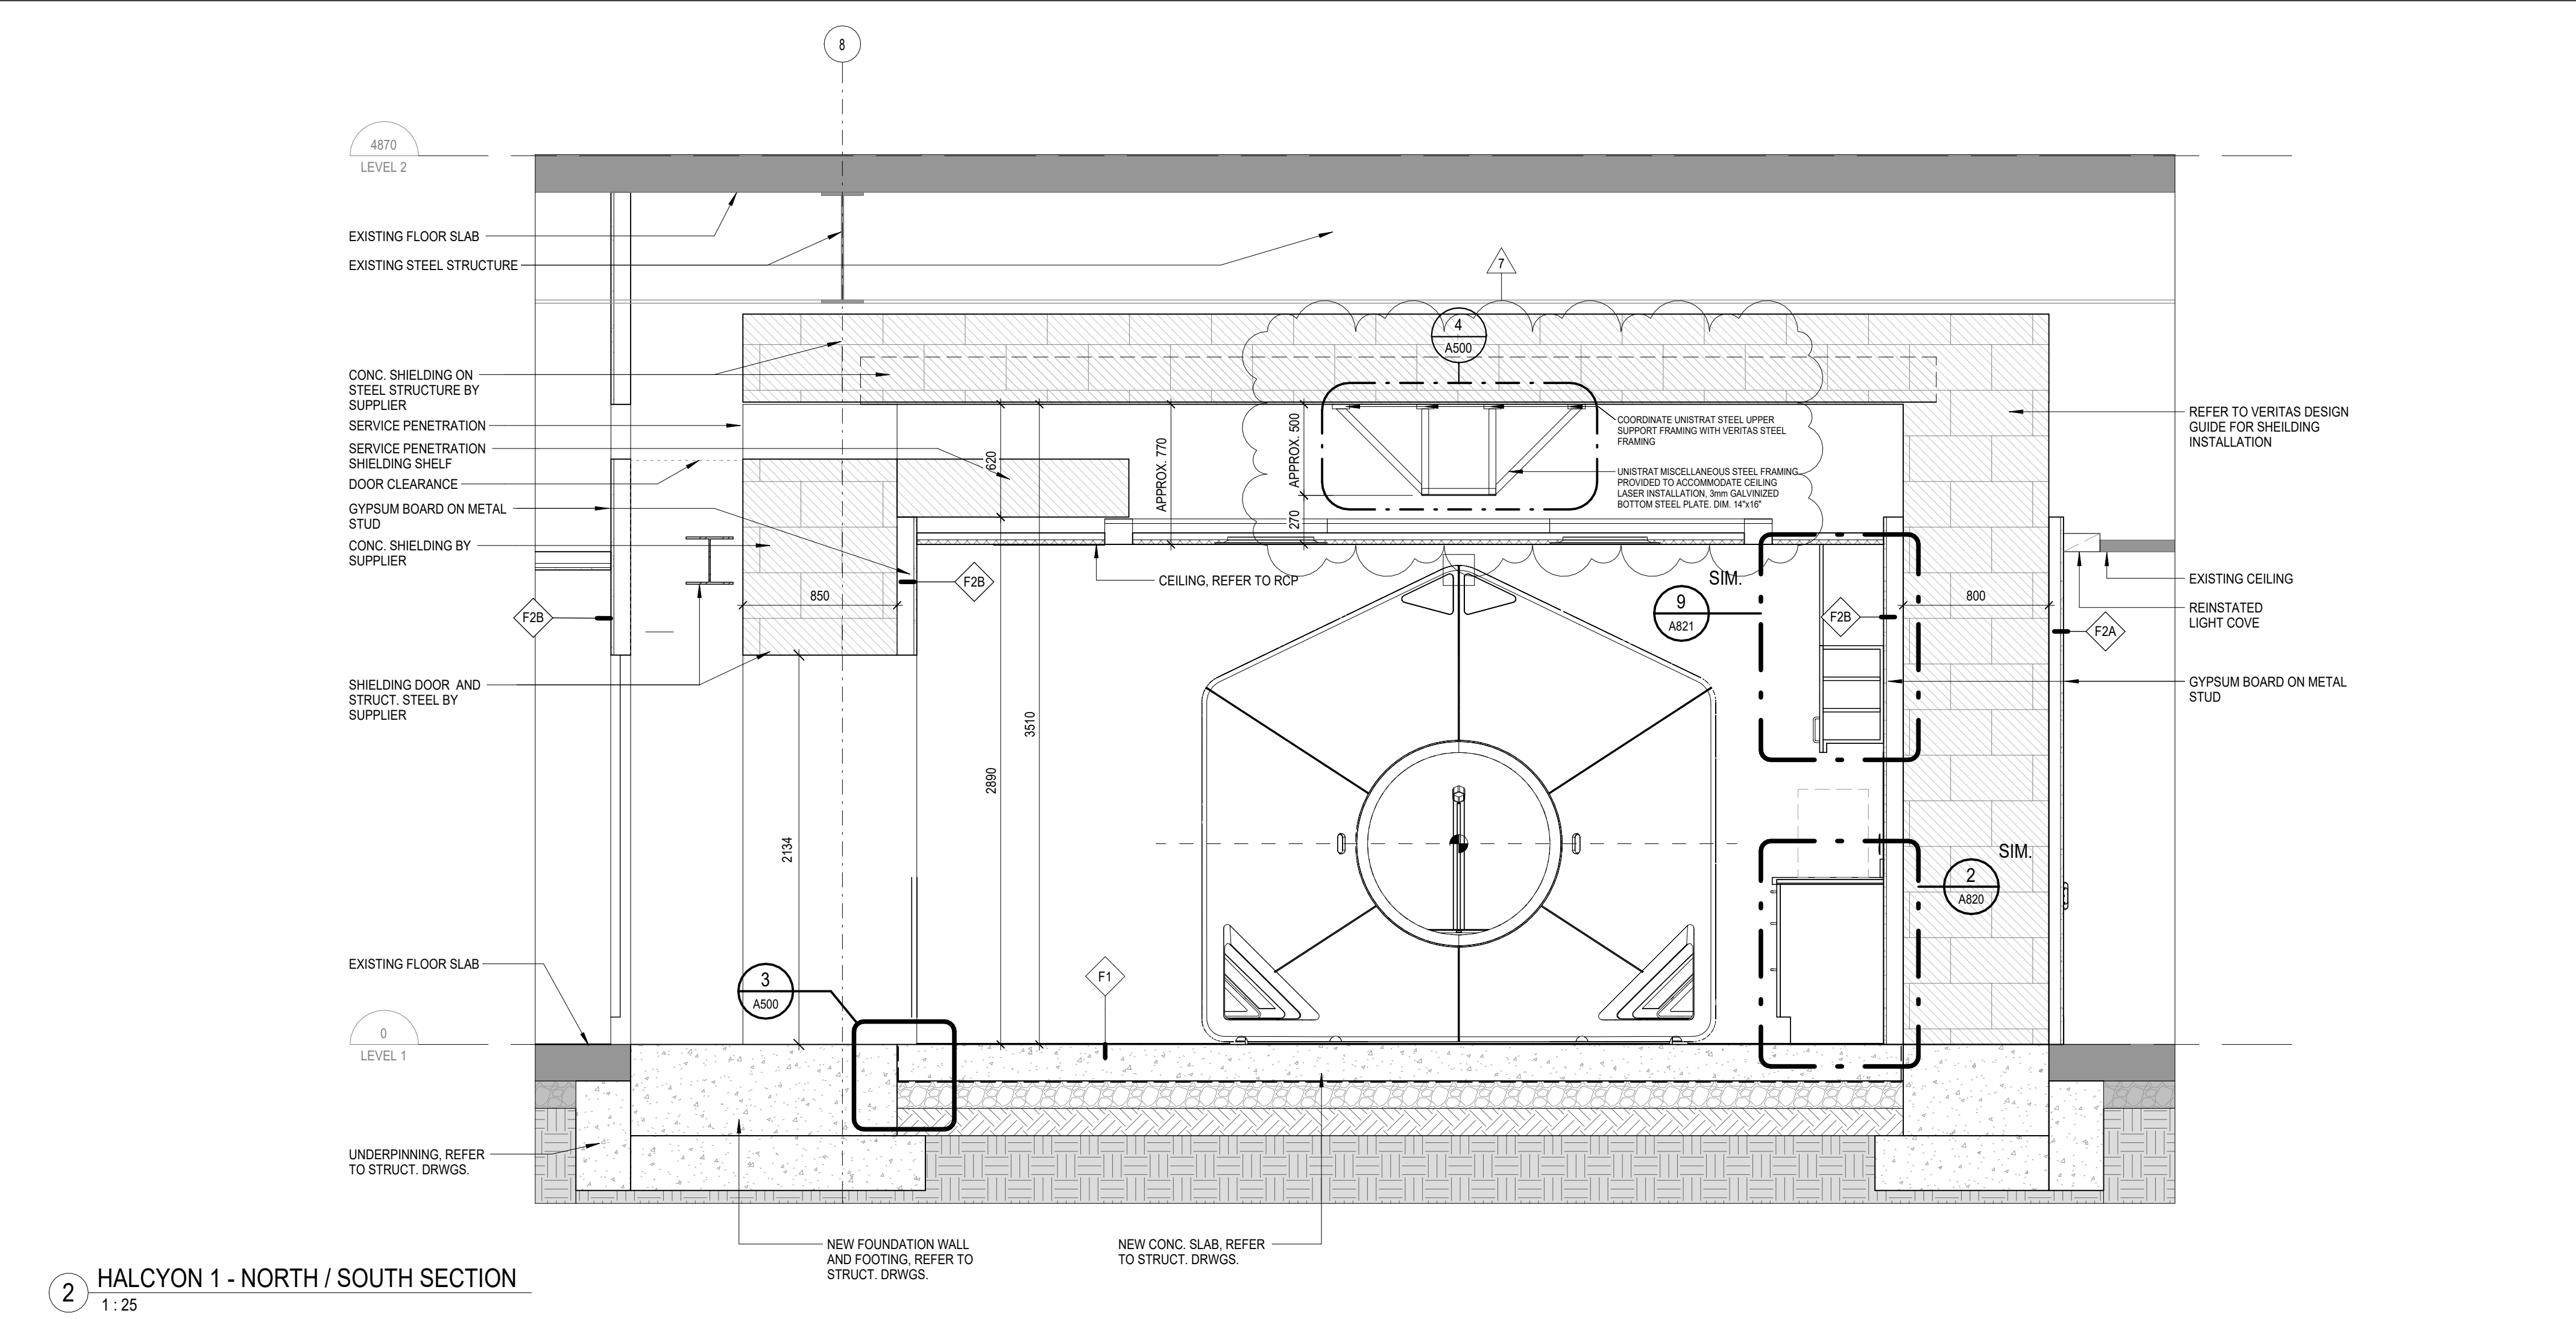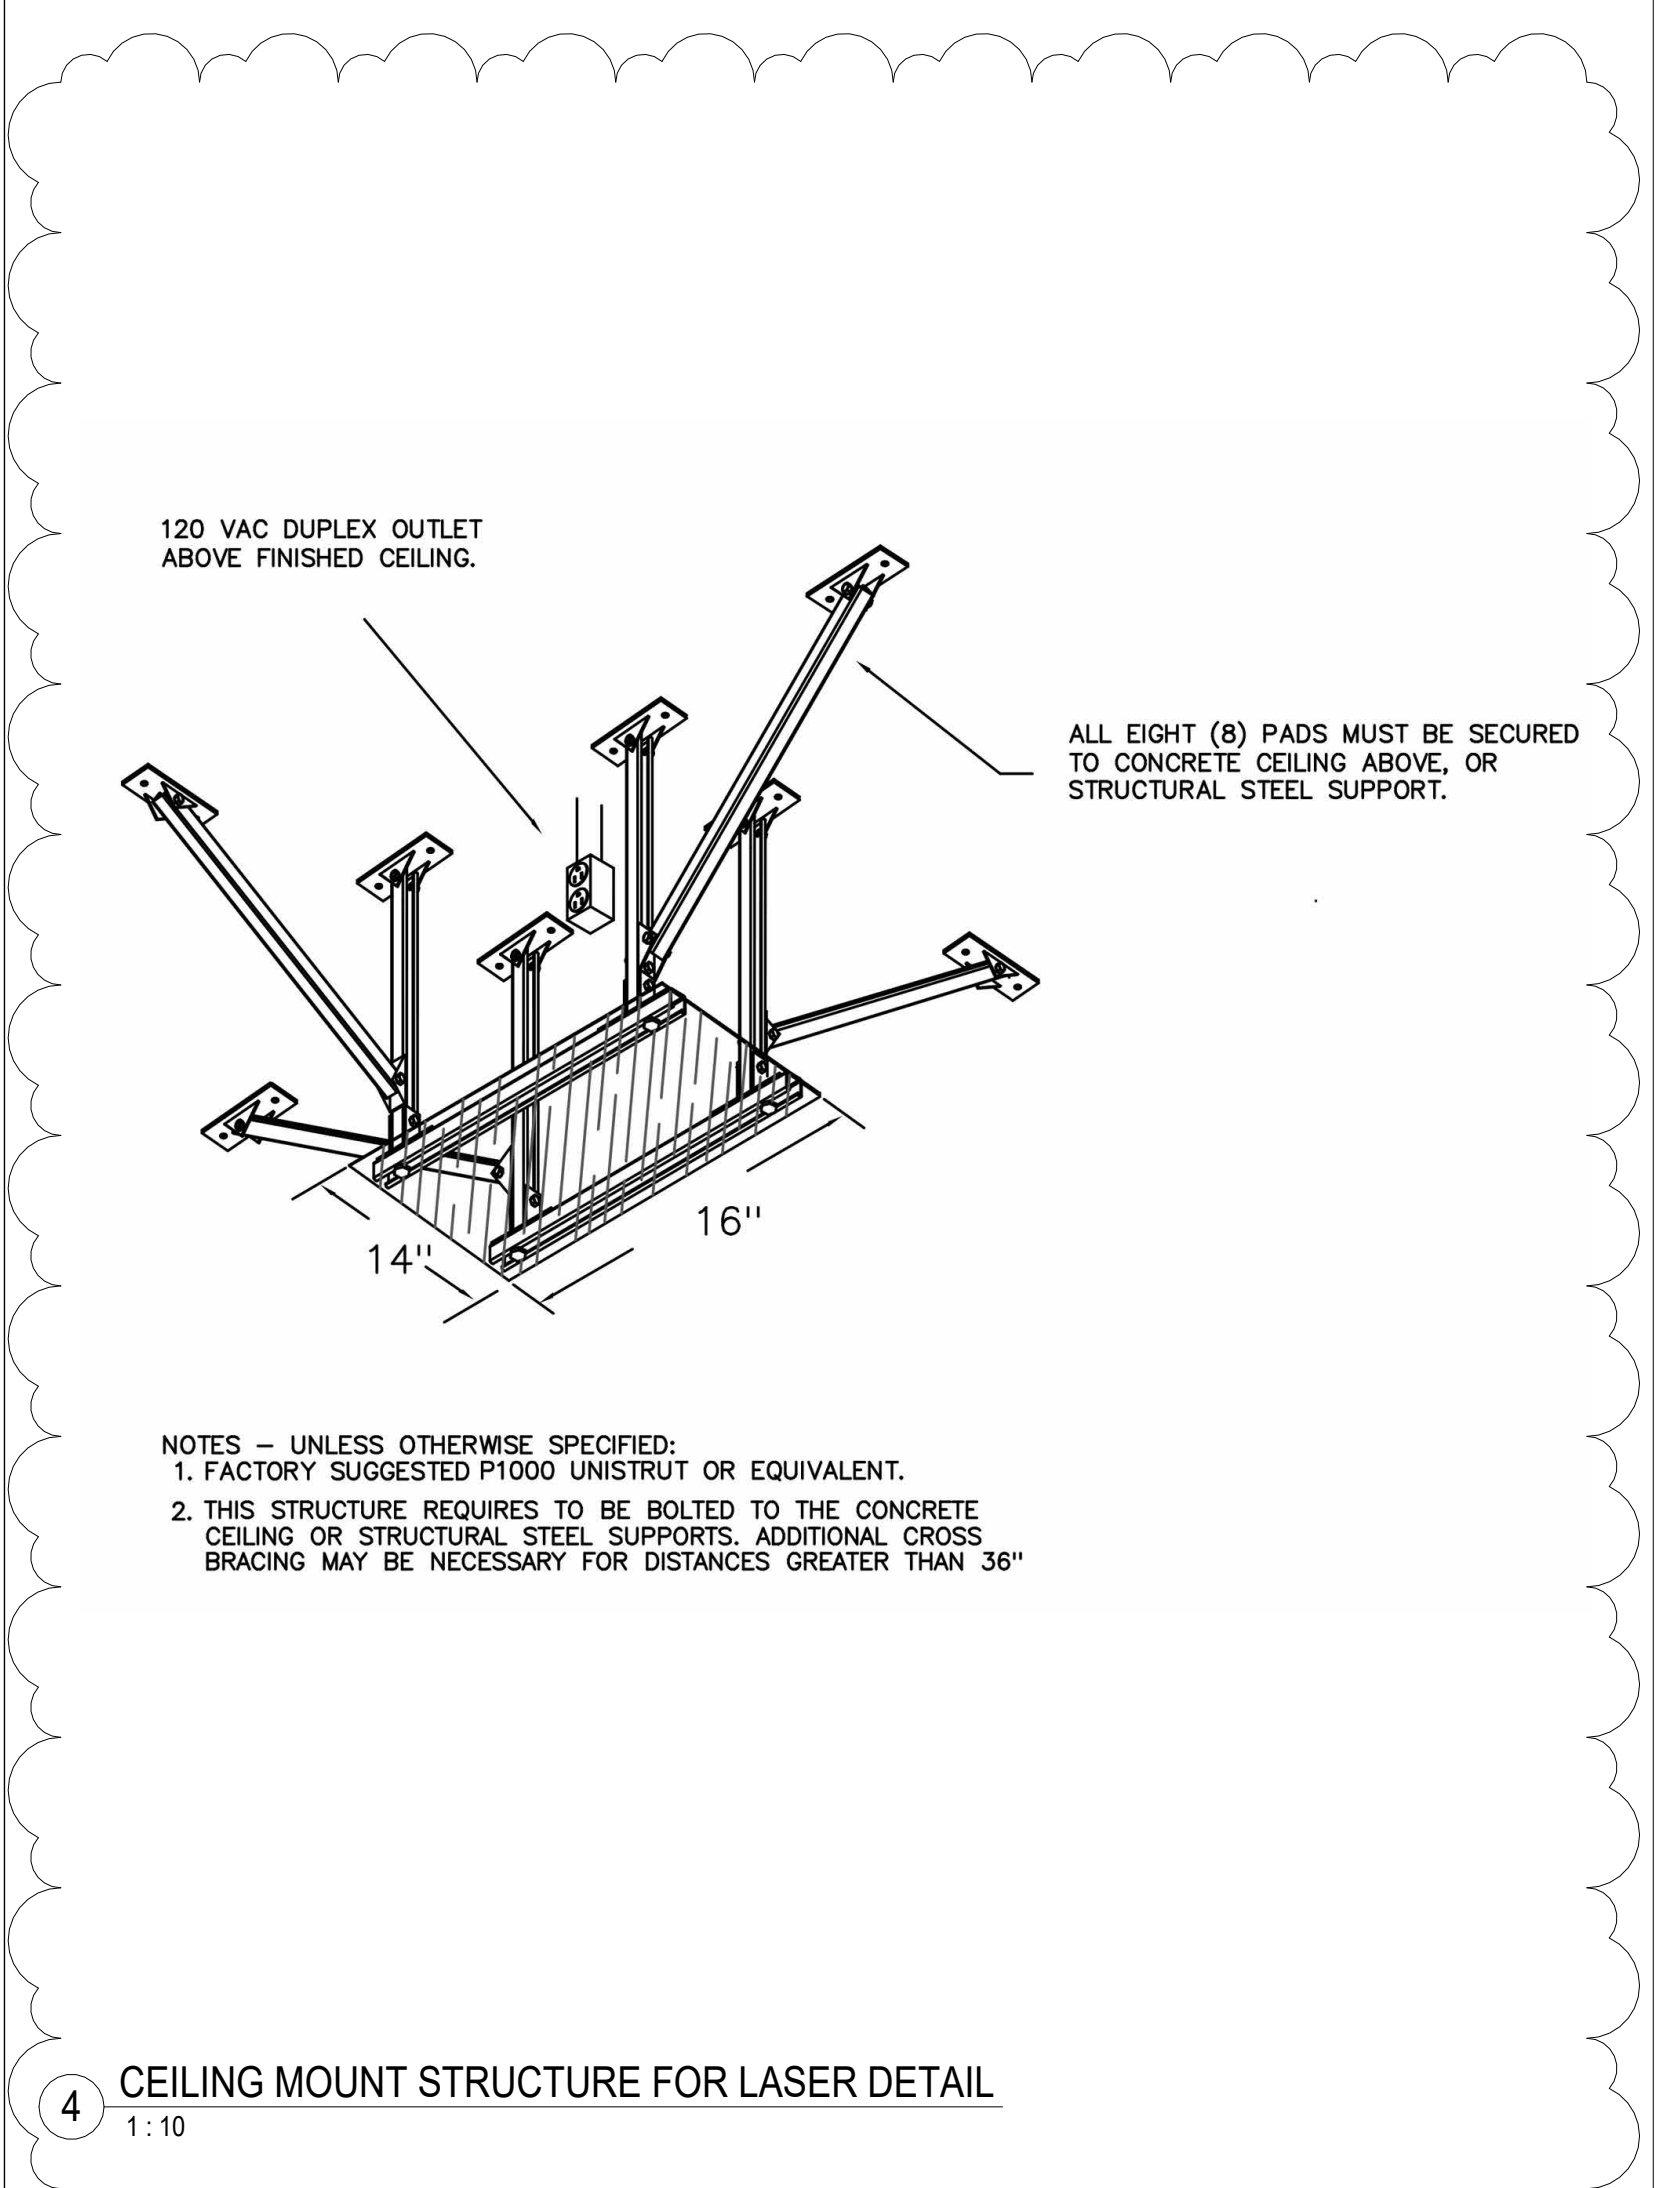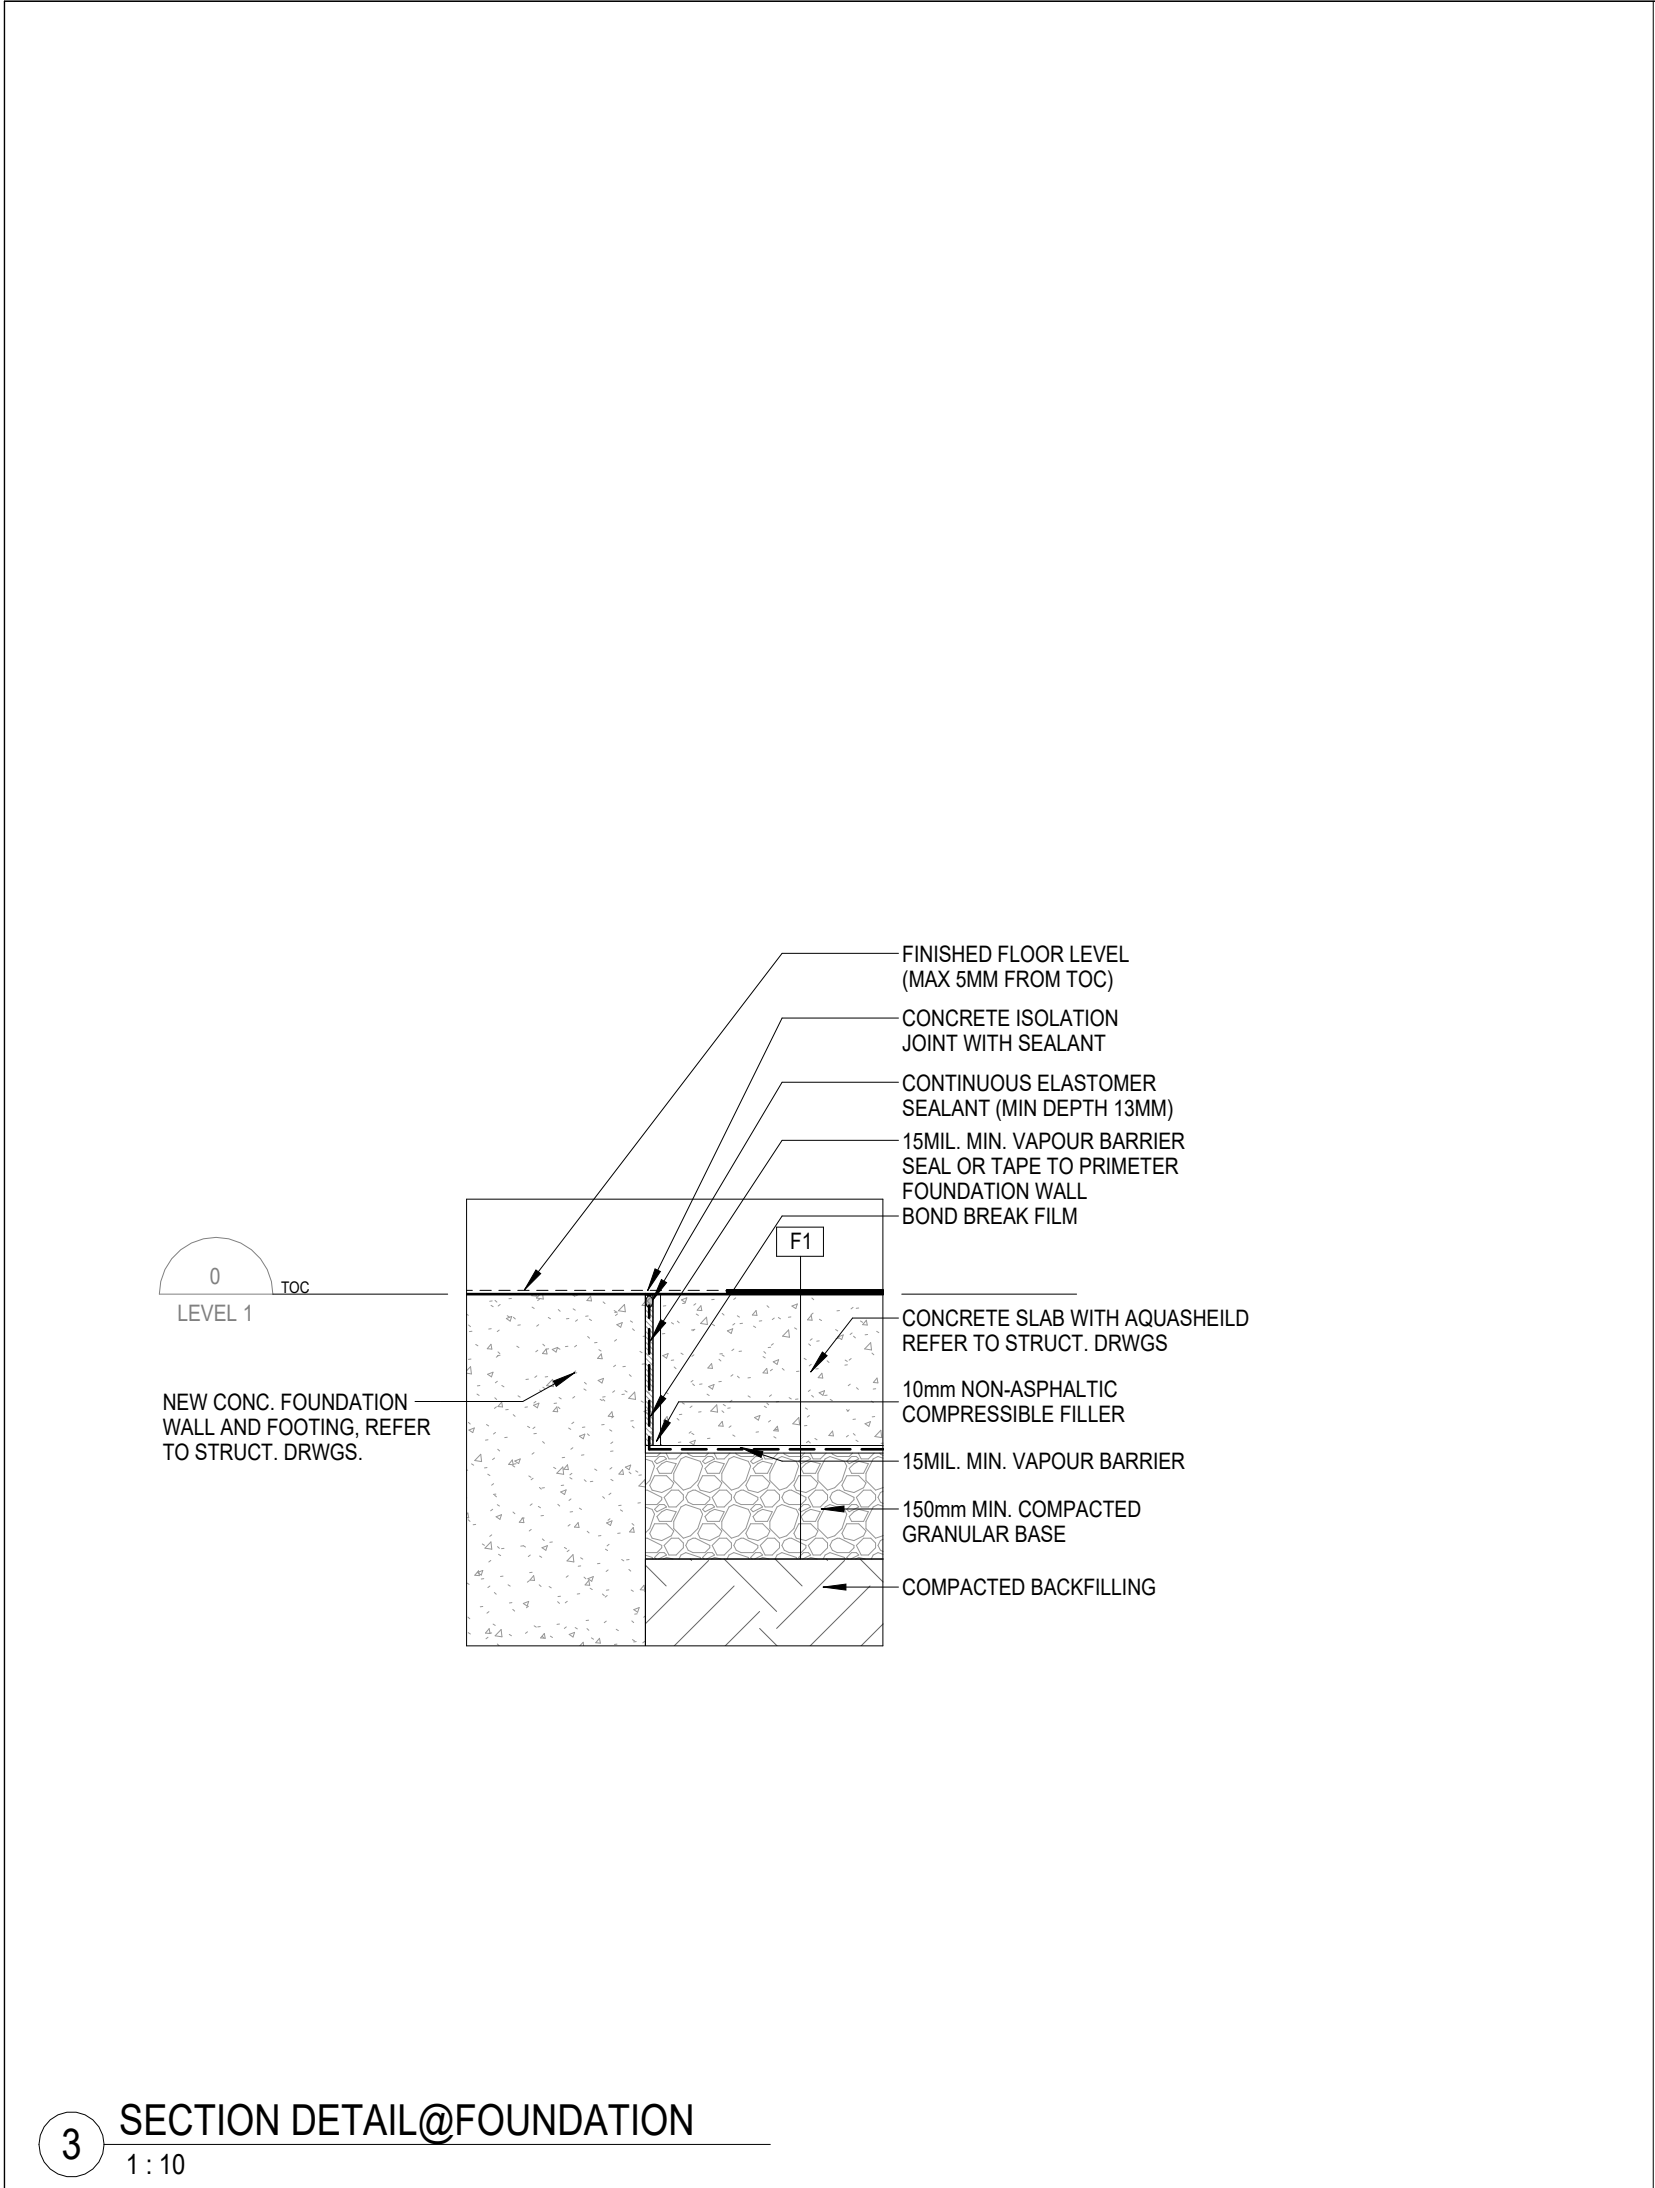

CLIENT:

2200 Eglinton Avenue West
Mississauga, ON, L5M 2N1
905 813 2200
thp.ca

CONSULTANT:

160 Pears Ave. - Suite 300
Toronto, ON M5R 3P8
416-539-0763
www.cumulusarch.com

SEAL:

This drawing, as an instrument of service, is the property of Cumulus Architects Inc. the copyright in the same being reserved to them. No reproduction is allowed without the permission of Cumulus Architects Inc. and when made must bear its name.

This drawing is not to be scaled. The contractor is to verify dimensions and data noted herein for conformity with the conditions on site and is responsible for reporting in writing any discrepancy to Cumulus Architects Inc. for adjustment.

Cumulus will not be liable for any claims or damages arising from the unauthorized use of this drawing or any portion thereof.

KEY PLAN

NO	DESCRIPTION	DATE
7	Issued for Addendum 1	2026/02/04
6	Issued for Tender	2025/12/16
5	Issued for Building Permit	2025/12/02
4	Issued For MOH 2.3 Resubmission	2025/06/20
2	Issued For MOH 2.3 Costing	2024/09/13
1	Issued For MOH 1.3/2.1/2.2	2023/10/18

PROJECT:

Oncology Radiation Treatment Expansion
2200 Eglinton Ave W,
Mississauga, ON L5M 2N1

TITLE:

HALCYON ROOM 1 SECTIONS

PROJECT NO:


23010

CHECKED:


Checker

DRAWING NO:

A500

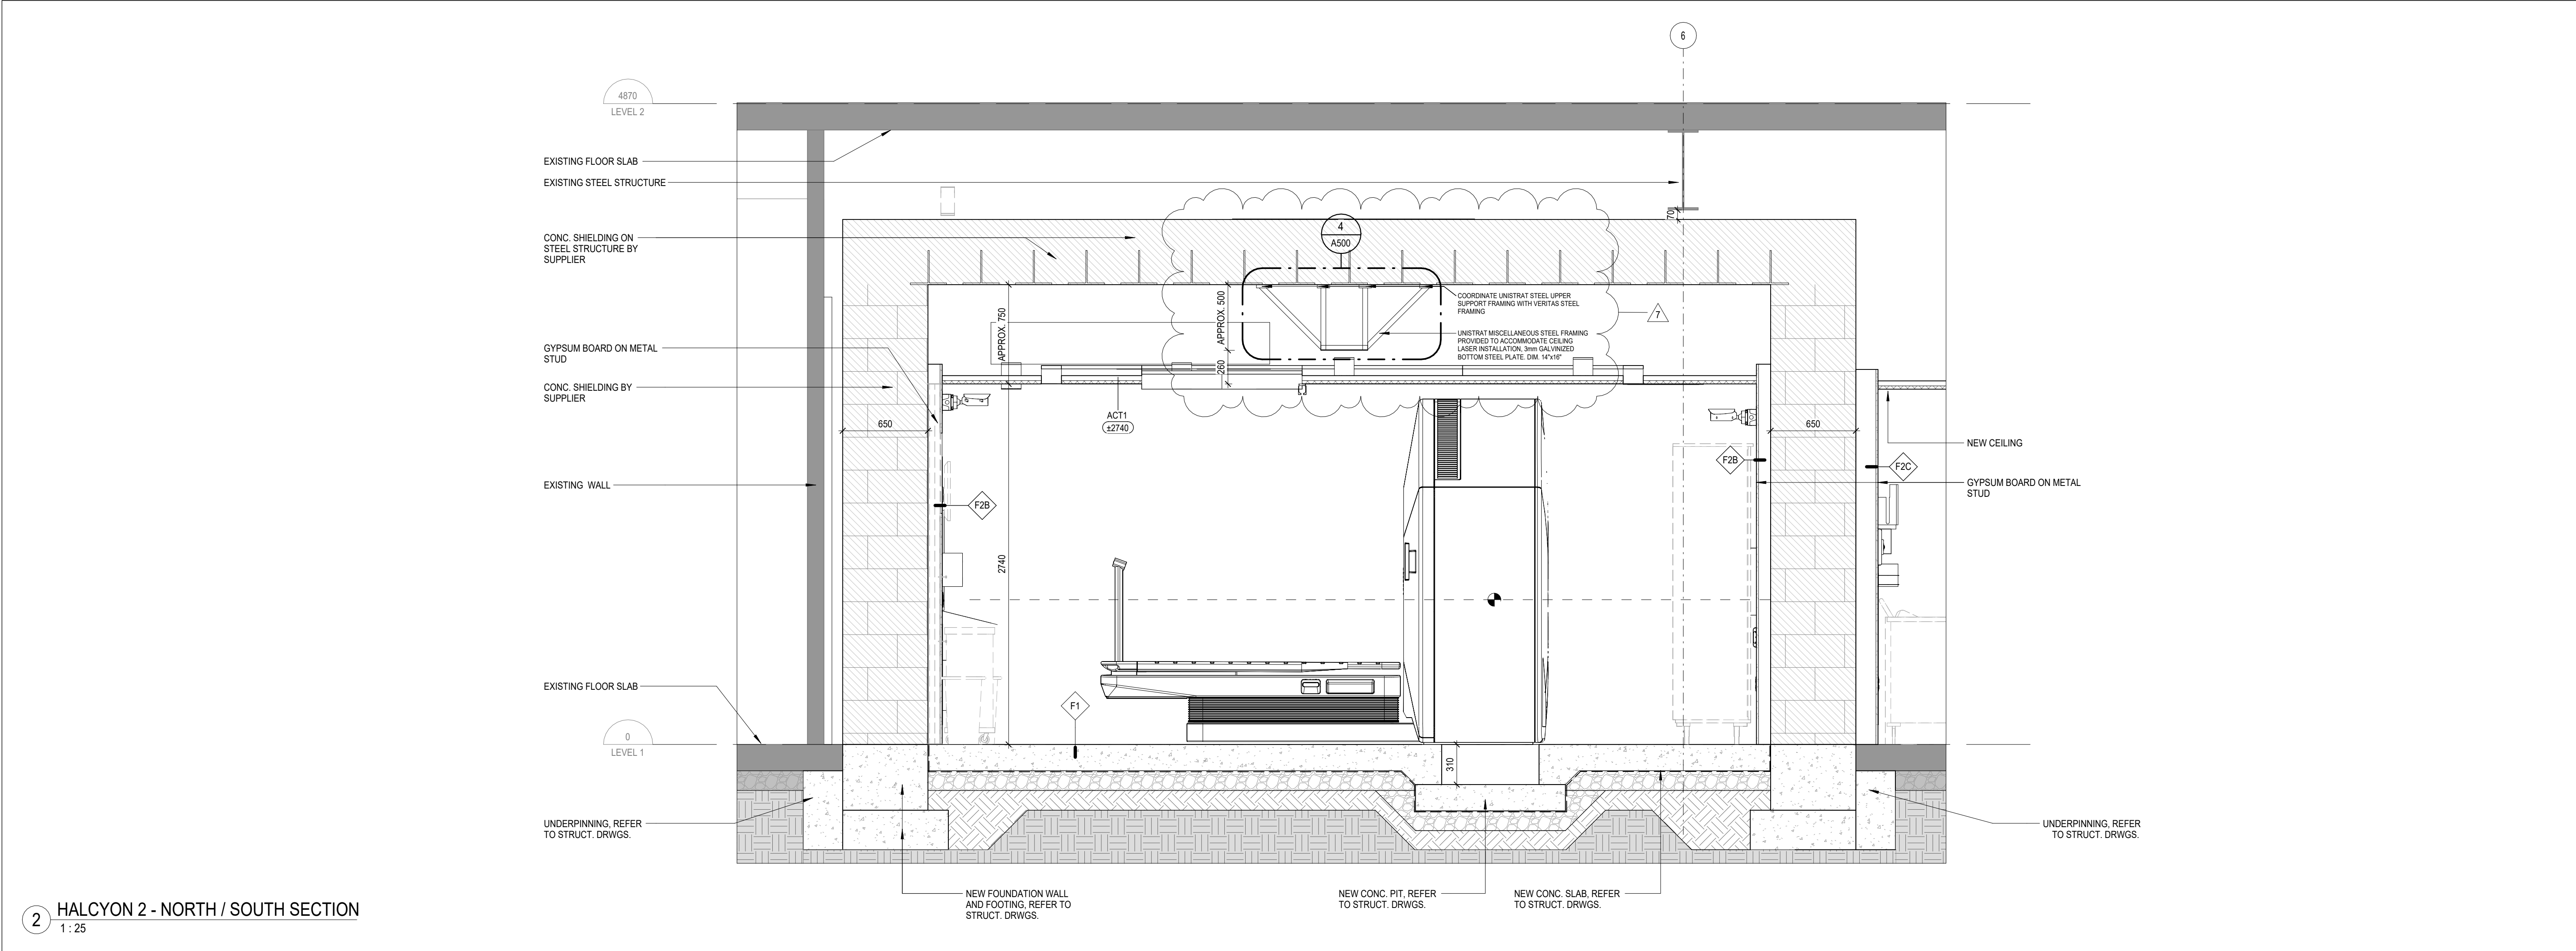


2 HALCYON 2 - NORTH / SOUTH SECTION
1 : 25

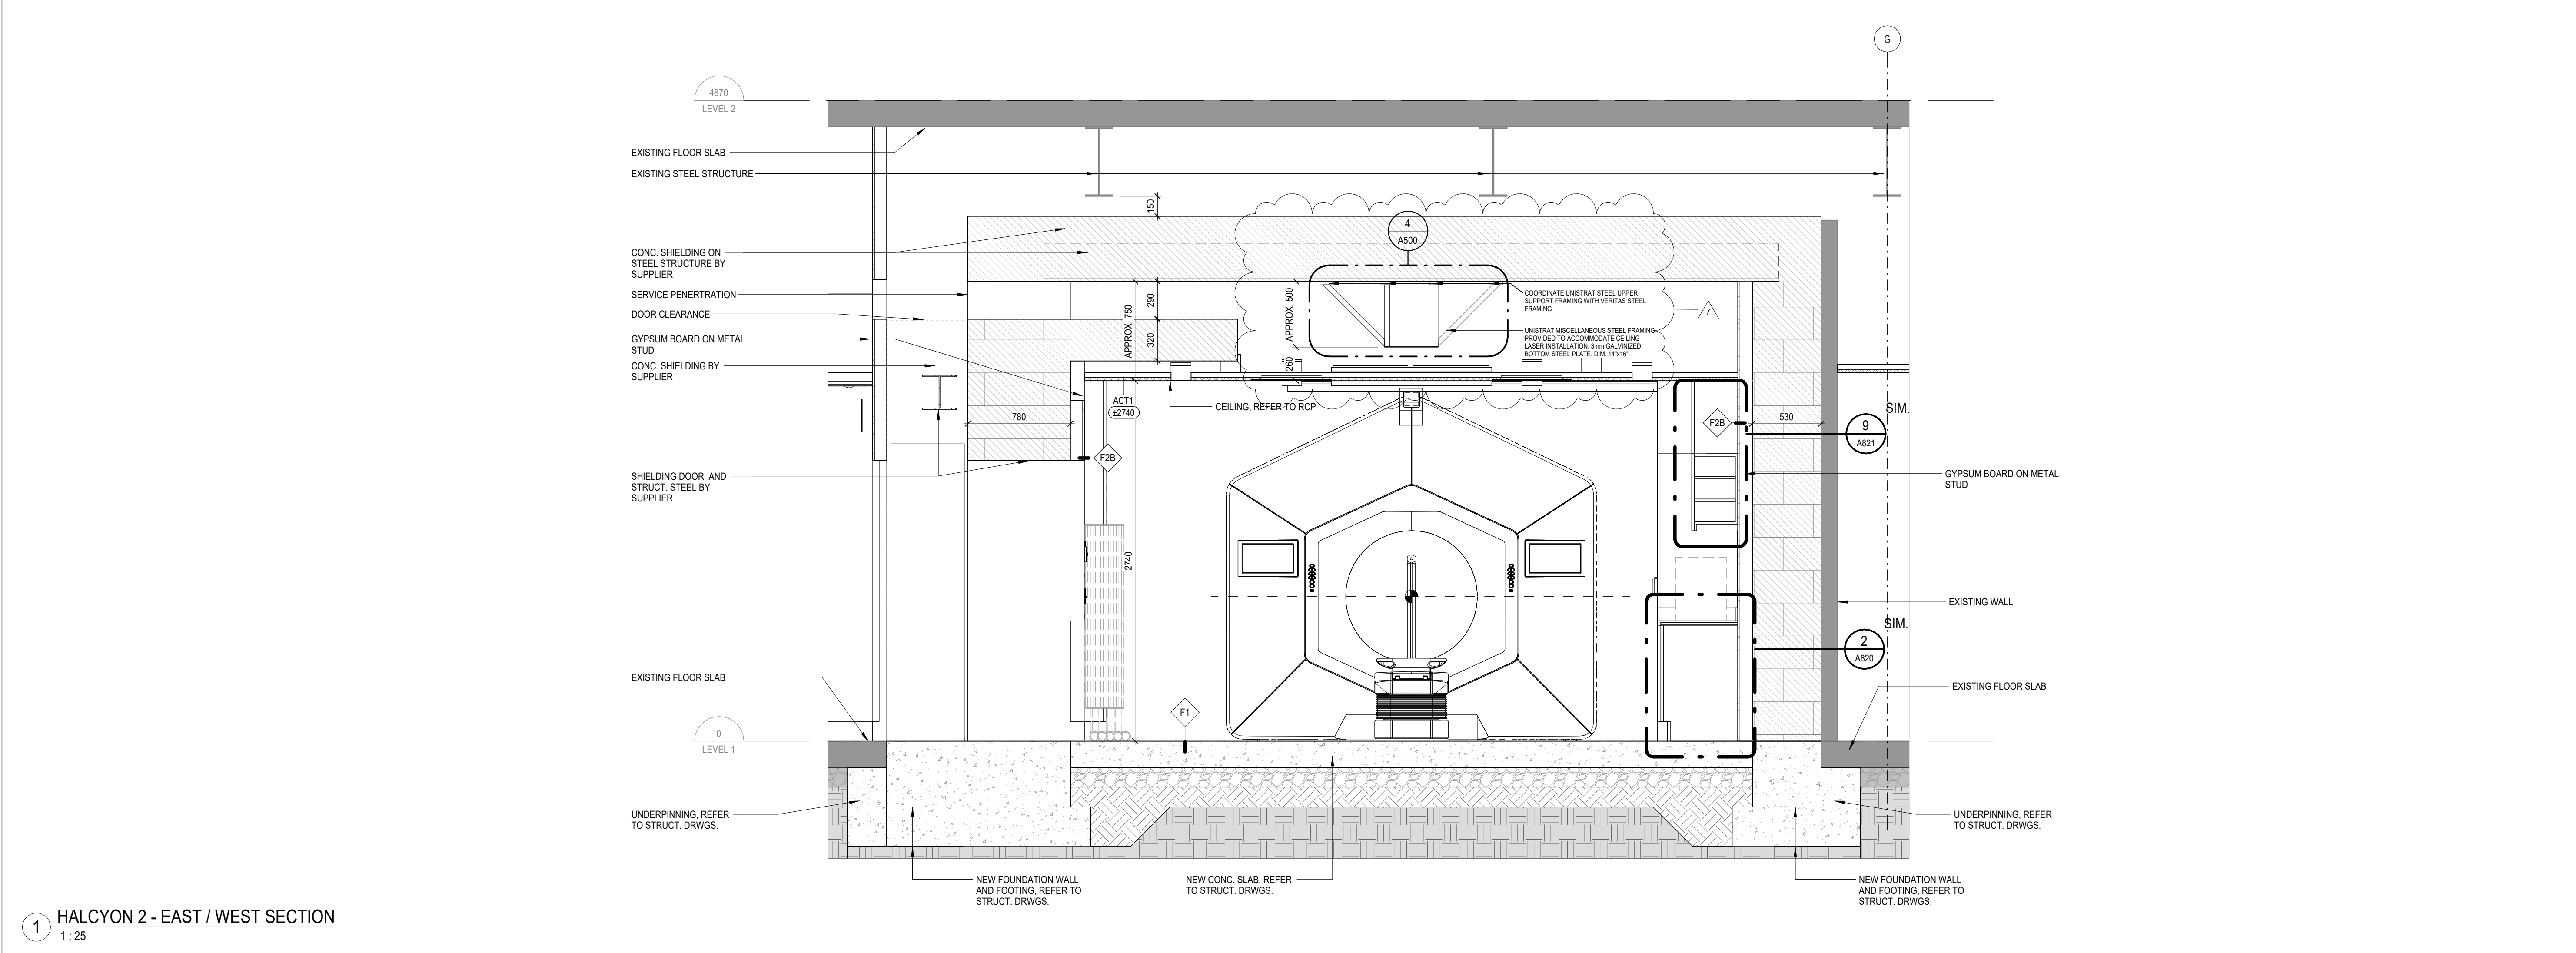


1 HALCYON 2 - EAST / WEST SECTION
1 : 25

CLIENT:

 2200 Eglinton Avenue West
Mississauga, ON L5M 2N1
905 813 2200
thp.ca

CONSULTANT:


 160 Pears Ave. - Suite 300
Toronto, ON M5R 3P8
416-539-0763
www.cumulusarch.com

SEAL:

This drawing, as an instrument of service, is the property of Cumulus Architects Inc. the copyright in the same being reserved to them. No reproduction is allowed without the permission of Cumulus Architects Inc. and when made must bear its name.

This drawing is not to be scaled. The contractor is to verify dimensions and data noted herein for conformity with the conditions on site and is responsible for reporting in writing any discrepancy to Cumulus Architects Inc. for adjustment.

Cumulus will not be liable for any claims or damages arising from the unauthorized use of this drawing or any portion thereof.

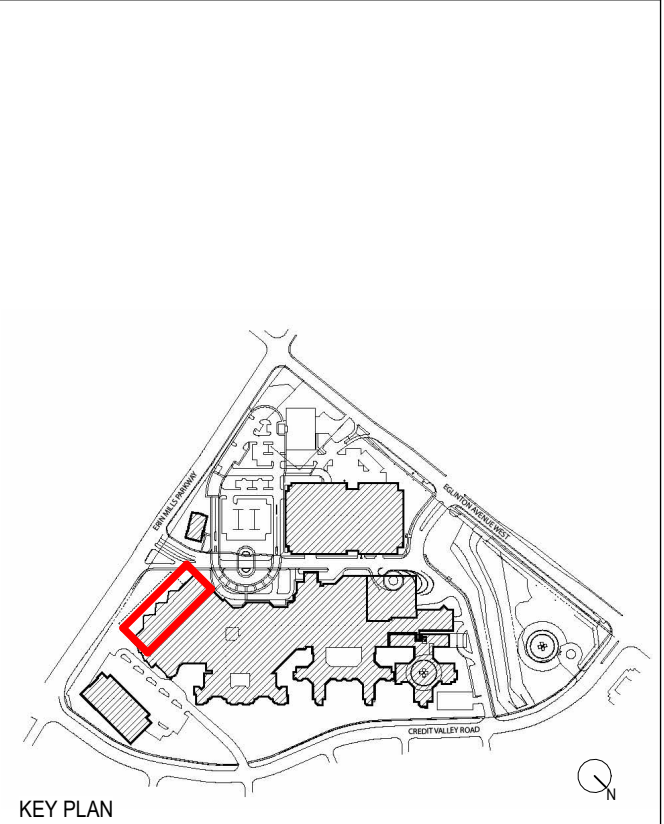

KEY PLAN

NO	DESCRIPTION	DATE
7	Issued for Addendum 1	2026/02/04
6	Issued for Tender	2025/12/16
5	Issued for Building Permit	2025/12/02
4	Issued For MOH 2.3 Resubmission	2025/06/20
2	Issued For MOH 2.3 Costing	2024/09/13


PROJECT:
Oncology Radiation Treatment Expansion
2200 Eglinton Ave W,
Mississauga, ON L5M 2N1

TITLE:
HALCYON ROOM 2 SECTIONS


PROJECT NO:
23010

CHECKED:
Checker

DRAWING NO:
A501

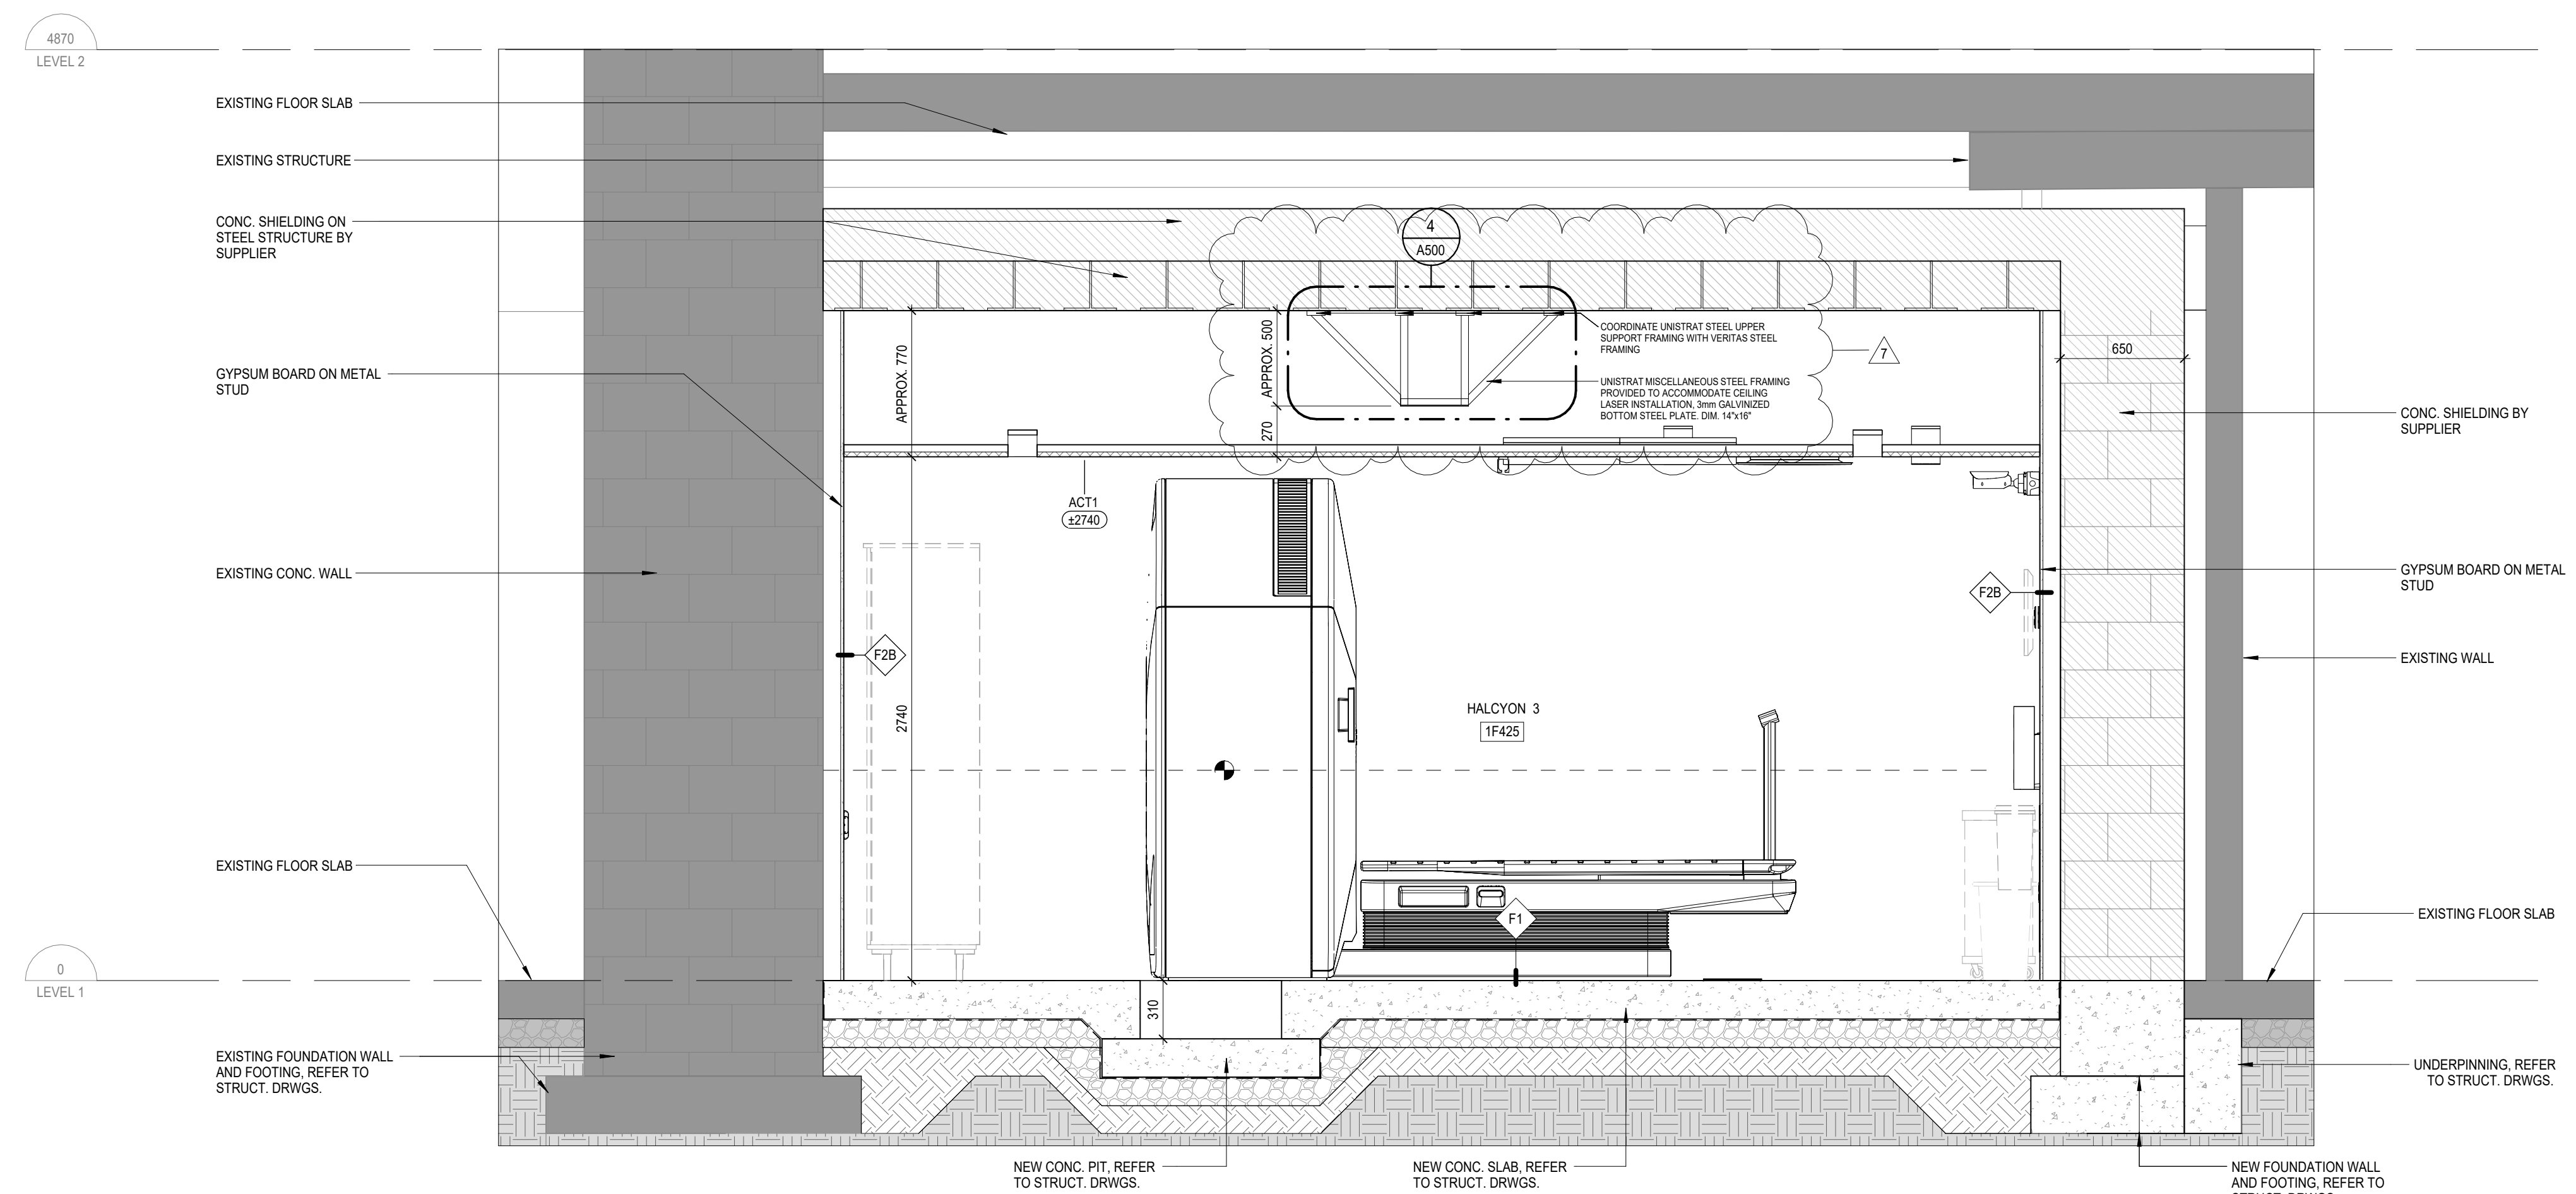

2 HALCYON 3 - NORTH / SOUTH SECTION
1:25

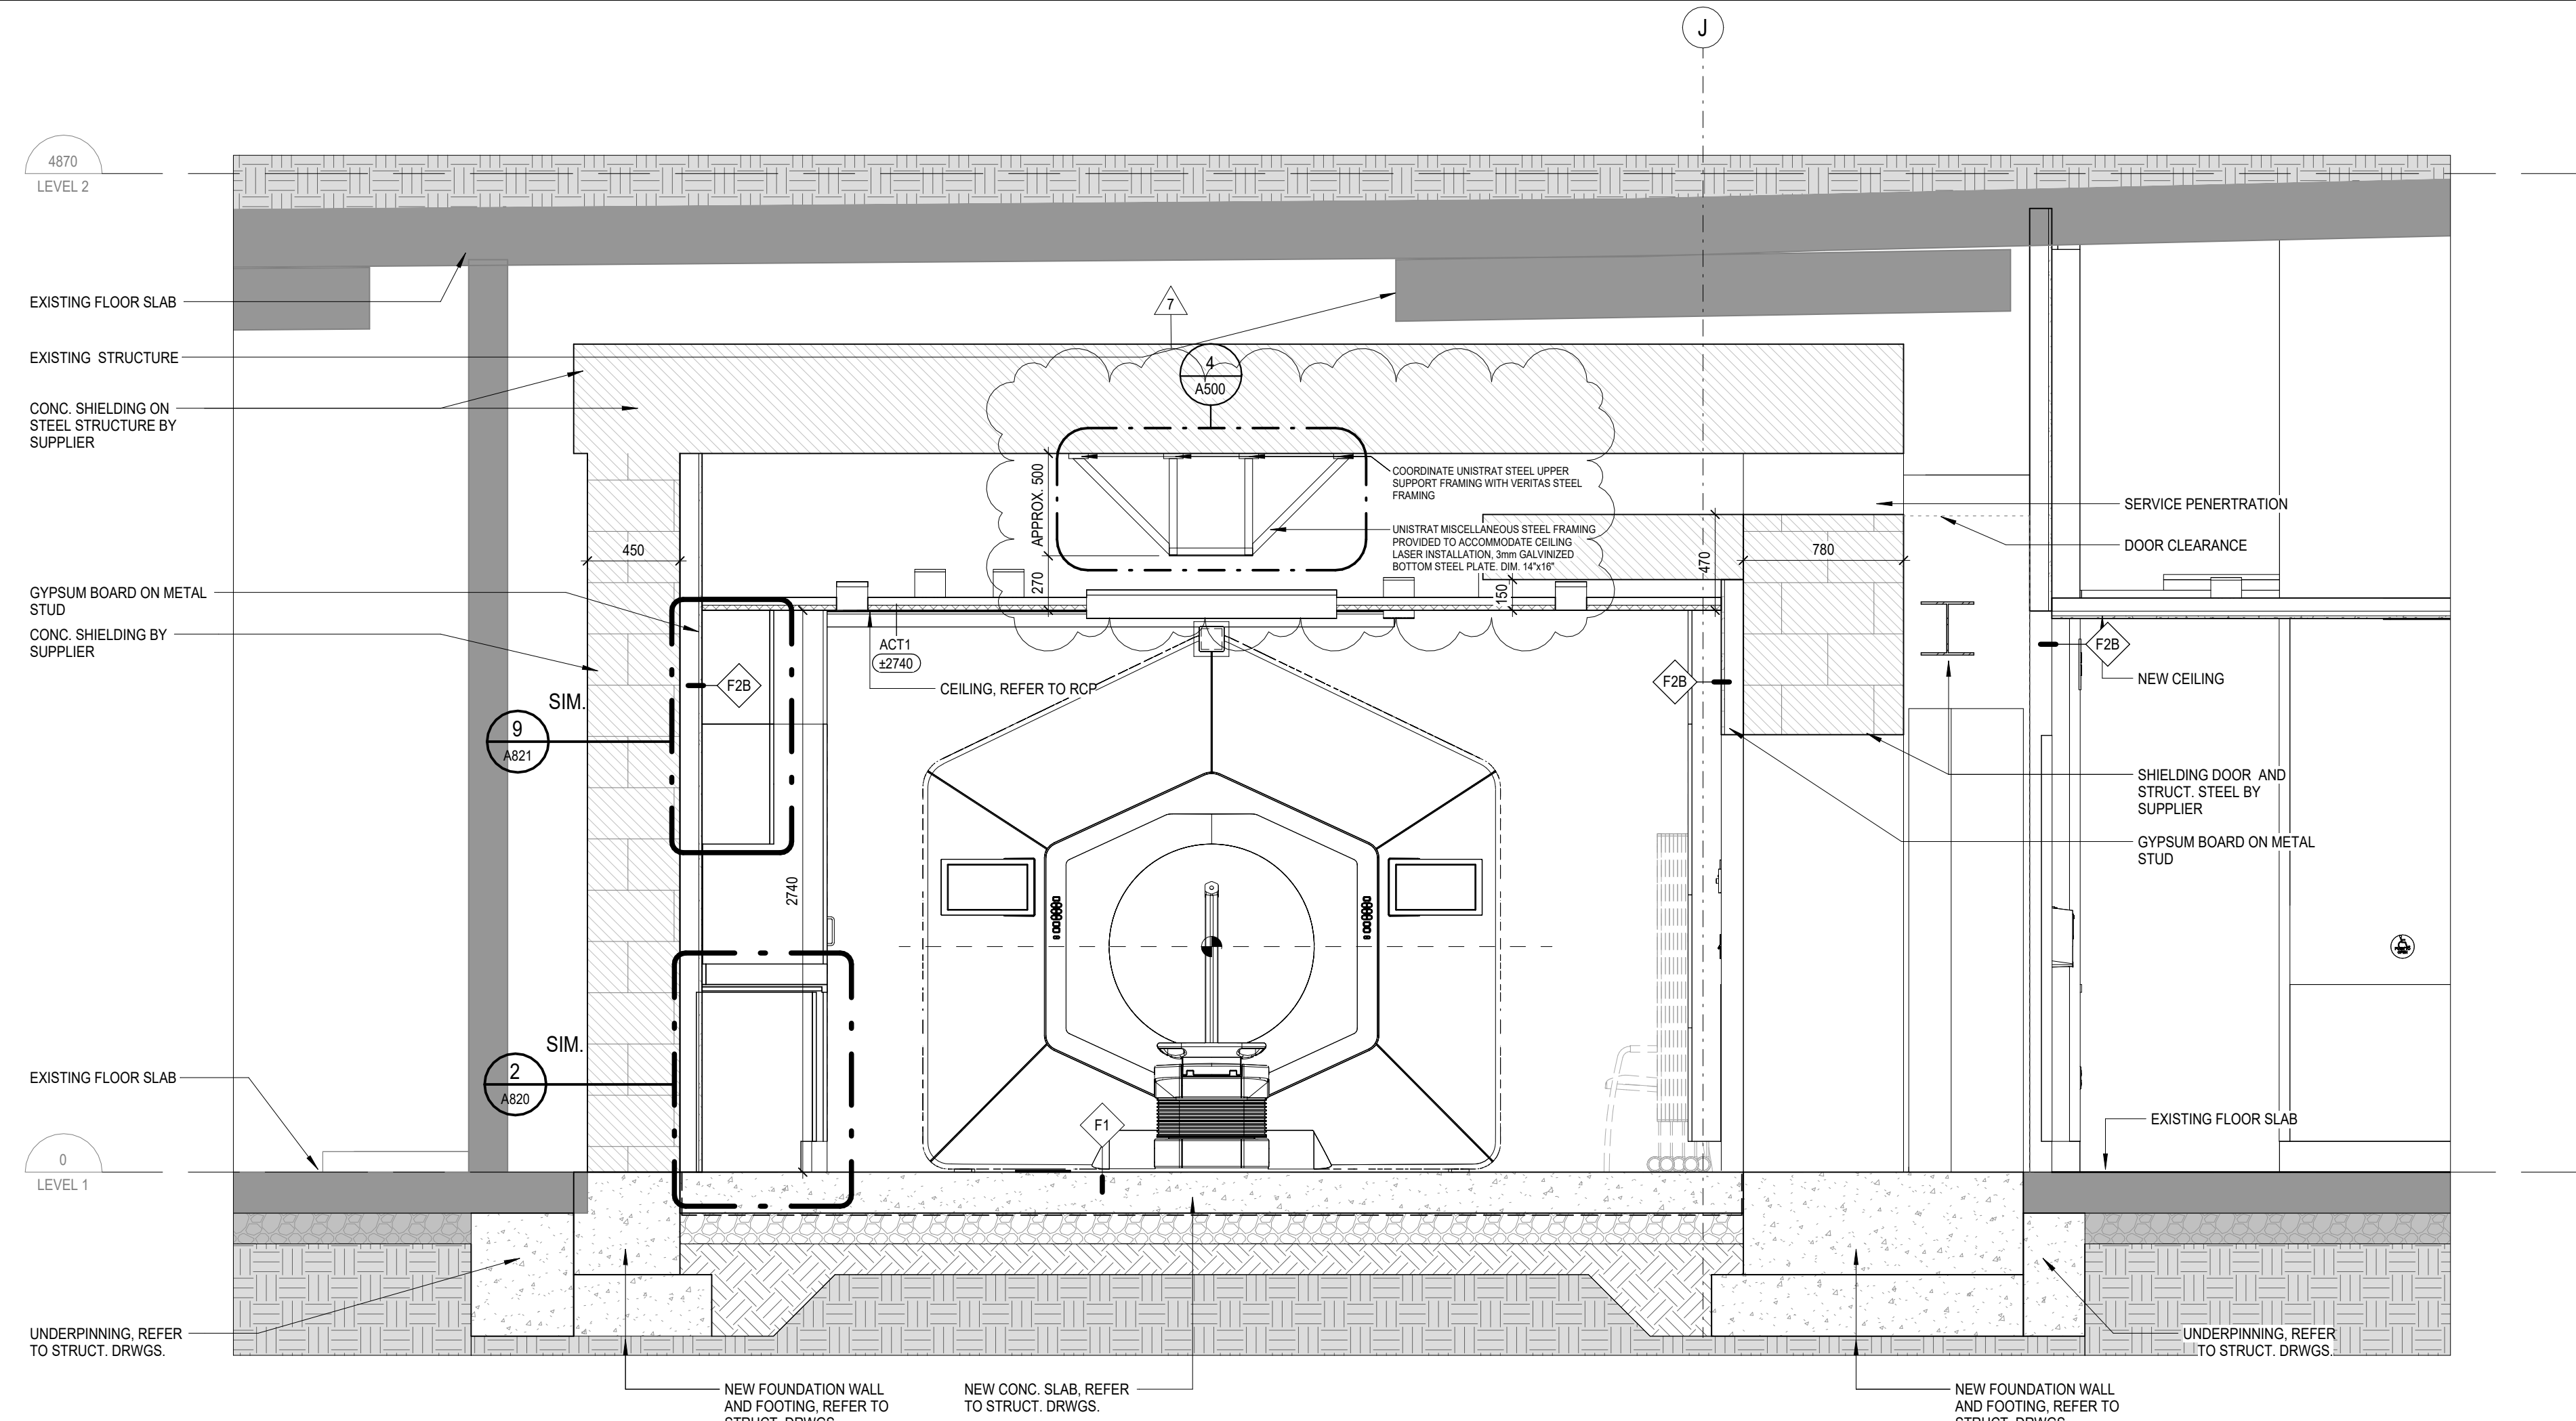

1 HALCYON 3 - EAST / WEST SECTION
1:25

CLIENT:

Trillium Health Partners

2200 Eglinton Avenue West
Mississauga, ON L5M 2N1
905 813 2200
thp.ca

CONSULTANT:

CUMULUS ARCHITECTS INC.


160 Pears Ave. - Suite 300
Toronto, ON M5R 3P8
416-539-0703
www.cumulusarch.com

SEAL:

This drawing, as an instrument of service, is the property of Cumulus Architects Inc. the copyright in the same being reserved to them. No reproduction is allowed without the permission of Cumulus Architects Inc. and when made must bear its name.

This drawing is not to be scaled. The contractor is to verify dimensions and data noted herein for conformity with the conditions on site and is responsible for reporting in writing any discrepancy to Cumulus Architects Inc. for adjustment.

Cumulus will not be liable for any claims or damages arising from the unauthorized use of this drawing or any portion thereof.

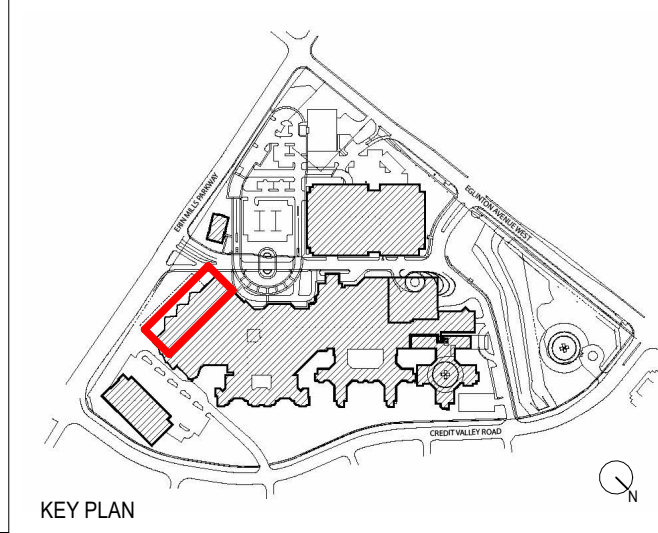

KEY PLAN

NO	DESCRIPTION	DATE
7	Issued for Addendum 1	2026/02/04
6	Issued for Tender	2025/12/16
5	Issued for Building Permit	2025/12/02
4	Issued For MOH 2.3 Resubmission	2025/06/20
2	Issued For MOH 2.3 Costing	2024/09/13

PROJECT:

Oncology Radiation Treatment Expansion
2200 Eglinton Ave W,
Mississauga, ON L5M 2N1

TITLE:

HALCYON ROOM 3 SECTIONS


PROJECT NO:
23010

CHECKED:
Checker


DRAWING NO:
A502

LEGEND - ELEVATIONS


FEATURE PAINT. REFER TO FINISHES PLAN

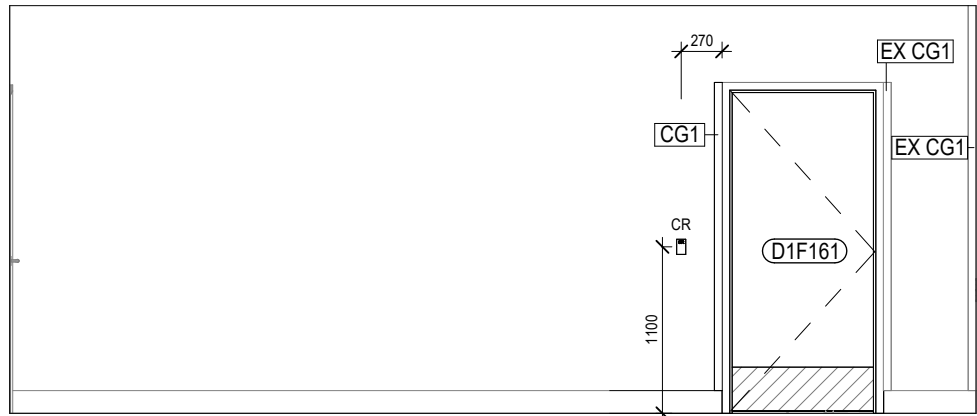


17 PHASE ONE WORKROOM CORRIDOR WEST ELEVATION
1 : 50

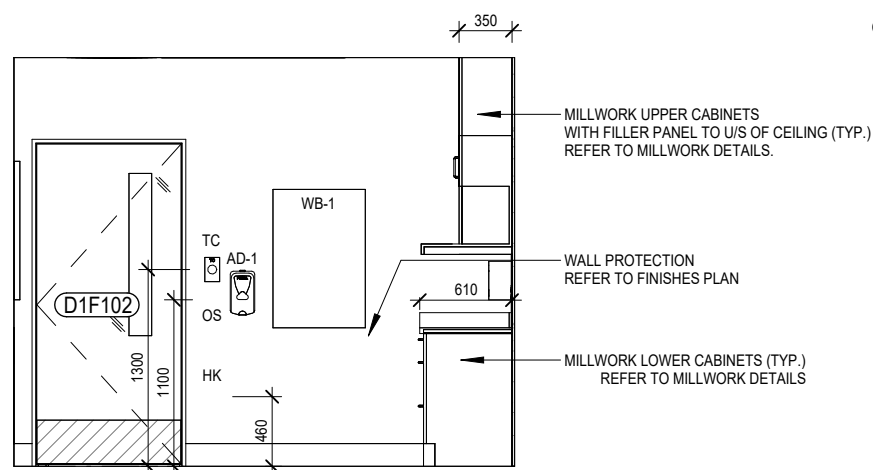


16 KITCHEN - 1F102 - NORTH ELEVATION
1 : 50

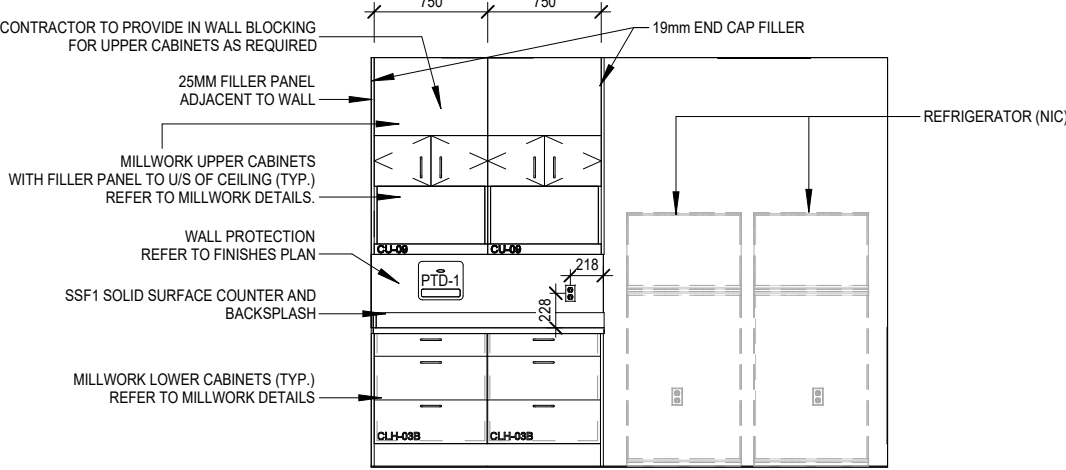


15 KITCHEN - 1F102 - EAST ELEVATION
1 : 50

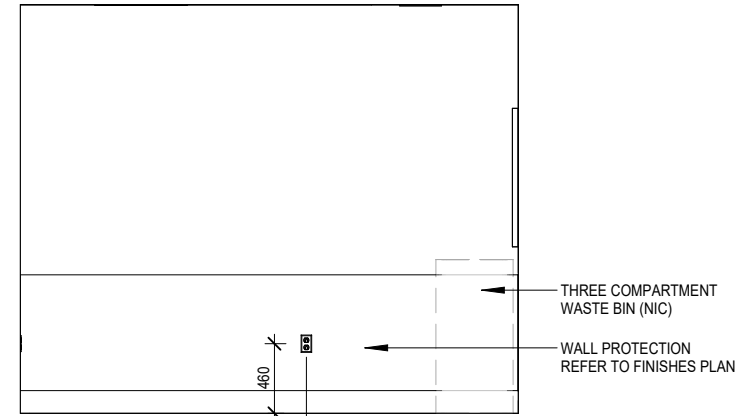


14 KITCHEN - 1F102 - SOUTH ELEVATION
1 : 50

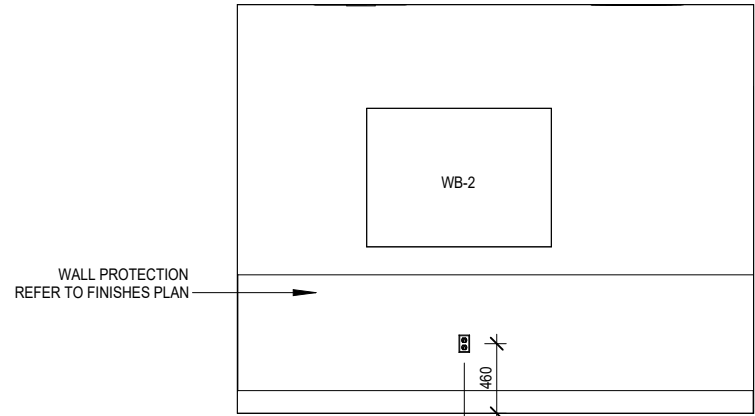


13 KITCHEN - 1F102 - WEST ELEVATION
1 : 50

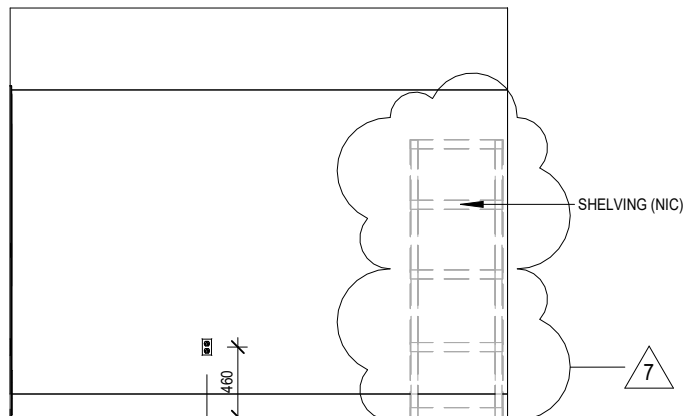


12 STORAGE - 1F162A - NORTH ELEVATION
1 : 50

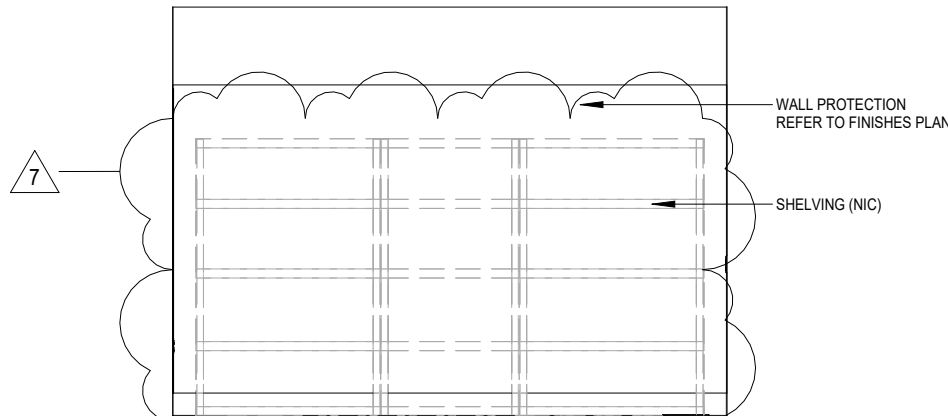


11 STORAGE - 1F162A - EAST ELEVATION
1 : 50

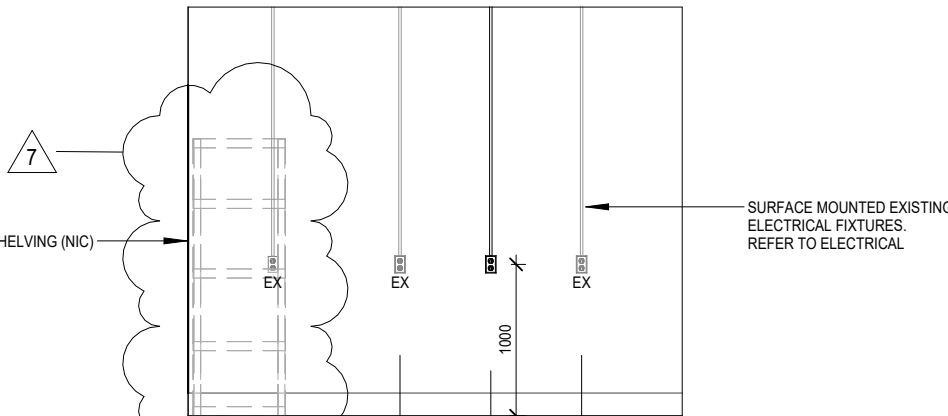


10 STORAGE - 1F162A - SOUTH ELEVATION
1 : 50

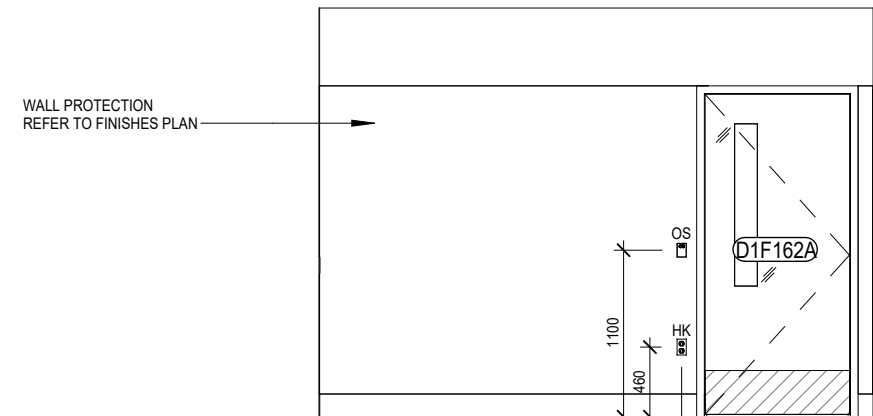


9 STORAGE - 1F162A - WEST ELEVATION
1 : 50

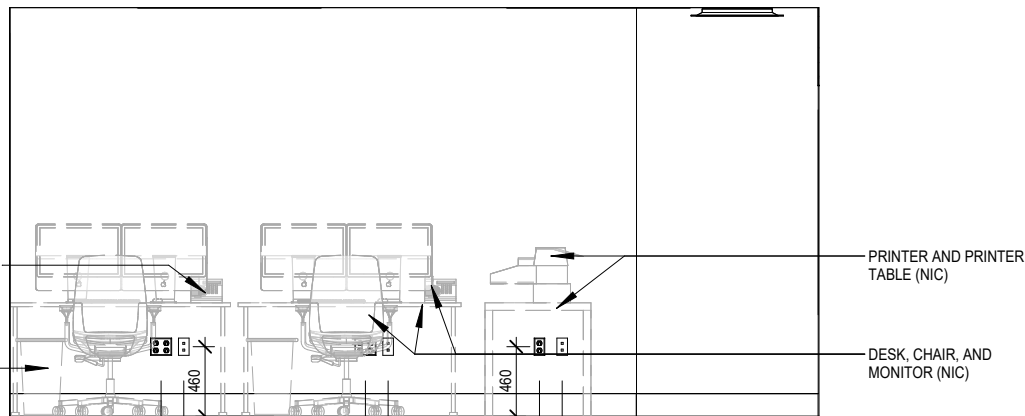


8 WORKROOM B - 1F161 - NORTH ELEVATION
1 : 50

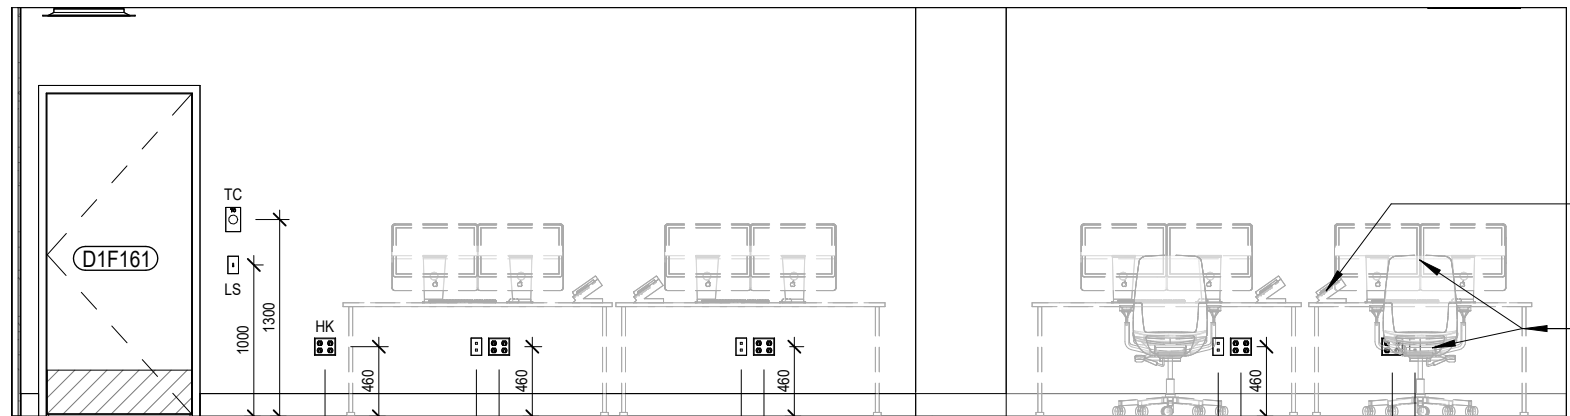


7 WORKROOM B - 1F161 - EAST ELEVATION
1 : 50

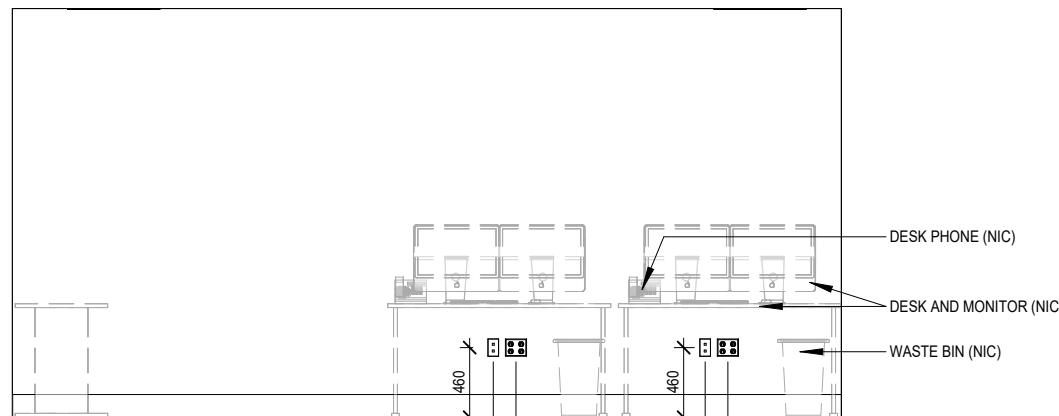


6 WORKROOM B - 1F161 - SOUTH ELEVATION
1 : 50

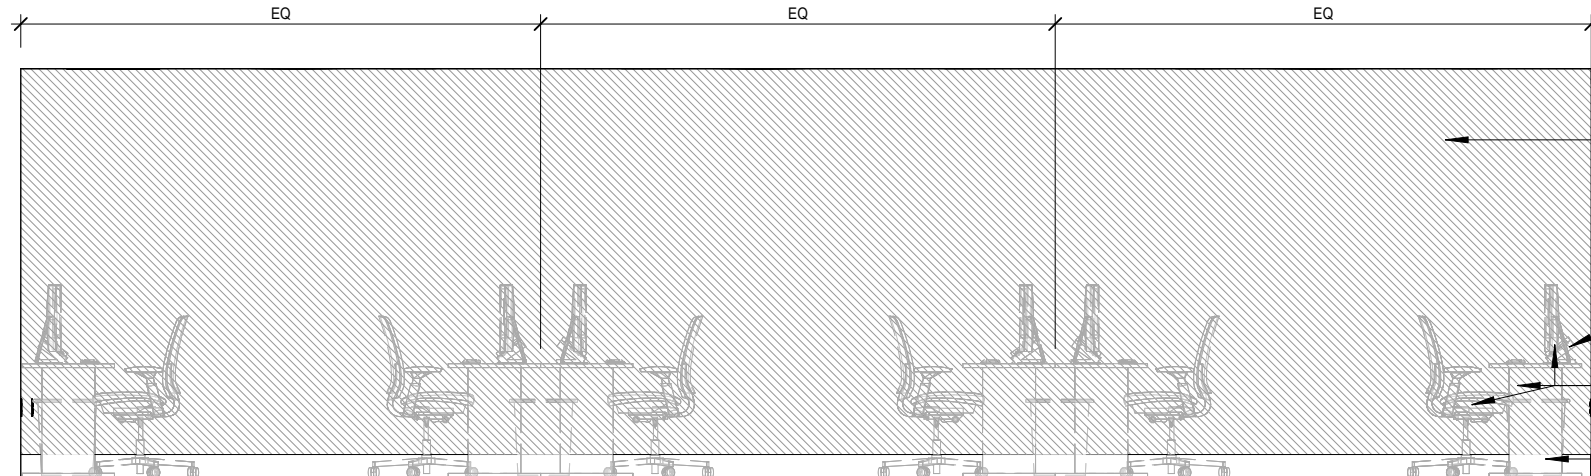


5 WORKROOM B - 1F161 - WEST ELEVATION
1 : 50

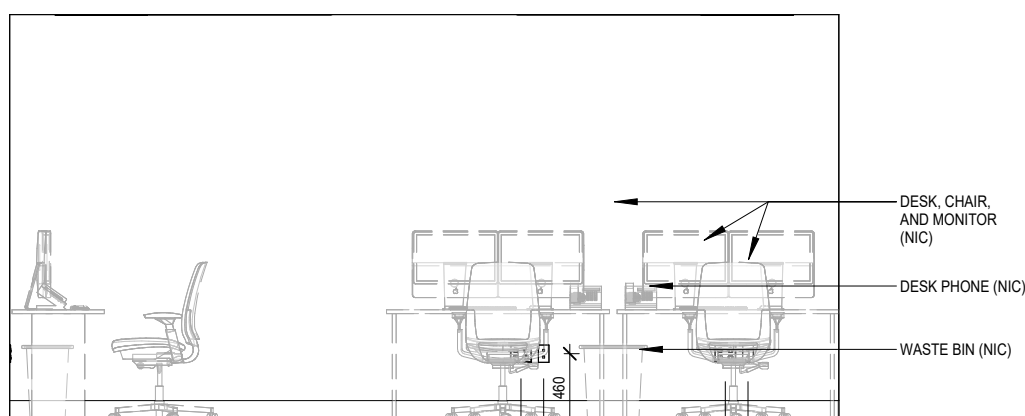


4 WORKROOM A - 1F152 - NORTH ELEVATION
1 : 50

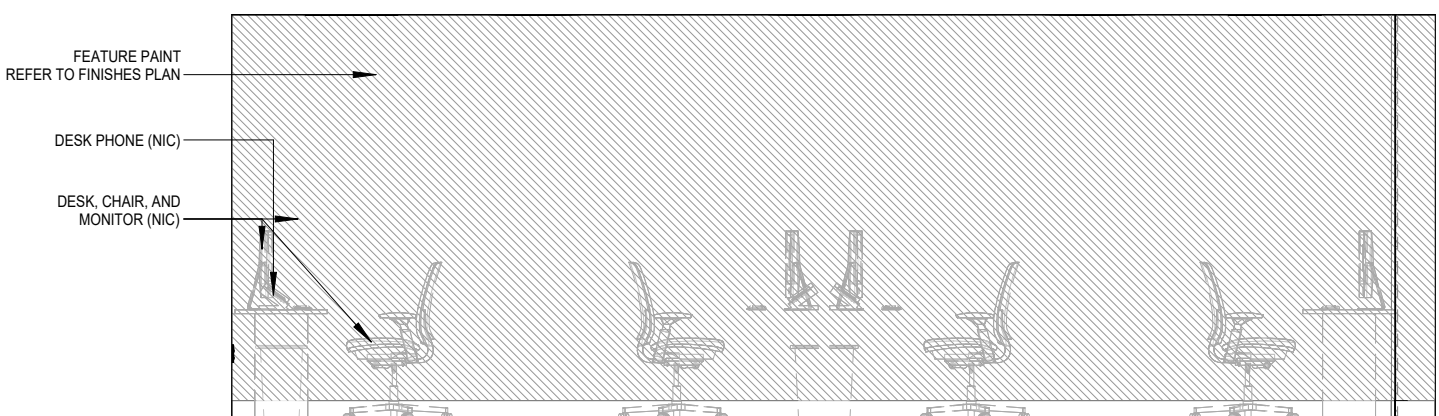

3 WORKROOM A - 1F152 - EAST ELEVATION
1 : 50

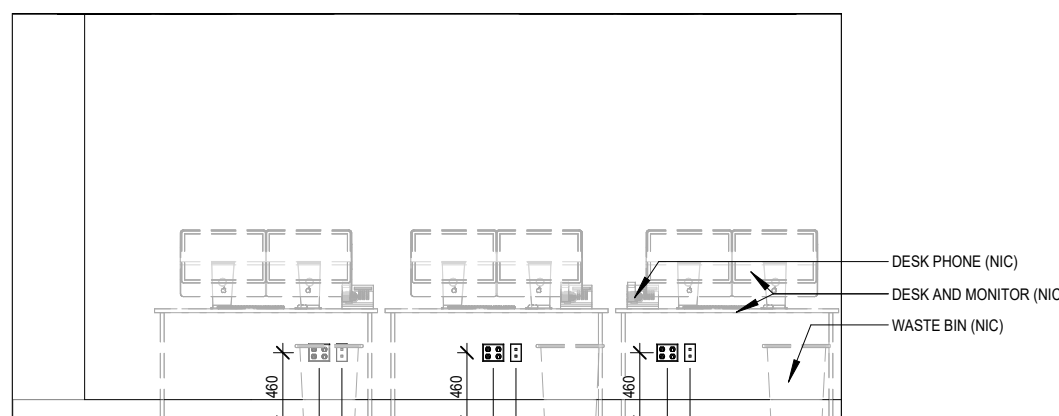

2 WORKROOM A - 1F152 - SOUTH ELEVATION
1 : 50

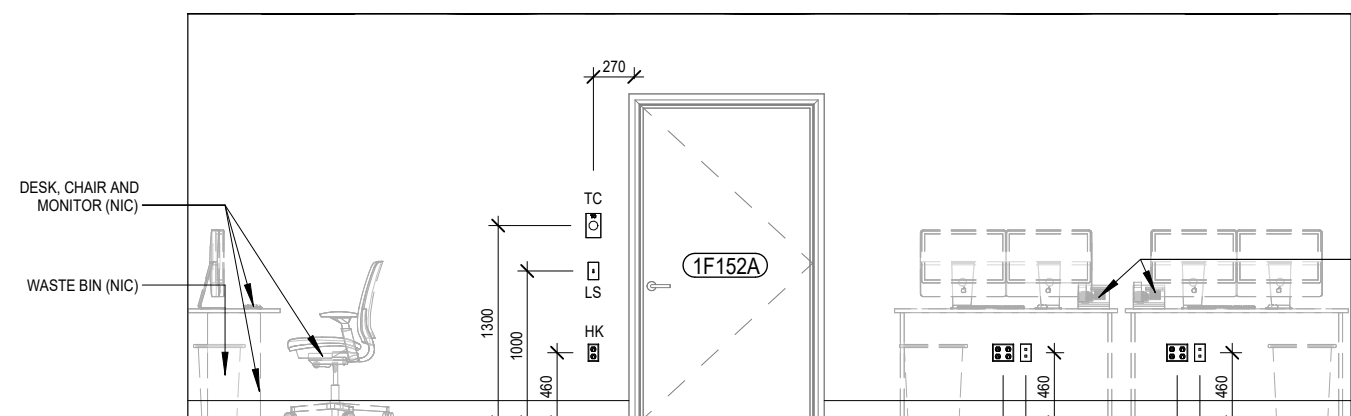

1 WORKROOM A - 1F152 - WEST ELEVATION
1 : 50

CLIENT:

Trillium Health Partners
2200 Eglinton Avenue West
Mississauga, ON L5M 2N1
905 813 2200
thp.ca

CONSULTANT:


CUMULUS ARCHITECTS INC.
160 Pears Ave. - Suite 300
Toronto, ON M5R 3P8
416-539-0763
www.cumulusarch.com

SEAL:

This drawing, as an instrument of service, is the property of Cumulus Architects Inc. the copyright in the same being reserved to them. No reproduction is allowed without the permission of Cumulus Architects Inc. and when made must bear its name.

This drawing is not to be scaled. The contractor is to verify dimensions and data noted herein for conformity with the conditions on site and is responsible for reporting in writing any discrepancy to Cumulus Architects Inc. for adjustment.

Cumulus will not be liable for any claims or damages arising from the unauthorized use of this drawing or any portion thereof.

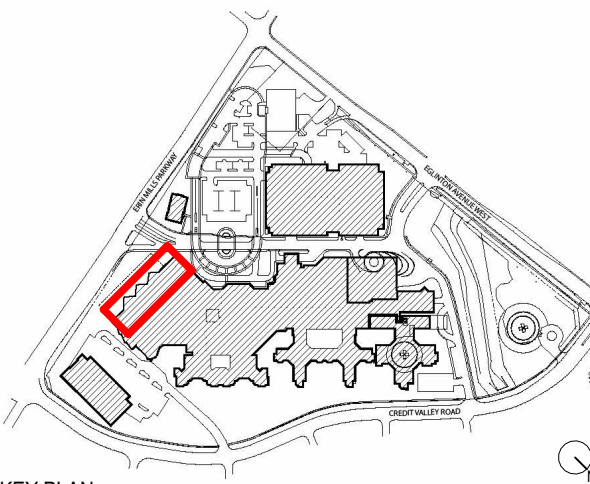

KEY PLAN

ELEVATIONS ABBREVIATION LEGEND

AD ANTISEPTIC DISPENSER
AOC AUTOMATIC DOOR OPENER
BFS BOTTLE FILLING STATION
BIF BLANKET IRONER
CB CODE BLUE
CG CORNER GUARD
CH COAT HOOK
CR CARD READER
EPO EMERGENCY POWER OFF SWITCH
EQ EQUAL
EX EXISTING
FHC FIRE HOSE CABINET
FRB FOLDABLE ROLL BOARD
GB GLOVE DISPENSER
HK HAND KEYPAD
HHS HAND HYGIENE STATION
HM HAZARD MACHINE INTERFACE
HR HAND RAIL
LPO LAST PERSON OUT SWITCH
LS LIGHT SWITCH
MR MEDICAL RECEPTION UNIT
MSU MEDICAL SERVICE UNIT
NC NOT CONTRACT
NUR NURSE CALL
O OCCUPANCY SENSOR
OS OSH OSH OPERATOR SYSTEM
PH PAMPHLET HOLDER
PL PLASTIC LAMINATE
PTD PAPER TOWEL DISPENSER
PK PRINTER OUTLET
RUB RELAY JUNCTION BOX
SC SHARP CONTAINER
SD SOAP DISPENSER
TC THERMOSTAT
TPO TOWEL PAPER DISPENSER
V VACUUM (MED. GAS)
WB WHITE BOARD
WR WASTE RECEPTACLE
ZVB ZONE VALVE BOX (MED. GAS)

NO	DESCRIPTION	DATE
7	Issued for Addendum 1	2026/02/04
6	Issued for Tender	2025/12/16
5	Issued for Building Permit	2025/12/02
4	Issued For MOH 2.3 Resubmission	2025/06/20
2	Issued For MOH 2.3 Costing	2024/09/13

SHEET REVISION

PROJECT:
Oncology Radiation Treatment Expansion
2200 Eglinton Ave W,
Mississauga, ON L5M 2N1


TITLE:
INTERIOR ELEVATIONS
PHASE 1

PROJECT NO:
23010
CHECKED:
Checker


DRAWING NO:
A800

LEGEND - ELEVATIONS


FEATURE PAINT. REFER TO FINISHES PLAN

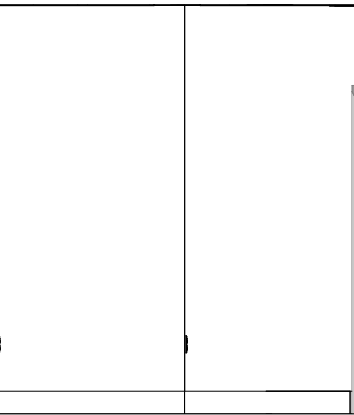


17 CLEAN UTILITY - 1F170 - NORTH ELEVATION
1: 50

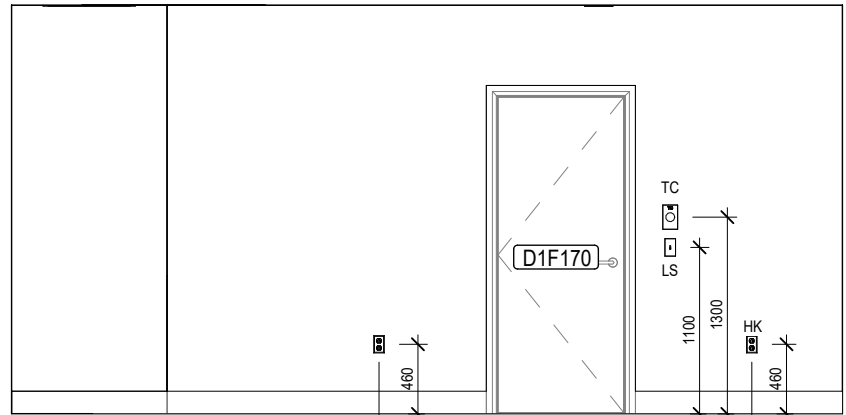


16 CLEAN UTILITY - 1F170 - EAST ELEVATION
1: 50

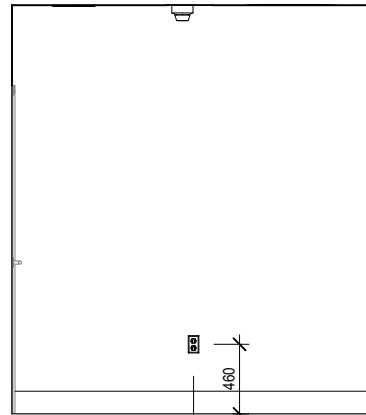


15 CLEAN UTILITY - 1F170 - SOUTH ELEVATION
1: 50

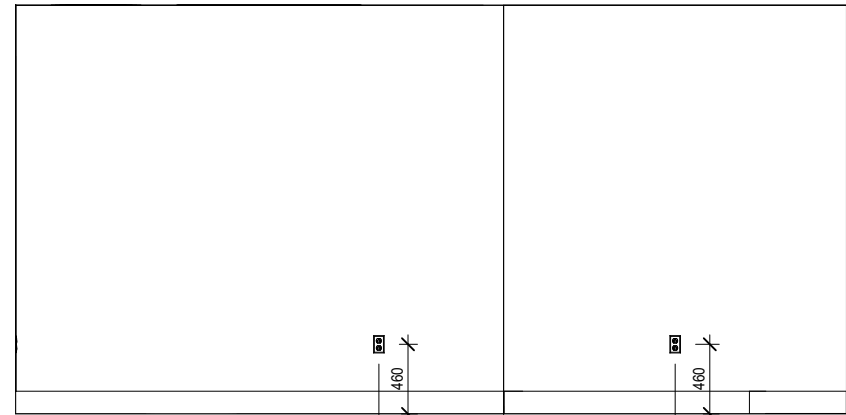


14 CLEAN UTILITY - 1F170 - WEST ELEVATION
1: 50

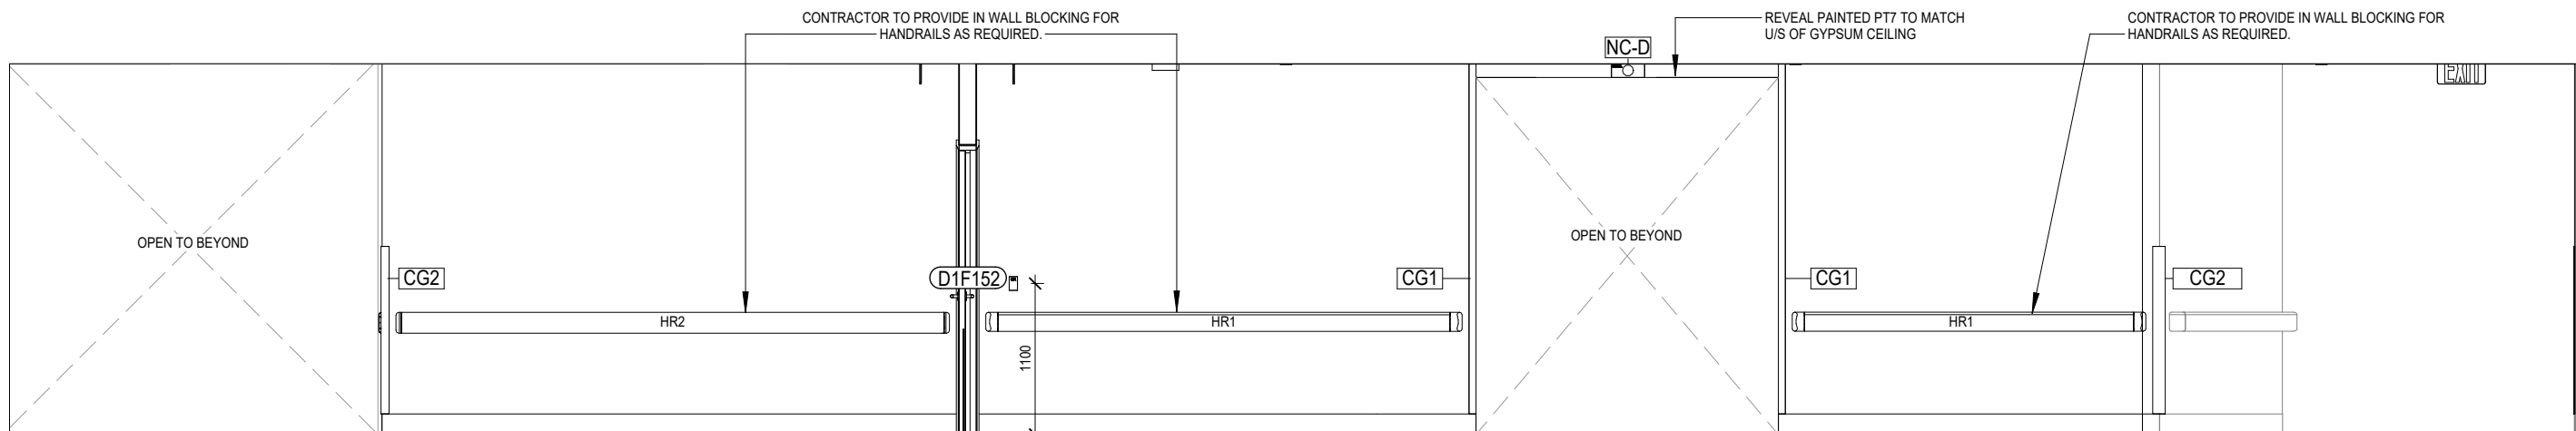


13 HALCYON 1 CORRIDOR EAST ELEVATION
1: 50

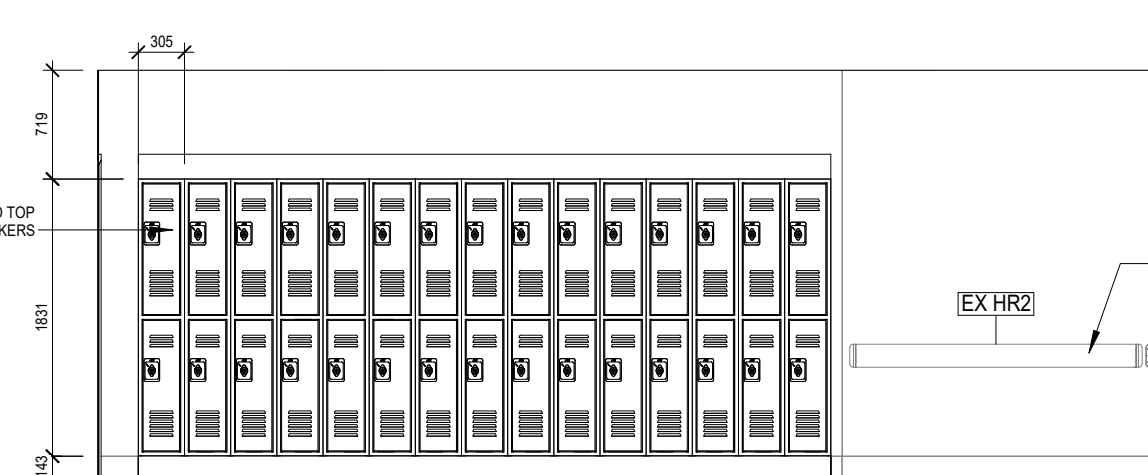


12 HALCYON 1 CORRIDOR WEST ELEVATION
1: 50

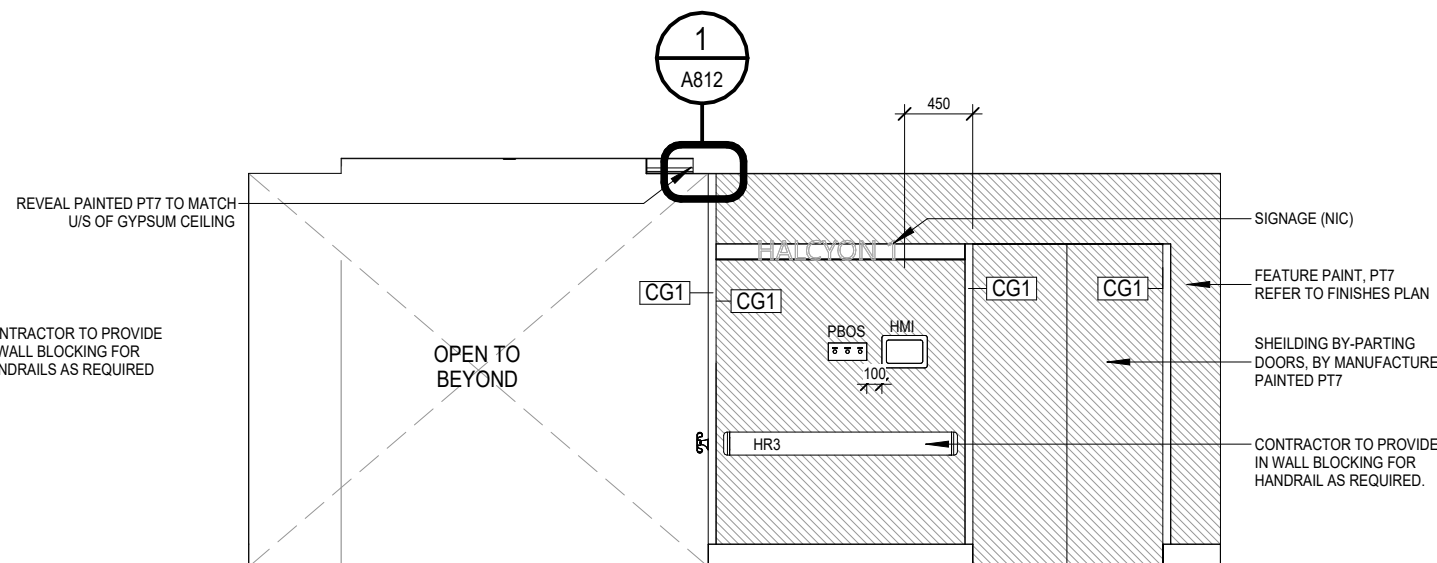


11 HALCYON 1 - CONTROL AREA - NORTH ELEVATION
1: 50

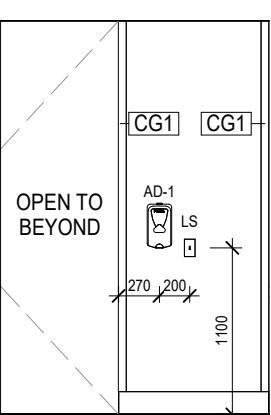


10 HALCYON 1 - VESTIBULE - SOUTH
1: 50

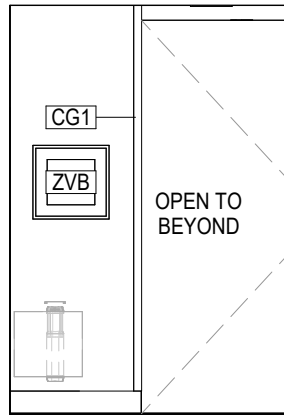


9 HALCYON 1 - CONTROL AREA - NORTH
1: 50

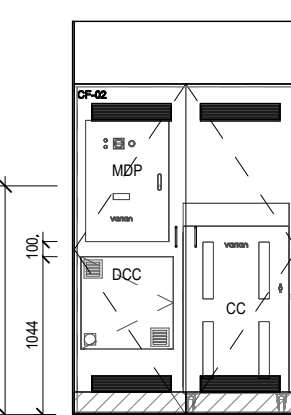


8 HALCYON 1 - CONTROL CABINET
1: 50

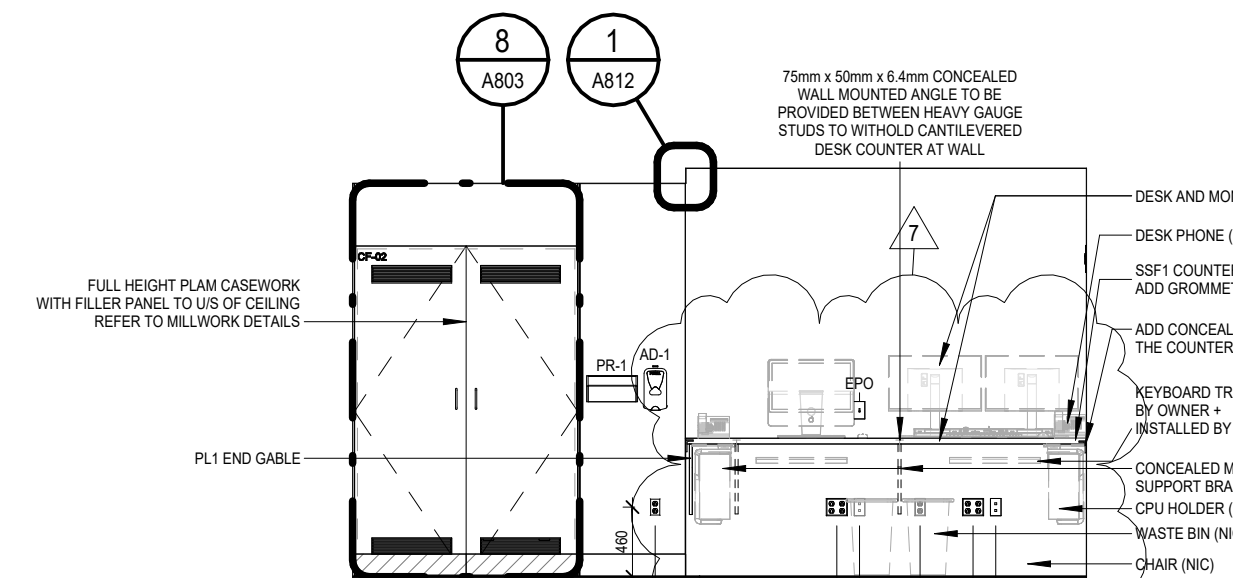


7 HALCYON 1 - CONTROL AREA - EAST ELEVATION
1: 50

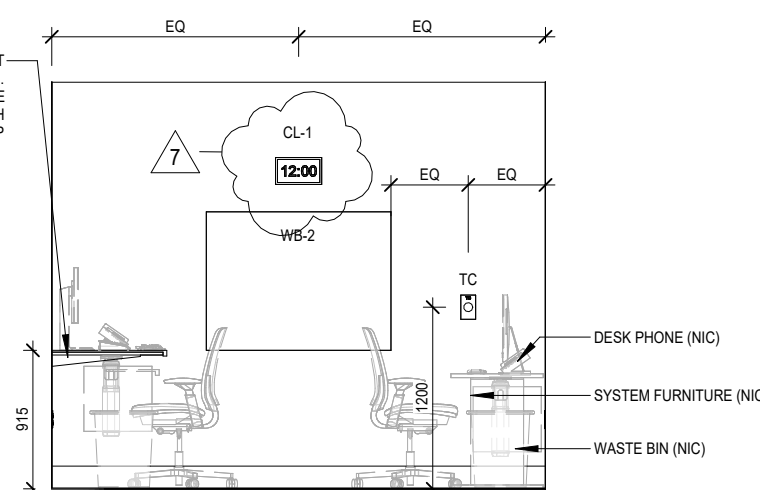


6 HALCYON 1 CONTROL AREA SOUTH ELEVATION
1: 50

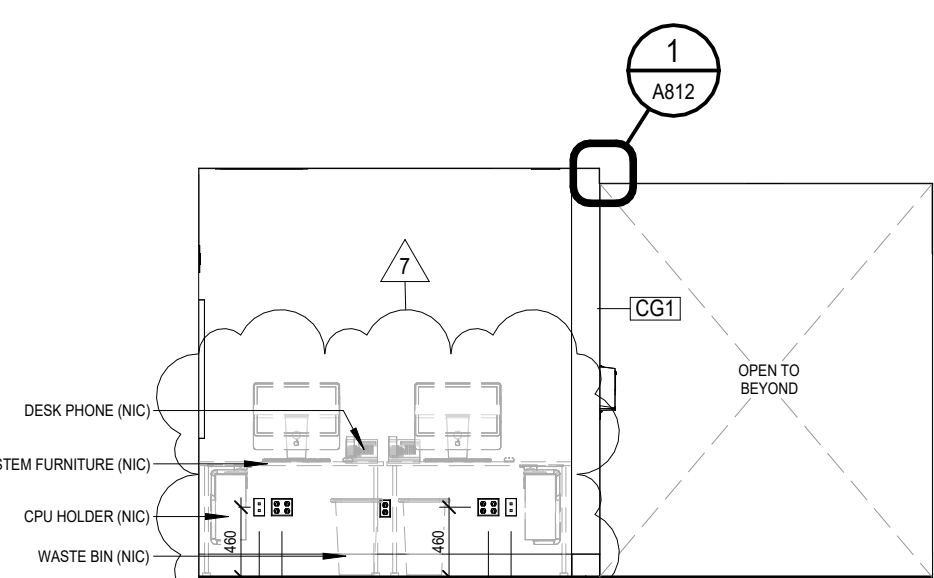


5 HALCYON 1 - CONTROL AREA - WEST ELEVATION
1: 50

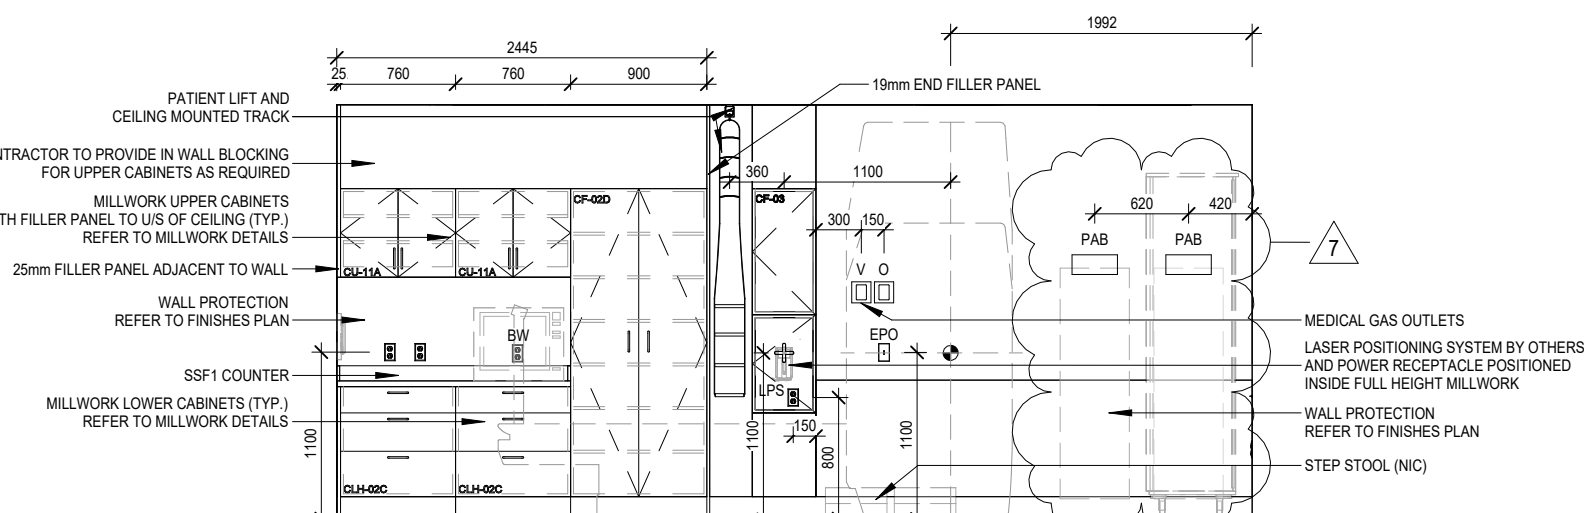


4 HALCYON 1 - NORTH ELEVATION
1: 50

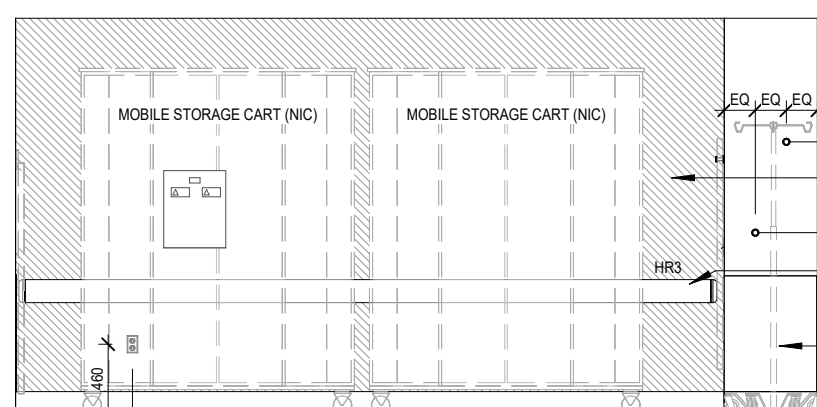

3 HALCYON 1 EAST ELEVATION
1: 50

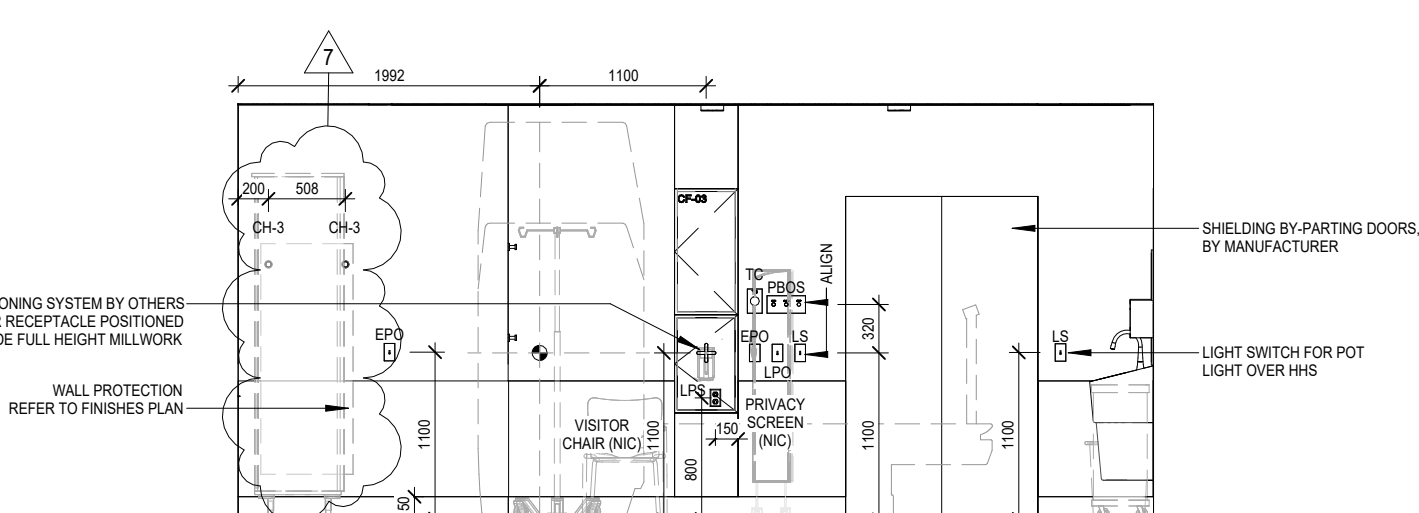

2 HALCYON 1 - SOUTH ELEVATION
1: 50

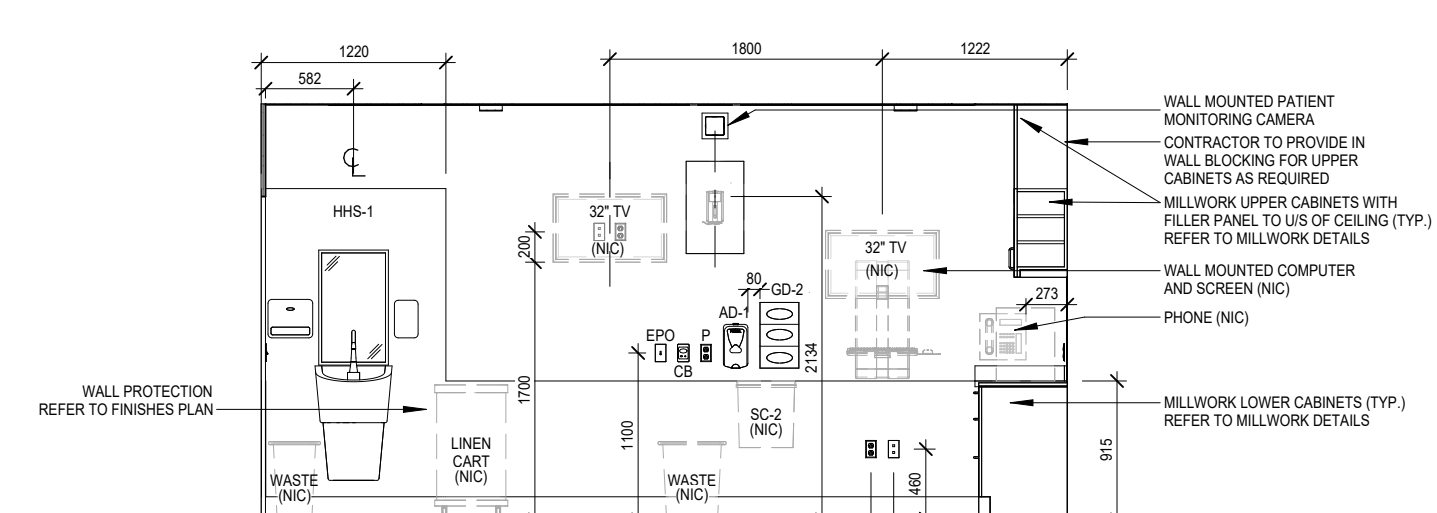

1 HALCYON 1 - WEST ELEVATION
1: 50

CLIENT:

Trillium Health Partners
2200 Eglinton Avenue West
Mississauga, ON L5M 2N1
905 813 2200
thp.ca

CONSULTANT:


CUMULUS ARCHITECTS INC.
160 Pears Ave. - Suite 300
Toronto, ON M5R 3P8
416-539-0763
www.cumulusarch.com

SEAL:

This drawing, as an instrument of service, is the property of Cumulus Architects Inc. the copyright in the same being reserved to them. No reproduction is allowed without the permission of Cumulus Architects Inc. and when made must bear its name.

This drawing is not to be scaled. The contractor is to verify dimensions and data noted herein for conformity with the conditions on site and is responsible for reporting in writing any discrepancy to Cumulus Architects Inc. for adjustment.

Cumulus will not be liable for any claims or damages arising from the unauthorized use of this drawing or any portion thereof.

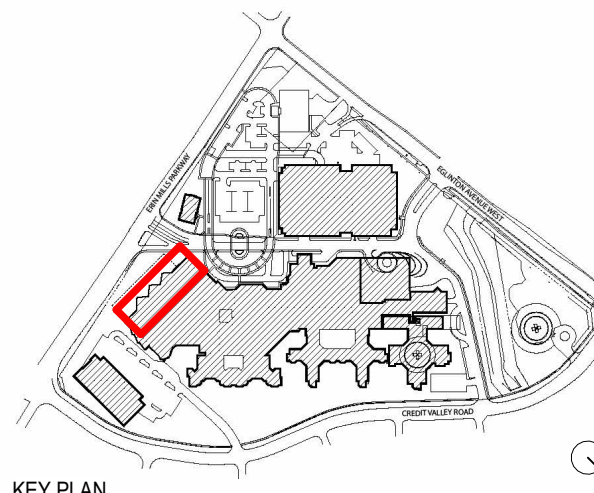

KEY PLAN

ELEVATIONS ABBREVIATION LEGEND

AD ANTISEPTIC DISPENSER
ADP AUTOMATIC DOOR OPENER
BFS BOTTLE FILLING STATION
BY BLANKET WARMER
CB CODE BLUE
CG CORNER GARLAND
CH COAT HOOK
CR CARD READER
EPO EMERGENCY POWER OFF SWITCH
EQ EXISTING
EX EXISTING
FHC FIRE HOSE CABINET
FNB FOLDABLE ROLL BOARD
GB GIBBY BAR
GD GLOVE DISPENSER
HK HOUSEKEEPING
HHS HAND HYGIENE STATION
HM HUMAN MACHINE INTERFACE
HR HAND RAIL
LPO LAST PERSON OUT SWITCH
LS LIGHT SWITCH
MR MIRROR
MSU MEDICAL SERVICE UNIT
NC NOT CONTRACT
NURSE CALL
O OCCUPANCY SENSOR
OS OCCUPANCY SENSOR
PH PAMPHLET HOLDER
PHT PAPER TOWEL DISPENSER
PR PRINTER OUTLET
RUB RELAY JUNCTION BOX
SC SOAP DISPENSER
SD SHOWERHEAD
TPO TOWEL PAPER DISPENSER
VACUUM (MED. GAS)
WB WHITE BOARD
WR WASTE RECEPTACLE
ZVB ZONE VALVE BOX (MED. GAS)

NO	DESCRIPTION	DATE
7	Issued for Addendum 1	2026/02/04
6	Issued for Tender	2025/12/16
5	Issued for Building Permit	2025/12/02
4	Issued For MOH 2.3 Resubmission	2025/06/20

SHEET REVISION

PROJECT:
Oncology Radiation Treatment Expansion
2200 Eglinton Ave W,
Mississauga, ON L5M 2N1

TITLE:
INTERIOR ELEVATIONS
PHASE 2

PROJECT NO:
23010
CHECKED:
Checker

DRAWING NO:

A803



ELEVATIONS ABBREVIATION LEGEND

AD	ANTISEPTIC DISPENSER
ADO	AUTOMATIC DOOR OPENER
AW	WATER
BW	BLANKET WARMER
CB	CODE BLUE
CG	CORNER CLOSET
CH	COAT HOOK
CR	CARD READER
CPD	CHARGE POWER OFF SW
EQ	EQUAL
EX	EXITING
FHC	FIRE HOSE CABINET
FRB	FOLDABLE ROLL GRAB BAR
GO	GLOVE DISPENSER
HU	HOLSEKEEPER
HMS	HAND HYGIENE STATION
HMI	HUMAN MACHINE INTERFACE
IP	INPATIENT
LPO	LAST PERSON OUT SWITCH
LS	LIGHT SWITCH
MSU	MEDICAL SERVICE UNIT
NC	NOT IN PRACTICE
NIC	NURSE CALL
OS	OXYGEN (MED. GAS)
POS	POC/PAP/ABP MONITOR
PH	PUSH BUTTON OPERATOR
PH	PAMPHLET HOLDER
PTD	PASTIC LAMINATE
PTD	PAPER TOWEL DISPENSER
R	RELAY
RUB	RELAY CANNOT
SC	SHARPS CONTAINER
SC	SOAK DISPENSER
TC	THERMOSTAT
TP	TOILET PAPER DISPENSER
UCL	ULCINUM (MED. GAS)
WB	WHITE BOARD
WV	WATER VALVE HANDLE
ZVB	ZONE VALVE BOX (MED. GAS)


7	Issued for Addendum 1	2026/02/04
6	Issued for Tender	2025/12/16
5	Issued for Building Permit	2025/11/02
4	Issued For MOH 2.3 Resubmission	2025/06/20
2	Issued For MOH 2.3 Costing	2024/09/13
NO	DESCRIPTION	DATE

PROJECT:
Oncology Radiation Treatment Expansion
2200 Eglinton Ave W,
Mississauga, ON L5M 2N1


TITLE:
INTERIOR ELEVATIONS
PHASE 2

PROJECT NO: 23010	DRAWING NO:
CHECKED: Checker	


A804

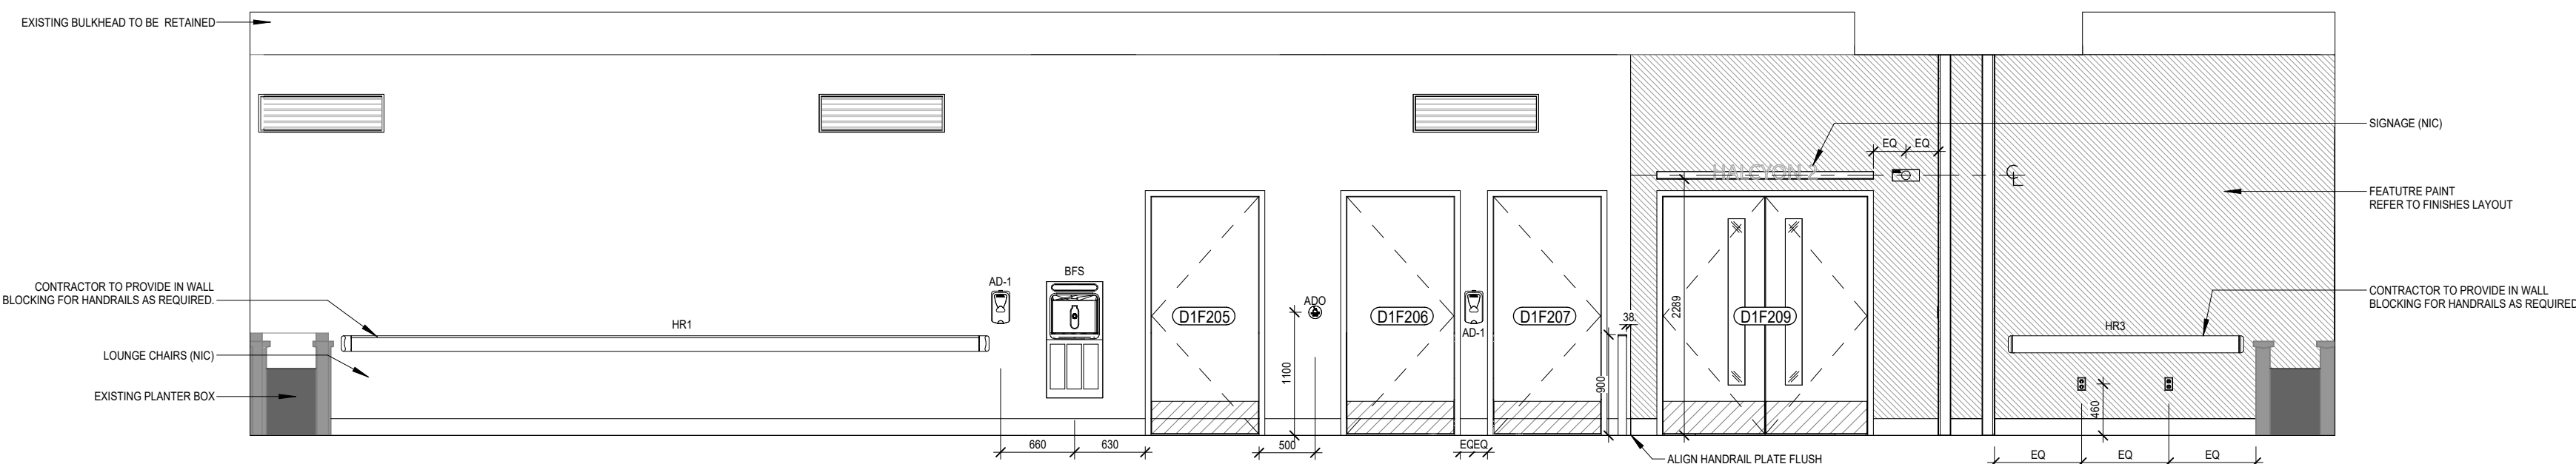


11 HALCYON 2 SUB-WAITING AREA EAST ELEVATION
1 : 50

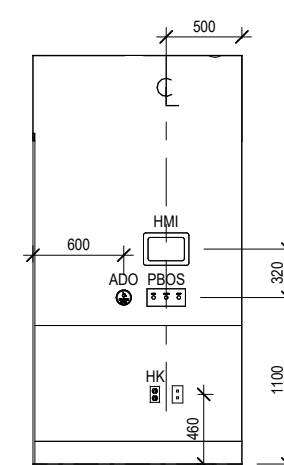


10 HALCYON 2 VESTIBULE NORTH ELEVATION
1:50

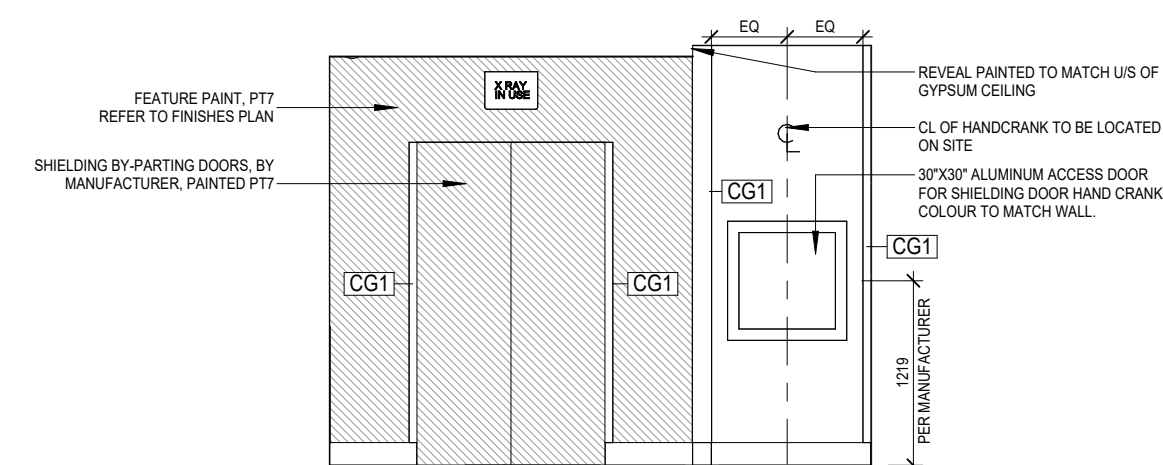


9 HALCYON 2 CONTROL ROOM EAST ELEVATION B
1:50

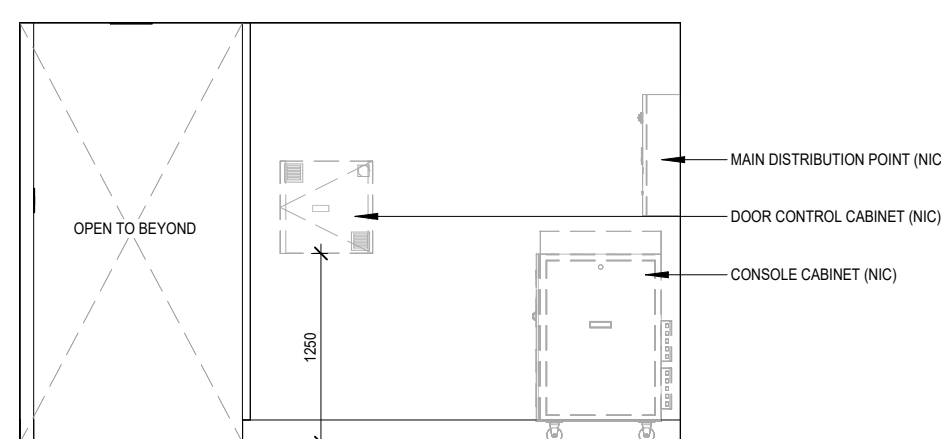


8 HALCYON 2 CONTROL AREA NORTH ELEVATION
1:50

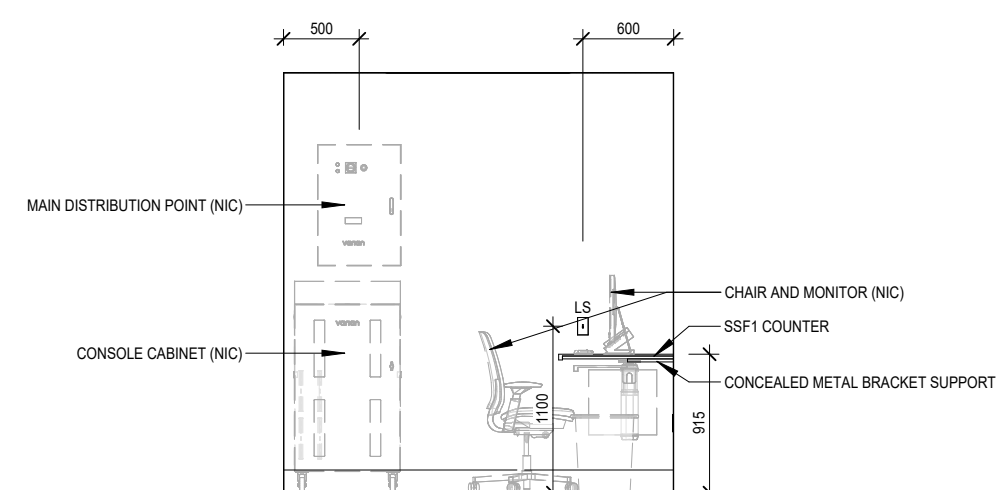


7 HALCYON 2 - CONTROL AREA -EAST ELEVATION
1:50

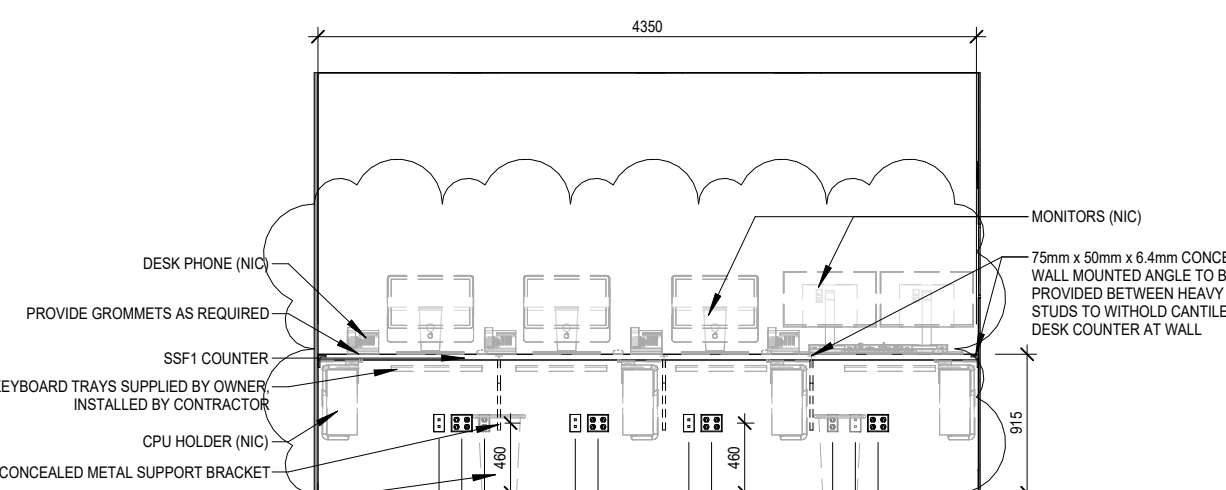


6 HALCYON 2 - CONTROL AREA - SOUTH ELEVATION
1:50

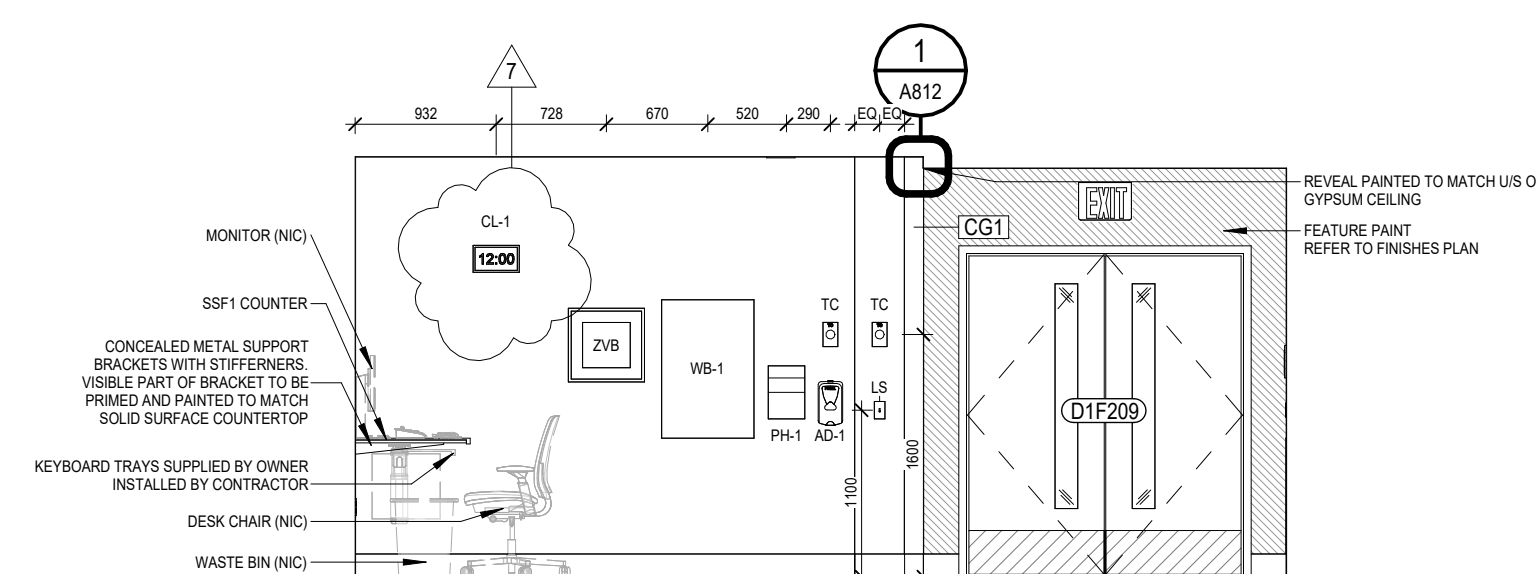


5 HALCYON 2 CONTROL ROOM & VESTIBULE - WEST ELEVATION
1:50

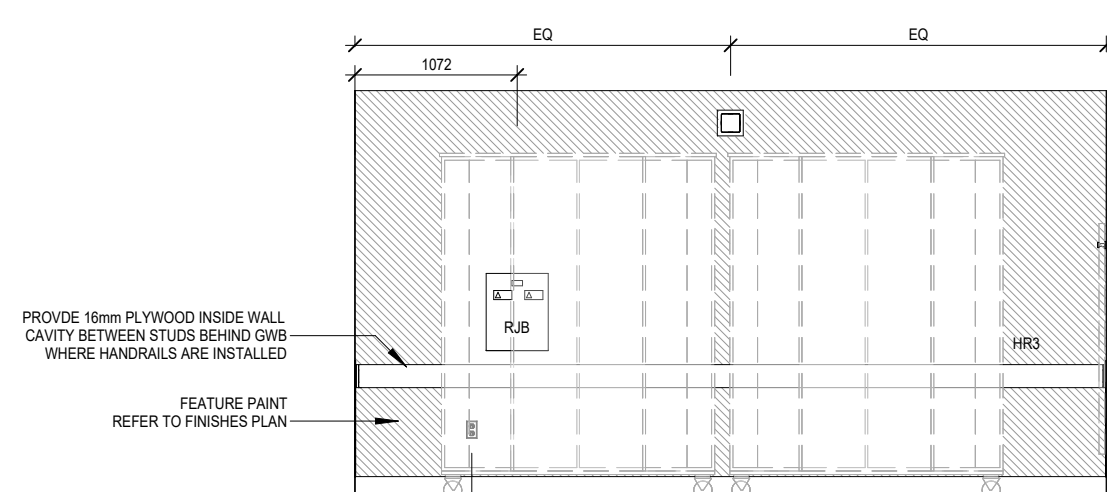


4 HALCYON 2 NORTH ELEVATION
1:50

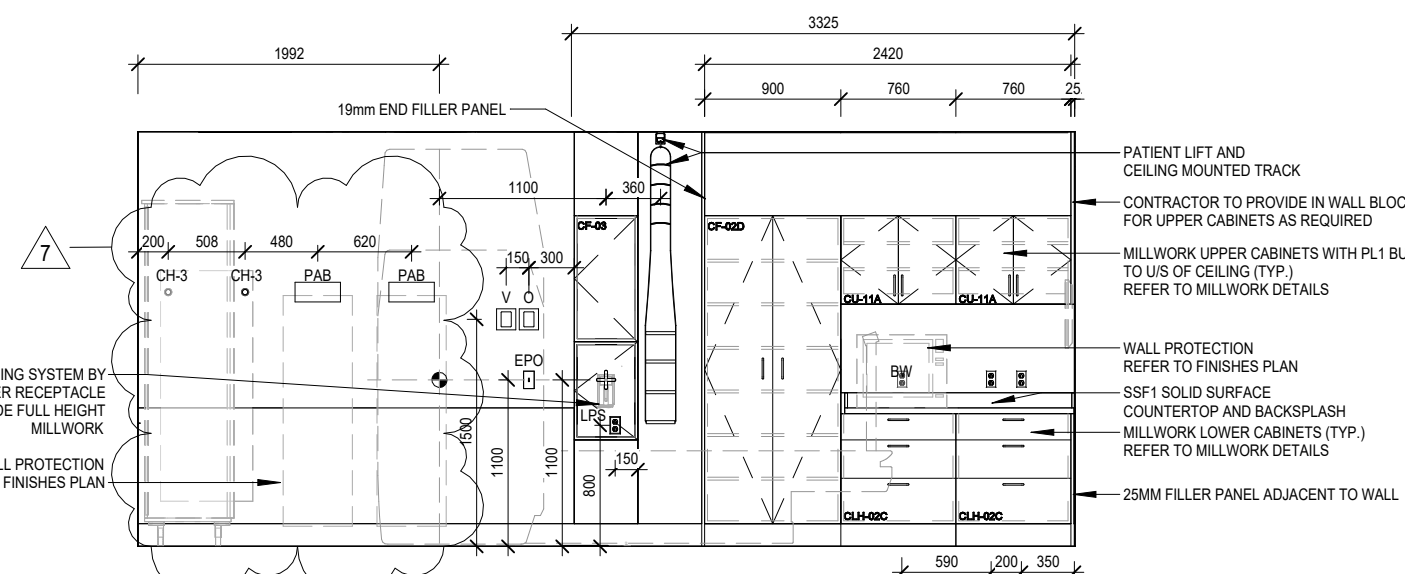

3 HALCYON 2 - EAST ELEVATION
1:50

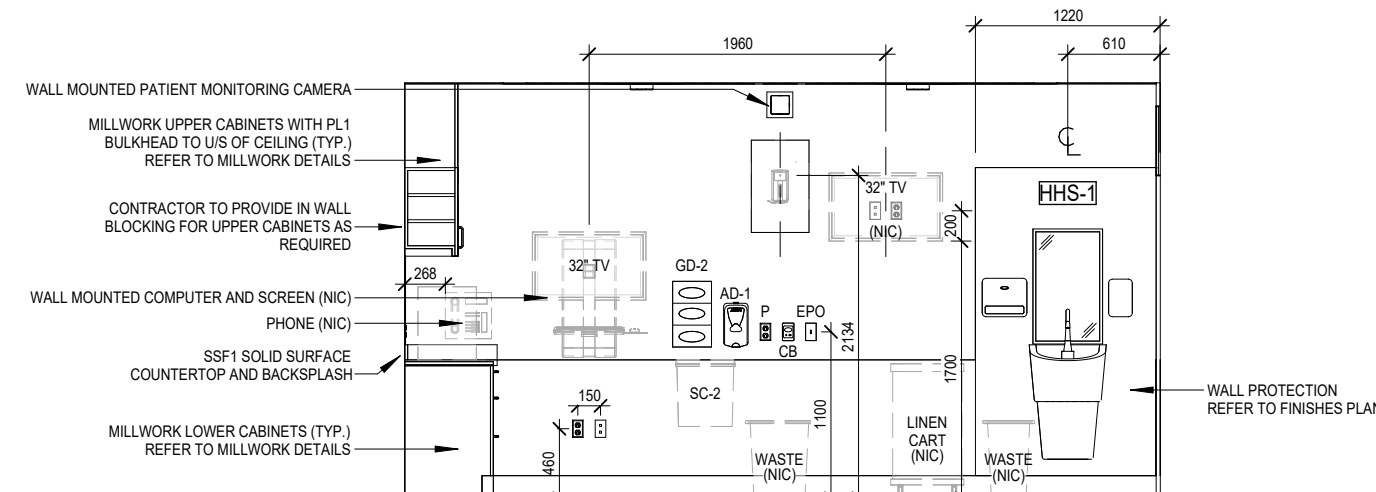














2 HALCYON 2 - SOUTH ELEVATION
1:50

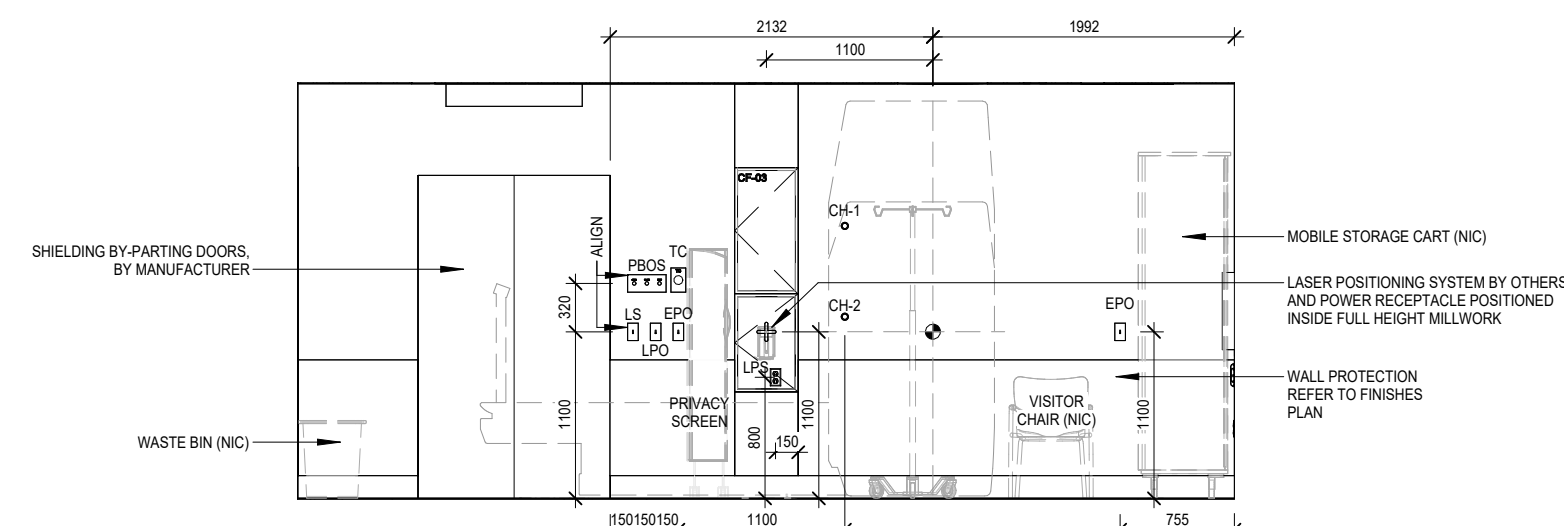

1 HALCYON 2 - WEST ELEVATION
1:50

LEGEND - ELEVATIONS

FEATURE PAINT. REFER TO FINISHES PLAN

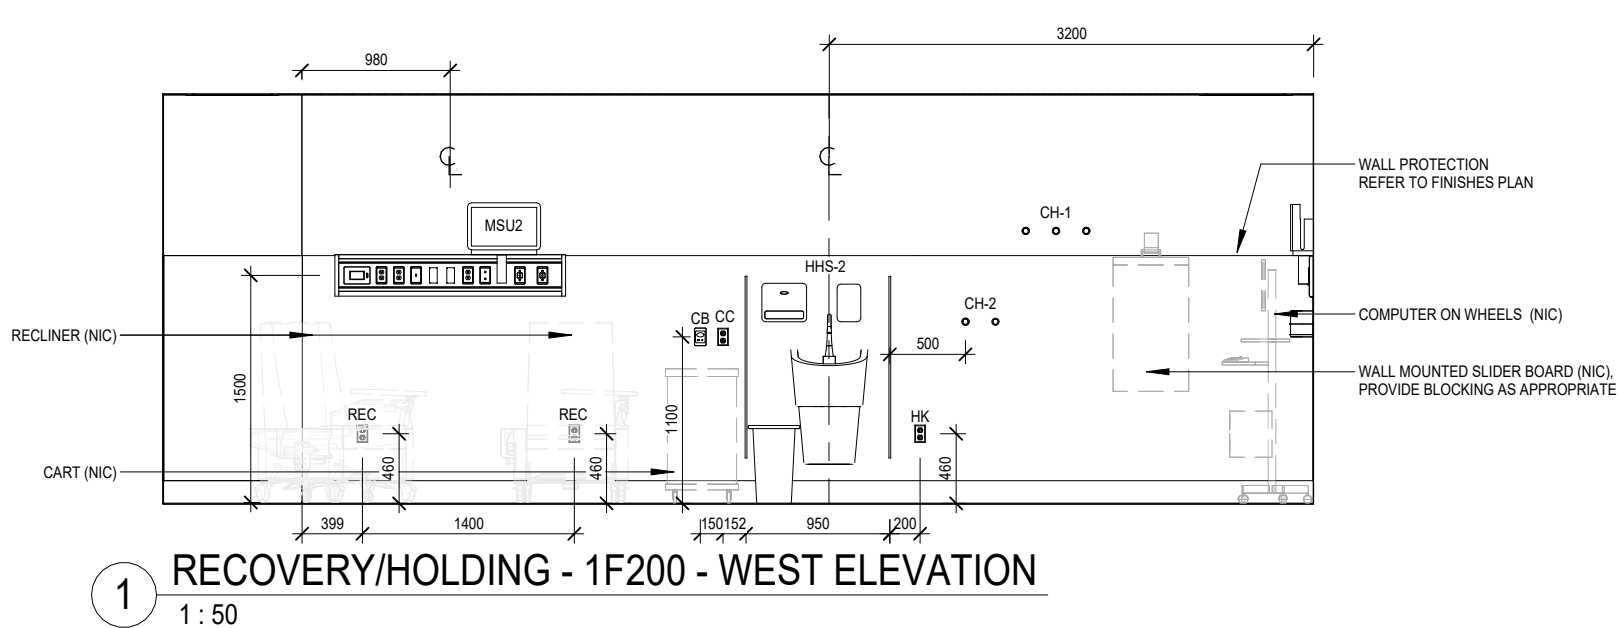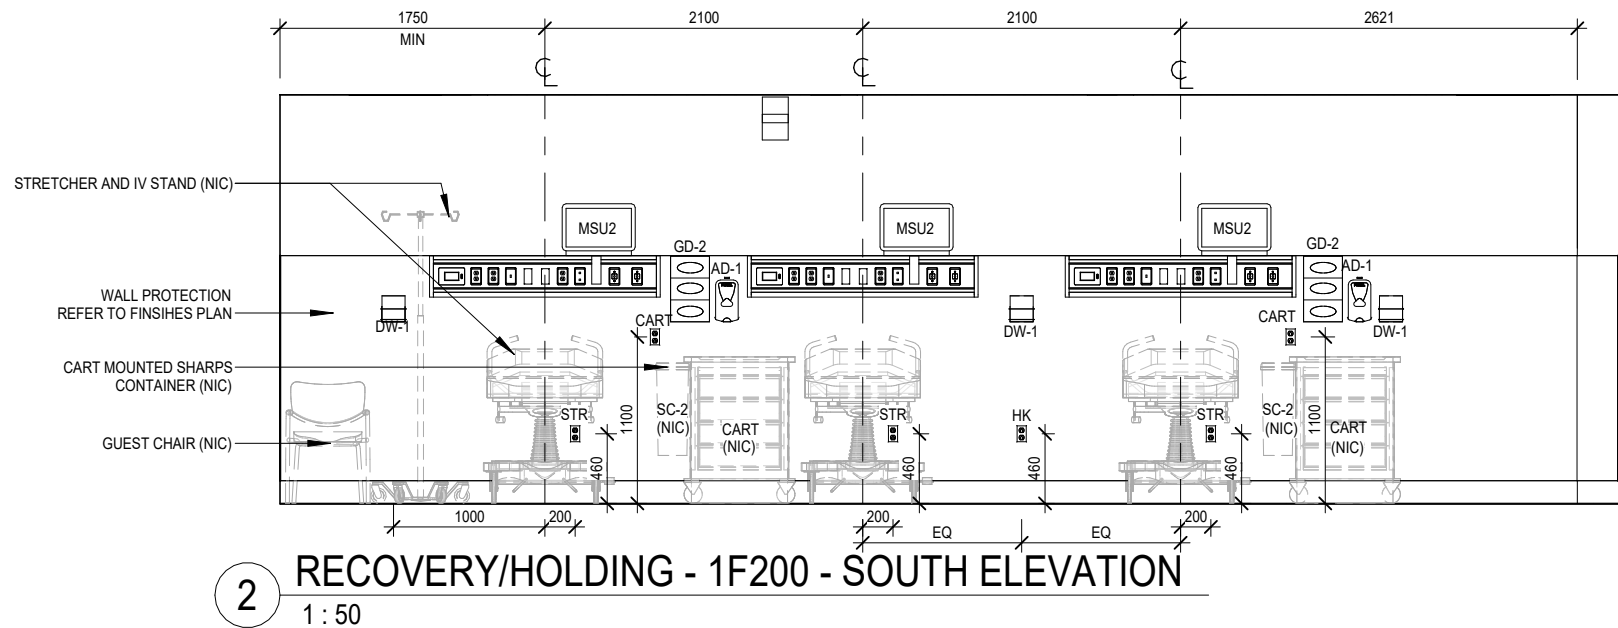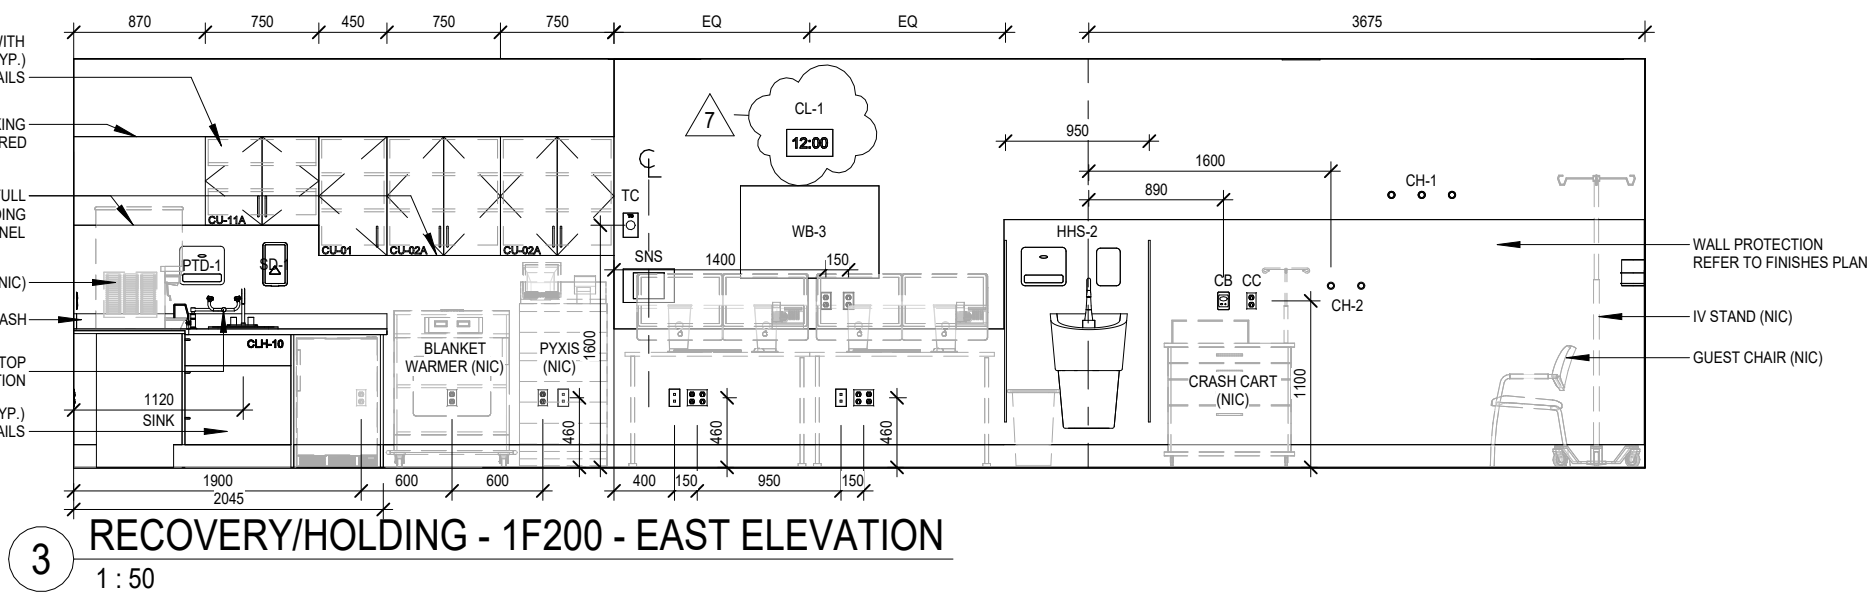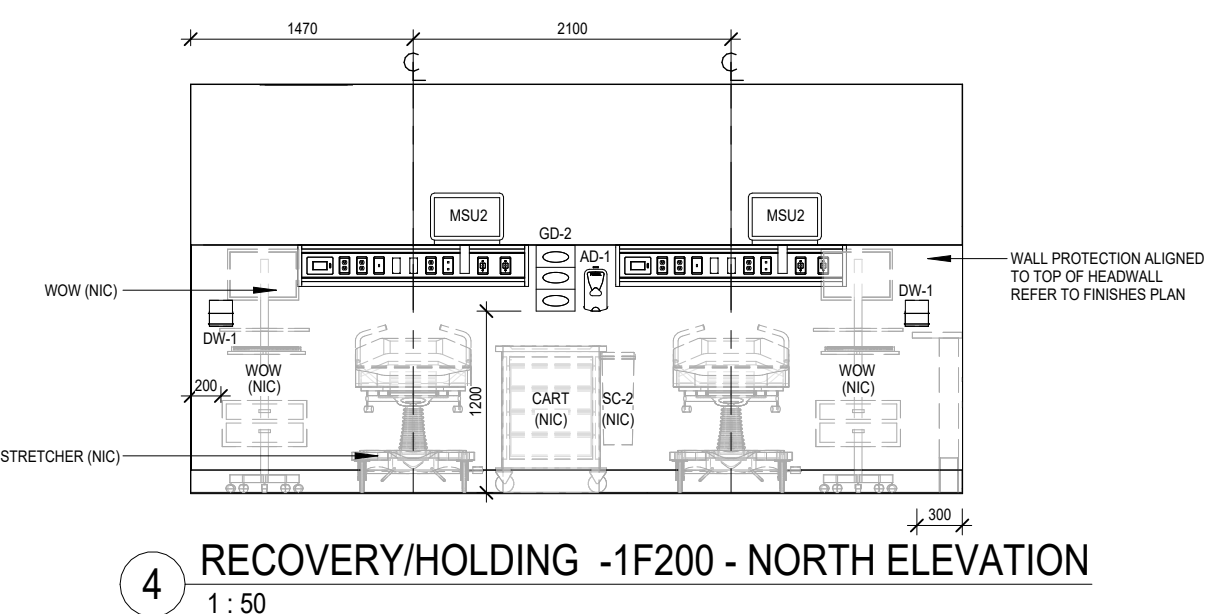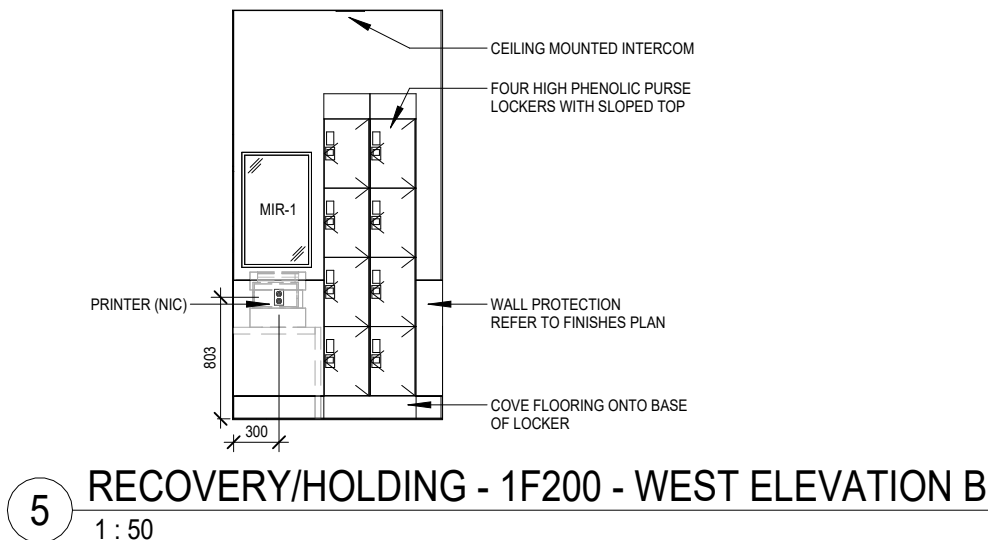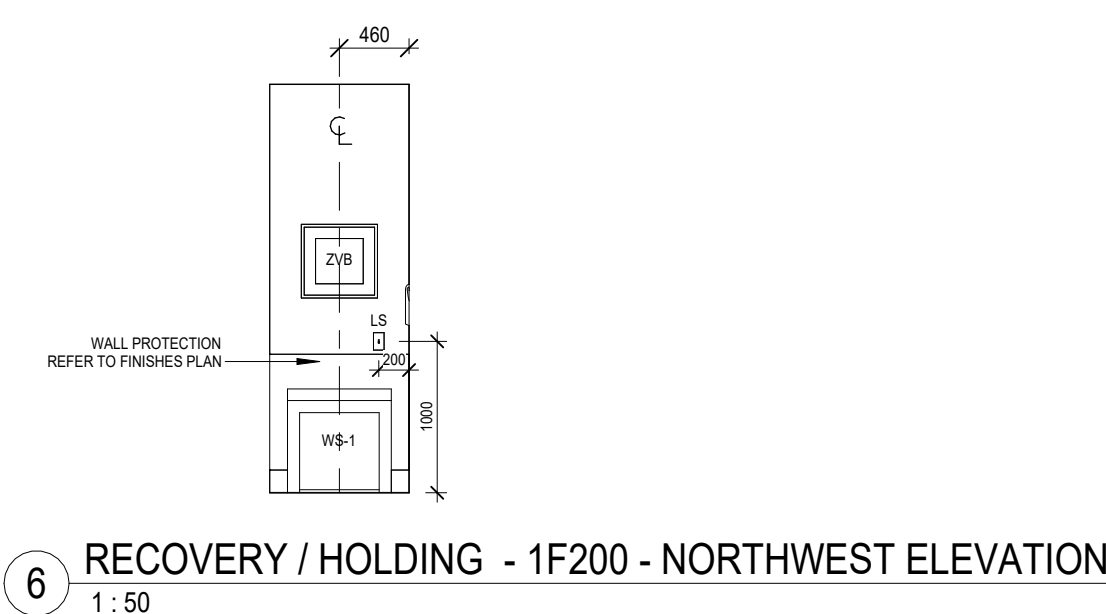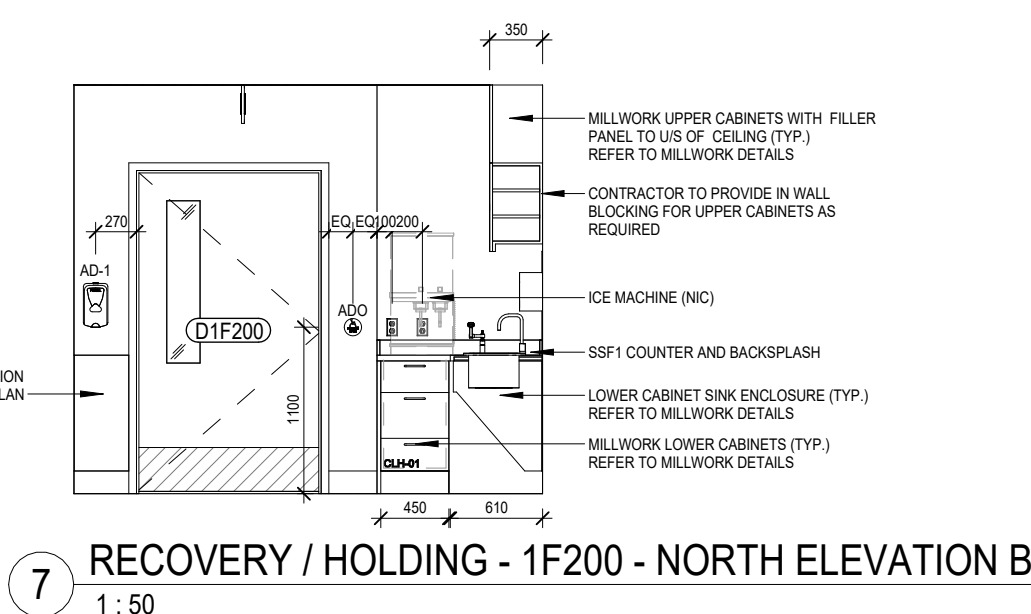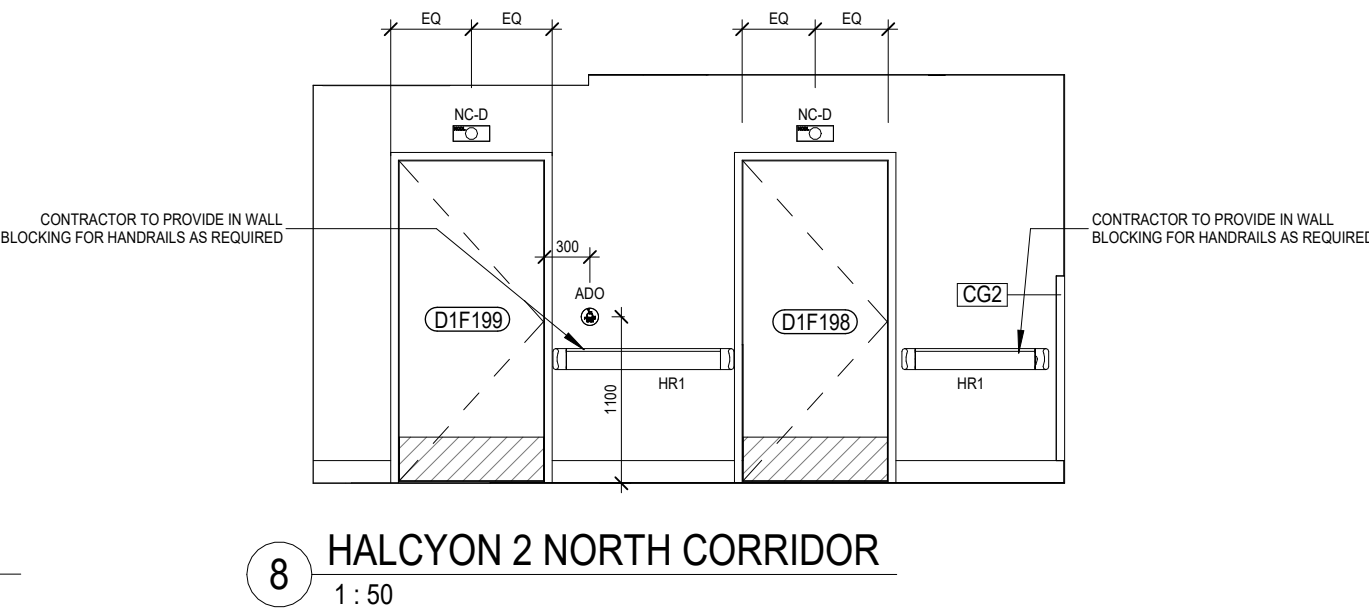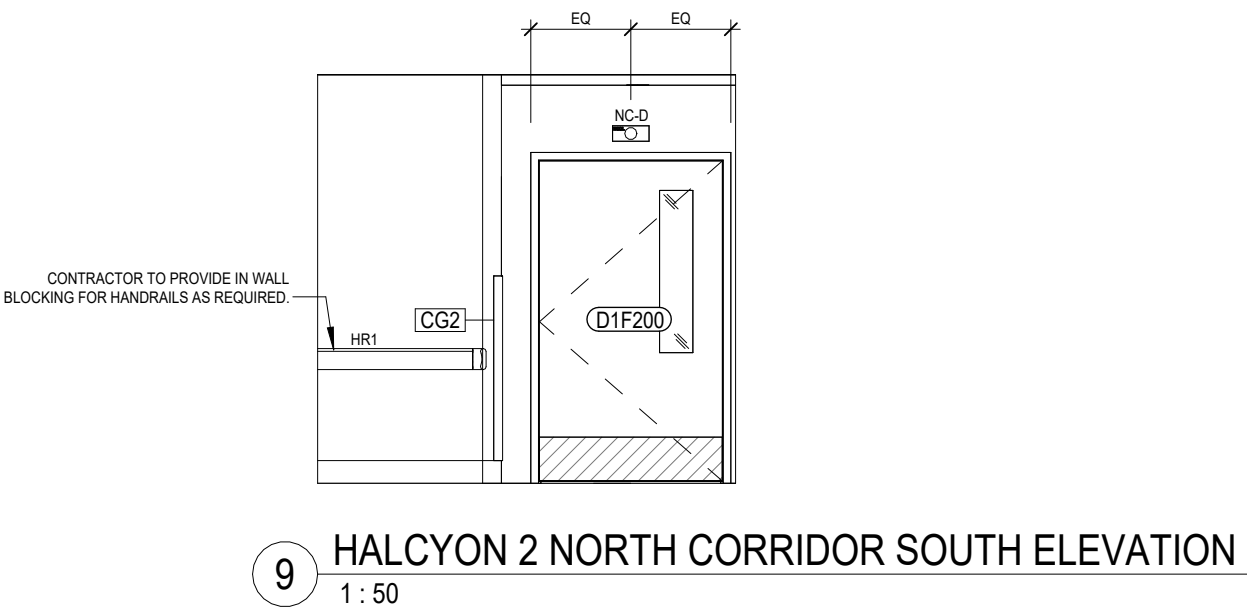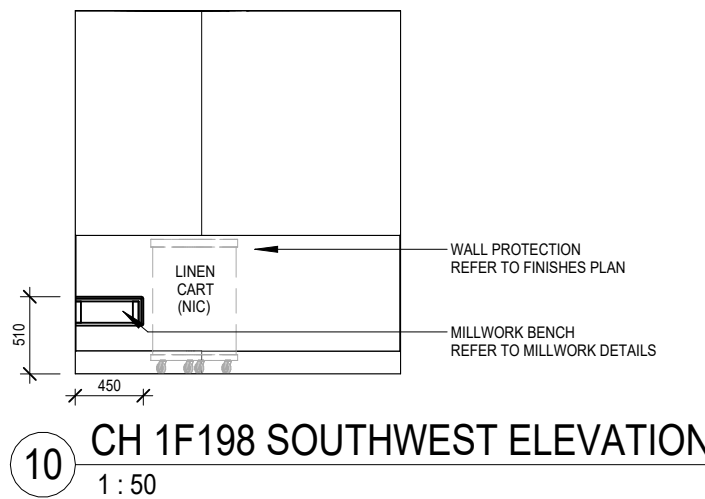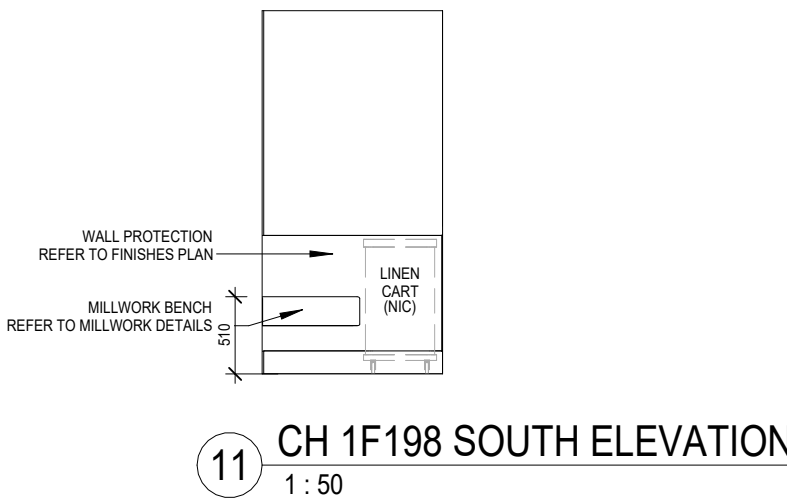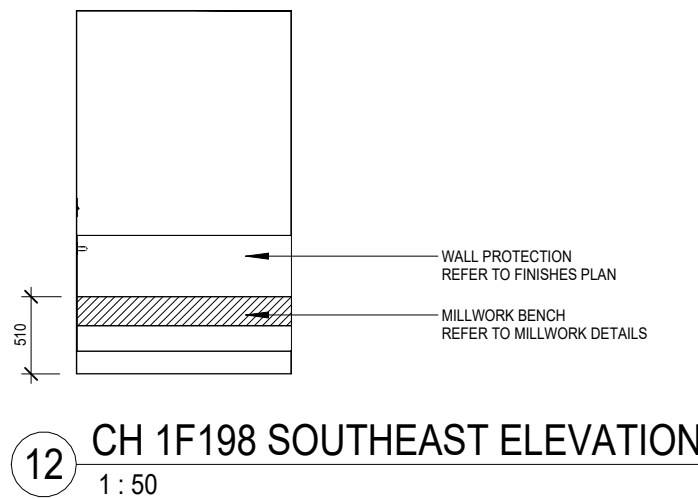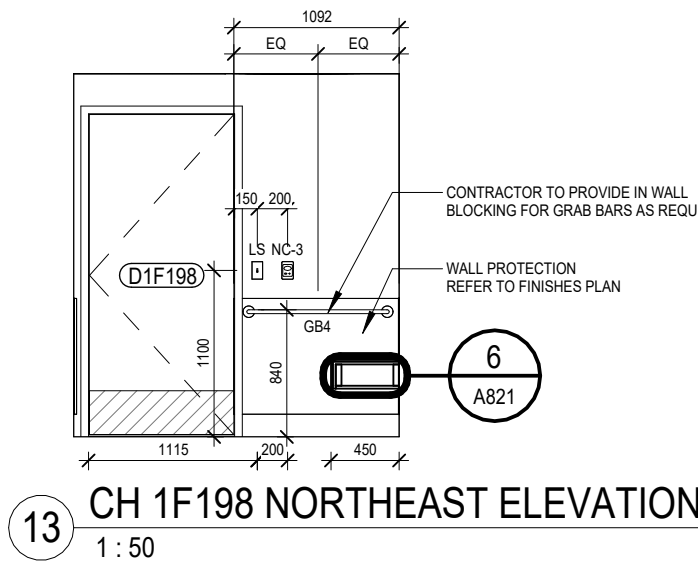

CLIENT:

Trillium Health Partners
2200 Eglinton Avenue West
Mississauga, ON, L5M 2N1
905 813 2200
thp.ca

CONSULTANT:


CUMULUS ARCHITECTS INC.
160 Pears Ave. - Suite 300
Toronto, ON M5R 3P8
416-539-0763
www.cumulusarch.com

SEAL:

This drawing, as an instrument of service, is the property of Cumulus Architects Inc. the copyright in the same being reserved to them. No reproduction is allowed without the permission of Cumulus Architects Inc. and when made must bear its name.

This drawing is not to be scaled. The contractor is to verify dimensions and data noted herein for conformity with the conditions on site and is responsible for reporting in writing any discrepancy to Cumulus Architects Inc. for adjustment.

Cumulus will not be liable for any claims or damages arising from the unauthorized use of this drawing or any portion thereof.

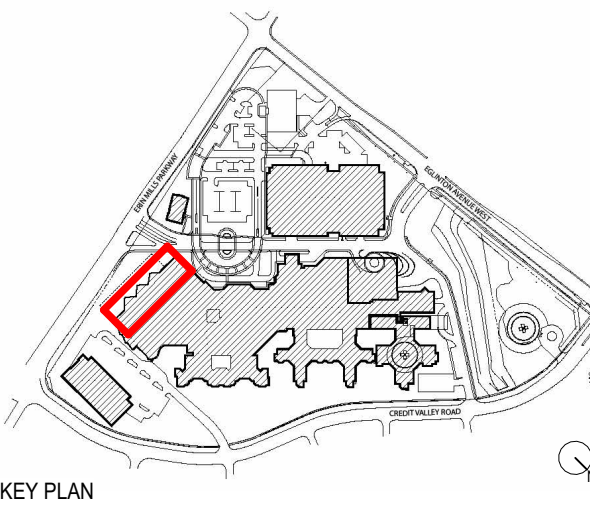

ELEVATIONS ABBREVIATION LEGEND

AD	ANTISEPTIC DISPENSER
ADO	AUTOMATIC DOOR OPENER
BFS	BOTTLE FILLING STATION
BYF	BLANKET WARMER
CB	CODE BLUE
CG	CORNER GARUD
CH	COAT HOOK
CR	CARD READER
EO	EMERGENCY POWER OFF SWITCH
EQ	EQUAL
EX	EXISTING
FXC	FIRE HOSE CABINET
FNB	FOLDABLE ROLL BOARD
GB	GRAB BAR
GD	GLOVE DISPENSER
HK	HAND HYGIENE STATION
HMS	HUMAN MACHINE INTERFACE
HR	HAND RAIL
LPO	LAST PERSON OUT SWITCH
LS	LIGHT SWITCH
MR	MIRROR
MSU	MEDICAL SERVICE UNIT
NC	NOT IN CONTRACT
NC	NURSE CALL
O	OXYGEN (MED. GAS)
OS	OCCUPANCY SENSOR
PH	PHONE
PH	PAMPHLET HOLDER
PL	PLASTIC LAMINATE
PTD	PAPER TOWEL DISPENSER
PK	PRINTER (OUTLET)
RUB	RELAY JUNCTION BOX
SC	SHARP CONTAINER
SD	SOAP DISPENSER
TC	THERMISTAT
TPD	TOILET PAPER DISPENSER
VACUUM (MED. GAS)	VACUUM (MED. GAS)
WB	WHITE BOARD
WR	WASTE RECEPTACLE
ZVB	ZONE VALVE BOX (MED. GAS)

NOTE: FOR MSN DETAILS, REFER TO A1001

7	Issued for Addendum 1	2026/02/04
6	Issued for Tender	2025/12/16
5	Issued for Building Permit	2025/12/02
4	Issued For MOH 2.3 Resubmission	2025/06/20
2	Issued For MOH 2.3 Costing	2024/09/13
NO	DESCRIPTION	DATE

SHEET REVISION

PROJECT:
Oncology Radiation Treatment Expansion
2200 Eglinton Ave W,
Mississauga, ON L5M 2N1

TITLE:
INTERIOR ELEVATIONS
PHASE 2

PROJECT NO:
23010
CHECKED:
Checker

DRAWING NO:
A805

LEGEND - ELEVATIONS

FEATURE PAINT. REFER TO FINISHES PLAN

CLIENT:

Trillium Health Partners
2200 Eglinton Avenue West
Mississauga, ON, L5M 2N1
905 813 2200
thp.ca

CONSULTANT:


CUMULUS ARCHITECTS INC.
160 Pears Ave. - Suite 300
Toronto, ON M5R 3P8
416-539-0763
www.cumulusarch.com

SEAL:

This drawing, as an instrument of service, is the property of Cumulus Architects Inc. the copyright in the same being reserved to them. No reproduction is allowed without the permission of Cumulus Architects Inc. and when made must bear its name.

This drawing is not to be scaled. The contractor is to verify dimensions and data noted herein for conformity with the conditions on site and is responsible for reporting in writing any discrepancy to Cumulus Architects Inc. for adjustment.

Cumulus will not be liable for any claims or damages arising from the unauthorized use of this drawing or any portion thereof.

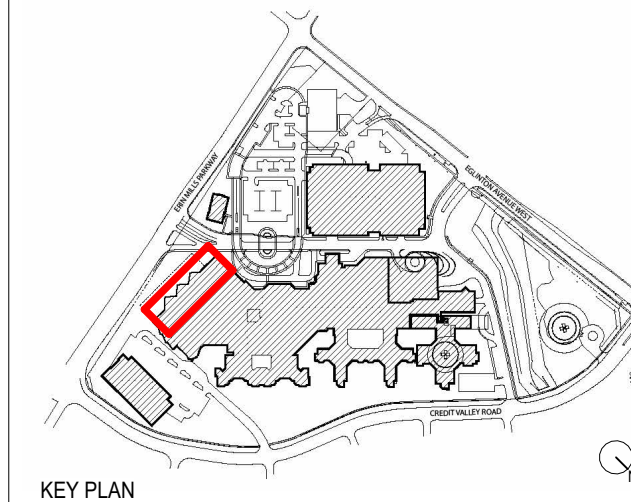

KEY PLAN

ELEVATIONS ABBREVIATION LEGEND

AD ANTISEPTIC DISPENSER
ADO AUTOMATIC DOOR OPENER
BFS BOTTLE FILLING STATION
BFV BLANKET VARMER
CB CODE BLUE
CG CORNER GUARD
CH COAT HOOK
CR CARD READER
EPO EMERGENCY POWER OFF SWITCH
EQ EQUAL
EX EXISTING
FHC FIRE HOSE CABINET
FNB FOLDABLE ROLL BOARD
GB GIBB BAR
GD GLOVE DISPENSER
HK HOUSEKEEPING
HHS HAND HYGIENE STATION
HM HUMAN MACHINE INTERFACE
HR HAND RAIL
LPO LAST PERSON OUT SWITCH
LS LIGHT SWITCH
MR MIRROR
MSU MEDICAL SERVICE UNIT
NC NOT IN CONTRACT
NC NURSE CALL
O OXYGEN (MED. GAS)
OS OCCUPANCY SENSOR
PROS PUSH BUTTON OPERATOR SYSTEM
PH PAMPHLET HOLDER
PL PLASTIC LAMINATE
PTD PAPER TOWEL DISPENSER
PK PRINTER (OUTLET)
RUB RELAY JUNCTION BOX
SC SHARPS CONTAINER
SD SOAP DISPENSER
TC THERMOSTAT
TPO TOWEL PAPER DISPENSER
V VACUUM (MED. GAS)
WB WHITE BOARD
WR WASTE RECEPTACLE
ZVB ZONE VALVE BOX (MED. GAS)


NO	DESCRIPTION	DATE
7	Issued for Addendum 1	2026/02/04
6	Issued for Tender	2025/12/16
5	Issued for Building Permit	2025/12/02
4	Issued For MOH 2.3 Resubmission	2025/06/20
2	Issued For MOH 2.3 Costing	2024/09/13

PROJECT:
Oncology Radiation Treatment Expansion
2200 Eglinton Ave W,
Mississauga, ON L5M 2N1


TITLE:
INTERIOR ELEVATIONS
PHASE 2

PROJECT NO:
23010
CHECKED:
Checker


DRAWING NO:
A806

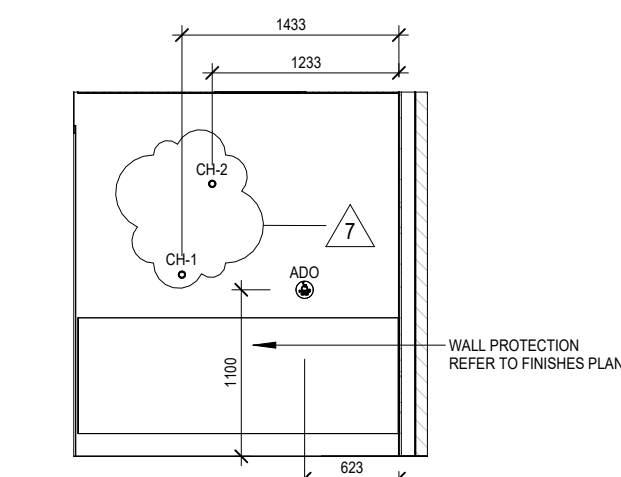


12 CH 1F205 NORTH ELEVATION
1 : 50

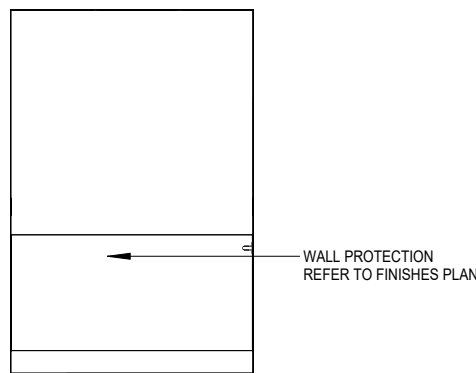


11 CH 1F205 EAST ELEVATION
1 : 50

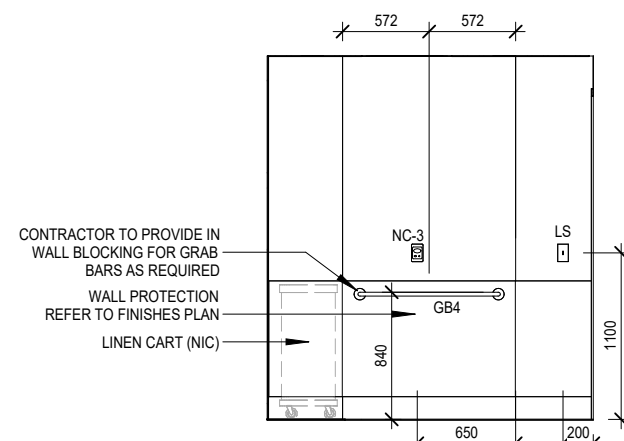


10 CH 1F205 - SOUTH ELEVATION
1 : 50

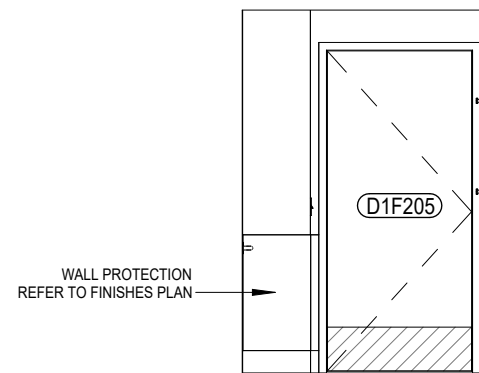


9 CH 1F205 WEST ELEVATION
1 : 50

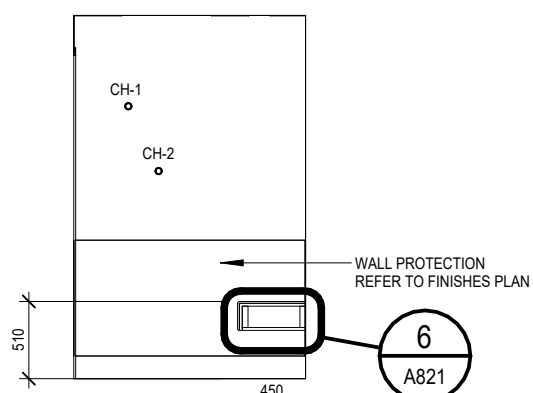


8 CH 1F206 NORTH ELEVATION
1 : 50

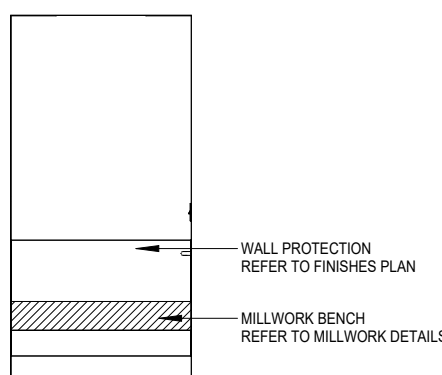


7 CH 1F206 EAST ELEVATION
1 : 50

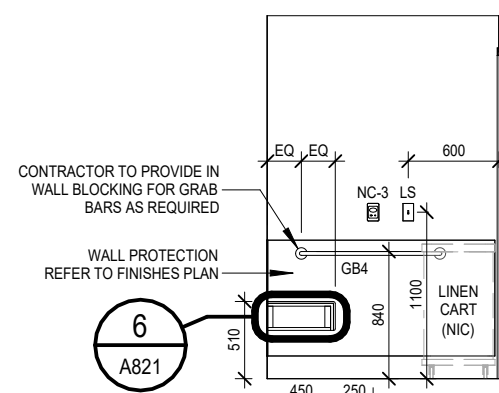


6 CH 1F206 SOUTH ELEVATION
1 : 50

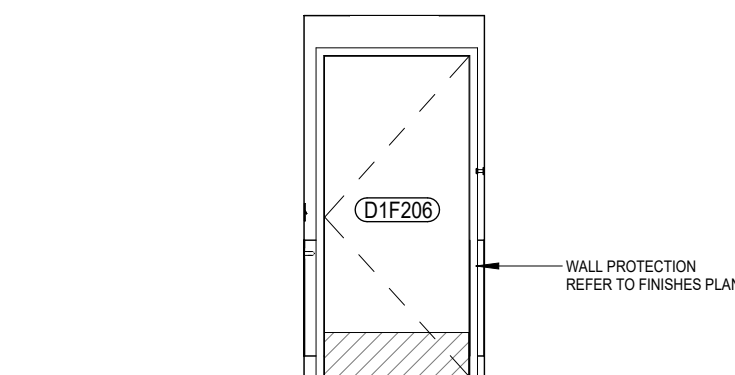


5 CH 1F206 WEST ELEVATION
1 : 50

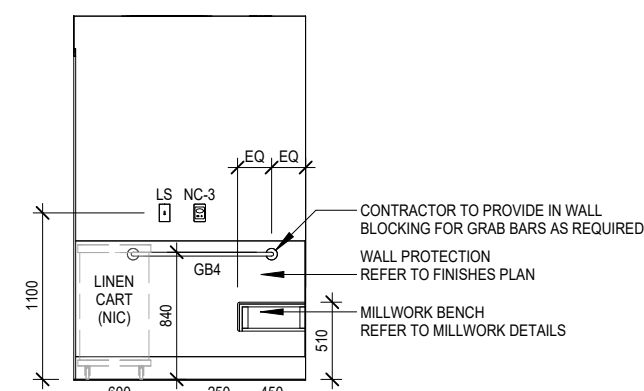


4 CH 1F207 - NORTH ELEVATION
1 : 50

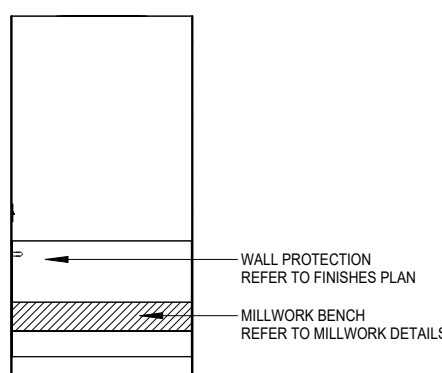

3 CH 1F207 - EAST ELEVATION
1 : 50

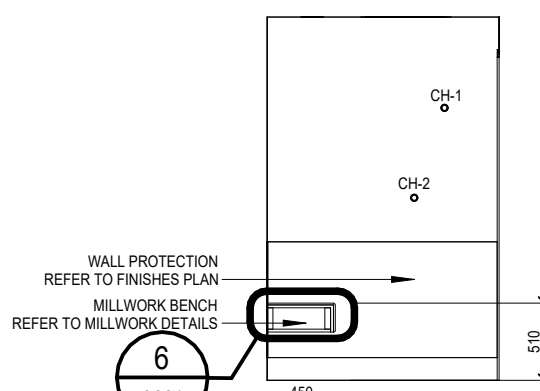


2 CH 1F207 SOUTH ELEVATION
1 : 50

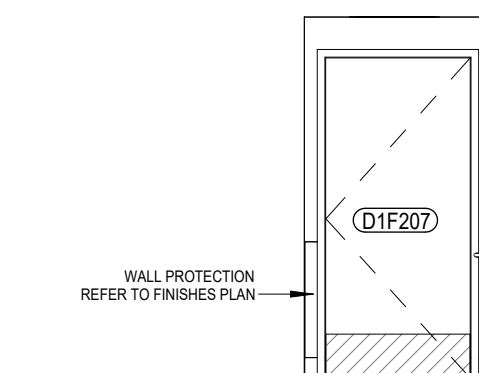


1 CH 1F207 WEST ELEVATION
1 : 50


 FEATURE PAINT. REFER TO FINISHES PLAN

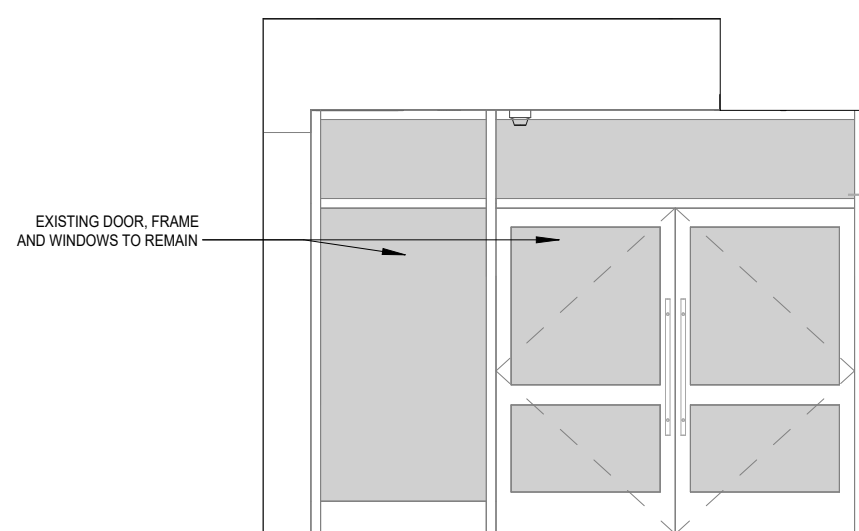


12 HALCYON 3 ENTRANCE SOUTH ELEVATION
1 : 50

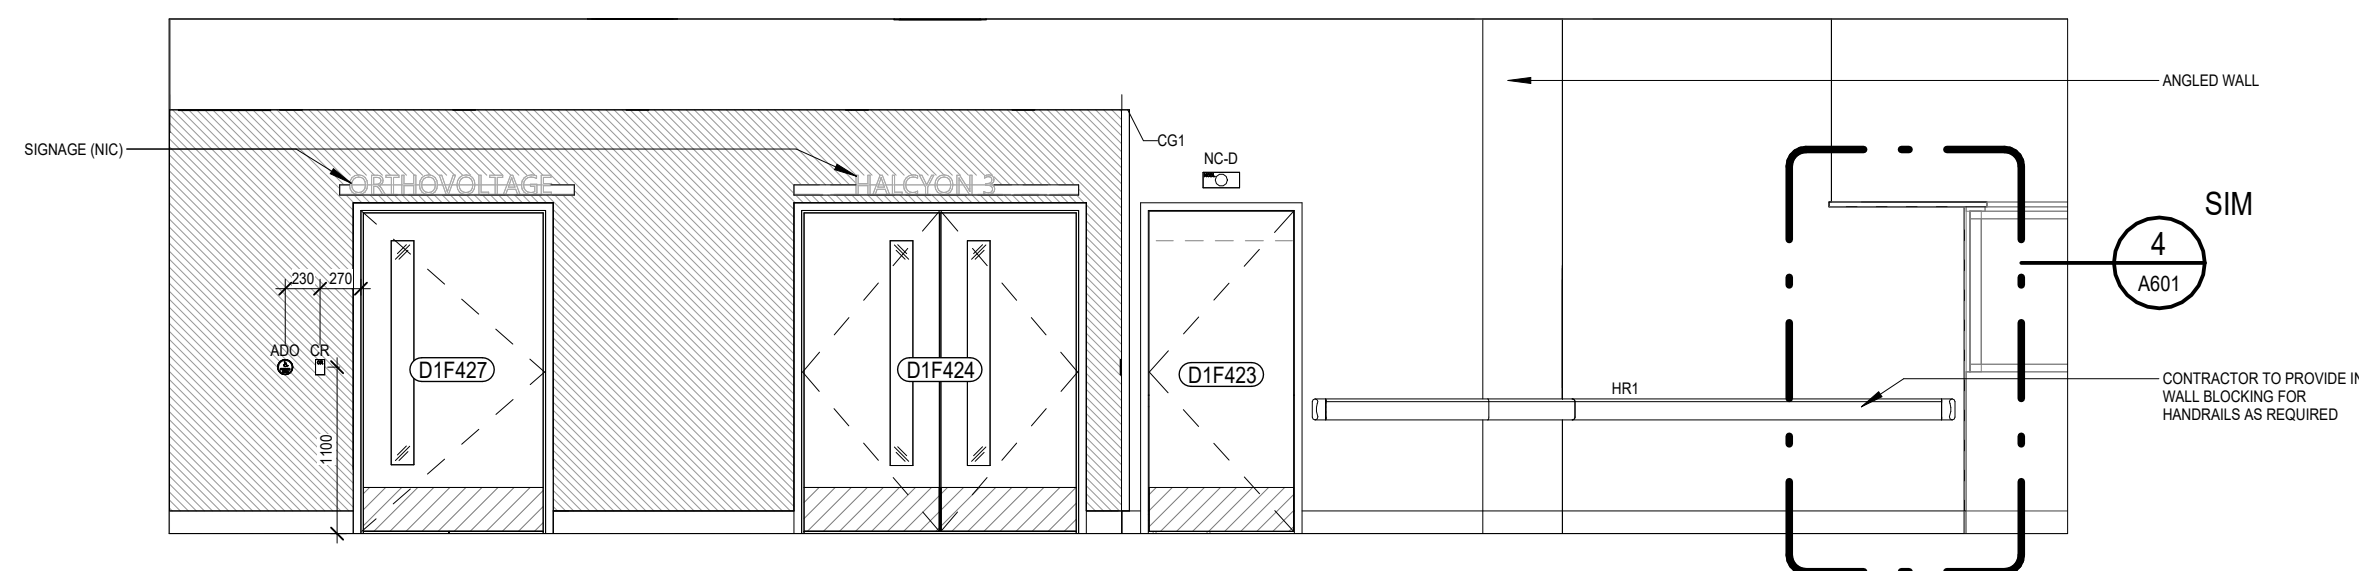


11 HALCYON 3 ENTRANCE WEST ELEVATION
1:50

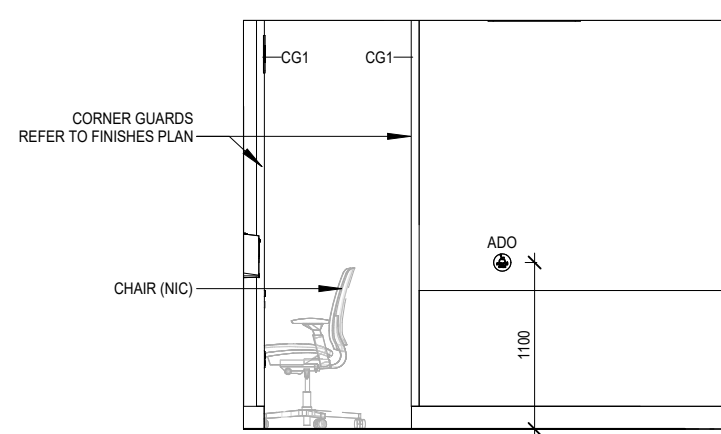


10 HALCYON 3 VESTIBULE NORTH ELEVATION
1:50

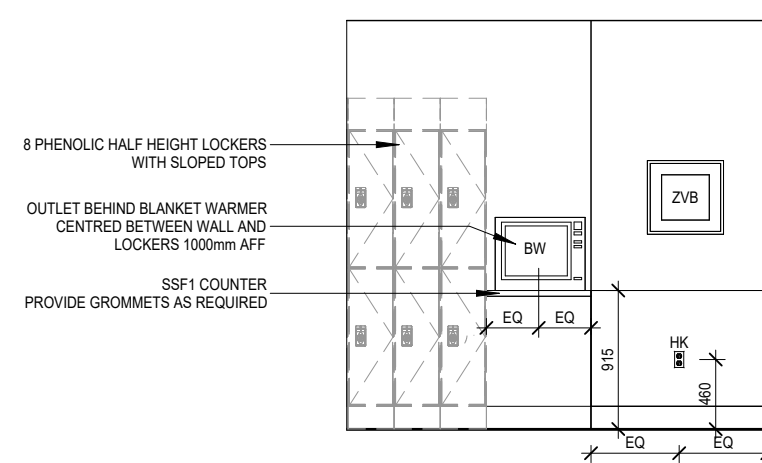


9 HALCYON 3 VESTIBULE SOUTH ELEVATION
1:50

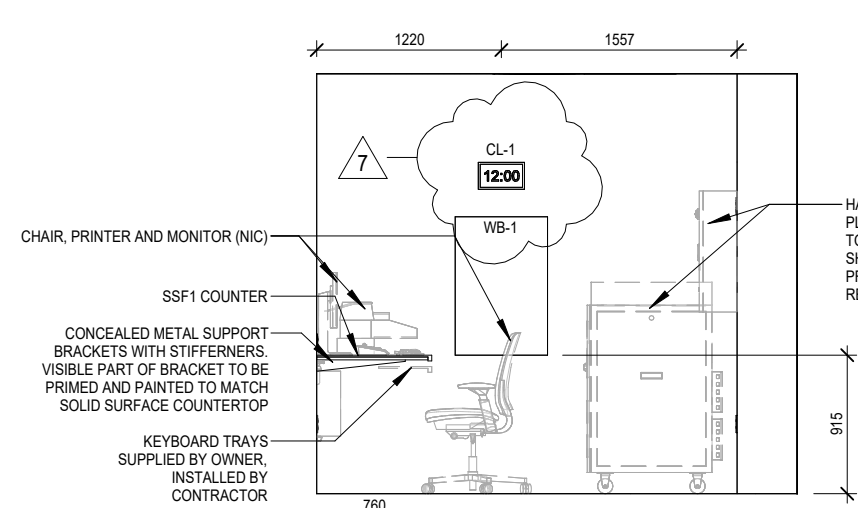


8 HALCYON 3 CONTROL AREA NORTH ELEVATION
1:50

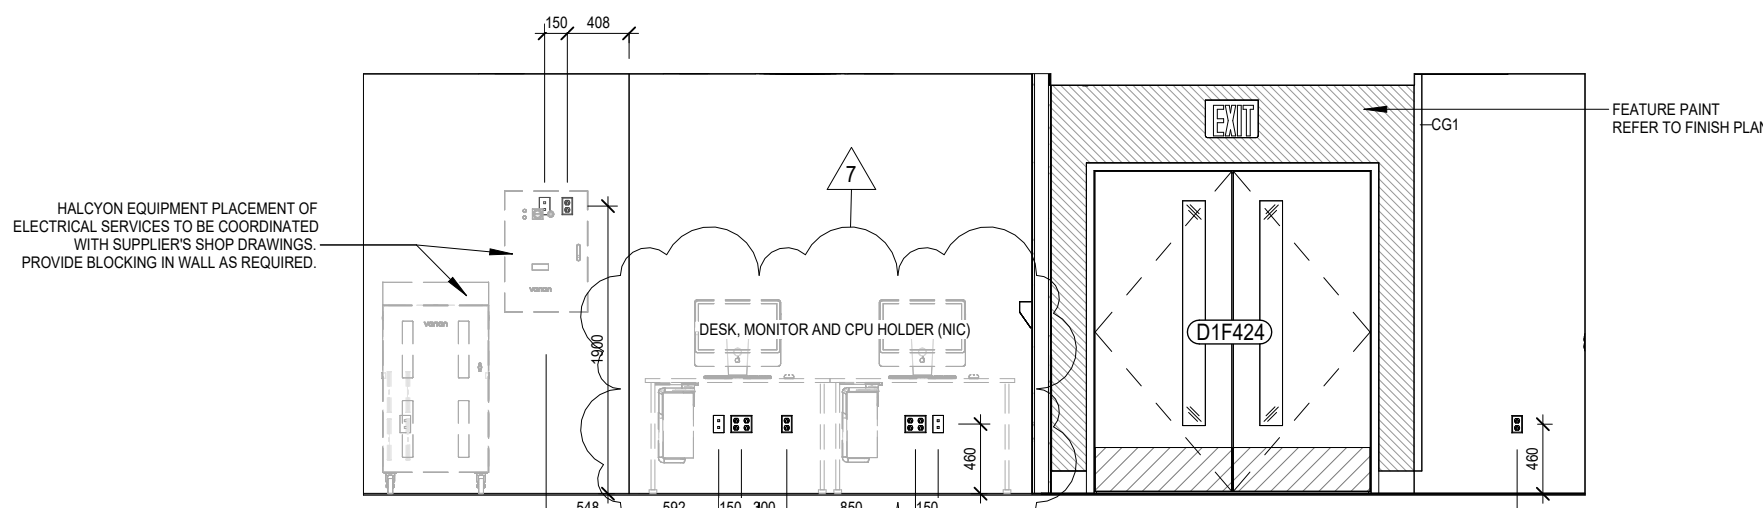


7 HALCYON 3 - CONTROL AREA - EAST ELEVATION
1:50

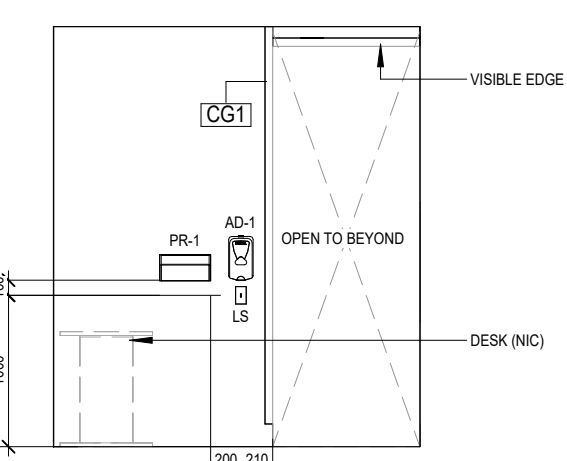


6 HALCYON 3 CONTROL AREA SOUTH ELEVATION
1:50

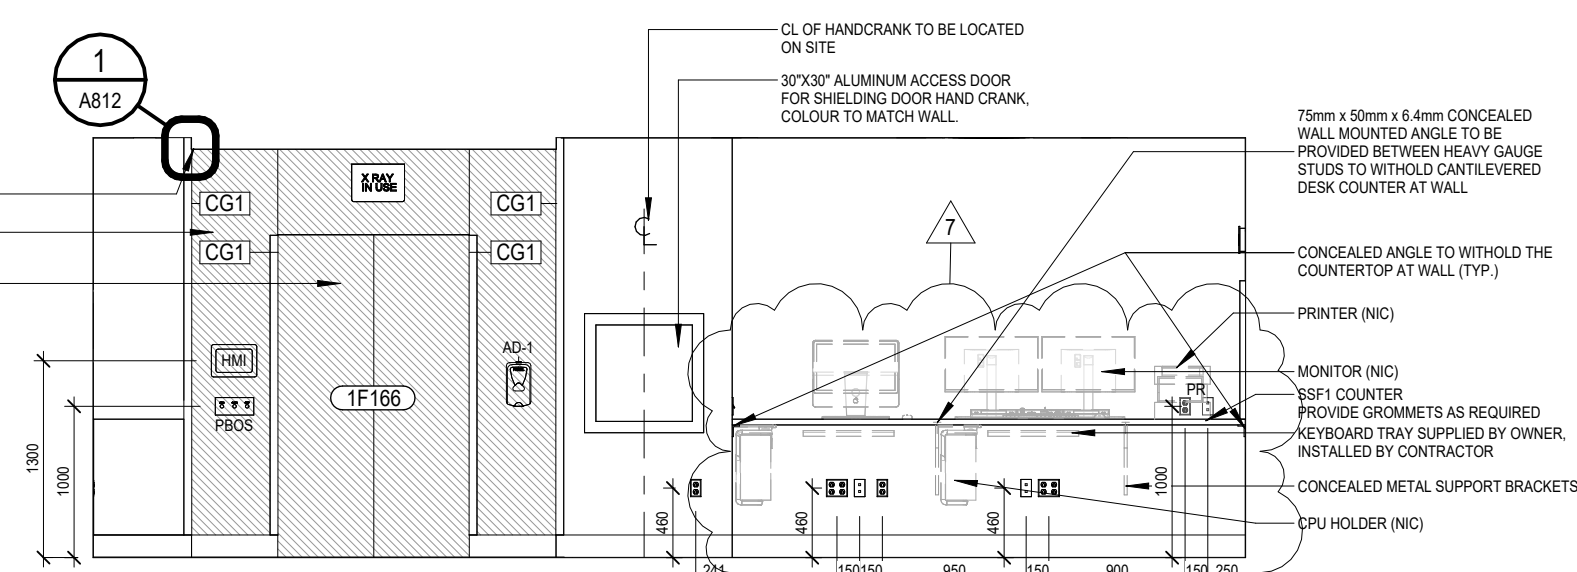


5 HALCYON 3 VESTIBULE WEST ELEVATION
1:50

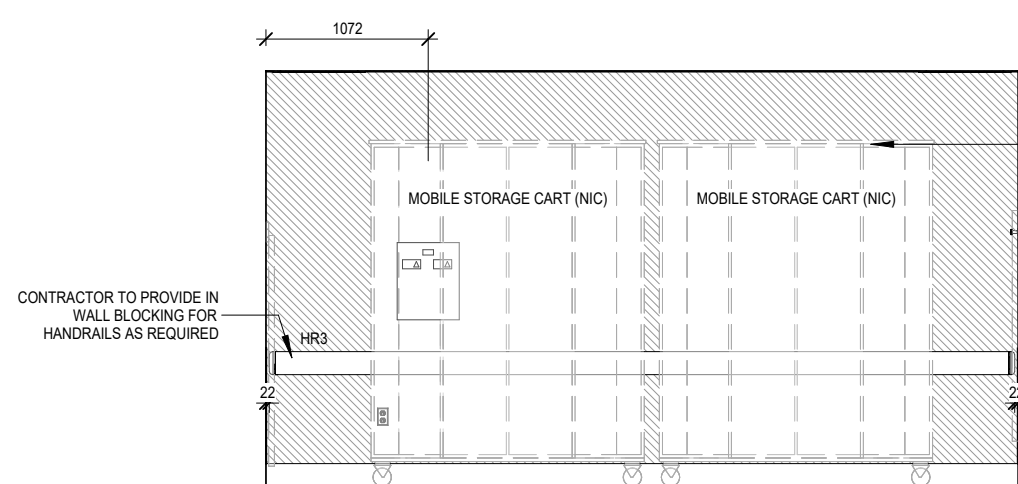


4 HALCYON 3 NORTH ELEVATION
1:50

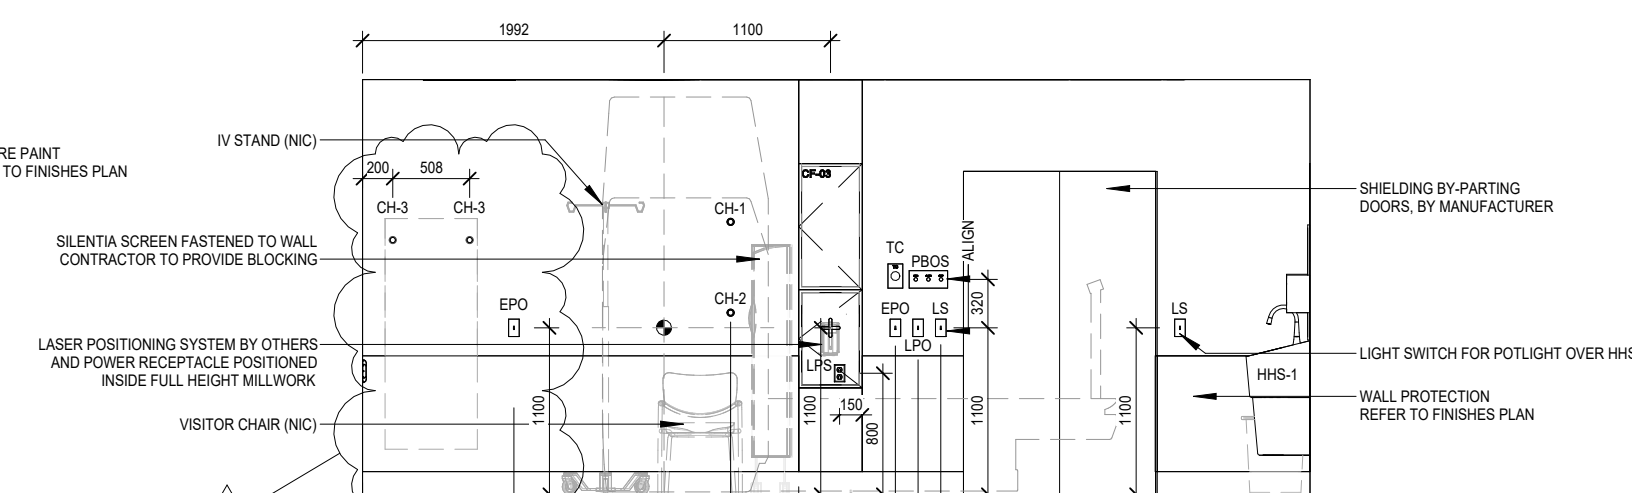

3 HALCYON 3 - EAST ELEVATION
1:50

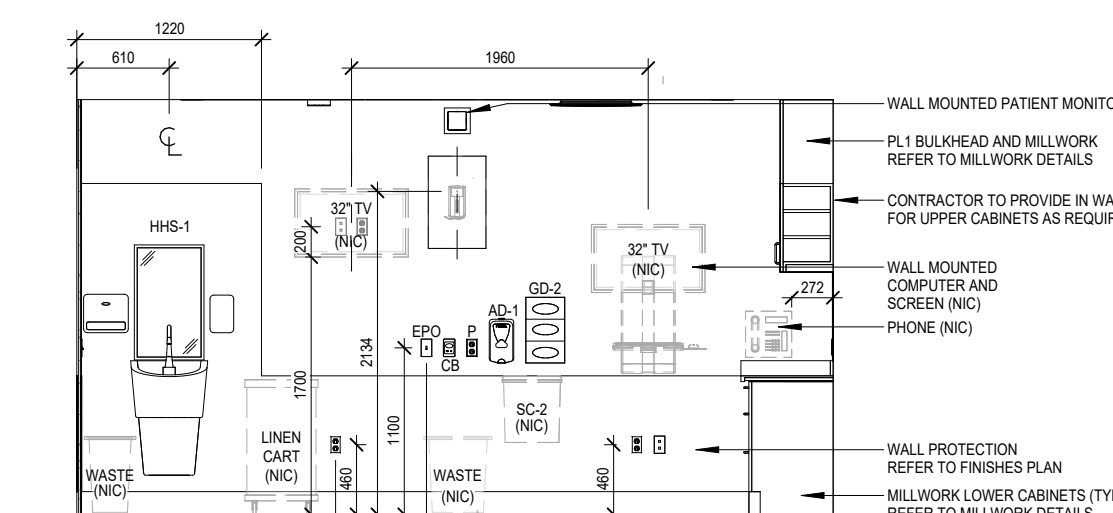

2 HALCYON 3 - SOUTH ELEVATION
1:50

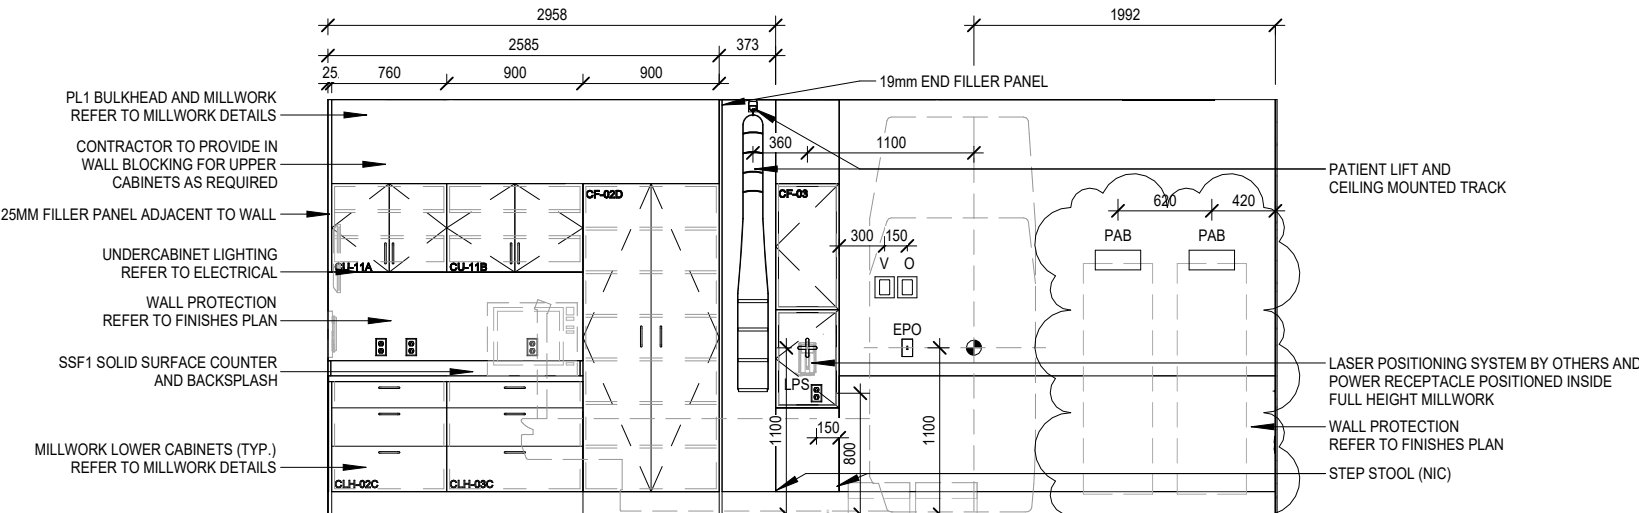

1 HALCYON 3 - WEST ELEVATION
1:50

CLIENT:	
---------	--



2200 Eglinton Avenue West
Mississauga, ON, L5M 2N1
905 813 2200
thp.ca

CONSULTANT




160 Pears Ave. - Suite 300
Toronto, ON M5R 3P8
416-539-0763
www.cumulusarch.com

SEAL:

This drawing, as an instrument of service, is the property of Cumulus Architects Inc., the copyright in the same being reserved to them. No reproduction is allowed without the permission of Cumulus Architects Inc. and when made must bear its name.

This drawing is not to be scaled. The contractor is to verify dimensions and data noted herein for conformity with the conditions on site and is responsible for reporting in writing any discrepancy to Cumulus Architects Inc. for adjustment.

Cumulus will not be liable for any claims or damages arising from the unauthorized use of this drawing or any portion thereof.

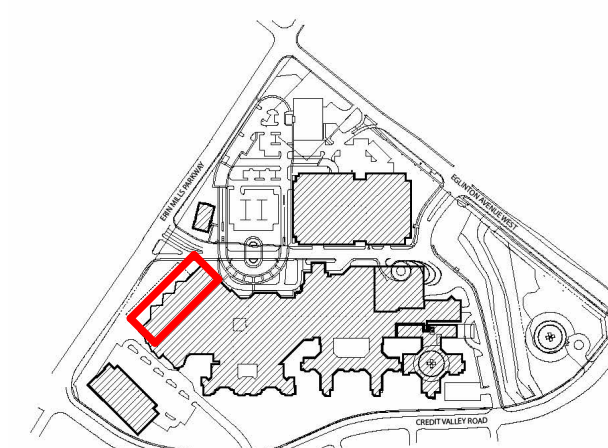

KEY PLANS

ELEVATIONS ABBREVIATION LEGEND

AD	ANTISETPIC DISPENSER
ADO	AUTOMATIC DOOR OPENER
ADP	ADJUSTING STATION
BW	BLUE
CB	COTTON BALL WARMER
CH	CHILLER
CH	COAT HOOK
CR	CARD READER
EPD	EMERGENCY POWER OFF SW
EQ	EQUAL
EX	EXHAUST
FHC	FIRE HOSE CABINET
FRB	FOLGABLE ROLL BOARD
GB	GRAB BAR
GD	GLUE DISPENSER
HK	HOUSEKEEPING
HRS	HAND HYGIENE
HM	HUMAN MACHINE INTERFACE
HM	HAND MACHINE
LPS	LAST PERSON OUT SWITCH
LPO	LIGHT SWITCH
LS	LEVER
MSU	MEDICAL SERVICE UNIT
NC	NOT IN CONTACT
NO	NURSE CALL
NO	OXYGEN MED GAS
NO	OCCUPANCY SENSOR
PBOS	PUSH BUTTON OPERATOR
PH	PAPER TOWEL HOLDER
PTD	PLASTIC THERMATE
PT	PAPER TOWEL DISPENSER
RJ	RELAY JUNCTION
RJB	RELAY JUNCTION BOX
SC	SHARPS CONTAINER
SC	SQUID DISPENSER
TC	THERMOSTAT
TPD	TOWEL PAPER DISPENSER
V	VACUUM DRAIN
W	WHITE BOARD
W	WASTE RECEPTACLE
ZVB	ZONE VALVE BOX (MED GAS)

7	Issued for Addendum 1	2026/0
6	Issued for Tender	2025/4
5	Issued for Building Permit	2025/5
4	Issued For MOH 2.3 Resubmission	2025/5
2	Issued For MOH 2.3 Costing	2024/0
NO	DESCRIPTION	DATE

PROJECT:
Oncology Radiation Treatment Expansion
2200 Eglinton Ave W,
Mississauga, ON L5M 2N1

TITLE:
INTERIOR ELEVATIONS
PHASE 3

PROJECT NO: 23010	DRAWING NO:
CHECKED: Checker	

A807

LEGEND - ELEVATIONS

FEATURE PAINT. REFER TO FINISHES PLAN

CLIENT:

Trillium Health Partners
2200 Eglinton Avenue West
Mississauga, ON, L5M 2N1
905 813 2200
thp.ca

CONSULTANT:


CUMULUS ARCHITECTS INC.
160 Pears Ave. - Suite 300
Toronto, ON M5R 3P8
416-539-0763
www.cumulusarch.com

SEAL:

This drawing, as an instrument of service, is the property of Cumulus Architects Inc. the copyright in the same being reserved to them. No reproduction is allowed without the permission of Cumulus Architects Inc. and when made must bear its name.

This drawing is not to be scaled. The contractor is to verify dimensions and data noted herein for conformity with the conditions on site and is responsible for reporting in writing any discrepancy to Cumulus Architects Inc. for adjustment.

Cumulus will not be liable for any claims or damages arising from the unauthorized use of this drawing or any portion thereof.

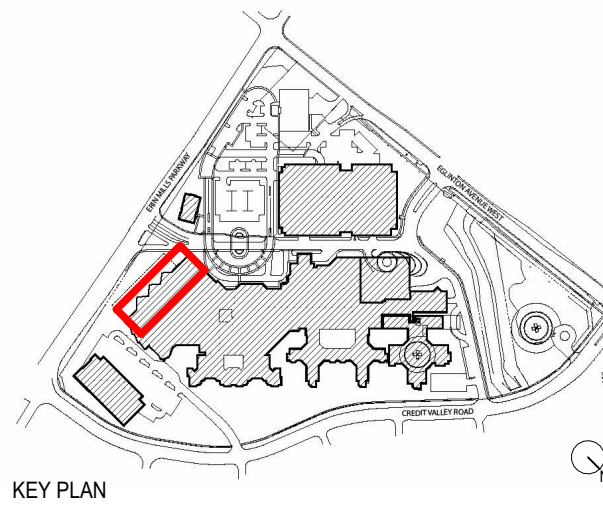

ELEVATIONS ABBREVIATION LEGEND

AD ANTISEPTIC DISPENSER
ADO AUTOMATIC DOOR OPENER
BFS BOTTLE FILLING STATION
BYF BLANKET FIRMER
CB CODE BLUE
CG CORNER GUARD
CH COAT HOOK
CR CARD READER
EPO EMERGENCY POWER OFF SWITCH
EQ EQUAL
EX EXISTING
FPC FIRE HOSE CABINET
FNB FOLDABLE ROLL BOARD
GB GIBBY BAR
GO GLOVE DISPENSER
HK HAND HYGIENE STATION
HHS HAND HYGIENE STATION
HM HAND MACHINE INTERFACE
HR HAND RAIL
LPO LAST PERSON OUT SWITCH
LS LIGHT SWITCH
MR MIRROR
MSU MEDICAL SERVICE UNIT
NIC NOT IN CONTRACT
NC NURSE CALL
O OXYGEN (MED. GAS)
OS OCCUPANCY SENSOR
PPOS PUSH BUTTON OPERATOR SYSTEM
PH PAMPHLET HOLDER
PL PLASTIC LAMINATE
PTD PAPER TOWEL DISPENSER
PK PRINTER OUTLET
RUB RELAY JUNCTION BOX
SC SHARPS CONTAINER
SD SOAP DISPENSER
TC THERMISTAT
TPO TOILET PAPER DISPENSER
V VACUUM (MED. GAS)
WB WHITE BOARD
WR WASTE RECEPTACLE
ZVB ZONE VALVE BOX (MED. GAS)


NO	DESCRIPTION	DATE
7	Issued for Addendum 1	2026/02/04
6	Issued for Tender	2025/12/16
5	Issued for Building Permit	2025/12/02
4	Issued For MOH 2.3 Resubmission	2025/06/20
2	Issued For MOH 2.3 Costing	2024/09/13

SHEET REVISION


PROJECT:
Oncology Radiation Treatment Expansion
2200 Eglinton Ave W,
Mississauga, ON L5M 2N1

TITLE:
INTERIOR ELEVATIONS
PHASE 3


PROJECT NO:
23010
CHECKED:
Checker
DRAWING NO:
A808

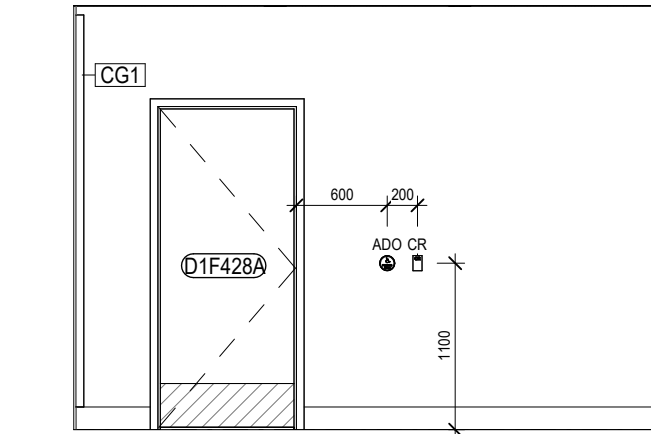


14 PHASE 3 VESTIBULE WEST ELEVATION
1:50

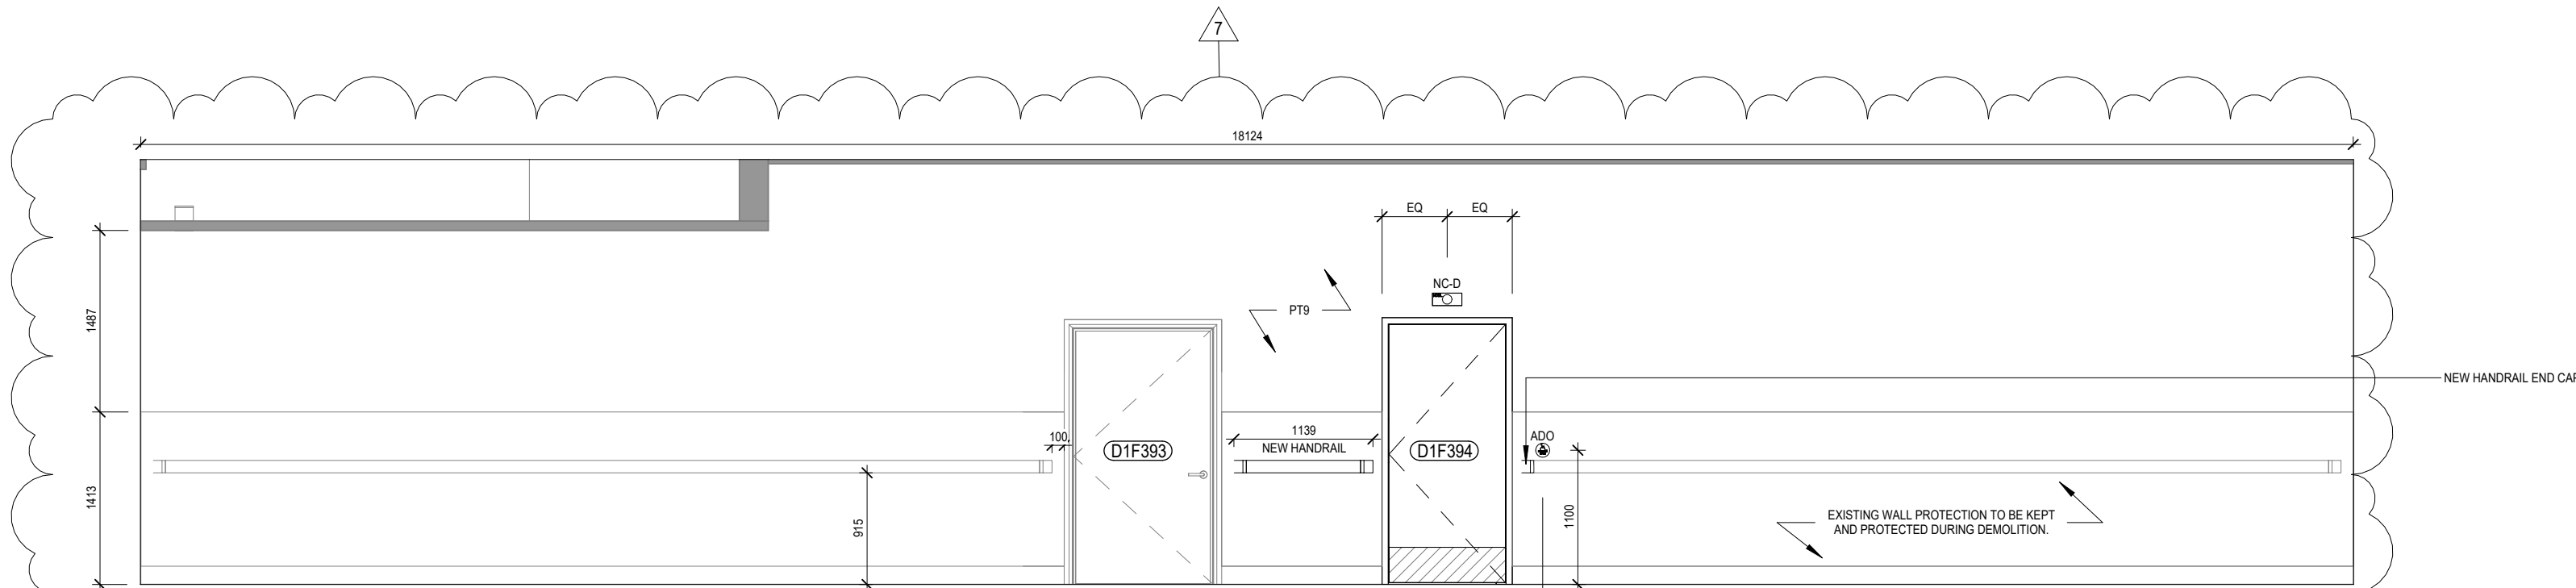


13 PHASE 3 CORRIDOR NORTH ELEVATION
1:50

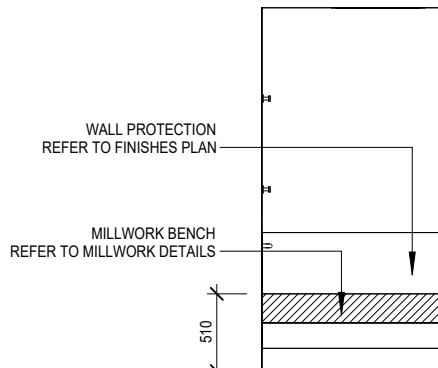


12 PATIENT CHANGE ROOM - 1F423 - NORTH ELEVATION
1:50

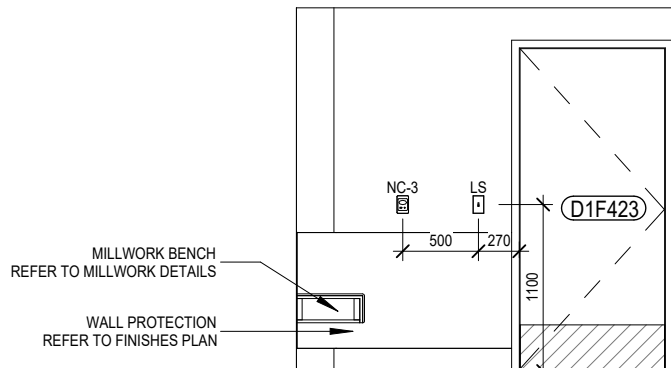


11 PATIENT CHANGE ROOM - 1F423 - EAST ELEVATION
1:50

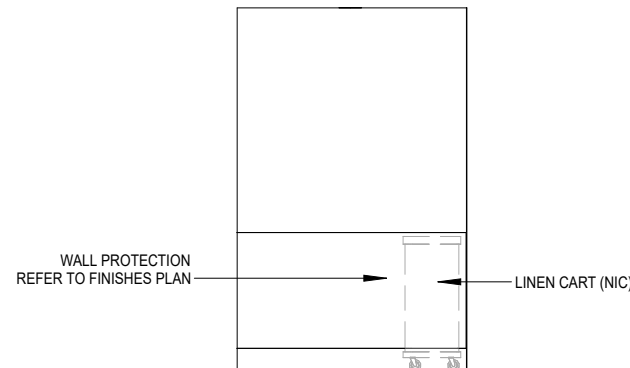


10 PATIENT CHANGE ROOM - 1F423 - SOUTH ELEVATION
1:50

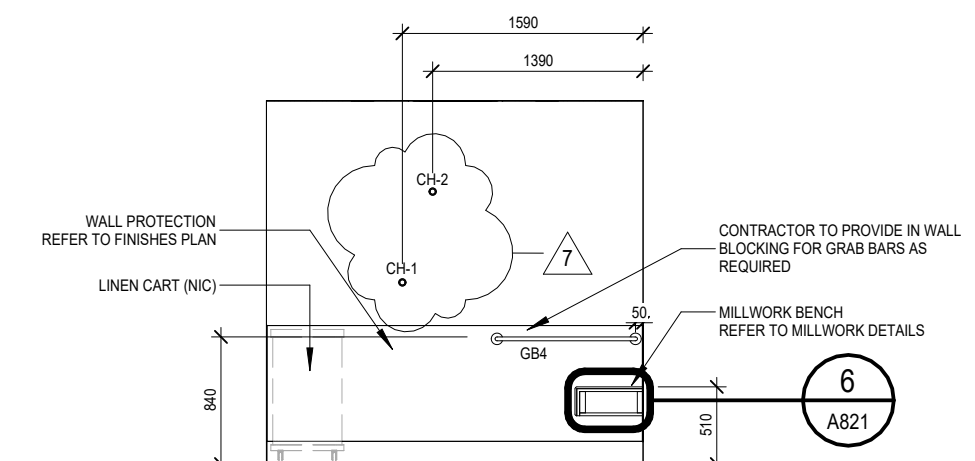


9 PATIENT CHANGE ROOM - 1F423 - WEST ELEVATION
1:50

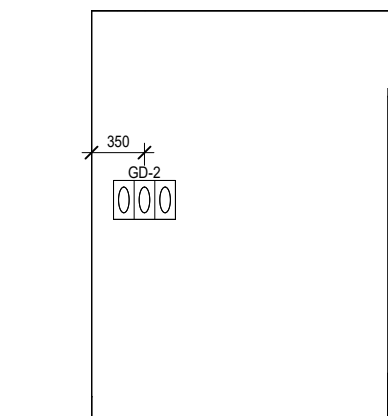


8 ORTHOVOLTAGE CONTROL - 1F427 - NORTH ELEVATION
1:50

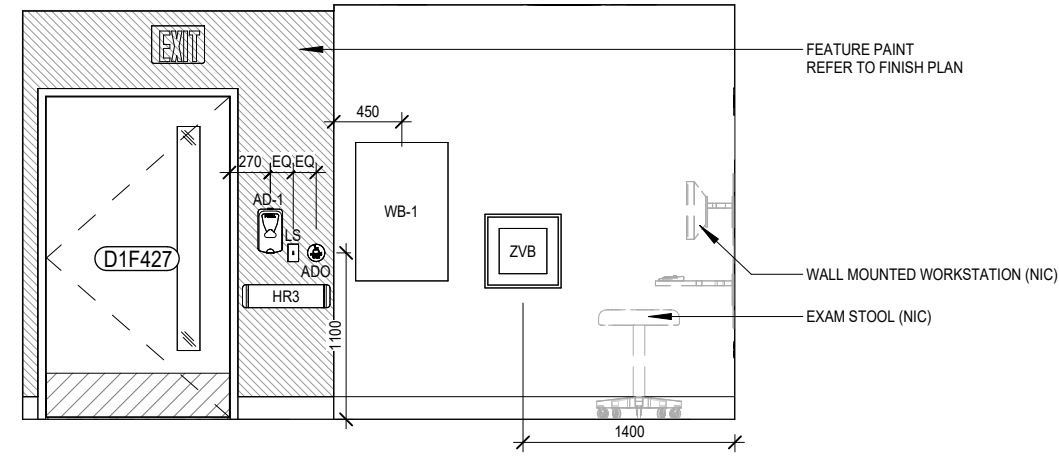


7 ORTHOVOLTAGE CONTROL - 1F427 - EAST ELEVATION
1:50

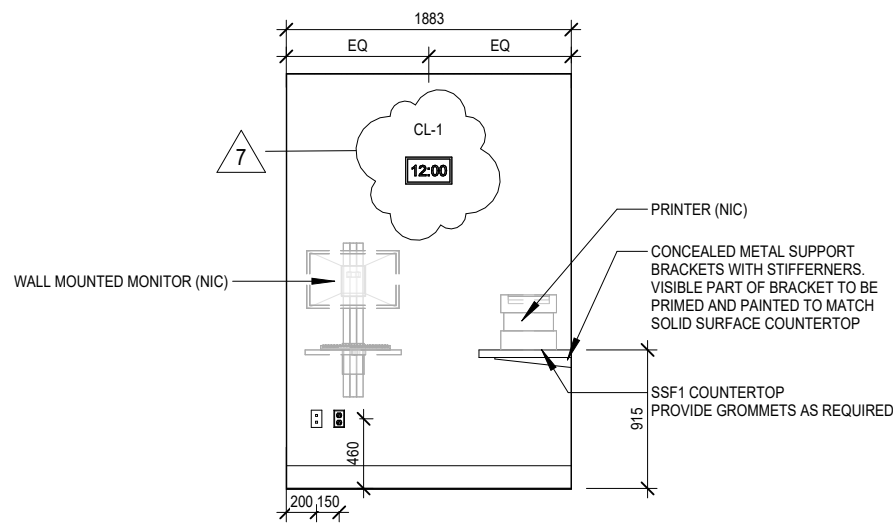


6 ORTHOVOLTAGE CONTROL - 1F427 - SOUTH ELEVATION
1:50

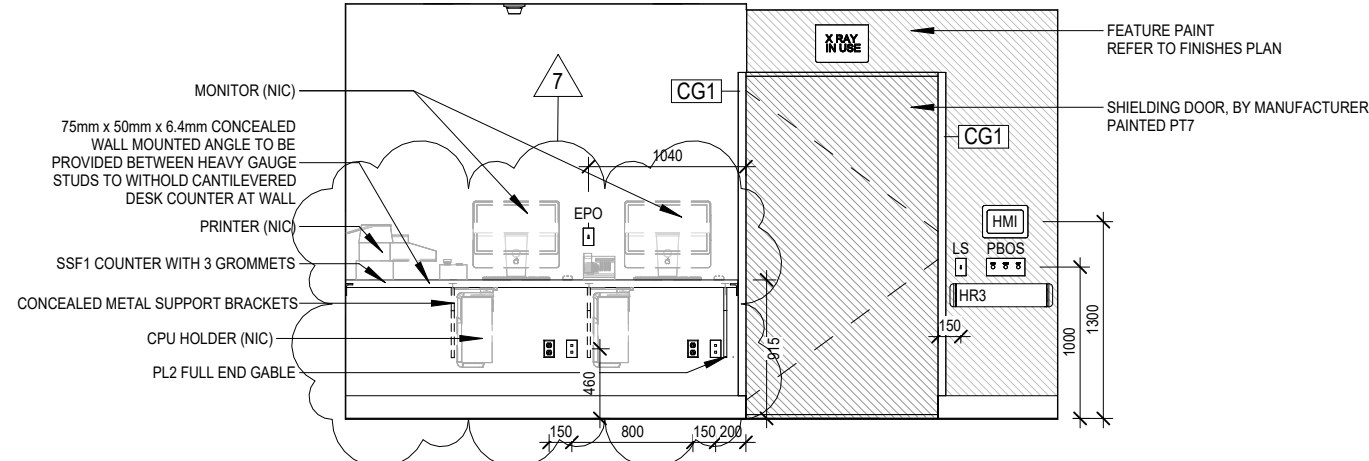


5 ORTHOVOLTAGE CONTROL - 1F427 - WEST ELEVATION
1:50

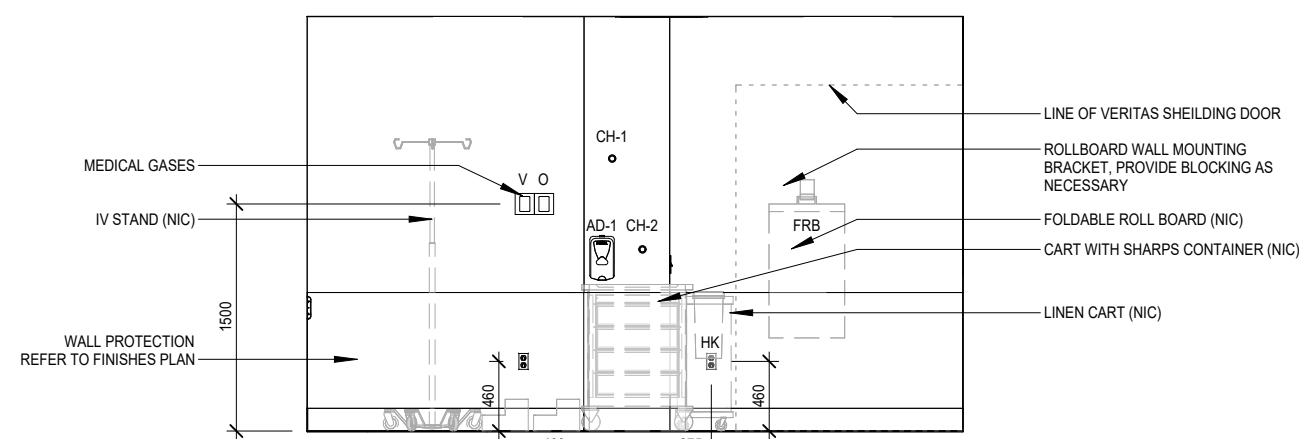


4 ORTHOVOLTAGE RM - 1F426 - NORTH ELEVATION
1:50

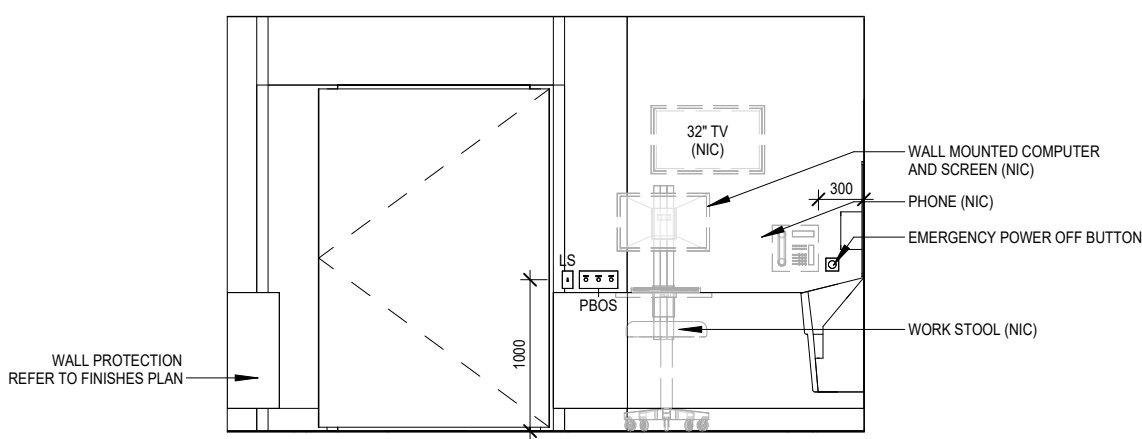

3 ORTHOVOLTAGE RM - 1F426 - EAST ELEVATION
1:50

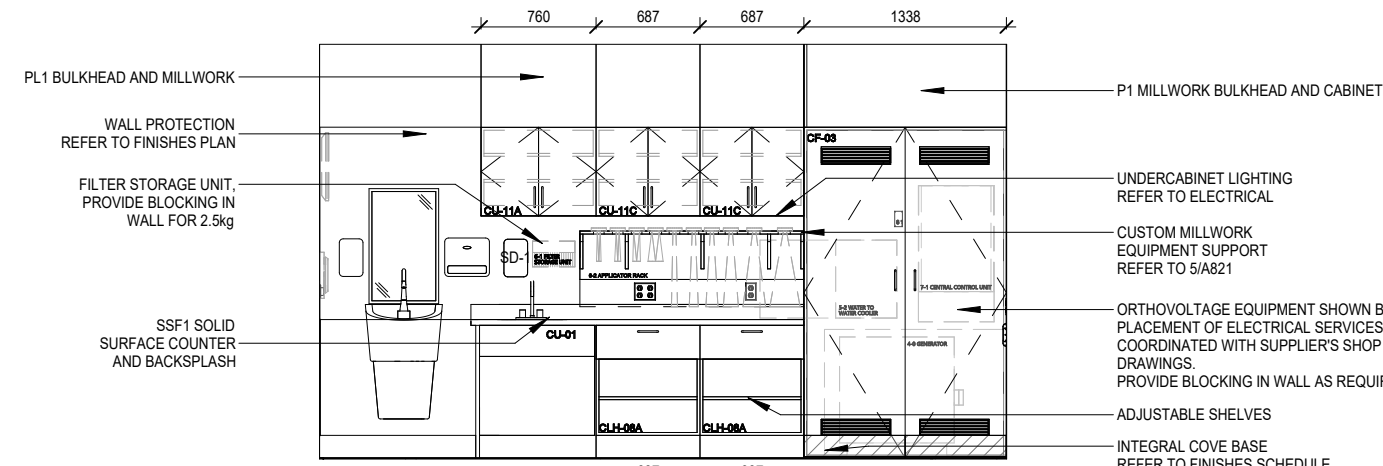


2 ORTHOVOLTAGE RM - 1F426 - SOUTH ELEVATION
1:50

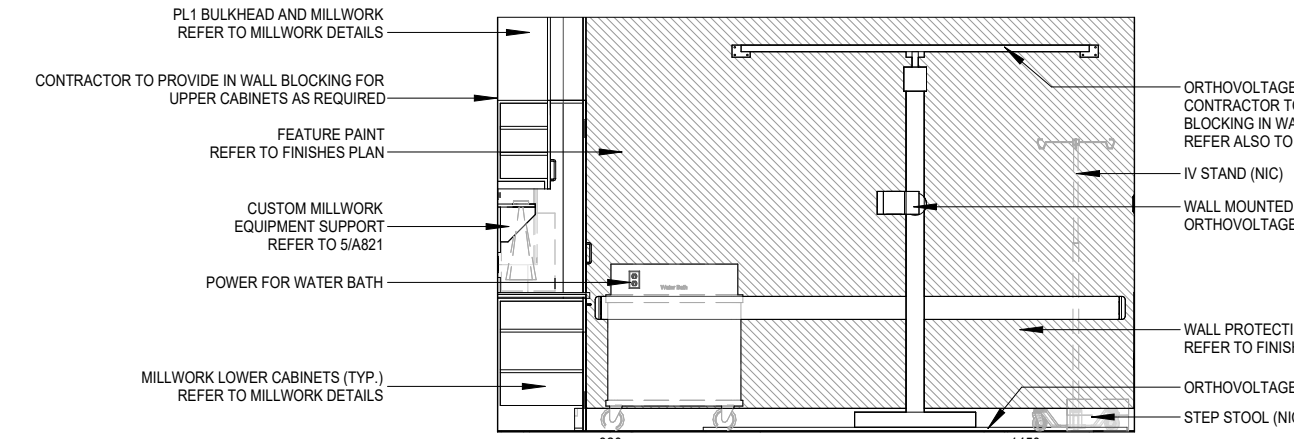


1 ORTHOVOLTAGE RM - 1F426 - WEST ELEVATION
1:50

PROJECT NO: 23010
CHECKED:
Checker


DRAWING NO: A1000

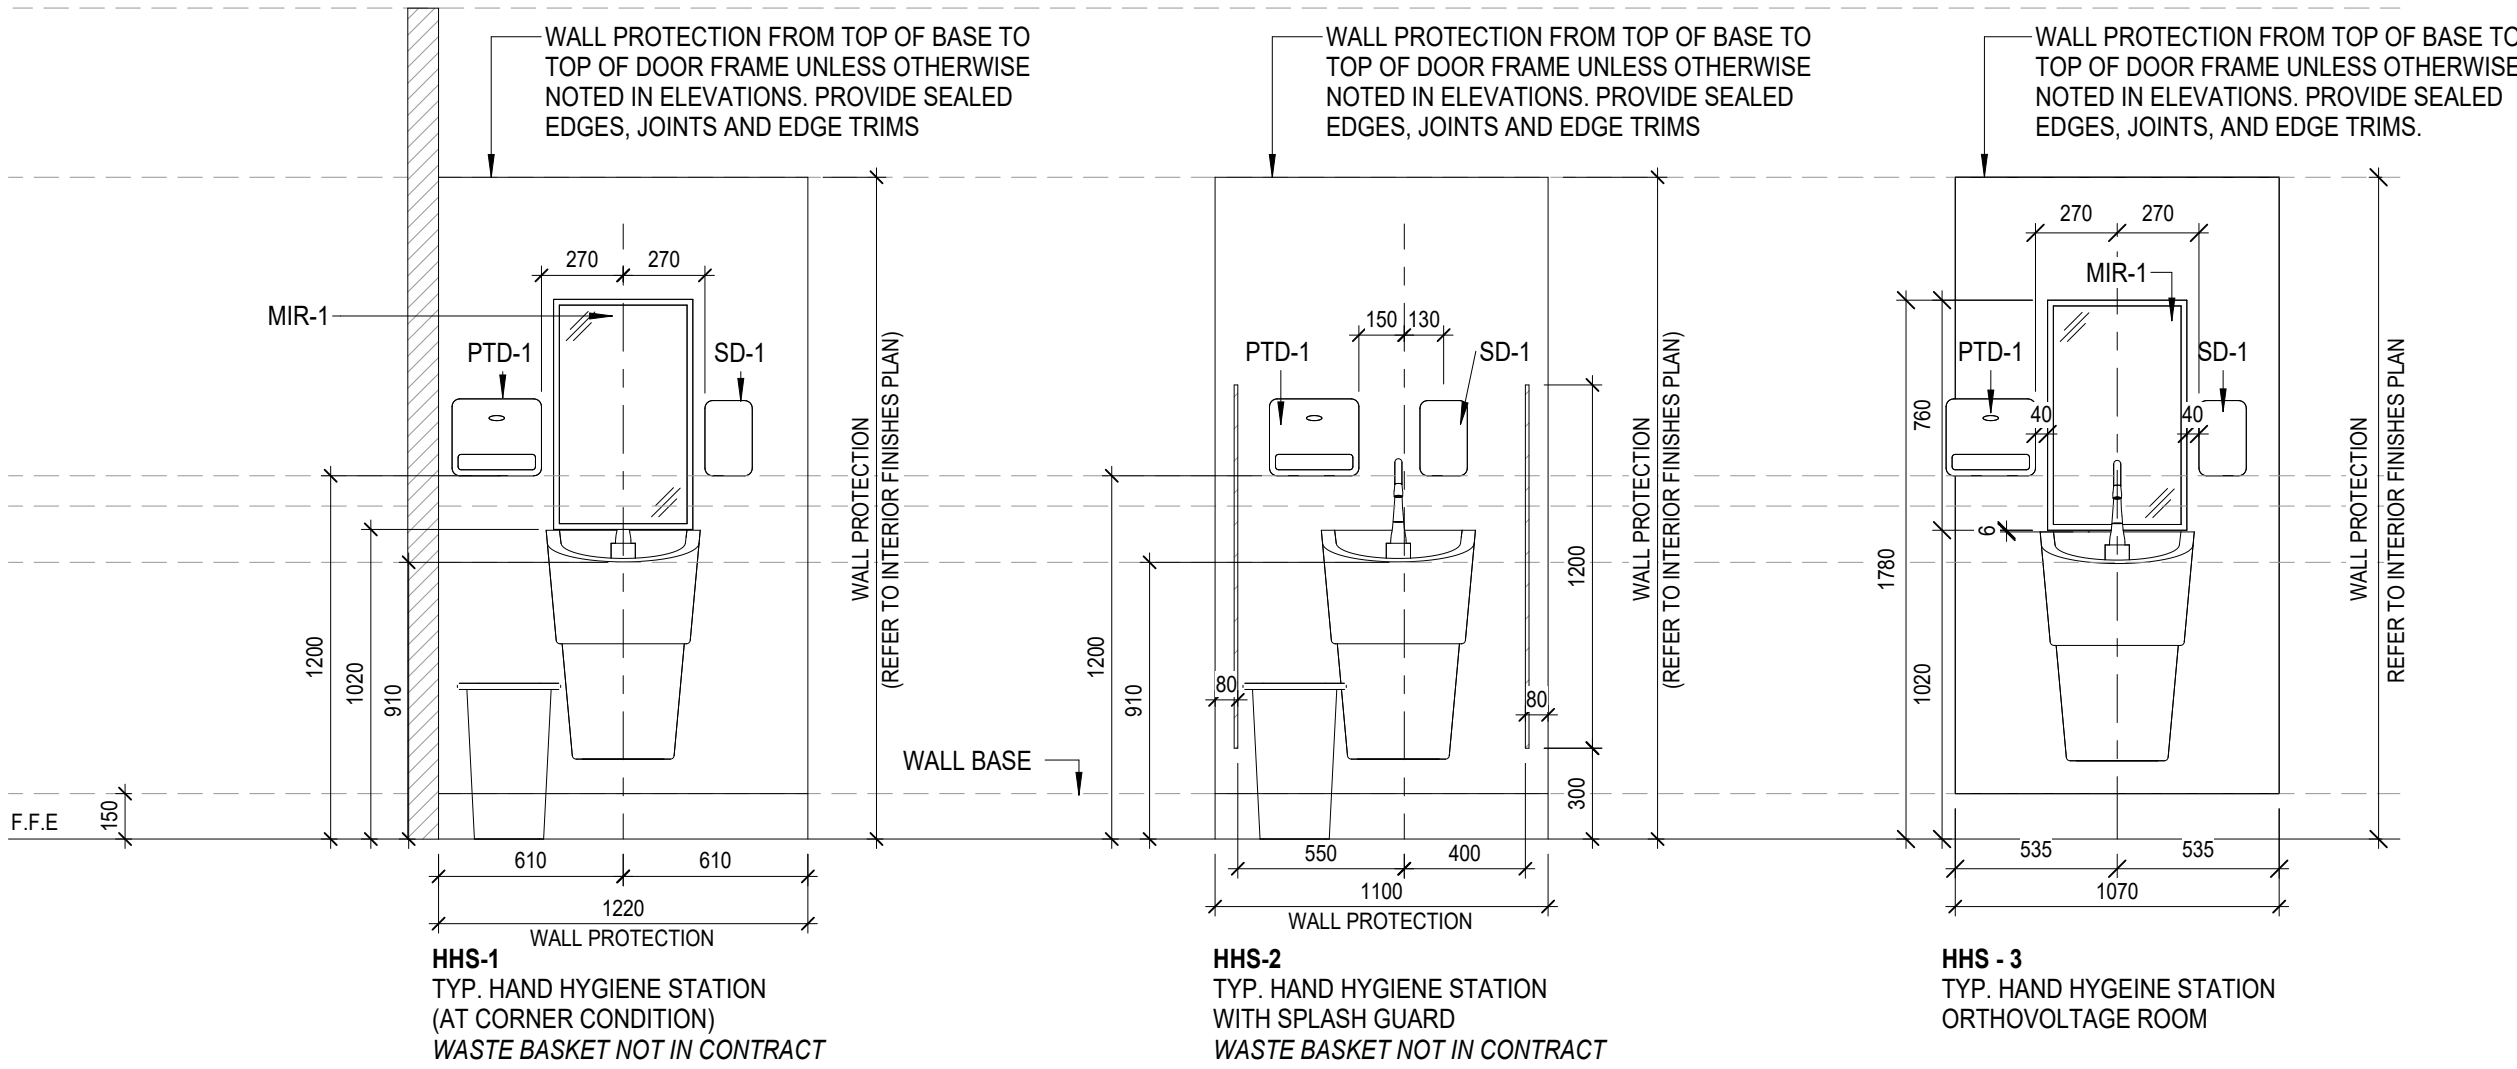


HAND HYGIENE SINK STATION TYPES

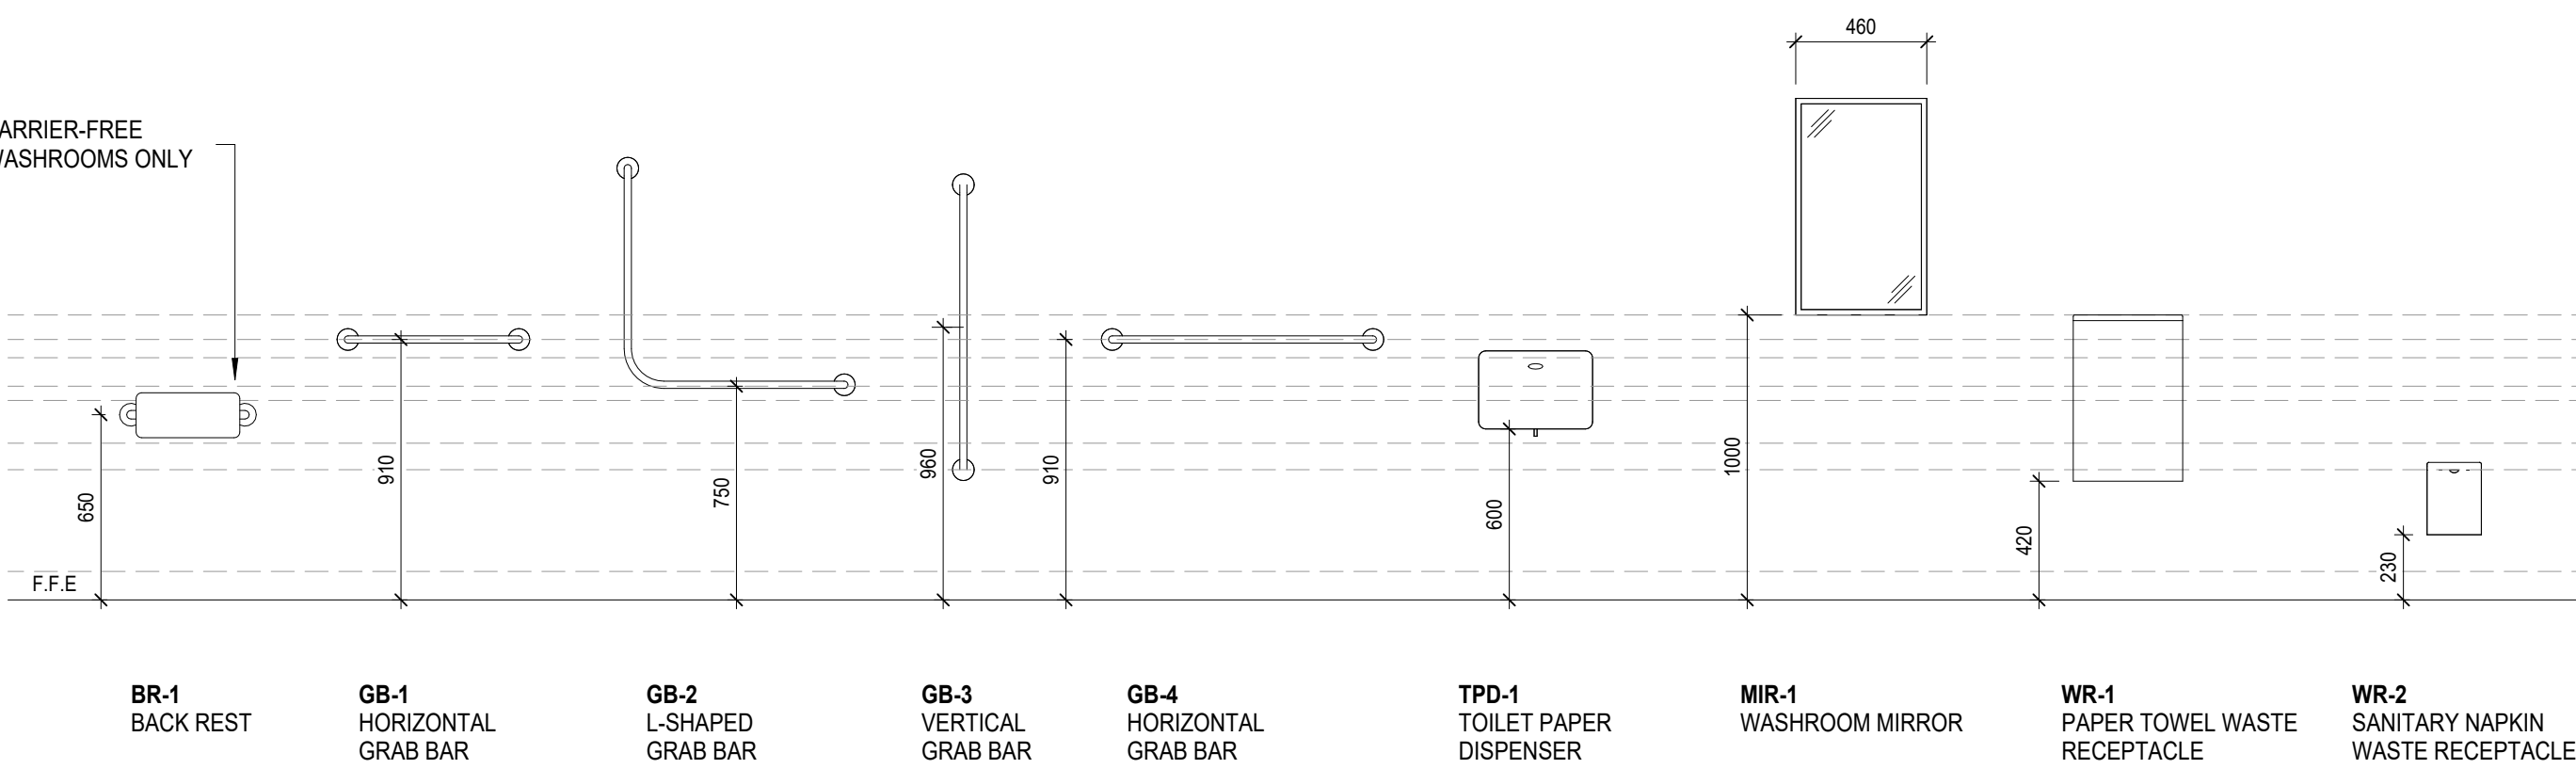

WASHROOM FIXTURES & ACCESSORIES

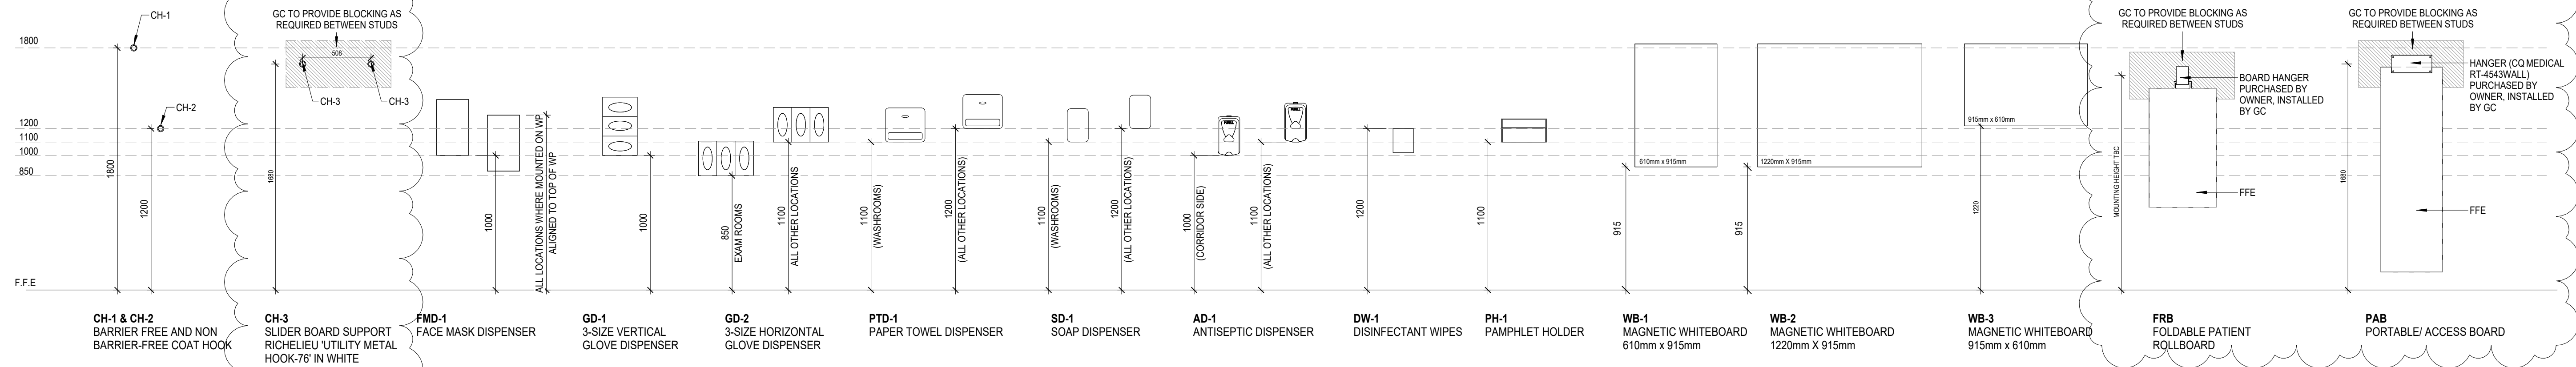


ROOM ACCESSORIES

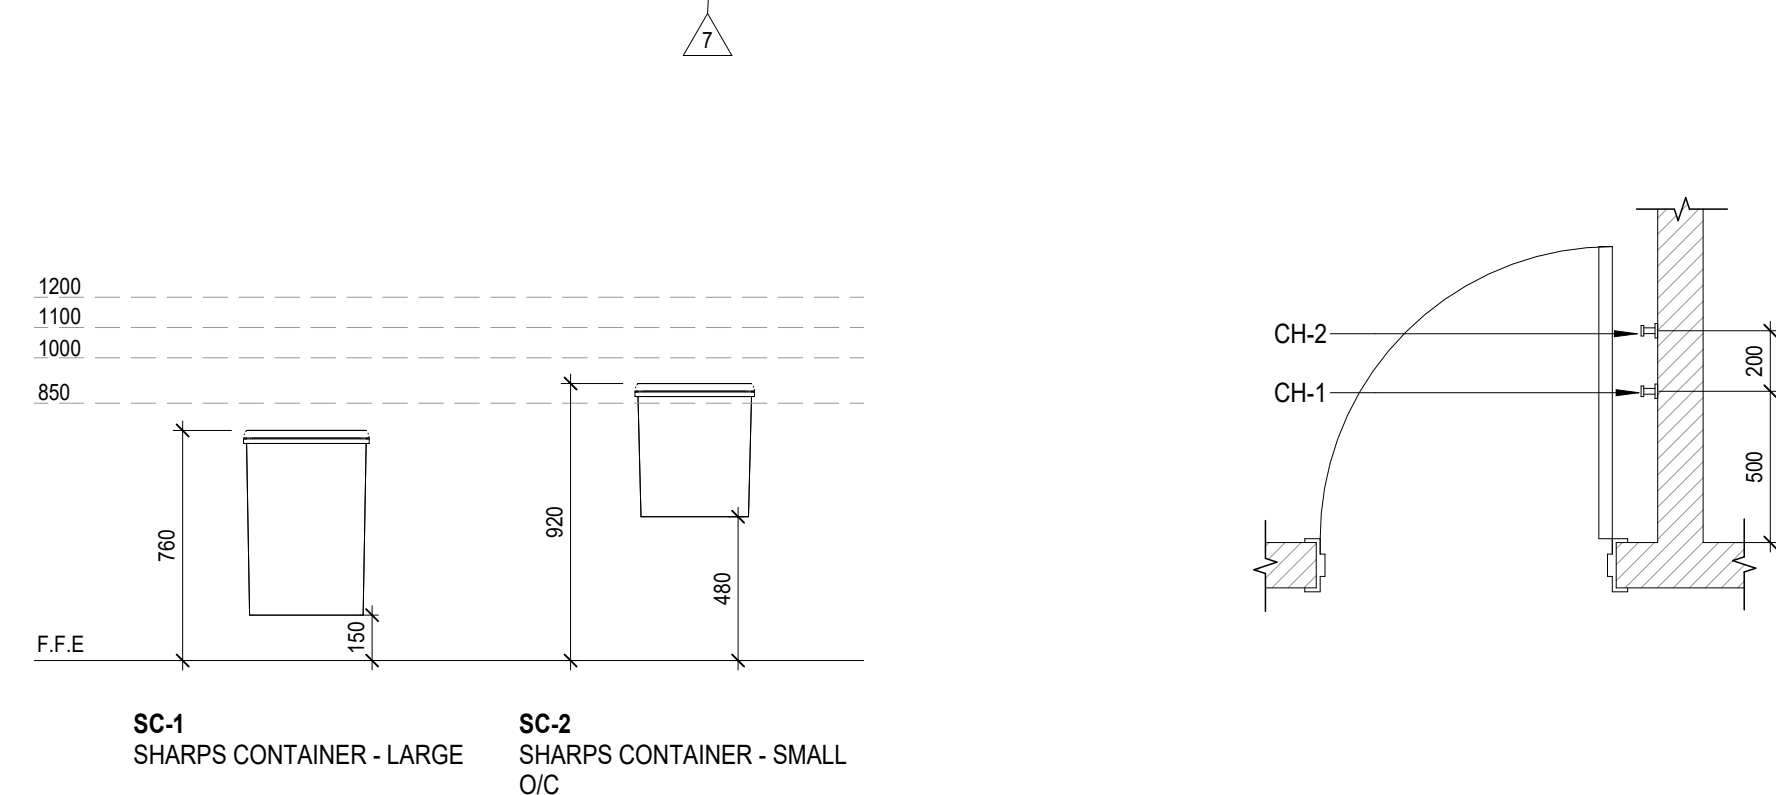

ROOM ACCESSORIES

COAT HOOKS TYP. AT SWING DOOR

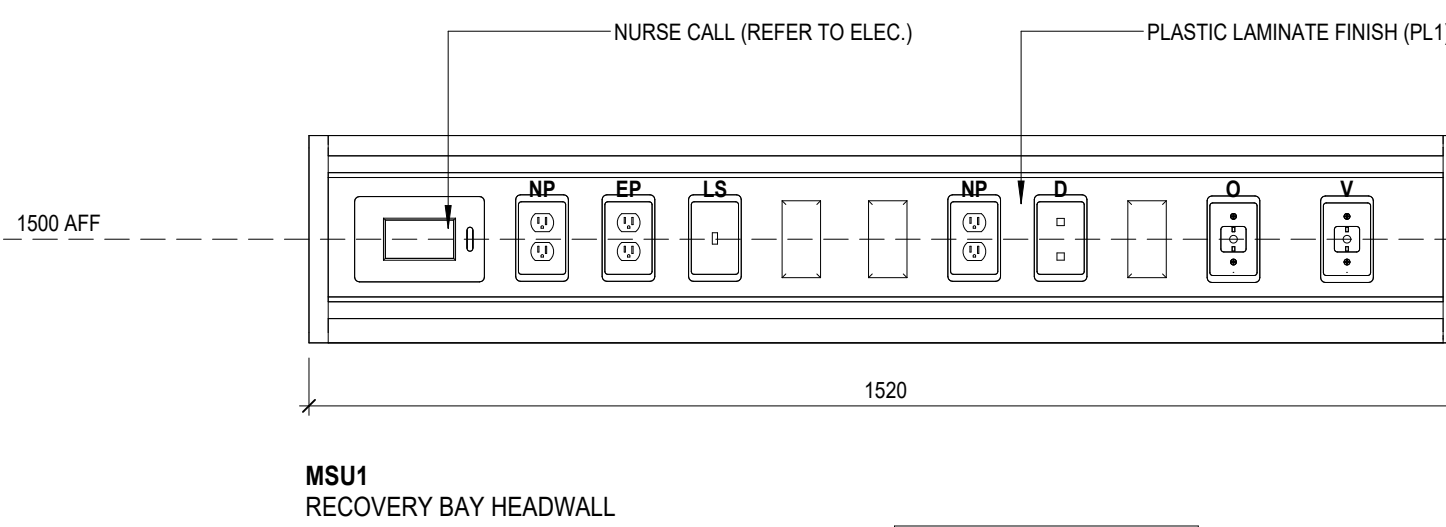


MEDICAL SERVICE UNIT TYPES (MSU)


1:10

LEGEND

EP = EMERGENCY POWER
NP = NORMAL POWER
D = DATA
DS = DIMMER SWITCH
ER = EQUIPMENT RAIL
FP = BLANK PLATE
O = OXYGEN GAS
V = VACUUM

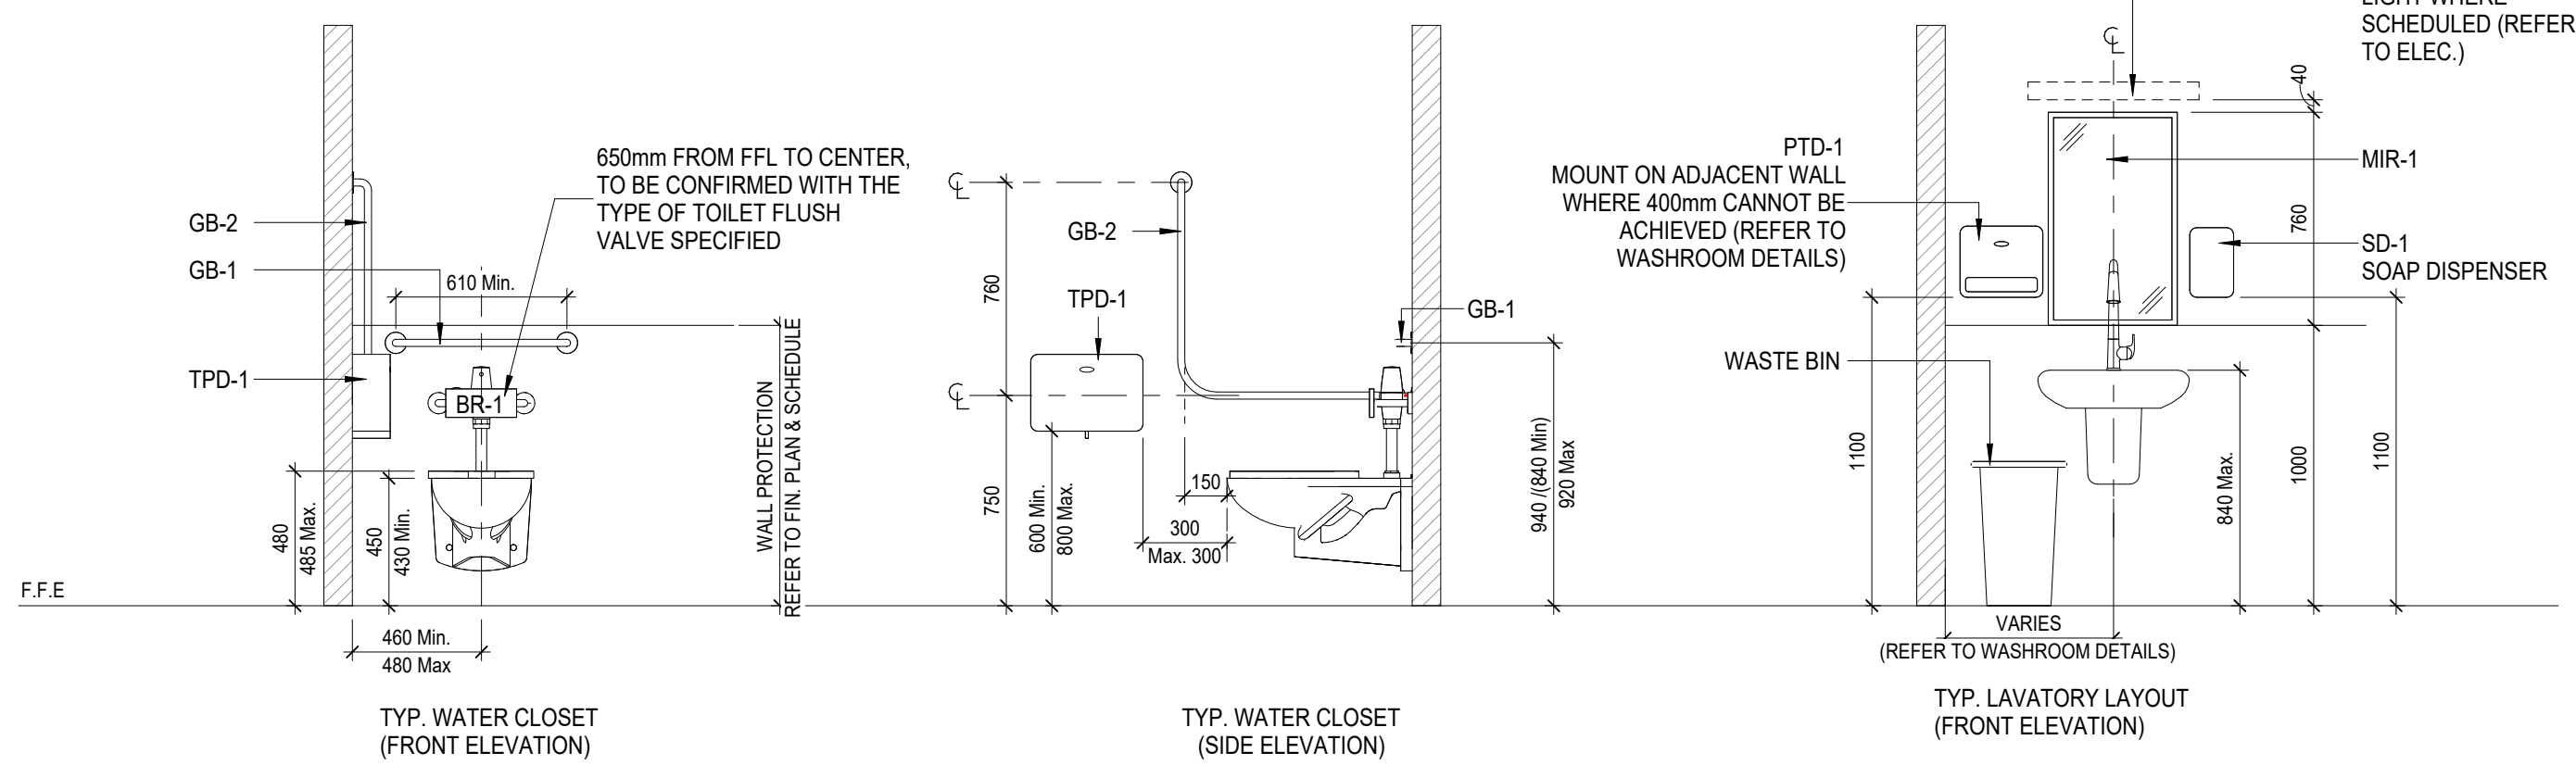


WASHROOM FIXTURES & ACCESSORIES

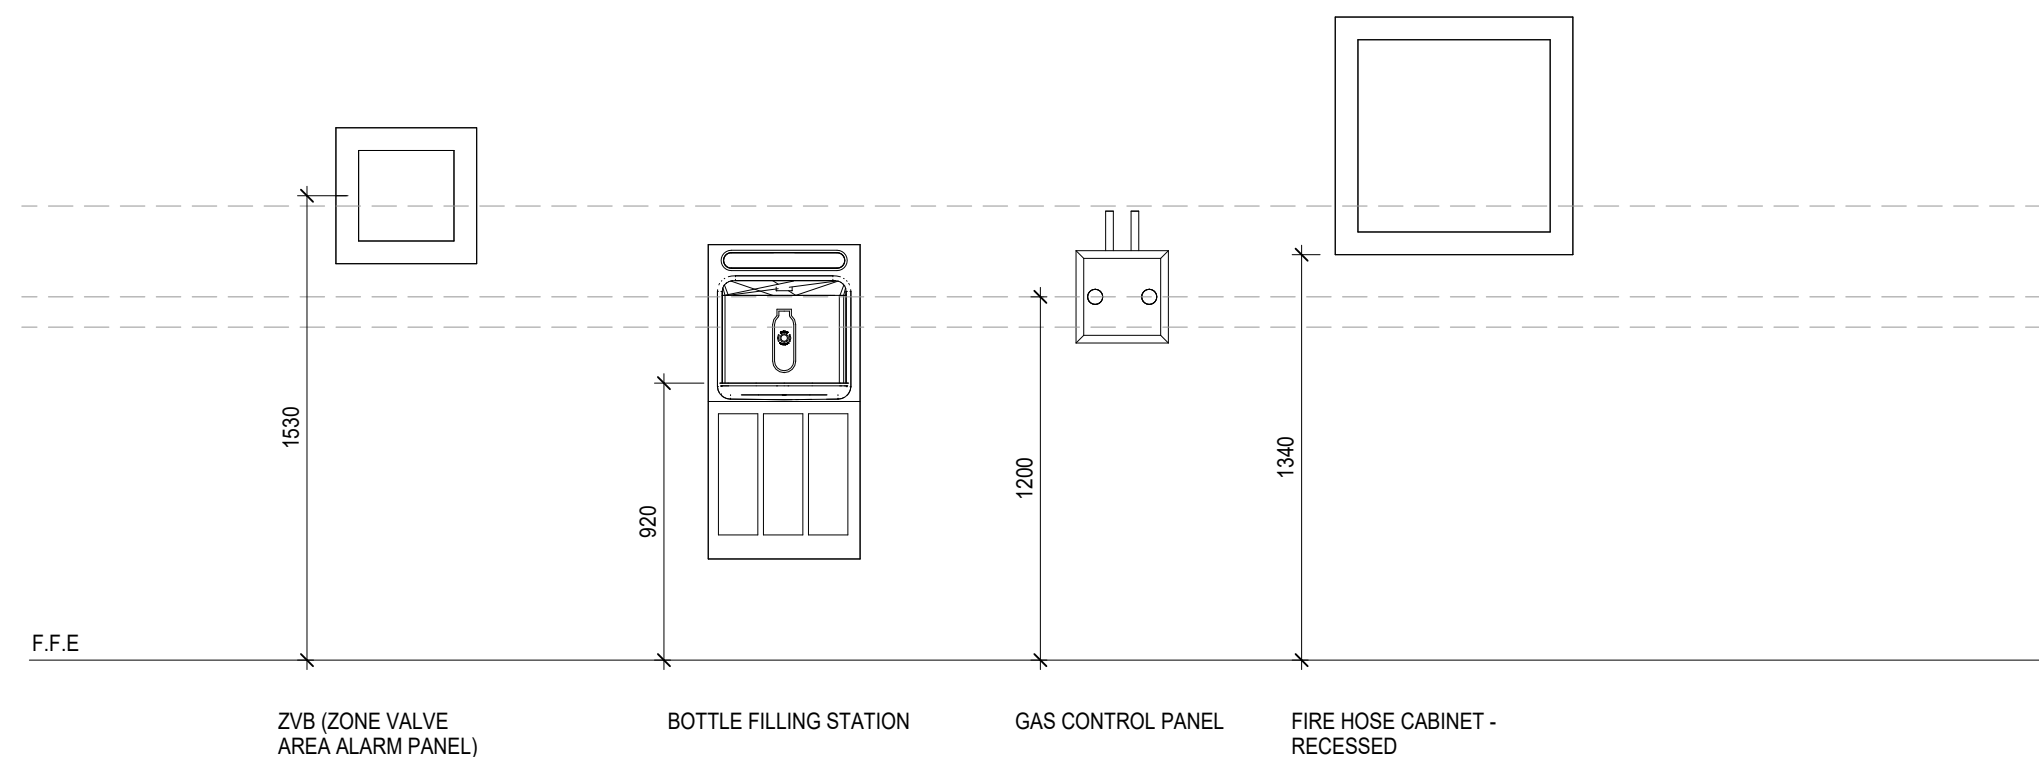

MECHANICAL DEVICES

NOTE: REFER TO MECHANICAL DRAWINGS

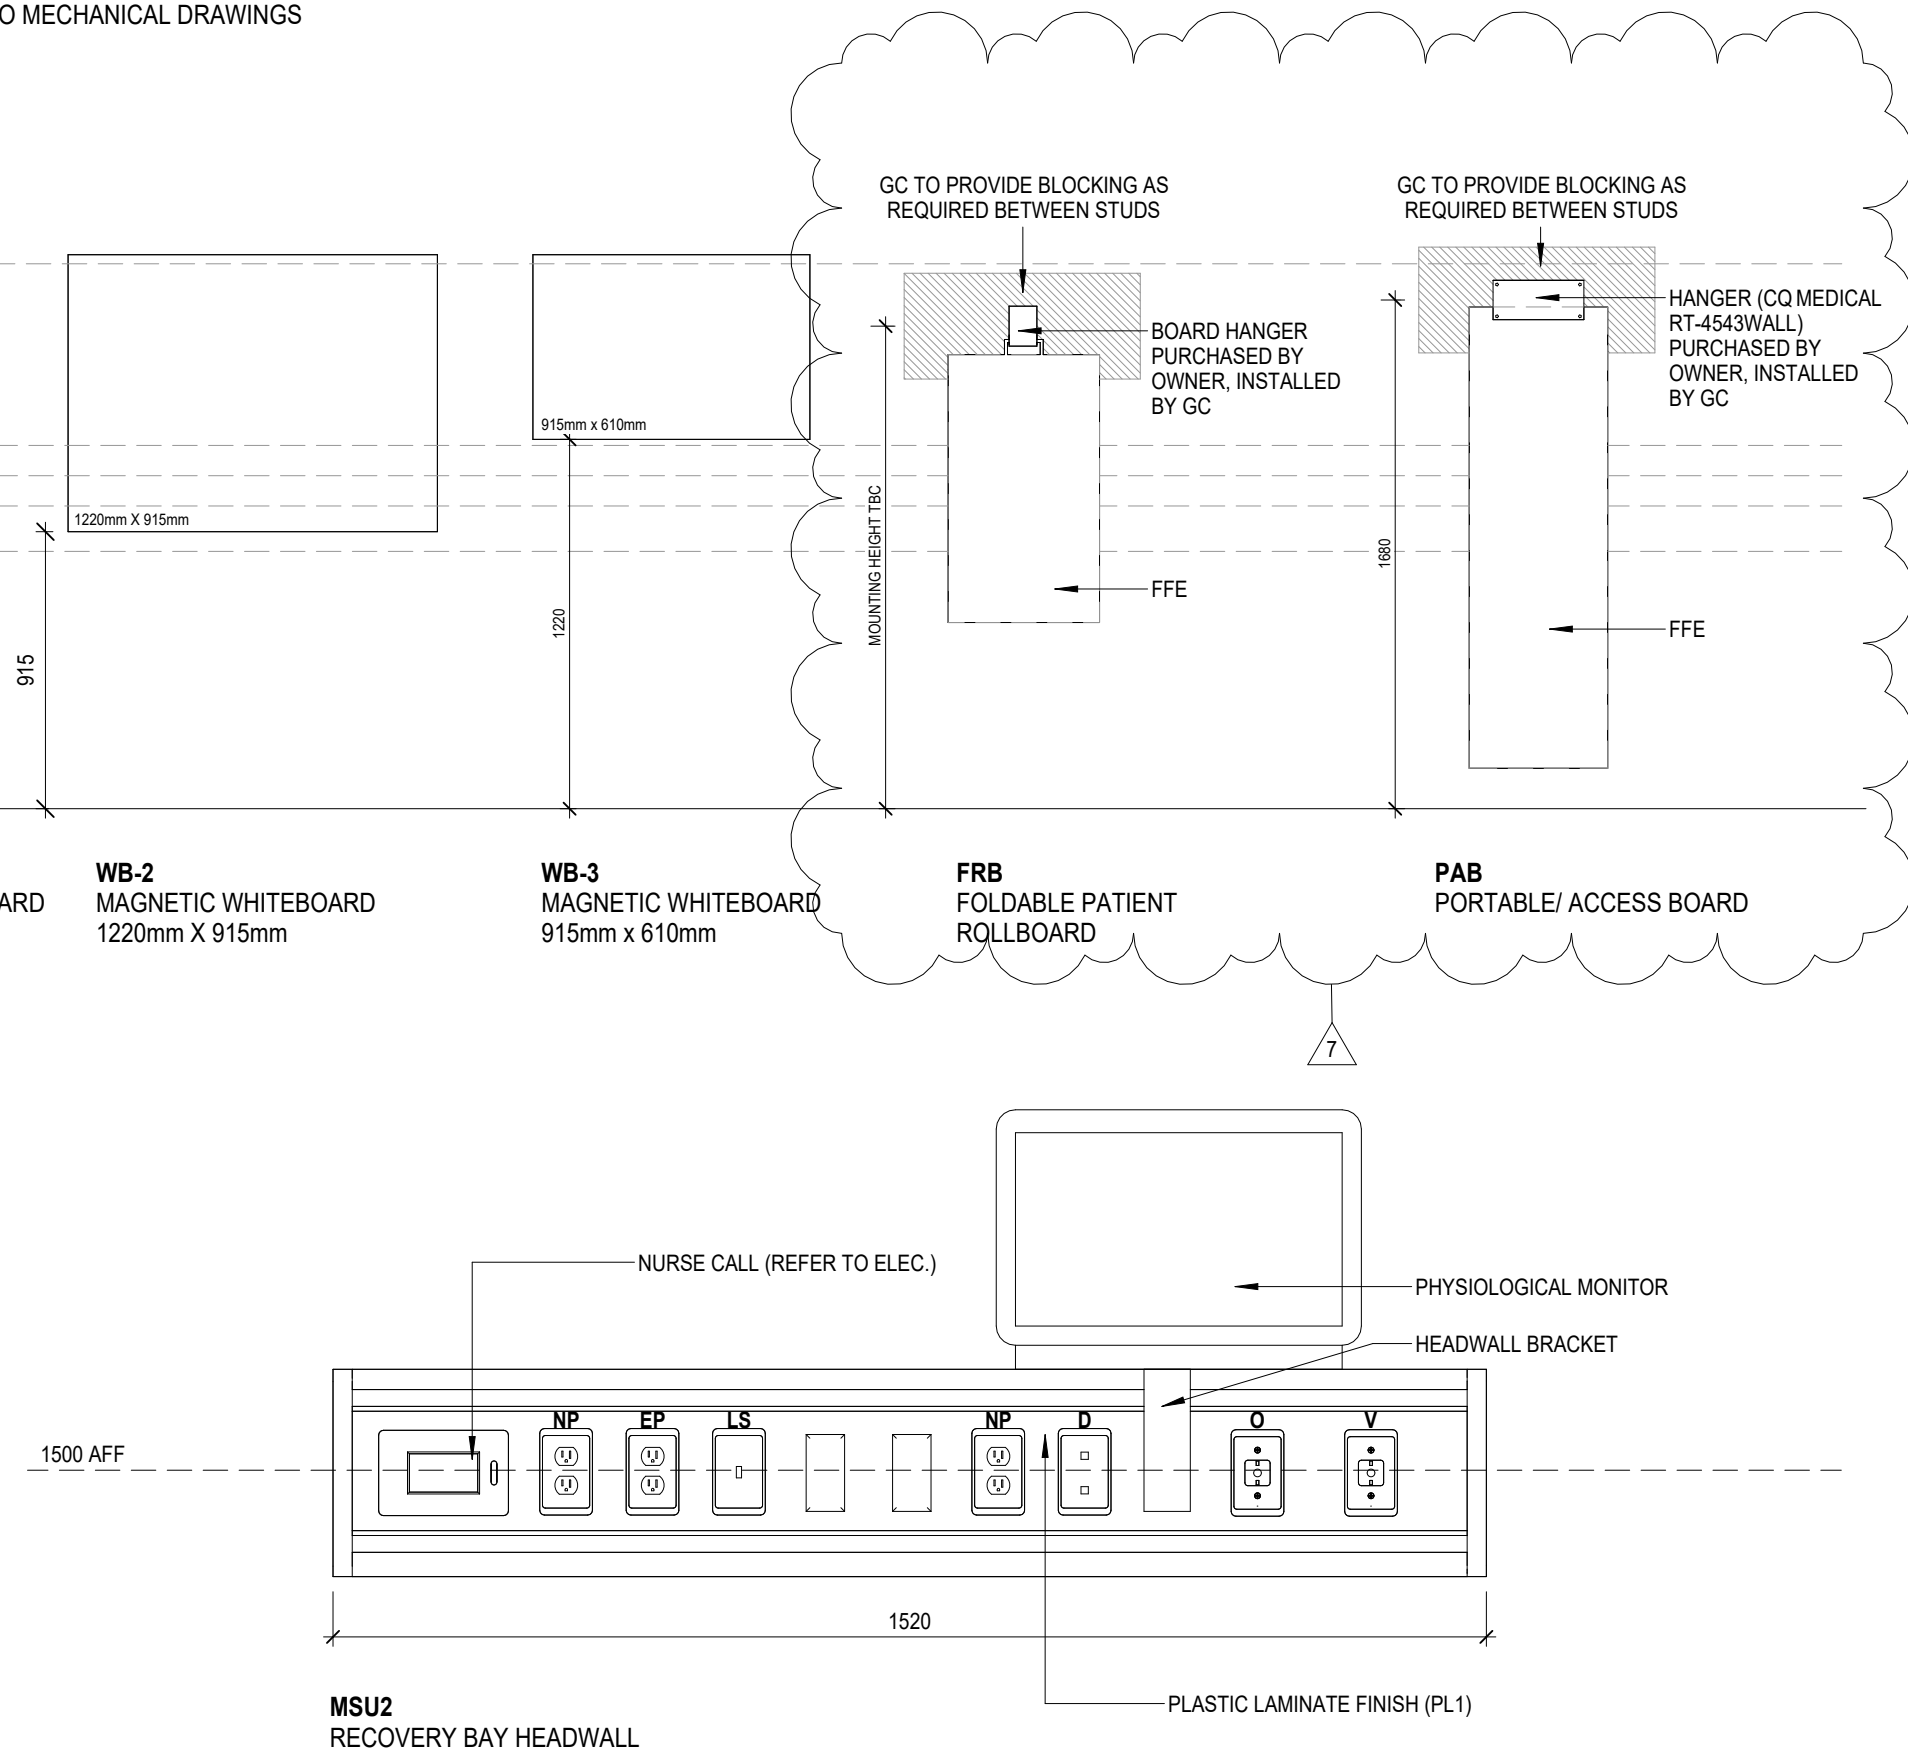

CLIENT:

Trillium Health Partners
2200 Eglinton Avenue West
Mississauga, ON L5M 2N1
905 813 2200
thp.ca

CONSULTANT:


CUMULUS ARCHITECTS INC.
160 Pears Ave. - Suite 300
Toronto, ON M5R 3P8
416-539-0763
www.cumulusarch.com

SEAL:

This drawing, as an instrument of service, is the property of Cumulus Architects Inc. the copyright in the same being reserved to them. No reproduction is allowed without the permission of Cumulus Architects Inc. and when made must bear its name.

This drawing is not to be scaled. The contractor is to verify dimensions and data noted herein for conformity with the conditions on site and is responsible for reporting in writing any discrepancy to Cumulus Architects Inc. for adjustment.

Cumulus will not be liable for any claims or damages arising from the unauthorized use of this drawing or any portion thereof.

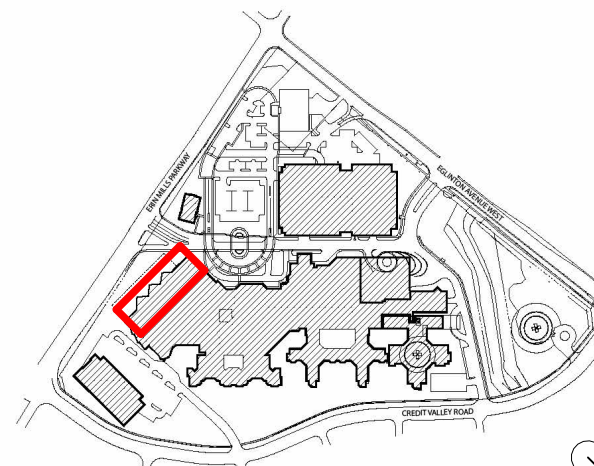

NO	DESCRIPTION	DATE
7	Issued for Addendum 1	2026/02/04
6	Issued for Tender	2025/12/16
5	Issued for Building Permit	2025/12/02
4	Issued For MOH 2.3 Resubmission	2025/06/20
2	Issued For MOH 2.3 Costing	2024/09/13

SHEET REVISION

PROJECT:
Oncology Radiation Treatment Expansion
2200 Eglinton Ave W,
Mississauga, ON L5M 2N1

TITLE:

MOUNTING HEIGHTS

PROJECT NO:

23010

CHECKED:

Checker

DRAWING NO:

A1001